
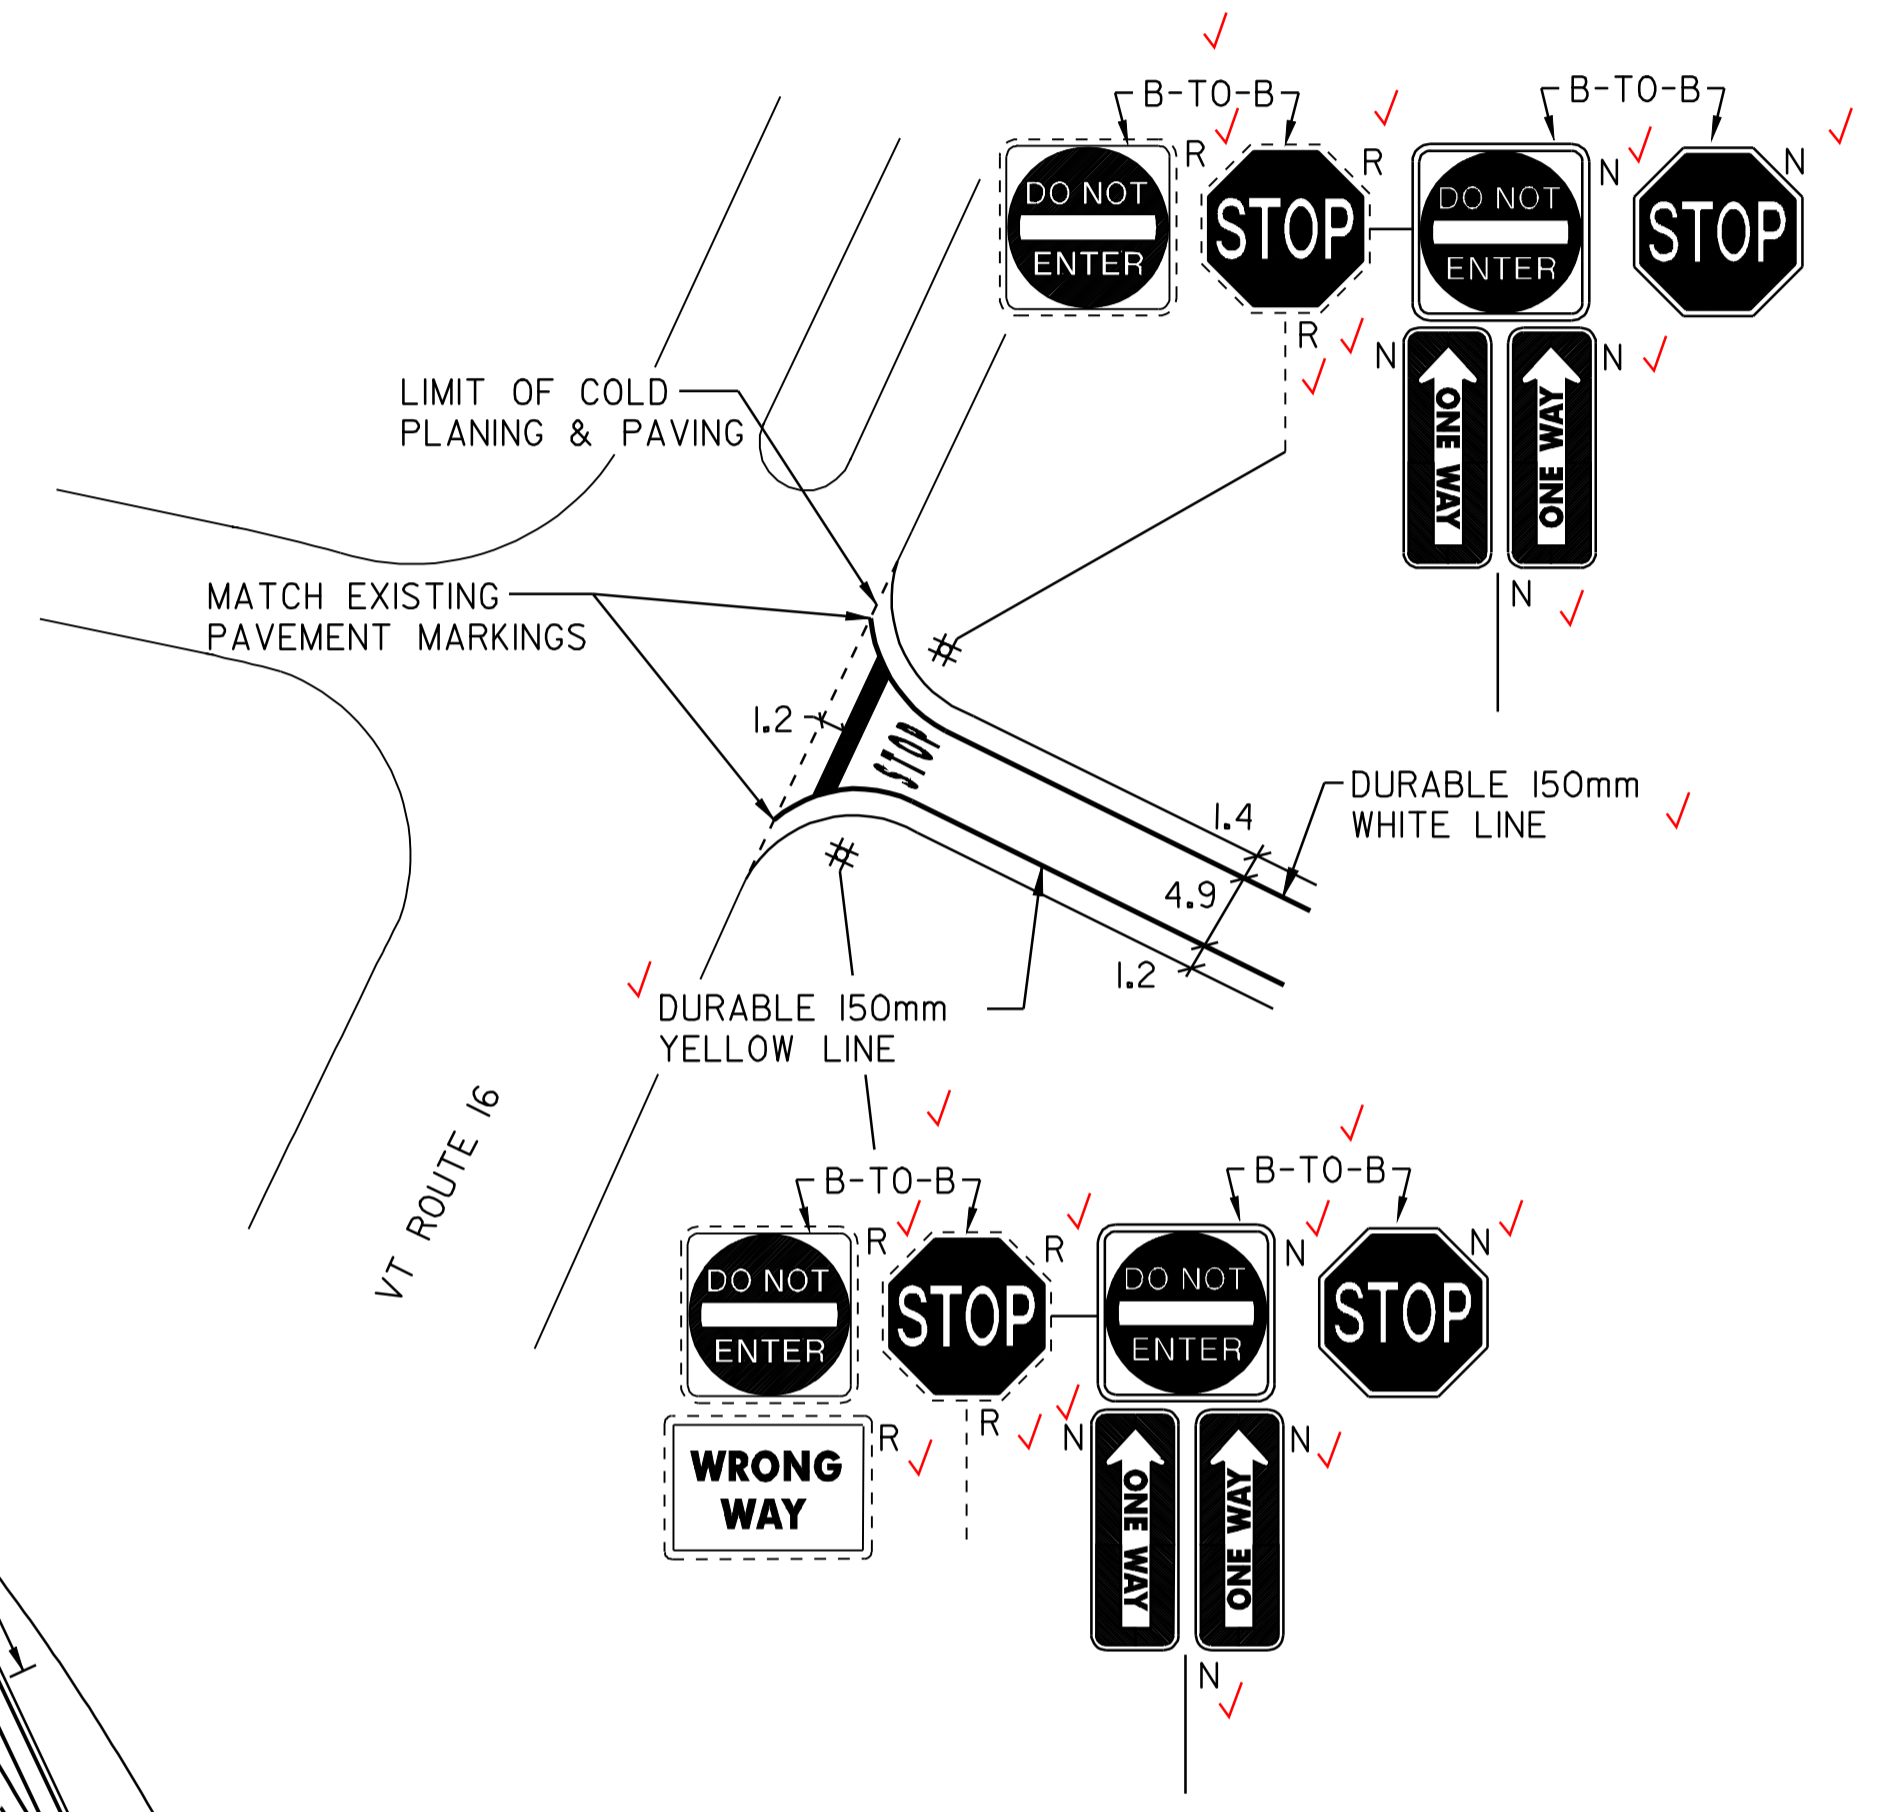


RAMP A

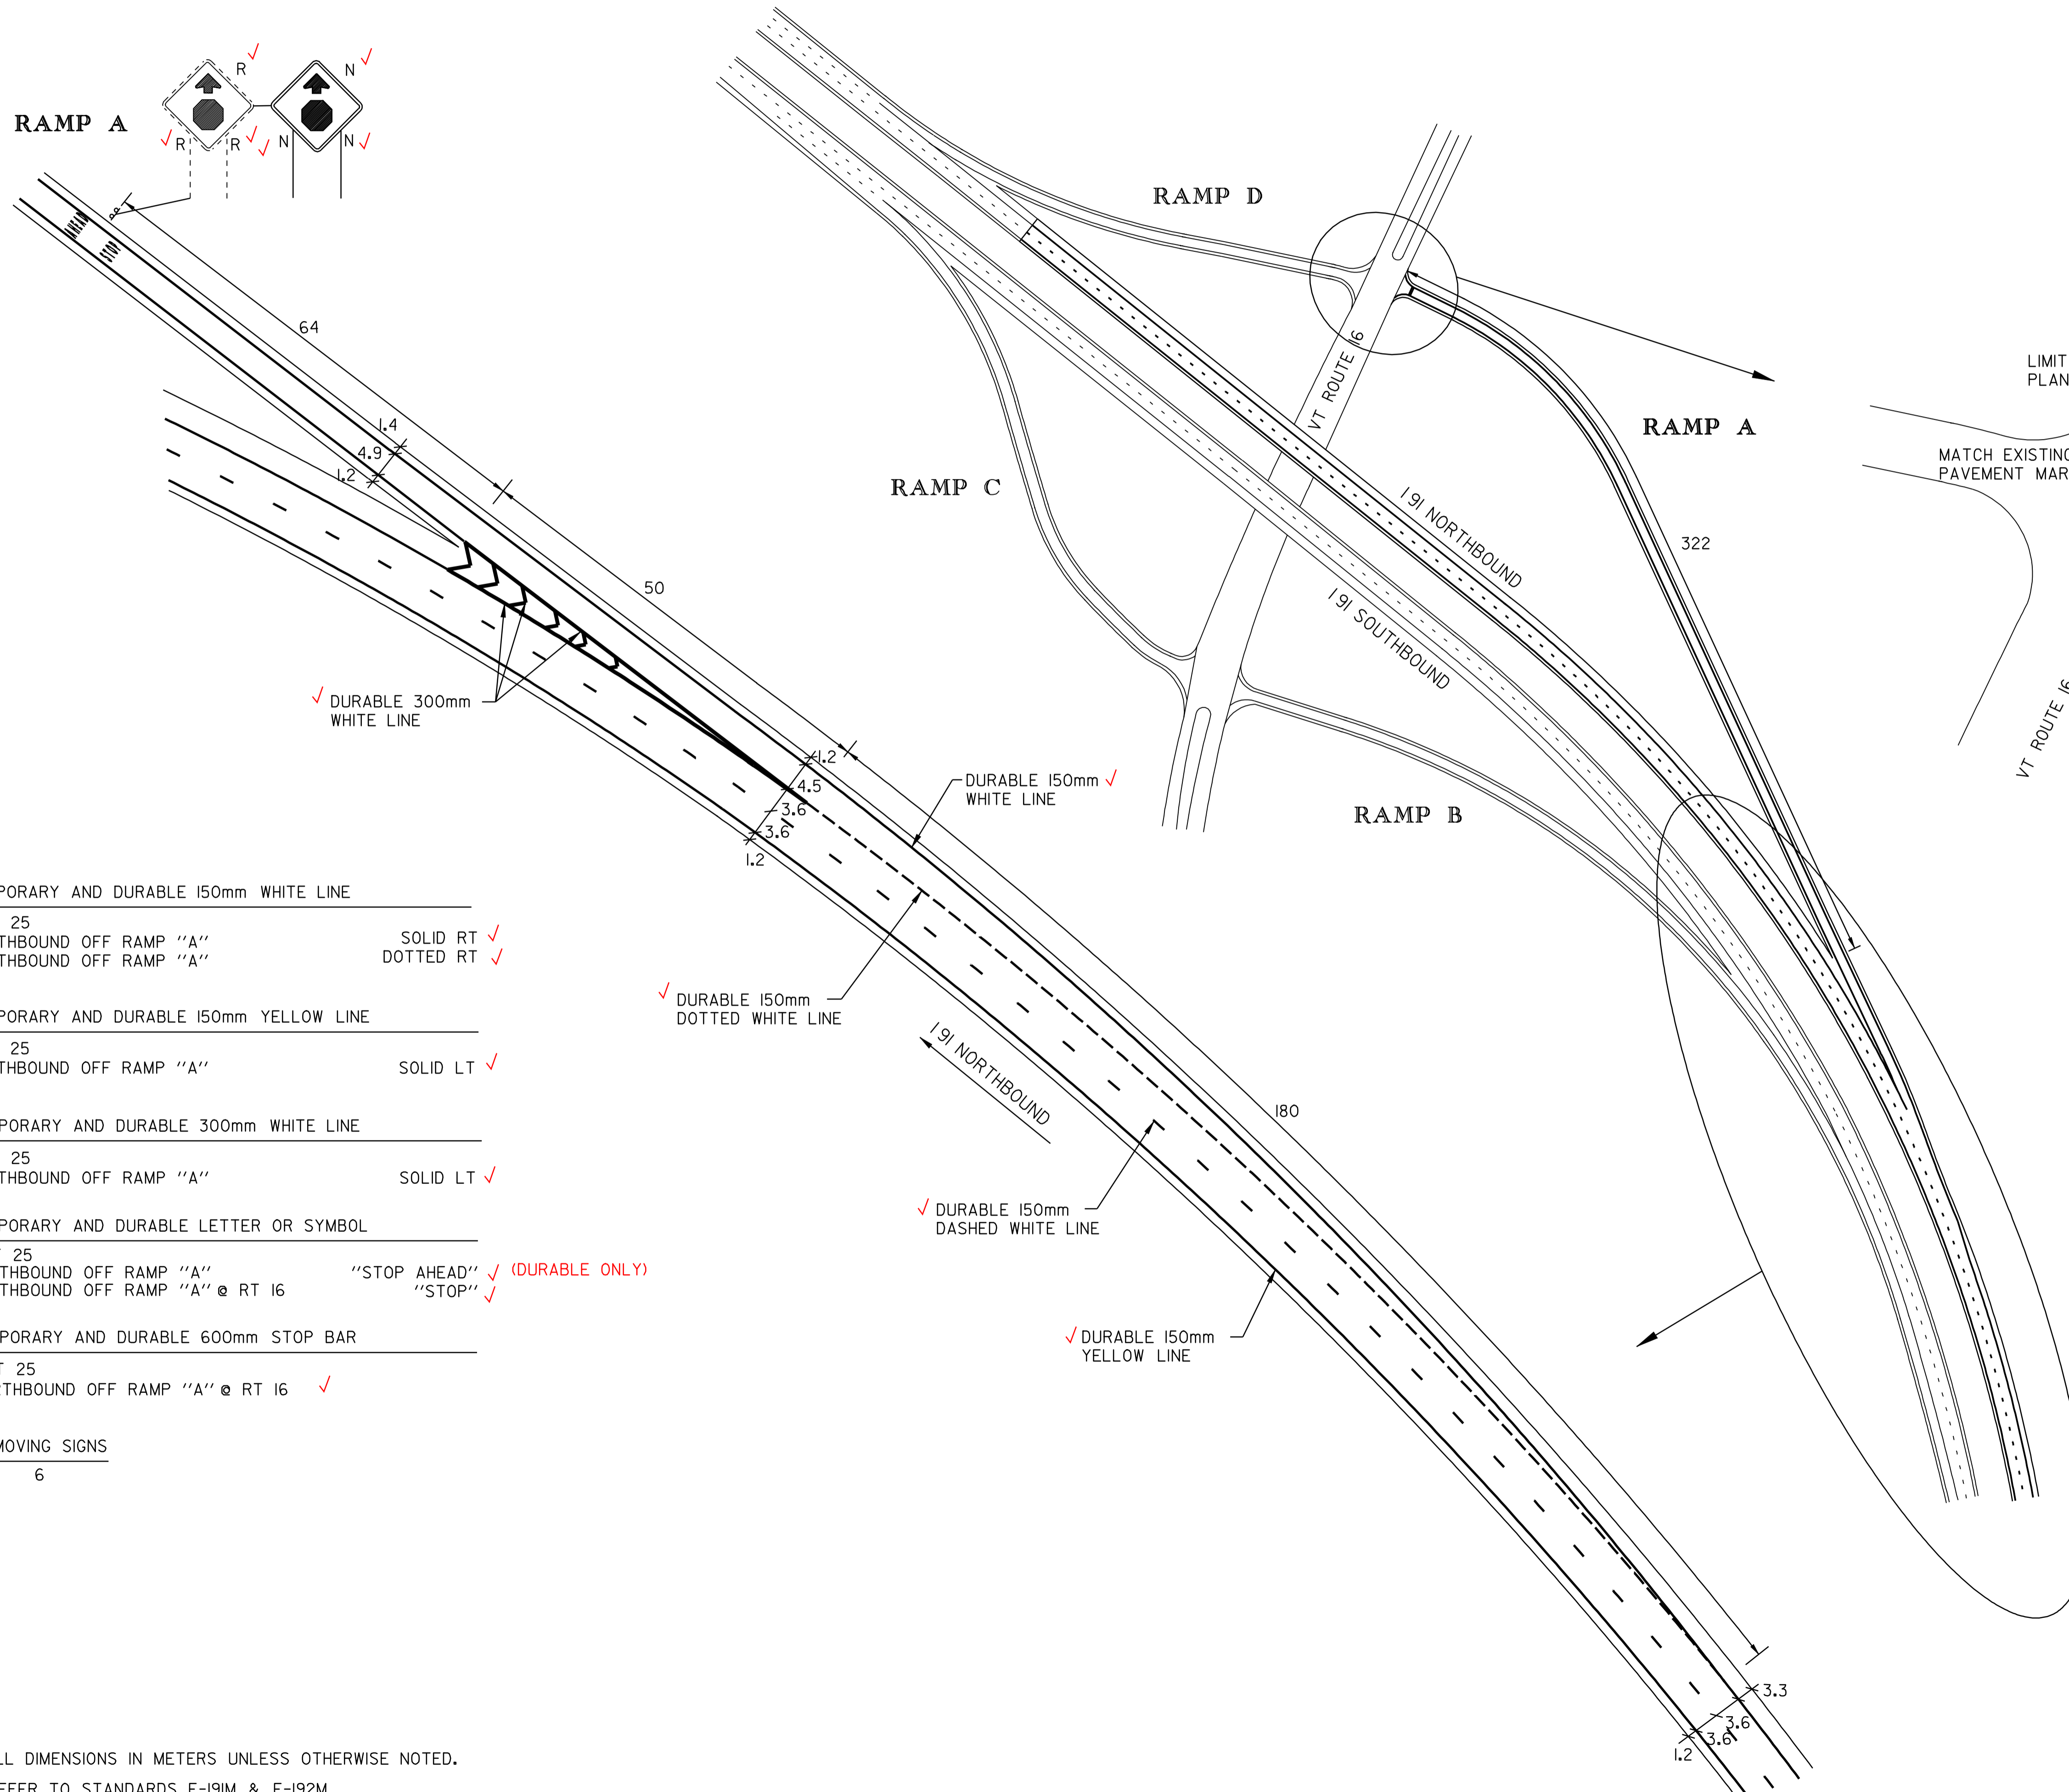

TEMPORARY AND DURABLE 150mm WHITE LINE

EXIT 25 NORTHBOUND OFF RAMP "A" SOLID RT ✓  
 NORTHBOUND OFF RAMP "A" DOTTED RT ✓

TEMPORARY AND DURABLE 150mm YELLOW LINE

EXIT 25 NORTHBOUND OFF RAMP "A" SOLID LT ✓

TEMPORARY AND DURABLE 300mm WHITE LINE

EXIT 25 NORTHBOUND OFF RAMP "A" SOLID LT ✓

TEMPORARY AND DURABLE LETTER OR SYMBOL

EXIT 25 NORTHBOUND OFF RAMP "A" "STOP AHEAD" (DURABLE ONLY) ✓  
 NORTHBOUND OFF RAMP "A" @ RT 16 "STOP" ✓

TEMPORARY AND DURABLE 600mm STOP BAR

EXIT 25 NORTHBOUND OFF RAMP "A" @ RT 16 ✓

REMOVING SIGNS

6

NOTE: ALL DIMENSIONS IN METERS UNLESS OTHERWISE NOTED.  
 REFER TO STANDARDS E-191M & E-192M FOR ADDITIONAL DETAILS.

**ARCHIVED  
IN DPR**



<b>RAMP DETAIL SHEET INTERCHANGE #25</b>	DESIGNED BY	BCE/PJM	DATE	9-00
	DRAWN BY	C.E.A., INC.	DATE	9-00
	DESIGN FILE NO.	/pave/99a204/pa204.dgn		
	PRF FILE	pa204i05.1	DATE PLOTTED	03-APR-2008 15:04
	PROJ. NAME	LYNDON - BARTON		
PROJ. NO.	IM 091 - 3(10)			
SHEET	11	OF	17	SHEETS