
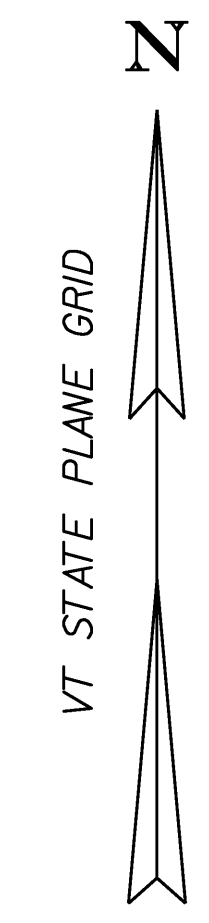
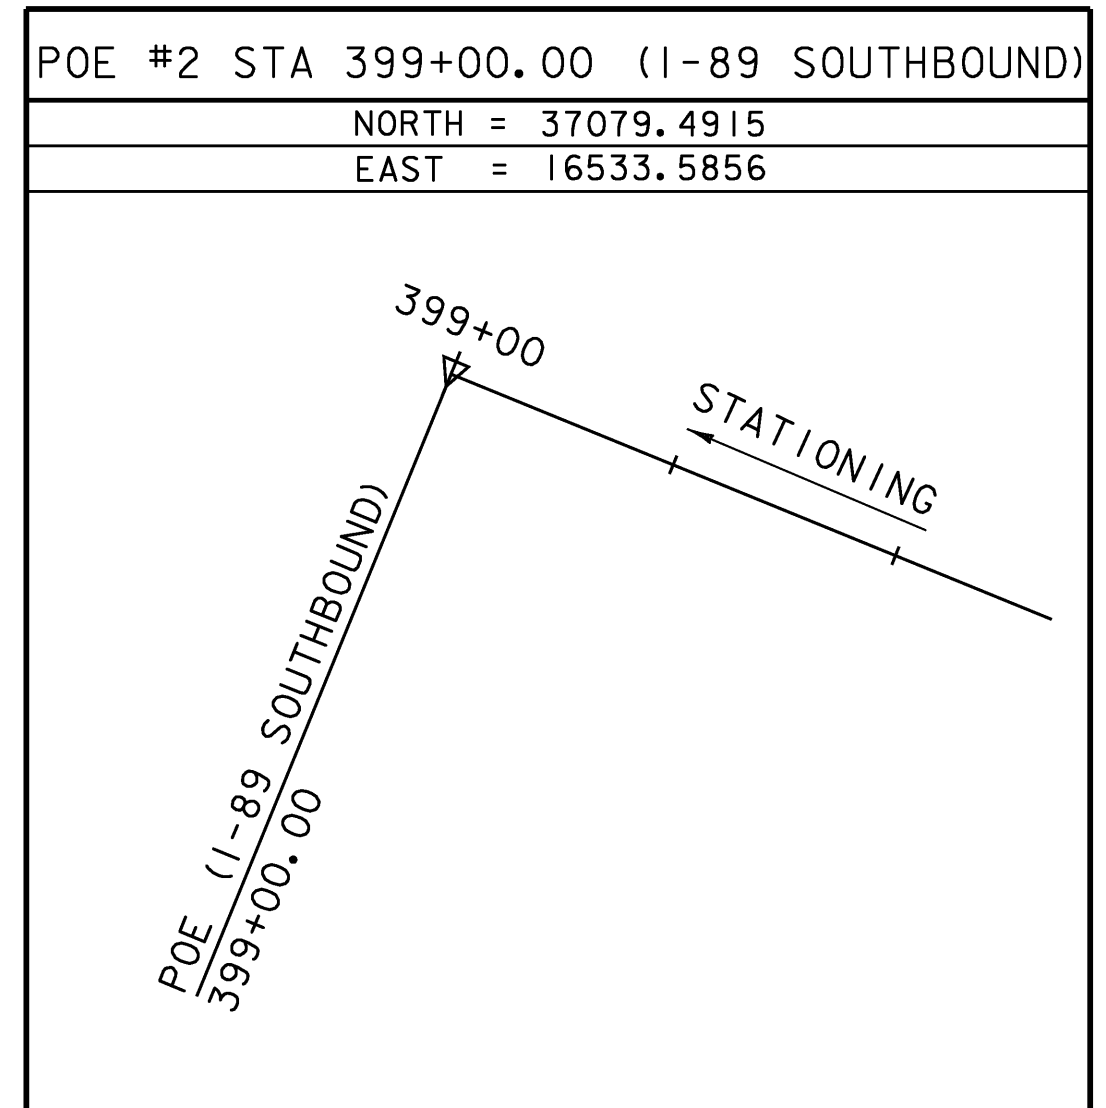
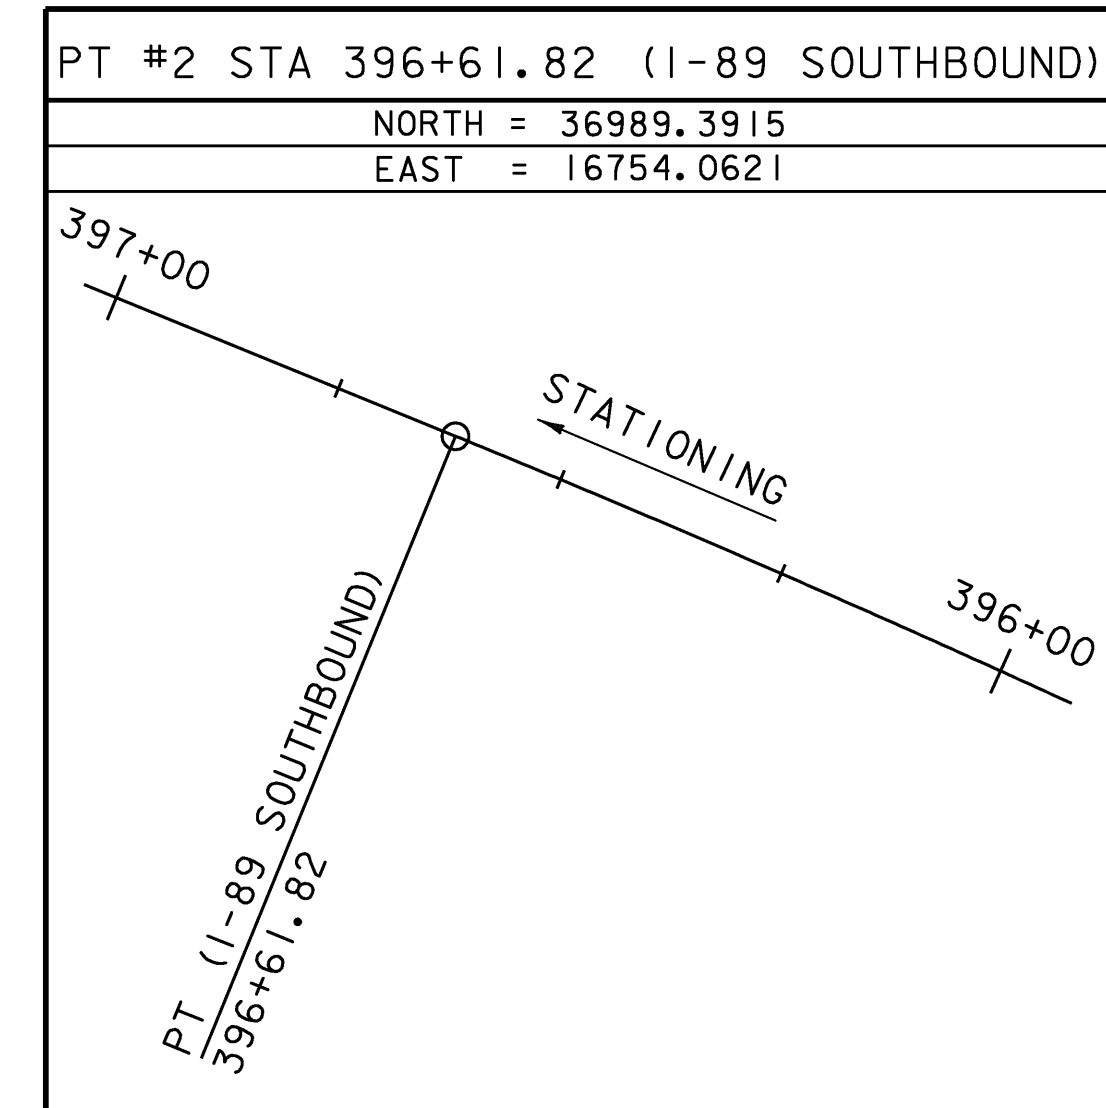
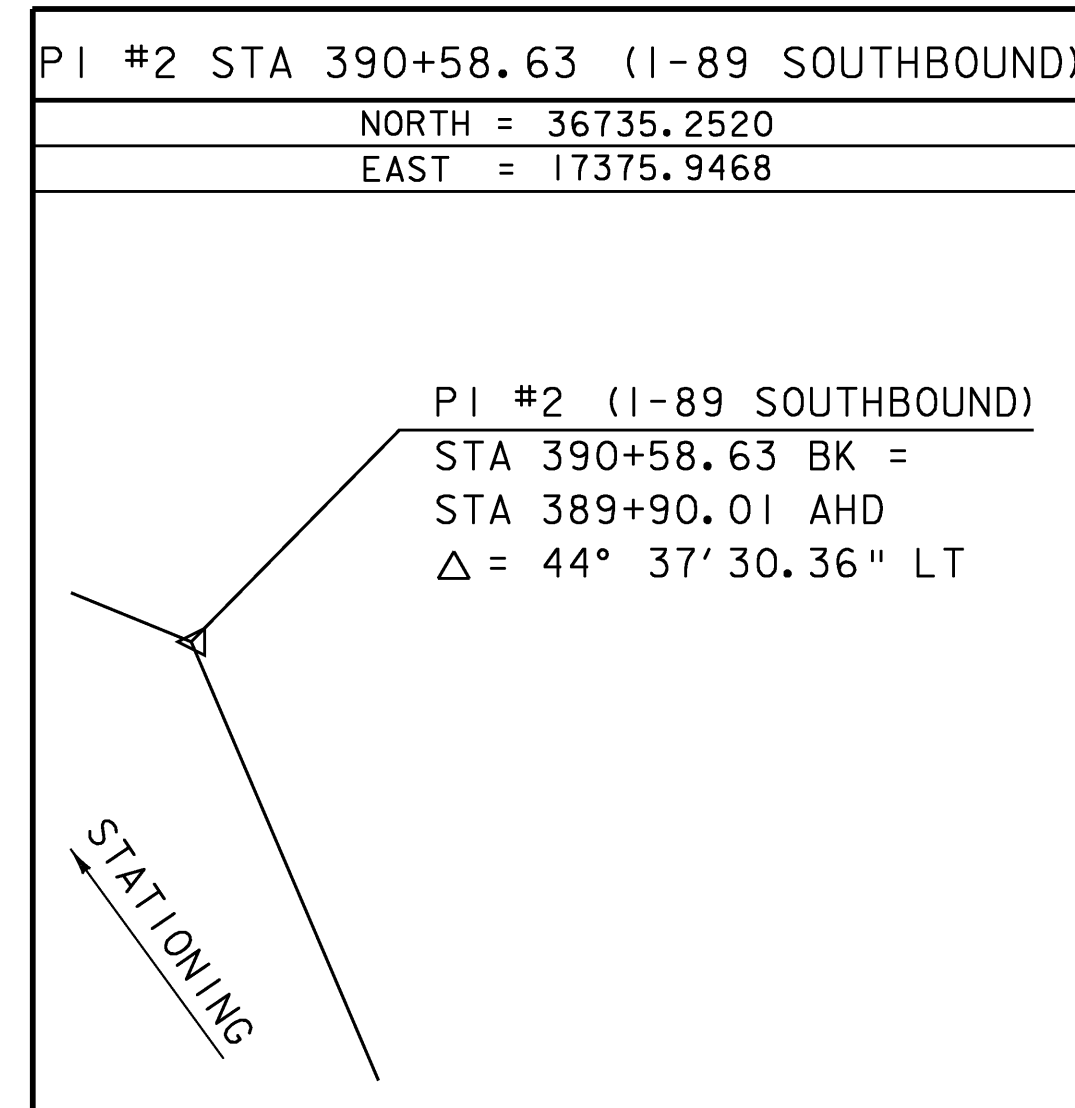


ALIGNMENT TIES

I-89 SOUTHBOUND

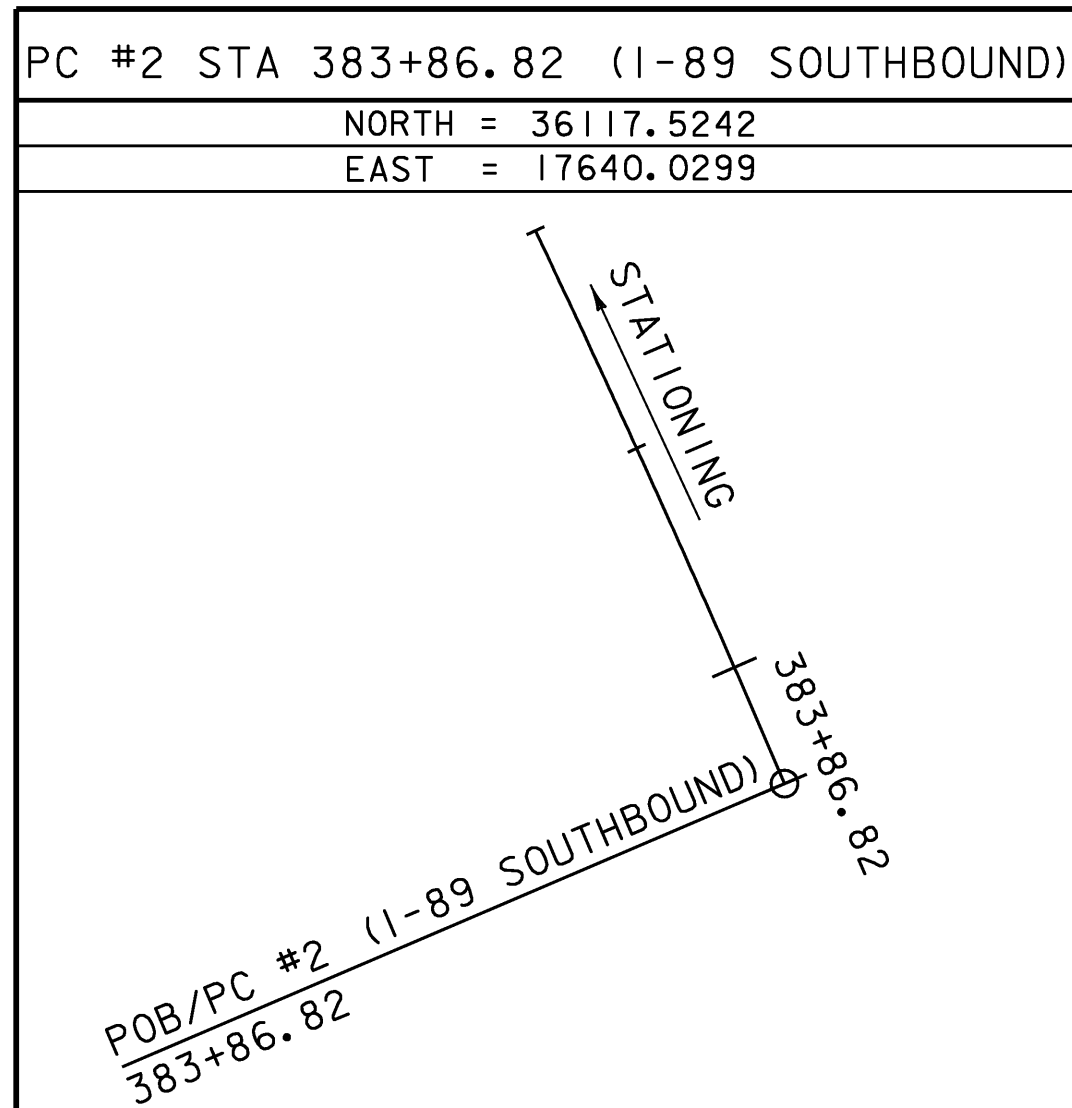

DATUM	
VERTICAL	NAVD 88
HORIZONTAL	NAD-83 (96)
ADJUSTMENT	COMPASS

PROJECT NAME:	BERLIN
PROJECT NUMBER:	IM 089-1(20)
FILE NAME:	99a270/s99a270+1.dgn
PROJECT LEADER:	C.P. WILLIAMS
DESIGNED BY:	G. SPILAK
SOUTHBOUND ALIGNMENT TIES	
PLOT DATE:	05-DEC-2007
DRAWN BY:	J. HULETT
CHECKED BY:	P. HODGE
SHEET	13 OF 104