


PROFILE #2 (LAYOUT I-89 NORTHBOUND)

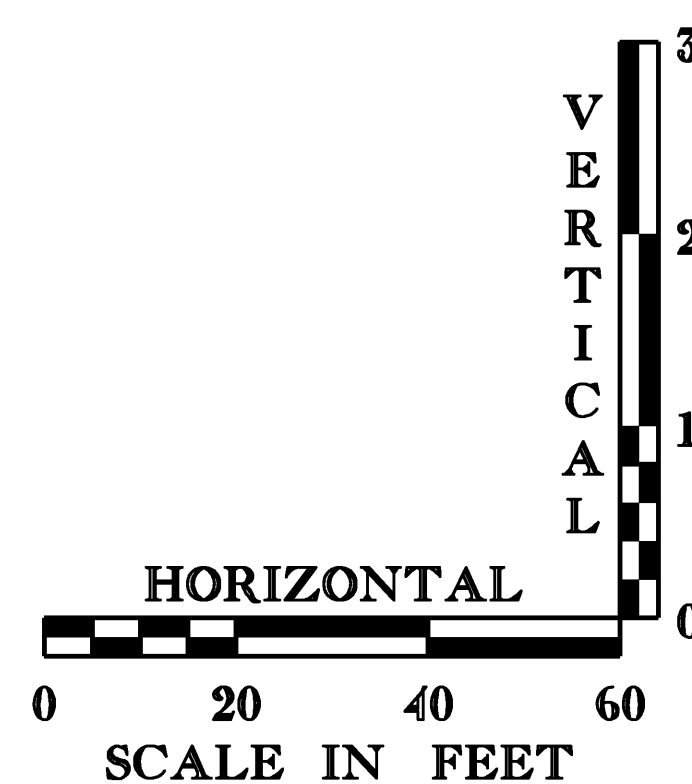

PROJECT: BERLIN	PROJECT NO.: IM 089-1 (20)
DESIGN FILE NAME: s99a270\structures\s99a270pro.dgn	PLOT DATE: 05-DEC-2007
IPARM FILE NAME: s99a270pro1.nb	DRAWN BY: D.D.BEARD
DESIGNED BY: K.M.HIGGINS	CHECKED BY: R.S.YOUNG
SQUAD LEADER: C.P.WILLIAMS	SHEET: 17 OF 104
NORTHBOUND PROFILE 1	