


LAYOUT #1 (I-89 SOUTHBOUND)

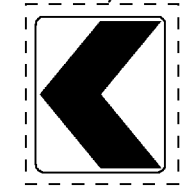

SCALE 1" = 20'-0"
 20 0 20

PROJECT: BERLIN	PROJECT NO. : IM 089-1 (20)
DESIGN FILE NAME: 99a270\structures\99a270bdr.dgn	PLOT DATE: 05-DEC-2007
IPARM FILE NAME: s99a270\1a1 sb.i	DESIGNED BY: K.M.HIGGINS
SQUAD LEADER: C.P.WILLIAMS	DRAWN BY: D.D.BEARD
LAYOUT SOUTHBOUND 1	CHECKED BY: R.S.YOUNG
	SHEET: 19 OF 104