

MM 52.10

MM 52.40

ROW LINE

MATCHLINE

MATCHLINE

BERLIN  
MONTPELLIER

ROW LINE

18" CGMP  
DI

18" CGMP  
DI

18" CGMP

1-2

1-2

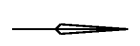
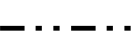
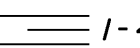

1-2

1-2

1-2

1-2

**LEGEND**

-  RUNOFF FLOW DIRECTION
-  SOIL BOUNDARY
-  SLOPE GRADE
-  EXISTING GUARD RAIL

**EPSC EXISTING CONDITIONS  
SITE PLAN SHEET 1**

PROJECT: BERLIN	PROJECT NO.: IM 089-1 (20)
DESIGN FILE NAME: 99a270\structures\s99a270bdr_ero.dgn	PLOT DATE: 05-DEC-2007
IPARM FILE NAME: s99a270excon1.i	DRAWN BY: M.FESSEL
DESIGNED BY: G.SPILAK	CHECKED BY: K.M.HIGGINS
SQUAD LEADER: C.P.WILLIAMS	SHEET: 67 OF 104
EPSC EXISTING CONDITIONS - 1	

