

MM 52.10

MM 52.40


MATCHLINE

MATCHLINE

BERLIN  
MONTPELIER

LEGEND			
	DETOUR		RUNOFF FLOW DIRECTION
	EROSION MATTING		TEMPORARY TRAFFIC BARRIER
	INLET PROTECTION DEVICE		RIPRAP OUTLET PROTECTION
	TRAFFIC DIRECTION		
	PROJECT DEMARCATION FENCE		

**EROSION PREVENTION & SEDIMENT CONTROL  
BRIDGE 40S CONSTRUCTION - SHEET 1**

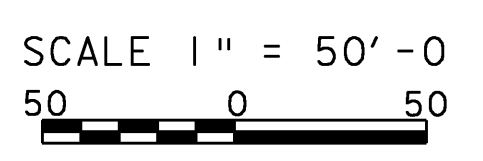

PROJECT: BERLIN	PROJECT NO.: IM 089-1 (20)
DESIGN FILE NAME: 99a270\structures\s99a270bdr_ero.dgn	PLOT DATE: 05-DEC-2007
IPARM FILE NAME: s99a270epscl.i	DRAWN BY: M.FESSEL
DESIGNED BY: G.SPILAK	CHECKED BY: K.M.HIGGINS
SQUAD LEADER: C.P.WILLIAMS	SHEET: 73 OF 104
EPSC PLAN SOUTHBOUND - 1	