

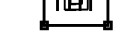
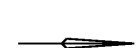



**LEGEND**

-  DETOUR
-  EROSION MATTING
-  INLET PROTECTION DEVICE, TYPE I
-  TRAFFIC DIRECTION
-  PROJECT DEMARCATION FENCE
-  RUNOFF FLOW DIRECTION
-  RIPRAP OUTLET PROTECTION
-  TEMPORARY TRAFFIC BARRIER

**EROSION PREVENTION & SEDIMENT CONTROL  
BRIDGE 405 CONSTRUCTION - SHEET 3**

PROJECT: BERLIN	PROJECT NO.: IM 089-1 (20)
DESIGN FILE NAME: s99a270\structures\s99a270bdr_ero.dgn	PLOT DATE: 05-DEC-2007
IPARM FILE NAME: s99a270epsccb3.i	DESIGNED BY: G. SPILAK
SQUAD LEADER: C.P. WILLIAMS	DRAWN BY: M. FESSEL
EPSC PLAN SOUTHBOUND - 3	CHECKED BY: K.M. HIGGINS
	SHEET: 75 OF 104

SCALE 1" = 50'-0"  
50 0 50