

MM 52.10

MM 52.40

ROW LINE

MATCHLINE

MATCHLINE

BERLIN
MONTPELIER

LOCATION OF
PROPOSED U-TURN &
NEW CULVERT

I-89 SB
TO WHITE RIVER JCT.

I-89 NB
TO MONTPELIER

18" CGMP
DI

18" CGMP
DI

18" CGMP

1-2

1-2

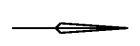
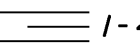

1-2

1-2

1-2

ROW LINE

LEGEND

-  RUNOFF FLOW DIRECTION
-  SLOPE GRADE
-  SEED AND MULCH

SCALE 1" = 50'-0"
50 0 50

**EPSC FINAL CONDITIONS
SITE PLAN SHEET 1**

PROJECT: BERLIN	PROJECT NO.: IM 089-1 (20)
DESIGN FILE NAME: 99a270\structures\s99a270bdr_ero.dgn	PLOT DATE: 05-DEC-2007
IPARM FILE NAME: s99a270finconl.i	DRAWN BY: M.FESSEL
DESIGNED BY: G.SPILAK	CHECKED BY: K.M.HIGGINS
SQUAD LEADER: C.P.WILLIAMS	SHEET: 76 OF 104
EPSC FINAL CONDITIONS - 1	