

**PLAN**  
SCALE 1/4" = 30 FT.

NOTE: N.B. Stationing is offset radially from Base Line

S.A. Spiral Curve Data		S.B. Spiral Curve Data	
$\Delta = 57^{\circ}56'$ L.P.	$\Delta = 59^{\circ}50'$ L.P.	$\Delta = 57^{\circ}56'$ L.P.	$\Delta = 59^{\circ}50'$ L.P.
$D_c = 3^{\circ}30'$	$D_c = 3^{\circ}30'$	$D_c = 3^{\circ}30'$	$D_c = 3^{\circ}30'$
$R_c = 1637.02'$	$R_c = 1637.02'$	$R_c = 1637.02'$	$R_c = 1637.02'$
$B_s = 7^{\circ}00'$	$B_s = 7^{\circ}00'$	$B_s = 7^{\circ}00'$	$B_s = 7^{\circ}00'$
$\Delta_c = 43^{\circ}56'$	$\Delta_c = 45^{\circ}50'$	$\Delta_c = 43^{\circ}56'$	$\Delta_c = 45^{\circ}50'$
$E_s = 238.72'$	$E_s = 256.36'$	$E_s = 238.72'$	$E_s = 256.36'$
Bank = 15%/ft.	Bank = 15%/ft.	Bank = 15%/ft.	Bank = 15%/ft.

**GENERAL NOTES**

- For additional General Notes see Std. Sh. SCB-D1-67.
- Elevation Datum is sea level based on nearest U.S. Government vertical control.
- All Piling shall be steel 12BP53. Piling for Abut. #2 shall be driven to point bearing on ledge. Piling for all other substructure units shall be driven to such depth as is determined by Pile Loading Tests to be required to develop bearing of 45 tons per pile, except that all Piles shall penetrate 10 Ft. minimum into existing ground regardless of bearing capacity.
- Where bottom of Footing elevation is above old ground, Fill is to be placed 0.5 feet above bottom of Footing elevation before Piles are driven. Excavation of this material to bottom of Footing elevation after piles are driven shall be paid for as Structure Excavation, Item 109.
- Superstructure and Pier Column and Cap concrete shall be Class AA, Mod. All other concrete shall be Class B, Mod.
- Bridge railing is to be as detailed on Std. Sheet SB-R1-64, Sh. 1 of 2 of 2, or SB-R2-65. Post spacing shall not exceed maximum shown on Standards.
- Wing Wall sections are not to be placed above adjacent bridge seat elevation until beams have been profiled and final grade determined by the Engineer.
- Water Repellent, Item 440, shall be used as follows:  
Abutments & Wings - All exposed surfaces not otherwise treated.  
Piers - Columns above grade; sides, ends, and bottoms of Pier Caps  
Superstructure - Top of concrete curb, fascia, and bottom of deck from fascia to exterior beam.
- For details of construction joints see Std. SCB-D6-67, Det. B.
- Scuppers are to be placed as detailed on BR. 413.
- All bridge geometry at Abutments #2 and #4 bridge ends is based on an extension of the S.B. and Base Line curves beyond the C.S. rather than on the true spiral  $\phi$ .

**LIST OF BRIDGE SHEETS**

- BR. 400 Plan and Elevation
- 401 Quantity Sheet
- 402 Preliminary Information
- 403-405 Borings
- 406 Typical Section of Curb and Railing Plan.
- 407, 408 S.B. Framing Plans
- 409, 410 N.B. Framing Plans
- 411 Girder and Bracing Details
- 412, 413 Expansion Dam and Drainage Details
- 414 Bearing Devices and Girder Gumpers
- 415-418 Abutments #1 thru #4
- 419-422 Piers #1 thru #4
- 423 Approach Slabs
- BR. 424-427 Reinforcing Schedules


**ROADWAY REFERENCE SHEETS**

- I 89 Profile Sheet Sta. 185+0 - 201+0
- I 89 Plan Sheet Sta. 185+0 - 201+0
- I 89 Base Line Sections Sta. 190+50 - 196+0
- I 89 Southbound Sections Sta. 190+50 - 196+0
- Rte. #12 Sections Sta. 49+50 - 56+50

**STANDARD SHEETS**

- SCB-D1-67 1-24-68
- SCB-D6-67, Det. A, B, F 1-24-68
- SB-R1-64 Sh. 1 of 2 11-31-68R
- SB-R1-64 Sh. 2 of 2 11-31-68R
- SB-R2-65 11-3-66R

Note: All 12BP53 Steel Piles are to be driven to a 45 ton bearing capacity. (See Note #3)

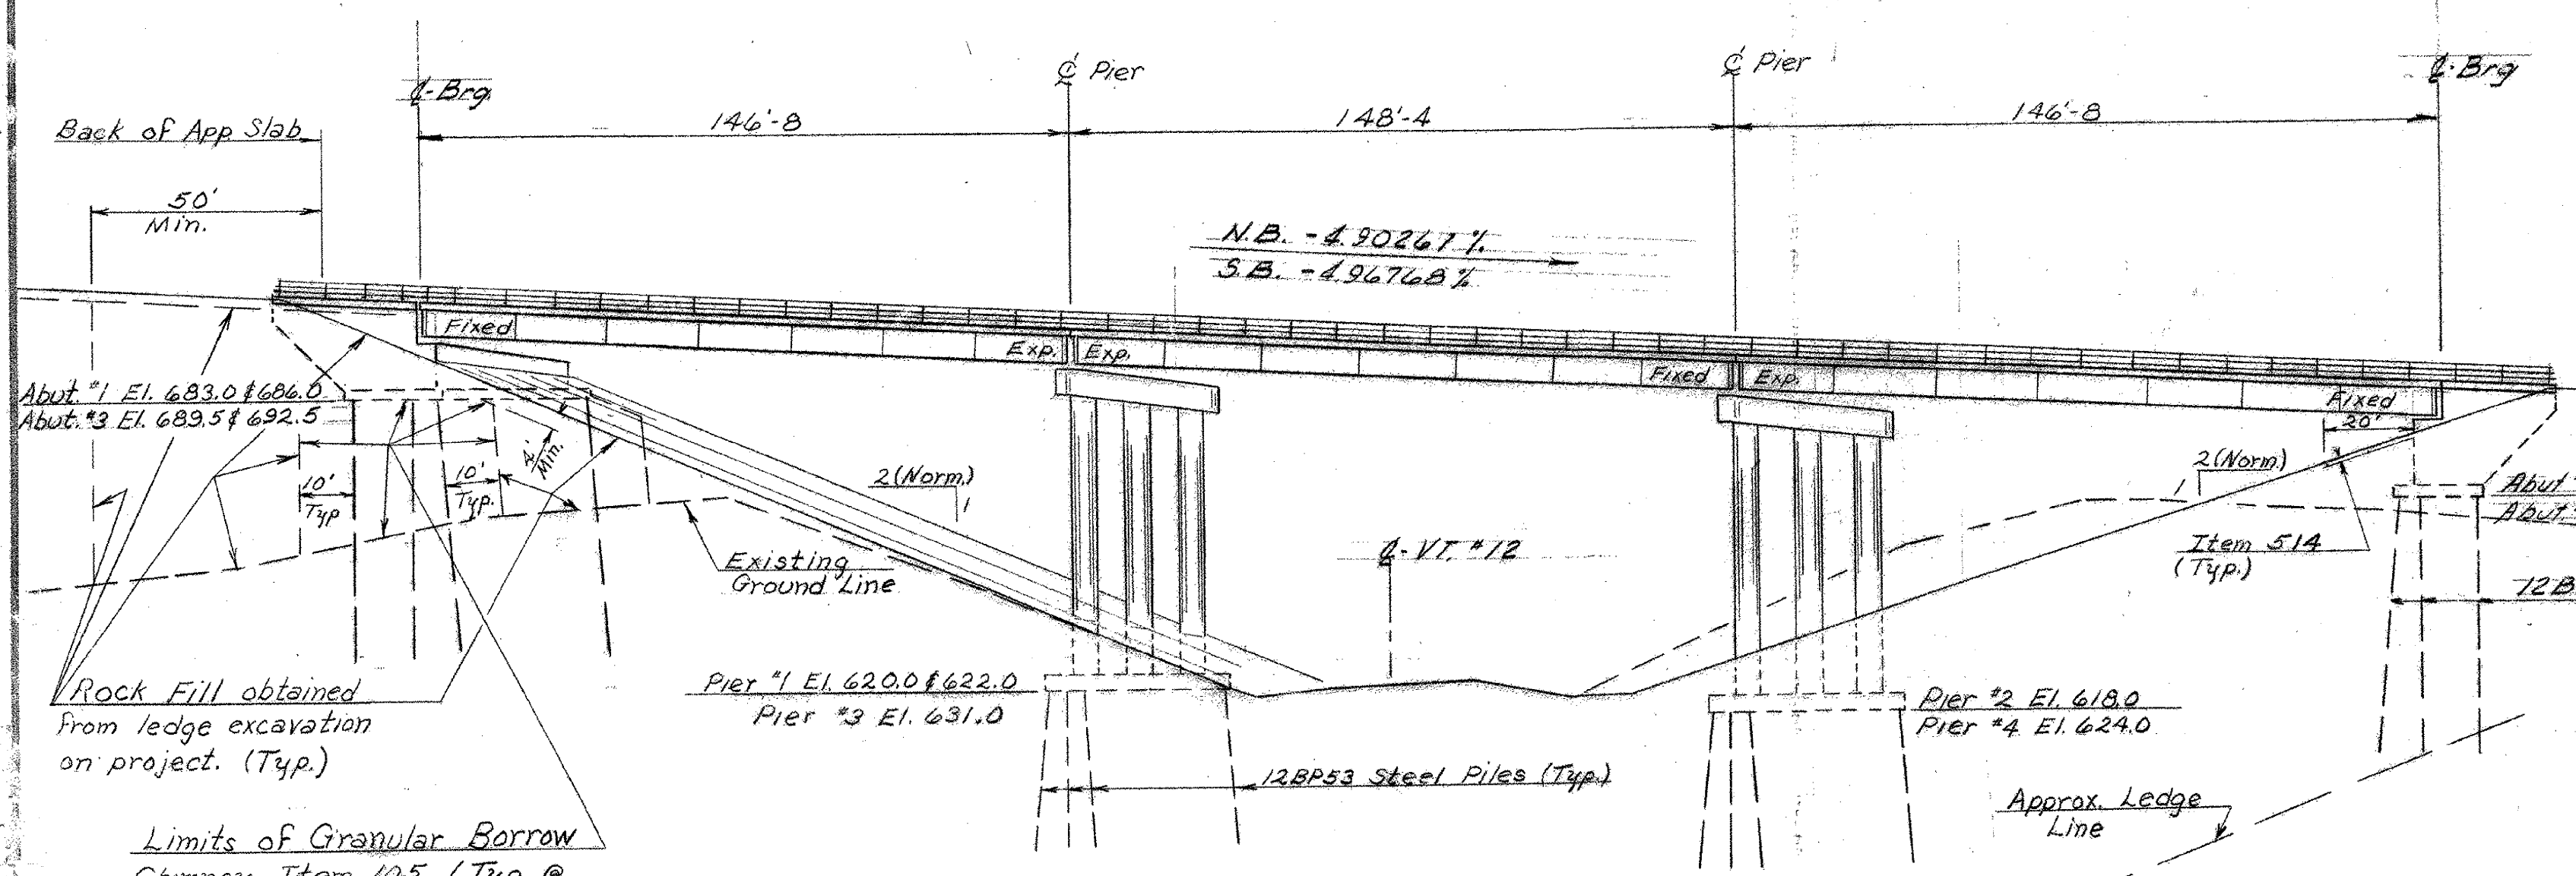

**ELEVATION - N.B. FASCIA**  
SCALE 1/4" = 30 FT.

Limits of Granular Borrow Chimney, Item 105 (Typ. @ All Abutments.) See I 89 Sections For Additional Details.

THIS SHEET FOR REFERENCE ONLY  
BERLIN 1M 089-1(20)  
BRIDGES 40 N&S  
SHEET 81 OF 104

**STATE OF VERMONT**  
DEPARTMENT OF HIGHWAYS

PROJECT: - BERLIN - MONTPELIER  
TOWNS OF BERLIN & MONTPELIER

ROUTE No. I-89 STA. 195+50  
I-89 OVER VT. RTE. 12

**PLAN AND ELEVATION**

SCALE AS SHOWN  
IN CHARGE W. Smith  
DRAWN BY P. Doherty CHECKED BY F. Gilman  
S.W. Tripp W. Wilkins  
PROJECT No. I-89-1(12)  
SHEET 151 OF 197 BR. 400