


MONDO POLYMER TECHNOLOGIES
 RECYCLED POLYMER OFFSET BLOCK
 STEEL POST THRI BEAM MODEL TB21SH
 P.O. BOX 250 BEND, OH 45773
 DOCUMENT # 600.008

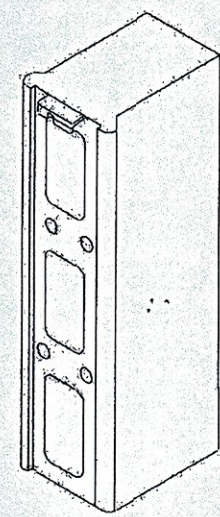

RECEIVED
 OK'D BY SS OK'D BY R
 SEP 16 2008
 RESUBMIT _____ APPROVED _____
 BY CPW DATE 9/16/08

All tolerances +/- 1/4" unless otherwise noted