

# STATE OF VERMONT AGENCY OF TRANSPORTATION




## PROPOSED IMPROVEMENT BRIDGE PROJECT

TOWN OF BERLIN  
COUNTY OF WASHINGTON  
ROUTE NO.: INTERSTATE 89, BRIDGE 40 N & 40 S

PROJECT LOCATION: IN BERLIN ON INTERSTATE 89 NEAR MILE MARKER 52.5


PROJECT DESCRIPTION: REMOVAL AND REPLACEMENT OF THE BRIDGE DECK  
AND PORTIONS OF THE SUBSTRUCTURE.  
PAINT THE STRUCTURAL STEEL.

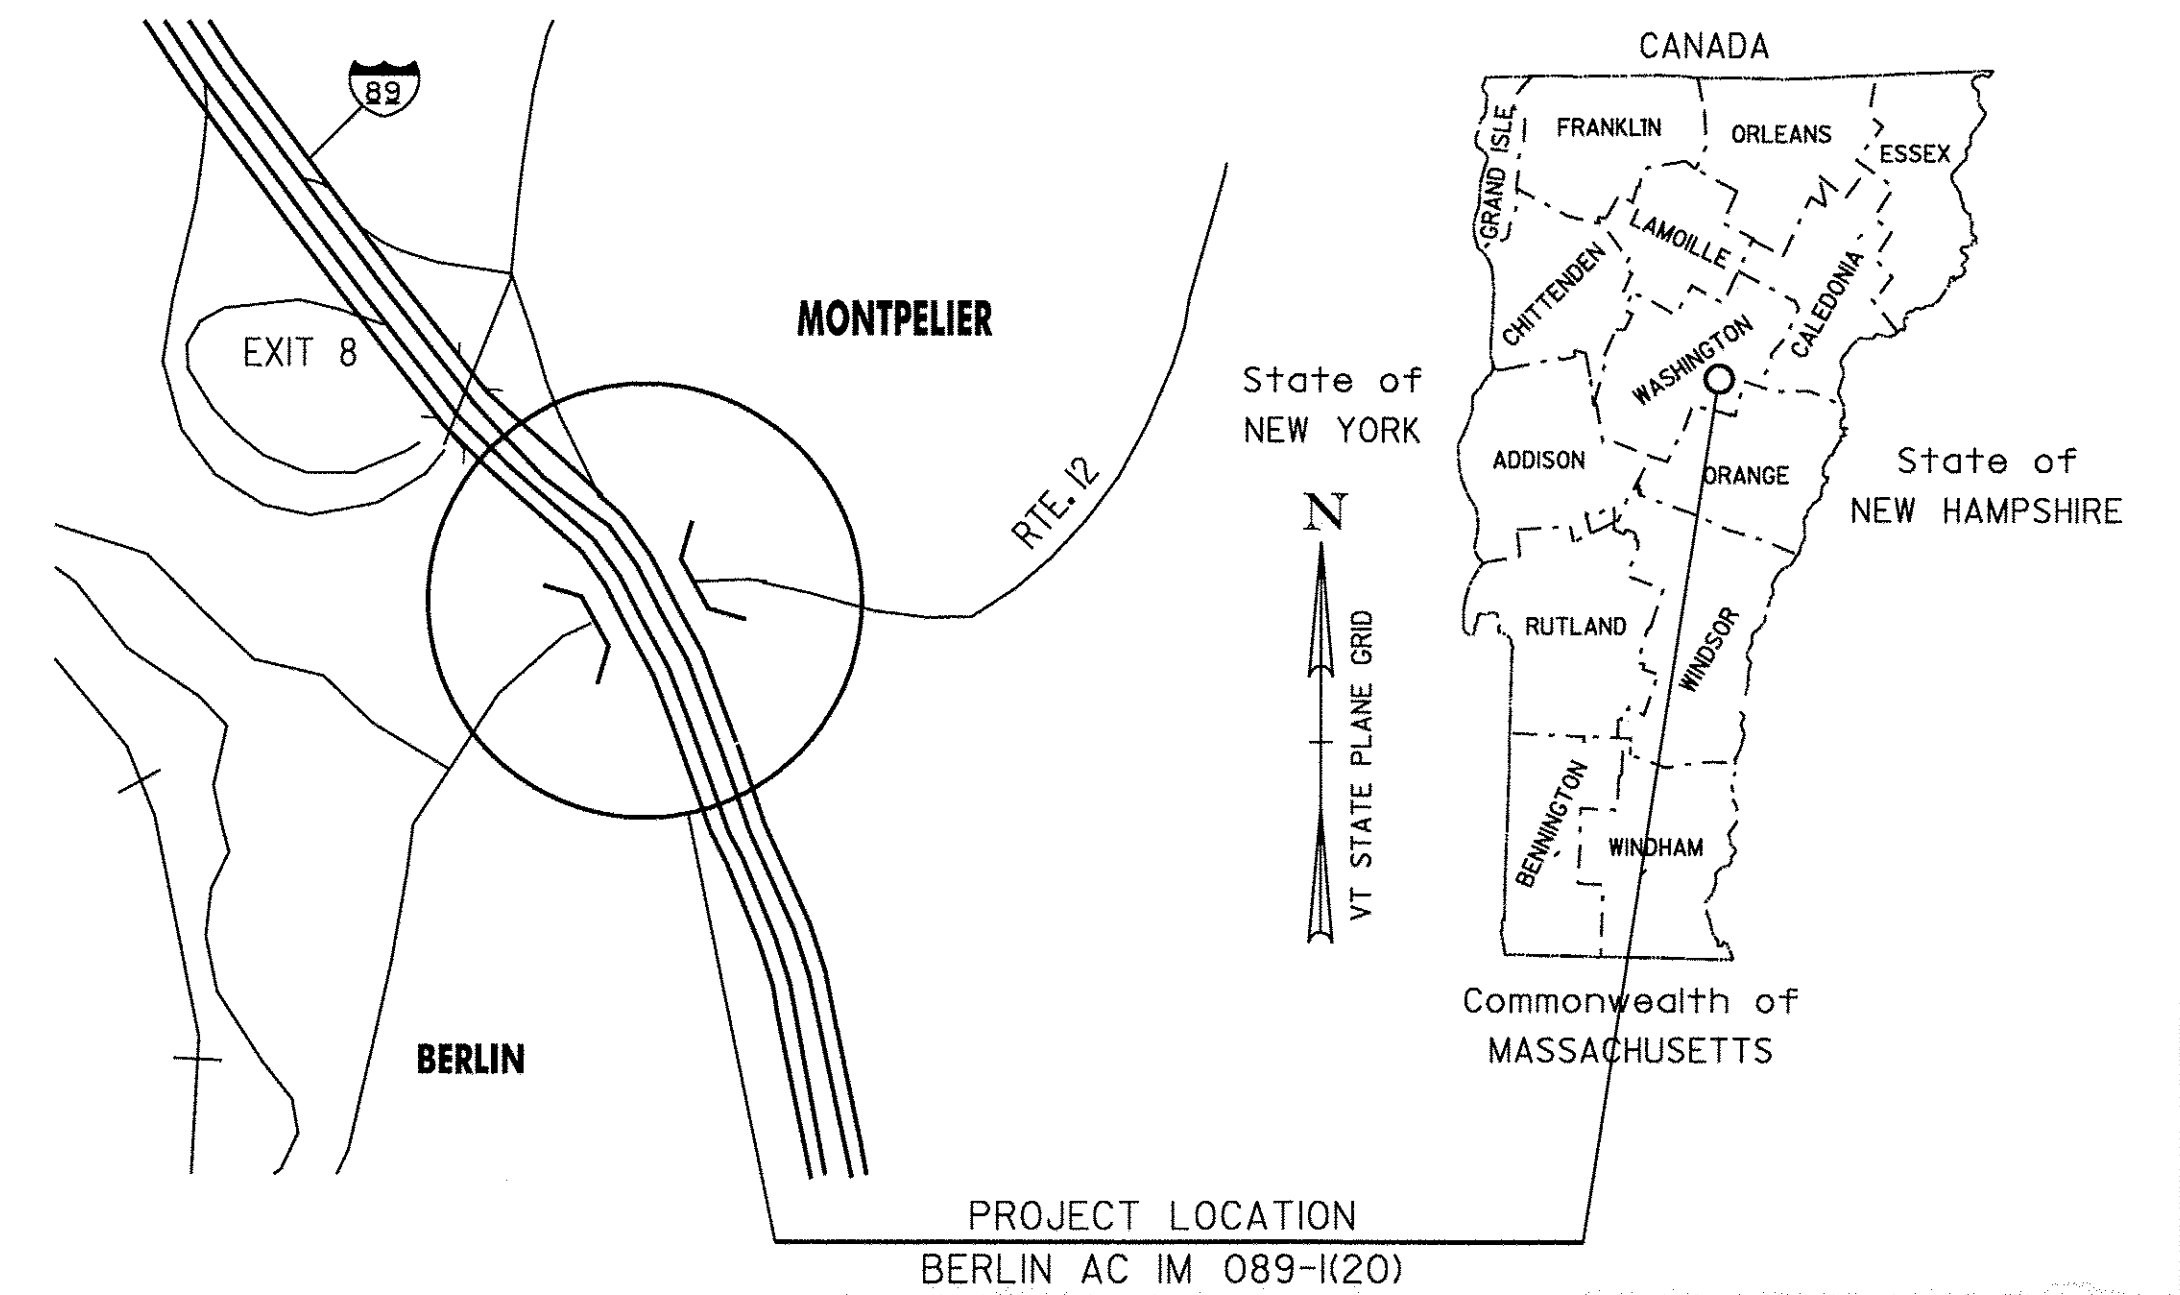

RECORD PLANS	
CONTRACTOR:	BECK & BELLUCCI INC. - FRANKLIN, NH
RESIDENT ENGINEER:	RICK HALE
CONSTRUCTION BEGAN:	APRIL 11, 2008
CONSTRUCTION COMPLETE:	APRIL 15, 2010
RECORD PLANS BY:	RICK HALE & AMOS KEMPTON
I HEREBY CERTIFY THAT ALL THE CONSTRUCTION REQUIRED BY THIS SET OF DRAWINGS HAS BEEN ACCOMPLISHED AS INDICATED HEREIN.	
BY	<i>Rick Hale</i> RESIDENT ENGINEER
DATE	11/3/11
NOTE: Any further information concerning final quantities, amounts or other details relative to this project may be found at Central Files in the electronic archives.	

BRIDGE 40S:  
 LENGTH OF STRUCTURE = 449.39 FEET  
 LENGTH OF ROADWAY = 100.61 FEET  
 LENGTH OF PROJECT = 550.00 FEET

BRIDGE 40N:  
 LENGTH OF STRUCTURE = 449.39 FEET  
 LENGTH OF ROADWAY = 100.61 FEET  
 LENGTH OF PROJECT = 550.00 FEET

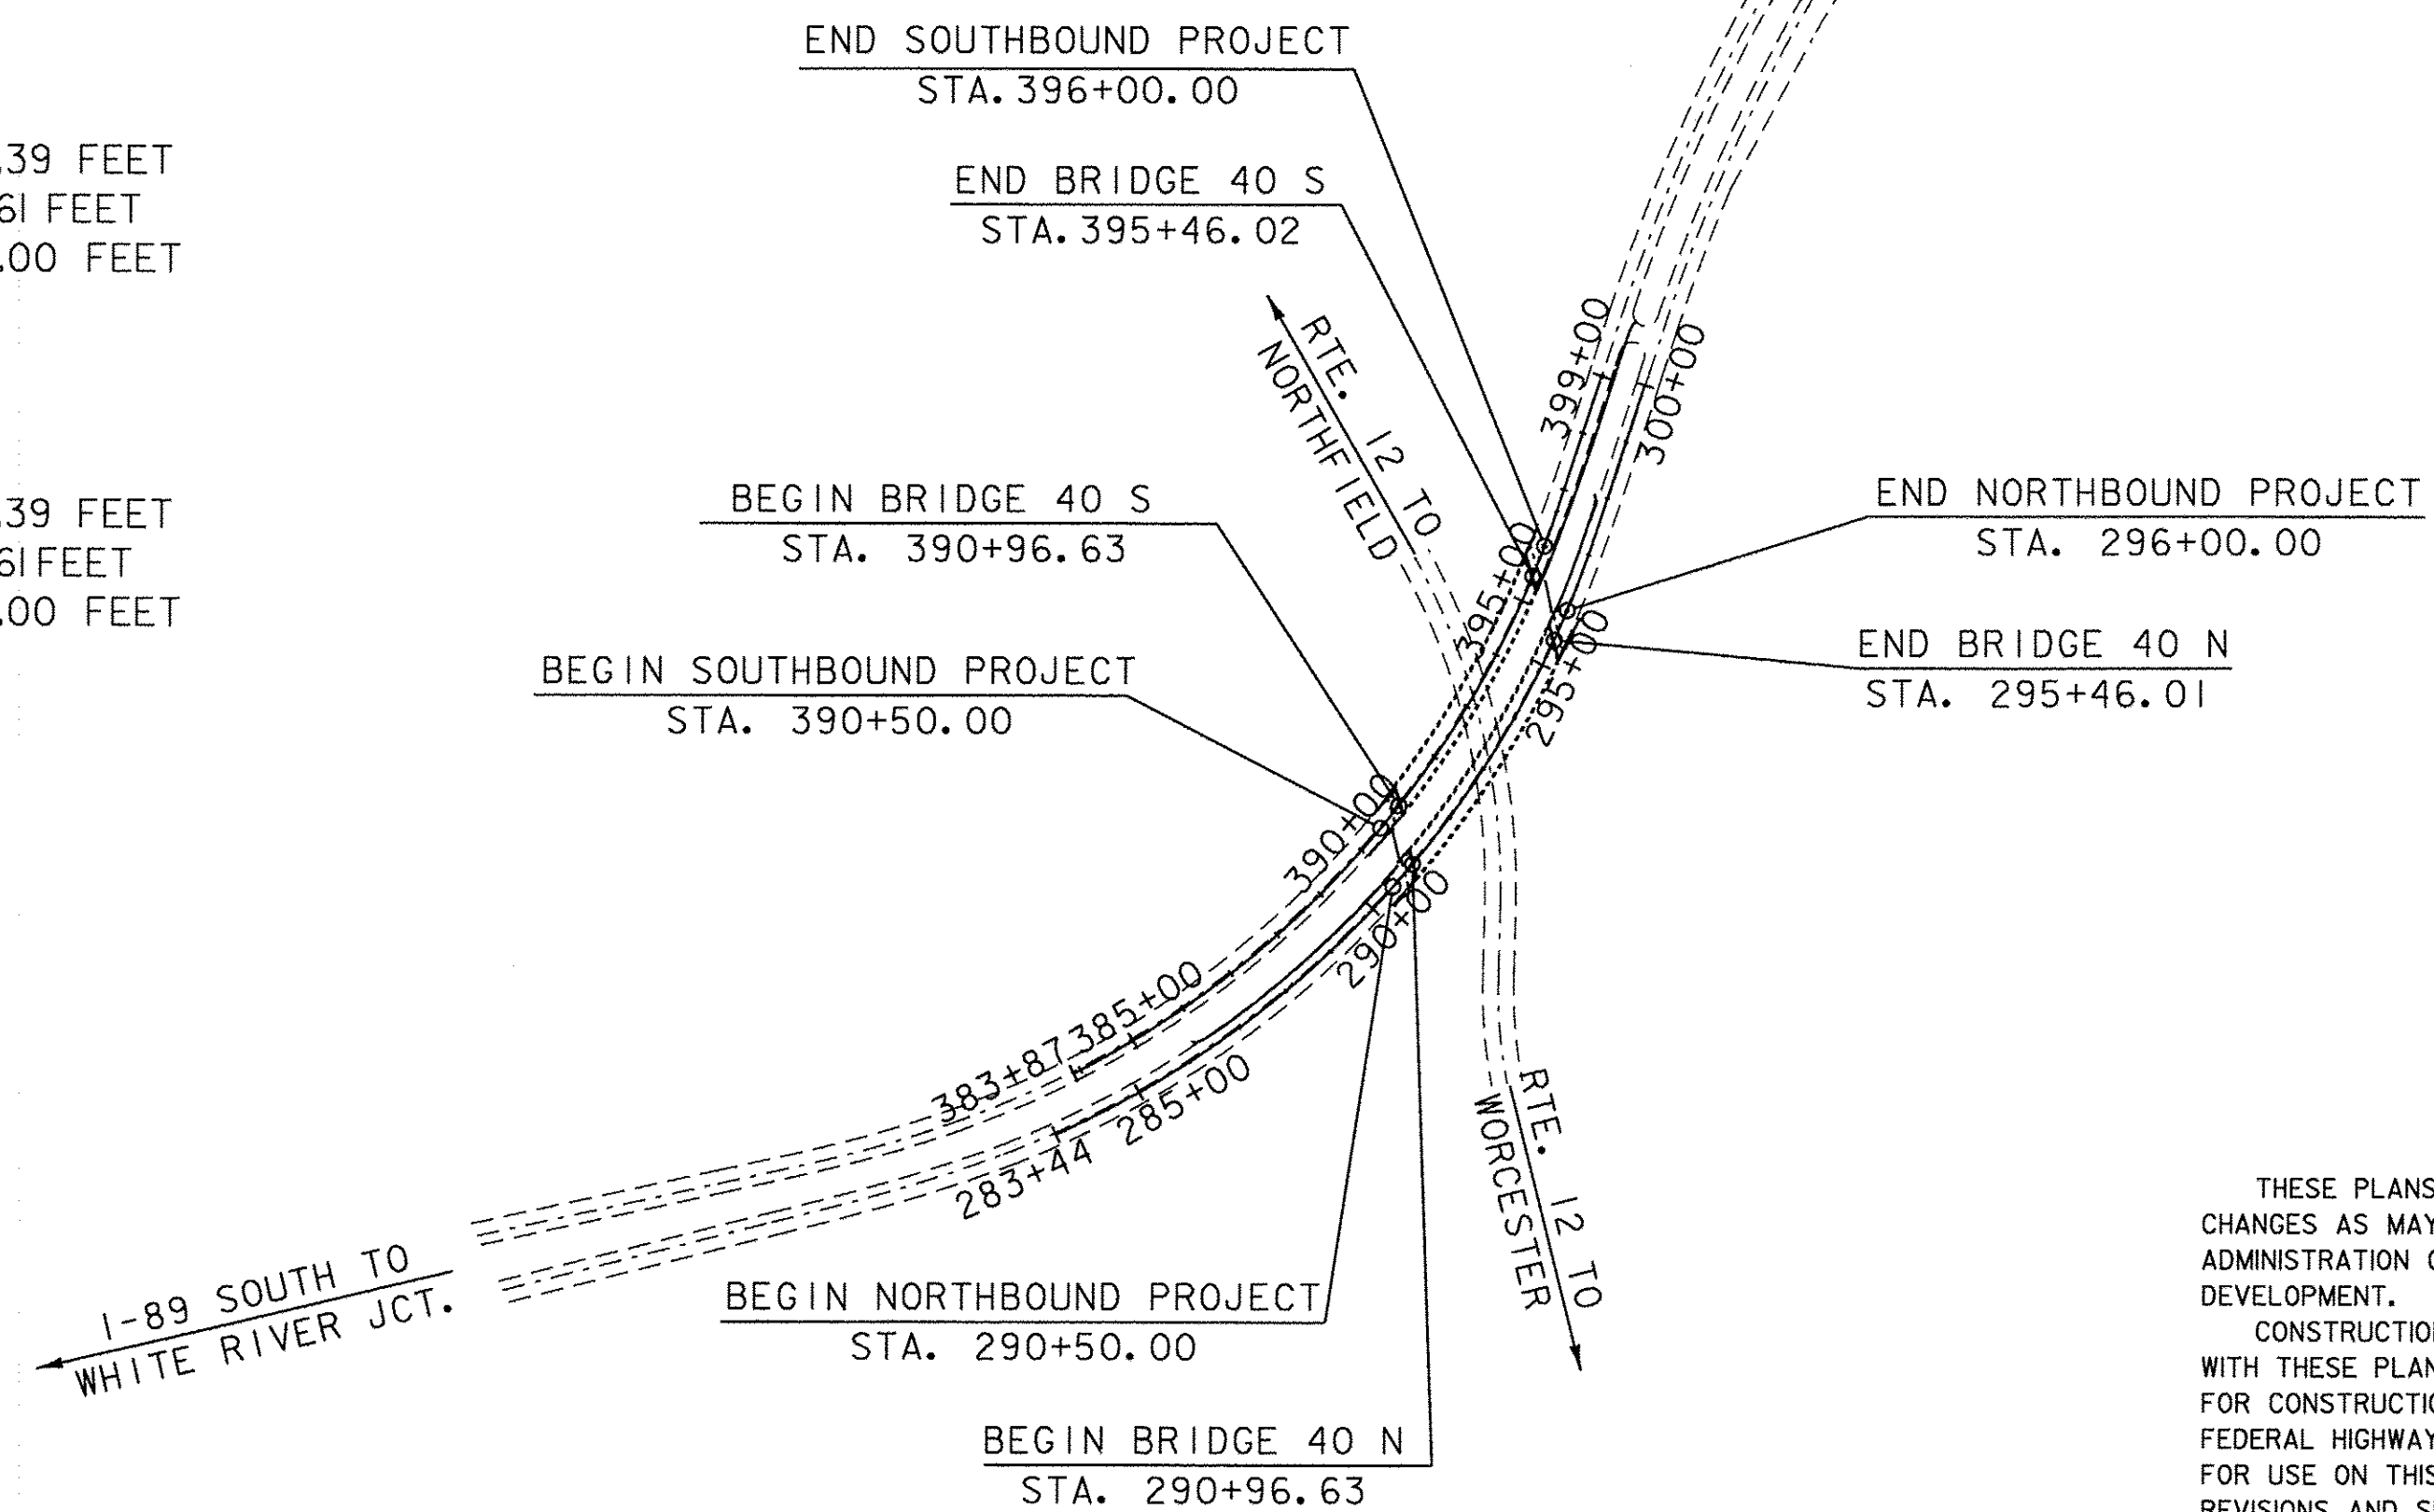

SCALE 1" = 300'-0"  
 300 0 300

CONVENTIONAL SYMBOLS	
COUNTY LINE	
TOWN LINE	
LIMITS OF ACCESS	
POINT OF ACCESS	
FENCE LINE	
STONE WALL	
TRAVELED WAY	
GUARDED RAIL	
RAILROAD	
SURVEY LINE	
CULVERT	
POWER POLE	
TELEPHONE POLE	
TREES	
CONTROL OF ACCESS	
PROPERTY LINE	
R.O.W. TAKING LINE	
SLOPE RIGHTS	
TOP OF CUT	
TOE OF SLOPE	

SURVEYED BY :	R. GILMAN
SURVEYED DATE :	12-02-2001
DATUM	
VERTICAL	NAVD 88
HORIZONTAL	NAD - 83 (96)

THESE PLANS ARE SUBJECT TO SUCH ENGINEERING CHANGES AS MAY BE REQUIRED BY THE FEDERAL HIGHWAY ADMINISTRATION OR THE DIRECTOR OF PROGRAM DEVELOPMENT.  
 CONSTRUCTION IS TO BE CARRIED ON IN ACCORDANCE WITH THESE PLANS AND THE STANDARD SPECIFICATIONS FOR CONSTRUCTION DATED 2006, AS APPROVED BY THE FEDERAL HIGHWAY ADMINISTRATION ON JUNE 15, 2006 FOR USE ON THIS PROJECT, INCLUDING ALL SUBSEQUENT REVISIONS AND SUCH REVISED SPECIFICATIONS AND SPECIAL PROVISIONS AS ARE INCORPORATED IN THESE PLANS.

DEPARTMENT OF TRANSPORTATION FEDERAL HIGHWAY ADMINISTRATOR	
APPROVED <i>Toel Kunkel</i>	DATE 12-21-07
DIRECTOR OF PROGRAM DEVELOPMENT	
APPROVED <i>Paul Johnson</i>	DATE 12/4/07
PROJECT MANAGER : C. P. WILLIAMS	
PROJECT NAME :	BERLIN
PROJECT NUMBER :	AC IM 089 - I (20)
SHEET 1 OF 104 SHEETS	

**INDEX OF SHEETS**

- 1. TITLE SHEET
- 2. PI SHEET
- 3.-7. QUANTITY SHEETS
- 8. PAY LIMITS AND SUBBASE TAPER
- 9. EXISTING TYPICAL SECTIONS
- 10. GENERAL NOTES AND NEW U-TURN
- 11. U-TURN & RUMBLE STRIP DETAILS
- 12.-13. SURVEY TIE SHEETS
- 14.-16. LAYOUT (NORTHBOUND)
- 17.-18. NORTHBOUND PROFILES
- 19.-21. LAYOUT (SOUTHBOUND)
- 22.-23. SOUTHBOUND PROFILES
- 24. TRAFFIC CONTROL NOTES SHEET
- 25. BRIDGE TRAFFIC CONTROL DETAILS
- 26. TEMPORARY PAVEMENT MARKINGS
- 27.-34. NORTHBOUND CLOSURE TRAFFIC CONTROL SHEETS
- 35.-42. SOUTHBOUND CLOSURE TRAFFIC CONTROL SHEETS
- 43. BRIDGE TYPICAL SECTION
- 44. DECK REINFORCING PLAN
- 45.-46. APPROACH SLAB DETAILS
- 47. EXPANSION JOINT DETAILS
- 48.-51. EXPANSION JOINT PLANS
- 52. DRAINAGE DETAILS
- 53.-59. ABUTMENT DETAILS
- 60. BRIDGE RAIL DETAILS
- 61. RAIL TRANSITION DETAILS
- 62. BRIDGE MOUNTED SIGN DETAILS
- 63. TRAFFIC SIGN SUMMARY SHEET
- 64.-65. REINFORCING STEEL SCHEDULE
- 66. EROSION CONTROL NARRATIVE
- 67.-78. EROSION CONTROL PLANS
- 79.-80. EROSION CONTROL DETAILS
- 81.-104. REFERENCE PLANS FROM BERLIN-MONTPELIER 1-89-1 (12)

**LIST OF STANDARDS:**

E-100	CONSTRUCTION APPROACH SIGNS	01/02/04
E-101	CONSTRUCTION SIGN DETAILS	05/30/03
E-102	CONSTRUCTION SIGN DETAILS	06/30/03
E-102A	CONSTRUCTION SIGN DETAILS	05/01/04
E-103	MAINLINE TRAFFIC CONTROL DIVIDED HIGHWAY ONE LANE CLOSED	03/01/04
E-104	MAINLINE TRAFFIC CONTROL DIVIDED HIGHWAY ONE ROADWAY CLOSED	02/03/99
E-104A	PAVEMENT MARKING DETAILS-DIVIDED HIGHWAY ONE ROADWAY CLOSED	12/27/96
E-106	TRAFFIC CONTROL - MISCELLANEOUS DETAILS	03/01/04
E-107	DELINEATION, BARRICADES AND DETOURS FOR U-TURNS ON DIVIDED HIGHWAYS	06/30/03
E-107A	BREAKAWAY BARRICADE DETAILS	08/08/95
E-120	STANDARD SIGN PLACEMENT - EXPRESSWAY & FREEWAY	08/08/95
E-126	TYPICAL FREEWAY INTERCHANGE SIGNING	02/01/00
E-134	BRIDGE NUMBER PLAQUE	08/08/95
E-135	INTERSTATE ROUTE MARKER SIGN DETAIL	08/18/95
E-142	REGULATORY SIGN DETAILS	09/20/95
E-143	REGULATORY SIGN DETAILS	06/15/04
E-146	REGULATORY SIGN DETAILS	09/20/95
E-150	WARNING SIGN DETAILS	05/01/04
E-151	WARNING SIGN DETAILS	05/01/04
E-152	WARNING SIGN DETAILS	05/01/04
E-155	WARNING SIGN DETAILS	05/01/04
E-160	FLANGED CHANNEL STEEL SIGN POST	05/20/99
E-164	SQUARE STEEL SIGN POST	05/20/99
E-191	PAVEMENT MARKING DETAILS	02/01/99
E-192	PAVEMENT MARKING DETAILS	10/12/00
E-193	PAVEMENT MARKING DETAILS	08/18/95
E-197	DELINEATOR PLACEMENT TYPICAL	04/01/05

**LIST OF STANDARDS (CONTINUED):**

E-198	DELINEATORS AND MILEPOSTS	04/01/05
G-1	STEEL BEAM GUARDRAIL (50 MPH & OVER) HEAVY DUTY STEEL BEAM RAIL TWISTED END TERMINAL	01/03/00
G-1D	ANCHOR FOR STEEL BEAM RAIL STEEL BEAM GUARDRAIL (40 MPH & LESS) HEAVY DUTY STEEL BEAM RAIL STEEL BEAM MEDIAN BARRIER	01/03/00
G-19	ANCHOR FOR STEEL BEAM RAIL GENERIC GRADING PLANS FOR GUARDRAIL END TERMINALS	11/15/02

**DESIGN CRITERIA:**

- 1. DESIGN LIVE LOAD AASHTO HS-25
- 2. DESIGN SPAN N/A -  $\bar{C}$  TO  $\bar{C}$  GIRDER SPACING IS 7'-6"
- 3. ALLOWABLE LOAD FOR SPREAD FOOTINGS ON SOIL N/A  
ON LEDGE N/A
- 4. ALLOWABLE LOAD FOR PILING N/A  
TYPE N/A  
ESTIMATED LENGTH N/A
- 5. STRUCTURAL STEEL N/A
- 6. REINFORCING STEEL GRADE 60
- 7. SPECIAL PROVISION (CONCRETE, HIGH PERFORMANCE CLASS A LOW CEMENT)  $f'_c$  4000 psi  
CONCRETE, HIGH PERFORMANCE CLASS B  $f'_c$  3500 psi

**TRAFFIC MAINTENANCE:**

- 1. IS TRAFFIC TO BE MAINTAINED? YES  
IF YES, ON EXISTING STRUCTURE? YES  
OR ON TEMPORARY BRIDGE? EXISTING STRUCTURE  
ONE OR TWO-WAY TRAVEL? TWO-WAY
- 2. TRAFFIC CONTROL SIGNALS REQUIRED? NO
- 3. ARE SIDEWALKS REQUIRED? NO  
IF SO, ON WHAT SIDE? \_\_\_\_\_

**LFD LOAD RATING (TONS)**

LOADING LEVELS	TRUCK						
	H	HS	3S2	6 AXLE	3A. STR.	4A. STR.	5A. SEMI
INVENTORY	45	81					
POSTED	63	114	124		109	110	119
OPERATING		136	148	161	130	131	

COMMENTS:

STRENGTH RF =  $\frac{0.85 M_N - 1.3 M_{DL}}{A \times M_{LL+1}}$  SERVICEABILITY RF =  $B \left[ \frac{0.95 F_y S_{LL+1} - M_{DL} \frac{S_{LL+1}}{S_{DL}} - M_{SDL} \frac{S_{LL+1}}{S_{SDL}}}{1.67 M_{LL+1}} \right]$

**TRAFFIC DATA**


YEAR	ADT	DHV	% D	% T	ADTT
2008 NE	11100	1300	0	13	1700
2028 NE	14700	1800	0	22	4000

20 year ESAL for flexible pavement N/A  
40 year ESAL for flexible pavement N/A  
Design speed: 70 mph

PROJECT:	<b>BERLIN</b>	PROJECT NO.:	<b>IM 089-1 (20)</b>
----------	---------------	--------------	----------------------

DESIGN FILE NAME: s99a270\structures\s99a270pi.dgn  
IPARM FILE NAME: s99a270pi.i  
DESIGNED BY: G. SPILAK  
SQUAD LEADER: C. P. WILLIAMS  
PRELIMINARY INFORMATION SHEET

PLOT DATE: 05-DEC-2007  
DRAWN BY: E. L. RUSTAY  
CHECKED BY: R. S. YOUNG  
SHEET: 2 OF 104

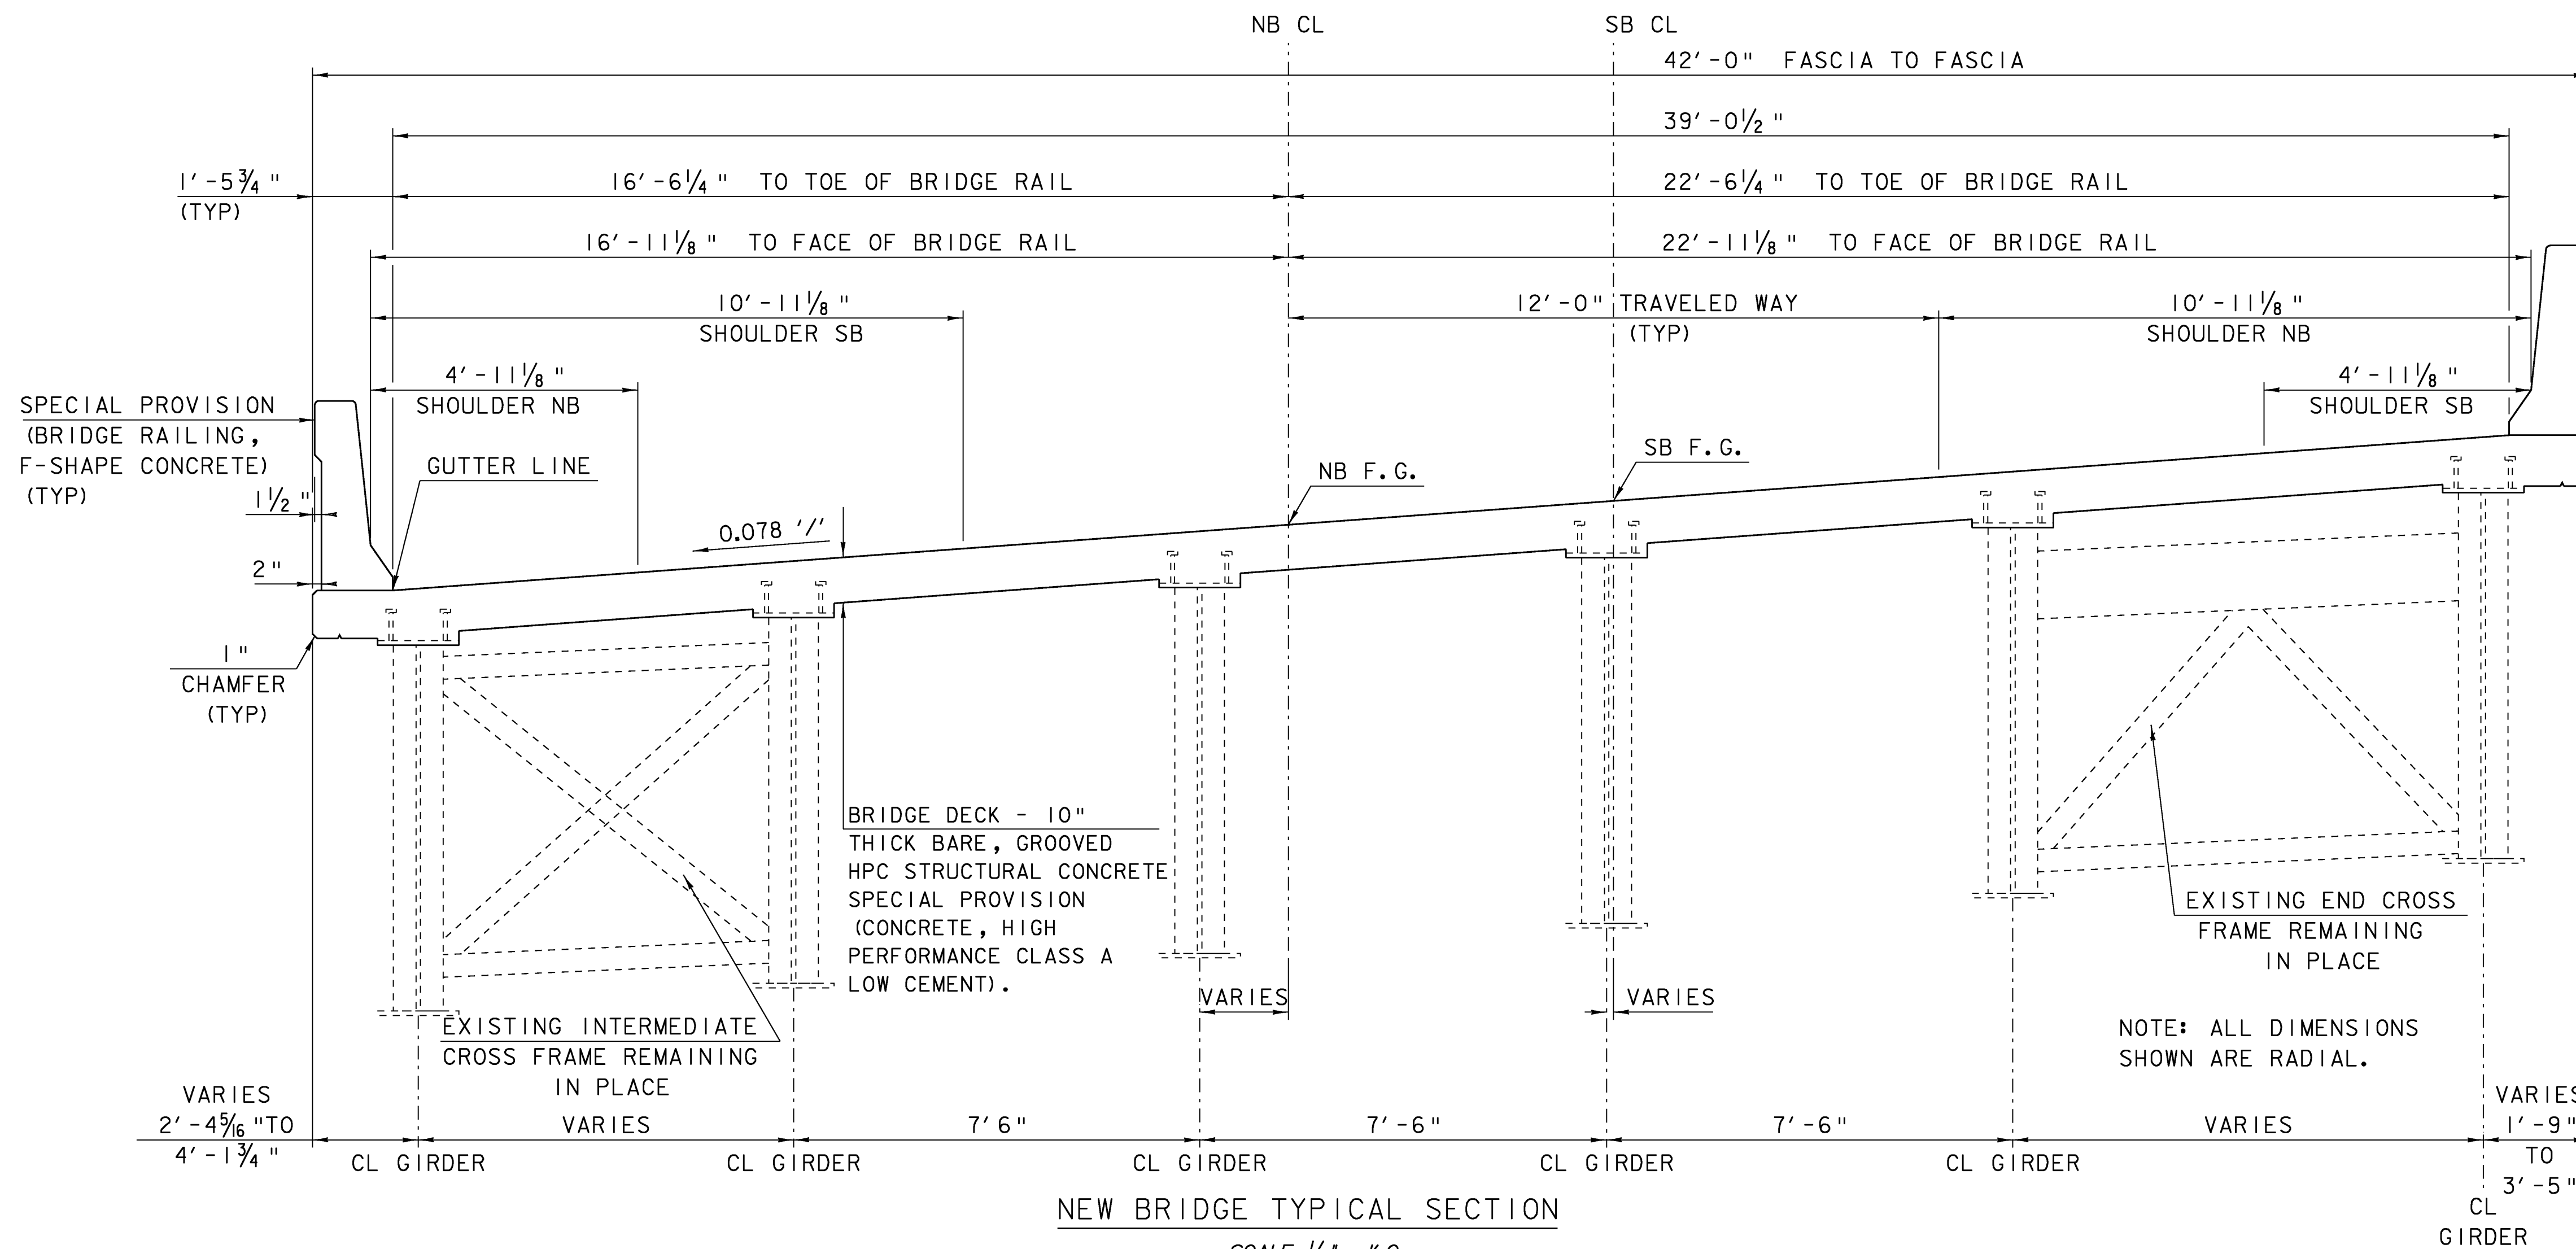

# QUANTITY SHEET 1

SUMMARY OF ESTIMATED QUANTITIES										TOTALS		DESCRIPTIONS				DETAILED SUMMARY OF QUANTITIES		
ROADWAY	TRAINING	EROSION CONTROL	BRIDGE 40 N	BRIDGE 40 S	ALTERNATE A (BRIDGE 40 N)	ALTERNATE B (BRIDGE 40 N)	ALTERNATE A (BRIDGE 40 S)	ALTERNATE B (BRIDGE 40 S)	FULL C.E ITEMS	GRAND TOTAL	FINAL	UNIT	ITEMS	ITEM NUMBER	ROUND	QUANTITIES	UNIT	ITEMS
1060										1060		CY	COMMON EXCAVATION	203.15				
			65	70						135		CY	STRUCTURE EXCAVATION	204.25				
			65	70						135		CY	GRANULAR BACKFILL FOR STRUCTURES	204.30				
965										965		SY	COLD PLANING, BITUMINOUS PAVEMENT	210.10				
1480										1480		LF	MILLED RUMBLE STRIPS	213.10				
840										840		CY	SUBBASE OF DENSE GRADED CRUSHED STONE	301.35				
985										985		TON	BITUMINOUS CONCRETE PAVEMENT (PG 58-34)	406.25				
			181	180						361		CY	CONCRETE, HIGH PERFORMANCE CLASS B	501.34				
			2	2						4		EACH	SHORING SUPERSTRUCTURE BEARINGS (ABUTMENT)	502.11				
			2	2						4		EACH	SHORING SUPERSTRUCTURE BEARINGS (PIER)	502.11				
			720							720		LB	STRUCTURAL STEEL	506.60				
			8600	8270						16870		LB	REINFORCING STEEL	507.15				
			142.5	145						287.5		LF	DRILLING AND GROUTING DOWELS	507.16				
			172518	174958						347476		LB	EPOXY COATED REINFORCING STEEL	507.17				
			0.5	0.5						1		LS	STRUCTURAL PAINTING, FIELD APPLIED (960 TONS)	513.30				
			0.5	0.5						1		LS	CONTAINMENT & ENVIRONMENTAL PROTECTION, FIELD	513.36				
			0.5	0.5						1		LS	SURFACE PREPARATION, FIELD (960 TONS)	513.41				
			670	670						1340		GAL	WATER REPELLENT, SILANE	514.10				
			110	110						220		LF	BRIDGE EXPANSION JOINT, ASPHALTIC PLUG	516.10				
			108	108						216		LF	BRIDGE EXPANSION JOINT, VERMONT	516.11				
			1875	1885						3760		SY	REMOVAL OF BRIDGE PAVEMENT	529.10				
			2	2						4		EACH	PARTIAL REMOVAL OF STRUCTURE (ABUTMENT)	529.20				
			1	1						2		EACH	PARTIAL REMOVAL OF STRUCTURE (DECK)	529.20				
80										80		LF	18" CPEP(SL)	601.2615				
2										2		EACH	18" CPEPES	601.7015				
3										3		EACH	CHANGING ELEVATION OF DROP INLETS, CATCH BASINS, OR MANHOLES	604.40				
		20								20		HR	ALL PURPOSE EXCAVATOR RENTAL, TYPE I	608.25				
			20	30						50		CY	STONE FILL, TYPE II	613.11				
200										200		LF	WOVEN WIRE FENCE WITH STEEL POSTS	620.25				
200										200		LF	REMOVAL OF EXISTING FENCE	620.55				
1075										1075		LF	HD STEEL BEAM GUARDRAIL, GALVANIZED	621.21				
3										3		EACH	MANUFACTURED TERMINAL SECTION, FLARED	621.50				
2										2		EACH	ANCHOR FOR STEEL BEAM RAIL	621.60				
1270										1270		LF	REMOVAL AND DISPOSAL OF GUARDRAIL	621.80				
6020										6020		LF	TEMPORARY TRAFFIC BARRIER	621.90				
250										250		HR	UNIFORMED TRAFFIC OFFICERS	630.10				
1600										1600		HR	FLAGGERS	630.15				
									1	1		LS	FIELD OFFICE, ENGINEERS	631.10				
									1	1		LS	TESTING EQUIPMENT, CONCRETE	631.16				
									1	1		LS	TESTING EQUIPMENT, BITUMINOUS	631.17				

# QUANTITY SHEET 2

SUMMARY OF ESTIMATED QUANTITIES										TOTALS		DESCRIPTIONS				DETAILED SUMMARY OF QUANTITIES		
ROADWAY	TRAINING	EROSION CONTROL	BRIDGE 40 N	BRIDGE 40 S	ALTERNATE A (BRIDGE 40 N)	ALTERNATE B (BRIDGE 40 N)	ALTERNATE A (BRIDGE 40 S)	ALTERNATE B (BRIDGE 40 S)	FULL C.E. ITEMS	GRAND TOTAL	FINAL	UNIT	ITEMS	ITEM NUMBER	ROUND	QUANTITIES	UNIT	ITEMS
									1	1		LS	TESTING EQUIPMENT, PROTECTIVE COATINGS	631.18				
									1	1		LU	FIELD OFFICE TELEPHONE (N.A.B.I.)	631.25				
	1560									1560		HR	EMPLOYEE TRANEESHIP	634.10				
1										1		LS	MOBILIZATION/DEMobilIZATION	635.11				
			0.5	0.5						1		LS	TRAFFIC CONTROL	641.10				
2										2		EACH	PORTABLE CHANGEABLE MESSAGE SIGN	641.15				
2										2		EACH	PORTABLE ARROW BOARD	641.16				
2600										2600		LF	DURABLE 6 INCH WHITE LINE, THERMOPLASTIC	646.422				
1300										1300		LF	DURABLE 6 INCH YELLOW LINE, THERMOPLASTIC	646.432				
14920										14920		LF	TEMPORARY 6 INCH WHITE LINE, TYPE II TAPE	646.621				
24890										24890		LF	TEMPORARY 6 INCH YELLOW LINE, TYPE II TAPE	646.631				
1999										1999		EACH	RAISED PAVEMENT MARKERS, TYPE II	646.75				
7080										7080		SF	PAVEMENT MARKING MASK	646.86				
		130								130		SY	GEOTEXTILE UNDER STONE FILL	649.31				
		130								130		SY	GEOTEXTILE FOR SILT FENCE	649.51				
		180								180		LB	SEED	651.15				
		180								180		LB	SEED, WINTER RYE	651.17				
		1500								1500		LB	FERTILIZER	651.18				
		6								6		TON	AGRICULTURAL LIMESTONE	651.20				
		13								13		TON	HAYMULCH	651.25				
85										85		CY	TOPSOIL	651.35				
		1								1		LS	EPSC PLAN	652.10				
		150								150		HR	MONITORING EPSC PLAN	652.20				
		1								1		LU	MAINTENANCE OF EPSC PLAN (N.A.B.I.)	652.30				
		1070								1070		SY	TEMPORARY EROSION MATTING	653.20				
		10								10		CY	TEMPORARY STONE CHECK DAM, TYPE I	653.25				
		80								80		CY	VEHICLE TRACKING PAD	653.35				
		9								9		EACH	INLET PROTECTION DEVICE, TYPE I	653.40				
		6200								6200		LF	PROJECT DEMARCATION FENCE	653.55				
88.7										88.7		SF	TRAFFIC SIGNS, TYPE A	675.20				
13										13		LF	FLANGED CHANNEL SIGN POST	675.301				
190										190		LF	SQUARE TUBE SIGN POST AND ANCHOR	675.341				
9										9		EACH	REMOVING SIGNS	675.50				
2										2		EACH	ERECTING SALVAGED SIGNS	675.60				
1										1		EACH	DELINEATOR WITH STEEL POST	676.10				
													BEGIN ALTERNATE ZA					
					607		607			1214		CY	SPECIAL PROVISION (HP CONCRETE, CLASS A LOW CEMENT) (FPQ)	900.608				
						607		607		1214		CY	SPECIAL PROVISION (HP CONCRETE, CLASS A LOW CEMENT) (SIPCMF) (FPQ)	900.608				
													END ALTERNATE ZA					
8										8		EACH	SPECIAL PROVISION (GR APPROACH SECTION TO F-SHAPE CONCRETE RAIL)	900.620				

# QUANTITY SHEET 3


SUMMARY OF ESTIMATED QUANTITIES										TOTALS		DESCRIPTIONS				DETAILED SUMMARY OF QUANTITIES		
ROADWAY	TRAINING	EROSION CONTROL	BRIDGE 40 N	BRIDGE 40 S	ALTERNATE A (BRIDGE 40 N)	ALTERNATE B (BRIDGE 40 N)	ALTERNATE A (BRIDGE 40 S)	ALTERNATE B (BRIDGE 40 S)	FULL C.E ITEMS	GRAND TOTAL	FINAL	UNIT	ITEMS	ITEM NUMBER	ROUND	QUANTITIES	UNIT	ITEMS
			1000	1000						2000		EACH	SPECIAL PROVISION (REMOVE AND REPLACE EXISTING SHEAR CONNECTORS)	900.620				
			136	137						273		LF	SPECIAL PROVISION (BRIDGE FIBERGLASS DRAIN SYSTEM)	900.640				
			993	991						1984		LF	SPECIAL PROVISION (BRIDGE RAILING, F-SHAPE CONCRETE)	900.640				
			0.5	0.5						1		LS	SPECIAL PROVISION (PUBLIC PROTECTION FOR BRIDGE PROJECTS)	900.645				
			1946	1953						3899		SY	SPECIAL PROVISION (LONGITUDINAL DECK GROOVING)	900.675				

# QUANTITY SHEET 4

SUMMARY OF BRIDGE QUANTITIES										TOTALS	DESCRIPTIONS			DETAILED SUMMARY OF QUANTITIES		
BRIDGE 40 N	BRIDGE 40 S	SUPER STRUCTURE BR 40S	ABUTMENT #1	ABUTMENT #2	PIER #1	PIER #2	APPROACH SLAB #1	APPROACH SLAB #2		BRIDGE TOTAL	UNIT	ITEMS	ITEM NUMBER	QUANTITIES	UNIT	ITEMS
			32	38						70	CY	STRUCTURE EXCAVATION	204.25			
			32	38						70	CY	GRANULAR BACKFILL FOR STRUCTURES	204.30			
	1		37	44			48	50		180	CY	CONCRETE, HIGH PERFORMANCE CLASS B	501.34			
			1	1						2	EACH	SHORING SUPERSTRUCTURE BEARINGS (ABUTMENT)	502.11			
					1	1				2	EACH	SHORING SUPERSTRUCTURE BEARINGS (PIER)	502.11			
			3782	4488						8270	LB	REINFORCING STEEL	507.15			
			65	80						145	LF	DRILLING AND GROUTING DOWELS	507.16			
		161177	906	1014			5898	5963		174958	LB	EPOXY COATED REINFORCING STEEL	507.17			
	0.5									0.5	LS	STRUCTURAL PAINTING, FIELD APPLIED (960 TONS)	513.30			
	0.5									0.5	LS	CONTAINMENT & ENVIRONMENTAL PROTECTION, FIELD	513.36			
	0.5									0.5	LS	SURFACE PREPARATION, FIELD (960 TONS)	513.41			
		597	8	9	28	28				670	GAL	WATER REPELLENT, SILANE	514.10			
		110								110	LF	BRIDGE EXPANSION JOINT, ASPHALTIC PLUG	516.10			
		108								108	LF	BRIDGE EXPANSION JOINT, VERMONT	516.11			
		1885								1885	SY	REMOVAL OF BRIDGE PAVEMENT	529.10			
			1	1						2	EACH	PARTIAL REMOVAL OF STRUCTURE (ABUTMENT)	529.20			
		1								1	EACH	PARTIAL REMOVAL OF STRUCTURE (DECK)	529.20			
					20	10				30	CY	STONE FILL, TYPE II	613.11			
	0.5									0.5	LS	TRAFFIC CONTROL	641.10			
	1000									1000	EACH	SPECIAL PROVISION (REMOVE AND REPLACE EXISTING SHEAR CONNECTORS)	900.620			
					68.5	68.5				137	LF	SPECIAL PROVISION (BRIDGE FIBERGLASS DRAIN SYSTEM)	900.640			
		991								991	LF	SPECIAL PROVISION (BRIDGE RAILING, F-SHAPE CONCRETE)	900.640			
	0.5									0.5	LS	SPECIAL PROVISION (PUBLIC PROTECTION FOR BRIDGE PROJECTS)	900.645			
		1953								1953	SY	SPECIAL PROVISION (LONGITUDINAL DECK GROOVING)	900.675			

# QUANTITY SHEET 5


SUMMARY OF BRIDGE QUANTITIES										TOTALS	DESCRIPTIONS			DETAILED SUMMARY OF QUANTITIES		
BRIDGE 40 N	BRIDGE 40 S	SUPER STRUCTURE BR 40N	ABUTMENT #3	ABUTMENT #4	PIER #3	PIER #4	APPROACH SLAB #3	APPROACH SLAB #4	BRIDGE TOTAL	UNIT	ITEMS	ITEM NUMBER	QUANTITIES	UNIT	ITEMS	
			30	35					65	CY	STRUCTURE EXCAVATION	204.25				
			30	35					65	CY	GRANULAR BACKFILL FOR STRUCTURES	204.30				
1			38	43			49	50	181	CY	CONCRETE, HIGH PERFORMANCE CLASS B	501.34				
			1	1					2	EACH	SHORING SUPERSTRUCTURE BEARINGS (ABUTMENT)	502.11				
					1	1			2	EACH	SHORING SUPERSTRUCTURE BEARINGS (PIER)	502.11				
		720							720	LB	STRUCTURAL STEEL	506.60				
			3967	4633					8600	LB	REINFORCING STEEL	507.15				
					62.5	80			142.5	LF	DRILLING AND GROUTING DOWELS	507.16				
		158755	956	1015			5871	5921	172518	LB	EPOXY COATED REINFORCING STEEL	507.17				
0.5									0.5	LS	STRUCTURAL PAINTING, FIELD APPLIED (960 TONS)	513.30				
0.5									0.5	LS	CONTAINMENT & ENVIRONMENTAL PROTECTION, FIELD	513.36				
0.5									0.5	LS	SURFACE PREPARATION, FIELD (960 TONS)	513.41				
			597	8	9	28	28		670	GAL	WATER REPELLENT, SILANE	514.10				
			110						110	LF	BRIDGE EXPANSION JOINT, ASPHALTIC PLUG	516.10				
			108						108	LF	BRIDGE EXPANSION JOINT, VERMONT	516.11				
		1875							1875	SY	REMOVAL OF BRIDGE PAVEMENT	529.10				
			1	1					2	EACH	PARTIAL REMOVAL OF STRUCTURE (ABUTMENT)	529.20				
			1						1	EACH	PARTIAL REMOVAL OF STRUCTURE (DECK)	529.20				
					10	10			20	CY	STONE FILL, TYPE II	613.11				
0.5									0.5	LS	TRAFFIC CONTROL	641.10				
1000									1000	EACH	SPECIAL PROVISION (REMOVE AND REPLACE EXISTING SHEAR CONNECTORS)	900.620				
					68	68			136	LF	SPECIAL PROVISION (BRIDGE FIBERGLASS DRAIN SYSTEM)	900.640				
993									993	LF	SPECIAL PROVISION (BRIDGE RAILING, F-SHAPE CONCRETE)	900.640				
0.5									0.5	LS	SPECIAL PROVISION (PUBLIC PROTECTION FOR BRIDGE PROJECTS)	900.645				
		1946							1946	SY	SPECIAL PROVISION (LONGITUDINAL DECK GROOVING)	900.675				

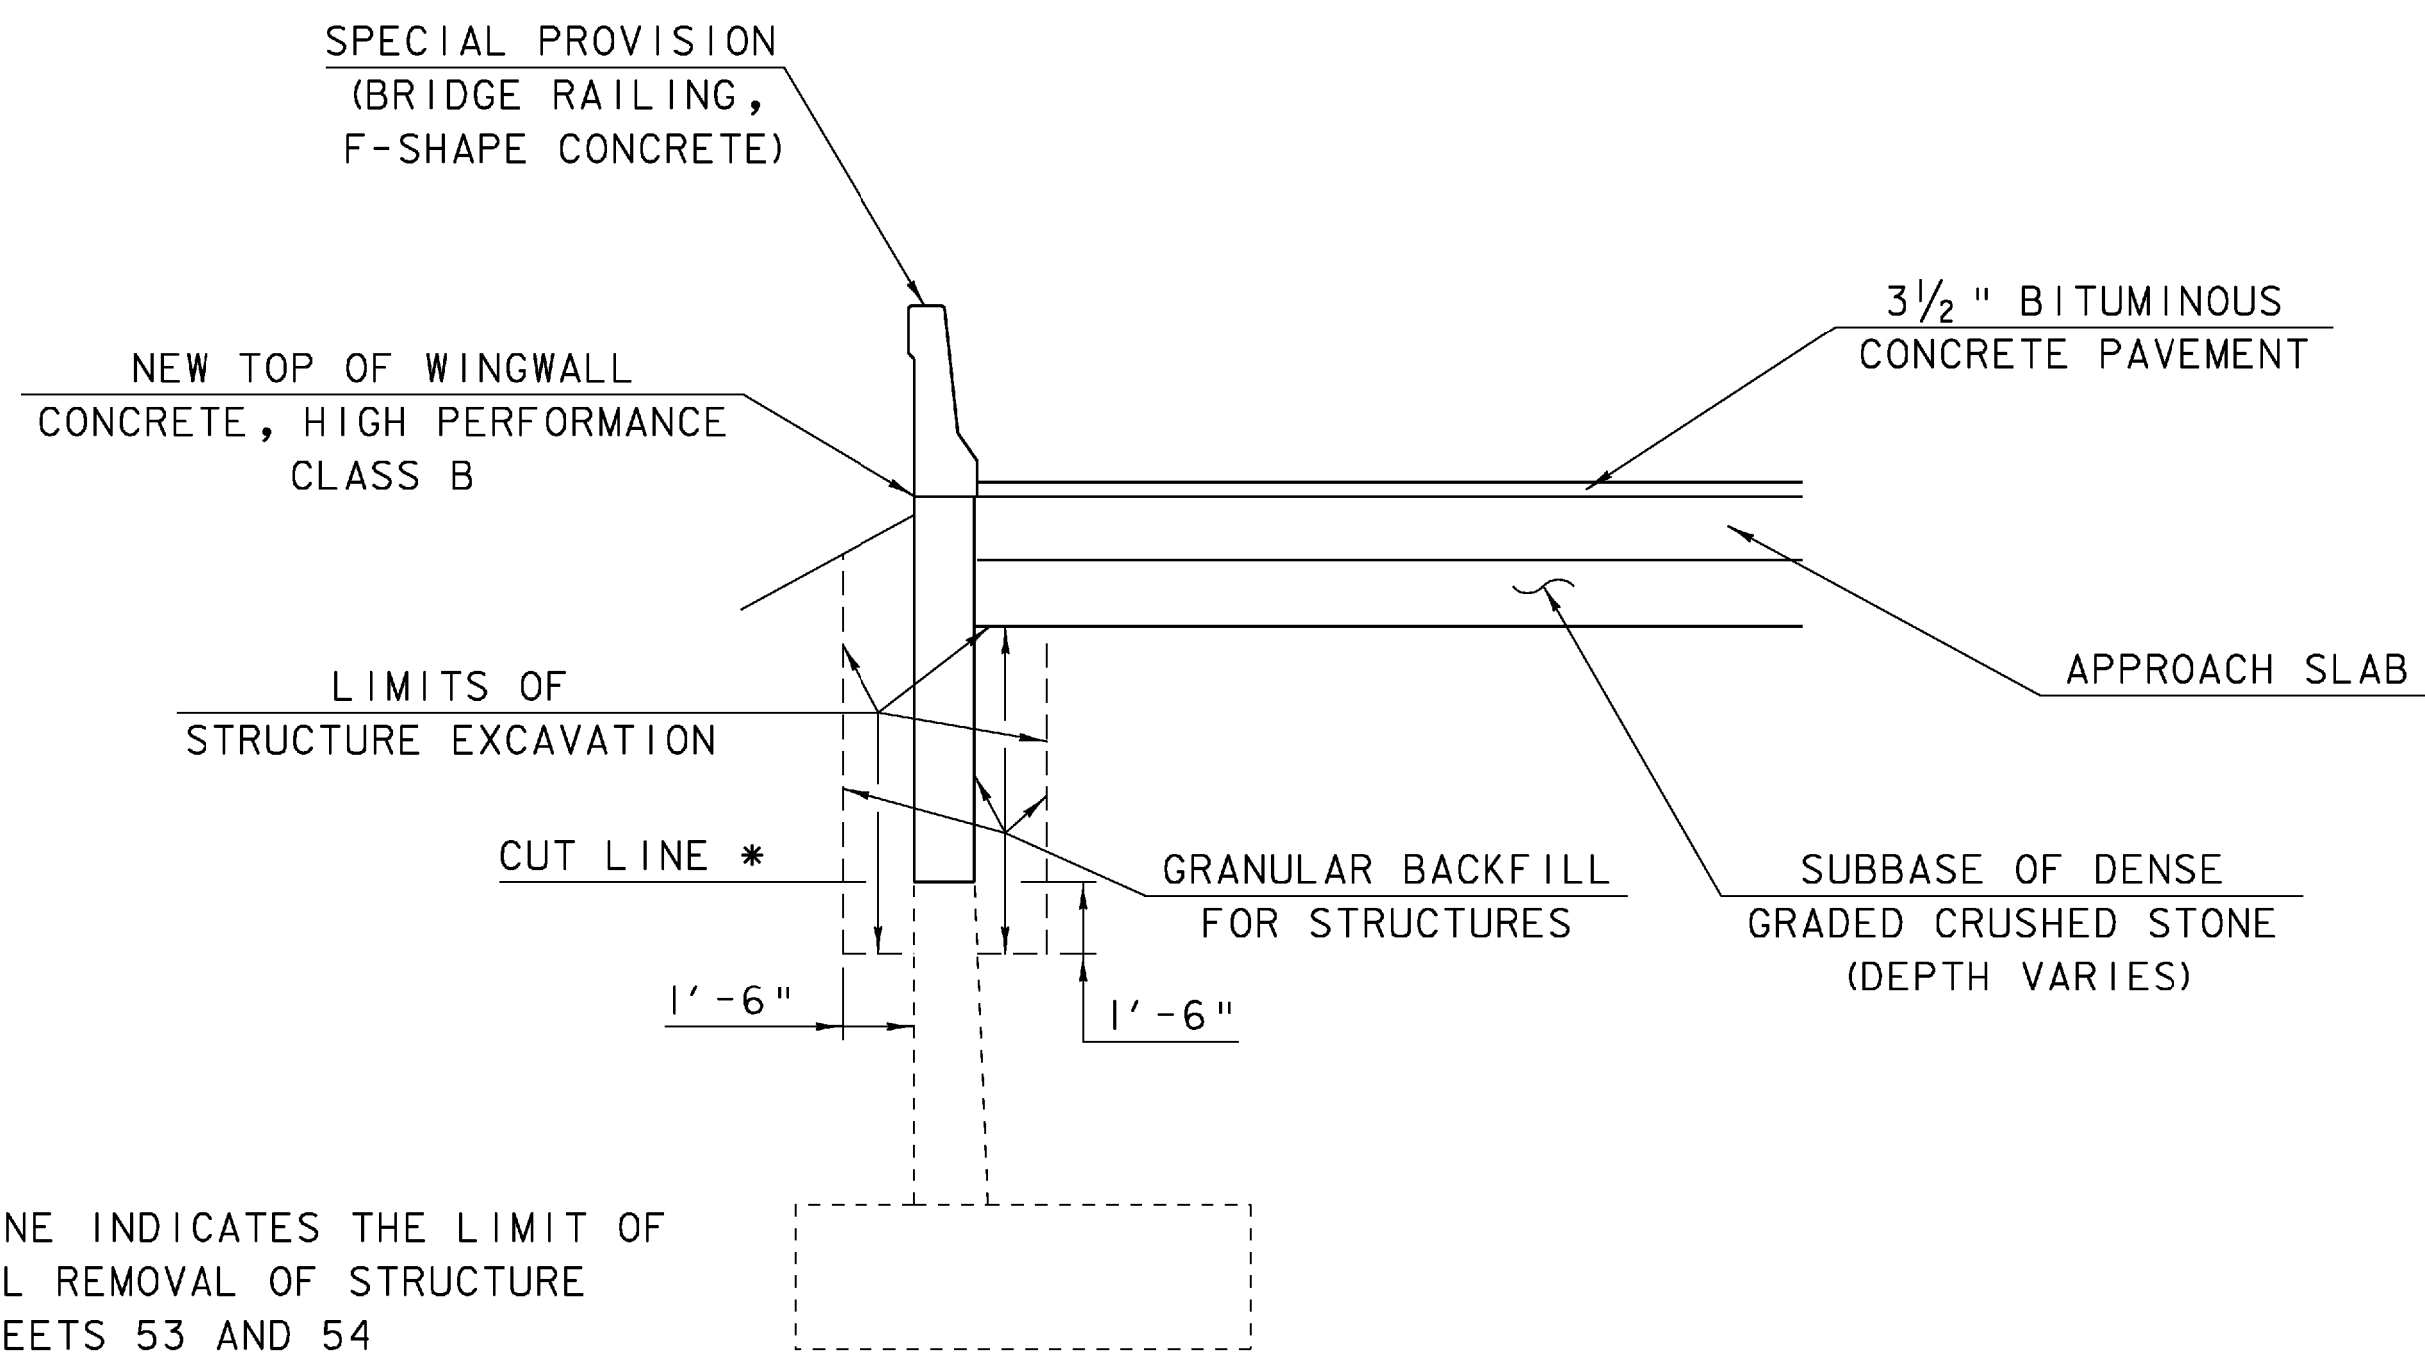

\* CUT LINE INDICATES THE LIMIT OF PARTIAL REMOVAL OF STRUCTURE SEE SHEETS 53 AND 54

**WINGWALL TYPICAL EXCAVATION & FILL LIMITS**


SCALE 1/4" = 1'-0"  
 1 0 2 4 6

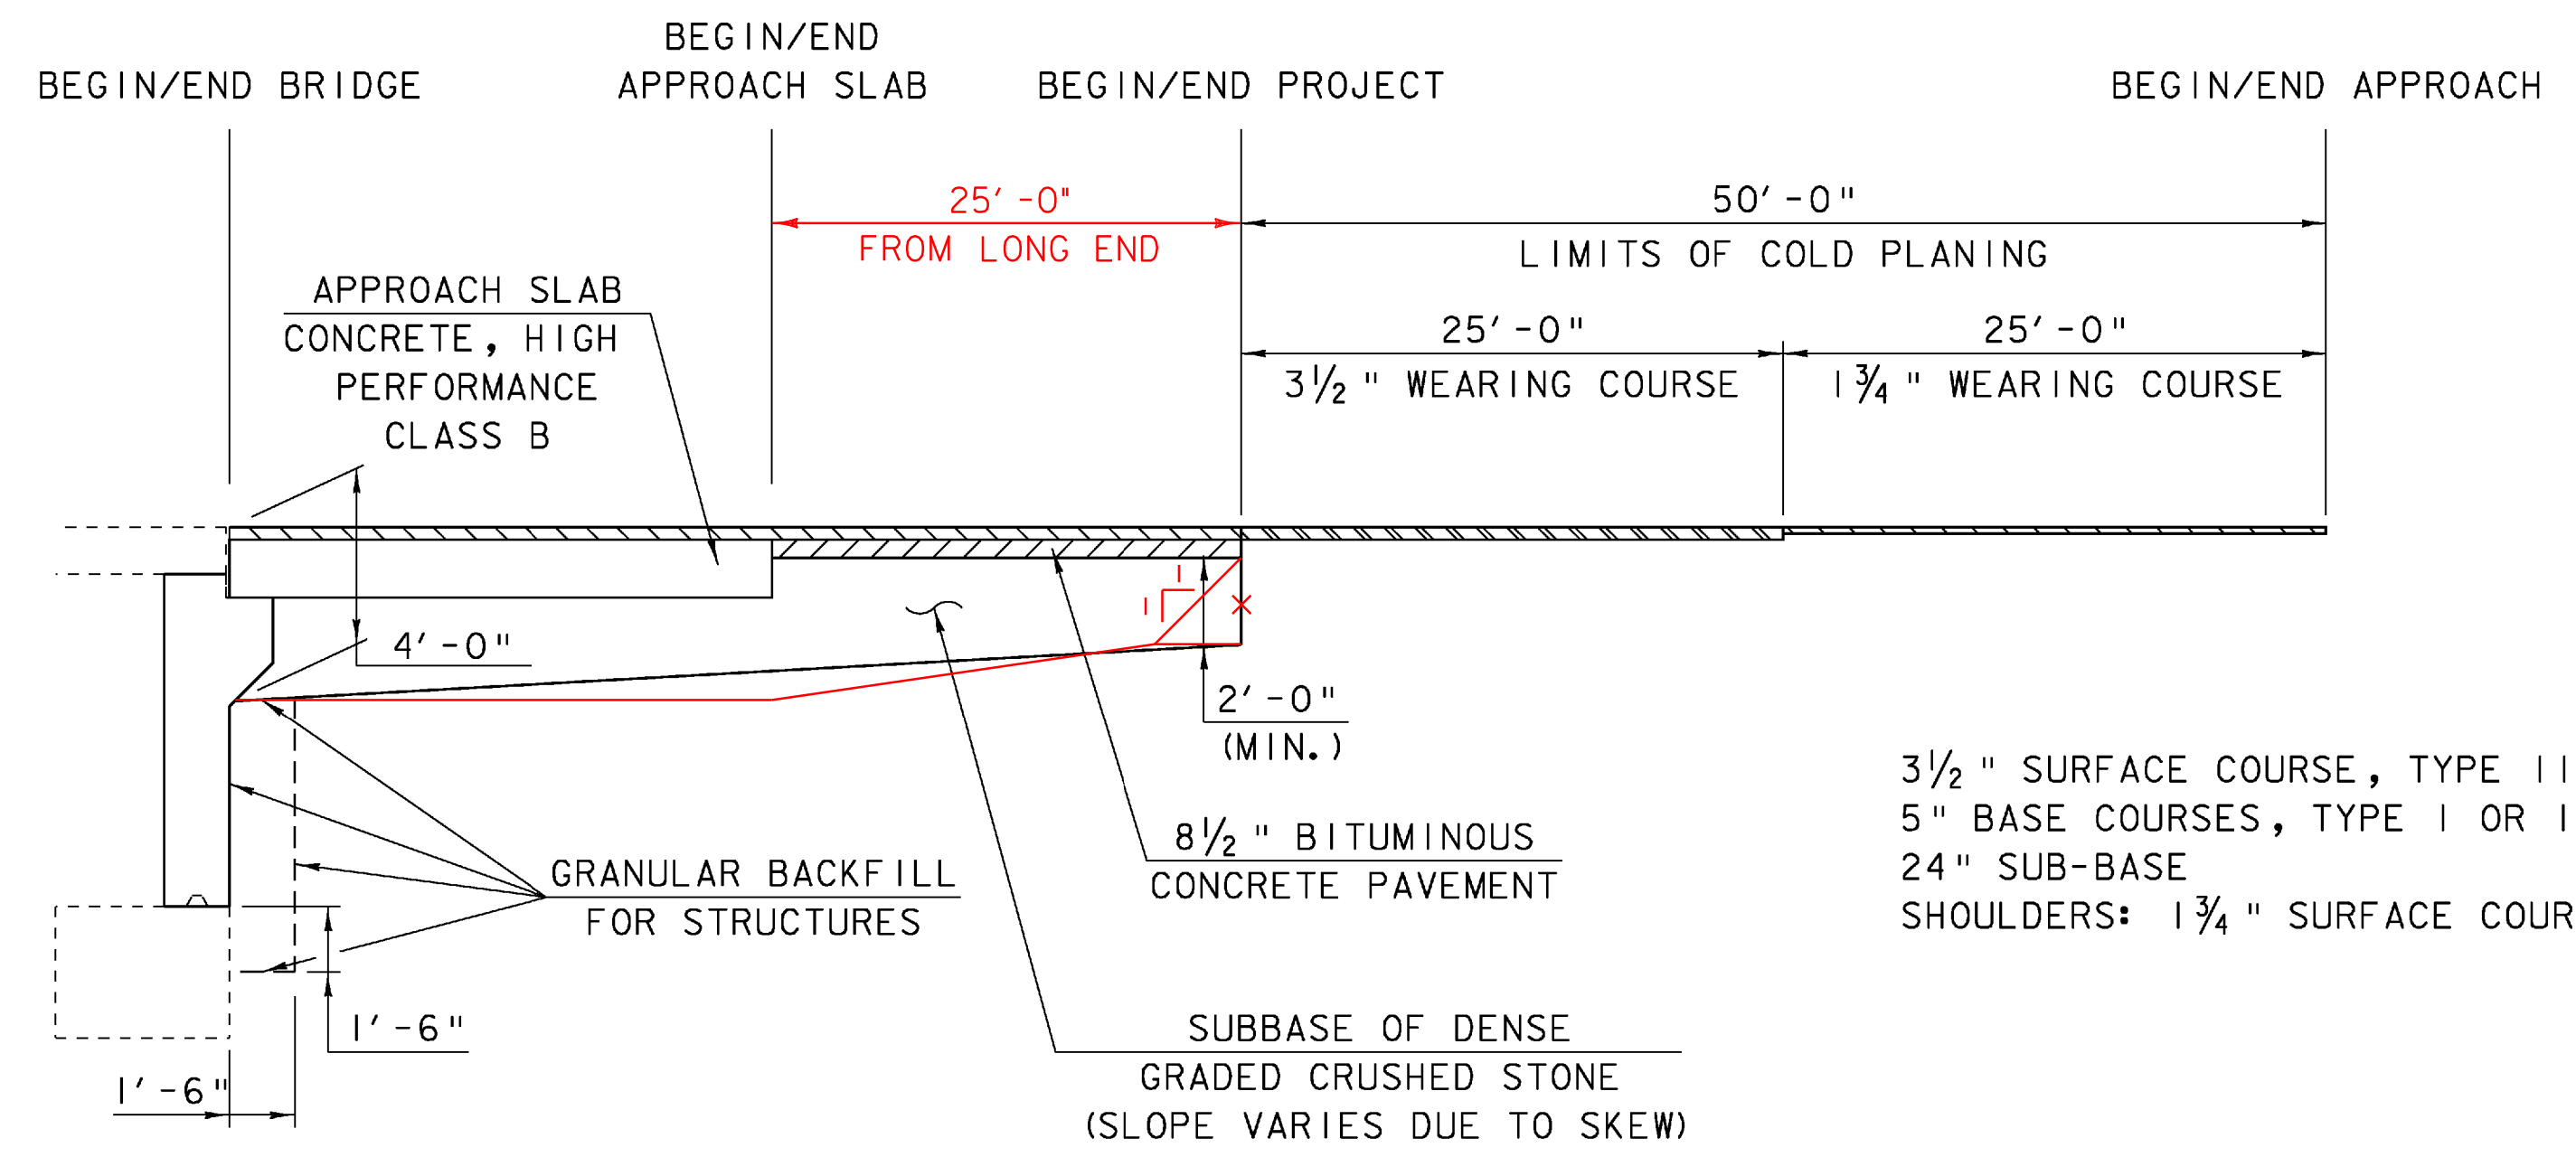

3 1/2" SURFACE COURSE, TYPE III  
 5" BASE COURSES, TYPE I OR II  
 24" SUB-BASE  
 SHOULDERS: 1 3/4" SURFACE COURSE, TYPE III


**SUBBASE TAPER AND BACKWALL FILL LIMITS**

N. T. S.

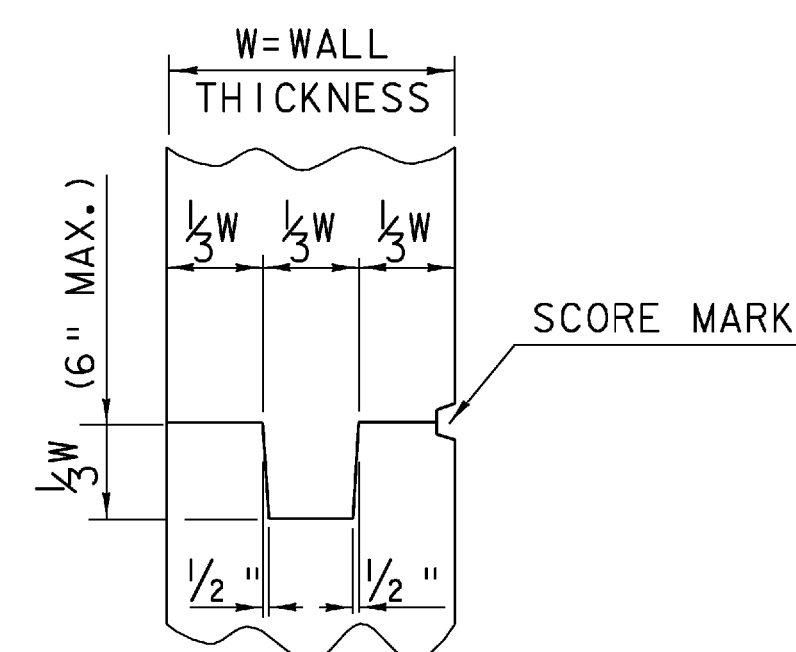

**TYPICAL CONCRETE CONSTRUCTION JOINT**


N. T. S.

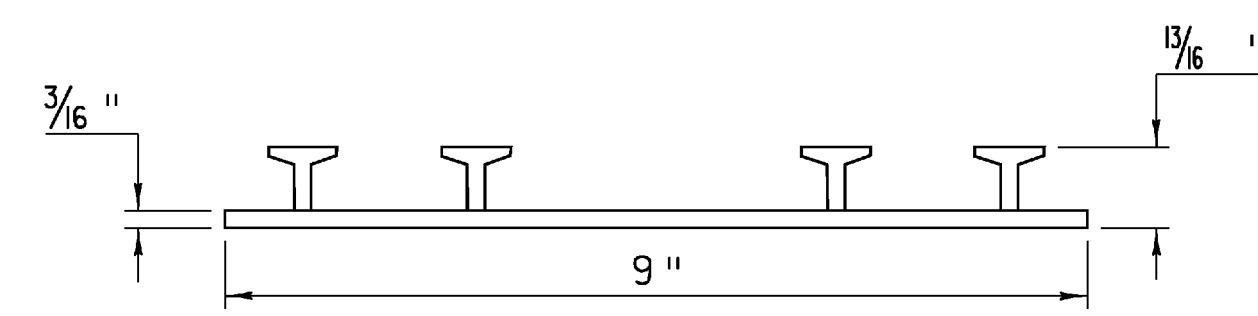

**P. V. C. WATERSTOP FOR CONSTRUCTION JOINTS**

N. T. S.

THE COSTS FOR P.V.C. WATERSTOP SHALL BE INCLUDED IN THE UNIT PRICE BID FOR ITEM 501.34 CONCRETE, HIGH PERFORMANCE CLASS B. OTHER CONFIGURATIONS MAY BE USED UPON APPROVAL OF THE STRUCTURES ENGINEER.

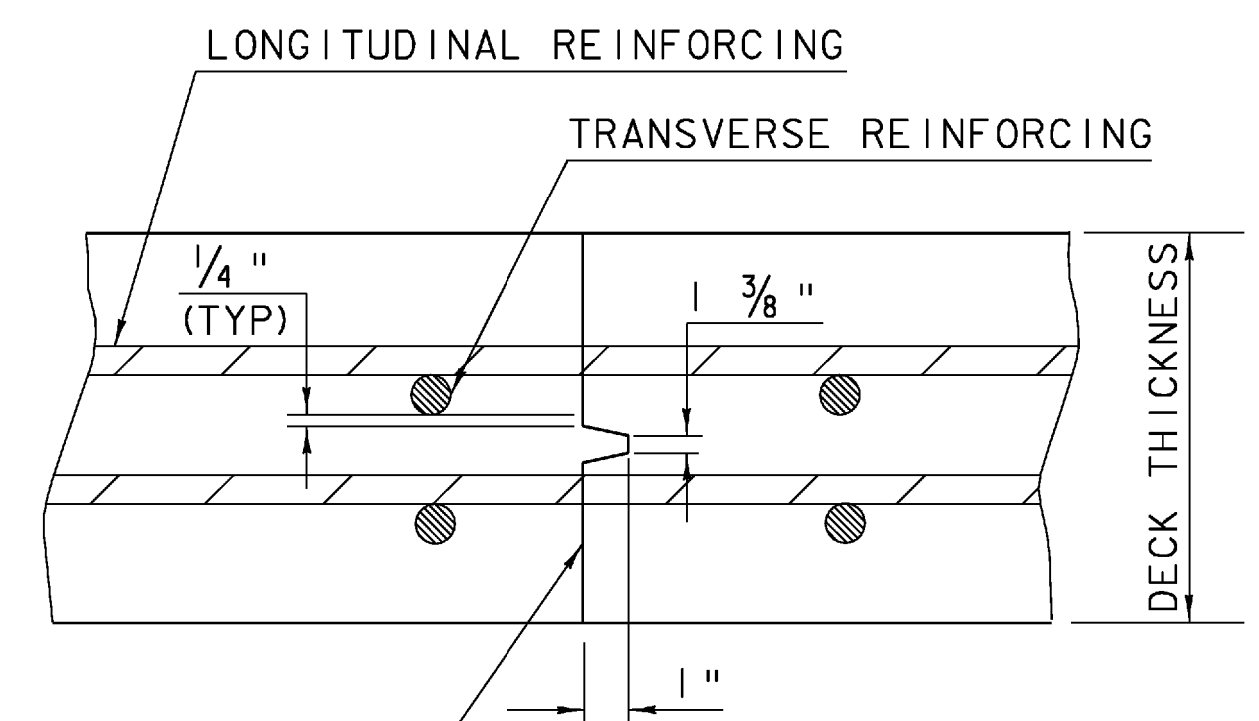


APPLY EPOXY BONDING COMPOUND BEFORE PLACING NEW CONCRETE. INCLUDE WITH COST BID FOR ITEM 501.34 CONCRETE, HIGH PERFORMANCE CLASS B.

**TRANSVERSE BRIDGE DECK CONSTRUCTION JOINT DETAILS**


N. T. S.

PROJECT:	BERLIN	PROJECT NO.:	IM 089-1 (20)
DESIGN FILE NAME: 99a270\structures\99a270miscdet.dgn			
IPARM FILE NAME: s00a270paylimits.iPLOT DATE: 05-DEC-2007			
DESIGNED BY: G. SPILAK		DRAWN BY: C. MOONEY	
SQUAD LEADER: C.P. WILLIAMS		CHECKED BY: R.S. YOUNG	
PAYLIMITS AND SUBBASE TAPER		SHEET: 8 OF 104	

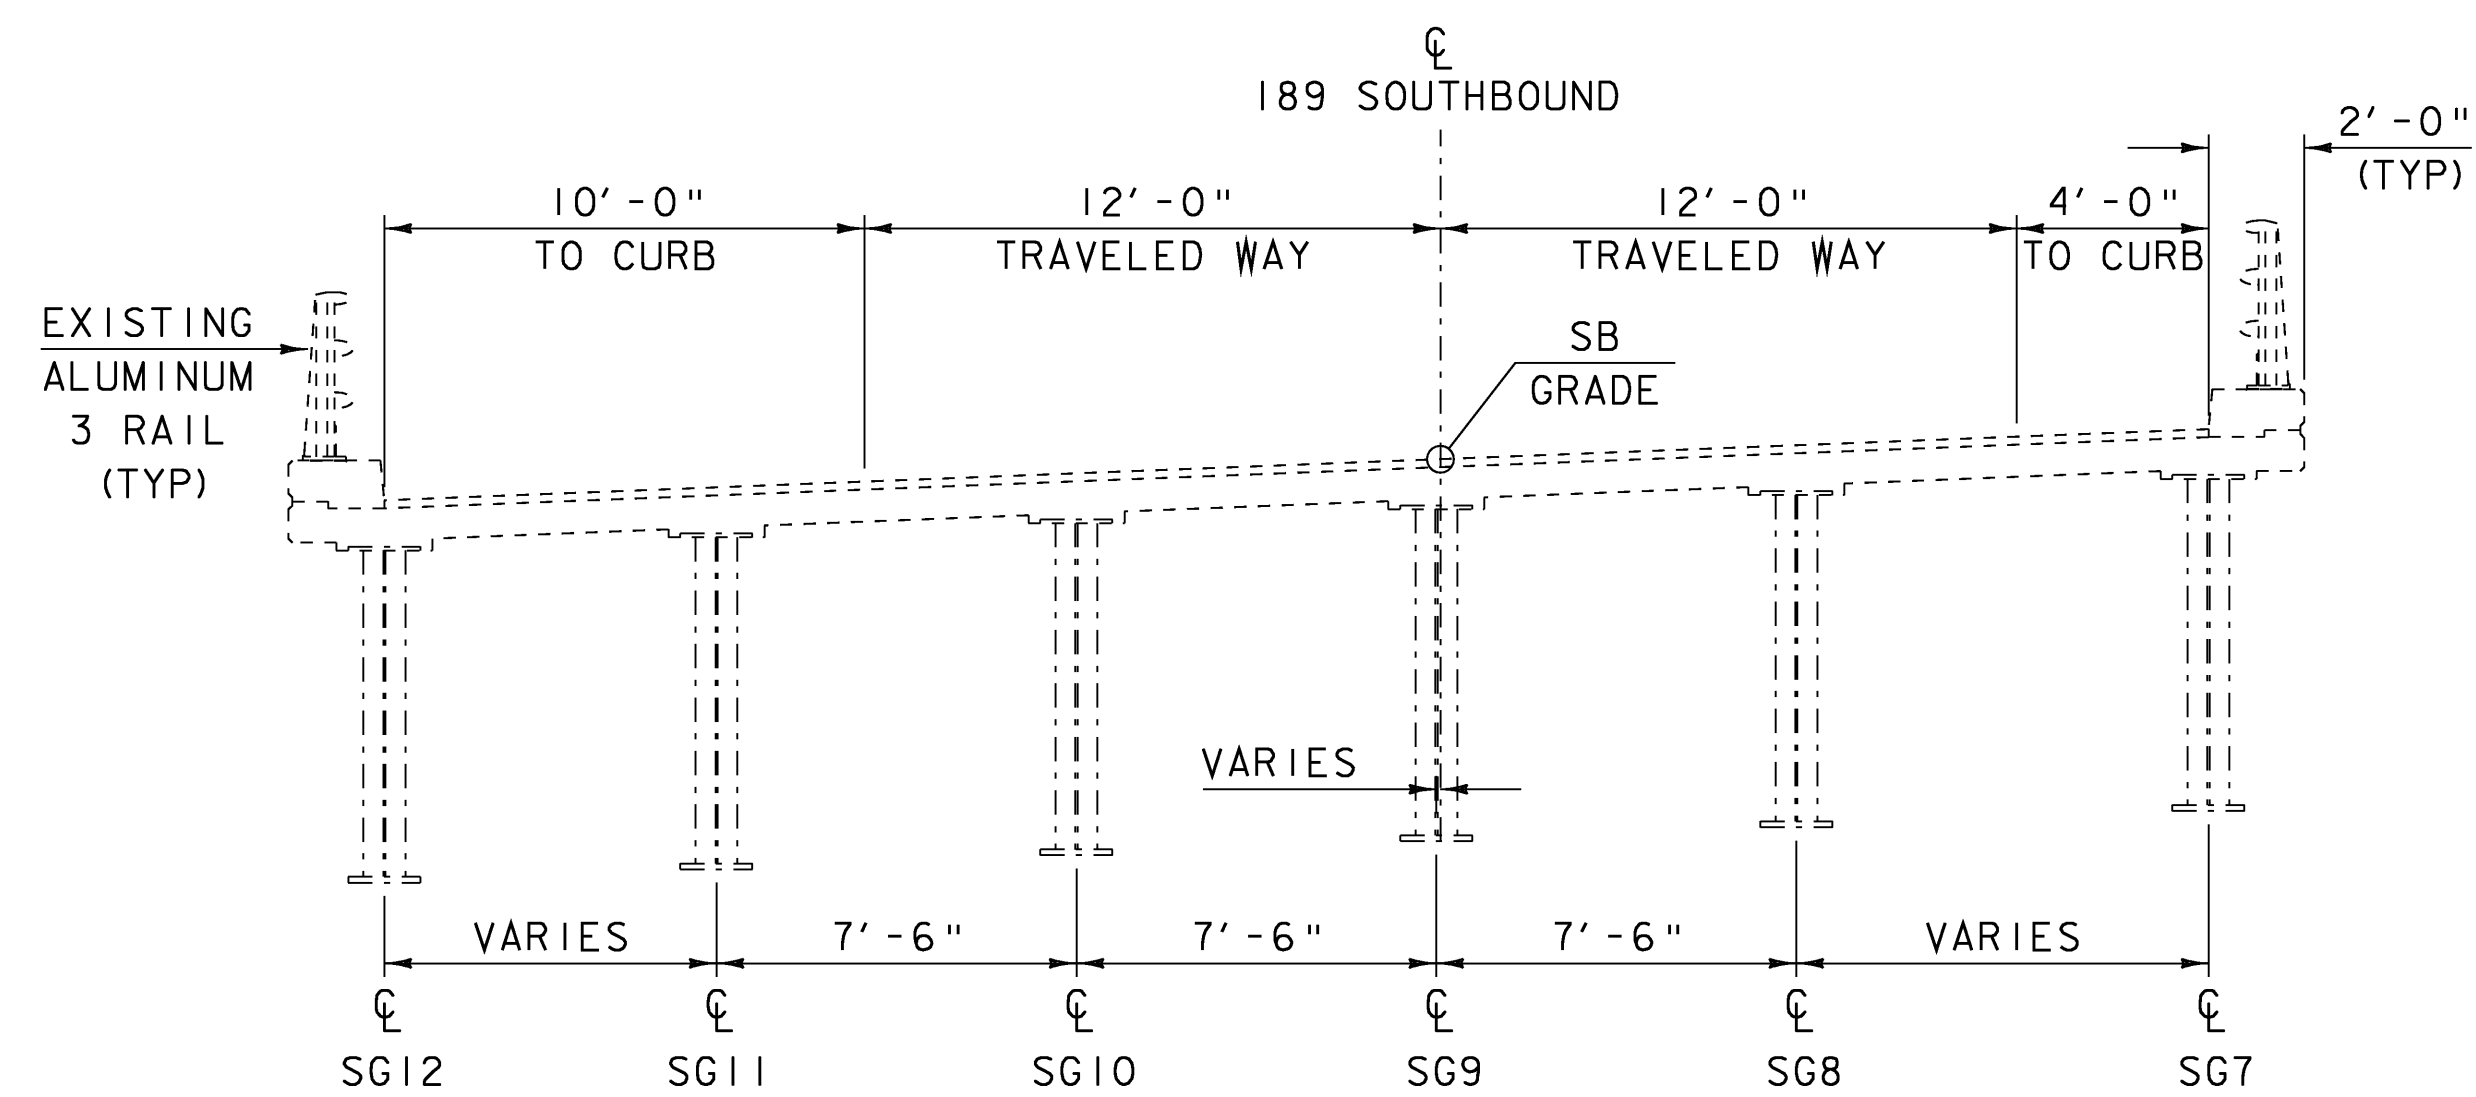


**SOUTH BOUND EXISTING BRIDGE TYPICAL**

SCALE 1/4" = 1'-0"

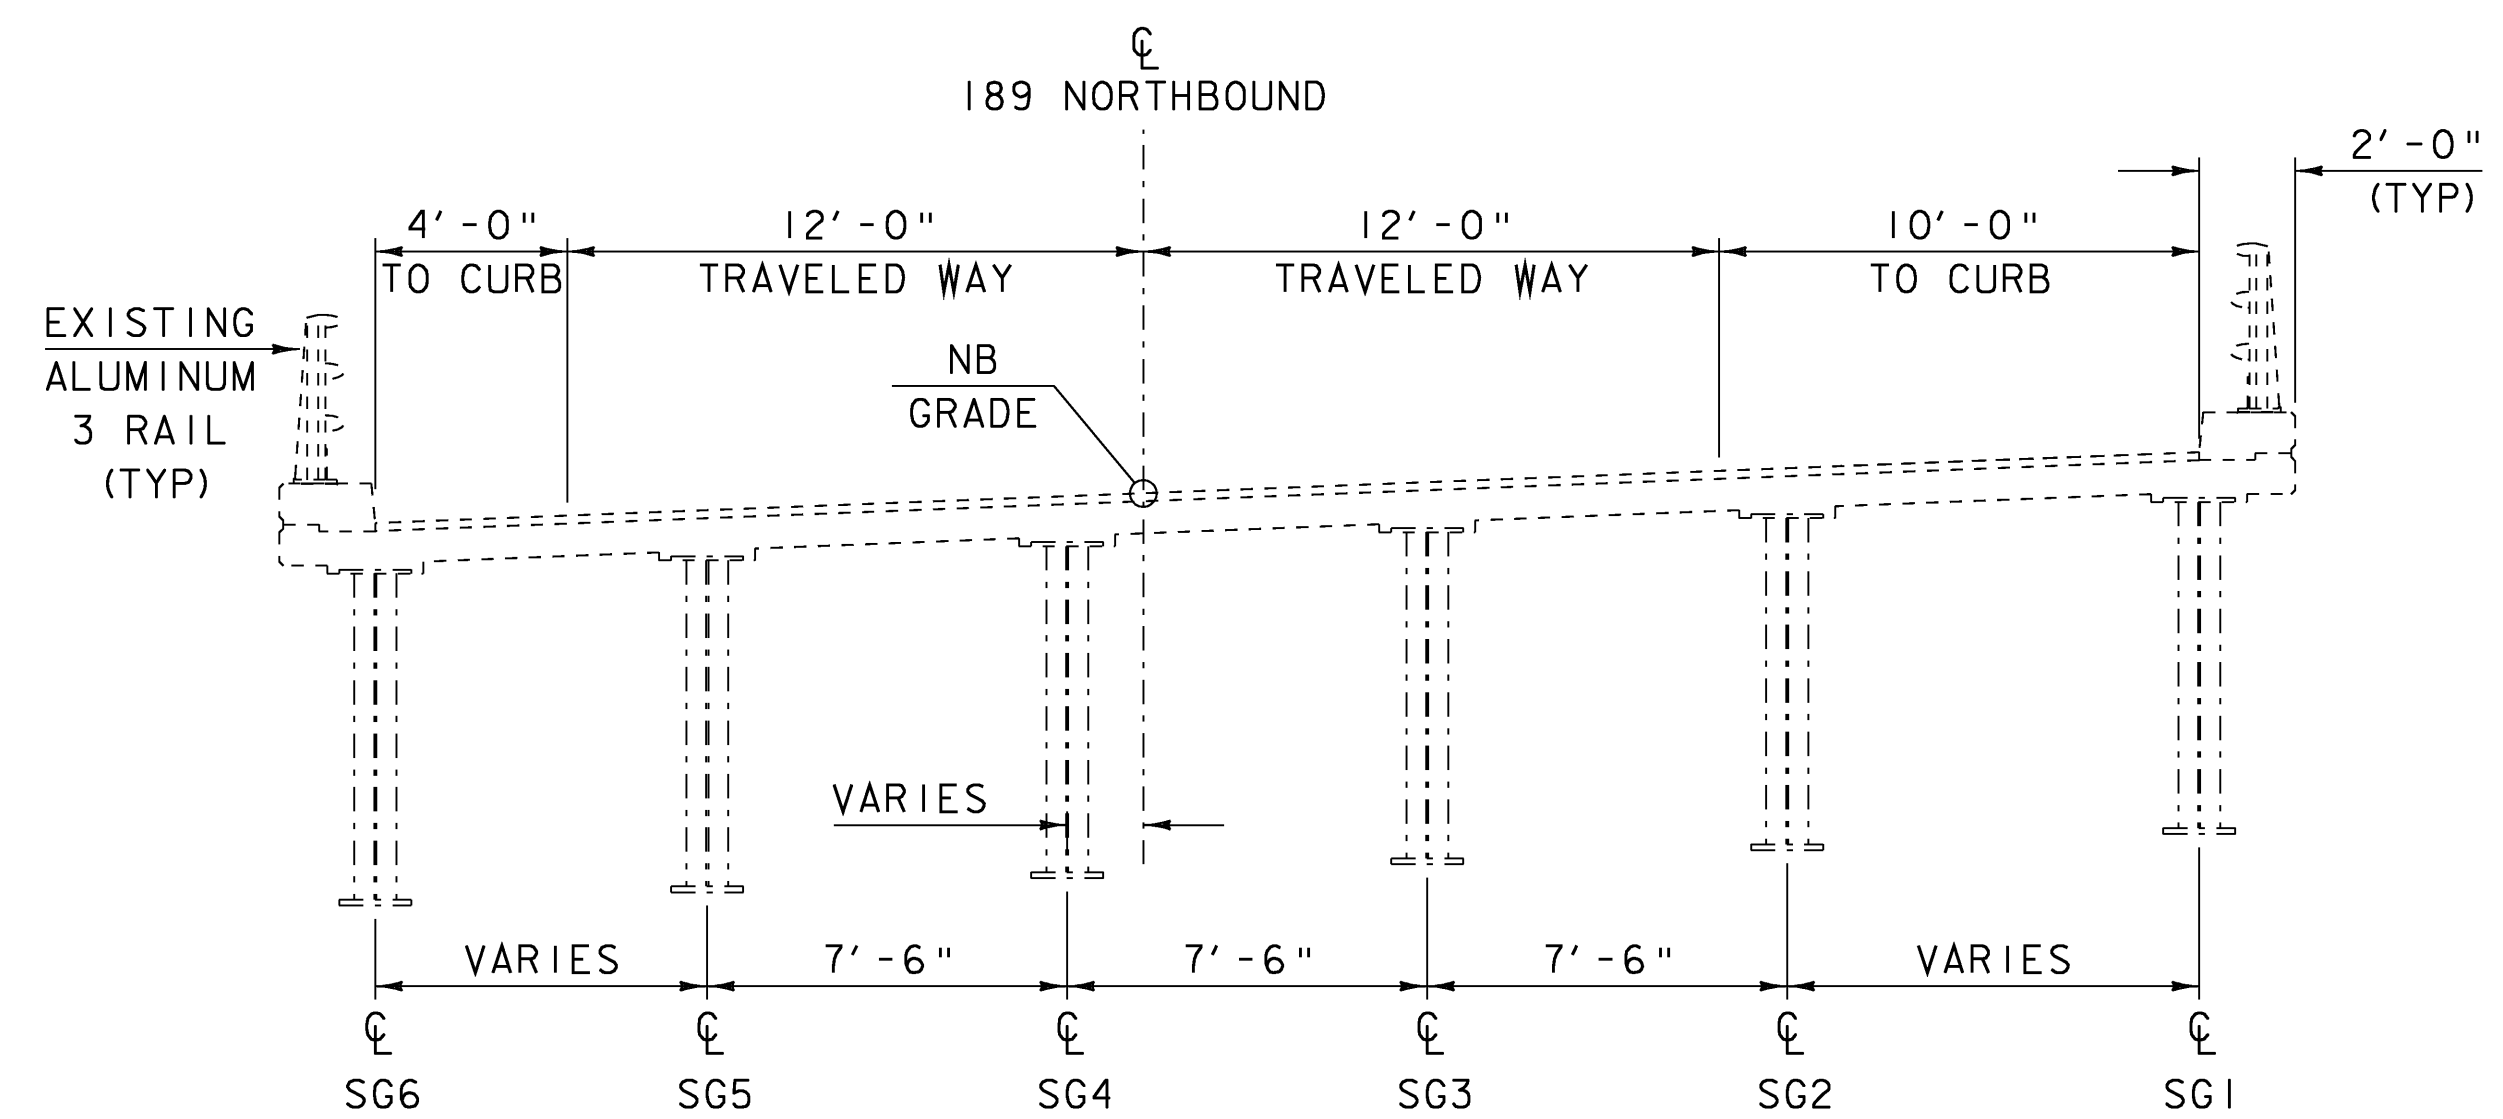

**NORTH BOUND EXISTING BRIDGE TYPICAL**

SCALE 1/4" = 1'-0"

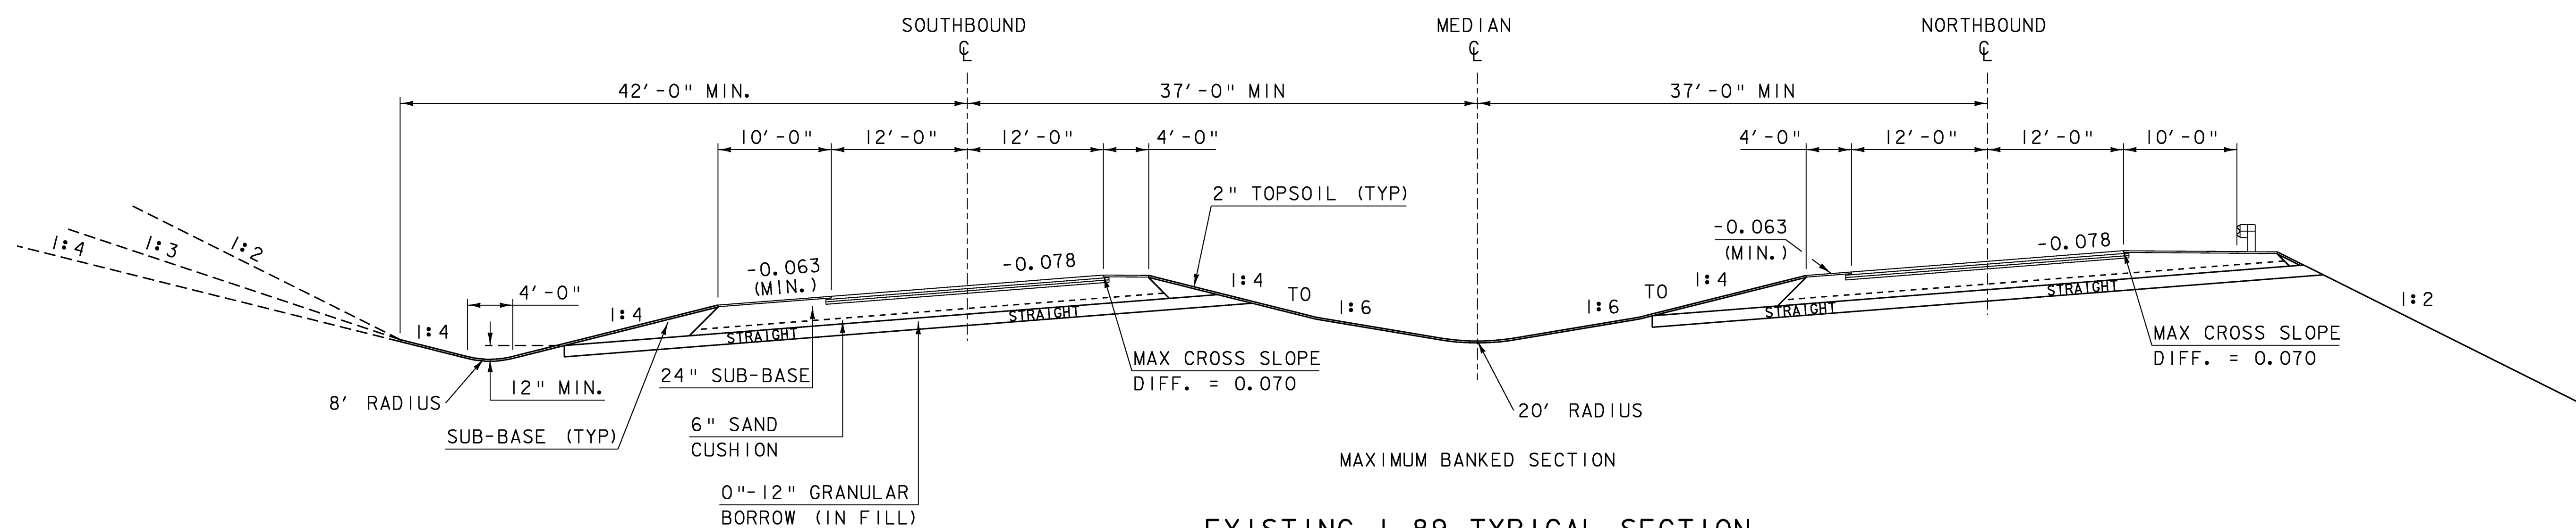


**EXISTING I-89 TYPICAL SECTION**

SCALE 1/8" = 1'-0"

SCALE 1/4" = 1'-0"

SCALE 1/8" = 1'-0"

PROJECT:	BERLIN	PROJECT NO.:	IM 089-1 (20)
DESIGN FILE NAME:	99a270\structures\s99a270typ.dgn	PLOT DATE:	05-DEC-2007
IPARM FILE NAME:	s00a270typ.i	DRAWN BY:	R.PELLETT
DESIGNED BY:	G.SPILAK	CHECKED BY:	R.S.YOUNG
SQUAD LEADER:	C.P.WILLIAMS	EXISTING TYPICAL SECTIONS	SHEET: 9 OF 104

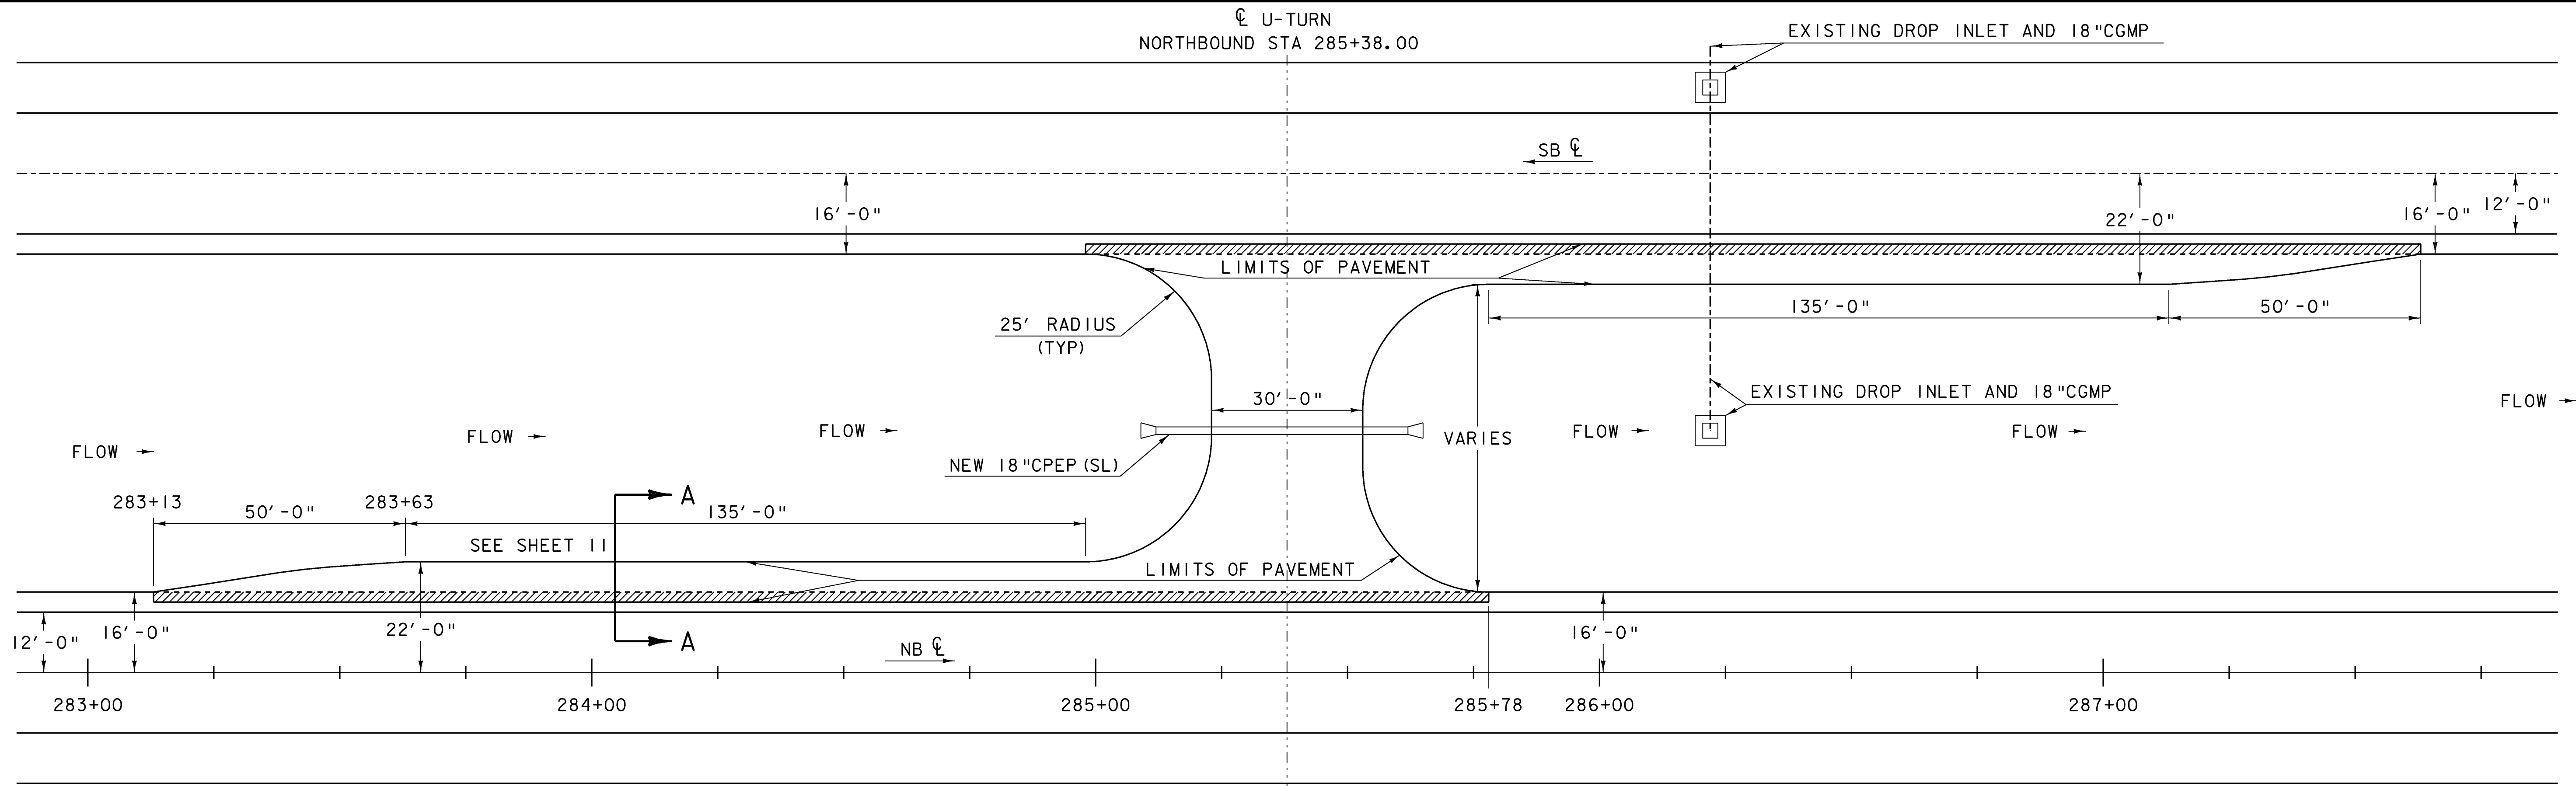

2'-0" COLD PLANING - EXISTING SHOULDER

**NEW U-TURN PLAN**  
**NORTHBOUND STA 285+38.00**  
 N. T. S.


NOTE: SEE SHEET 11 FOR U-TURN SECTIONS AND SECTION A-A

**GENERAL NOTES**

1. ALL MATERIALS AND CONSTRUCTION SHALL CONFORM TO THE STATE OF VERMONT AGENCY OF TRANSPORTATION "STANDARD SPECIFICATIONS FOR CONSTRUCTION", DATED 2006 AND ITS LATEST REVISIONS, AND THE AASHTO "STANDARD SPECIFICATIONS FOR HIGHWAY BRIDGES", SEVENTEENTH EDITION, AND ITS LATEST REVISIONS.
2. ALL DIMENSIONS SHOWN IN THE PLANS ARE HORIZONTAL OR VERTICAL AND ARE GIVEN AT 68 DEGREES FAHRENHEIT, UNLESS NOTED OTHERWISE.
3. ITEM 529.20, "PARTIAL REMOVAL OF STRUCTURE (DECK)" WILL BE FULL COMPENSATION FOR ALL MATERIALS, LABOR, EQUIPMENT AND INCIDENTALS TO COMPLETELY REMOVE FEATURES OF THE EXISTING DECKS DOWN TO THE TOP FLANGE OF THE EXISTING GIRDERS, SOME OF THE FEATURES INCLUDE, BUT ARE NOT LIMITED TO THE FOLLOWING: METAL BRIDGE RAILING; STEEL BRIDGE JOINTS; GRANITE CURB; AND REINFORCED CONCRETE DECK SLAB.
4. THE EXISTING SHEAR STUDS SHALL REMAIN ON THE GIRDERS. THE CONTRACTOR SHALL TAKE EXTRA CARE NOT TO DAMAGE THE SHEAR STUDS DURING DECK REMOVAL. DAMAGED STUDS SHALL BE REMOVED AND A NEW STUD SHALL BE REPLACED IN KIND TO THE SATISFACTION OF THE ENGINEER. EXISTING AND NEW SHEAR STUDS SHALL BE TESTED ACCORDING TO SECTION 508. REMOVAL AND REPLACEMENT OF SHEAR STUDS THAT ARE DAMAGED SHALL BE PAID FOR UNDER ITEM 900.620 SPECIAL PROVISION (REMOVE AND REPLACE, EXISTING SHEAR CONNECTORS).
5. ITEM 529.20, "PARTIAL REMOVAL OF STRUCTURE (ABUTMENT)" WILL BE FULL COMPENSATION FOR ALL MATERIALS, LABOR, EQUIPMENT AND INCIDENTALS TO COMPLETELY REMOVE THE APPROACH SLAB AND PORTIONS OF THE WING WALLS AND ABUTMENT AS DETAILED ON THE PLANS.
6. AN ESTIMATED QUANTITY FOR ITEM 502.11, "SHORING SUPERSTRUCTURE BEARINGS (ABUTMENT)" AND "SHORING SUPERSTRUCTURE BEARINGS (PIER)" HAS BEEN INCLUDED IN THIS PROJECT BASED ON THE ASSUMPTION THAT ONE BEARING MAY NEED TO BE RESET AT EACH BRIDGE FOUNDATION LOCATION. AFTER THE EXISTING DECK HAS BEEN REMOVED AND BEFORE THE NEW DECK IS CONSTRUCTED THE CONTRACTOR SHALL PROVIDE ACCESS FOR THE ENGINEER TO INSPECT THE BEARINGS. THE ENGINEER WILL DECIDE WHICH, IF ANY, OF THE BEARINGS WILL BE SHORED AND RESET. PAYMENT FOR PROVIDING ACCESS SHALL BE INCIDENTAL TO ITEM 502.11.
7. ALL WORK ASSOCIATED WITH THE PREPARATION AND PAINTING OF THE STRUCTURAL STEEL, 513.30, 513.36 AND 513.41, SHALL BE STARTED ONLY AFTER TRAFFIC IS ALLOWED ON THE REHABILITATED BRIDGE.
8. SUBSTRUCTURE CONCRETE AND APPROACH SLABS SHALL BE HIGH PERFORMANCE CLASS B. THE DECK CONCRETE SHALL BE ACCORDING TO ITEM 900.608, "SPECIAL PROVISION (HIGH PERFORMANCE CONCRETE, CLASS A LOW CEMENT)."
9. THE DECK SHALL RECEIVE A TURF DRAG FINISH ACCORDING TO ITEM 900.608, "SPECIAL PROVISION (HIGH PERFORMANCE CONCRETE, CLASS A LOW CEMENT)." THE DECK SHALL BE GROOVED ACCORDING TO ITEM 900.675, "SPECIAL PROVISION (LONGITUDINAL DECK GROOVING)."
10. WATER REPELLENT, SILANE, SHALL BE APPLIED TO ALL EXPOSED CONCRETE SURFACES, NEW OR EXISTING, INCLUDING CONCRETE PIERS. THE DECK SURFACE SHALL BE PRESSURE WASHED AFTER GROOVING OPERATIONS, PRIOR TO TREATMENT. THE DECK UNDERSIDE NEED NOT BE TREATED BETWEEN DRIP NOTCHES.
11. ALL EXPOSED EDGES OF CONCRETE SHALL BE CHAMFERED 1 INCH X 1 INCH, EXCEPT FOR THE TOP OF BRIDGE RAIL.
12. JOINTS AND SCORE MARKS IN CONCRETE SHALL BE CONSTRUCTED AS SHOWN IN THE PLANS OR AS DIRECTED BY THE RESIDENT ENGINEER.
13. THE KEY IN CONCRETE CONSTRUCTION JOINTS SHALL BE MONOLITHIC AND CONTINUOUS FOR THE FULL LENGTH OF THE JOINT. UPWARD KEYS SHALL BE PLACED INTEGRALLY WITH THE CONCRETE BELOW THE JOINT.
14. ALL DECK REINFORCING STEEL SHALL BE EPOXY COATED AND PAID FOR UNDER ITEM 507.17, "EPOXY COATED REINFORCING STEEL".
15. MINIMUM COVER FOR REINFORCING STEEL SHALL BE AS INDICATED IN THE PLANS.
16. REINFORCING STEEL PLACEMENT TOLERANCES SHALL BE:  
 SPACING: +/- 1 INCH  
 CLEARANCE: +/- 1/4 INCH  
 SEE SPECIAL PROVISIONS FOR F-SHAPE RAIL REINFORCING TOLERANCES
17. A NEW U-TURN SHALL BE INSTALLED AS SHOWN ABOVE AT NORTHBOUND STATION 285+38.00. THE EXISTING U-TURN AT MILE MARKER 52.68 SHALL BE REMOVED. PAYMENT FOR THE NEW U-TURN SHALL BE UNDER THE APPROPRIATE CONTRACT ITEMS. PAYMENT FOR REMOVAL OF THE EXISTING U-TURN SHALL BE INCIDENTAL TO THE TRAFFIC CONTROL ITEMS.
18. ACCESS TO EITHER THE NEW OR EXISTING U-TURN SHALL BE PROVIDED BETWEEN NOVEMBER 15 AND APRIL 15.
19. WOVEN WIRE FENCE SHALL BE USED AS NEEDED NEAR THE PIERS WHERE THE EXISTING FENCE INTERFERES WITH CONSTRUCTION AND WHERE THE CONTRACTOR HAS REMOVED EXISTING FENCE FOR ACCESS INSIDE THE R.O.W. PAYMENT FOR NEW FENCE SHALL BE PAID UNDER ITEM 620.25 "WOVEN WIRE FENCE WITH STEEL POSTS."
20. "GROOVED BRIDGE AHEAD" SIGNS SHALL BE PLACED AT MILE MARKERS 52.09 NORTHBOUND AND 52.81 SOUTHBOUND. SIGN DETAILS ARE ON SHEET 24.
21. THE SURFACE PREPARATION OF THE EXISTING STEEL SHALL INCLUDE 100% REMOVAL OF THE EXISTING PAINT SYSTEM IN THE AREA 7 FEET FROM THE END OF ALL GIRDERS INCLUDING BEARINGS. 100% REMOVAL WILL ALSO BE REQUIRED FOR THE ENTIRE BOTTOM FLANGE OF ALL GIRDERS. **THE APPROXIMATE AMOUNT OF 100% REMOVAL FOR THE REMAINING SURFACES IS 40%. AREAS OUTSIDE OF 100% REMOVAL SHALL BE PREPARED ACCORDING TO SPECIFICATION 513.04(e), SECOND AND FOURTH PARAGRAPHS.**
22. ALL STEEL SURFACES SHALL RECEIVE A FIELD APPLIED PAINT SYSTEM PER SPECIFICATION 513. THE COLOR OF THE FINAL COAT OF PAINT SHALL BE GREEN AND CONFORM TO FEDERAL STANDARD NO. 595, COLOR CHIP #14062.
23. THE GIRDER ENDS AND BEARINGS SHALL BE GREASED ACCORDING TO SPECIFICATION 513.
24. THE EXISTING BRIDGE PLAQUE LOCATED AT WINGWALL #3 SHALL BE REMOVED AND REPLACED ONTO NEW CONCRETE. PAYMENT SHALL BE INCIDENTAL TO ITEM 501.34, "CONCRETE, HIGH PERFORMANCE CLASS B."
25. THE CONTRACTOR SHALL HAVE TWO FULLY OPERATIONAL CONCRETE PUMP TRUCKS CAPABLE OF THE WORK REQUIRED ON SITE DURING THE DECK POUR OPERATIONS. PAYMENT FOR COSTS ASSOCIATED WITH SUPPLYING CONCRETE PUMP TRUCKS SHALL NOT BE PAID SEPARATELY, BUT SHALL BE INCIDENTAL TO ITEM 900.608, "SPECIAL PROVISION (HIGH PERFORMANCE CONCRETE, CLASS A LOW CEMENT) (FPQ)."


REVISED 01/22/08

PROJECT:	BERLIN	PROJECT NO.:	IM 089-1 (20)
DESIGN FILE NAME:	99a270\structures\s99a270gen.dgn		
IPARM FILE NAME:	s99a270gennotes.i		
DESIGNED BY:	G. SPILAK	DRAWN BY:	C. MOONEY
SQUAD LEADER:	C.P. WILLIAMS	CHECKED BY:	R.S. YOUNG
GENERAL NOTES & NEW U-TURN	SHEET: 10 OF 104		

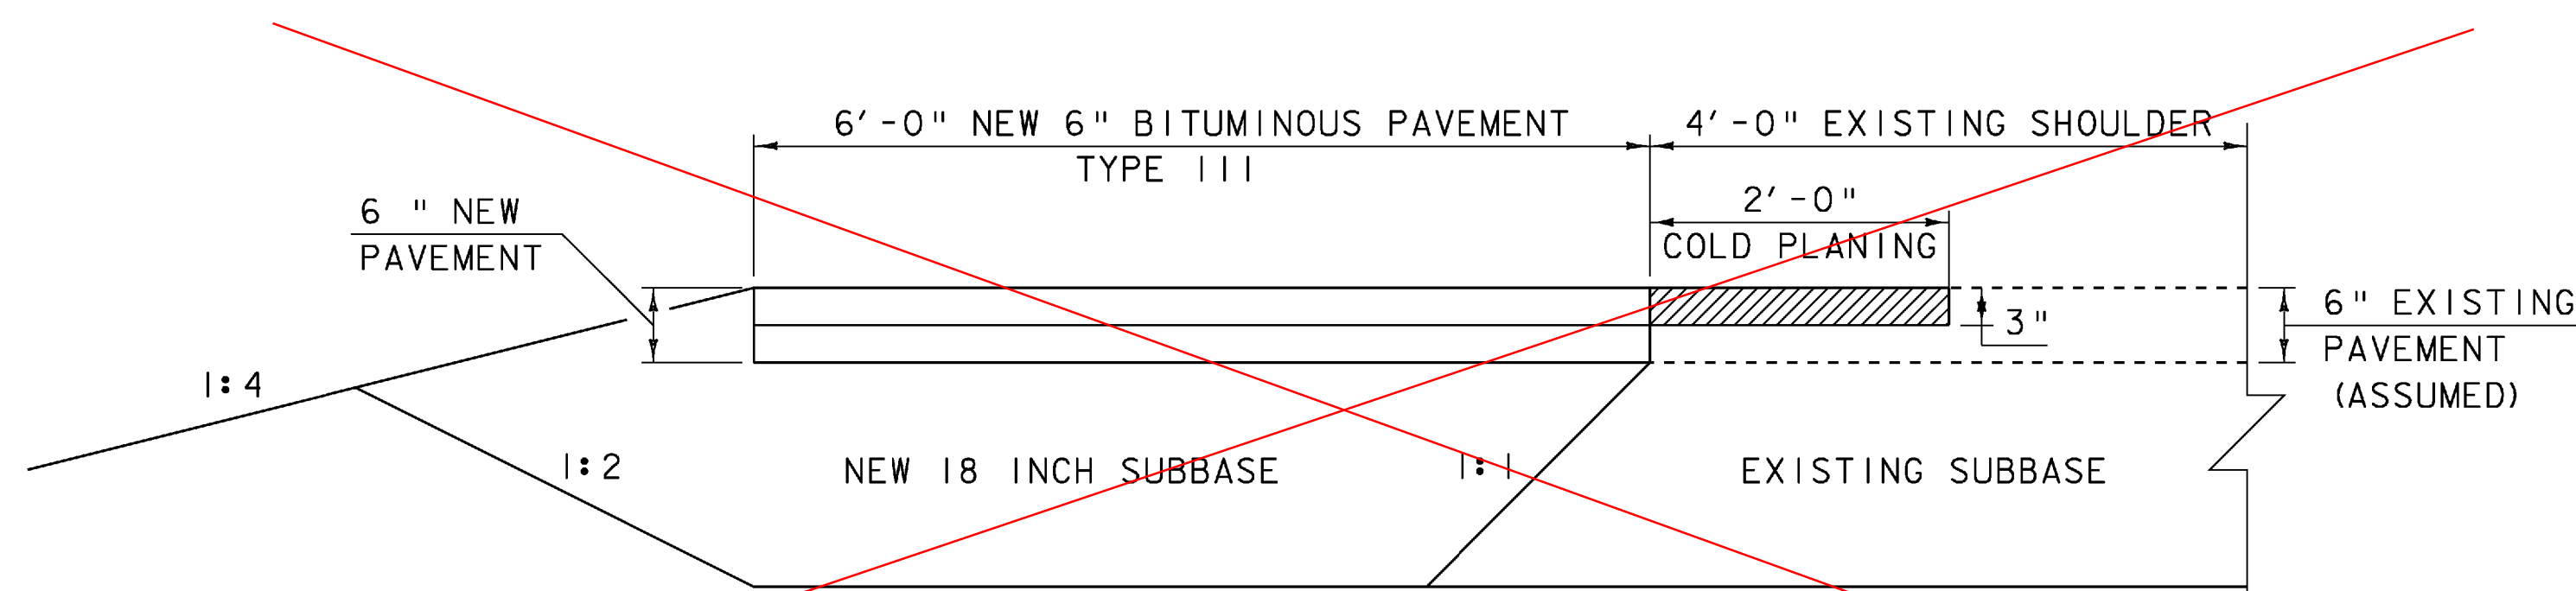


**SECTION A-A**  
N. T. S.


30" FOR ALL SHOULDERS  
6'-0" OR WIDER, OR 6" FOR  
ALL SHOULDERS LESS THAN  
6'-0" WIDE WITH NO  
GUARDRAIL

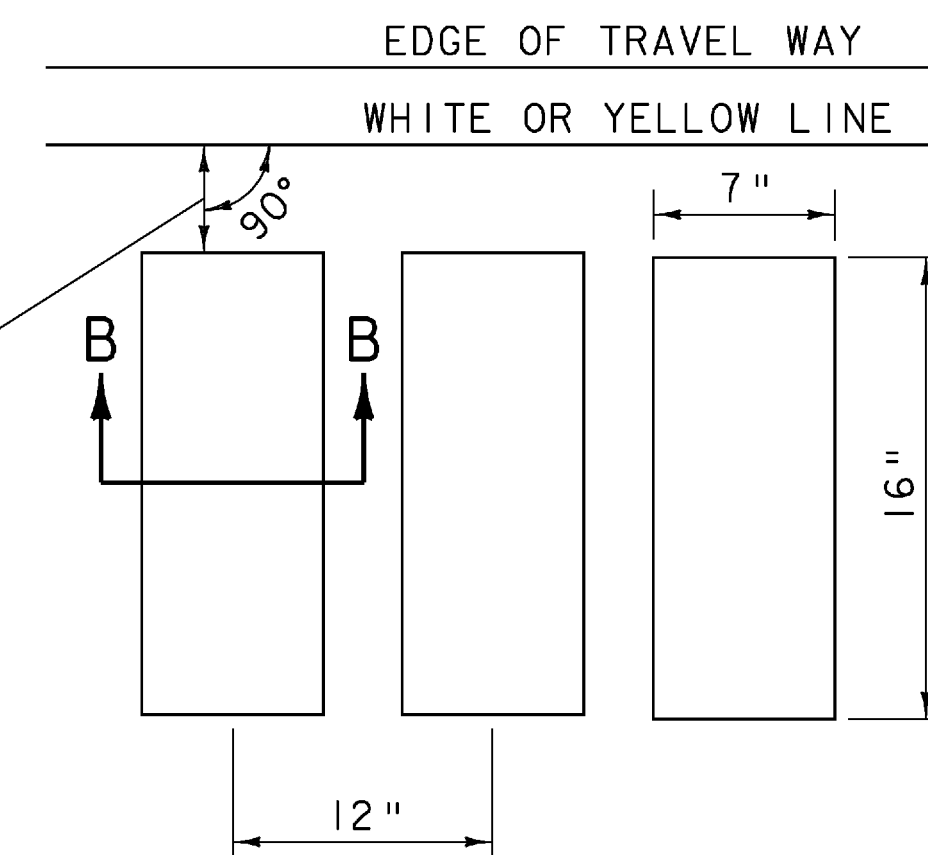


**TYPICAL MILLING DETAIL**  
N. T. S.

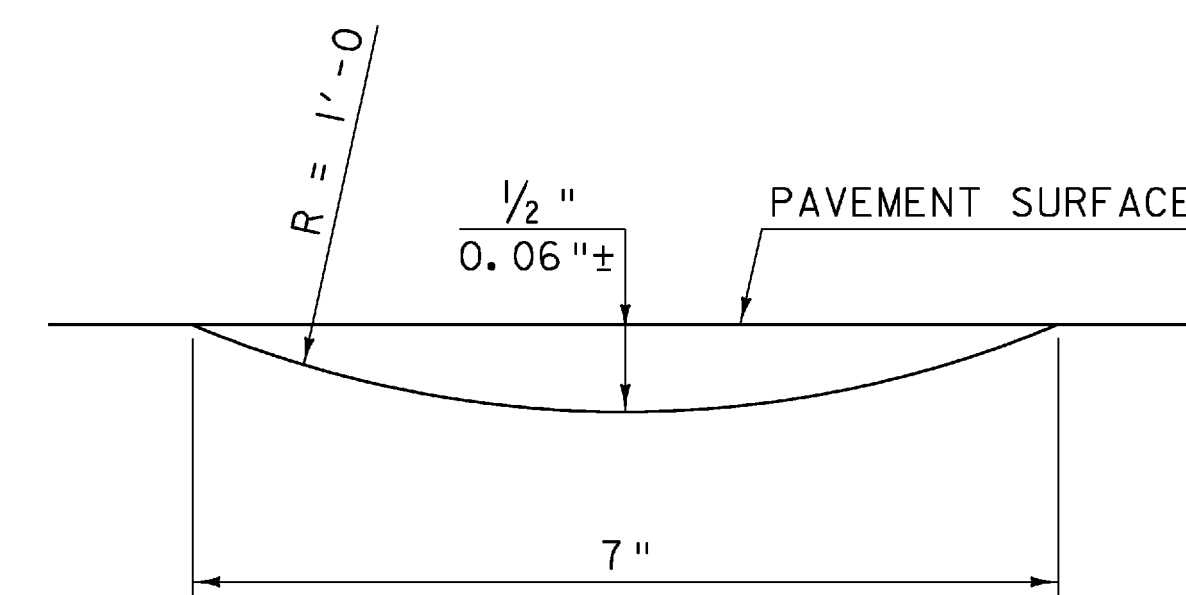


**SECTION B-B**  
N. T. S.

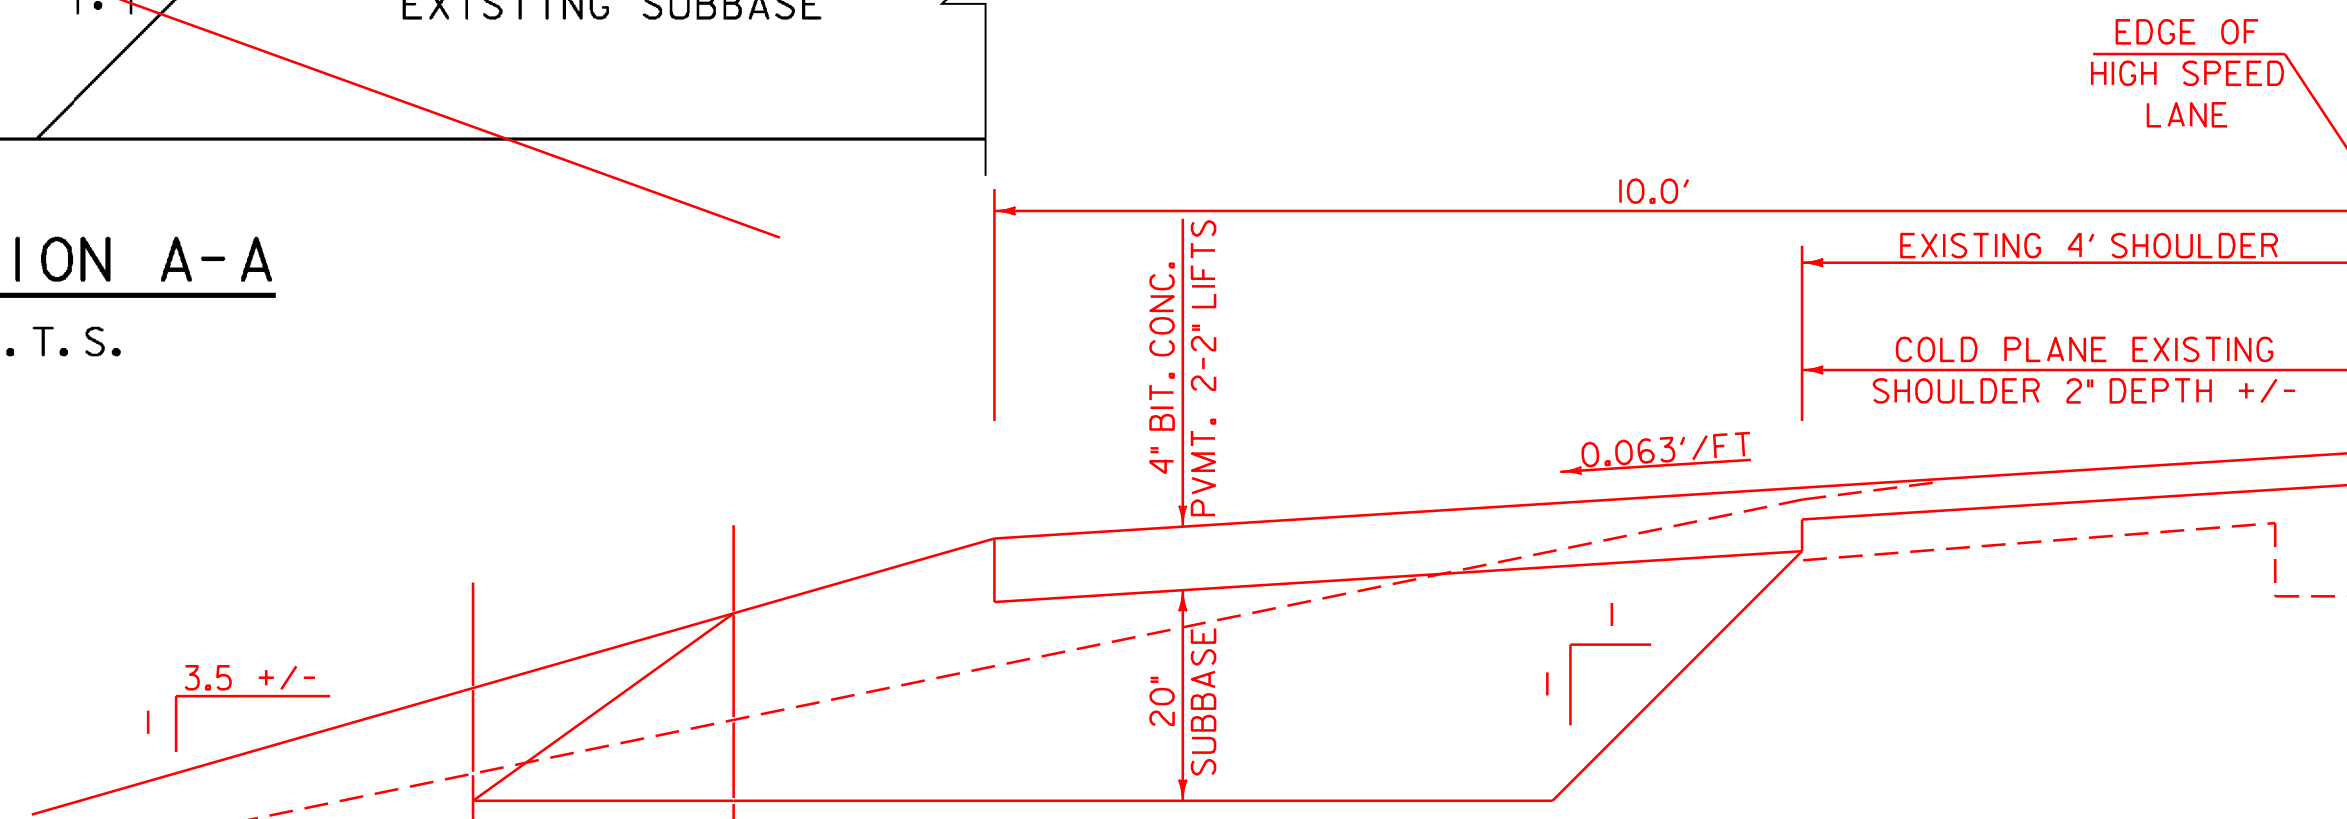


**SHOULDER WIDENING DETAILS**  
N.B. AND S.B. LANES  
N.T.S.

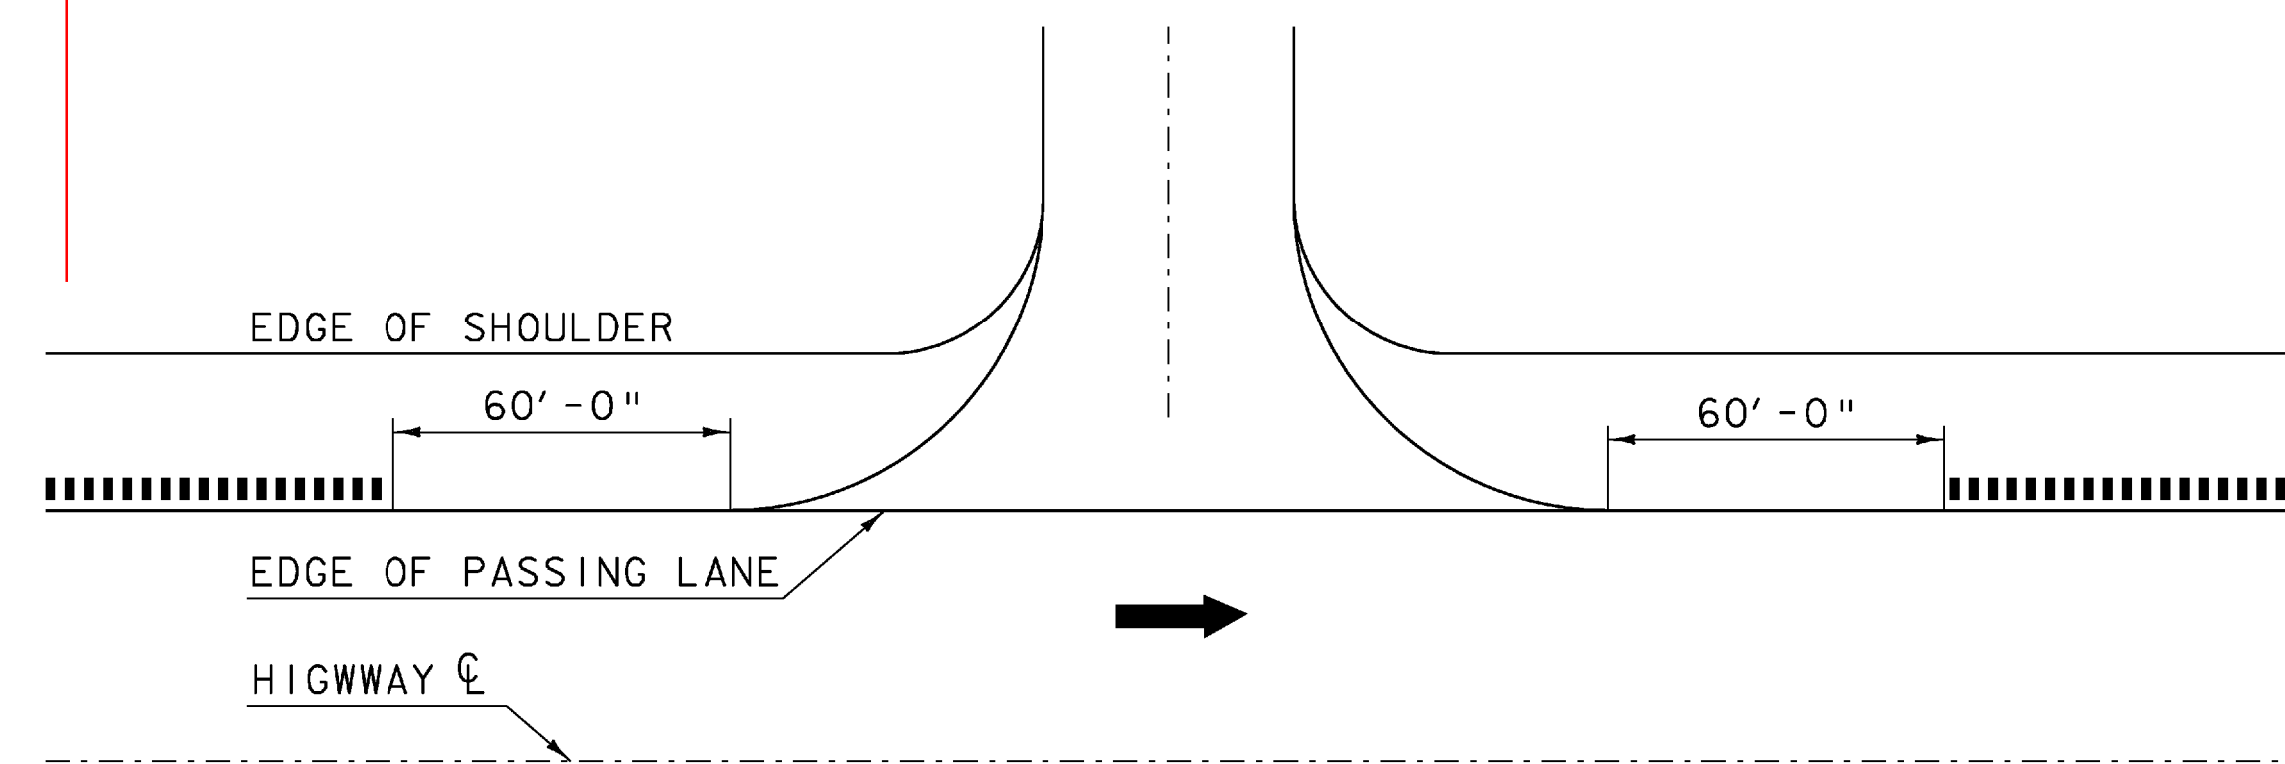


**U-TURN DETAIL**  
N. T. S.

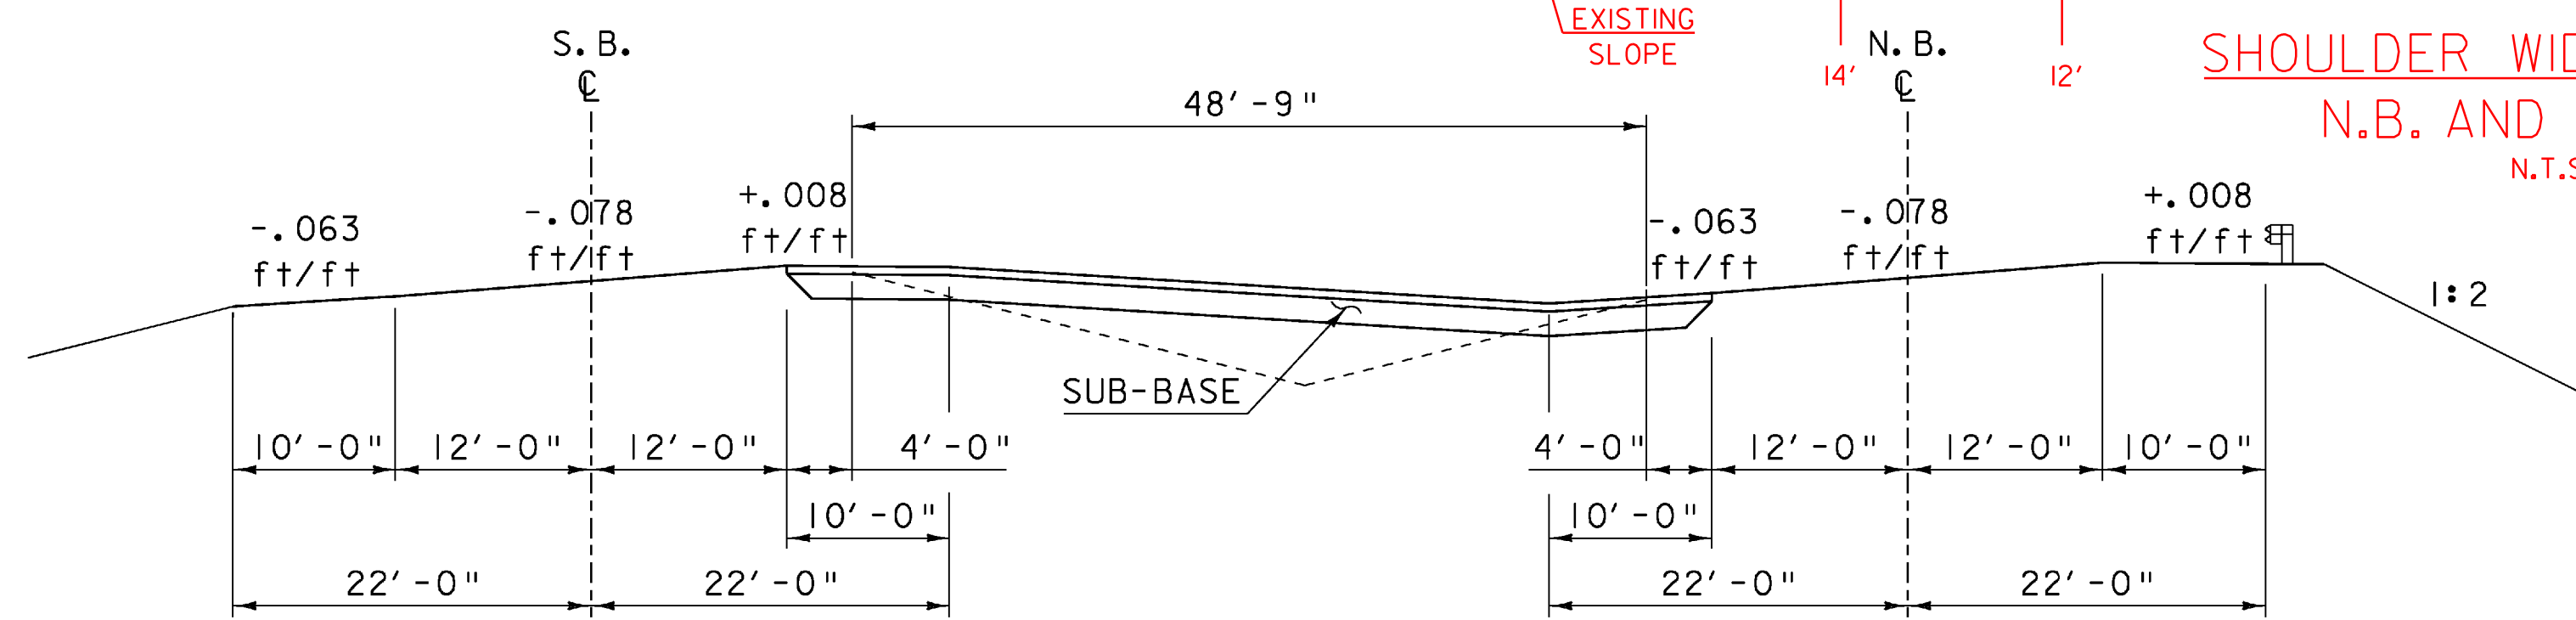

**U-TURN @ NORTHBOUND CL**  
STA 285+38.00  
SCALE 1"=10'-0"

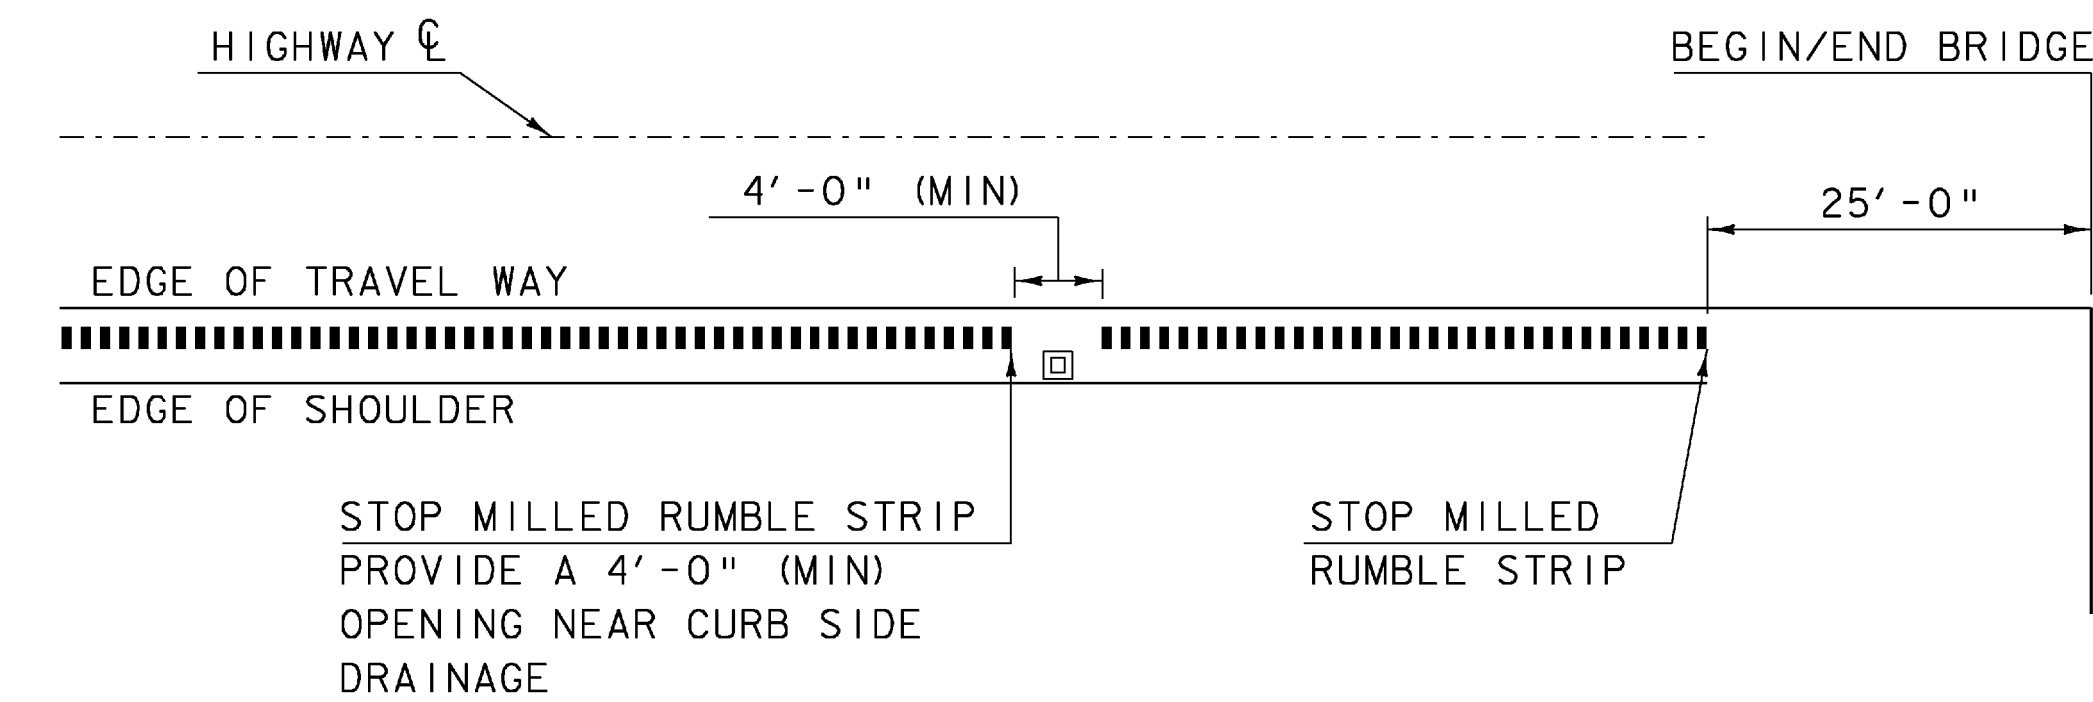

**DRAINAGE DETAIL**  
N. T. S.

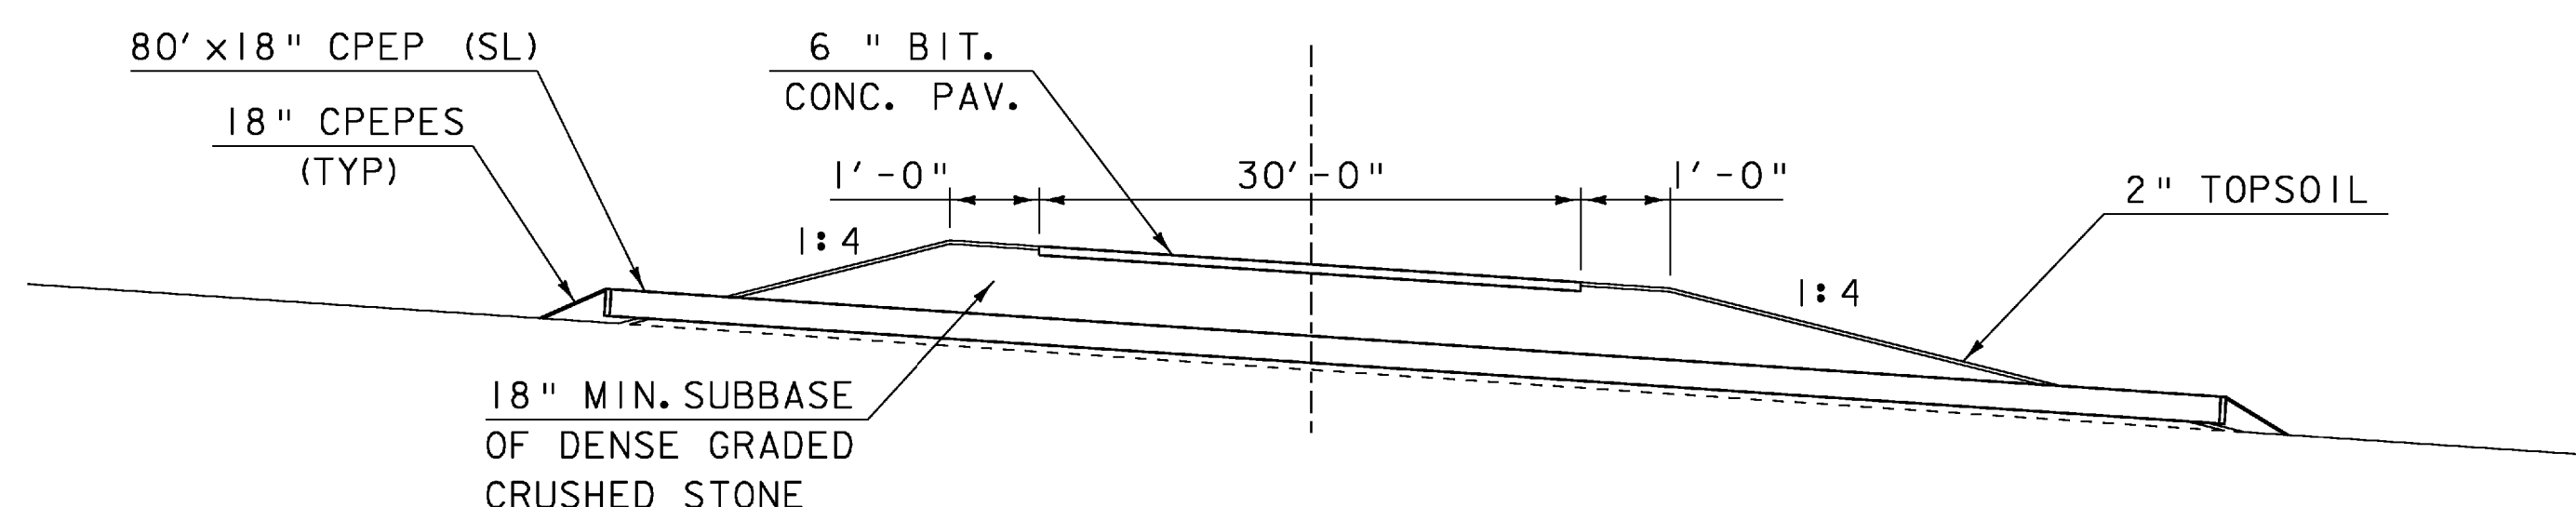

**U-TURN SECTION  
ALONG CL NEW PIPE**  
SCALE 1"=10'-0"

NOTE:  
THERE IS NO SURVEY FOR THIS SECTION  
OF THE PROJECT. AS SUCH NO ELEVATIONS  
ARE KNOWN AND THE EXISTING GROUND MAY  
DIFFER FROM THESE SECTIONS

SCALE 1" = 10'-0"  
10 0 10

PROJECT: <b>BERLIN</b>	PROJECT NO.: <b>IM 089-1 (20)</b>
DESIGN FILE NAME: 99a270\structures\s99a270gen.dgn	PLOT DATE: 05-DEC-2007
IPARM FILE NAME: s99a270turn.i	DESIGNED BY: G. SPILAK
SQUAD LEADER: C.P. WILLIAMS	DRAWN BY: C. MOONEY
U-TURN & RUMBLE STRIP DETAILS	CHECKED BY: R. S. YOUNG
	SHEET: 11 OF 104

GPS CONTROL POINTS

HVCTRL #1

STANDARD DISC STAMPED

JORDAN

\*\* N = 34440.2370  
E = 15507.9300  
ELEV. = 522.4400

GENERAL LOCATION, BERLIN, VT. TO REACH FROM THE INTERSECTION OF US ROUTE 2 (MEMORIAL DRIVE) AND VT ROUTE 12 (NORTHFIELD STREET) IN MONTPELIER GO SOUTH ALONG VT ROUTE 12 FOR 1.0 MI (1.6 KM) TO THE I-89 BRIDGES OVERHEAD. CONTINUE STRAIGHT AHEAD AND GO SOUTH ALONG VT ROUTE 12 FOR 0.6 MI (1.0 KM) TO THE INTERSECTION OF A GRAVEL DRIVE RIGHT LEADING TO A PUMP STATION AND THE SITE OF THE MARK ON THE RIGHT, NORTH OF THE DRIVE. IT IS ABOUT OPPOSITE THE NORTH SIDE OF THE WHEELS TRANSPORTATION BUILDING ON THE LEFT. THE MARK IS SET 20 CM BELOW GROUND SURFACE IN THE TOP OF A CAST ALUMINUM MONUMENT. IT IS 7.5 M (24.6 FT) WEST OF AND ABOUT 0.4 M (1.3 FT) LOWER THAN THE CENTERLINE OF VT ROUTE 12, 5.8 M (19.0 FT) NORTH OF THE CENTERLINE OF THE GRAVEL DRIVE, 27.5 M (90.2 FT) SOUTH OF POLE NO 60S, 26.5 M (86.9 FT) NORTHEAST OF THE NORTHEAST CORNER OF A SMALL WOOD PUMP STATION BUILDING, AND 0.4 M (1.3 FT) NORTH OF A FIBERGLASS WITNESS POST.

HVCTRL #2

STANDARD DISC STAMPED

 
 
 


JORDAN AZ

\*\* N = 35850.4340  
E = 15655.2000  
ELEV. = 527.7500

GENERAL LOCATION, BERLIN, VT. OWNERSHIP, KEN WESTON, 6261 ROUTE 12, BERLIN, VT 05602. TO REACH FROM THE INTERSECTION OF US ROUTE 2 (MEMORIAL DRIVE) AND VT ROUTE 12 (NORTHFIELD STREET) IN MONTPELIER GO SOUTH ALONG VT ROUTE 12 FOR 1.0 MI (1.6 KM) TO THE I-89 BRIDGES OVERHEAD. CONTINUE STRAIGHT AHEAD AND GO SOUTH ALONG VT ROUTE 12 FOR 0.3 MI (0.5 KM) TO THE INTERSECTION OF DOG RIVER ROAD RIGHT. TURN RIGHT AND GO NORTHWEST ALONG DOG RIVER ROAD FOR ABOUT 65 M (213.3 FT) TO THE SITE OF THE MARK ON THE LEFT, UNDER A POWERLINE. THE MARK IS SET IN THE TOP OF THE NORTHWEST END OF A MASSIVE ROCK OUTCROP WHICH PROJECTS ABOUT 1 M (3.3 FT) ABOVE GROUND SURFACE. IT IS 66.1 M (216.9 FT) NORTHWEST OF AND ABOUT LEVEL WITH THE CENTERLINE OF VT ROUTE 12, 68.4 M (224.4 FT) SOUTHWEST OF THE CENTERLINE OF DOG RIVER ROAD, 57.5 M (188.6 FT) SOUTH OF POLE NO 105, 54.2 M (177.8 FT) NORTH NORTHWEST OF POLE NO 368, 1.7 M (5.6 FT) NORTHEAST OF THE SOUTHWEST END OF THE OUTCROP, AND 1.4 M (4.6 FT) NORTHWEST OF A FIBERGLASS WITNESS POST.

\*\* TO ALLOW THE AGENCY DESIGN PLANE COORDINATES TO FIT THE STATE PLANE COORDINATES, ADD 600000 TO THE NORTHING & ADD 1600000 TO THE EASTINGS, TO THE ABOVE AND BELOW VALUES.  
\* DESCRIPTION PROVIDED BY VERMONT AGENCY OF TRANSPORTATION GEODETIC SURVEY UNIT






TRAVERSE TIES

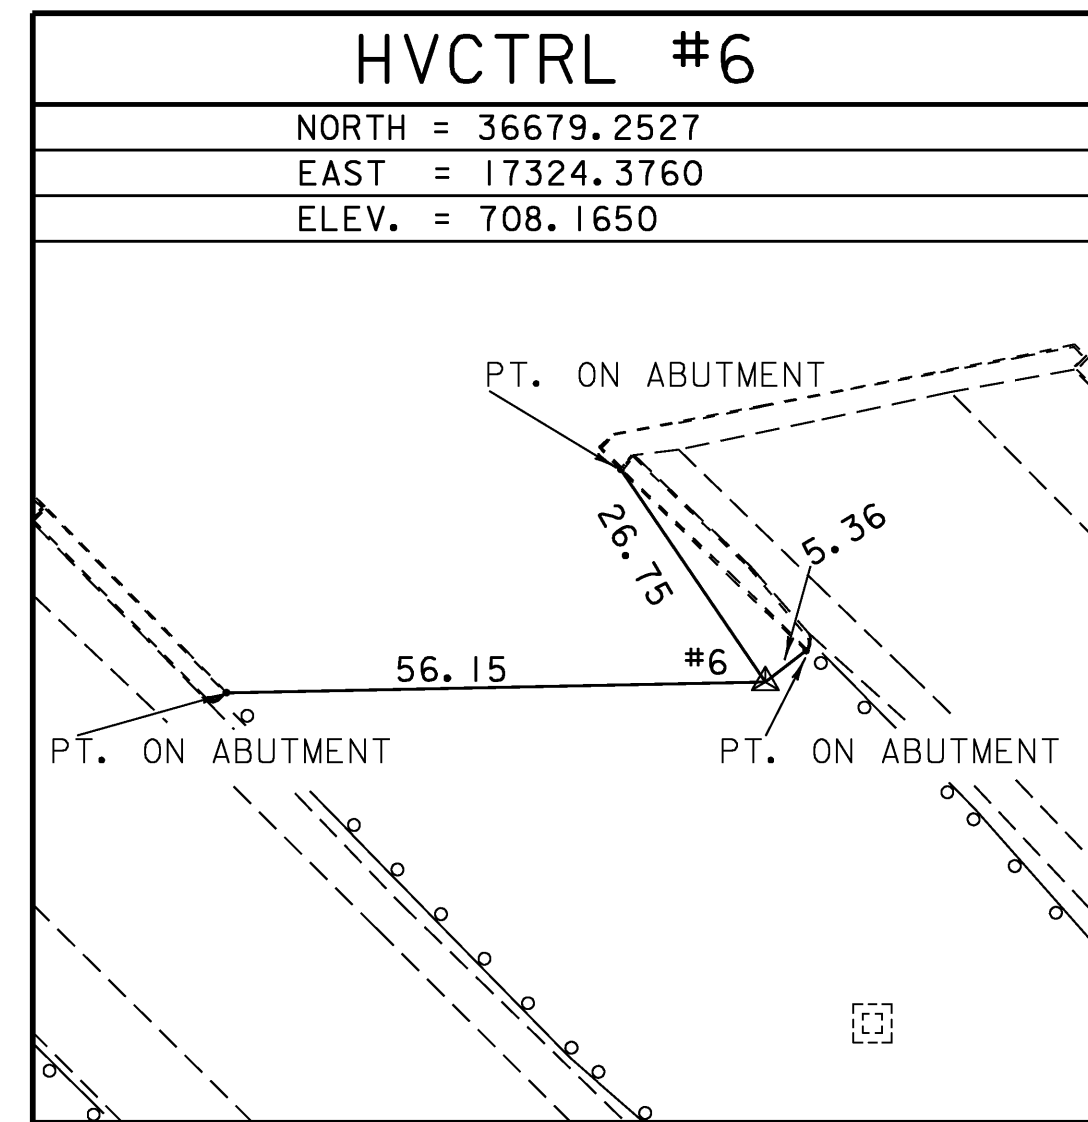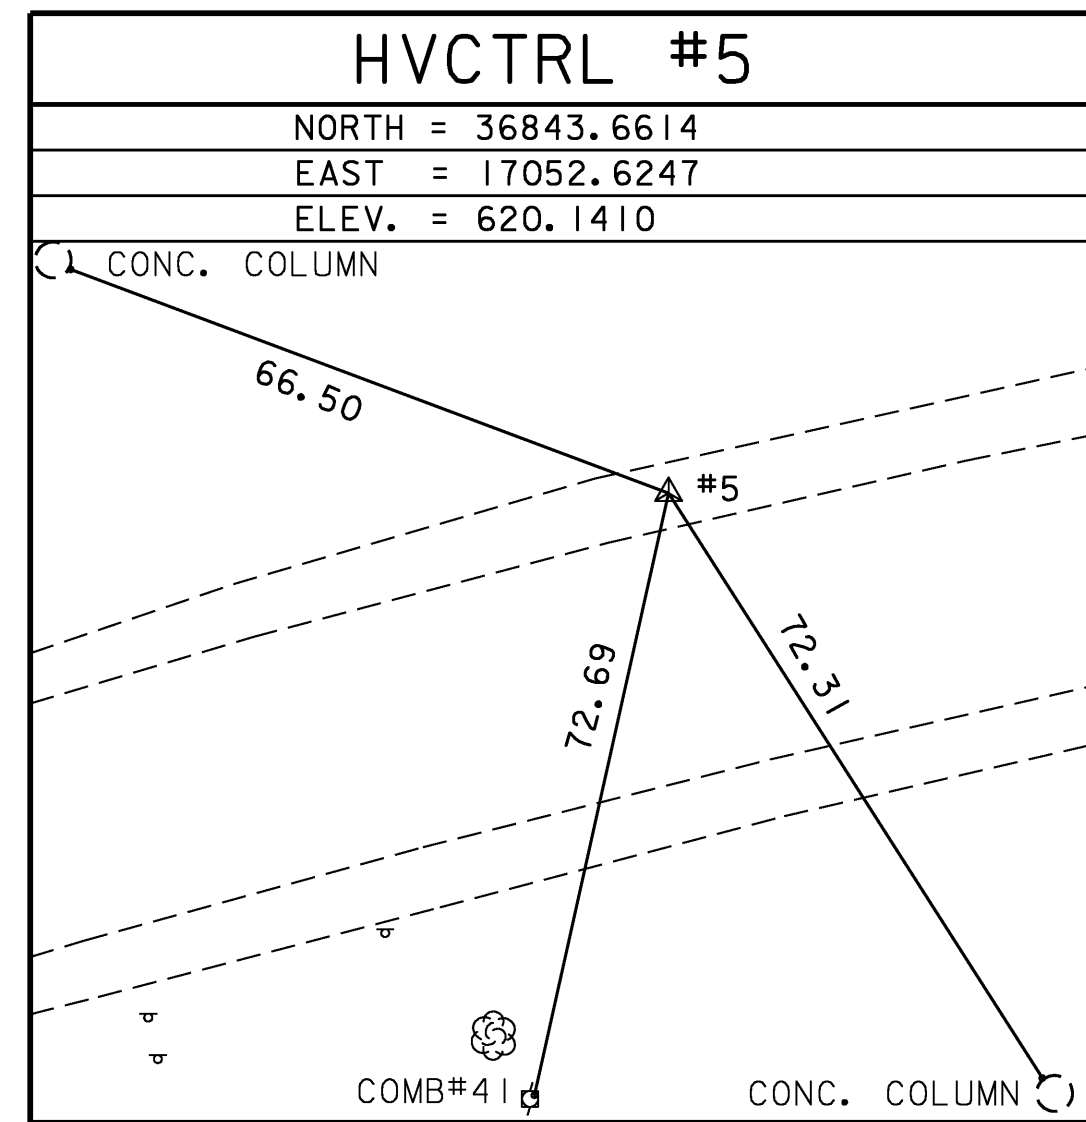

\* MAIN TRAVERSE COMPLETED: DECEMBER 2, 2001 BY R. GILMAN, P. WINTERS, & D. BREER

ALIGNMENT TIES

I-89 NORTHBOUND

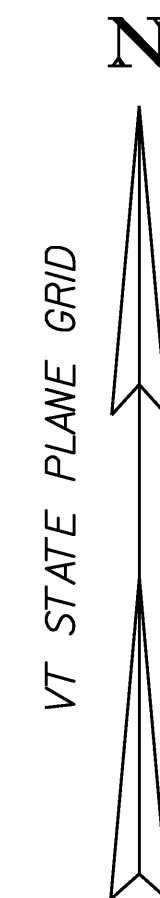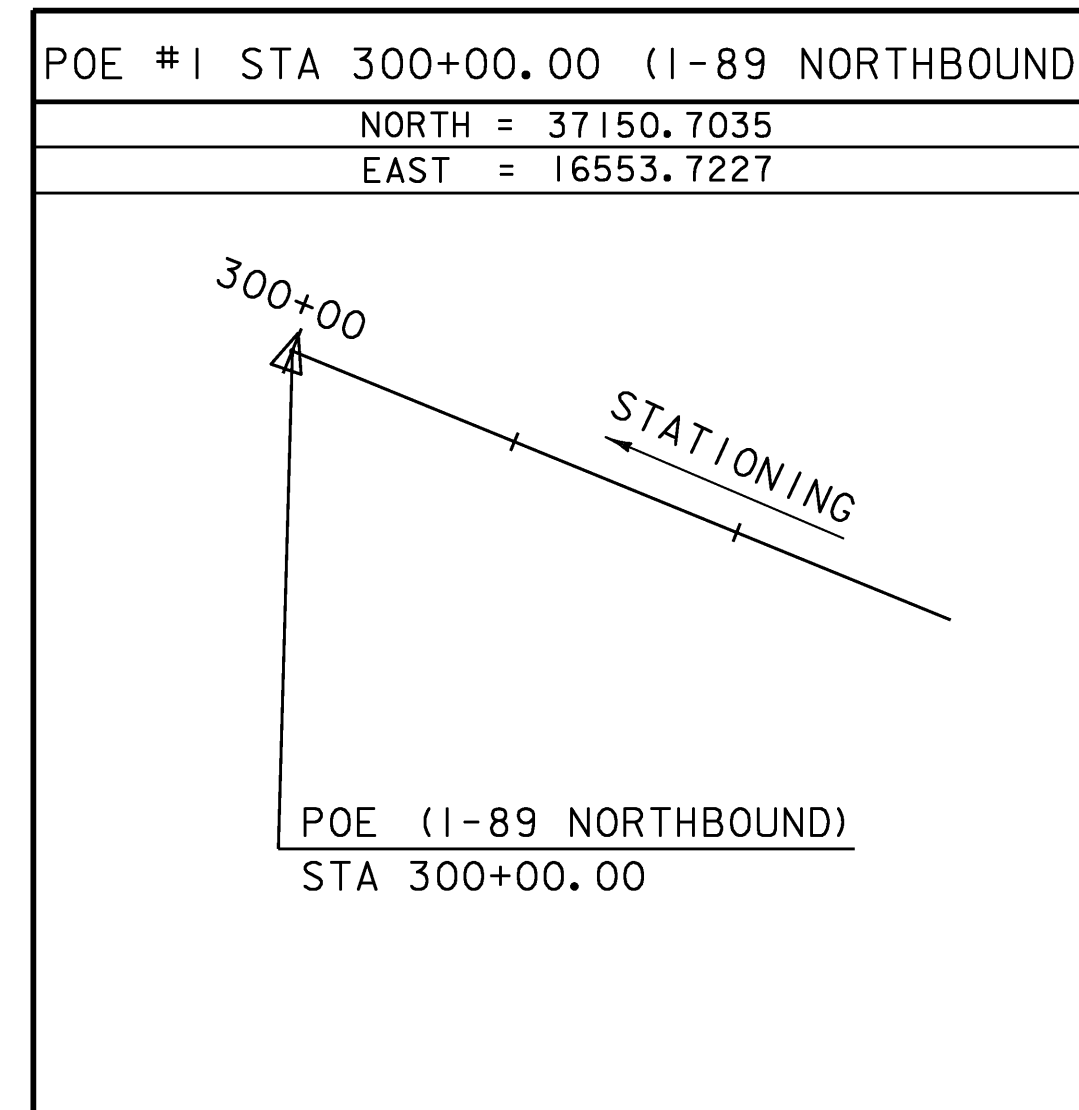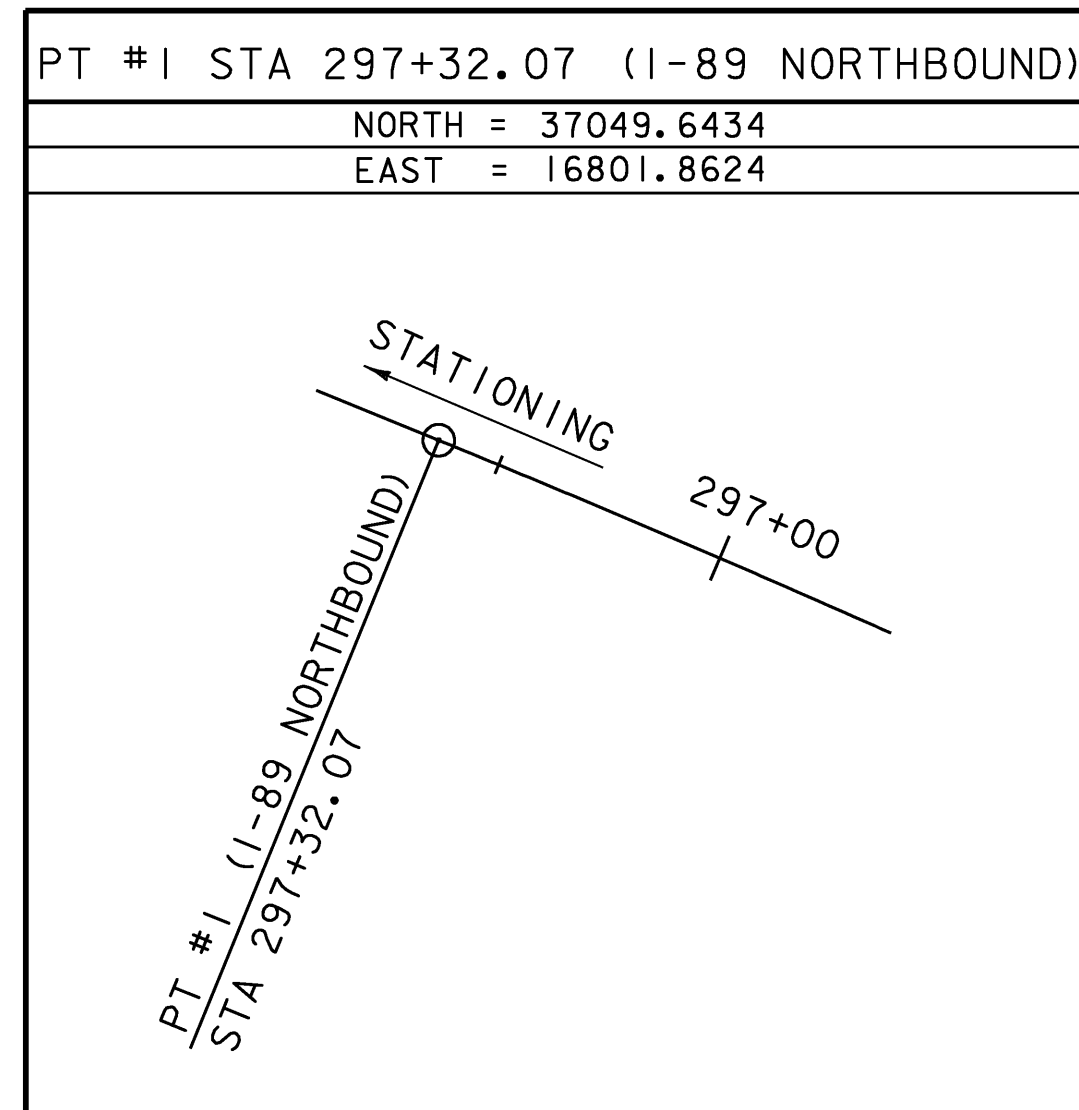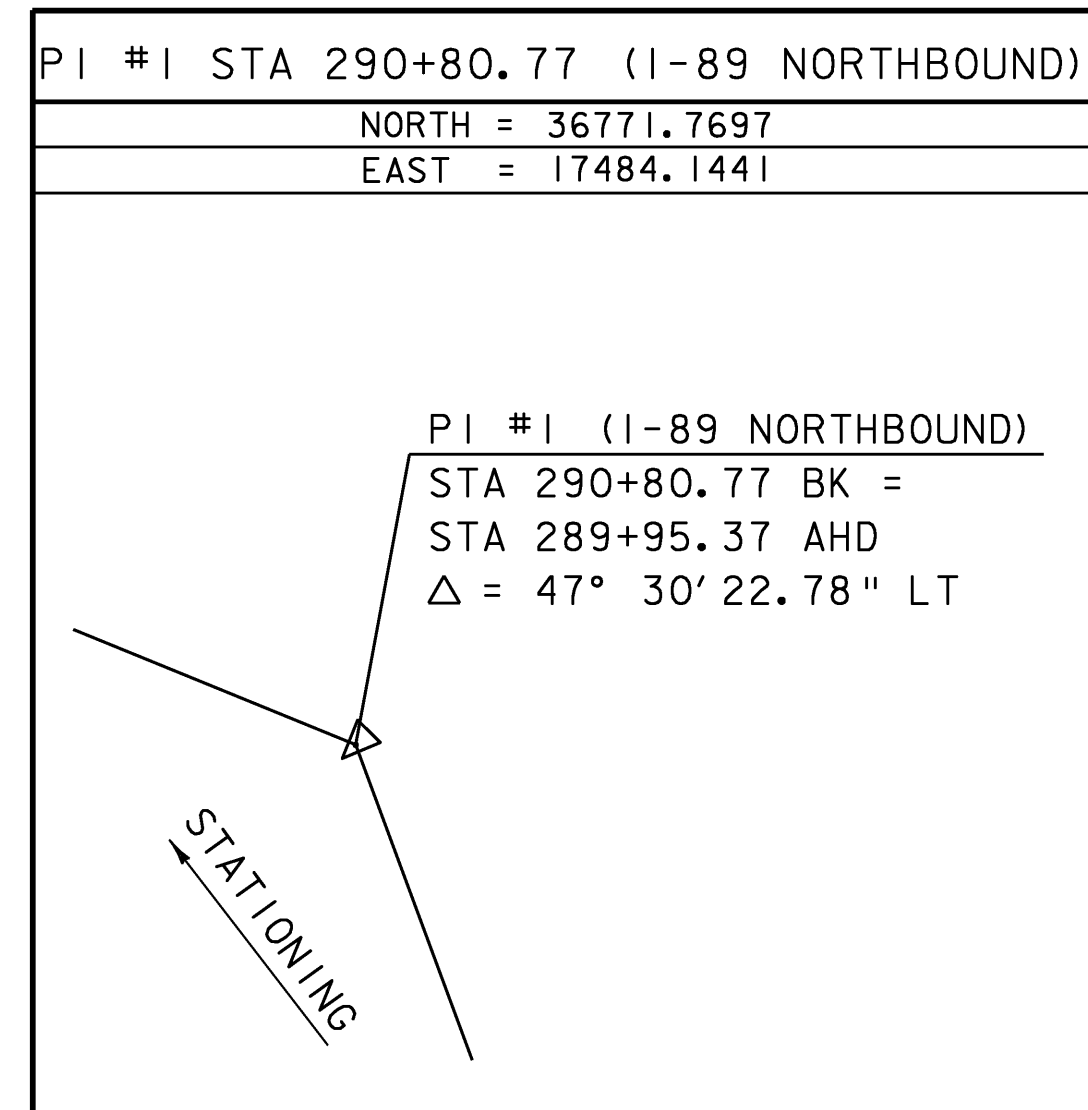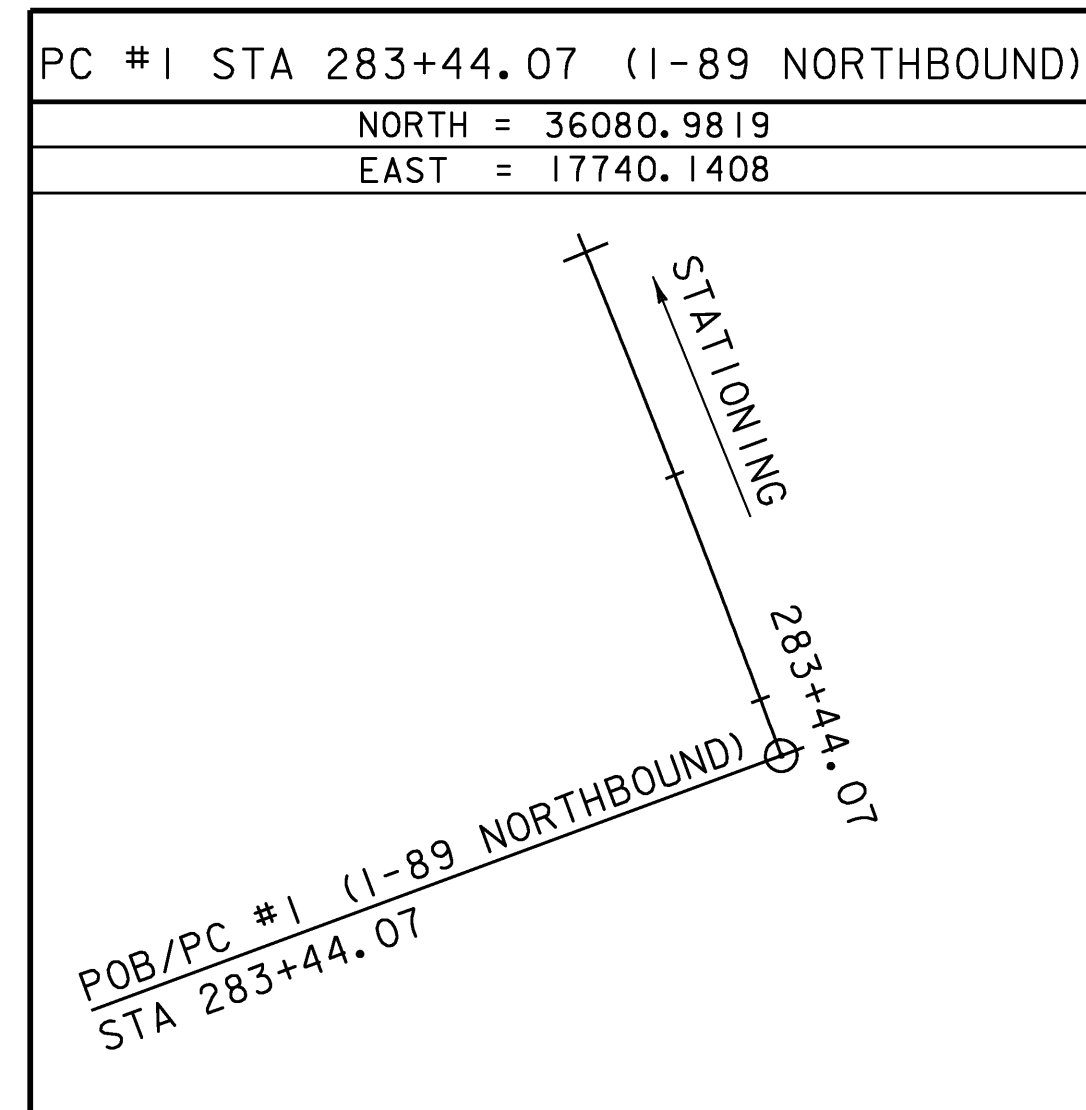






\* ALIGNMENT STAKED

<b>DATUM</b>	
VERTICAL	NAVD 88
HORIZONTAL	NAD-83 (96)
ADJUSTMENT	COMPASS

PROJECT NAME:	BERLIN
PROJECT NUMBER:	IM 089-1(20)
FILE NAME:	99a270/xa270+1.dgn
PROJECT LEADER:	S.FARNSWORTH
DESIGNED BY:	G.SPILAK
SURVEY & NORTHBOUND ALIGNMENT TIES	
PLOT DATE:	05-DEC-2007
DRAWN BY:	J. HULETT
CHECKED BY:	P. HODGE
SHEET	12 OF 104

ALIGNMENT TIES

I-89 SOUTHBOUND

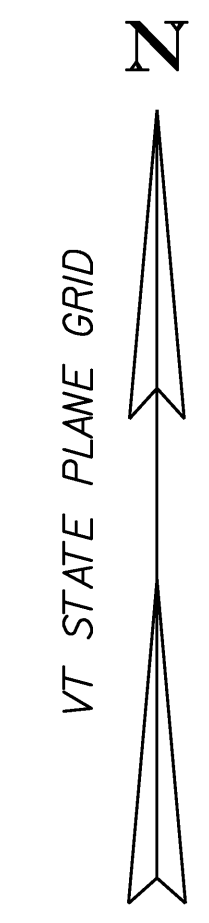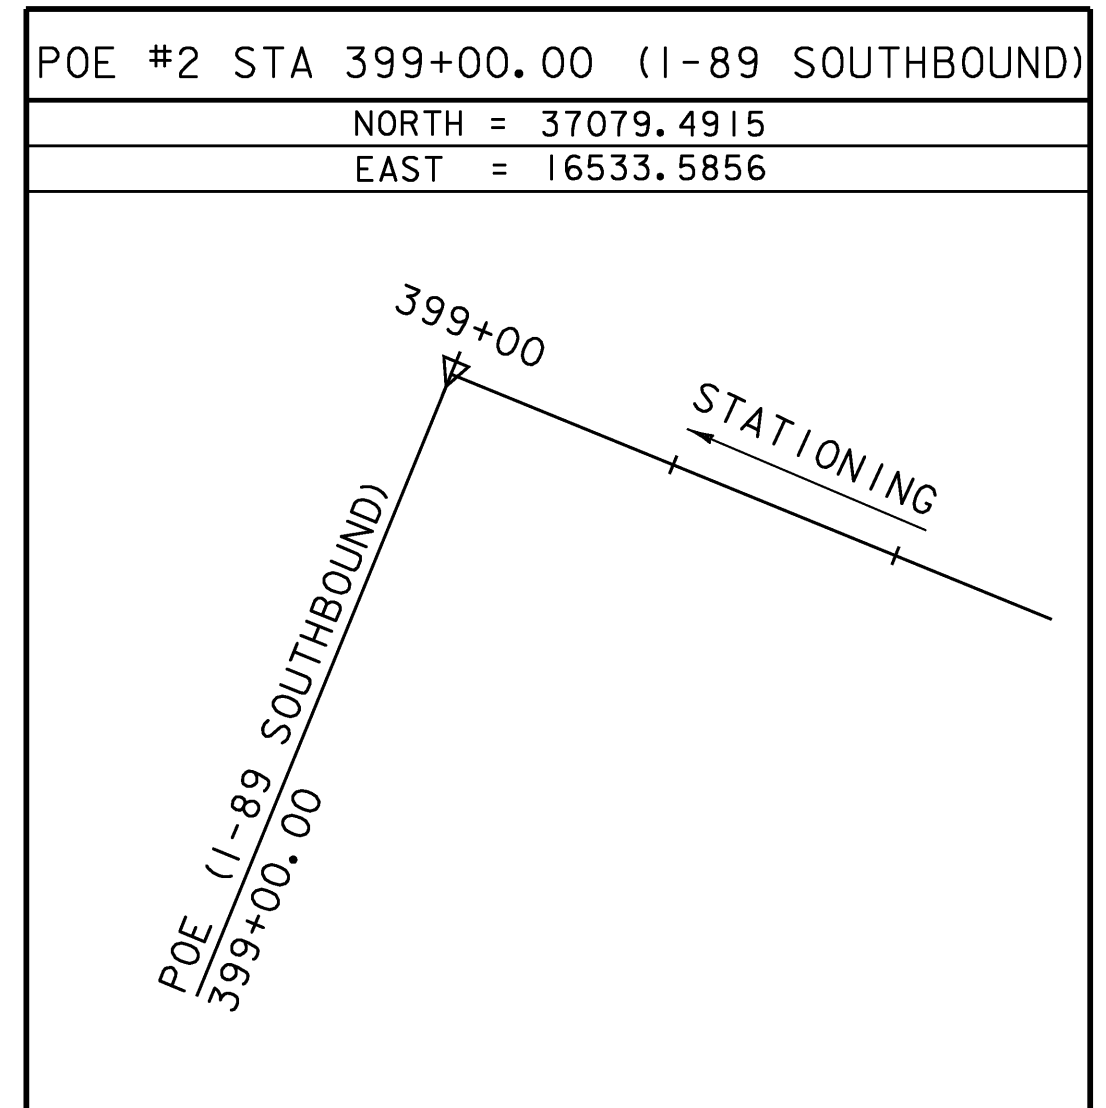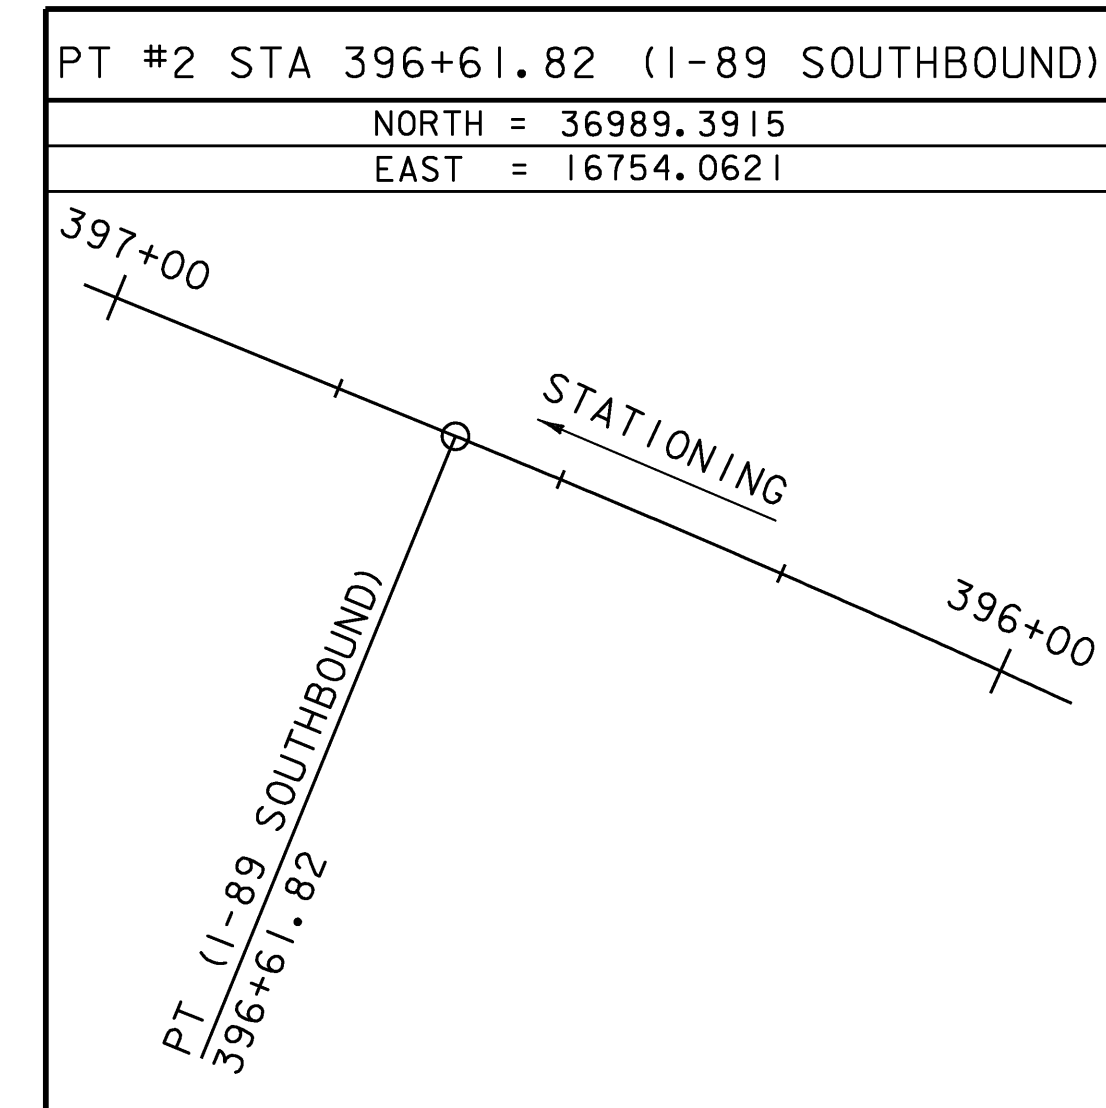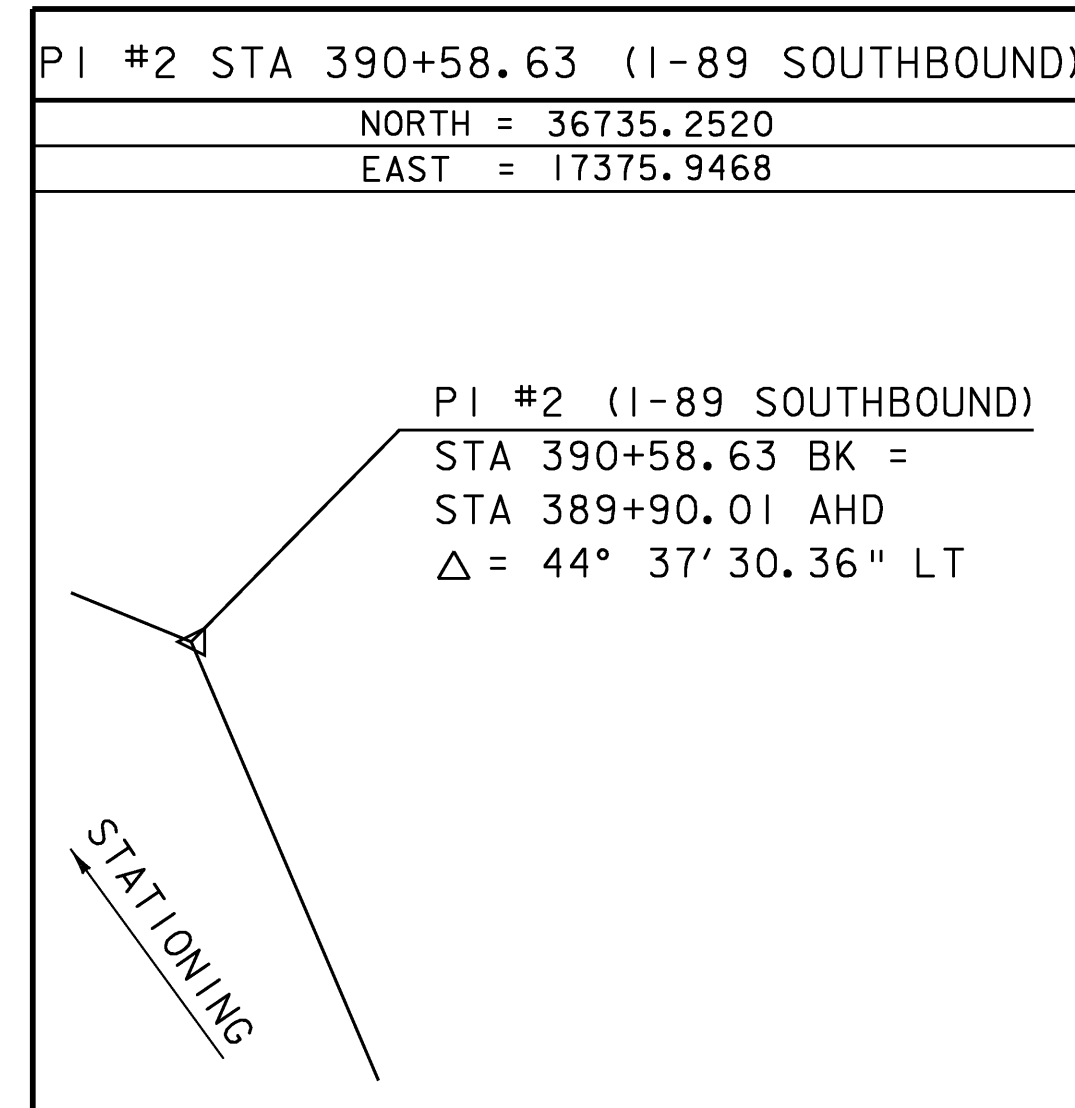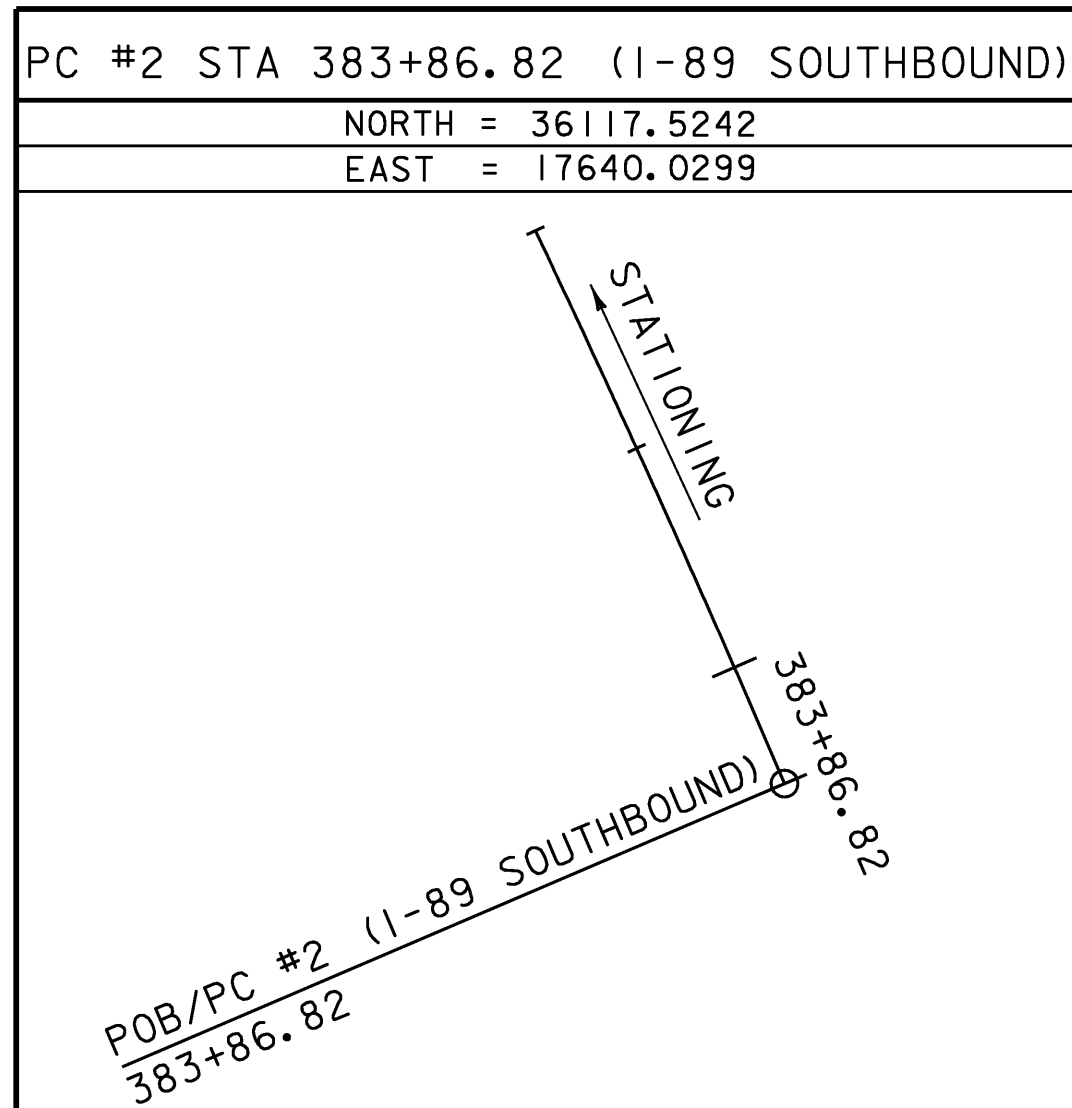

<b>DATUM</b>	
VERTICAL	NAVD 88
HORIZONTAL	NAD-83 (96)
ADJUSTMENT	COMPASS

PROJECT NAME:	BERLIN
PROJECT NUMBER:	IM 089-1(20)
FILE NAME:	99a270/s99a270+1.dgn
PROJECT LEADER:	C.P. WILLIAMS
DESIGNED BY:	G. SPILAK
SOUTHBOUND ALIGNMENT TIES	
PLOT DATE:	05-DEC-2007
DRAWN BY:	J. HULETT
CHECKED BY:	P. HODGE
SHEET	13 OF 104

REMOVAL AND DISPOSAL OF GUARDRAIL  
STA 288+34.60 - STA 290+00.00 LT



HD STEEL BEAM GUARDRAIL, GALVANIZED  
STA 286+60.30 - STA 290+00.00 LT

MANUFACTURED TERMINAL SECTION, FLARED  
STA 286+22.50 - STA 286+60.30 LT

REMOVING SIGNS  
STA 289+22 RT

TRAFFIC SIGNS, TYPE A  
MM 52.09 RT (NOT SHOWN)  
STA 289+22 RT  
ERECTING SALVAGED SIGNS  
285+00 LT  
285+71 LT

18" CPEP (SL) WITH 18" CPEPES  
STA 285+01.94 - STA 285+84.04 LT

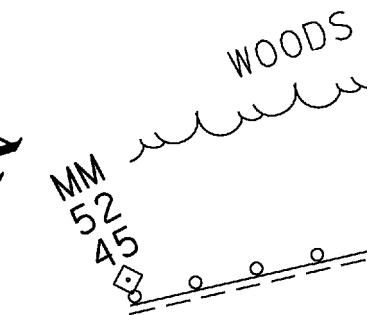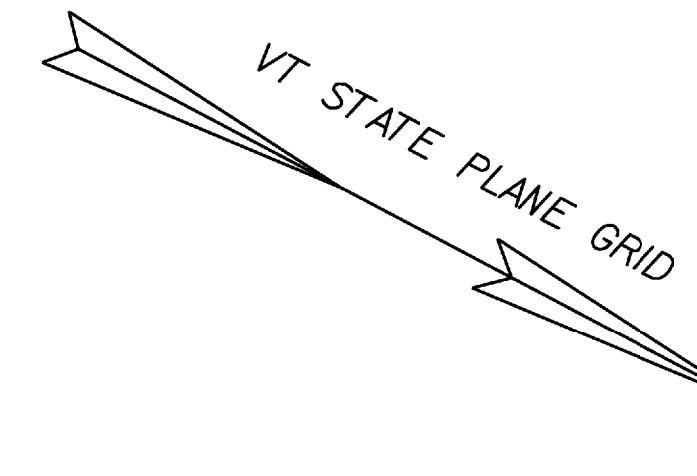

MACHINE STA 290+00

NEW U-TURN  
SEE SHEETS 10 & 11

I-89 SOUTHBOUND

BEGIN APPROACH  
STA 290+00.00  
289+82.00



CONSTRUCTION LIMITS  
WITH NEW U-TURN

I-89 NORTHBOUND

POB/PC #1 (I-89 NORTHBOUND)  
283+44.07

283+44 284+00 285+00 286+00 287+00 288+00 289+00

N20°20'02.49"W

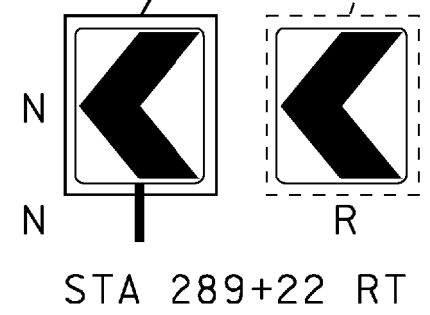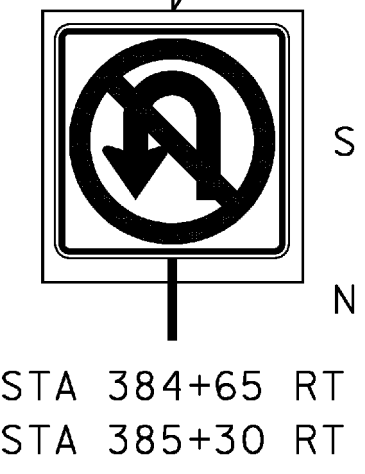

LAYOUT #1 (I-89 NORTHBOUND)

SCALE 1" = 20'-0"  
20 0 20

SIGN LEGEND
N - NEW SIGN & POST
R - REMOVE EXISTING SIGN AND POST

PROJECT: BERLIN	PROJECT NO. : IM 089-1 (20)
DESIGN FILE NAME: 99a270\structures\99a270bdr.dgn	PLOT DATE: 05-DEC-2007
IPARM FILE NAME: s99a270\al nb.i	DESIGNED BY: K.M.HIGGINS
SQUAD LEADER: C.P.WILLIAMS	DRAWN BY: D.D.BEARD
LAYOUT NORTHBOUND 1	CHECKED BY: R.S.YOUNG
	SHEET: 14 OF 104

MILLED RUMBLE STRIPS  
 STA 290+00.00 - STA 290+55.00 RT  
 STA 295+55.00 - STA 296+25.00 RT

DURABLE 6" WHITE LINE, THERMOPLASTIC  
 STA 290+00.00 - STA 296+25.00 RT  
 STA 290+00.00 - STA 296+25.00 DASHED C

DURABLE 6" YELLOW LINE, THERMOPLASTIC  
 STA 290+00.00 - STA 296+25.00 LT

REMOVAL AND DISPOSAL OF GUARDRAIL  
 STA 290+00.00 - STA 290+82.70 LT  
 STA 290+27.21 - STA 290+57.44 RT  
 STA 295+39.15 - STA 296+50.00 RT  
 STA 295+91.74 - STA 298+90.08 LT

SPECIAL PROVISION  
 (GUARDRAIL APPROACH SECTION,  
 TO F-SHAPE CONCRETE RAIL)  
 STA 290+51.75 - STA 290+82.70 LT  
 STA 290+27.20 - STA 290+57.45 RT  
 STA 295+91.75 - STA 296+22.70 LT  
 STA 295+39.15 - STA 295+69.35 RT

HD STEEL BEAM GUARDRAIL, GALVANIZED  
 STA 290+00.00 - STA 290+51.75 LT  
 STA 295+69.35 - STA 295+95.65 RT  
 STA 296+22.70 - STA 296+25.00 LT


REMOVING SIGNS  
 STA 290+49 RT  
 STA 291+67 RT  
 STA 292+93 RT  
 STA 294+11 RT

TRAFFIC SIGNS, TYPE A  
 STA 290+49 RT  
 STA 291+67 RT  
 STA 294+11 RT

ANCHOR FOR STEEL BEAM RAIL  
 STA 295+86.00 RT

CHANGING ELEVATION OF DROP INLET,  
 CATCH BASINS, OR MANHOLES  
 STA 296+11.60 LT

SPECIAL PROVISION  
 (BRIDGE RAILING, F-SHAPE CONCRETE).  
 STA 290+82.70 - STA 295+91.75 LT  
 STA 290+57.45 - STA 295+39.15 RT

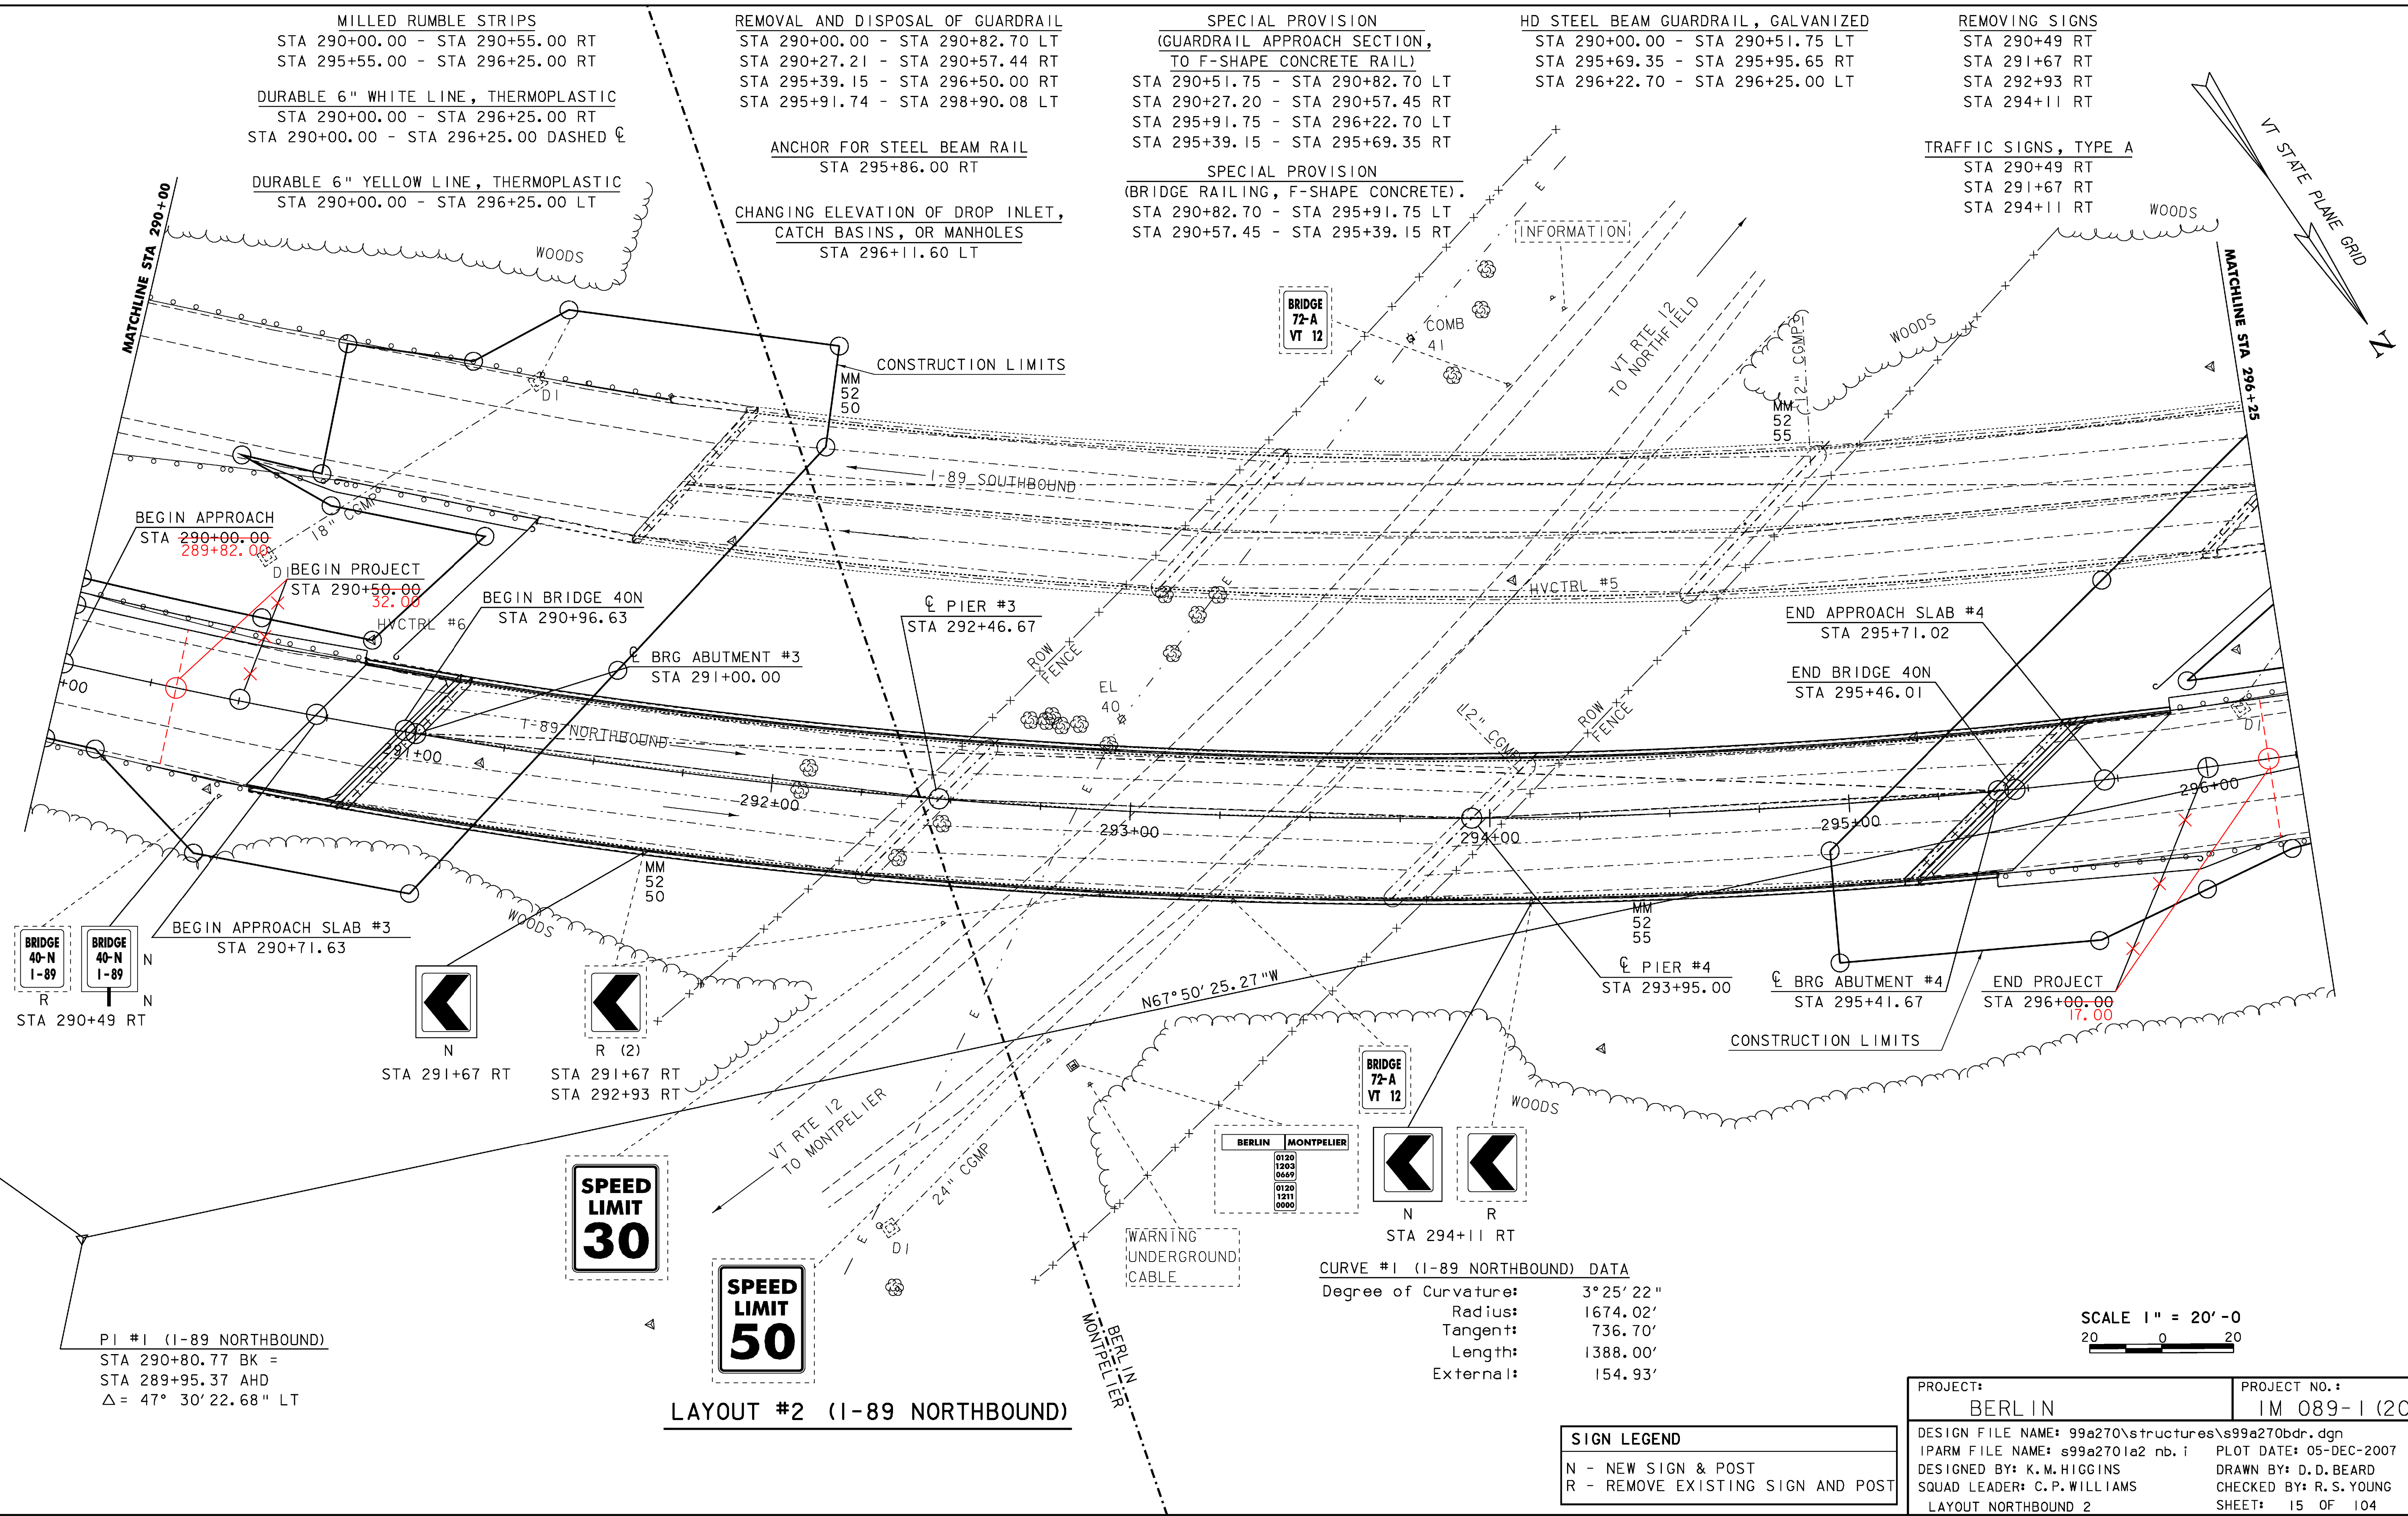

PI #1 (I-89 NORTHBOUND)  
 STA 290+80.77 BK =  
 STA 289+95.37 AHD  
 $\Delta = 47^\circ 30' 22.68''$  LT

LAYOUT #2 (I-89 NORTHBOUND)

CURVE #1 (I-89 NORTHBOUND) DATA

Degree of Curvature:	3° 25' 22"
Radius:	1674.02'
Tangent:	736.70'
Length:	1388.00'
External:	154.93'

SCALE 1" = 20' - 0  
 20 0 20

SIGN LEGEND

N	- NEW SIGN & POST
R	- REMOVE EXISTING SIGN AND POST

PROJECT: BERLIN	PROJECT NO. : IM 089-1 (20)
DESIGN FILE NAME: s99a270\structures\s99a270bdr.dgn	PLOT DATE: 05-DEC-2007
IPARM FILE NAME: s99a270\1a2 nb.i	DRAWN BY: D.D. BEARD
DESIGNED BY: K.M. HIGGINS	CHECKED BY: R.S. YOUNG
SQUAD LEADER: C.P. WILLIAMS	SHEET: 15 OF 104
LAYOUT NORTHBOUND 2	

**ANCHOR FOR STEEL BEAM RAIL**  
296+50.00 LT

**REMOVAL AND DISPOSAL OF GUARDRAIL**  
STA 296+25.00 - STA 298+80.00 LT

**HD STEEL GUARDRAIL, GALVANIZED**  
STA 296+25.00 - STA ~~297+62.50~~ **296+50.00** LT

**MANUFACTURED TERMINAL SECTION, FLARED**  
~~STA 297+62.50 - STA 298+00.00~~ LT

**REMOVAL OF SIGNS**  
STA 297+29.00 RT  
STA 300+37 LT  
STA 301+02 LT

**TRAFFIC SIGN, TYPE A**  
STA 297+29.00 RT



**ERECTING SALVAGED SIGNS**  
PLACE SALVAGED SIGN FROM STA 297+29 RT AS SHOWN ON DETOUR SHEET 32, PRIOR TO DETOURING TRAFFIC. ONCE NORTHBOUND CONSTRUCTION IS COMPLETED, PLACE AT MM 52.85 RT

**DURABLE 6" WHITE LINE, THERMOPLASTIC**  
STA 296+25.00 - STA 296+50.00 RT  
STA 296+25.00 - STA 296+50.00 DASHED C

**DURABLE 6" YELLOW LINE, THERMOPLASTIC**  
STA 296+25.00 - STA 296+50.00 LT

**MILLED RUMBLE STRIPS**  
STA 296+25.00 - STA 296+50.00 RT

**EXISTING U-TURN TO BE REMOVED**  
SEE NOTE 17 SHEET 10

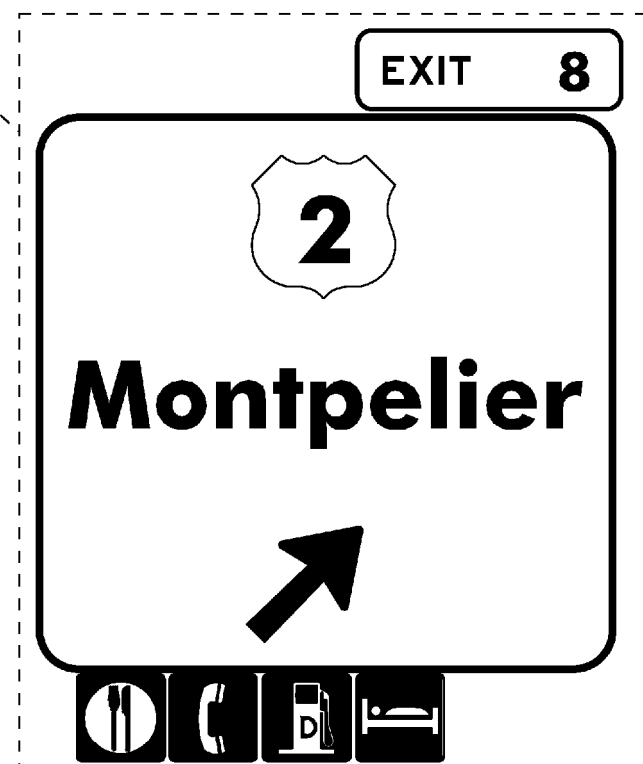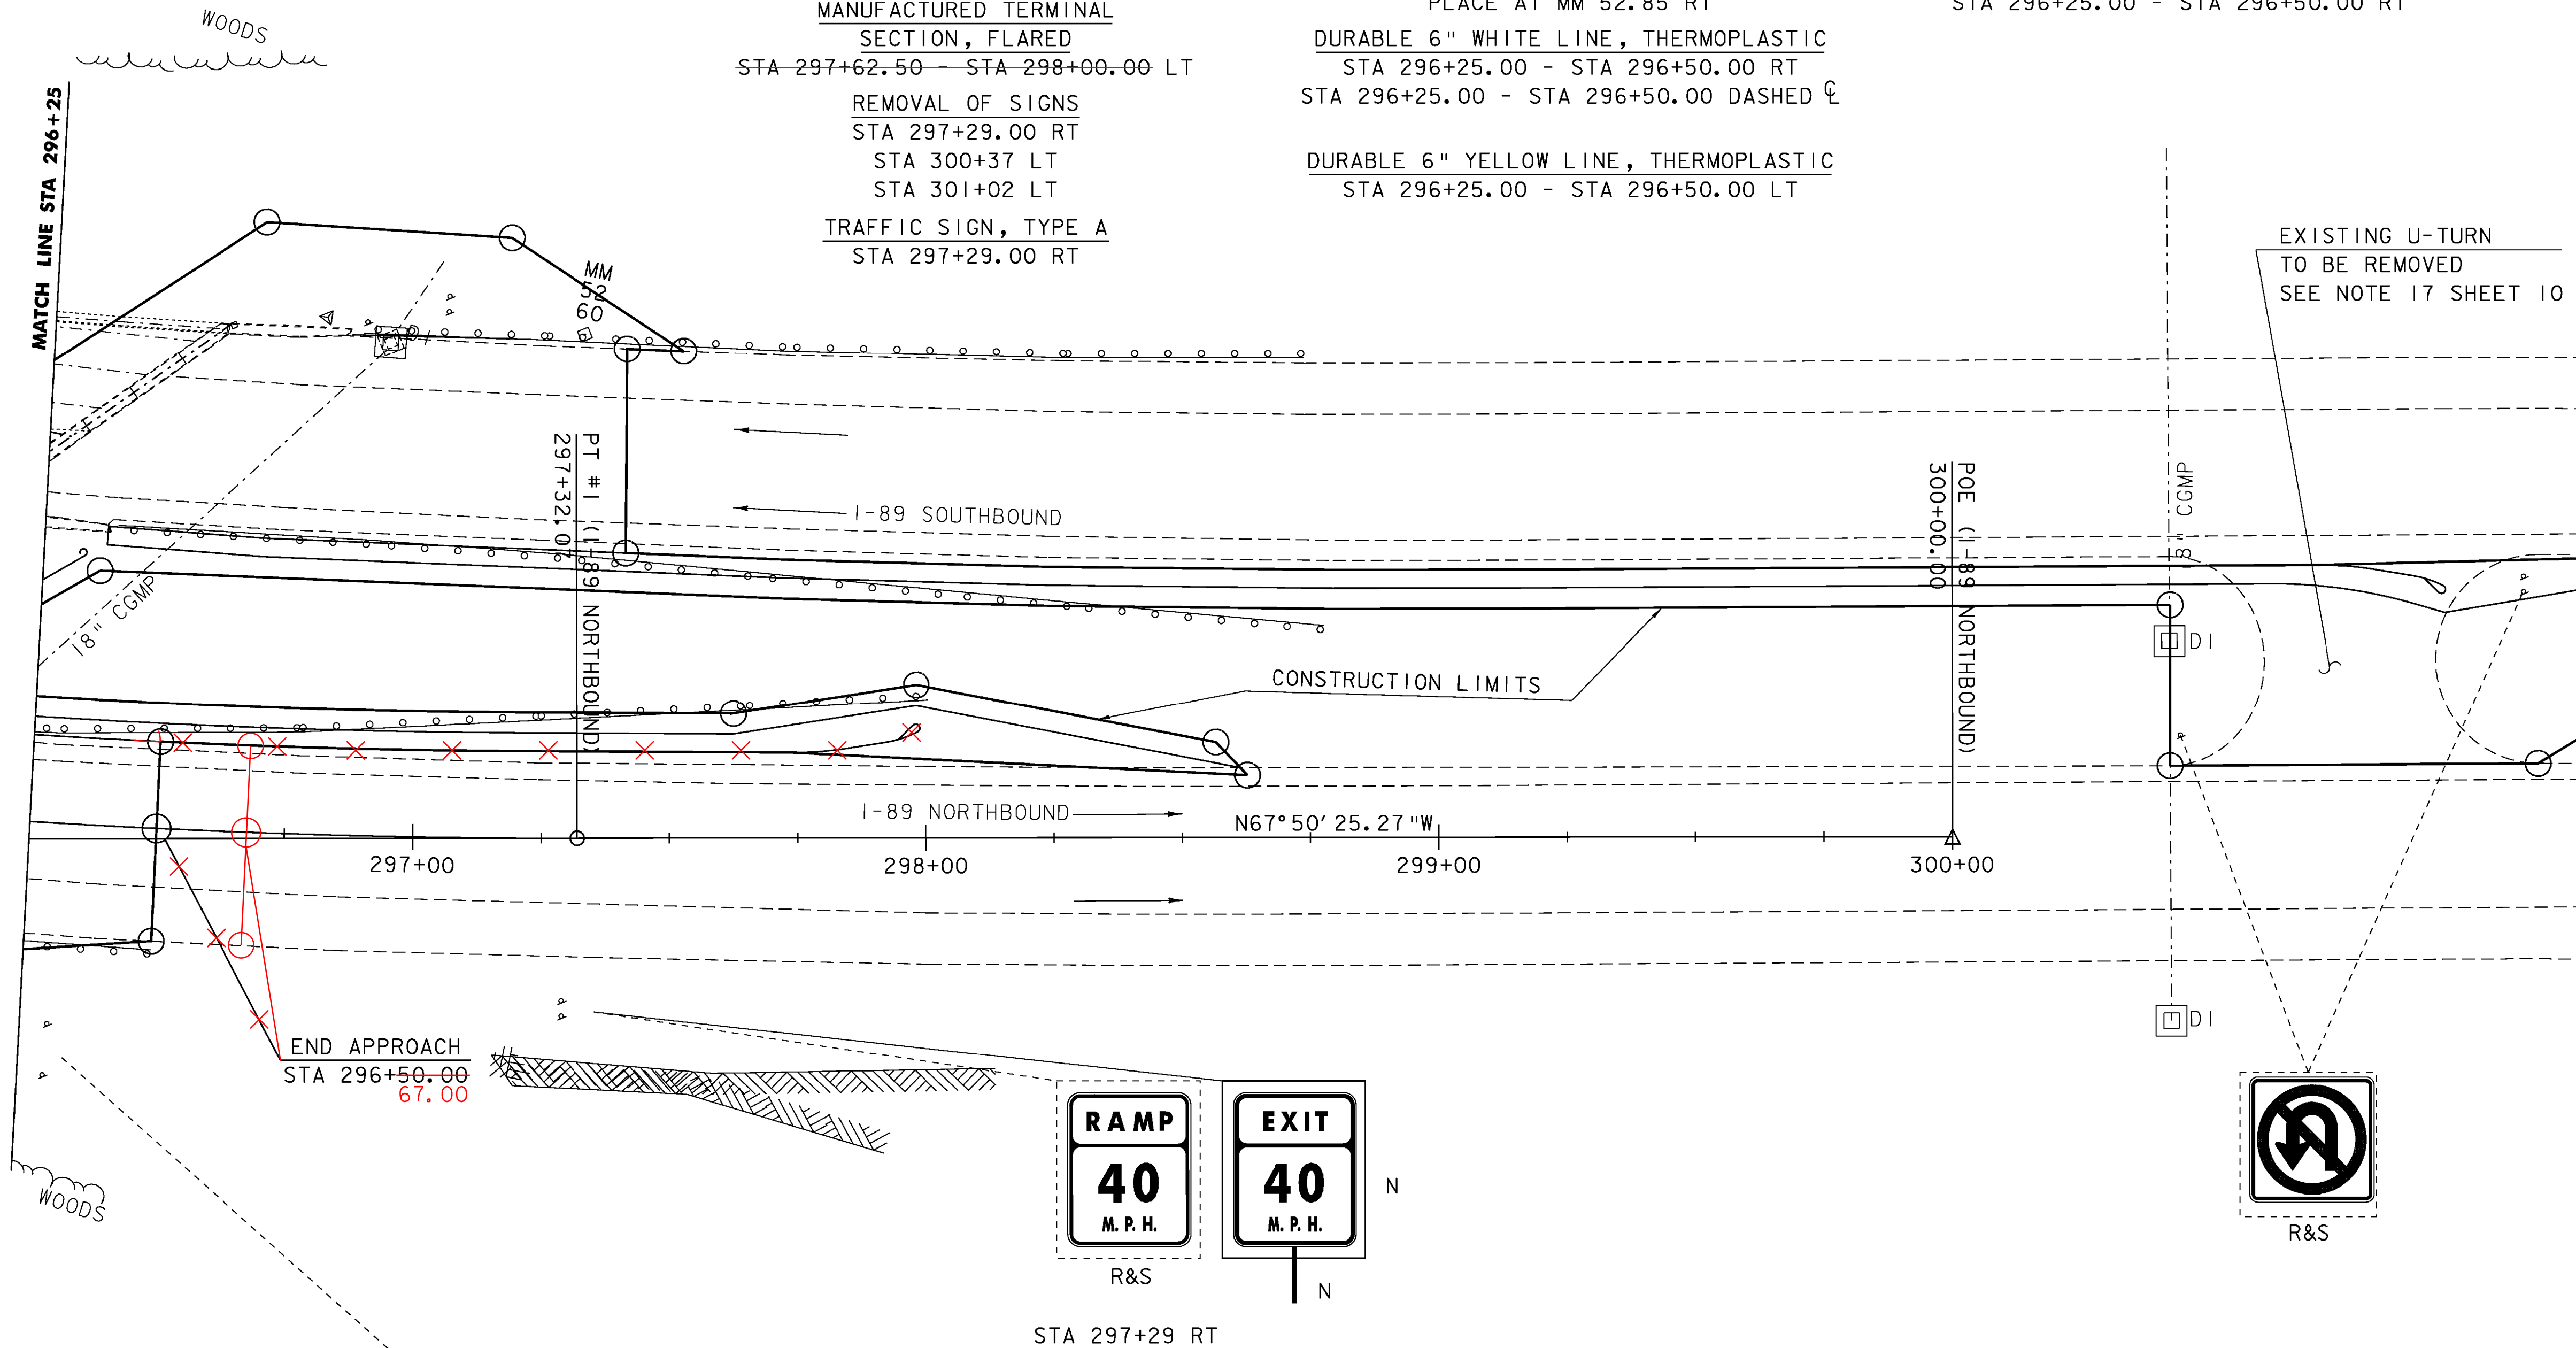



**LAYOUT #3 (I-89 NORTHBOUND)**

SCALE 1" = 20'-0"  
20 0 20


SIGN LEGEND	
N	- NEW
R	- REMOVE
RET	- RETAIN
R&S	- REMOVE & SALVAGE
S	- ERECTING SALVAGED SIGNS

PROJECT: <b>BERLIN</b>	PROJECT NO.: <b>IM 089-1 (20)</b>
DESIGN FILE NAME: 99a270\structures\99a270bdr.dgn	PLOT DATE: 05-DEC-2007
IPARM FILE NAME: s99a2701a3 nb.i	DRAWN BY: D.D.BEARD
DESIGNED BY: K.M.HIGGINS	CHECKED BY: R.S.YOUNG
SQUAD LEADER: C.P.WILLIAMS	SHEET: 16 OF 104
LAYOUT NORTHBOUND 3	

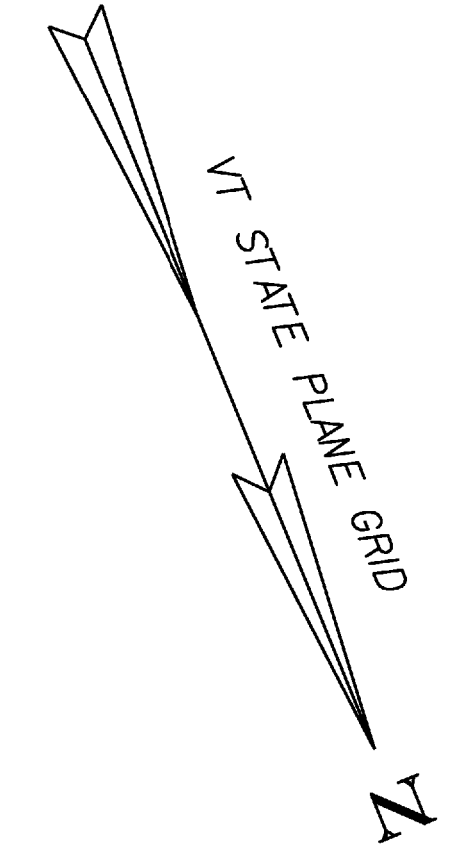


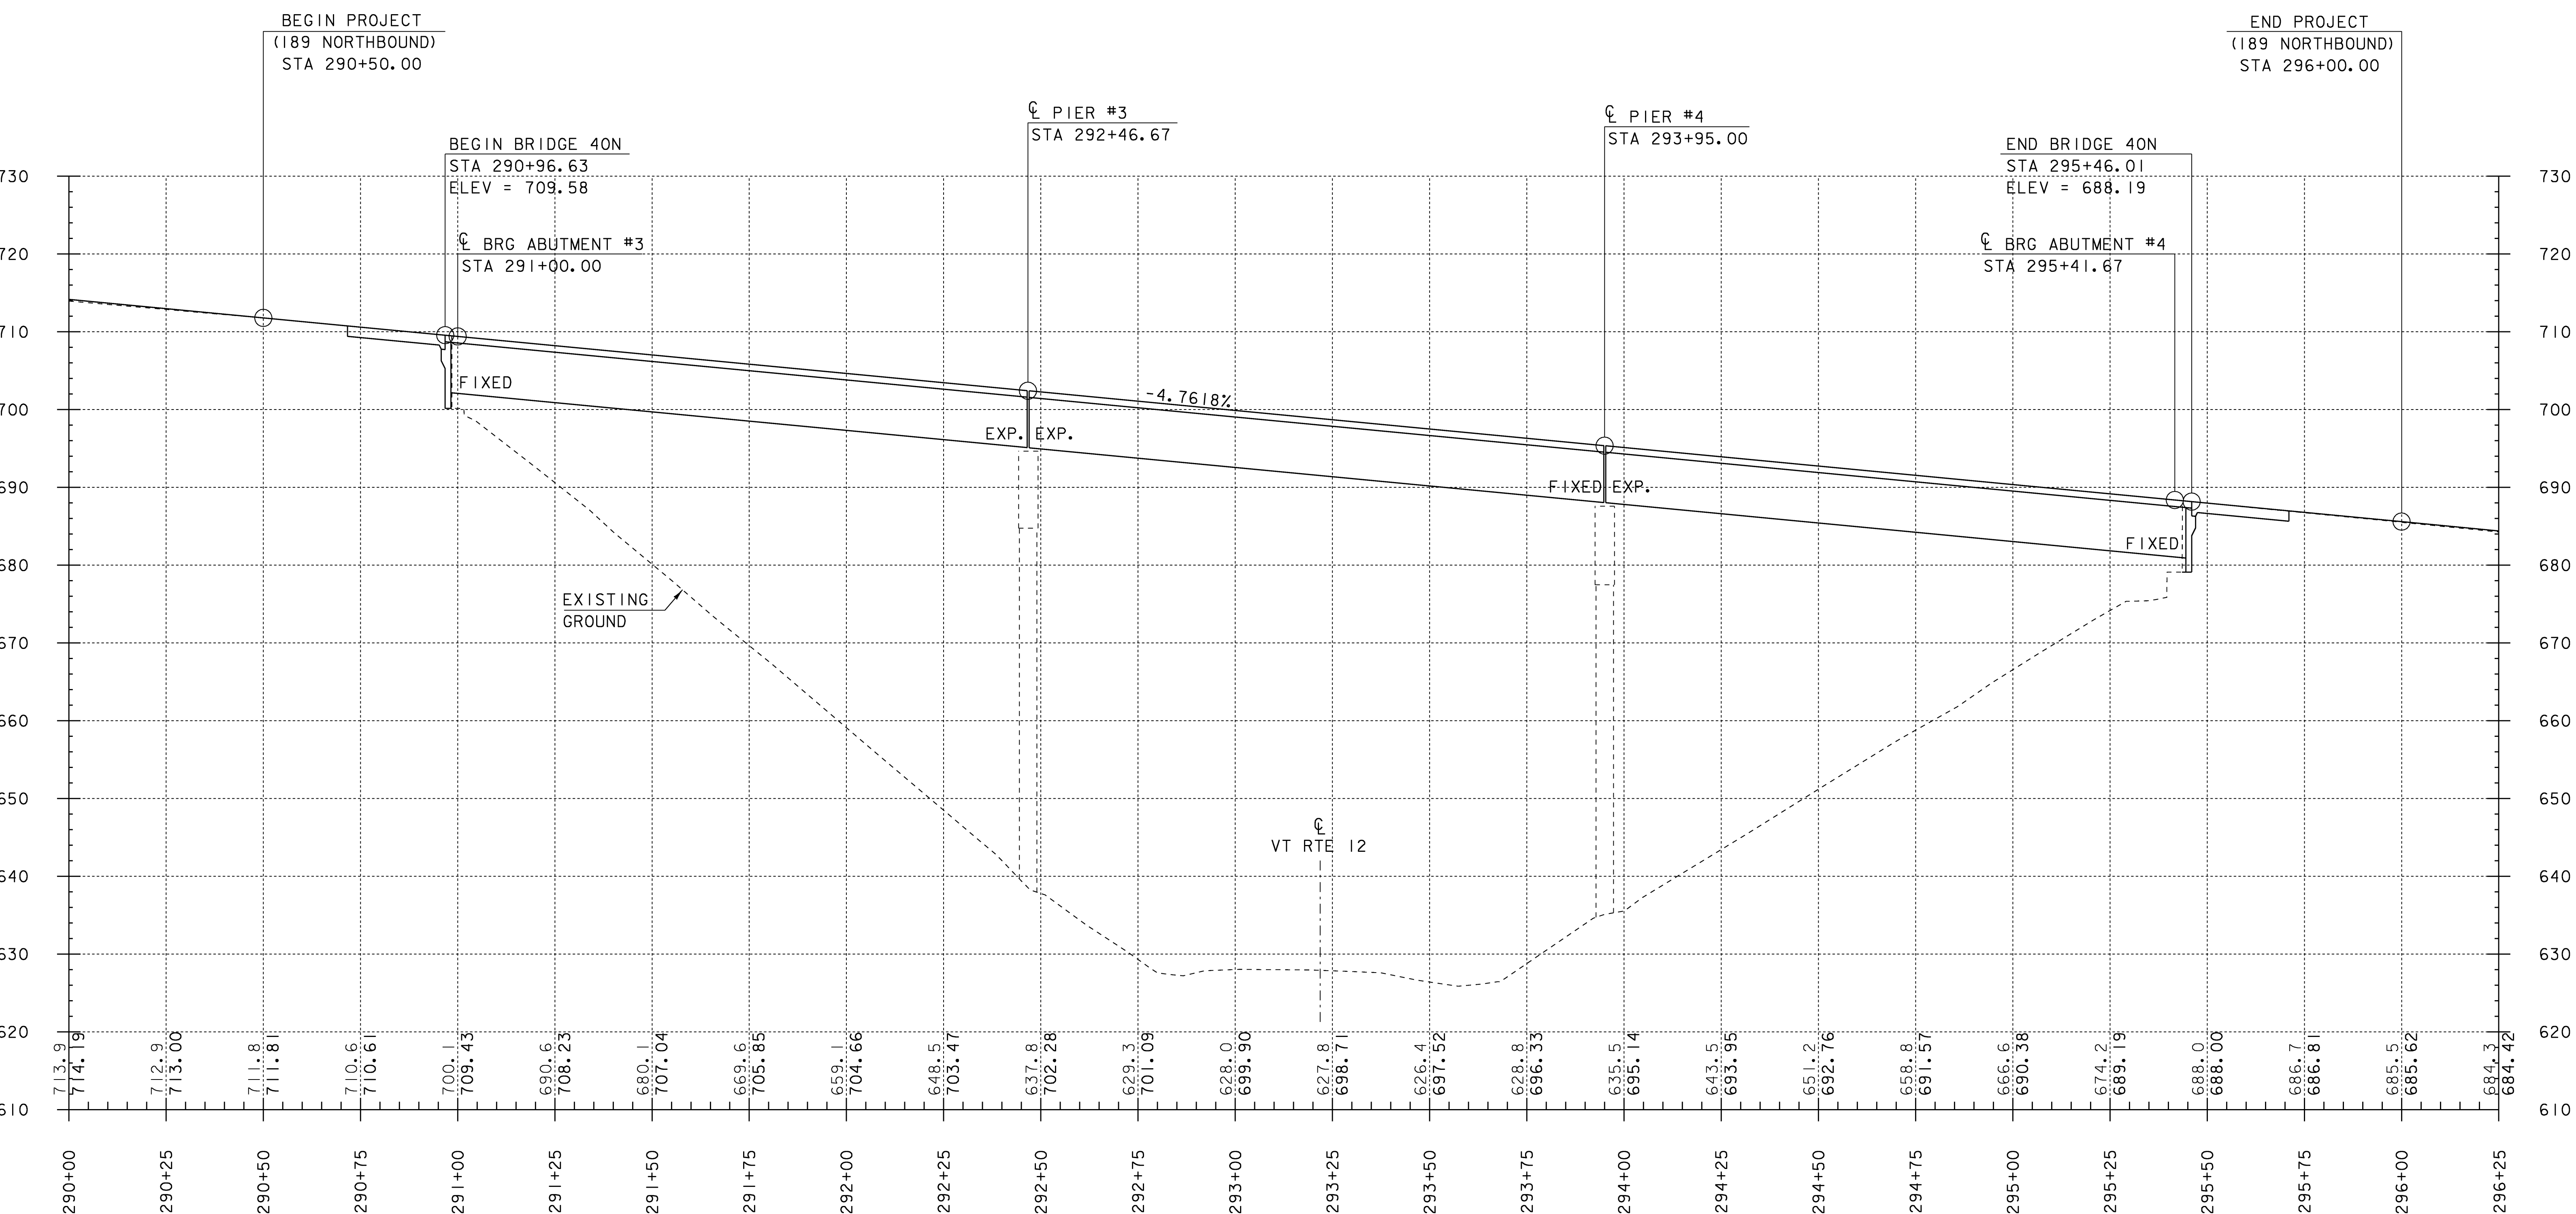


PROFILE #2 (LAYOUT I-89 NORTHBOUND)

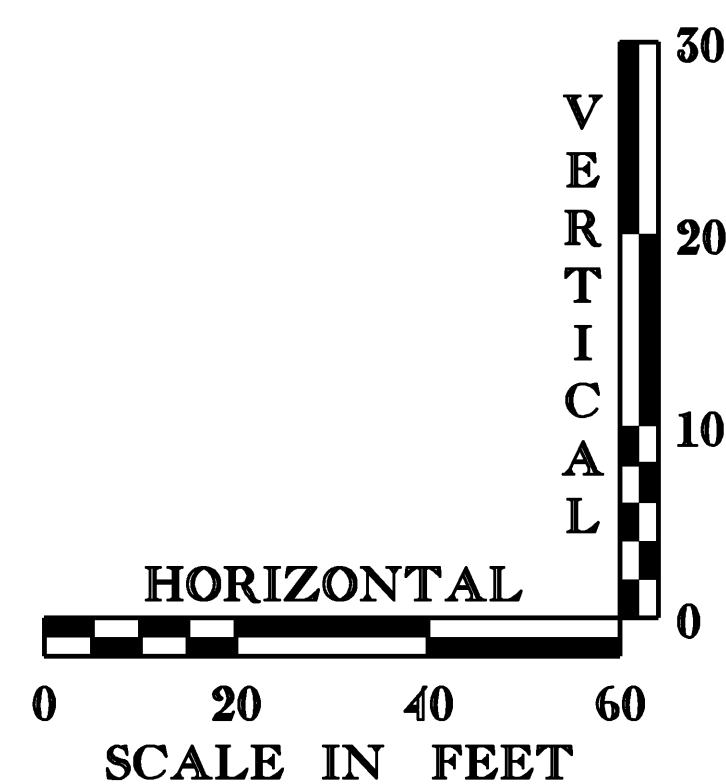


PROJECT: <b>BERLIN</b>	PROJECT NO.: <b>IM 089-1 (20)</b>
DESIGN FILE NAME: s99a270\structures\s99a270pro.dgn	PLOT DATE: 05-DEC-2007
IPARM FILE NAME: s99a270pro1.nb	DRAWN BY: D.D.BEARD
DESIGNED BY: K.M.HIGGINS	CHECKED BY: R.S.YOUNG
SQUAD LEADER: C.P.WILLIAMS	SHEET: 17 OF 104
NORTHBOUND PROFILE 1	

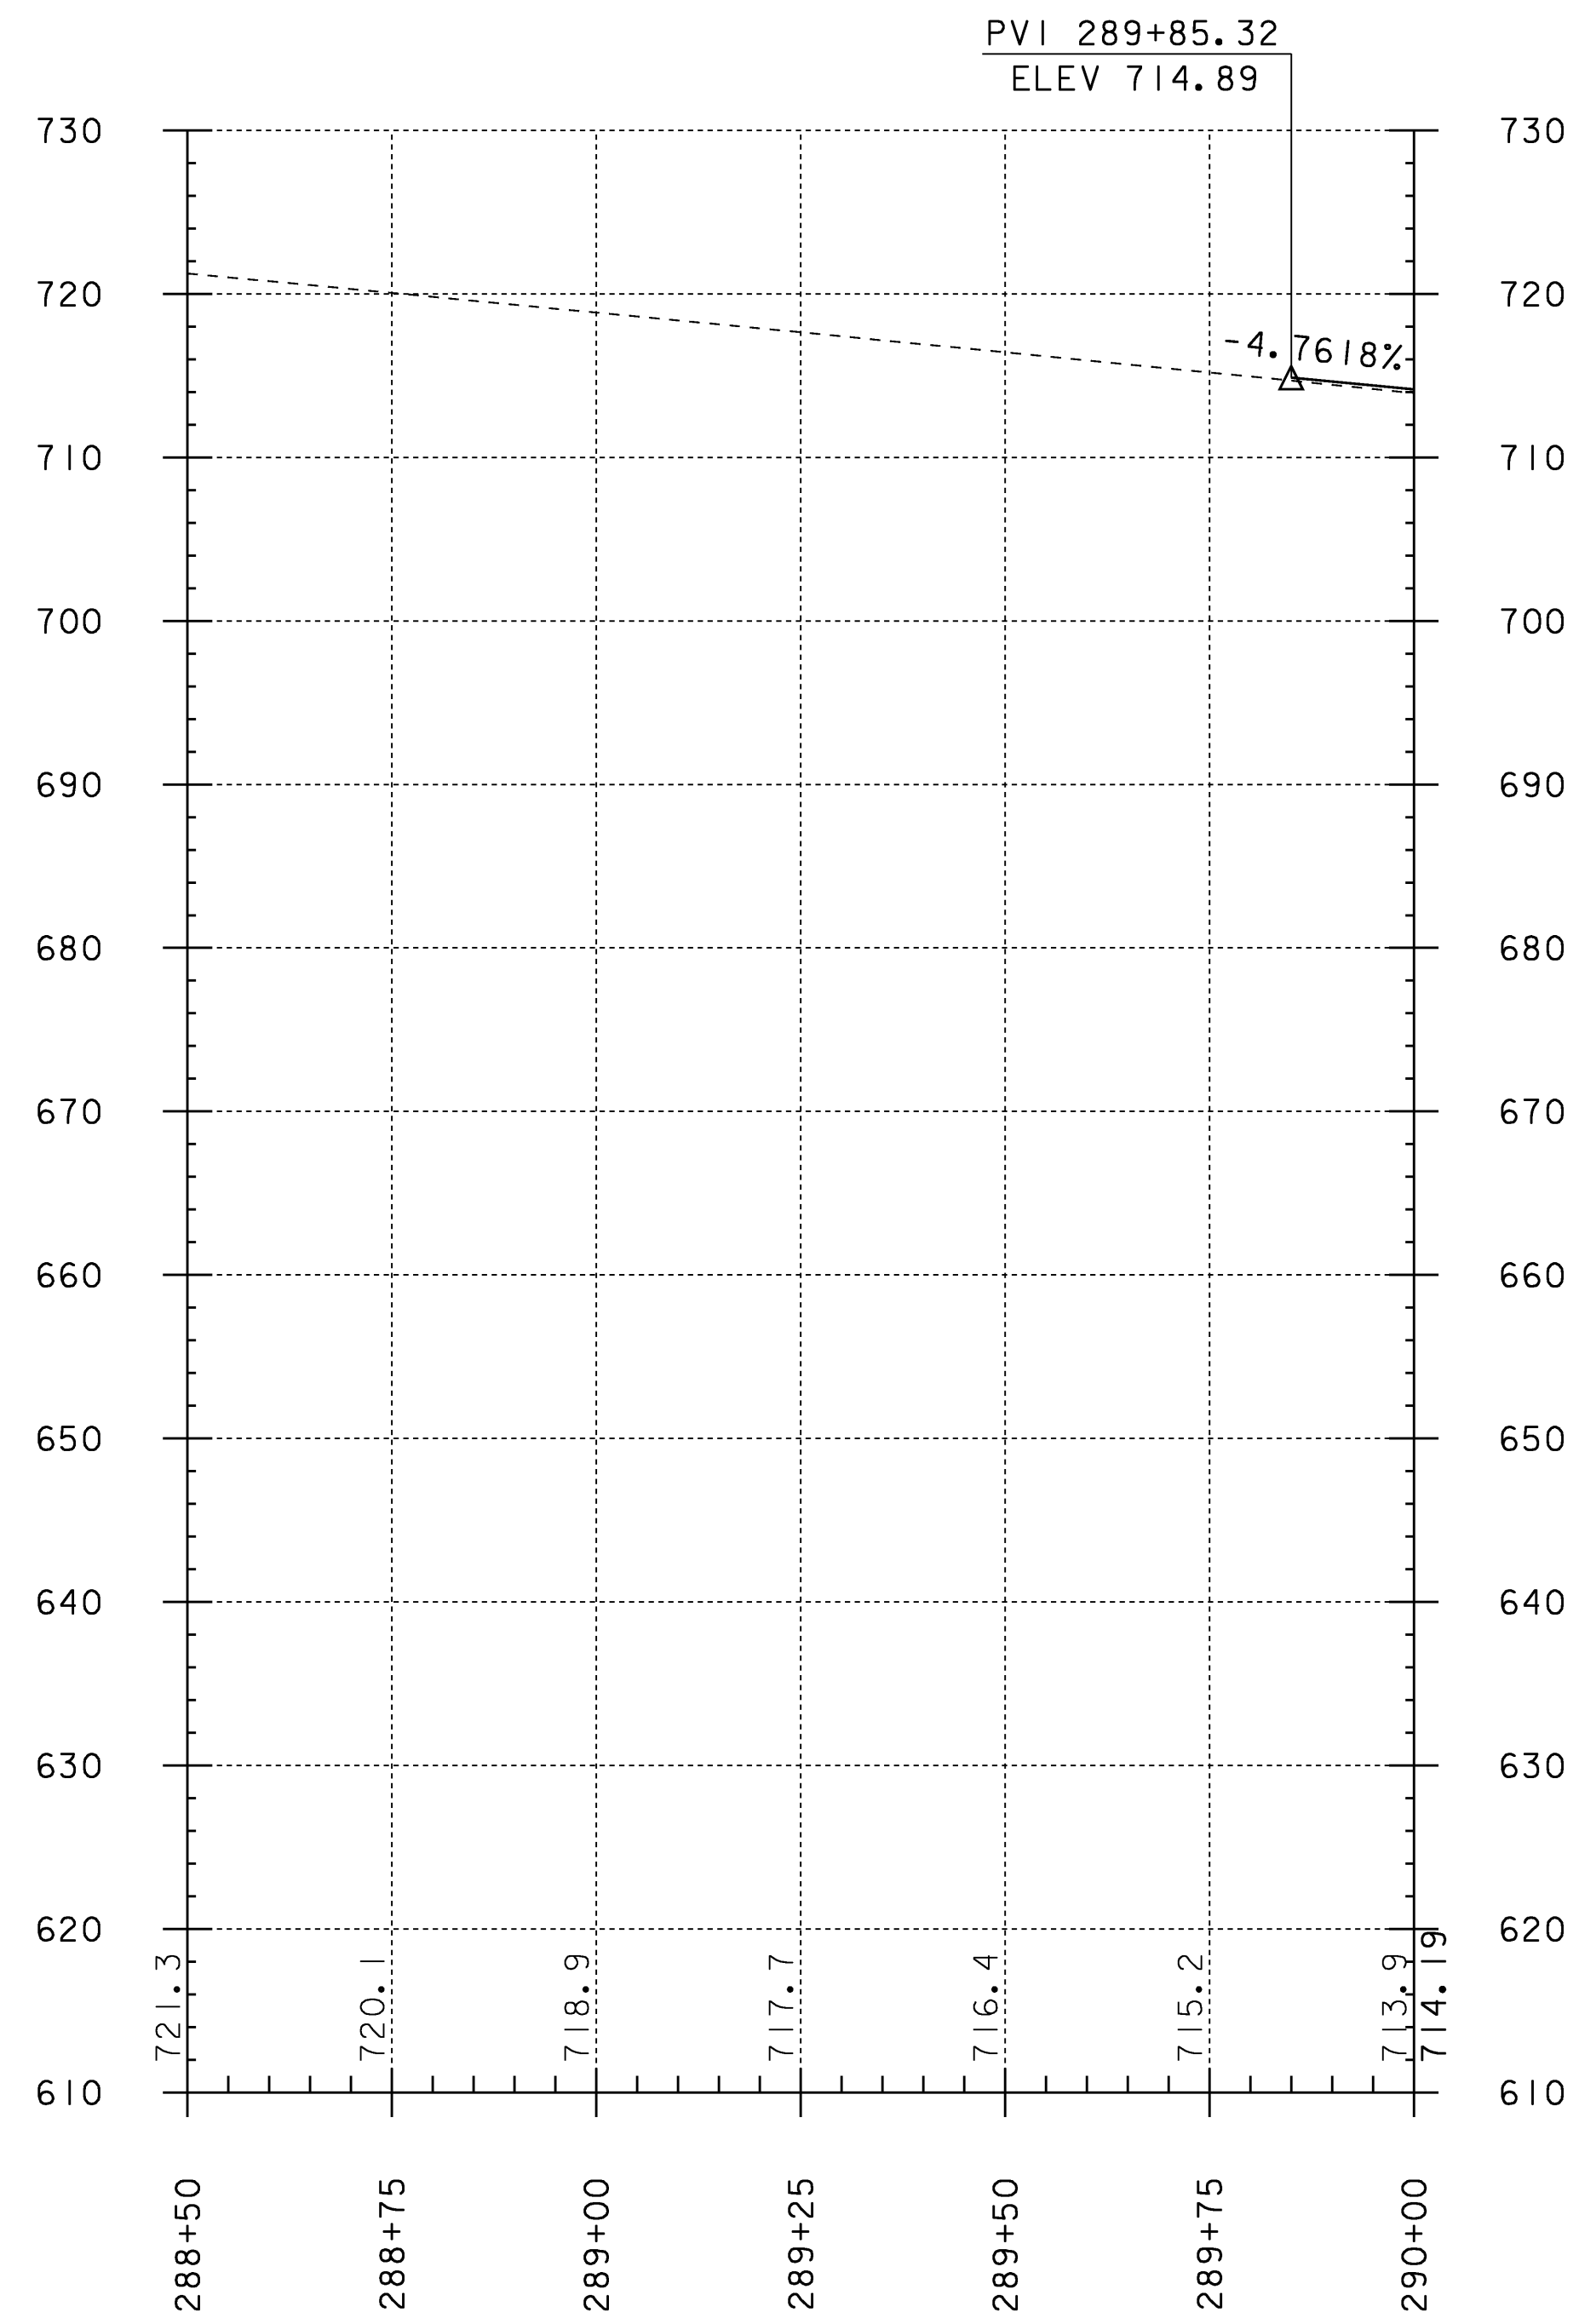


PROFILE #1 (LAYOUT I-89 NORTHBOUND)

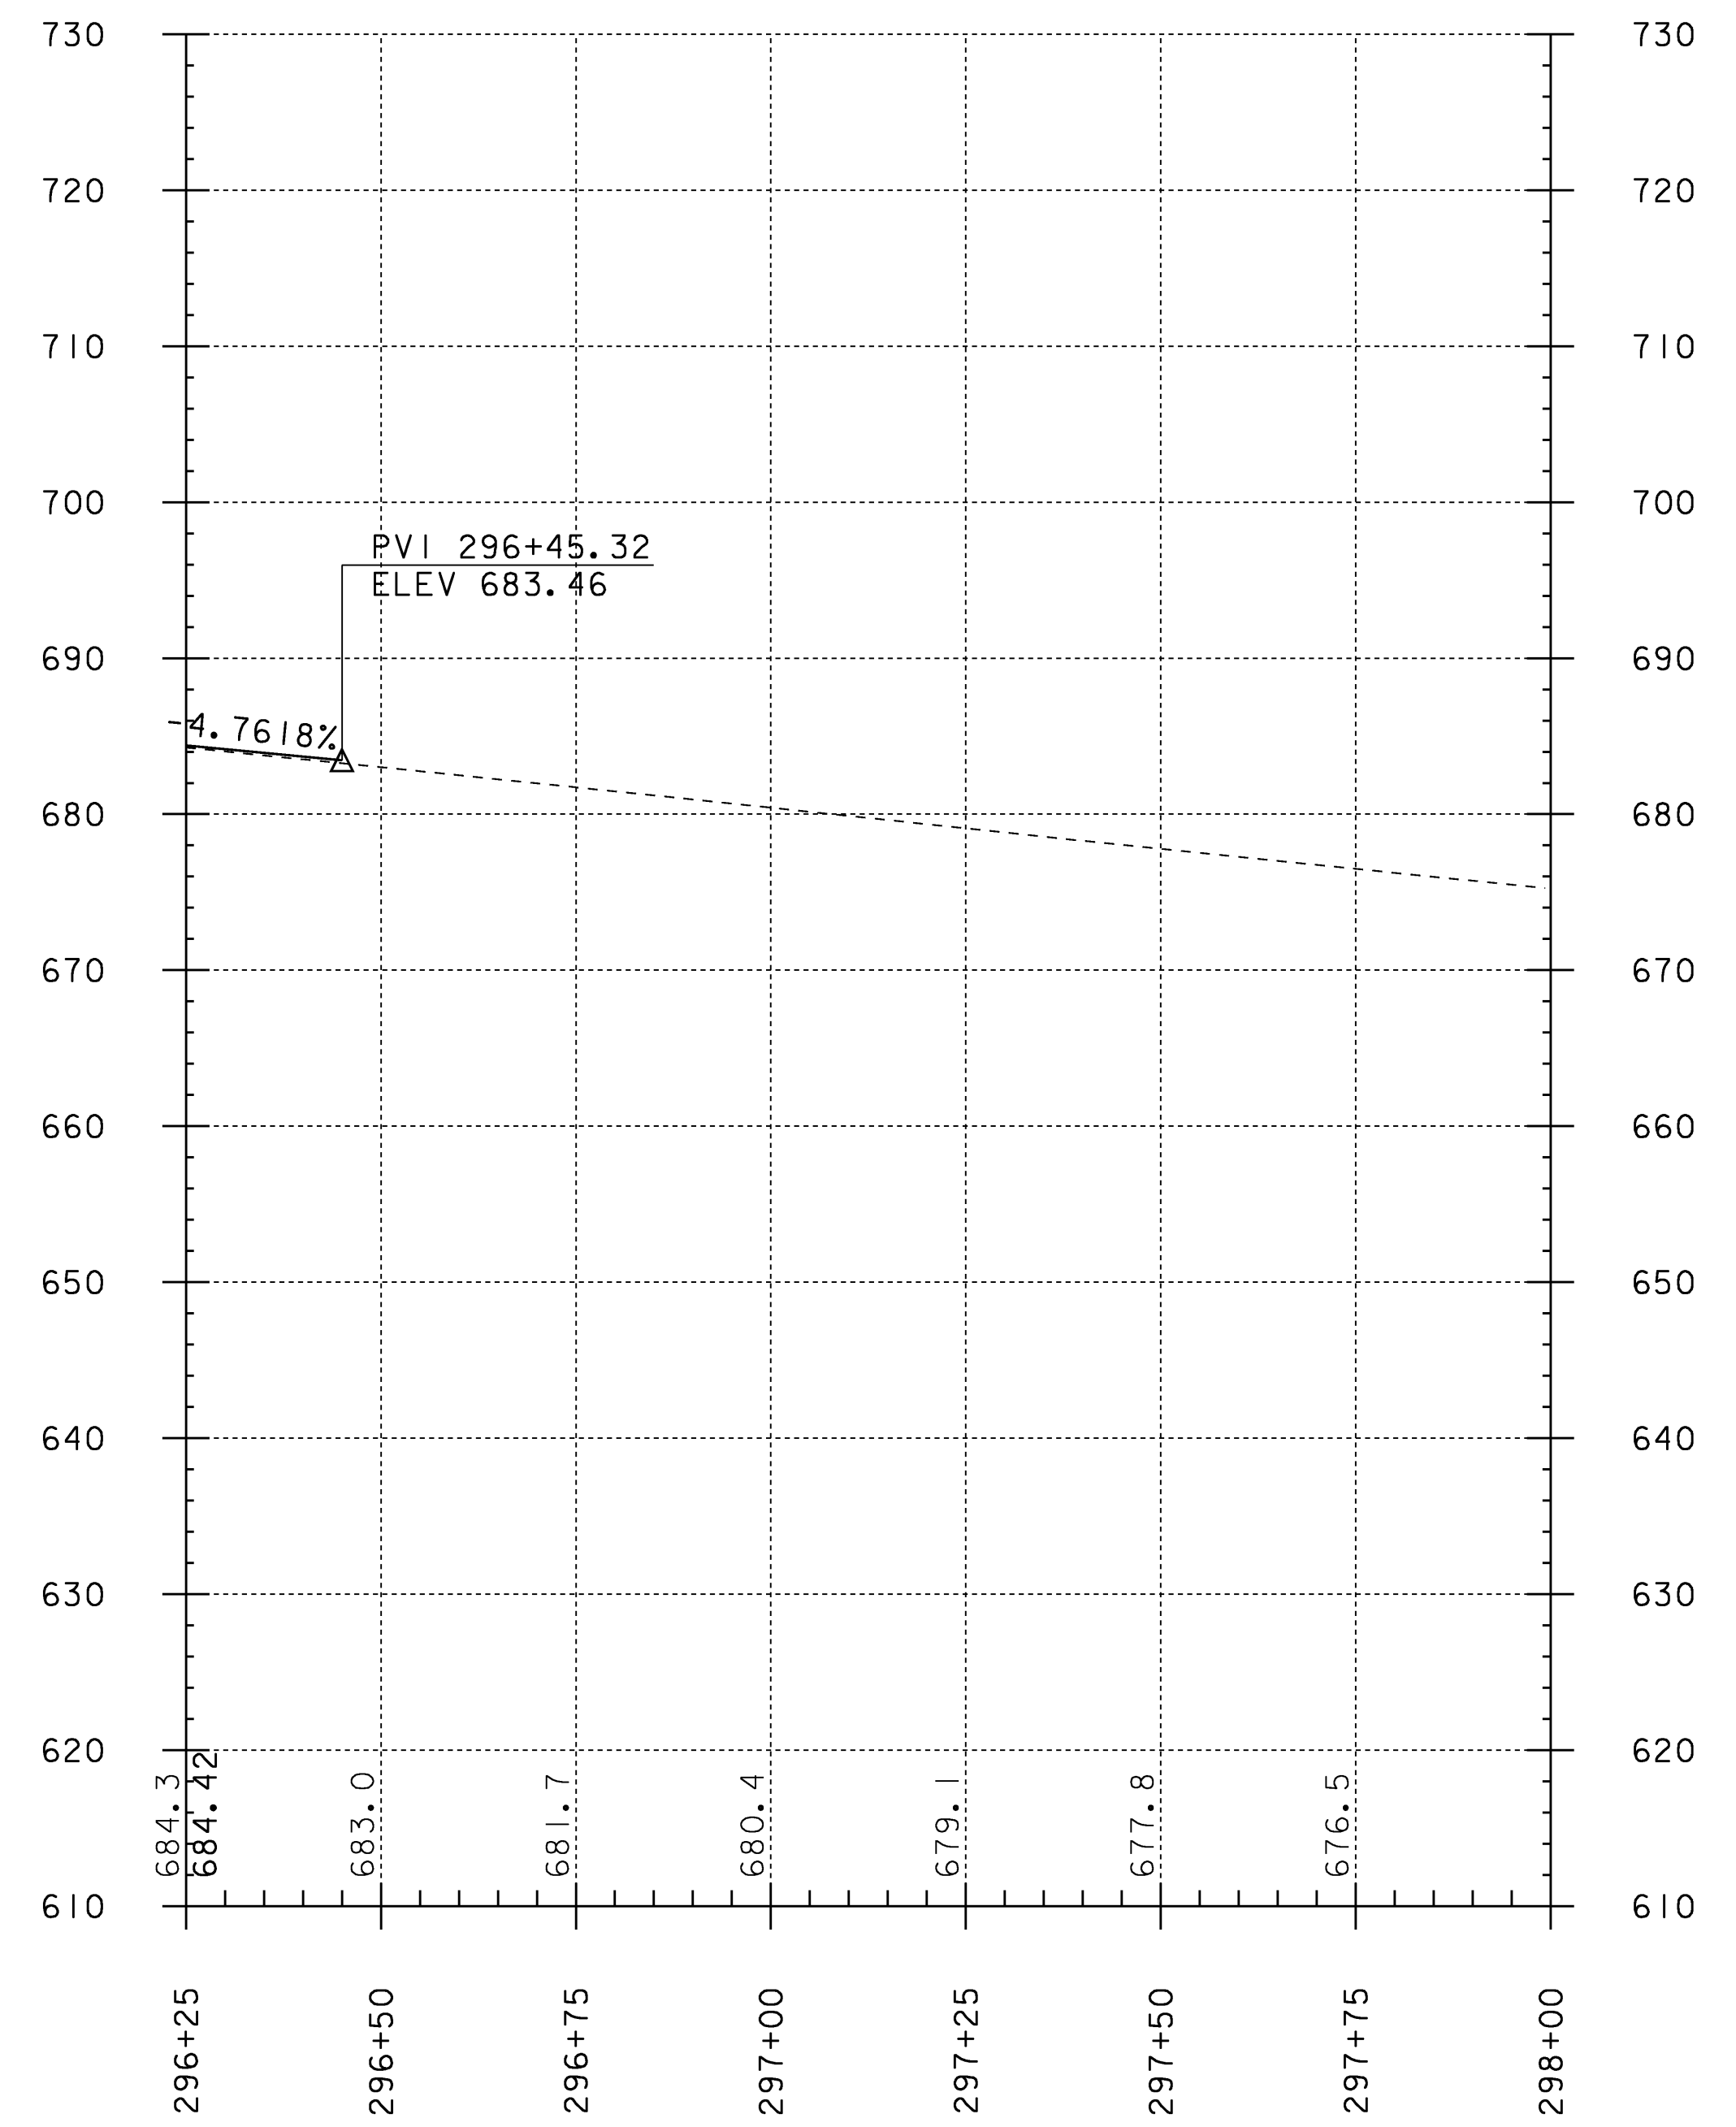


PROFILE #3 (LAYOUT I-89 NORTHBOUND)

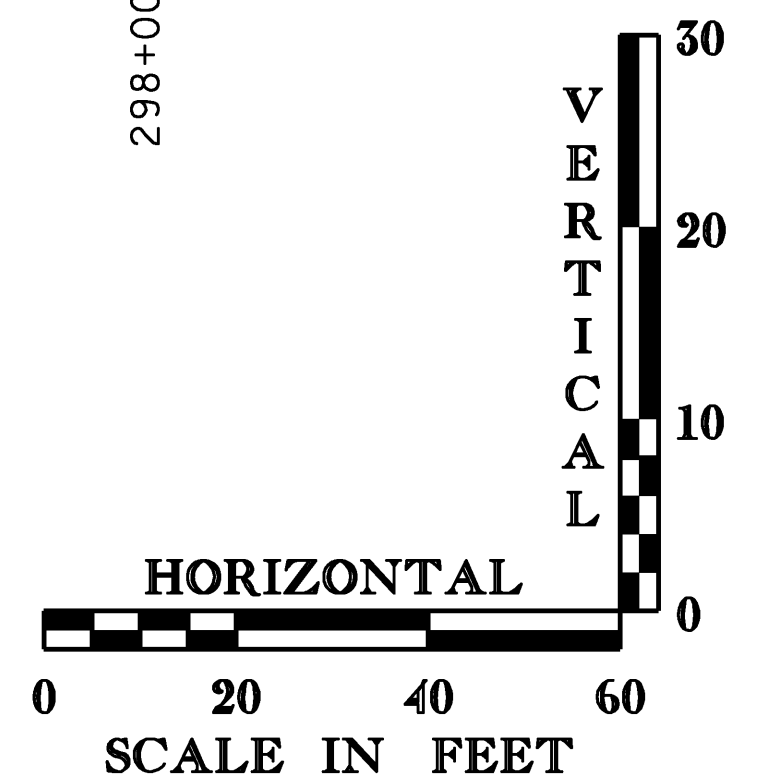

PROJECT: BERLIN	PROJECT NO.: IM 089-1 (20)
DESIGN FILE NAME: 99a270\structures\s99a270pro.dgn	PLOT DATE: 05-DEC-2007
IPARM FILE NAME: s99a270pro2 nb	DRAWN BY: D.D.BEARD
DESIGNED BY: K.M.HIGGINS	CHECKED BY: R.S.YOUNG
SQUAD LEADER: C.P.WILLIAMS	SHEET: 18 OF 104
NORTHBOUND PROFILE 2	

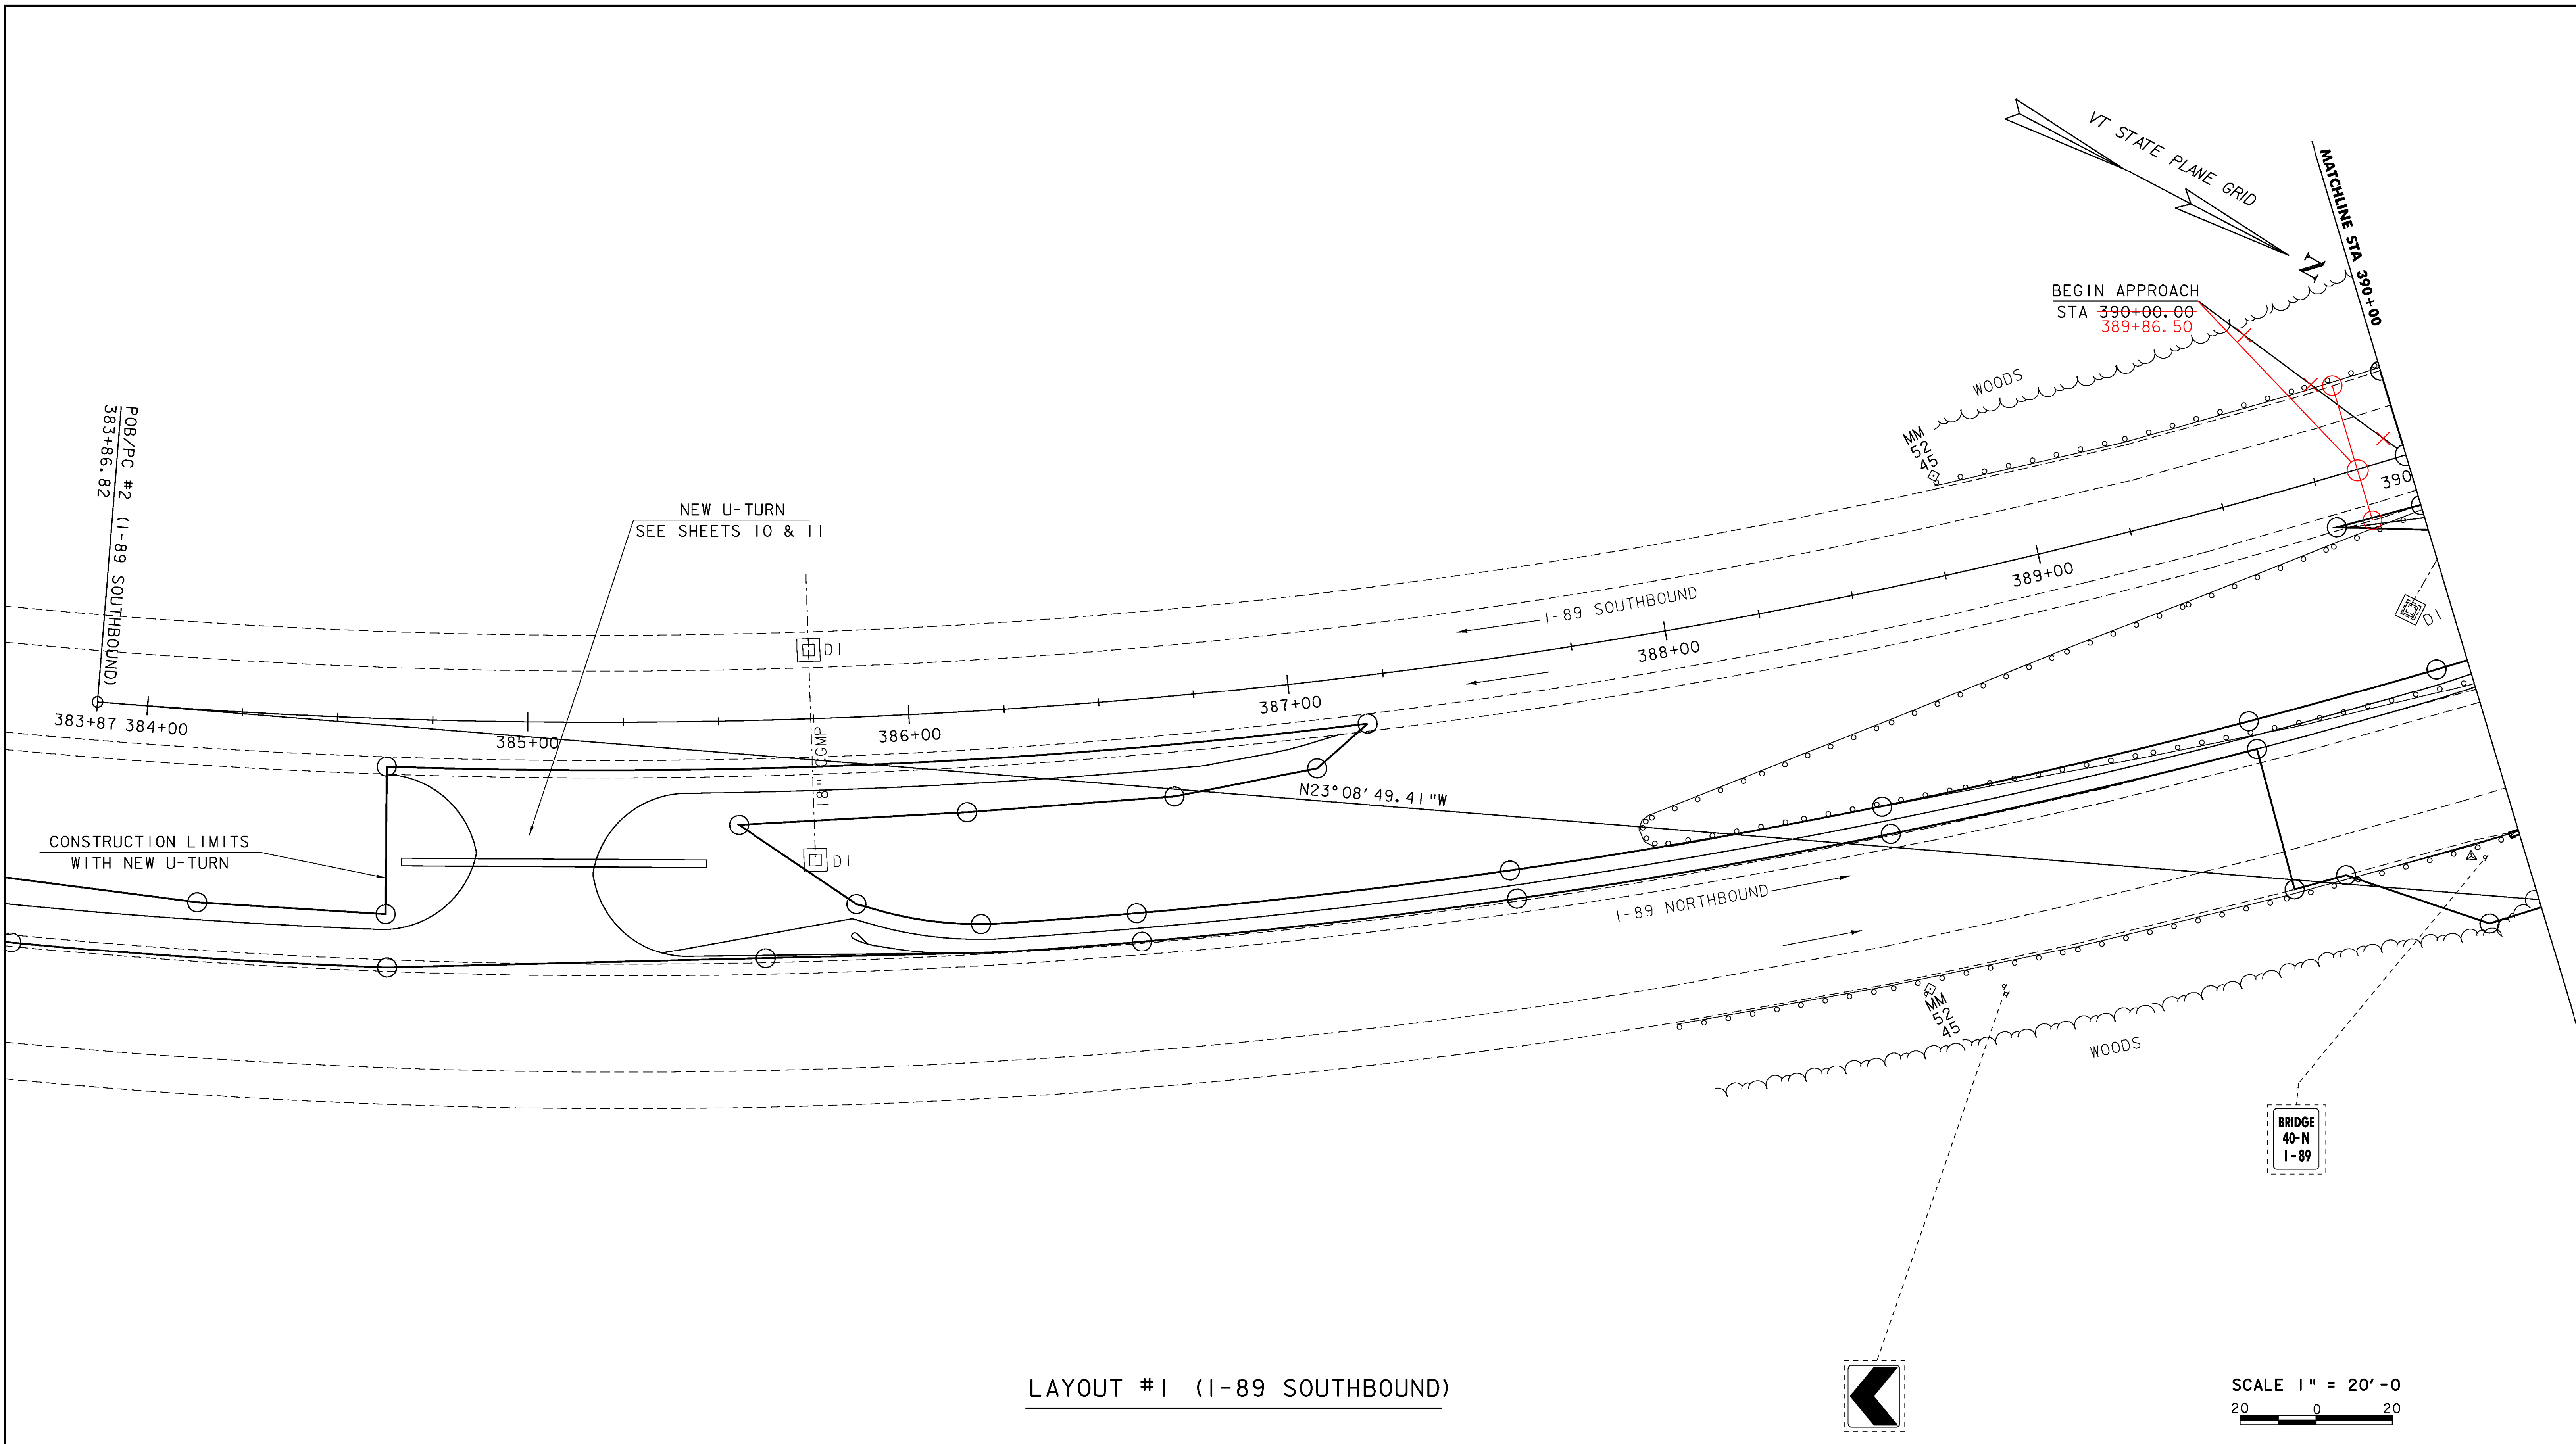

LAYOUT #1 (I-89 SOUTHBOUND)

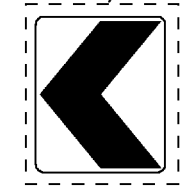

SCALE 1" = 20'-0"  
 20 0 20

PROJECT: BERLIN	PROJECT NO. : IM 089-1 (20)
DESIGN FILE NAME: 99a270\structures\99a270bdr.dgn	PLOT DATE: 05-DEC-2007
IPARM FILE NAME: s99a270\1a1 sb.i	DESIGNED BY: K.M.HIGGINS
SQUAD LEADER: C.P.WILLIAMS	DRAWN BY: D.D.BEARD
LAYOUT SOUTHBOUND 1	CHECKED BY: R.S.YOUNG
	SHEET: 19 OF 104

CHANGING ELEVATION OF DROP INLET,  
CATCH BASINS, OR MANHOLES  
STA 390+54.67 LT

REMOVAL AND DISPOSAL OF GUARDRAIL  
STA 390+00.00 - STA 390+60.66 RT  
STA 390+61.40 - STA 390+92.47 LT  
STA 395+95.61 - STA 396+00.00 LT  
STA 395+50.09 - STA 396+00.00 RT

HD STEEL BEAM GUARDRAIL, GALVANIZED  
STA 390+03.80 - STA 390+30.30 RT  
STA 395+80.45 - STA 396+00.00 RT  
STA 390+28.50 - STA 395+59.50 RT  
STA 395+03.15 - STA 395+46.30 RT


MILLED RUMBLE STRIPS  
STA 390+00.00 - STA 390+55.00 LT  
STA 395+60.00 - STA 396+00.00 LT  
DURABLE 6" WHITE LINE, THERMOPLASTIC  
STA 390+00.00 - STA 396+00.00 LT  
STA 390+00.00 - STA 396+00.00 DASHED  $\text{C}$   
DURABLE 6" YELLOW LINE, THERMOPLASTIC  
STA 390+00.00 - STA 396+00.00 RT

REMOVING SIGNS  
STA 395+99 LT  
TRAFFIC SIGNS, TYPE A  
STA 395+99 LT

SPECIAL PROVISION  
(BRIDGE RAILING, F-SHAPE CONCRETE)  
STA 390+92.45 - STA 395+95.60 LT  
STA 390+60.65 - STA 395+50.10 RT

ANCHOR FOR STEEL BEAM RAIL  
STA 390+13.00 RT

SPECIAL PROVISION  
(GUARDRAIL APPROACH SECTION  
TO F-SHAPE CONCRETE RAIL)  
STA 390+61.40 - STA 390+92.45 LT  
STA 390+30.30 - STA 390+60.65 RT  
STA 395+95.60 - STA 396+00.00 LT  
STA 395+50.10 - STA 395+80.45 RT

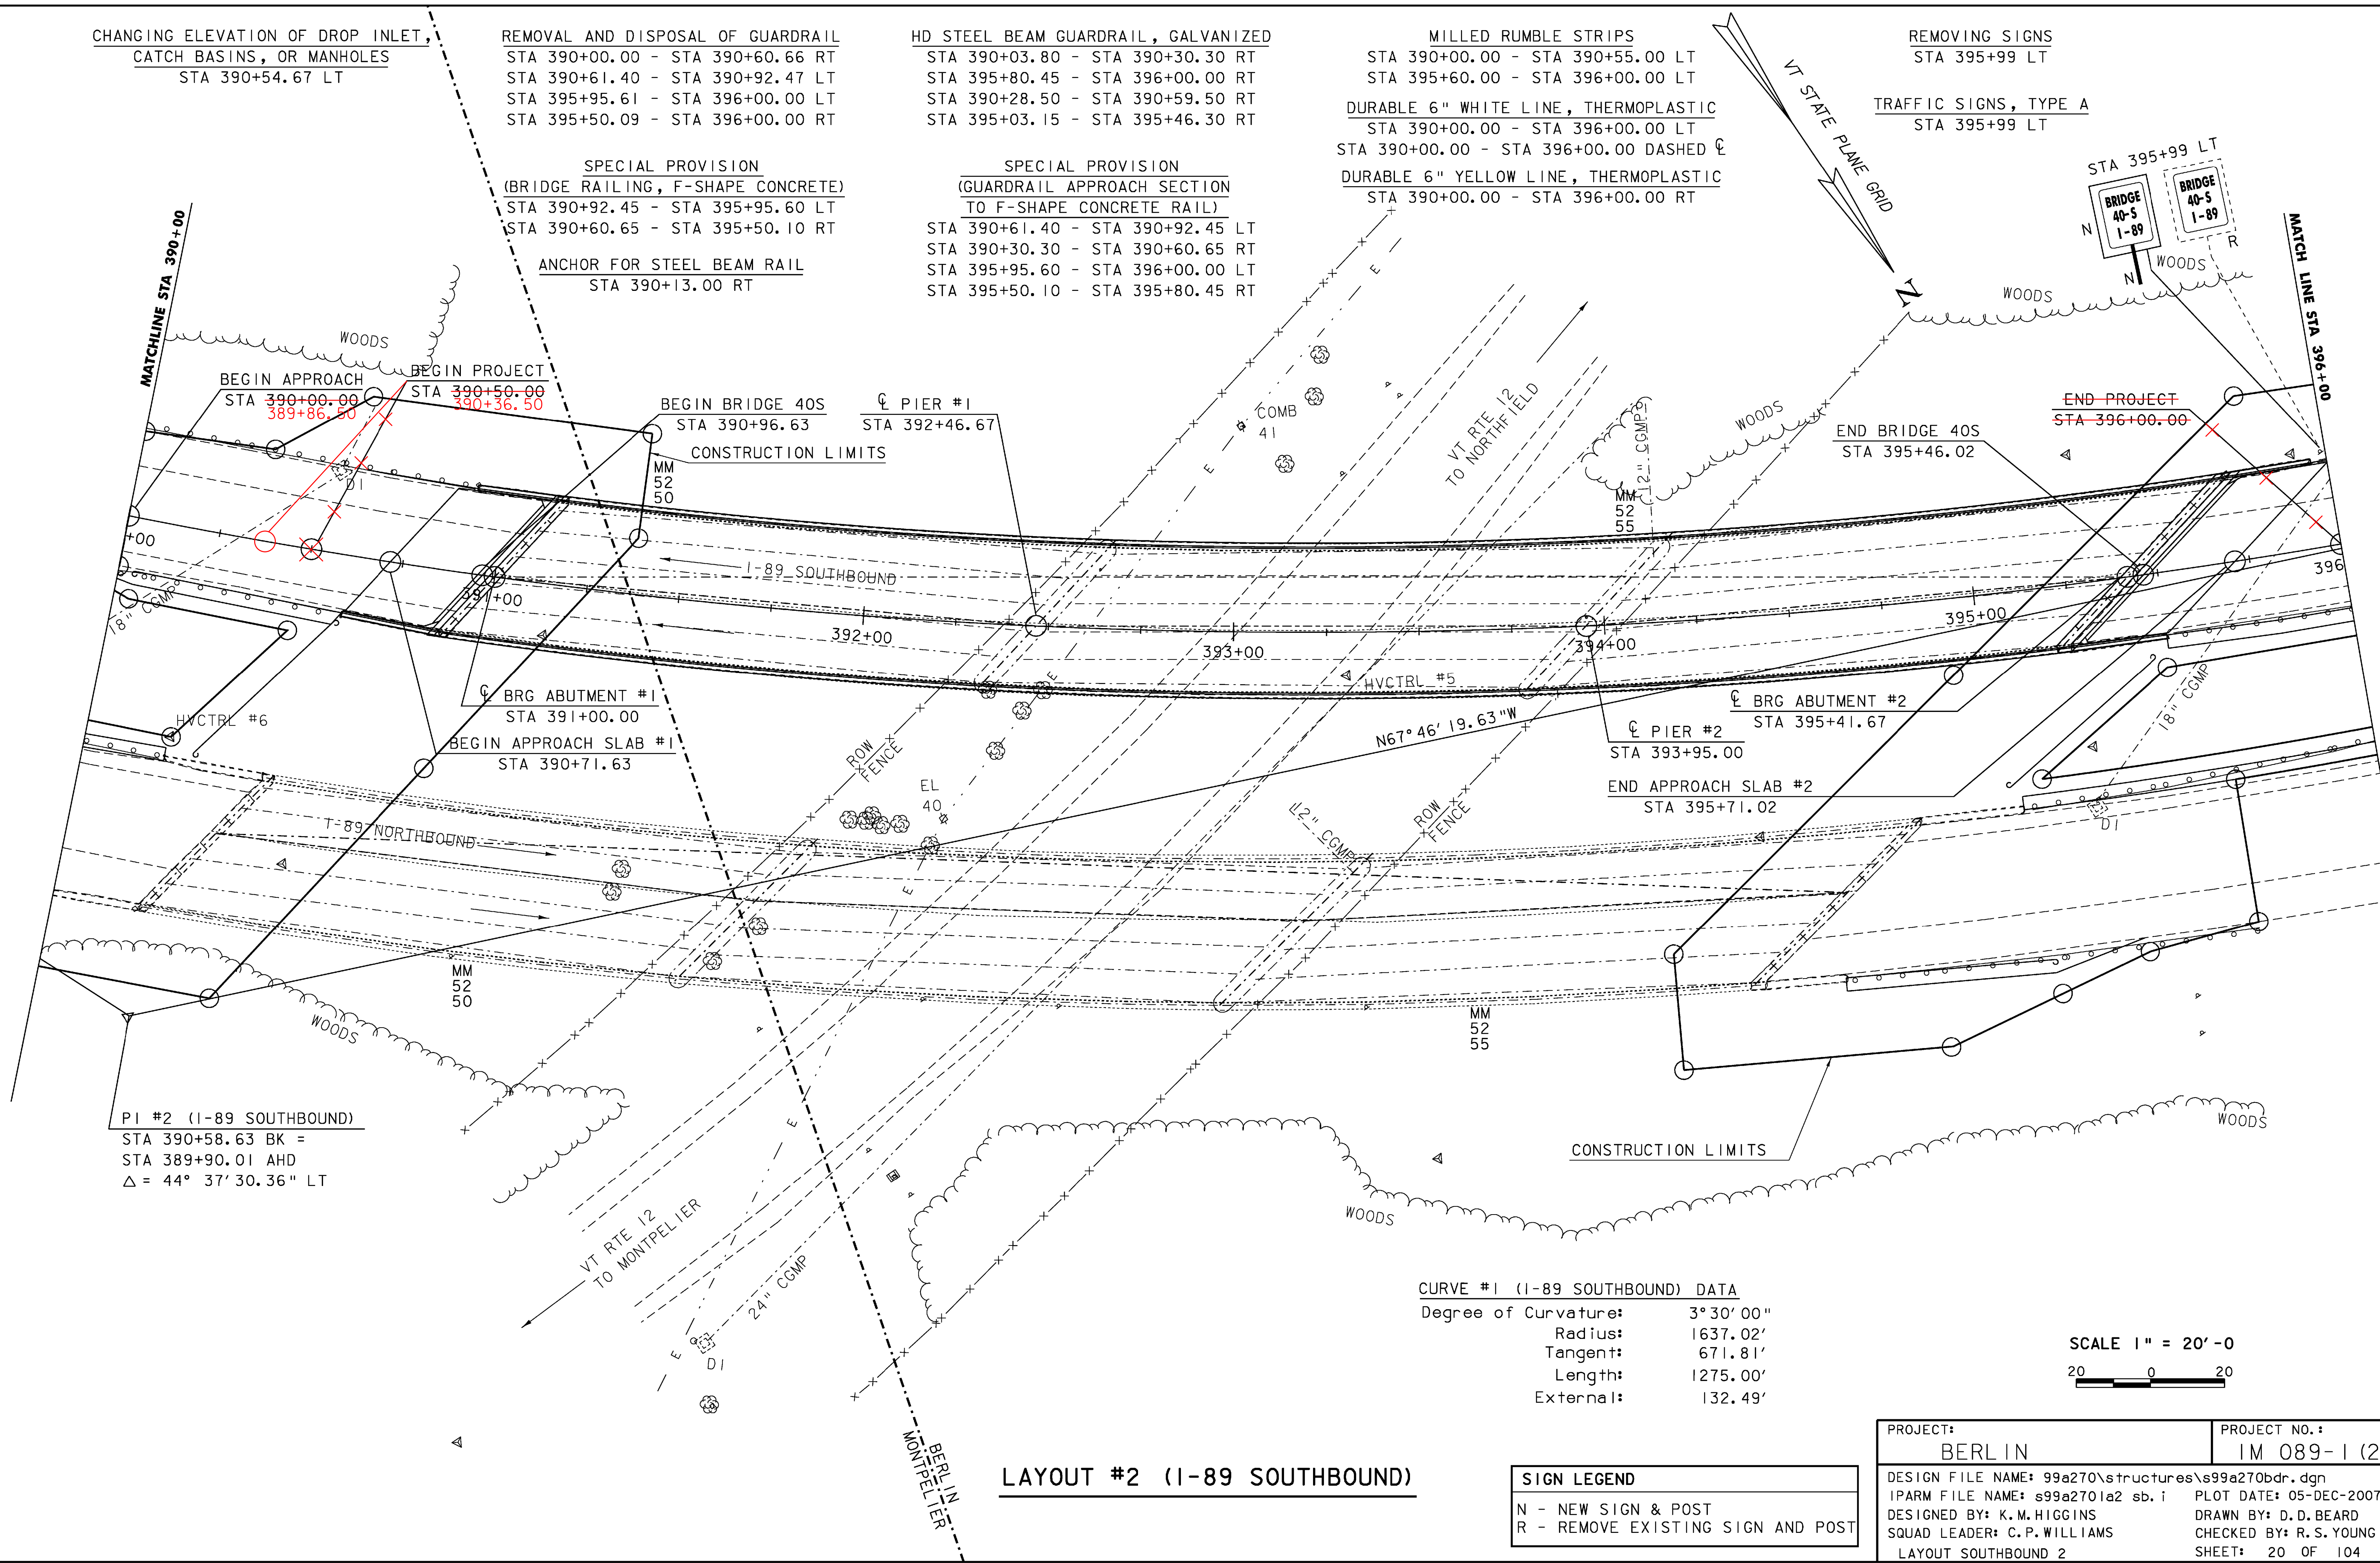

PI #2 (I-89 SOUTHBOUND)  
STA 390+58.63 BK =  
STA 389+90.01 AHD  
 $\Delta = 44^\circ 37' 30.36''$  LT

CURVE #1 (I-89 SOUTHBOUND) DATA  
Degree of Curvature:  $3^\circ 30' 00''$   
Radius: 1637.02'  
Tangent: 671.81'  
Length: 1275.00'  
External: 132.49'

SCALE 1" = 20' - 0  
20 0 20

LAYOUT #2 (I-89 SOUTHBOUND)

SIGN LEGEND	
N	NEW SIGN & POST
R	REMOVE EXISTING SIGN AND POST

PROJECT: BERLIN	PROJECT NO.: IM 089-1 (20)
DESIGN FILE NAME: s99a270\structures\s99a270bdr.dgn	PLOT DATE: 05-DEC-2007
IPARM FILE NAME: s99a2701a2 sb.i	DRAWN BY: D.D.BEARD
DESIGNED BY: K.M.HIGGINS	CHECKED BY: R.S.YOUNG
SQUAD LEADER: C.P.WILLIAMS	SHEET: 20 OF 104
LAYOUT SOUTHBOUND 2	

REMOVAL AND DISPOSAL OF GUARDRAIL  
 STA 396+00.00 - STA 396+26.70 LT  
 STA 396+00.00 - STA 397+85.93 RT

SPECIAL PROVISION  
 (GUARDRAIL APPROACH SECTION,  
 TO F-SHAPE CONCRETE RAIL)  
 STA 396+00.00 - STA 396+26.70 LT  
 HD STEEL BEAM GUARDRAIL, GALVANIZED  
 STA 396+00.00 - STA 399+67.00 RT



CHANGING ELEVATION OF DROP INLET,  
 CATCH BASIN, OR MANHOLES  
 STA 396+06.09  
  
 MANUFACTURED TERMINAL  
 SECTION, FLARED  
 STA 399+67.00 - STA 400+04.30 RT

MILLED RUMBLE STRIP  
 STA 396+00.00 - STA 396+50.00 LT  
  
 DURABLE 6" WHITE LINE, THERMOPLASTIC  
 STA 390+00.00 - STA 396+50.00 LT  
 STA 390+00.00 - STA 396+50.00 DASHED CL  
  
 DURABLE 6" YELLOW LINE, THERMOPLASTIC  
 STA 390+00.00 - STA 396+50.00 RT

DELINIATOR WITH STEEL POST  
 STA 396+41.60 LT  
  
 TRAFFIC SIGN, TYPE A  
 MM 52.81 LT (NOT SHOWN)

**SPEED LIMIT 65**  
**MINIMUM SPEED 40**

MATCH LINE STA 396+00

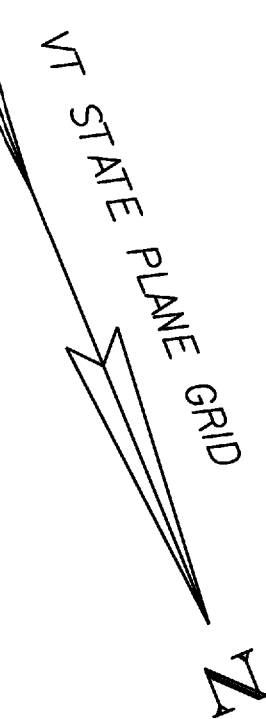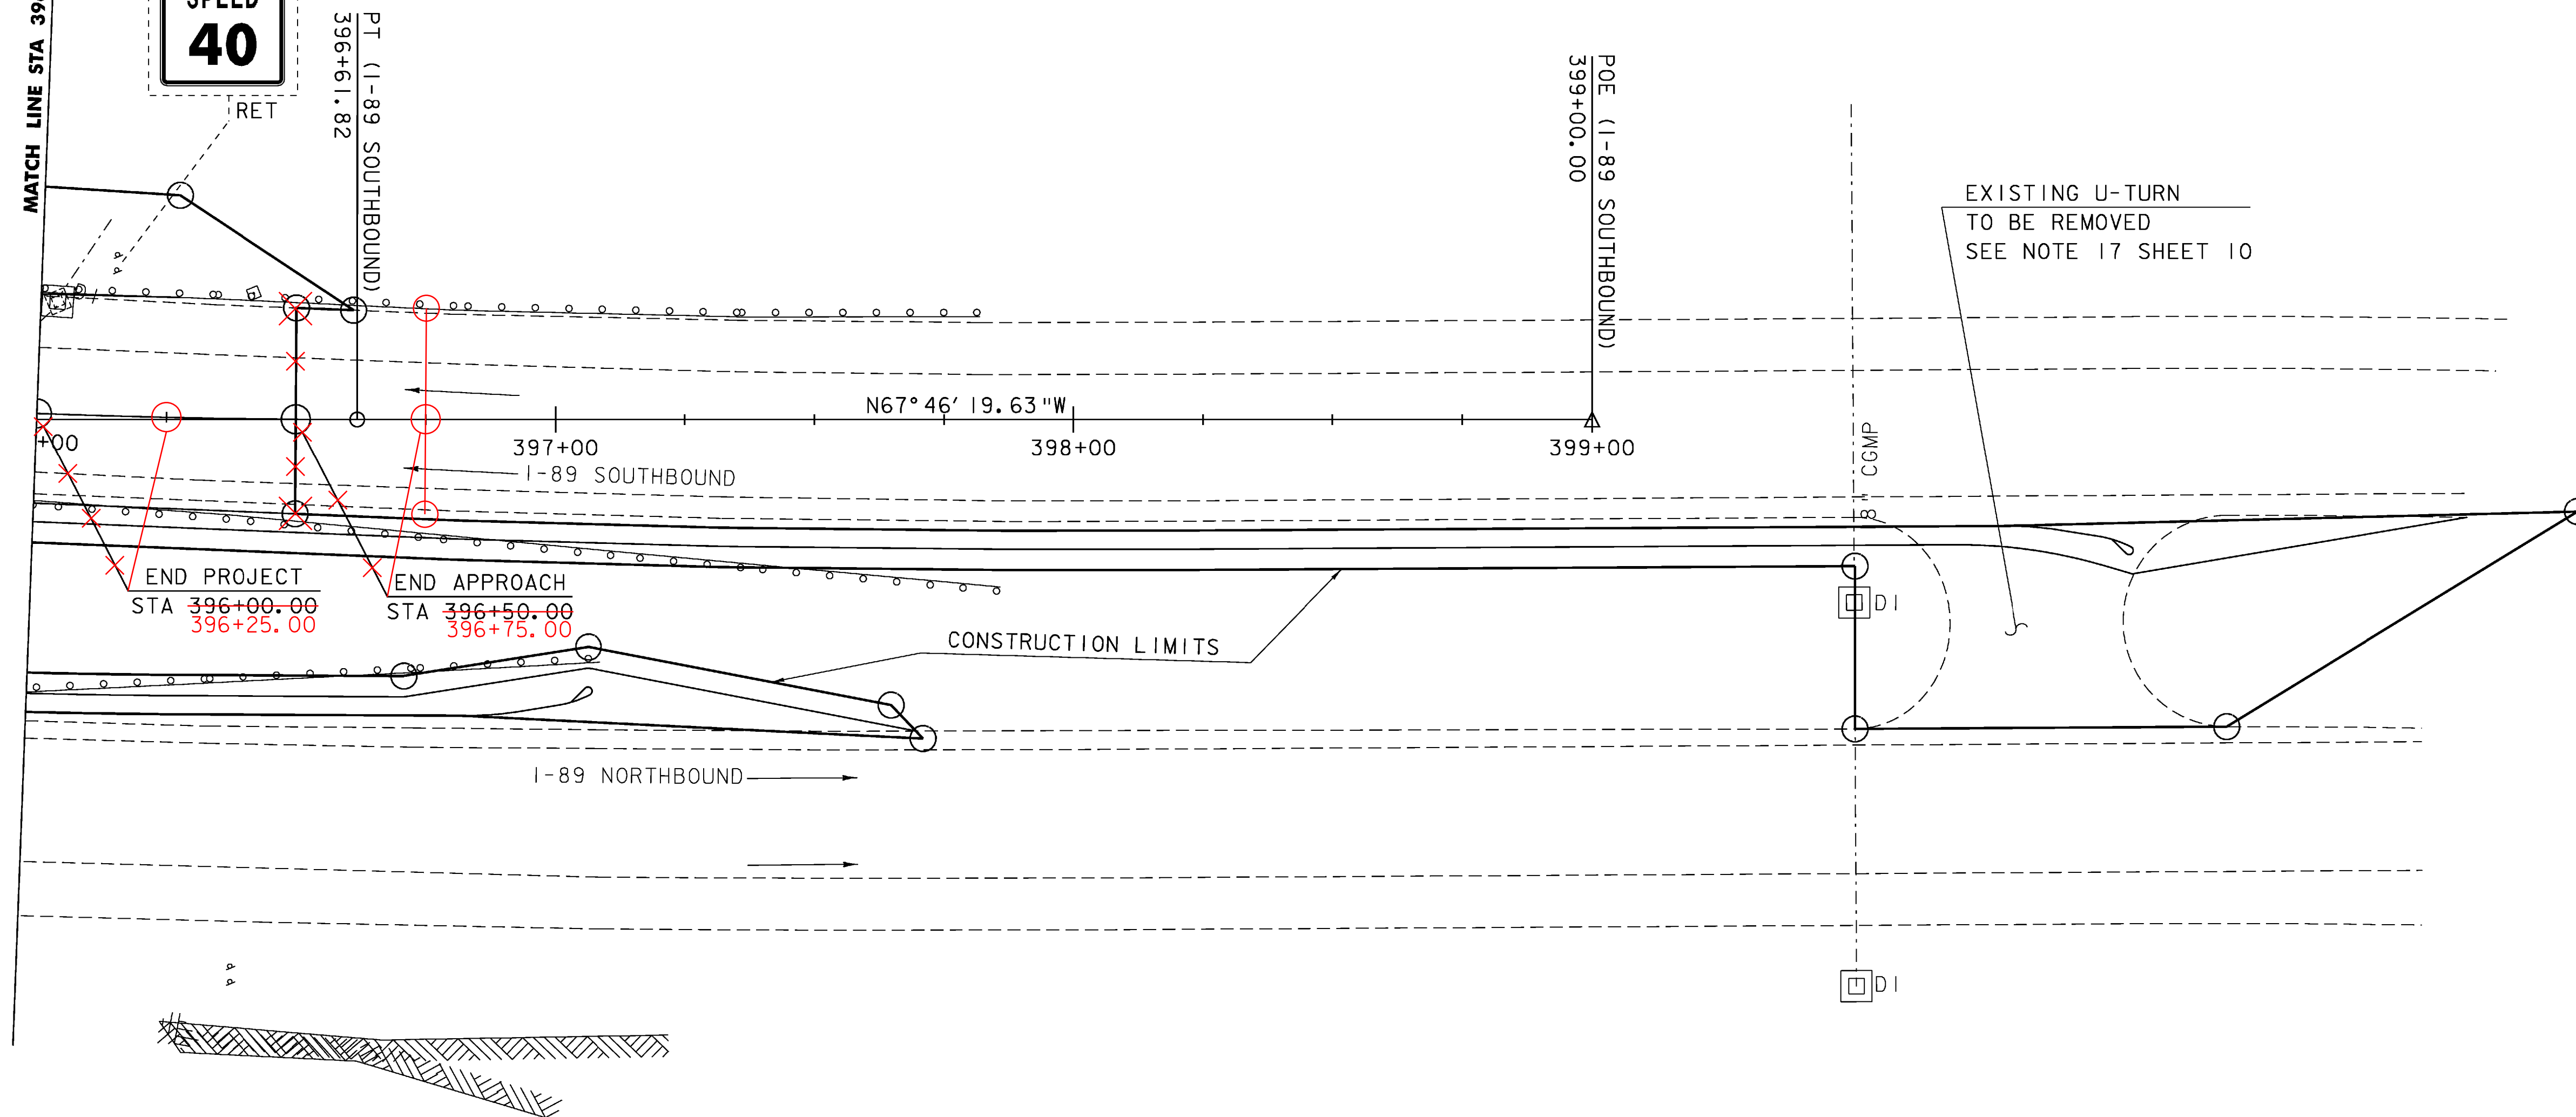


**LAYOUT #3 (I-89 SOUTHBOUND)**


SCALE 1" = 20'-0"  
 20 0 20

SIGN LEGEND	
N	- NEW
R	- REMOVE
RET	- RETAIN
R&S	- REMOVE & SALVAGE
S	- ERECTING SALVAGED SIGNS


PROJECT: <b>BERLIN</b>	PROJECT NO.: <b>IM 089-1 (20)</b>
DESIGN FILE NAME: 99a270\structures\99a270bdr.dgn	PLOT DATE: 05-DEC-2007
IPARM FILE NAME: s99a2701a3 sb.i	DRAWN BY: D.D.BEARD
DESIGNED BY: K.M.HIGGINS	CHECKED BY: R.S.YOUNG
SQUAD LEADER: C.P.WILLIAMS	SHEET: 21 OF 104
LAYOUT SOUTHBOUND 3	

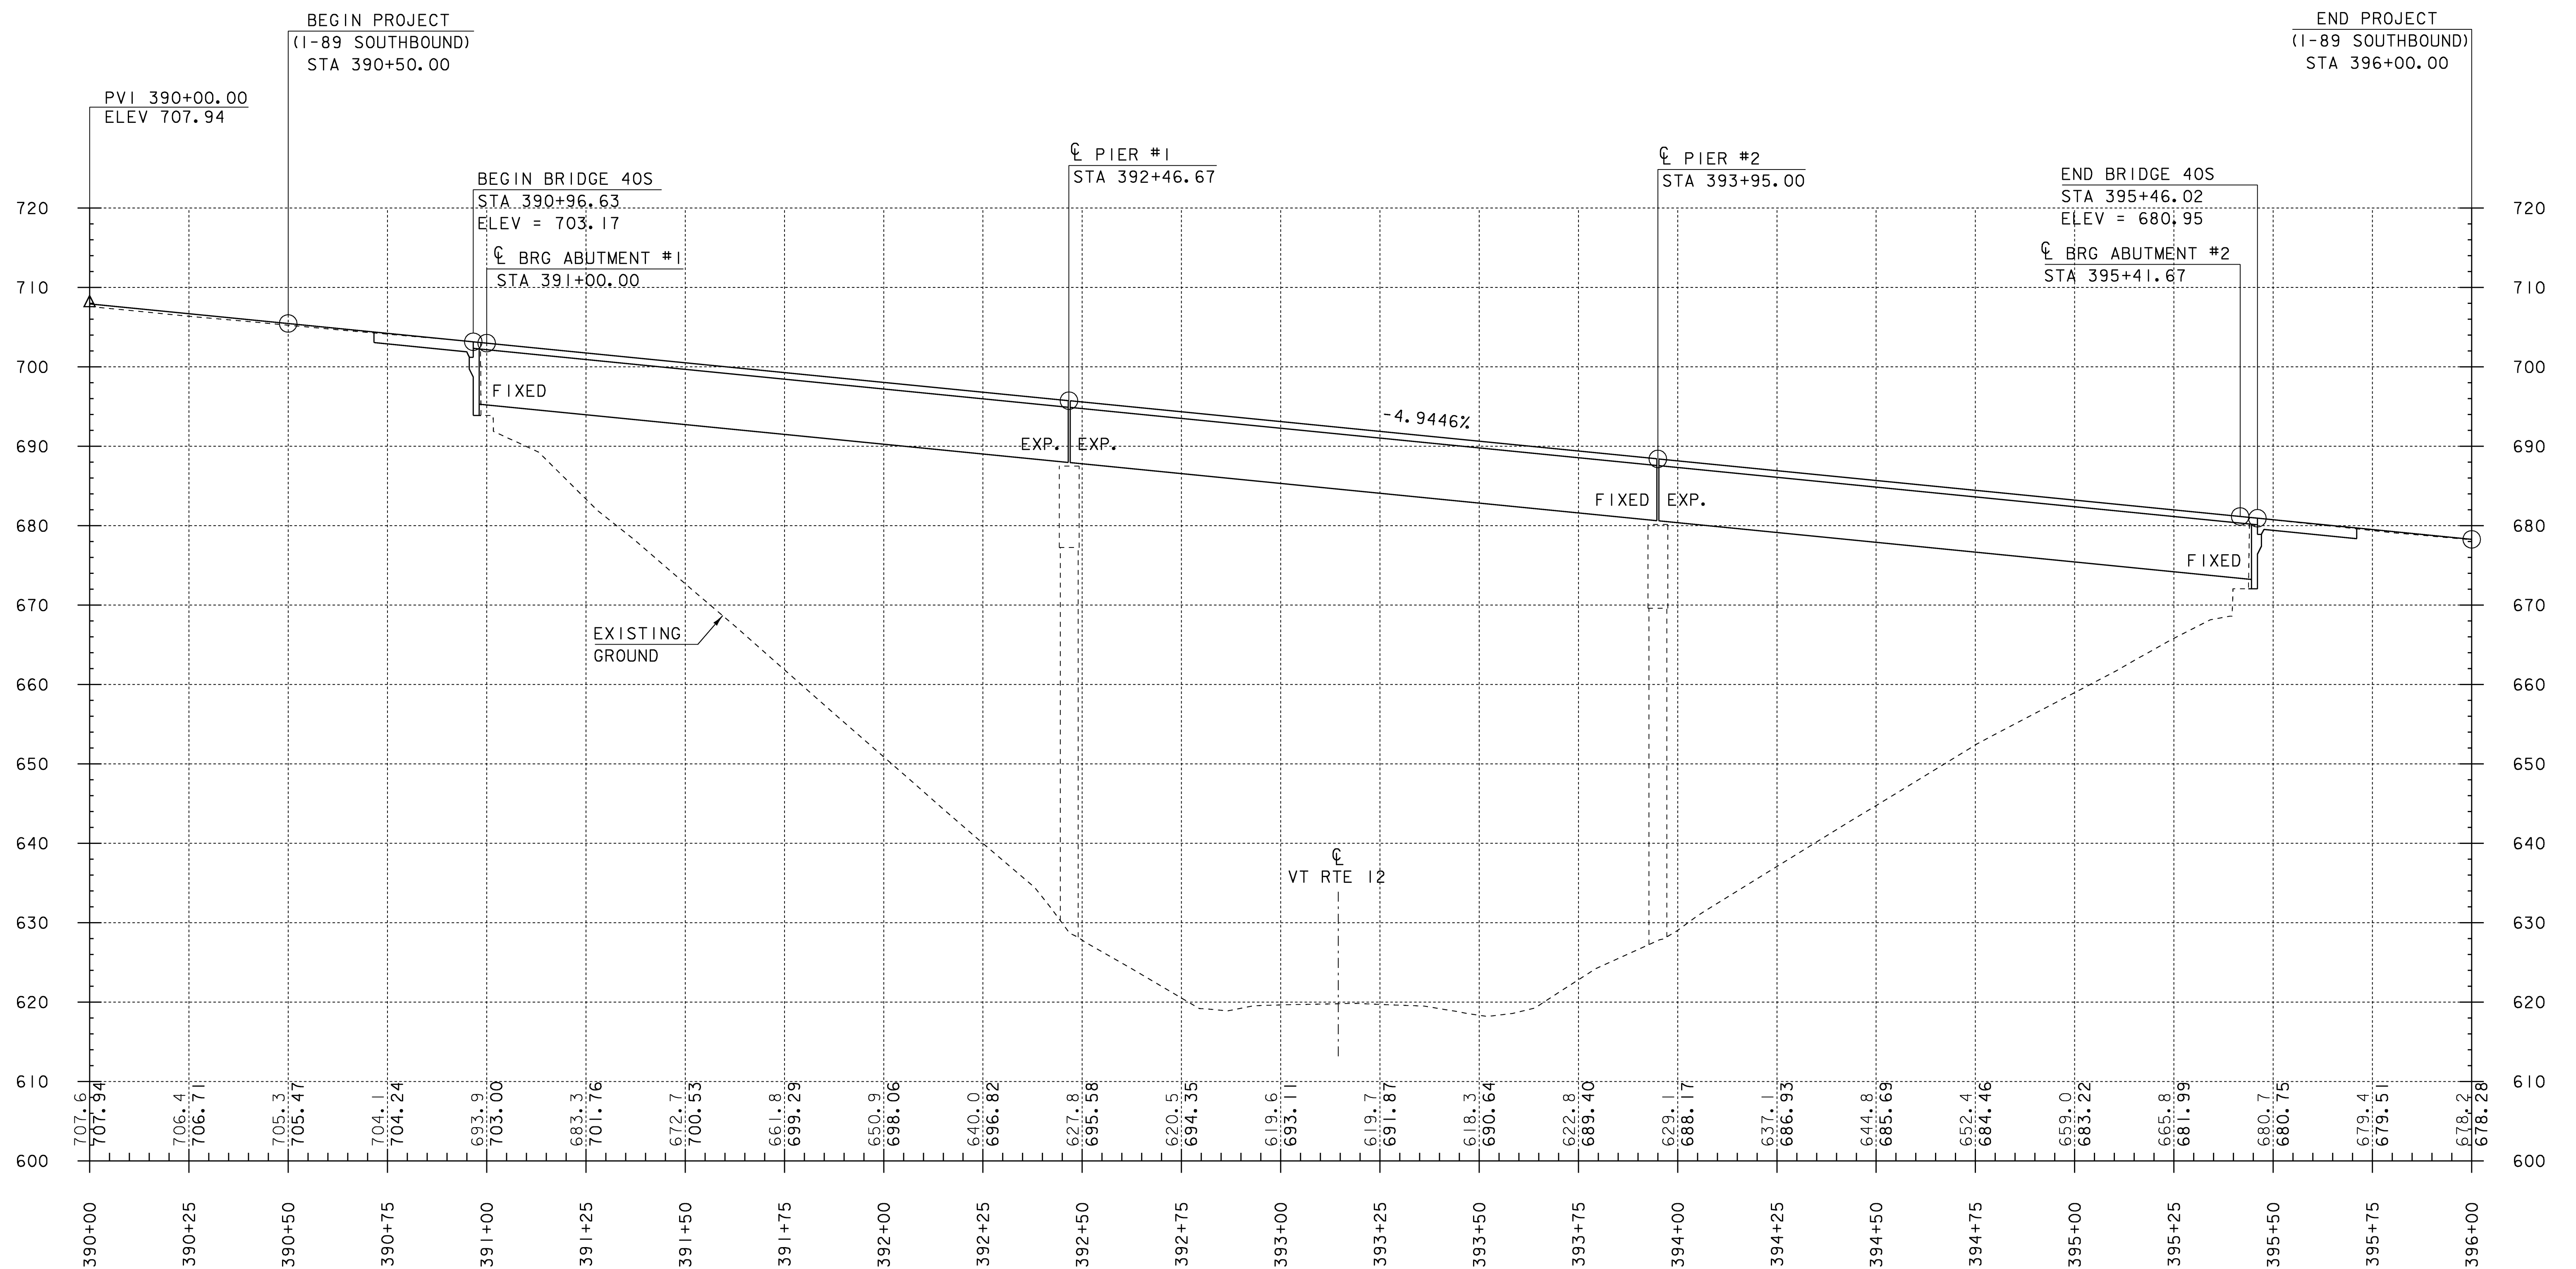


PROFILE #2 (LAYOUT I-89 SOUTHBOUND)

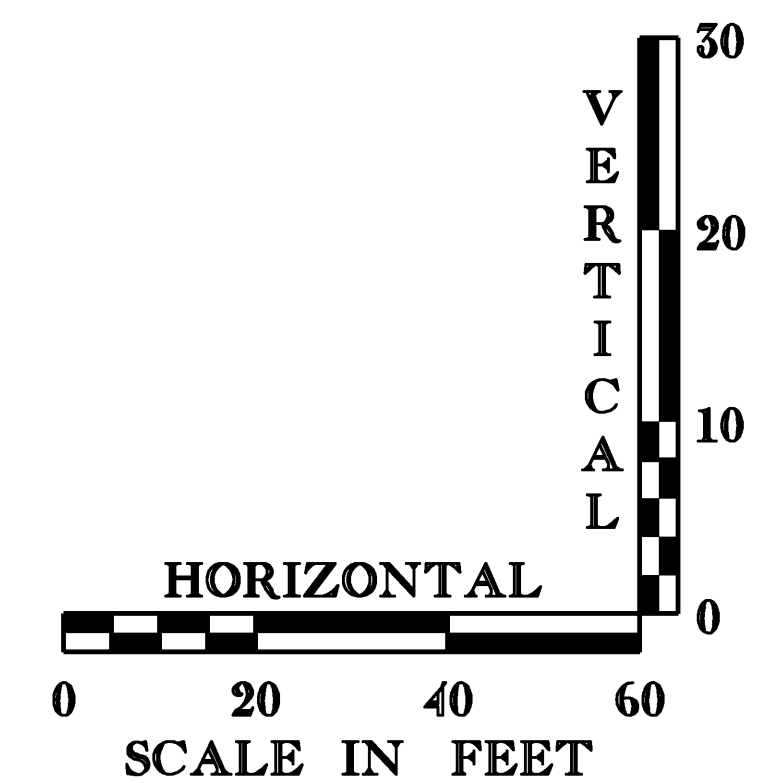


PROJECT: <b>BERLIN</b>	PROJECT NO.: <b>IM 089-1 (20)</b>
DESIGN FILE NAME: s99a270\structures\s99a270pro.dgn	PLOT DATE: 05-DEC-2007
IPARM FILE NAME: s99a270pro1.sb	DRAWN BY: D.D.BEARD
DESIGNED BY: K.M.HIGGINS	CHECKED BY: R.S.YOUNG
SQUAD LEADER: C.P.WILLIAMS	SHEET: 22 OF 104
SOUTHBOUND PROFILE 1	

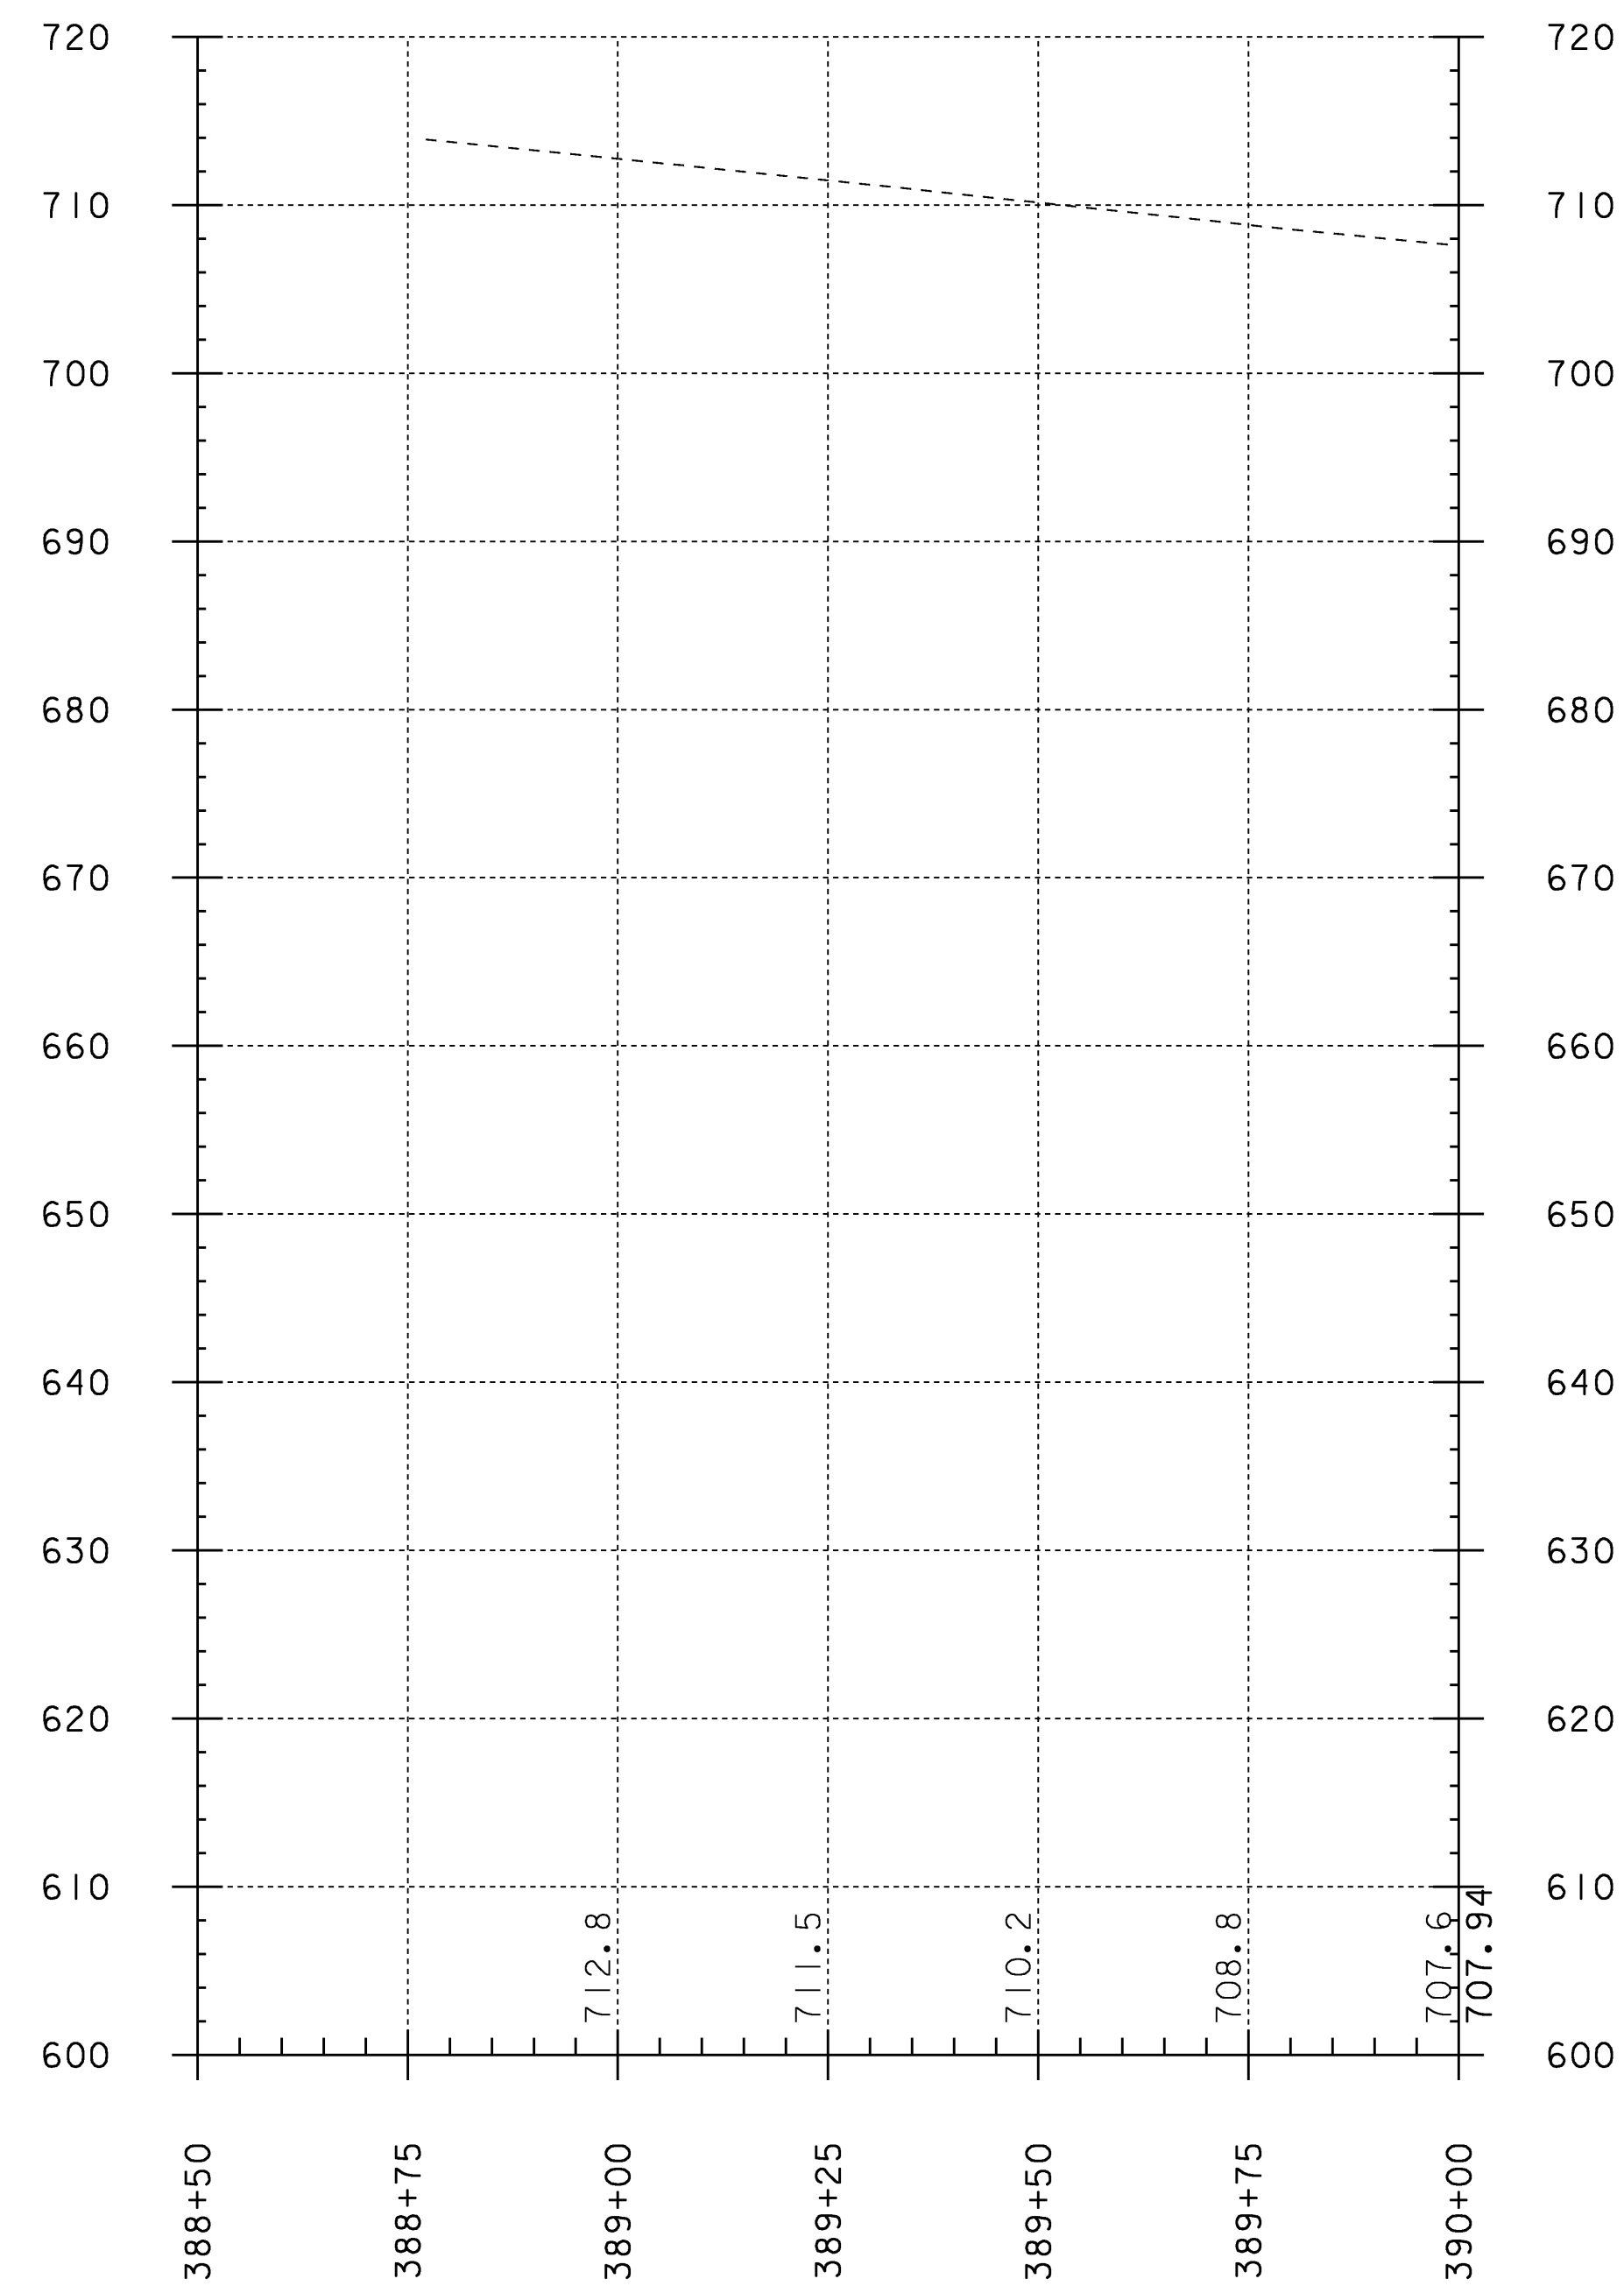

PROFILE #1 (LAYOUT I-89 SOUTHBOUND)

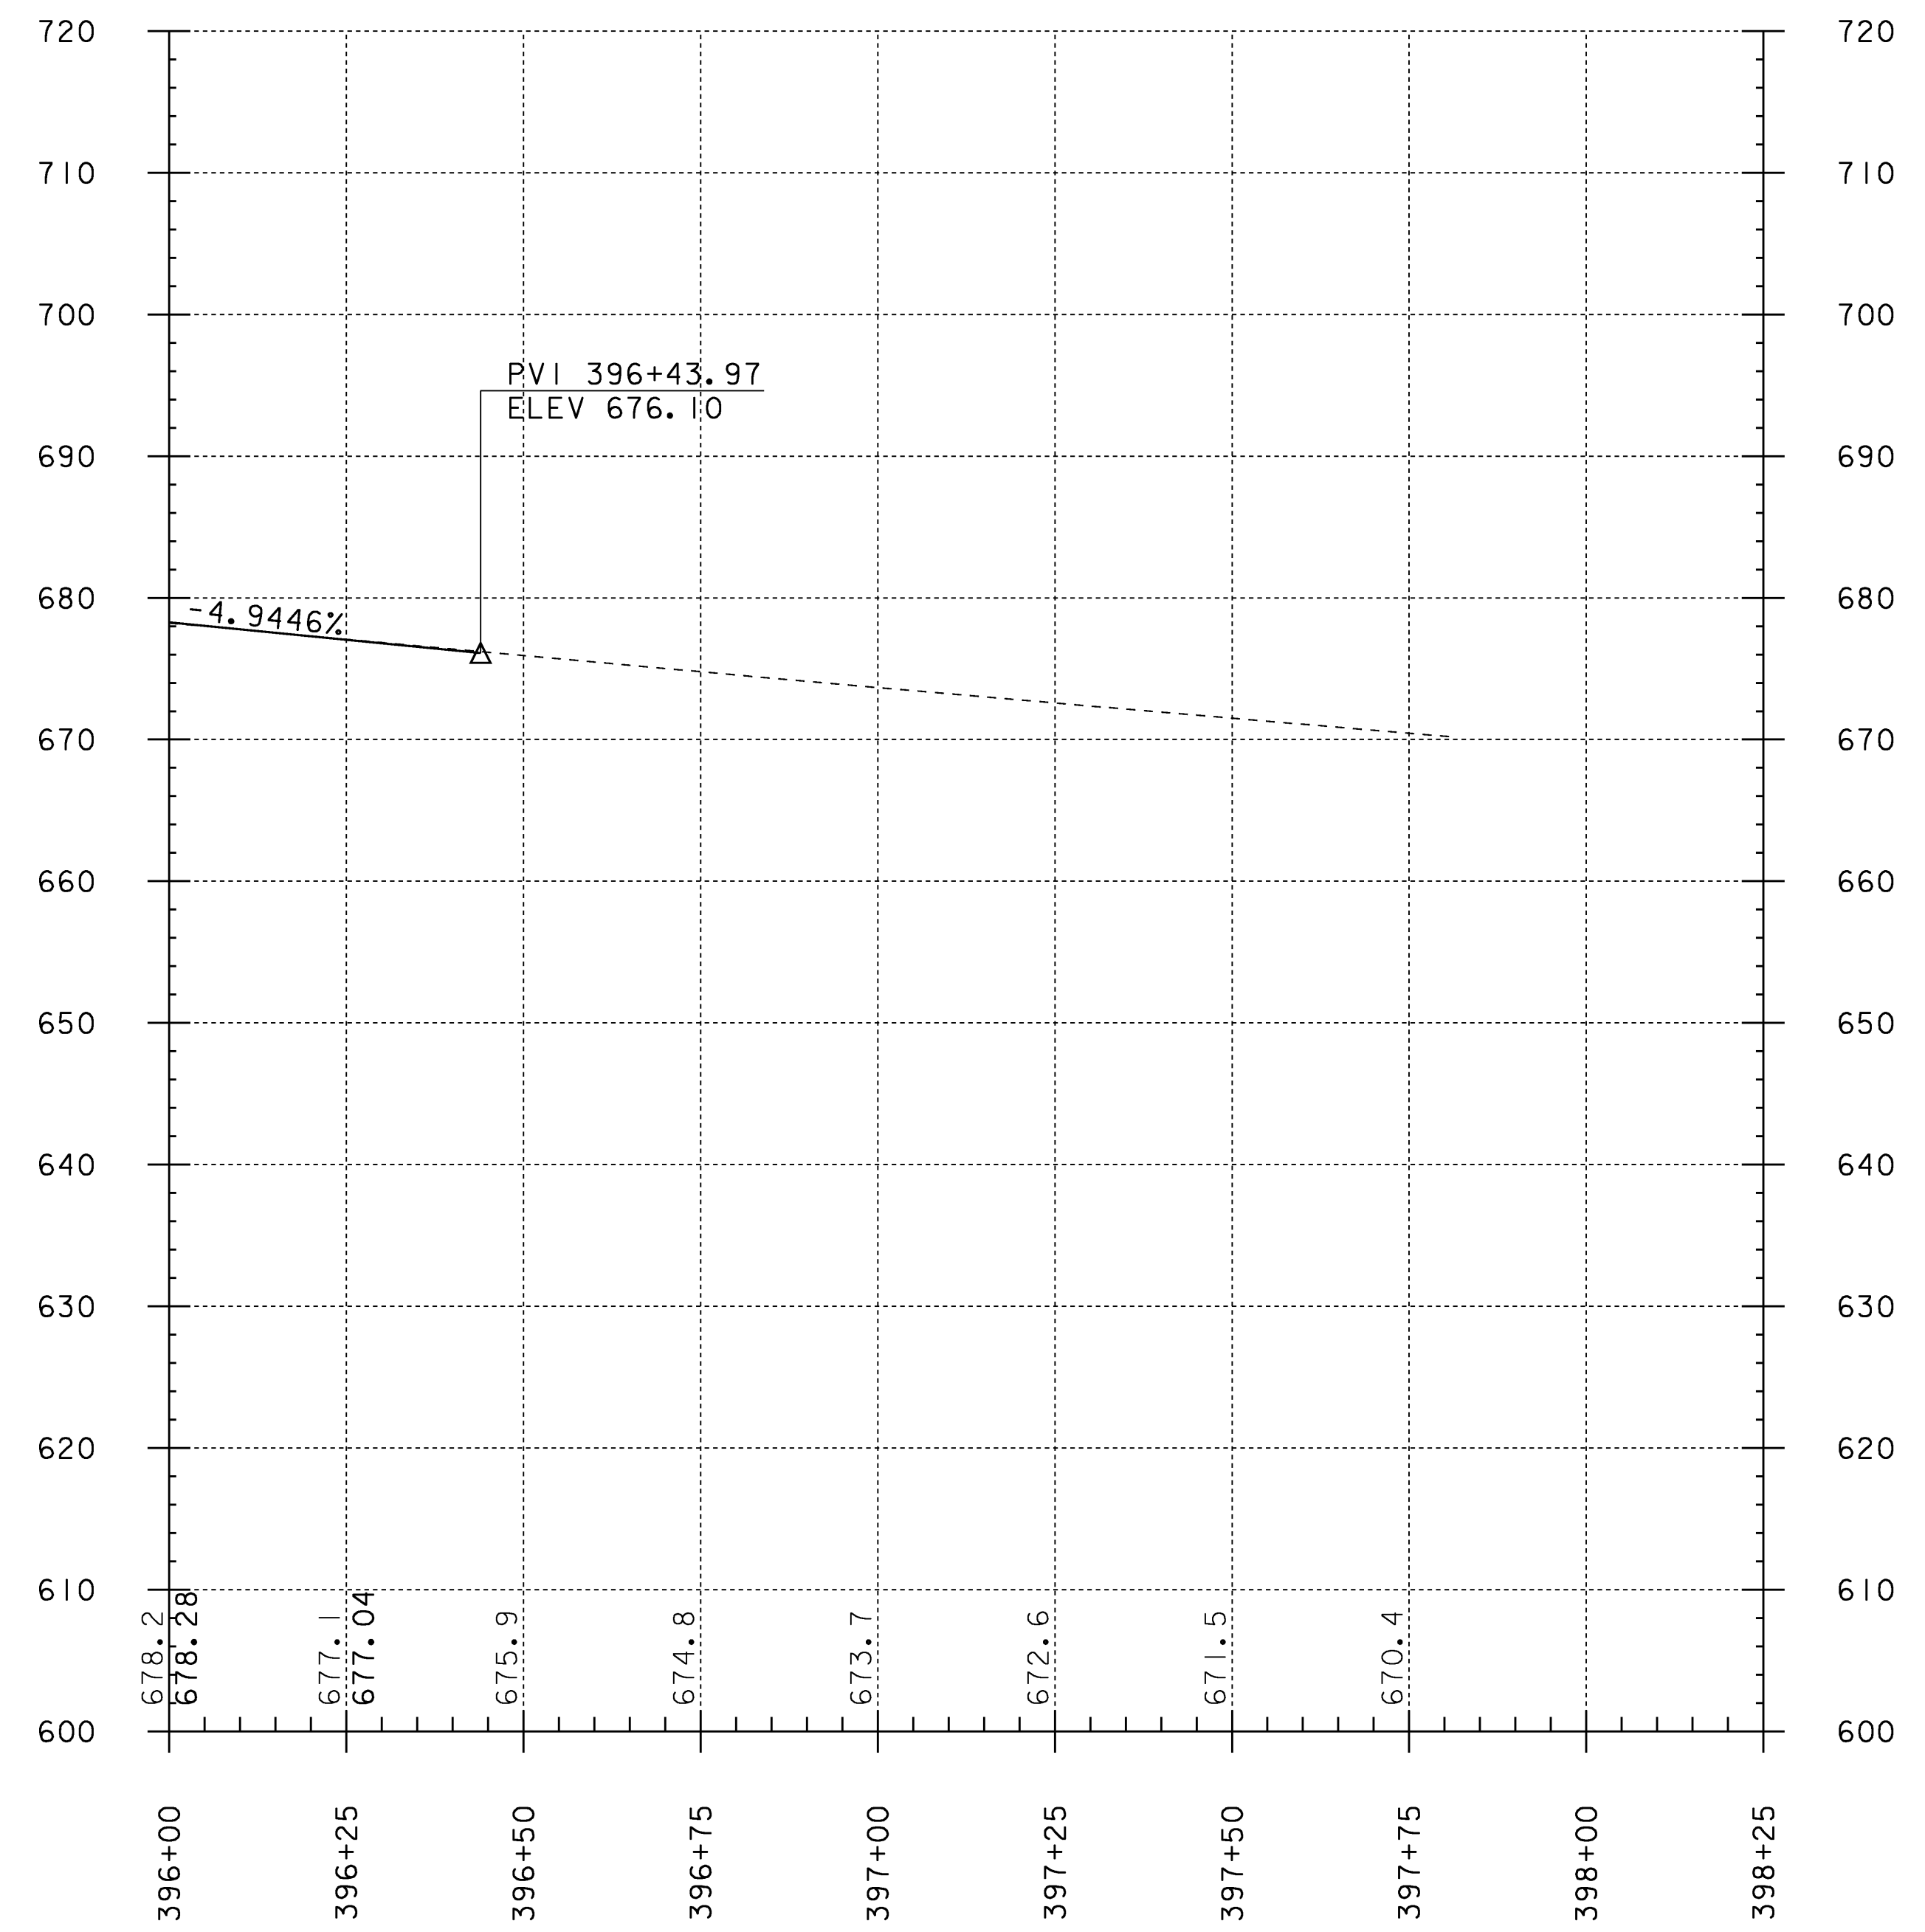

PROFILE #3 (LAYOUT I-89 SOUTHBOUND)

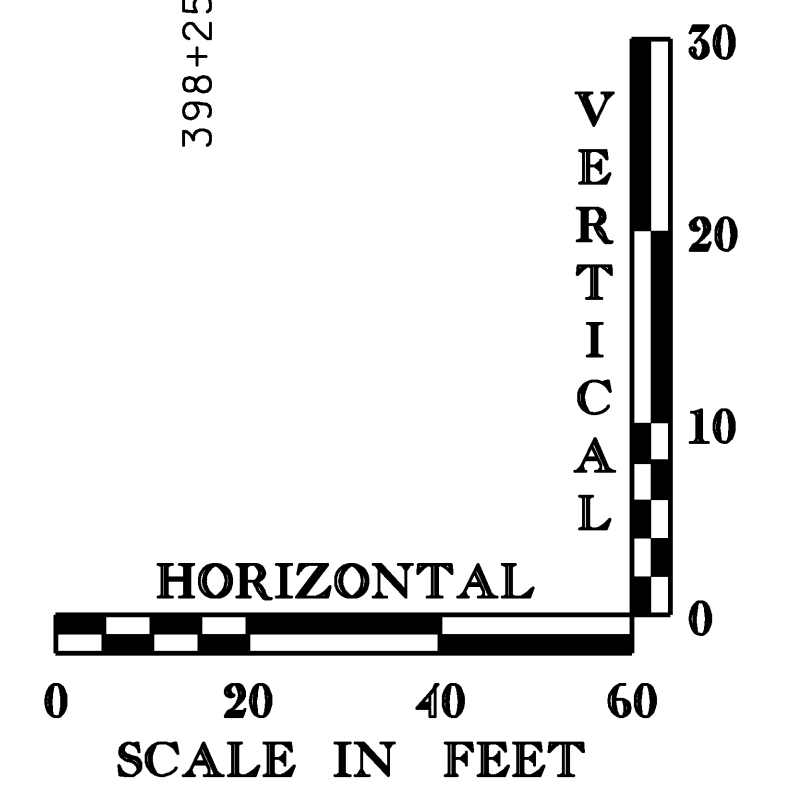


PROJECT: BERLIN	PROJECT NO.: IM 089-1 (20)
DESIGN FILE NAME: s99a270\structures\s99a270pro.dgn	PLOT DATE: 05-DEC-2007
IPARM FILE NAME: s99a270pro2.sb	DRAWN BY: D.D.BEARD
DESIGNED BY: K.M.HIGGINS	CHECKED BY: R.S.YOUNG
SQUAD LEADER: C.P.WILLIAMS	SHEET: 23 OF 104
SOUTHBOUND PROFILE 2	

# TRAFFIC CONTROL NOTES

- ALL TRAFFIC CONTROL DEVICES AND PLANS SHALL CONFORM TO THE AMERICAN ASSOCIATION OF STATE HIGHWAY AND TRANSPORTATION OFFICIALS (AASHTO) "GREEN BOOK", THE MANUAL ON UNIFORM TRAFFIC CONTROL DEVICES (MUTCD) AND VERMONT AGENCY OF TRANSPORTATION (VAOT) STANDARD SPECIFICATIONS FOR CONSTRUCTION 2006. THE RESIDENT ENGINEER SHALL HAVE THE AUTHORITY TO ALTER ALL TRAFFIC CONTROL PLANS IN THE FIELD AS NECESSARY.
- THE TRAFFIC CONTROL PLANS HAVE BEEN SHOWN ON THE ORIGINAL 1960 SURVEY DATUM.
- TRAFFIC CONTROL MEASURES WILL NOT BE PERMITTED BETWEEN THE DATES OF NOVEMBER 15 AND APRIL 15 UNLESS OTHERWISE APPROVED BY THE RESIDENT ENGINEER.
- THE CONTRACTOR SHALL SUBMIT TRAFFIC CONTROL PLANS AND SCHEDULES FOR ALL WORK ASSOCIATED WITH THIS PROJECT TO THE RESIDENT ENGINEER FOR APPROVAL PRIOR TO ANY CONSTRUCTION ACTIVITY.
- THE NUMBER AND LOCATION OF REFLECTORIZED PLASTIC DRUMS, TYPE III BARRICADES AND DELINEATORS SHOWN ON THESE PLANS ARE FOR ILLUSTRATIVE PURPOSES ONLY. THE CONTRACTOR SHALL FIELD VERIFY ALL LOCATIONS IN ACCORDANCE WITH THE APPLICABLE STANDARDS PRIOR TO PLACEMENT.
- MILE MARKERS REFERENCED IN THE DRAWINGS SHALL BE USED FOR LAYOUT PURPOSES; THE CONTRACTOR SHALL BE RESPONSIBLE FOR VERIFYING ALL MILE MARKERS NECESSARY TO DESIGN AND CONSTRUCT ALL TRAFFIC CONTROL RELATED ITEMS.
- ALL EXISTING PAVEMENT MARKINGS IN CONFLICT WITH TEMPORARY PAVEMENT MARKINGS AS SHOWN IN THE STANDARD E-103, E-104 AND E-104A, SHALL BE COVERED WITH ITEM 646.86 "PAVEMENT MARKING MASK". WHEN APPLIED, THE BLACK PAVEMENT MARKING MASKING TAPE SHALL BE CUT AT 100' INTERVALS TO PREVENT UNRAVELING.
- PAYMENT FOR PORTABLE CHANGEABLE MESSAGE SIGNS SHALL BE UNDER ITEM 641.15 "PORTABLE CHANGEABLE MESSAGE SIGN" AND PAYMENT FOR FLASHING ARROW PANELS SHALL BE UNDER ITEM 641.16 "PORTABLE ARROW BOARD." PAYMENT FOR TRAFFIC CONTROL SIGNS, PLASTIC DRUMS, DELINEATORS, AND TYPE III (MOD.) BARRICADE SHALL BE UNDER ITEM 641.10 "TRAFFIC CONTROL". PAYMENT SHALL INCLUDE ALL NECESSARY MAINTENANCE AND REPAIRS TO THESE TRAFFIC CONTROL DEVICES ON A DAILY BASIS.
- THE CONTRACTOR SHALL KEEP AN EXTRA PORTABLE CHANGEABLE MESSAGE SIGN AND A PORTABLE ARROW BOARD ON SITE AT ALL TIMES TO BE USED AS A "BACK-UP" IN THE EVENT THAT A PORTABLE CHANGEABLE MESSAGE SIGN OR A PORTABLE ARROW BOARD IS RENDERED INOPERATIVE.
- NOT ALL EXISTING SIGNS ARE SHOWN ON THE PLANS. CONTRACTOR SHALL VERIFY LOCATION OF ALL EXISTING SIGNS IN THE FIELD. PLACEMENT OF CONSTRUCTION SIGNS SHALL BE DIRECTED BY THE RESIDENT ENGINEER WHERE CONFLICTS WITH EXISTING SIGNS OCCUR.
- THE CONTRACTOR SHALL COVER OR REMOVE ANY SIGNS THAT CONTRADICT TEMPORARY TRAFFIC CONTROL SIGNS. ALL SIGNS REMOVED OR COVERED BY THE CONTRACTOR SHALL BE REPLACED OR UNCOVERED BY THE CONTRACTOR WHEN THE TRAFFIC CONTROL PLAN IS DISASSEMBLED. PAYMENT FOR REMOVAL AND REPLACEMENT, COVERING AND UNCOVERING OF SIGNS AND PLACEMENT AND REMOVAL OF TEMPORARY OVERLAYS SHALL BE INCIDENTAL TO ITEM 641.10, "TRAFFIC CONTROL". ANY DAMAGE TO EXISTING SIGNS BY THE CONTRACTOR SHALL BE REPLACED BY THE CONTRACTOR WITH NO EXTRA COMPENSATION.
- WHERE CROSSOVERS ARE TO BE PLACED, EXISTING SLOPES SHALL BE STRIPPED OF TOPSOIL AND BENCHED AS DIRECTED BY THE ENGINEER. FILL MATERIAL SHALL BE APPROVED BY THE ENGINEER PRIOR TO PLACEMENT AND SHALL BE FREE OF EXCESSIVE AMOUNTS OF MOISTURE, ORGANICS, AND SILTS. SUBBASE MATERIAL SHALL BE APPROVED BY THE ENGINEER PRIOR TO PLACEMENT AND SHALL BE PLACED TO A MAXIMUM DEPTH OF 12 INCHES. PAVING OF CROSSOVER DETOURS SHALL BE PAID FOR AS ITEM 406.25, "BITUMINOUS CONCRETE PAVEMENT (PG 58-34)". THE PAVEMENT SHALL BE PLACED IN A SINGLE COURSE OF TYPE III MIX, AT A DEPTH OF 3". THE COST OF ALL OTHER MATERIALS AND WORK REQUIRED FOR THE DESIGN, CONSTRUCTION, AND REMOVAL OF CROSSOVERS SHALL BE INCLUDED IN THE UNIT PRICE BID FOR ITEM 641.10 "TRAFFIC CONTROL".
- THE CONTRACTOR SHALL BE RESPONSIBLE FOR INSTALLING, MAINTAINING AND REMOVING TEMPORARY DRAINAGE STRUCTURES AS NECESSARY TO MAINTAIN POSITIVE DRAINAGE TO EXISTING DRAINAGE STRUCTURES (IE: CATCH BASINS, CULVERTS) WHICH COULD BECOME BLOCKED FROM INSTALLATION OF THE CROSSOVERS. THE CONTRACTOR SHALL VERIFY THE LOCATION OF EXISTING DRAINAGE STRUCTURES AND SUBMIT A TEMPORARY DRAINAGE PLAN FOR EACH CROSS OVER TO THE RESIDENT ENGINEER FOR APPROVAL. PAYMENT FOR DEVELOPMENT OF THIS PLAN AND ALL CONSTRUCTION ACTIVITIES ASSOCIATED WITH TEMPORARY DRAINAGE SHALL BE CONSIDERED INCIDENTAL TO ITEM 641.10, "TRAFFIC CONTROL". ALL TEMPORARY CULVERTS SHALL BE INCIDENTAL TO 641.10 "TRAFFIC CONTROL".


- ALL GUARDRAIL, BRIDGE APPROACH RAIL OR BRIDGE RAIL THAT IS LAPPED IN THE OPPOSITE DIRECTION OF TRAVEL SHALL BE TEMPORARILY RESET TO PROVIDE LAPS IN THE DIRECTION OF TRAVEL. ANY WORK REQUIRED TO CHANGE DIRECTION OF THE LAPS DURING CONSTRUCTION AND RESTORE OR RESET RAILING TO ORIGINAL CONDITION AFTER CONSTRUCTION SHALL BE INCIDENTAL TO ITEM 641.10 "TRAFFIC CONTROL".
- EXISTING RUMBLE STRIPS WITHIN THE TRAVELED WAY OF THE TRAFFIC DETOUR SHALL BE FILLED BY A METHOD APPROVED BY THE ENGINEER. ALL LABOR, MATERIALS, AND EQUIPMENT NECESSARY TO DO THE WORK SHALL BE INCIDENTAL TO ITEM 641.10 "TRAFFIC CONTROL." NEW RUMBLE STRIPS SHALL BE INSTALLED ACCORDING TO THE DETAILS ON SHEET 11 AND PAID FOR UNDER ITEM 213.10 "MILLED RUMBLE STRIPS."
- THE CONTRACTOR SHALL REPLACE ALL DELINEATOR POSTS, DELINEATORS, GUARDRAIL, APPROACH RAIL AND BRIDGE RAIL THAT IS DAMAGED OR DESTROYED BY THE CONTRACTOR WITH NO ADDITIONAL COMPENSATION.
- THE STATE WILL ONLY PAY FOR THE INSTALLATION OF THE FINAL MEDIAN RAILING COMPONENTS ONCE. SHOULD THE CONTRACTOR CHOOSE TO INSTALL, THEN MODIFY THIS RAILING DUE TO CHOICE OF CONSTRUCTION METHODS, THE CONTRACTOR SHALL RETURN IT TO THE FINAL PROJECT POSITION IN A LIKE NEW CONDITION AT THE CONTRACTOR'S COST.
- DURING PAINTING OPERATIONS, TWO LANES SHALL REMAIN OPEN TO TRAFFIC AT ALL TIMES.
- AN ADDITIONAL ROAD WORK AHEAD SIGN NOT SHOWN ON THE PLANS SHALL BE PLACED ON THE EXIT 7 ON-RAMP AT A LOCATION AS DIRECTED BY THE RESIDENT ENGINEER.

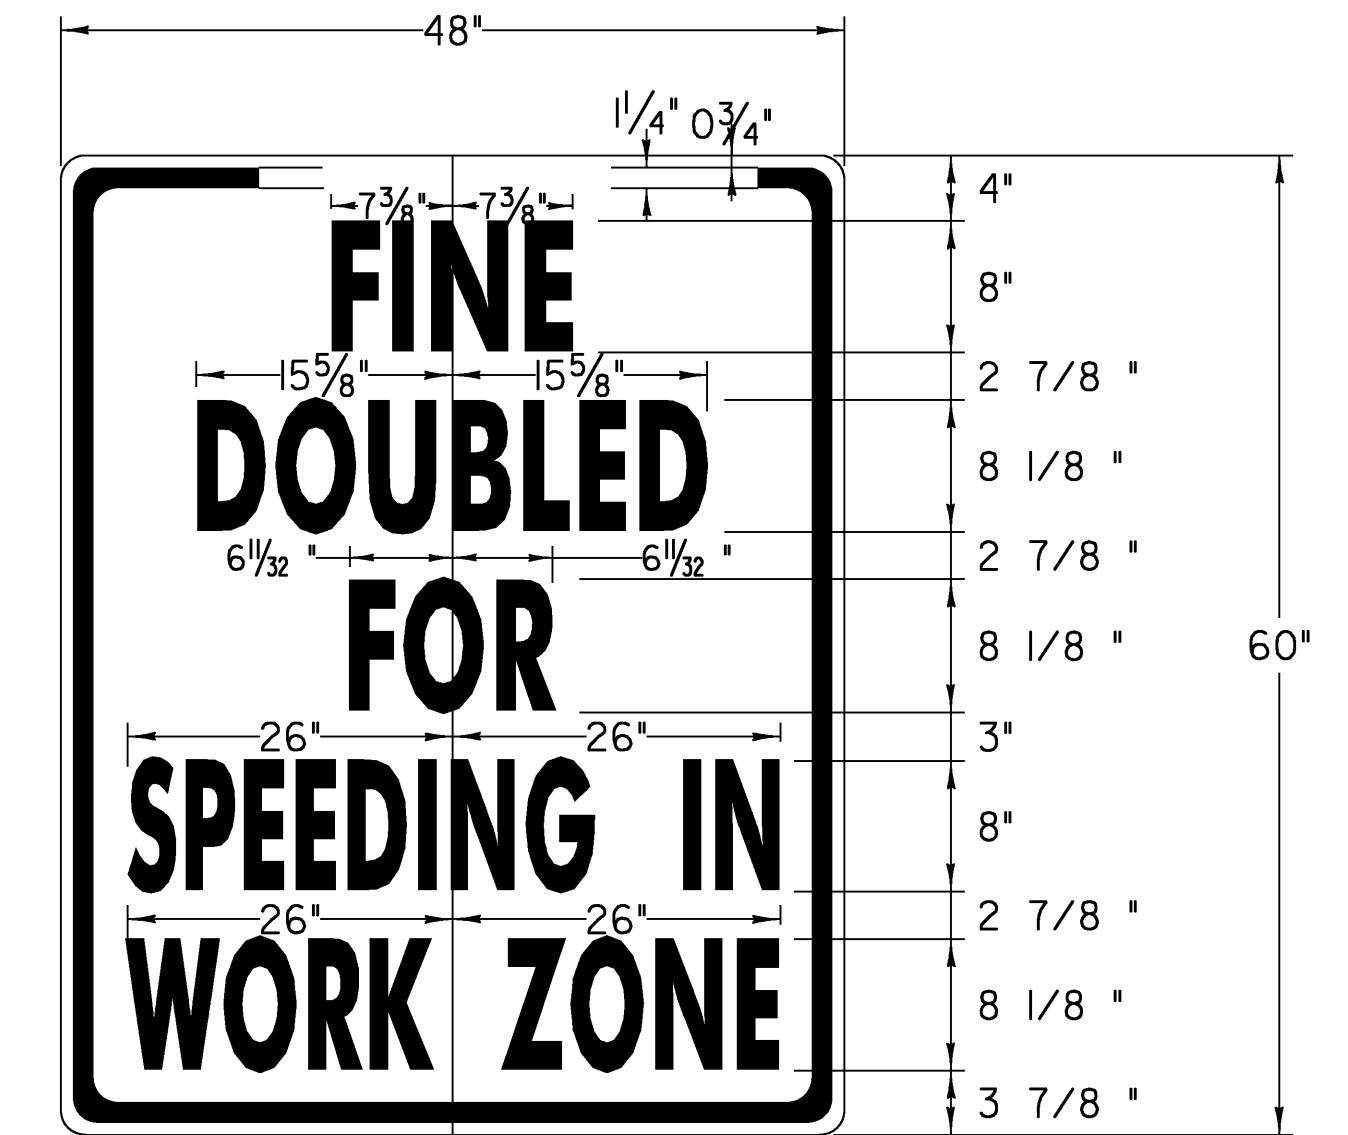

VR-355

EXPWY FWY 26\*\* REDUCE SPACING BY 12%  
EXPWY FWY 26\* REDUCE SPACEIACING BY 7.7%


COLORS: BLACK TEXT AND BORDER  
WITH WHITE REFLECTORIZED BACKGROUND

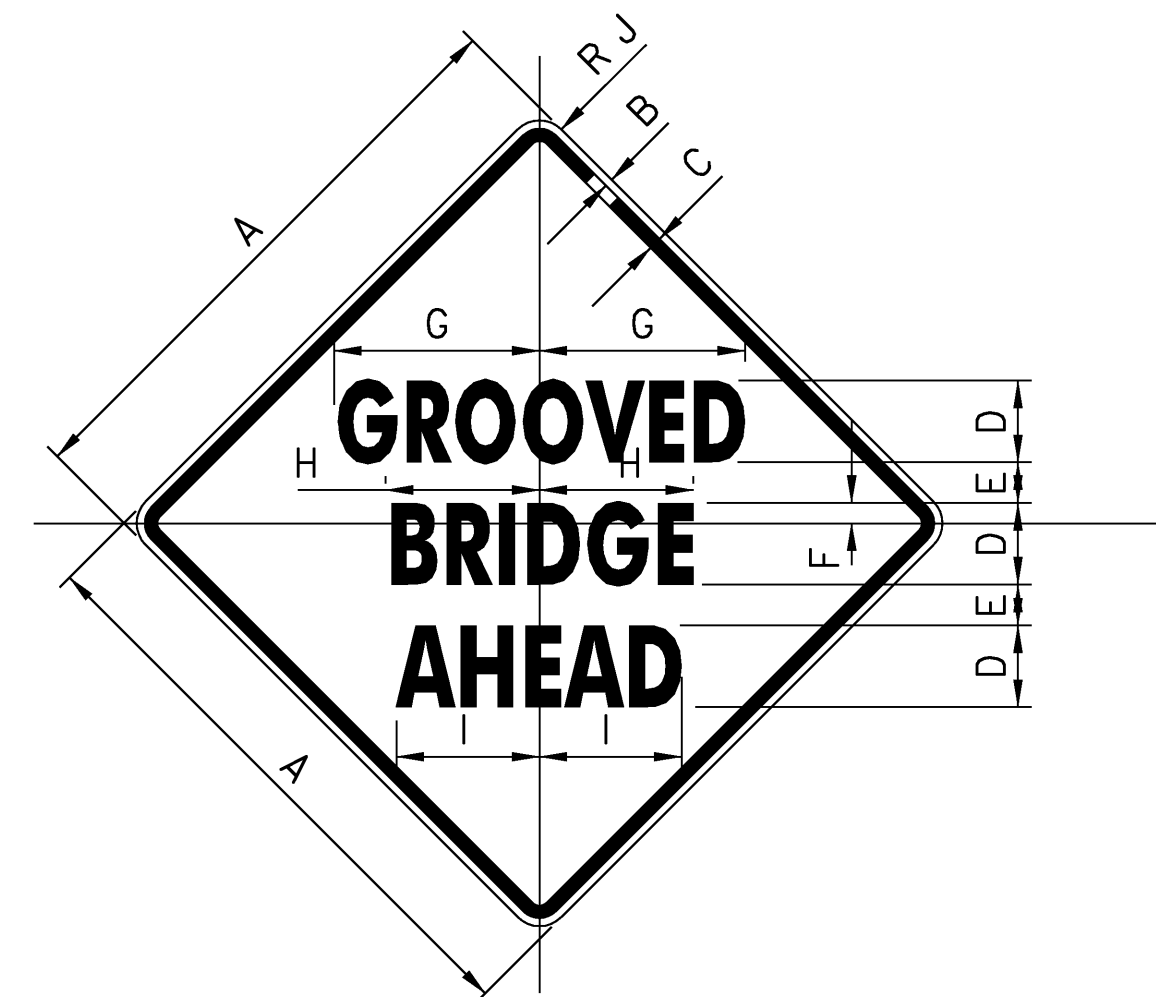

VW8-14

SIGN	DIMENSIONS ( INCHES )									
	A	B	C	D	E	F	G	H	I	J
MIN.	24	3/8	1/2	3 3/8	1 1/8	9/8	8 1/4	6 3/8	5 7/8	1 1/4
STD.	30	7/8	5/8	4 1/4	2 1/8	1 1/8	10 3/8	7 7/8	7 3/8	1 3/8
EXPWY.	36	1 1/2	3/4	5	2 1/2	1 1/4	12 3/8	9 3/8	8 9/8	1 7/8
FREEWY.	48	1 1/8	1	6 3/4	3 3/8	1 1/8	16 3/8	12 3/8	11 3/8	2 1/2

COLORS: BLACK TEXT AND BORDERS  
ON YELLOW REFLECTORIZED BACKGROUND

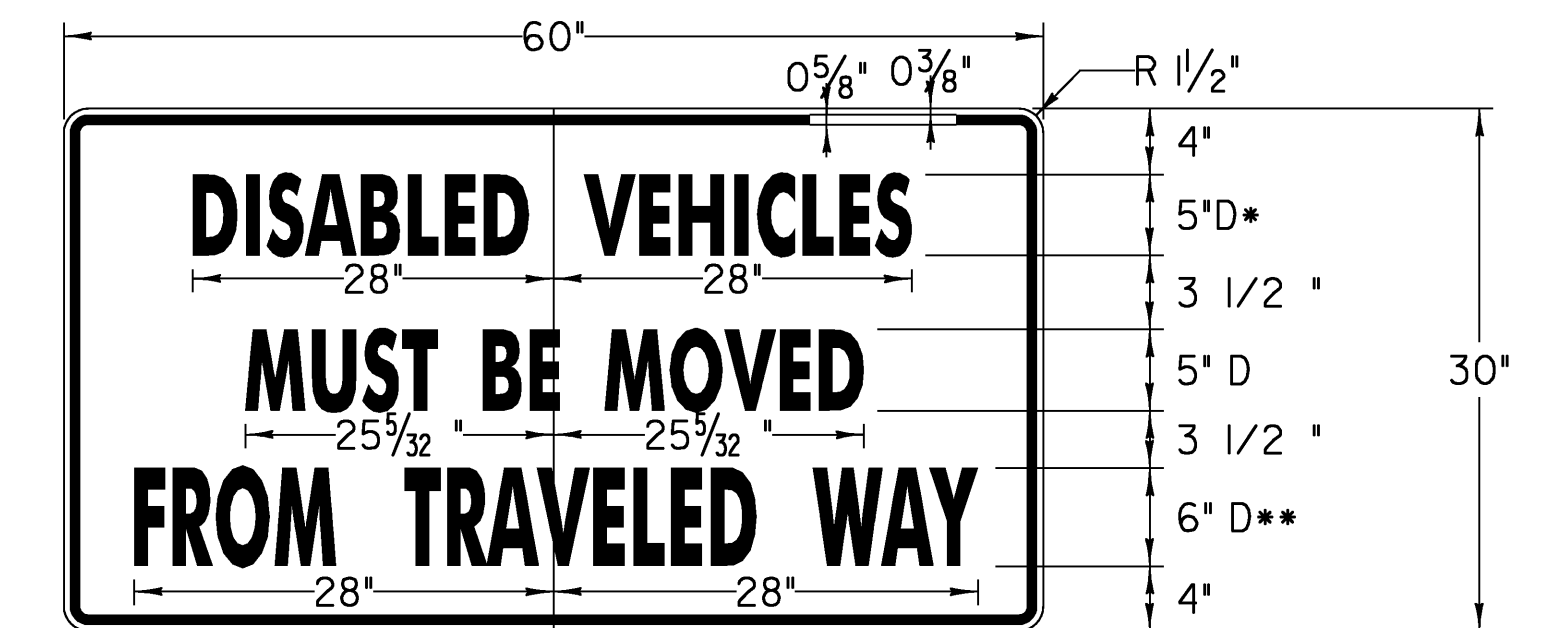


VR-355


- \* REDUCE SPACING BY 5%
- \*\* REDUCE SPACING BY 13%

COLORS: BLACK TEXT AND BORDER  
WITH REFLECTORIZED ORANGE BACKGROUND


PROJECT NAME:	BERLIN		
PROJECT NUMBER:	IM 089-1(20)		
FILE NAME:	s99a270trafnote.xls	PLOT DATE:	
PROJECT LEADER:	C.P.WILLIAMS	DRAWN BY:	SHANE MORIN
DESIGNED BY:	G. SPILAK	CHECKED BY:	R.S.YOUNG
TRAFFIC CONTROL NOTES SHEET		SHEET	24 OF 104

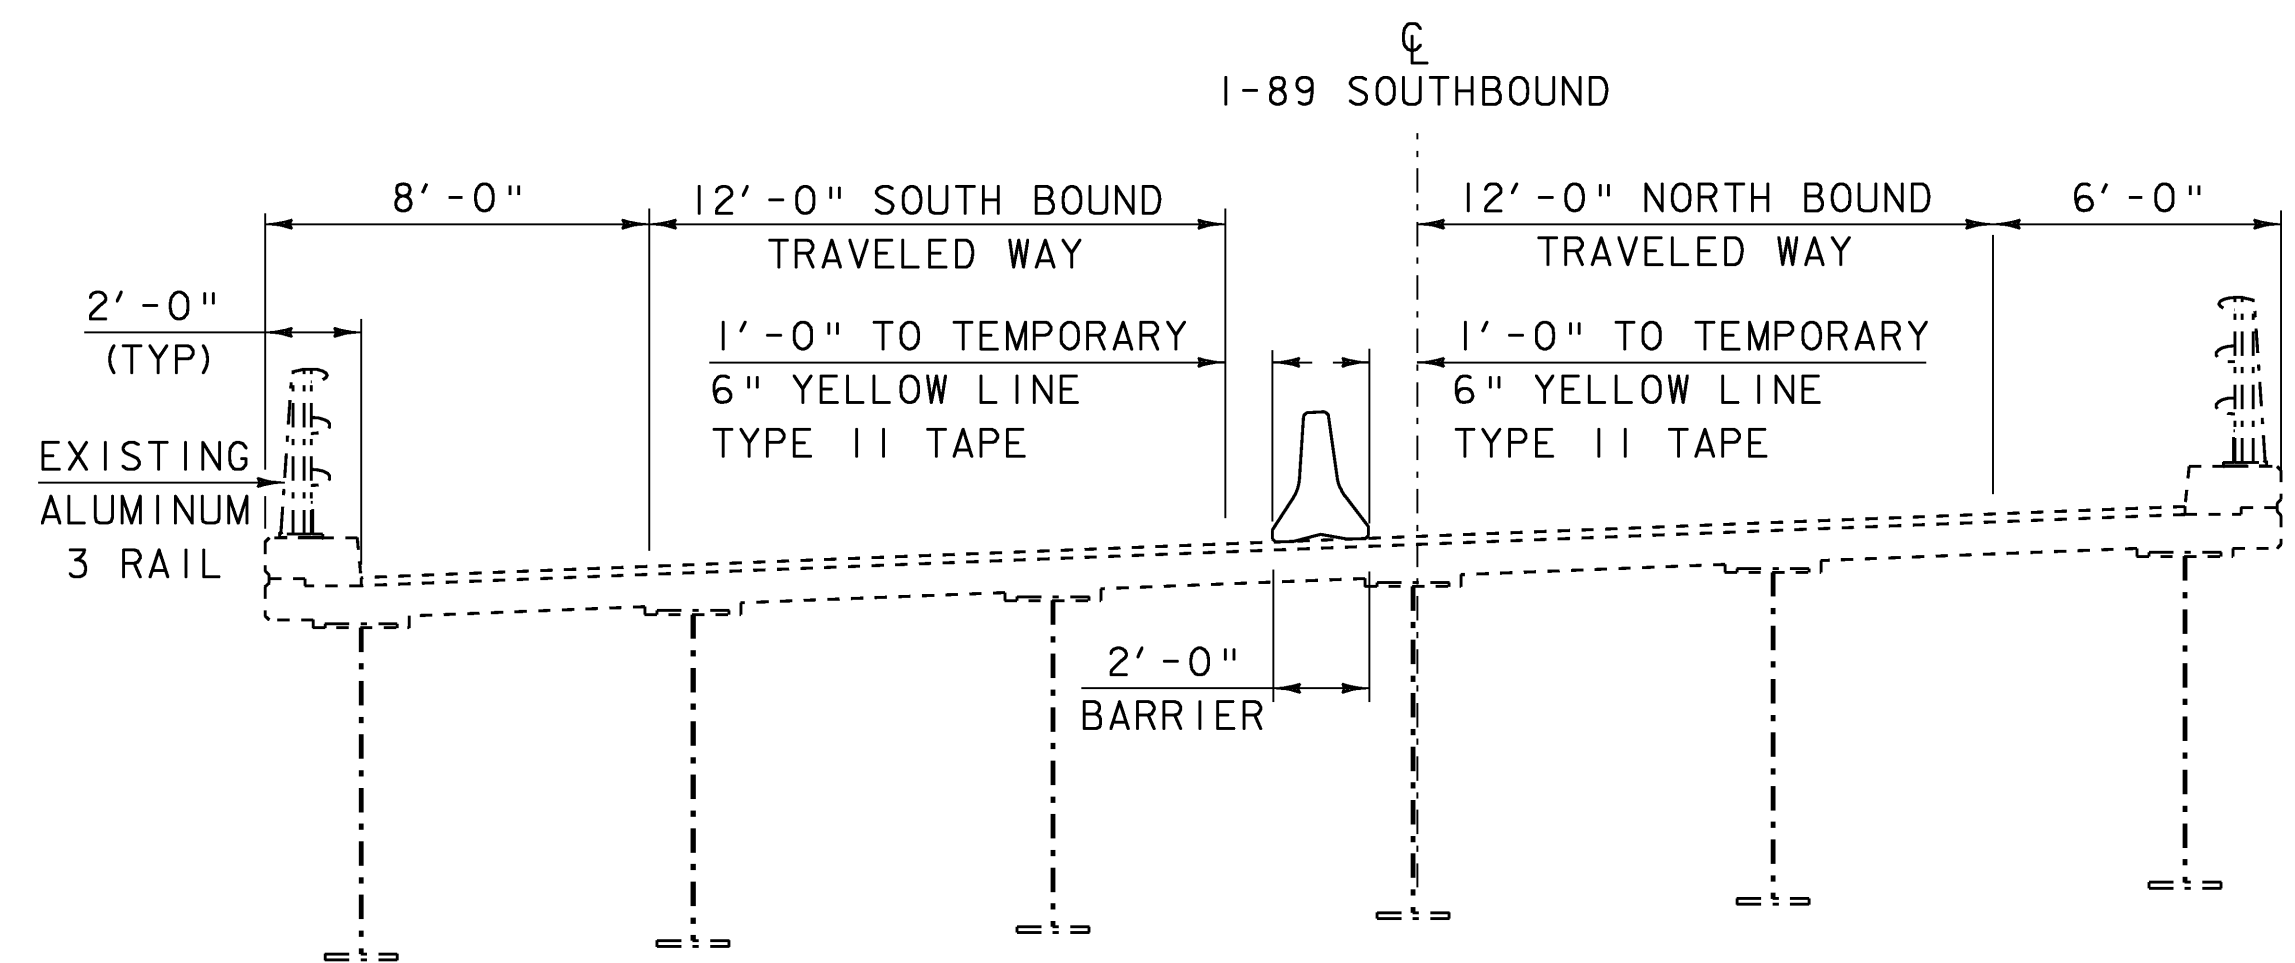


**PHASE I TYPICAL SECTION**  
**I-89 BRIDGE 40 SB (NORTHBOUND CLOSED)**  
 SCALE 1/4" = 1'-0"

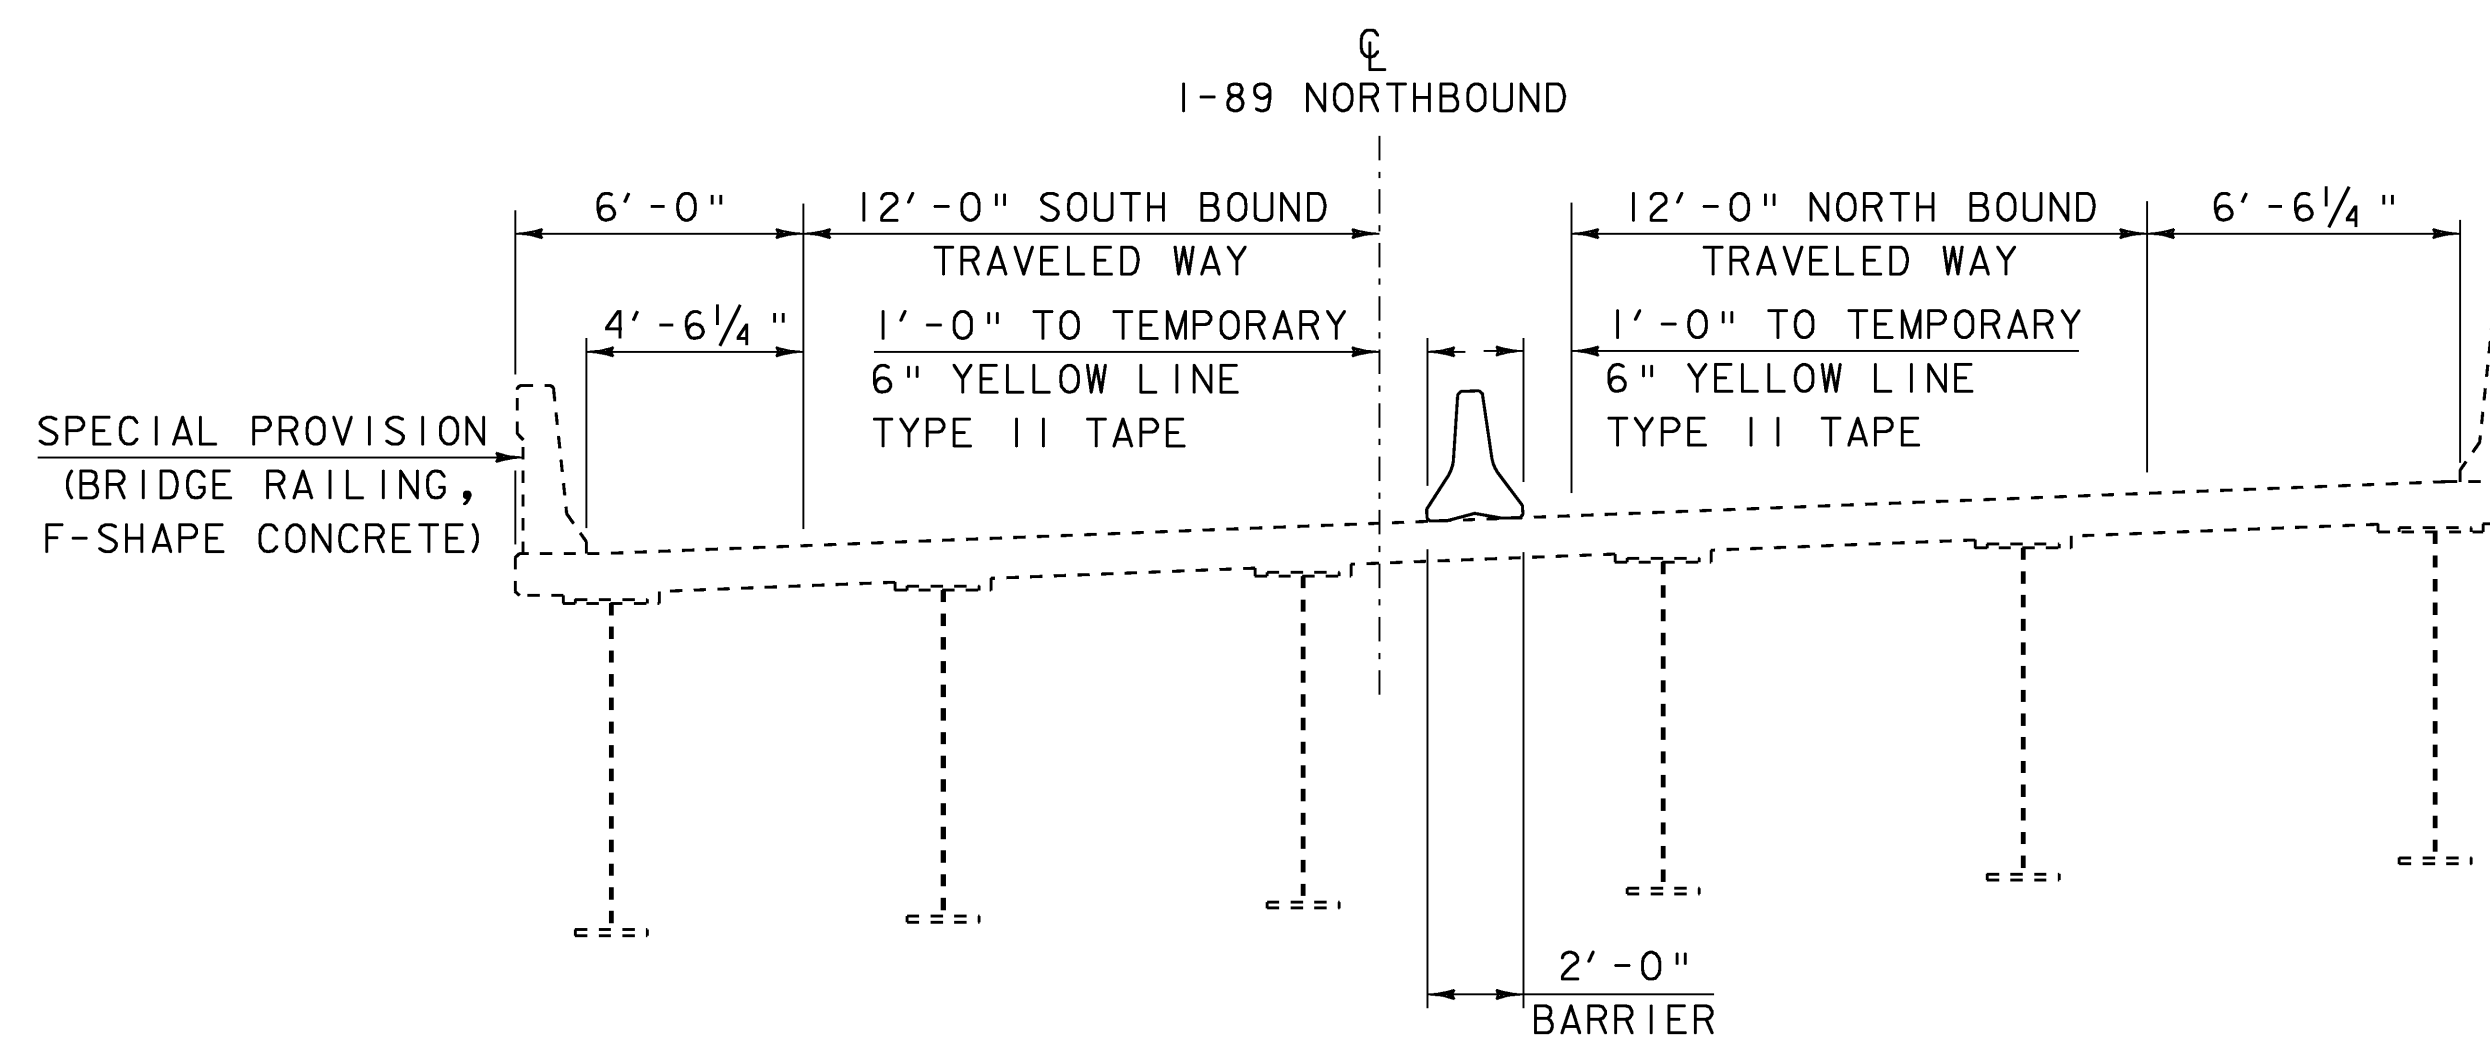

**PHASE II TYPICAL SECTION**  
**I-89 BRIDGE 40 NB (SOUTHBOUND CLOSED)**  
 SCALE 1/4" = 1'-0"

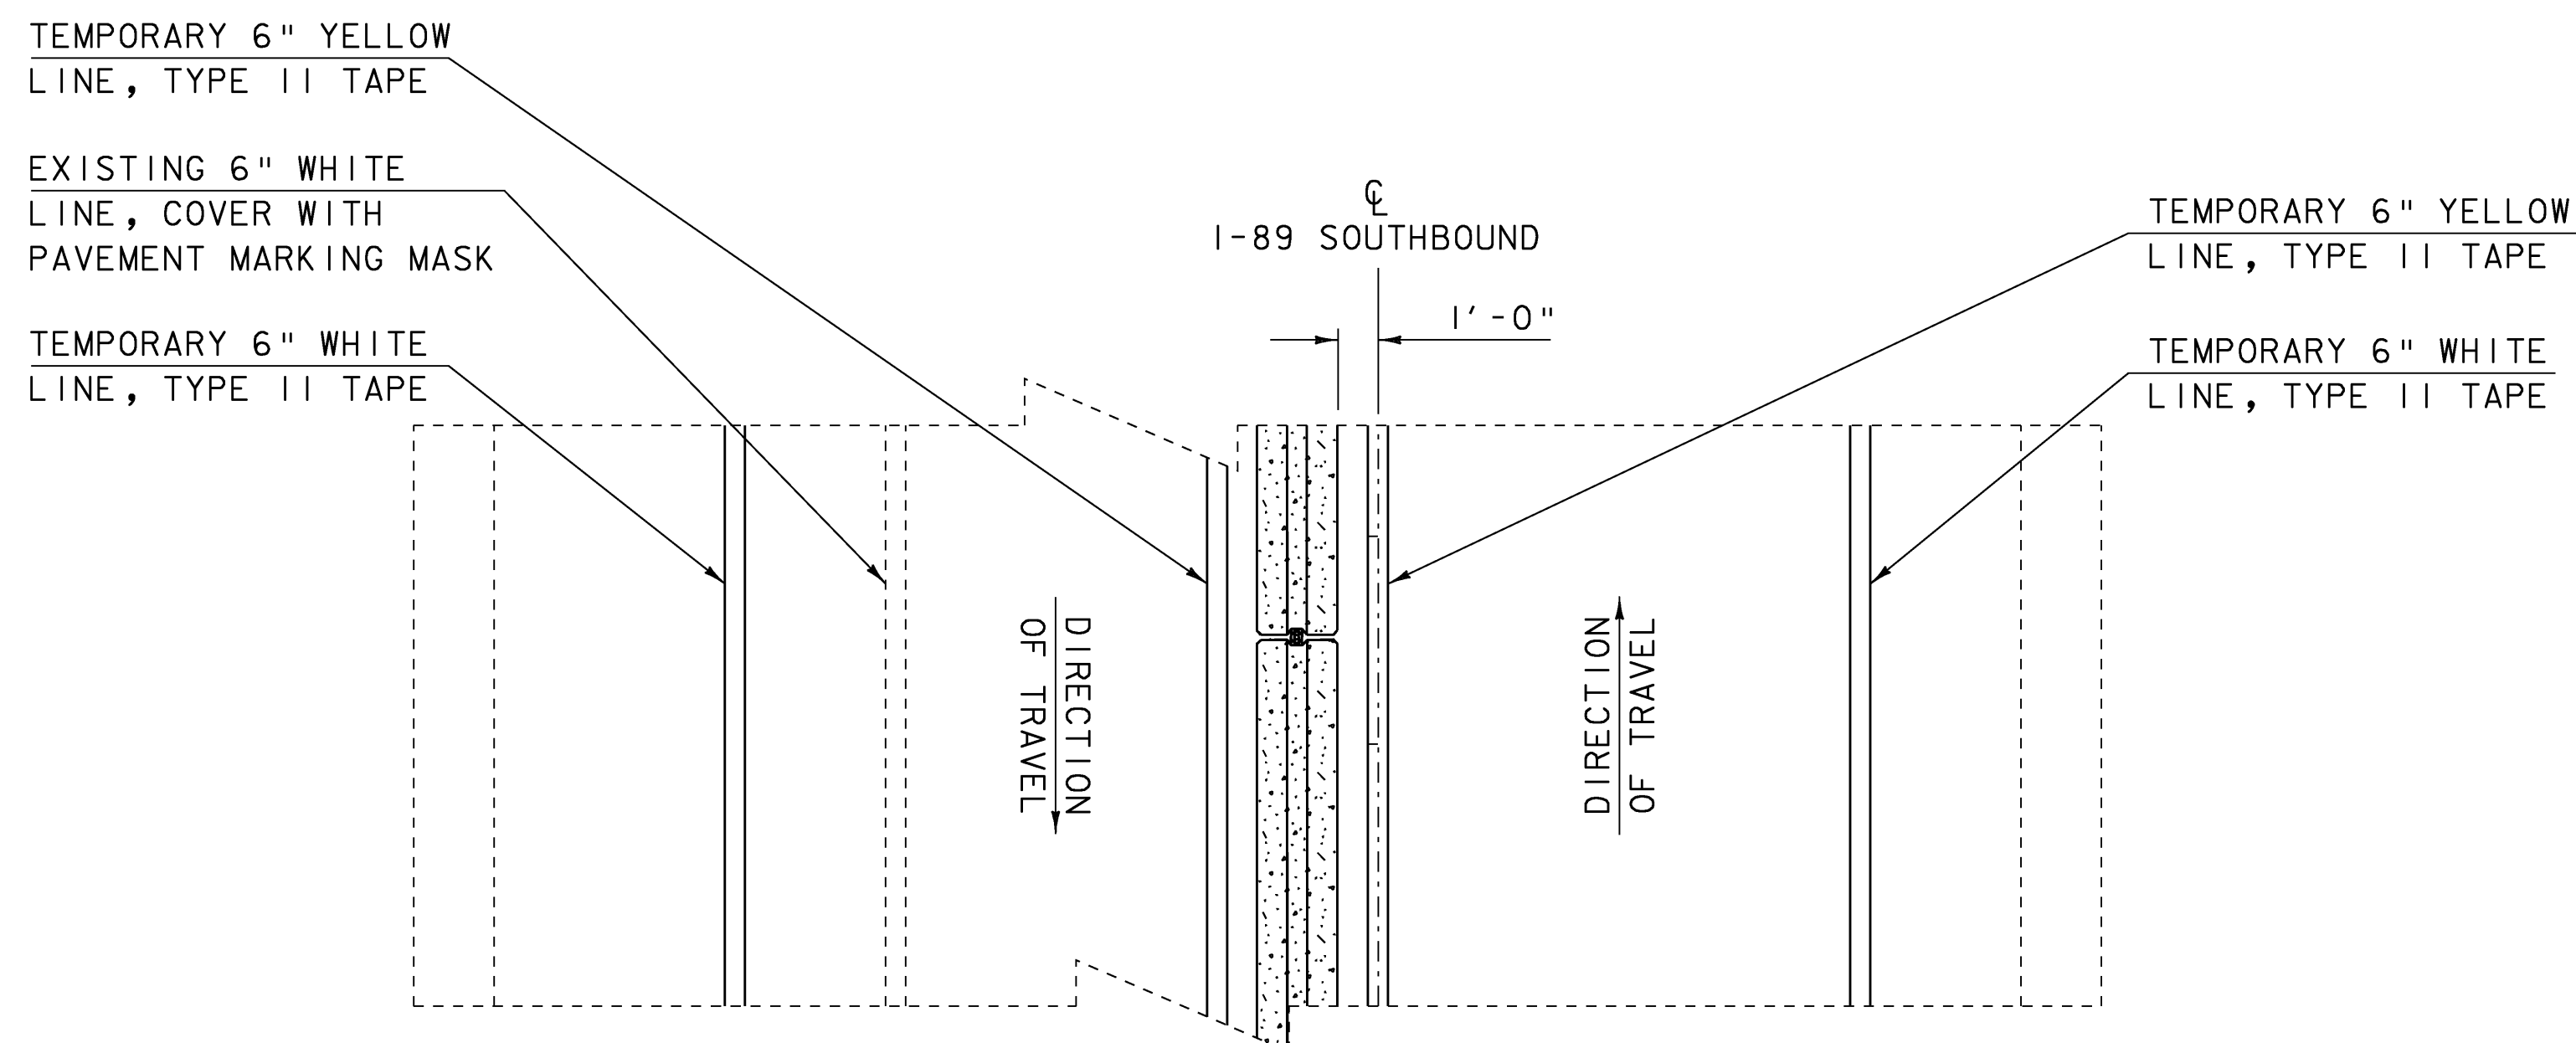

**PHASE I PLAN**  
**I-89 BRIDGE 40 SB (NORTHBOUND CLOSED)**  
 SCALE 1/4" = 1'-0"

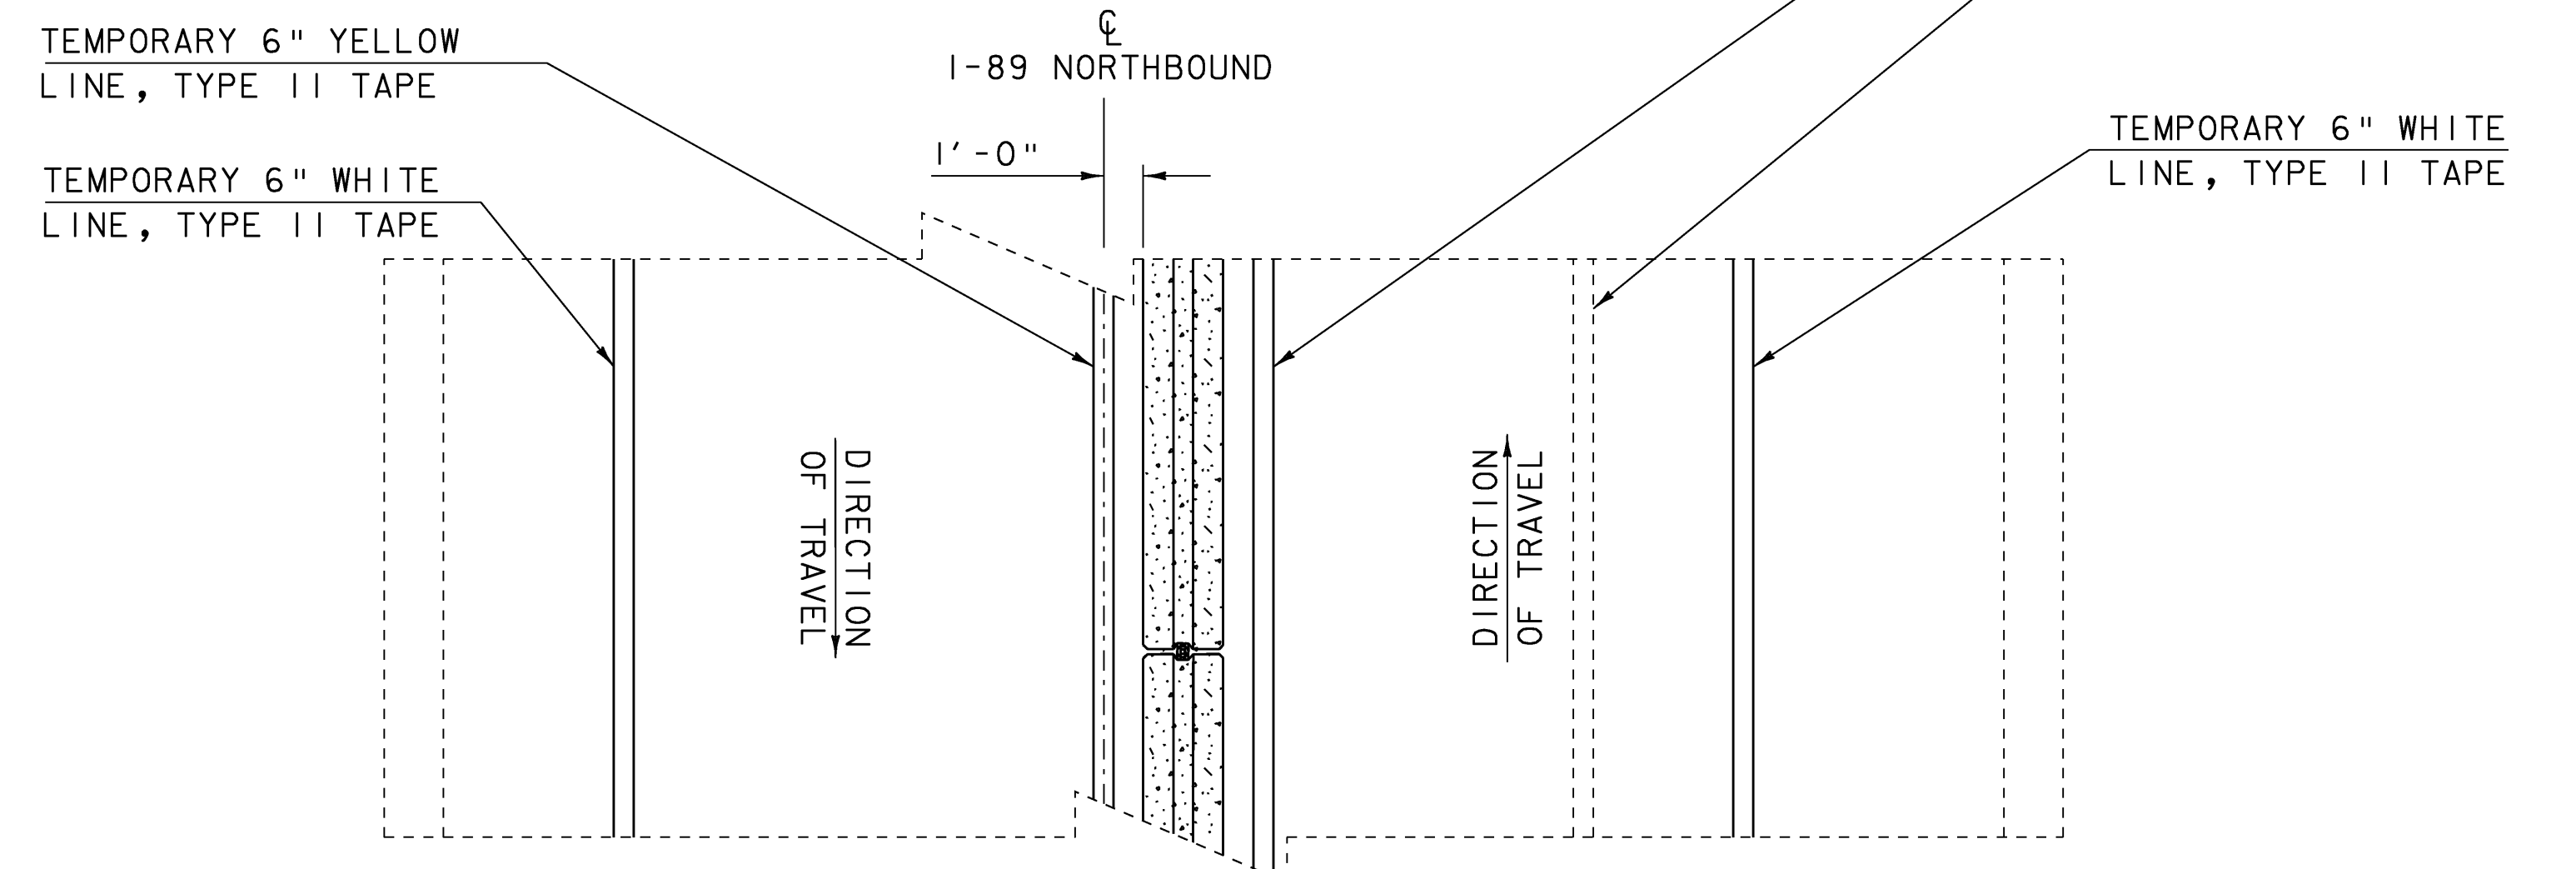


**PHASE II PLAN**  
**I-89 BRIDGE 40 NB (SOUTHBOUND CLOSED)**  
 SCALE 1/4" = 1'-0"


KEY	
---	EXISTING
—	NEW

SCALE 1/4" = 1'-0"  
 0 2 4 6

PROJECT: BERLIN	PROJECT NO.: IM 089-1 (20)
DESIGN FILE NAME: 99a270\structures\99a270trafnote.dgn	IPARM FILE NAME: s99a270traf typ.i PLOT DATE: 05-DEC-2007
DESIGNED BY: K.M.HIGGINS	DRAWN BY: D.D.BEARD
SQUAD LEADER: C.P.WILLIAMS	CHECKED BY: R.S.YOUNG
BRIDGE TRAFFIC CONTROL DETAILS	SHEET: 25 OF 104

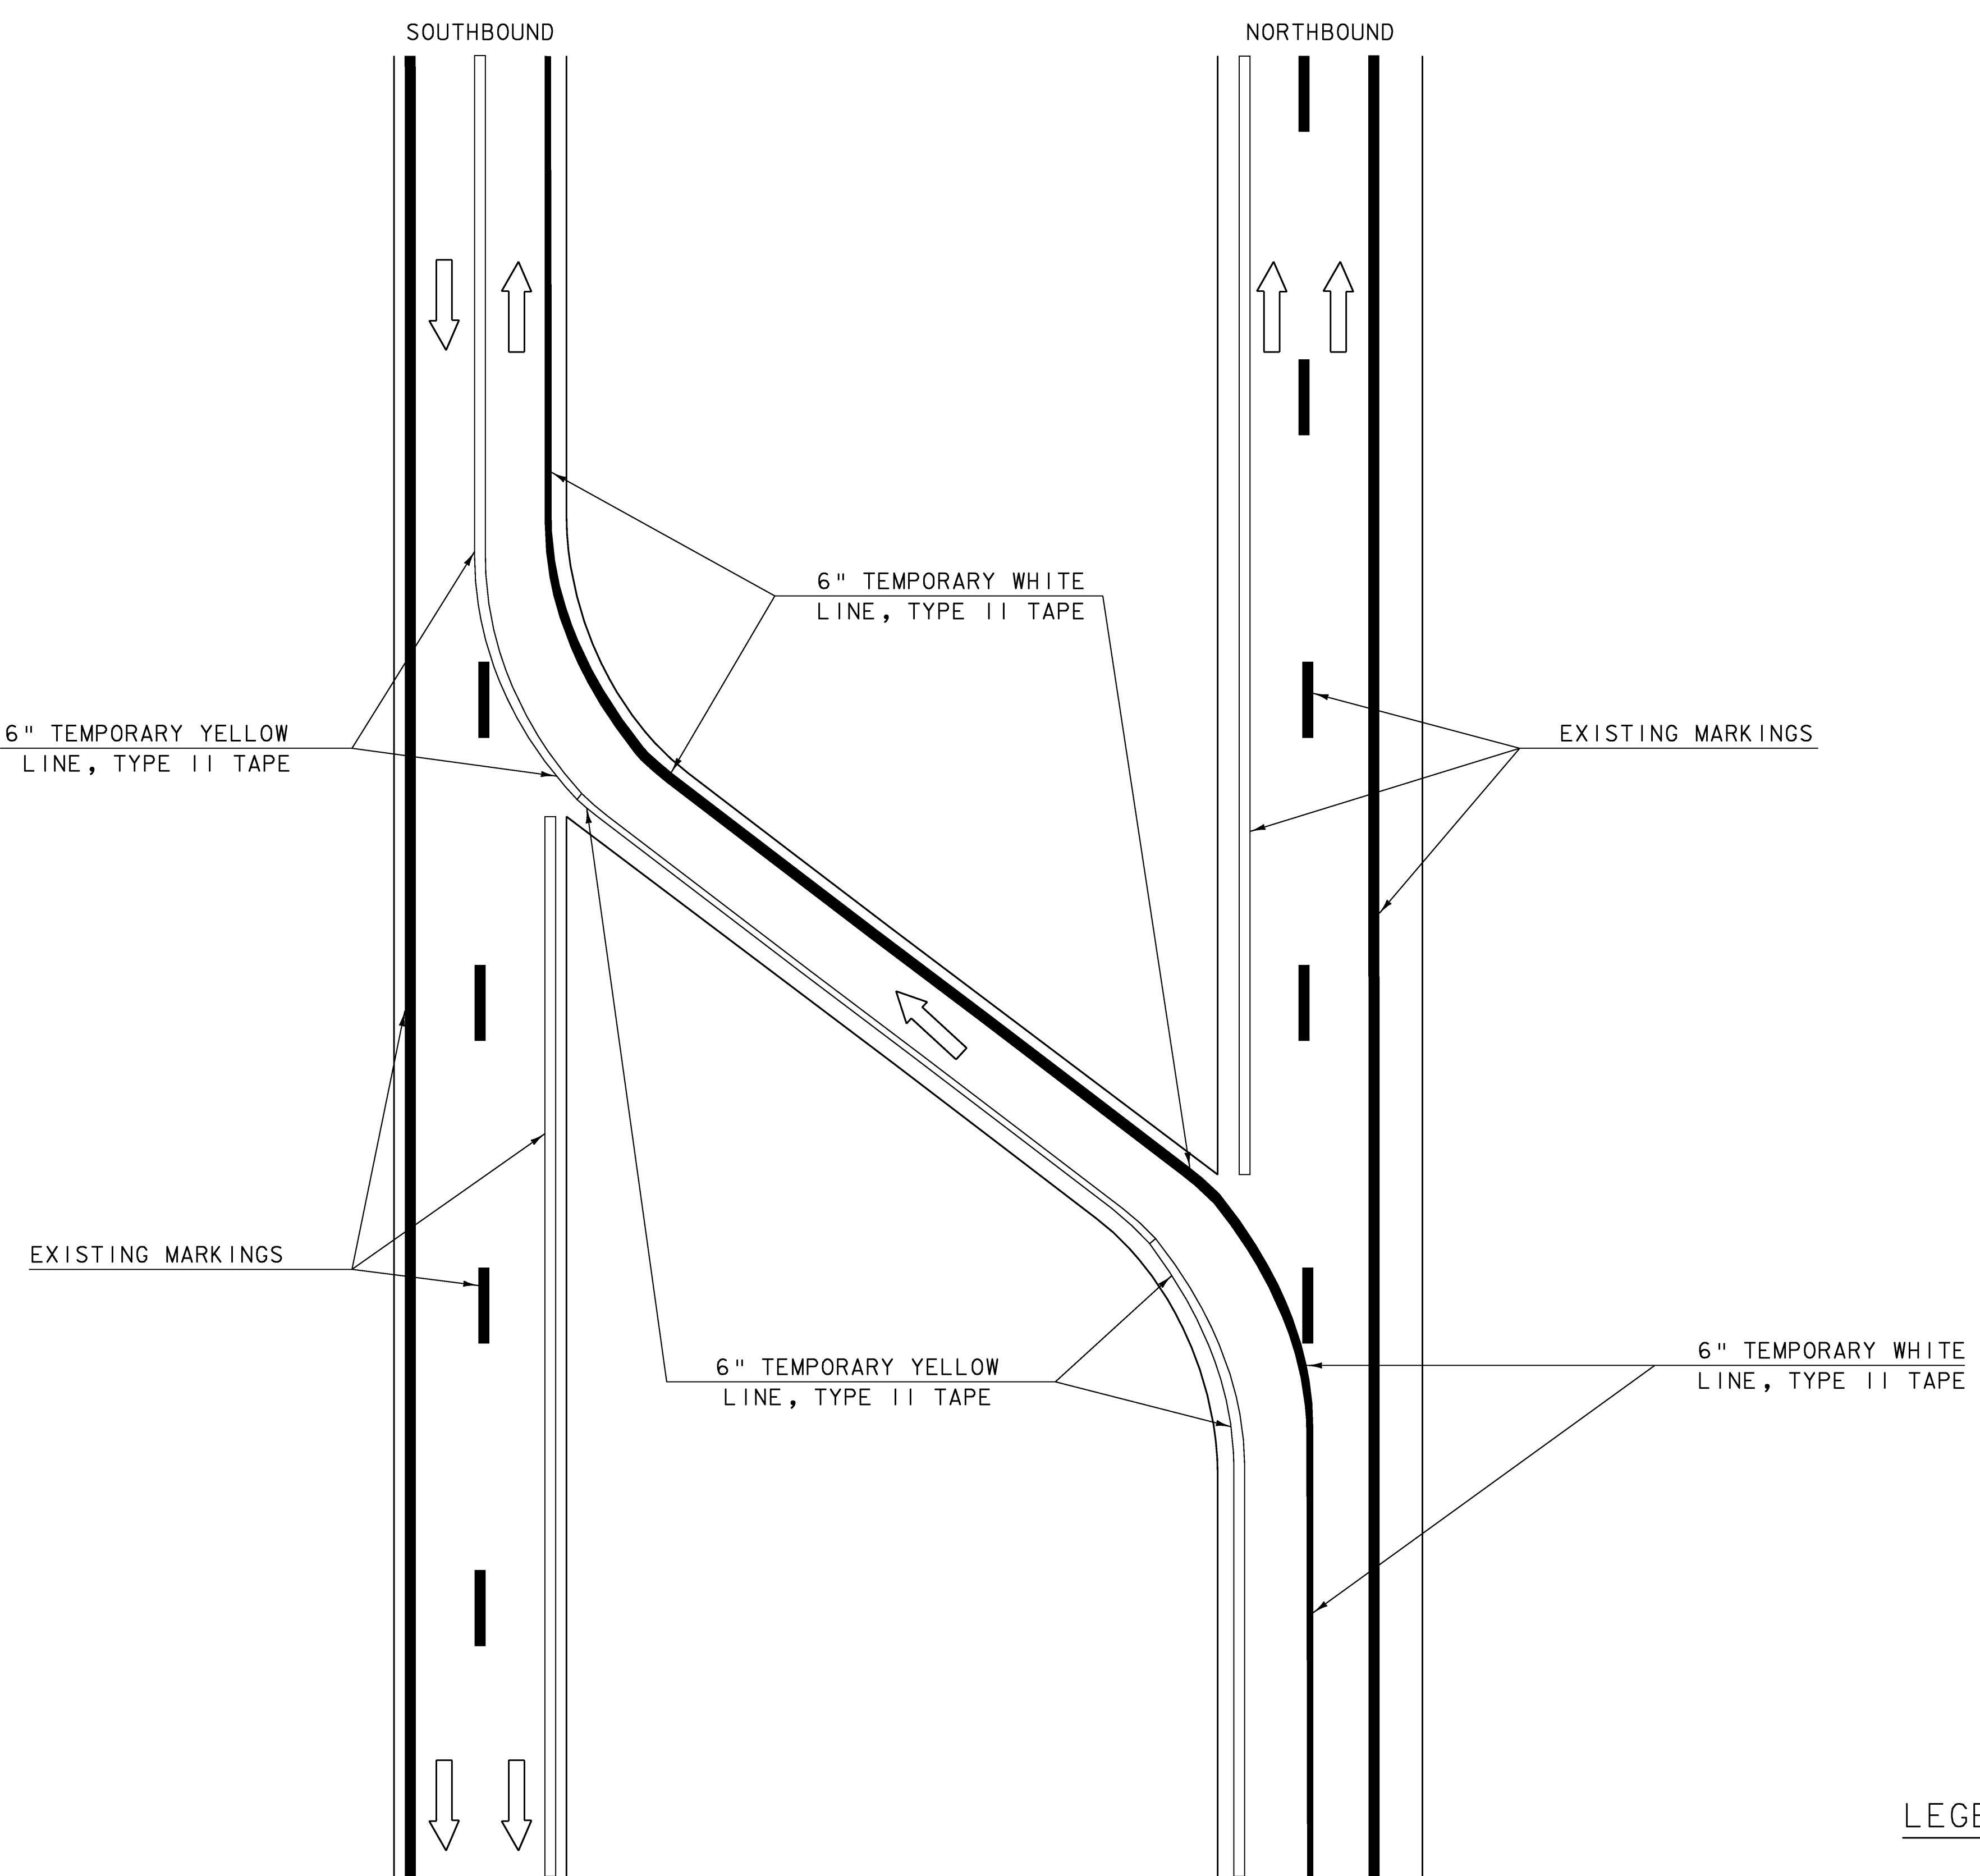

**TYPICAL MEDIAN CROSS OVER MARKINGS**  
 (NORTHBOUND SHOWN, SOUTHBOUND SIMILAR)  
 NTS


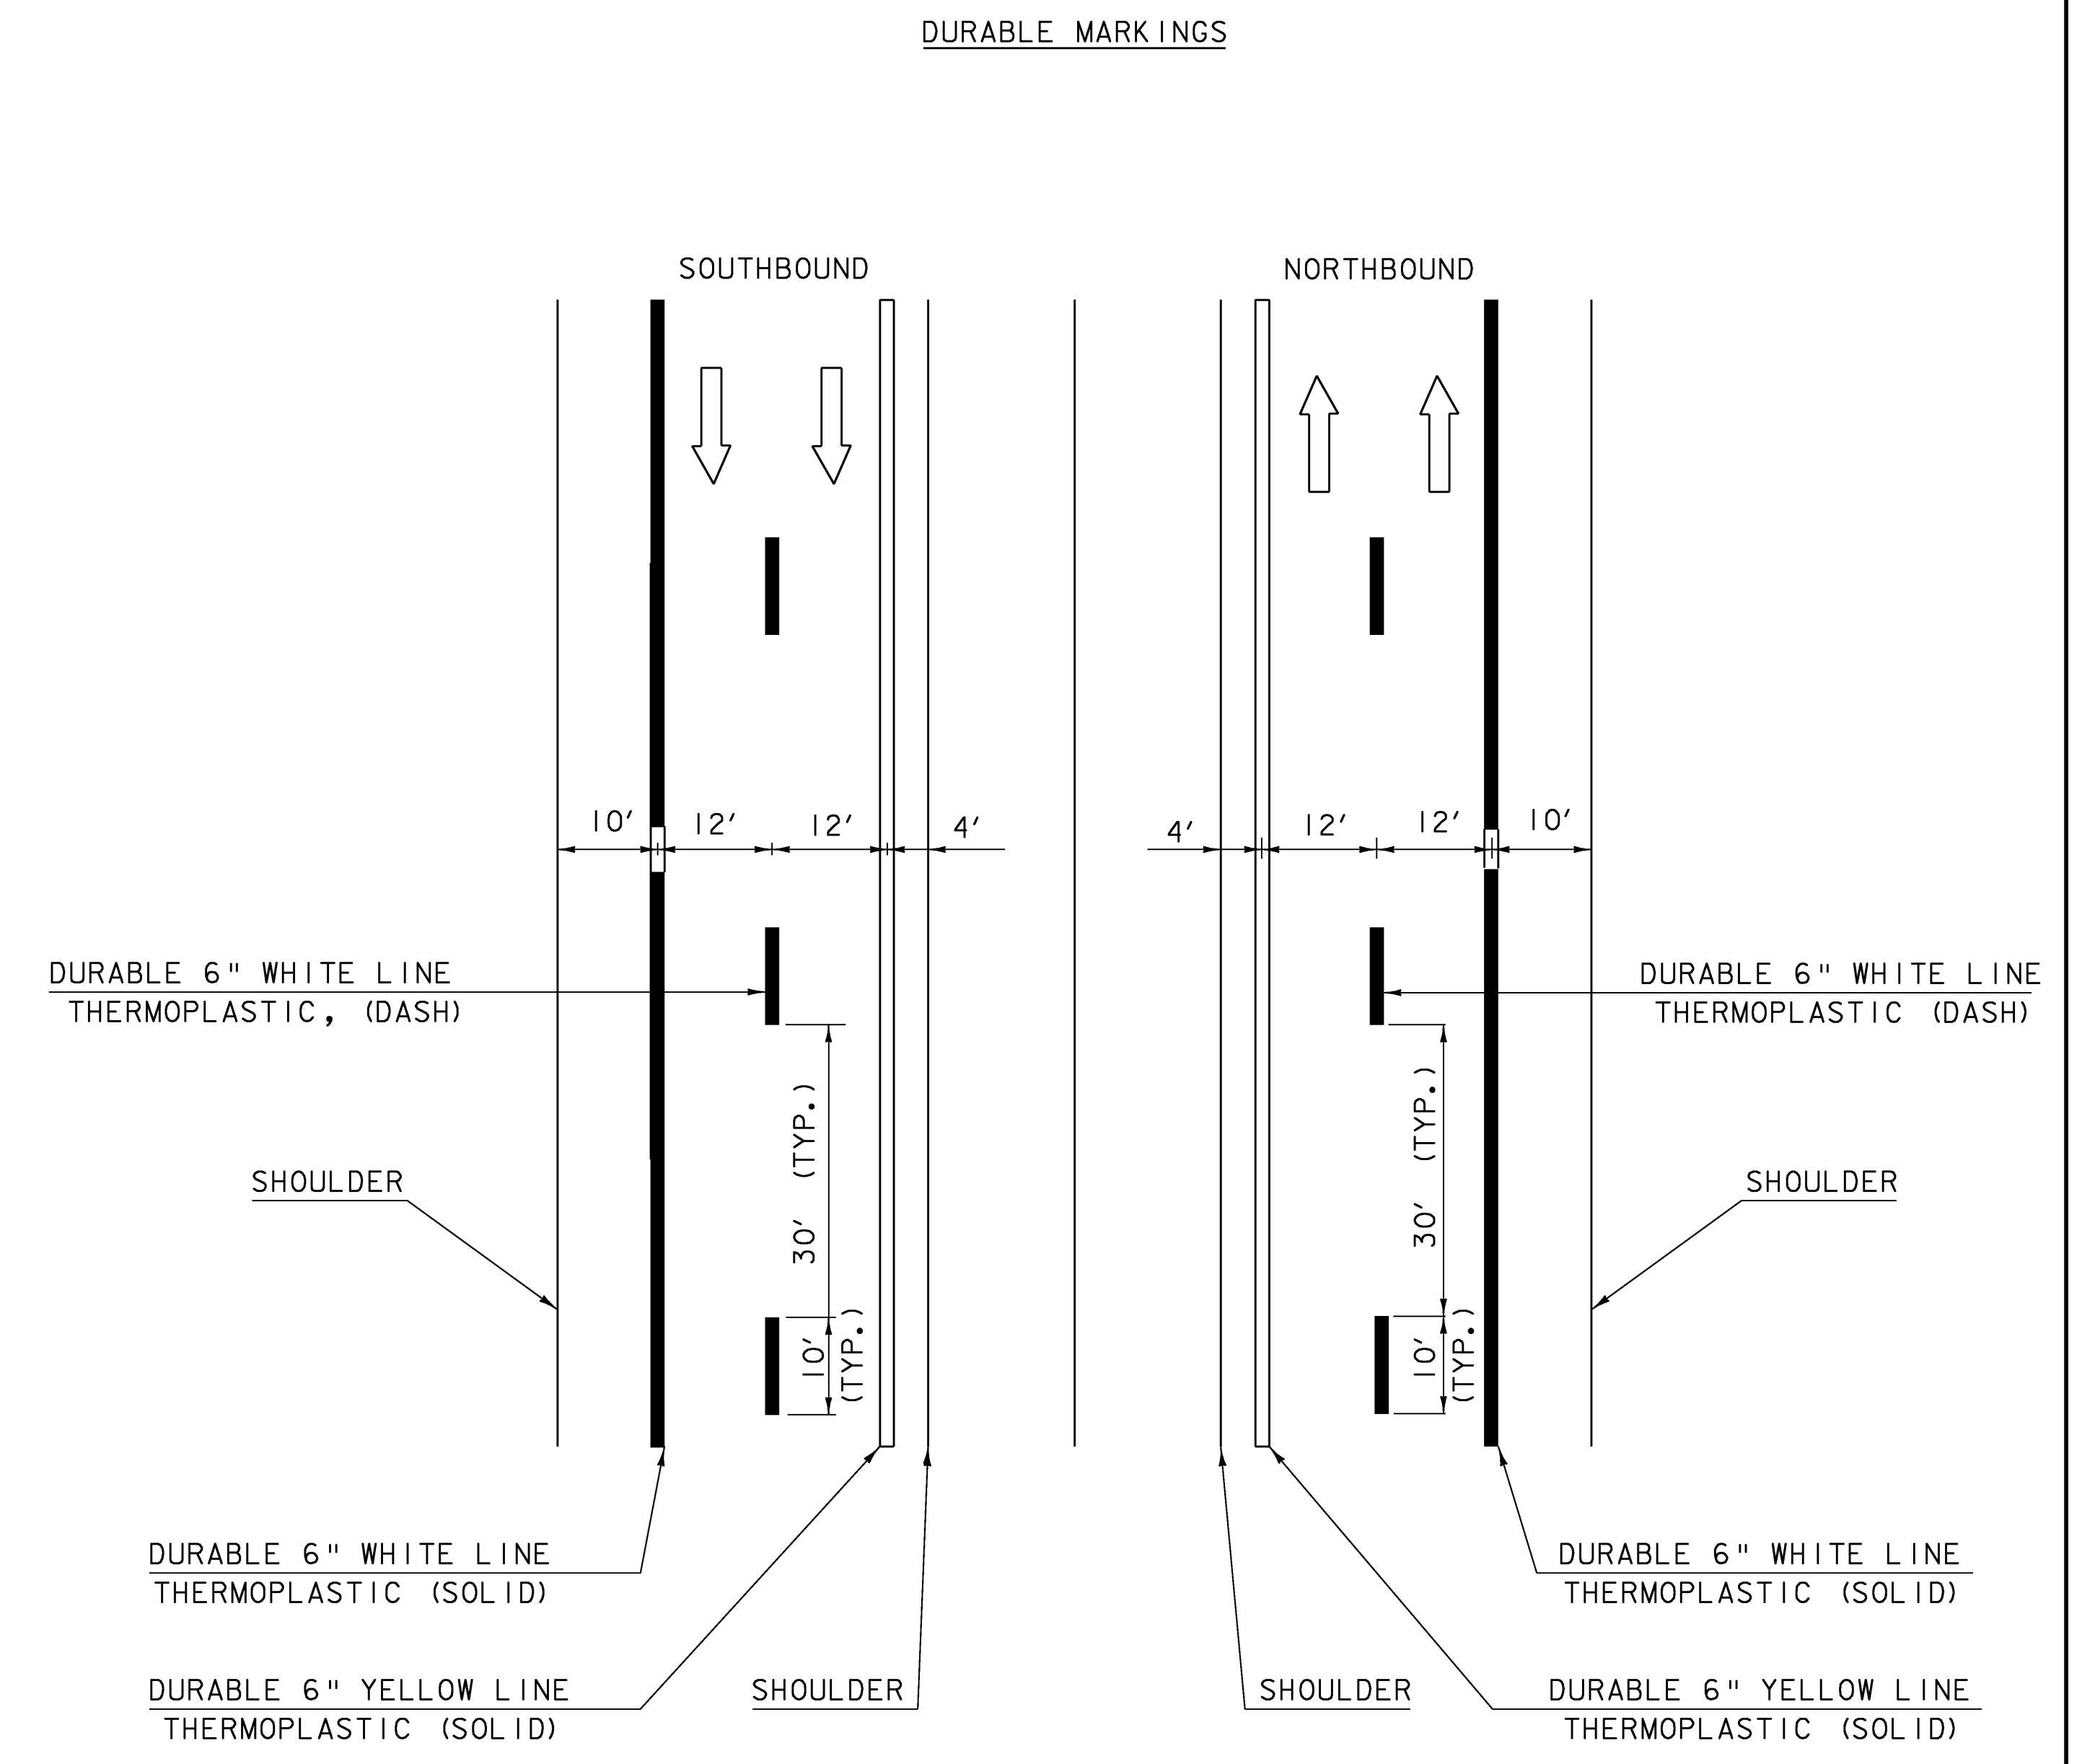


**TYPICAL MAINLINE MARKING PLAN**  
 NTS


**LEGEND**

- 6" TEMPORARY/PERMANENT WHITE LINES
- 6" TEMPORARY/PERMANENT YELLOW LINES
- DIRECTION OF TRAFFIC FLOW

PROJECT: <b>BERLIN</b>	PROJECT NO.: <b>IM 089-1 (20)</b>
DESIGN FILE NAME: 99a270\structures\s99a270trafnote.dgn	PLOT DATE: 05-DEC-2007
IPARM FILE NAME: s99a270pvmt mrk.i	DRAWN BY: C. MOONEY
DESIGNED BY: G. SPILAK	CHECKED BY: R. S. YOUNG
SQUAD LEADER: C. P. WILLIAMS	
PAVEMENT MARKINGS	SHEET: 26 OF 104

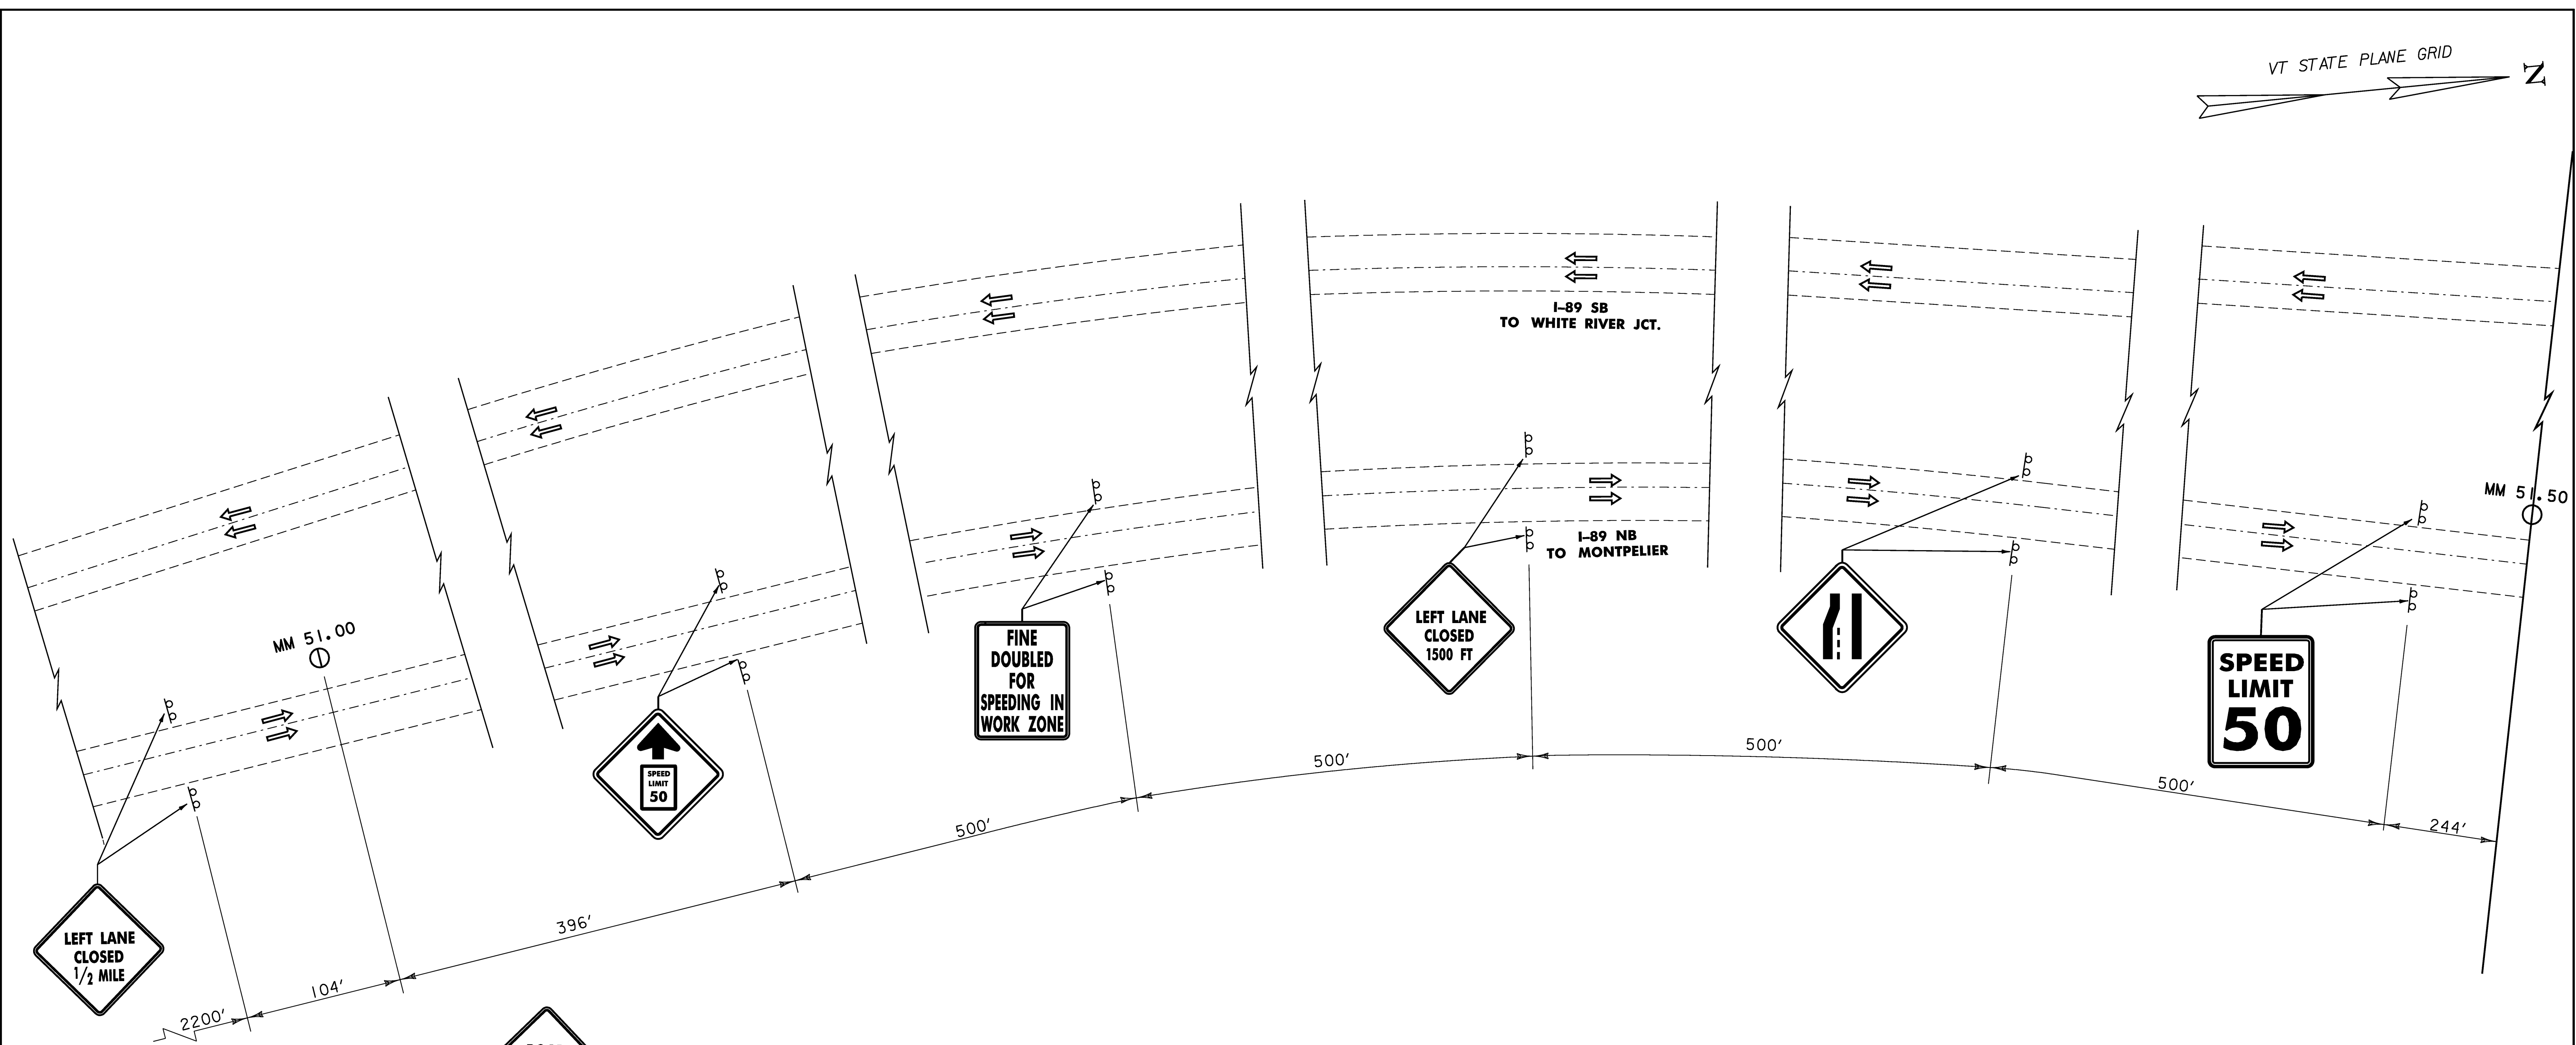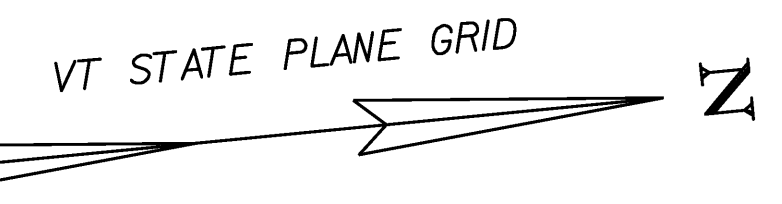

### APPROACH SIGNS

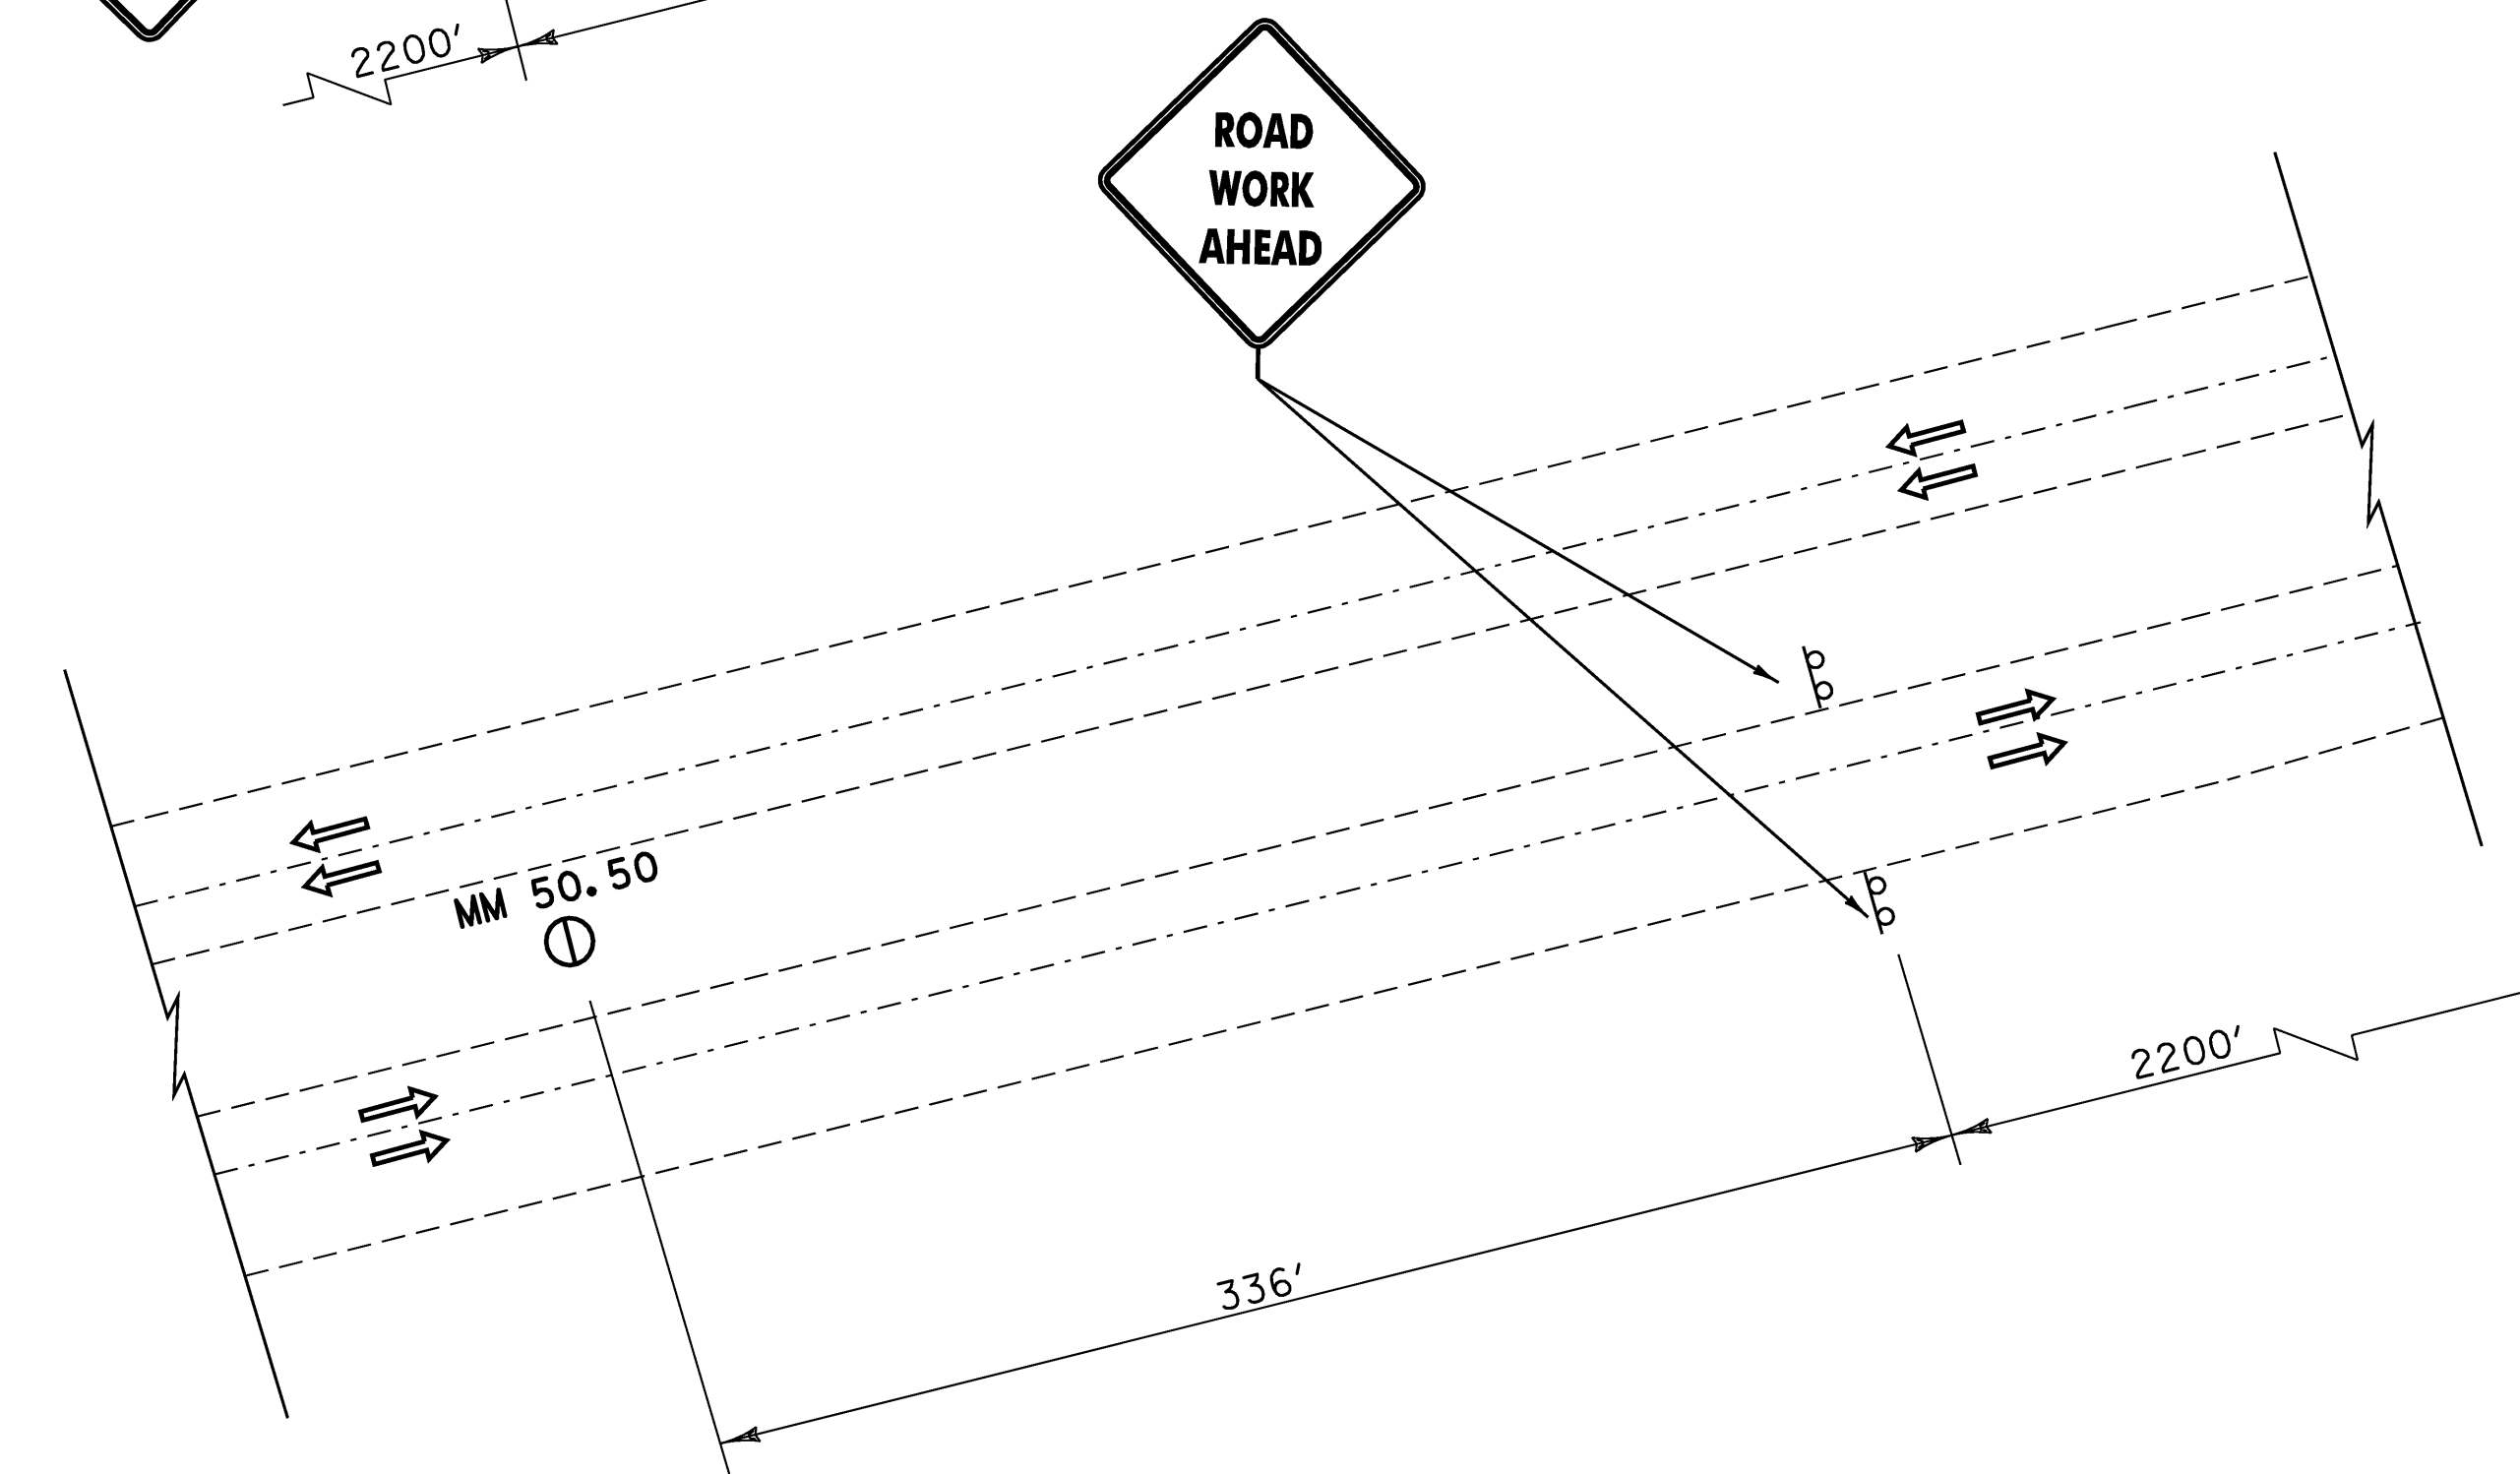
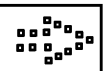
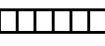
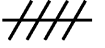








NOTE - TRAFFIC CONTROL PLANS ARE SHOWN USING THE ORIGINAL INTERSTATE PLANS



### NORTHBOUND CLOSURE TRAFFIC CONTROL SHEET 1

SCALE 1" = 50'-0"

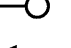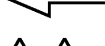PROJECT: <b>BERLIN</b>	PROJECT NO. : <b>IM 089-1 (20)</b>
DESIGN FILE NAME: 99a270\structures\s99a270bdr_detnb.dgn	PLOT DATE: 05-DEC-2007
IPARM FILE NAME: s99a270trafnb01.i	DRAWN BY: C. MOONEY
DESIGNED BY: G. SPILAK	CHECKED BY: K. M. HIGGINS
SQUAD LEADER: C. P. WILLIAMS	SHEET: 27 OF 104
NORTHBOUND CLOSURE SHEET 1	

- LEGEND**
-  - TYPE III BARRICADES.
  -  - PORTABLE ARROW BOARD
  -  - TEMPORARY TRAFFIC BARRIER
  -  - REMOVAL OF EXISTING PAVEMENT MARKING
  -  - REFLECTORIZED PLASTIC DRUM
  -  - TYPE I DELINEATOR ( AMBER )
  -  - TYPE I DELINEATOR ( WHITE )
  -  - FLOW OF TRAFFIC
  -  - PAVEMENT MARKING MASK
  -  - TEMPORARY 6" WHITE OR YELLOW LINE, TYPE II TAPE \*


\* WHITE ON RIGHT, YELLOW ON LEFT WITH FLOW OF TRAFFIC

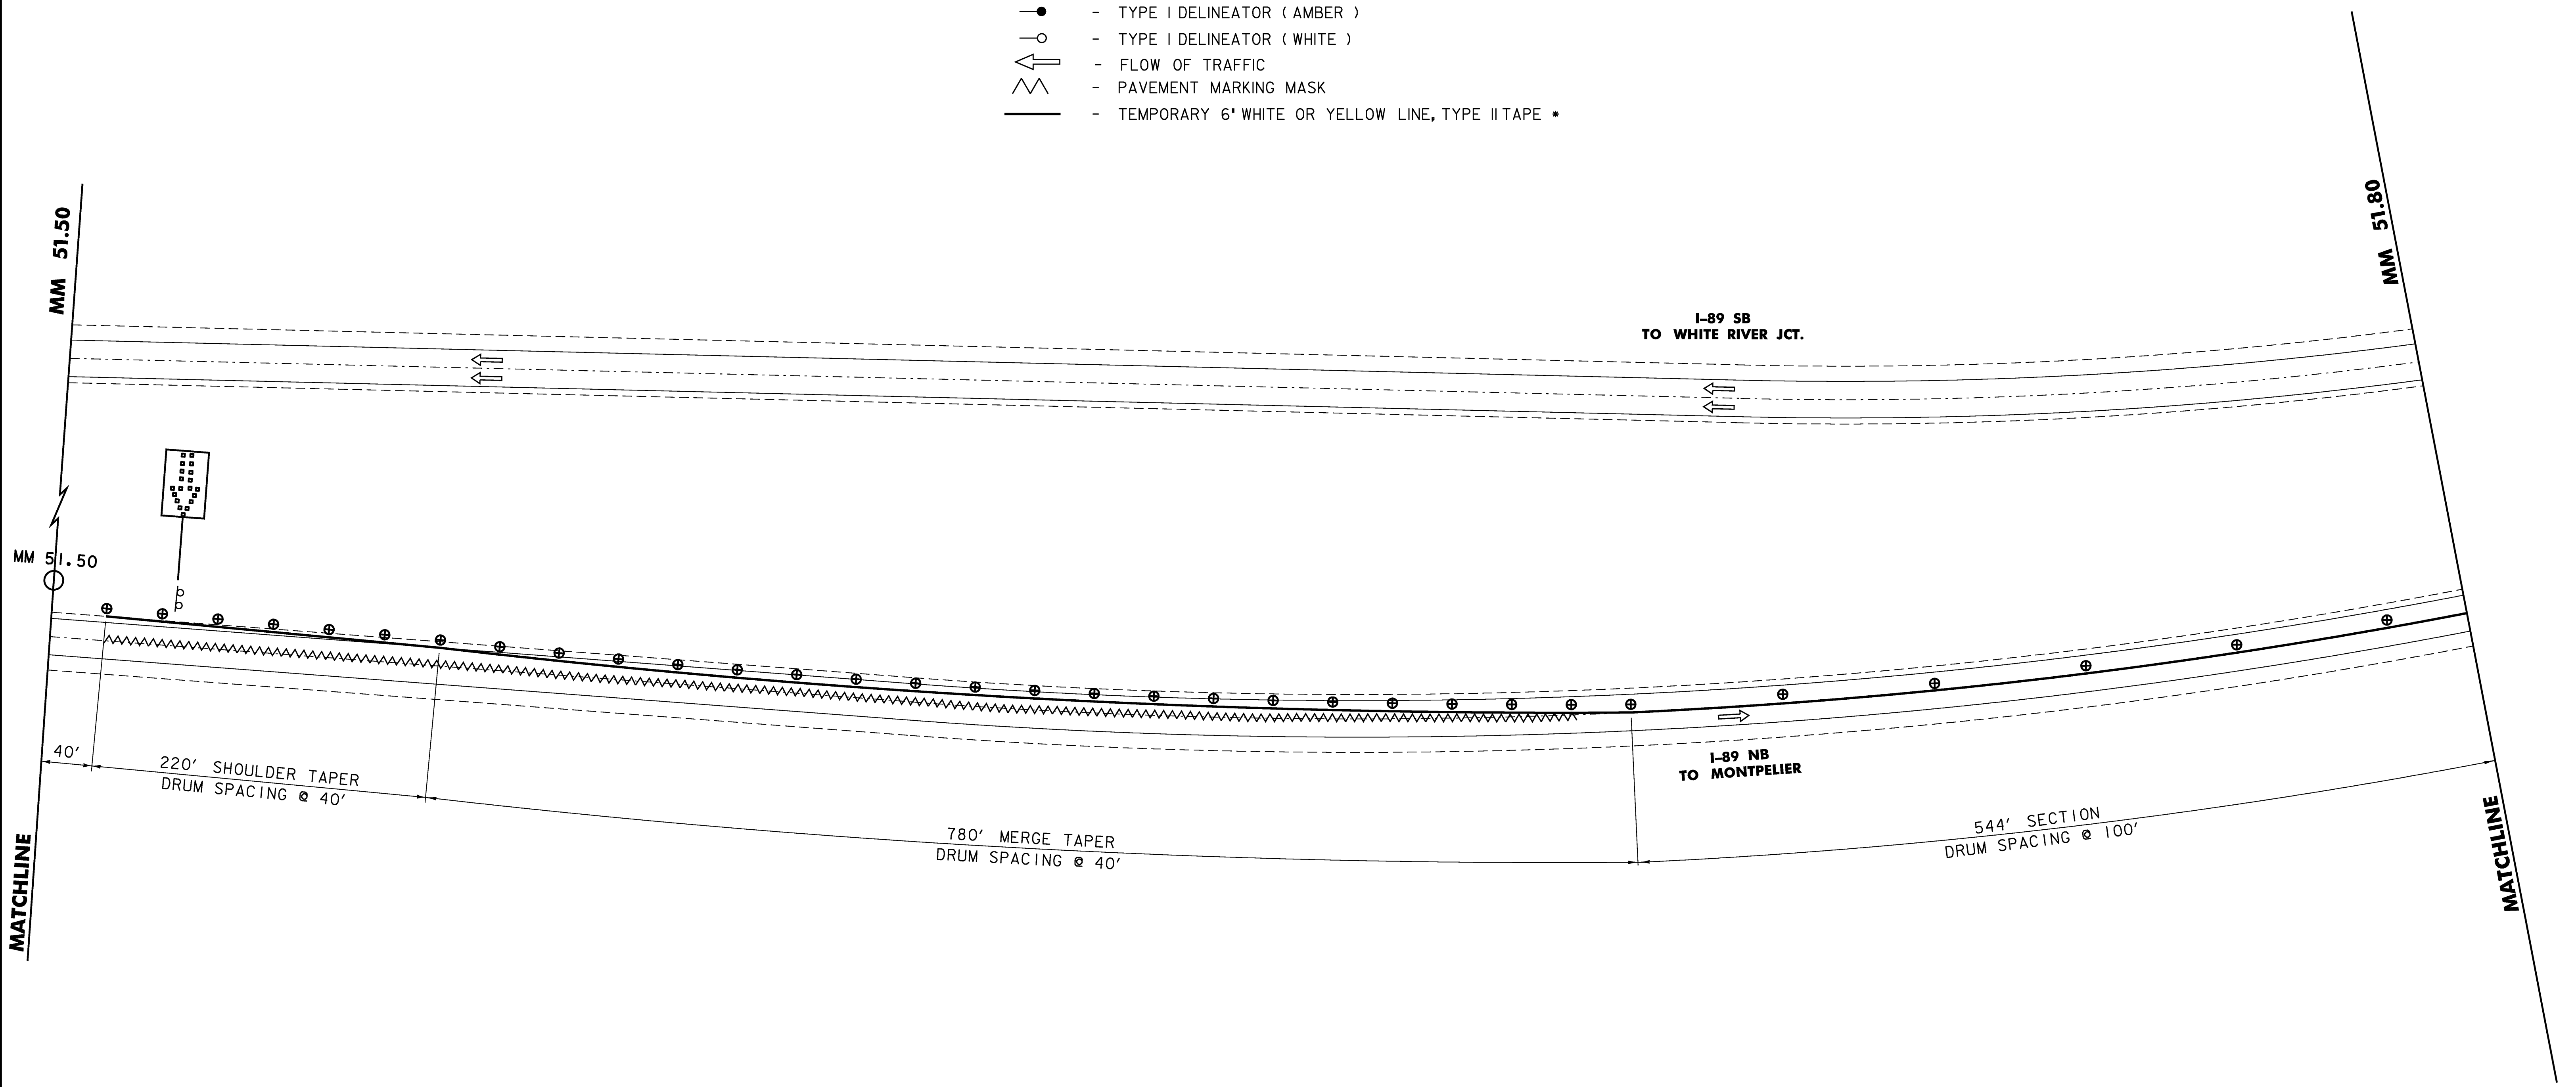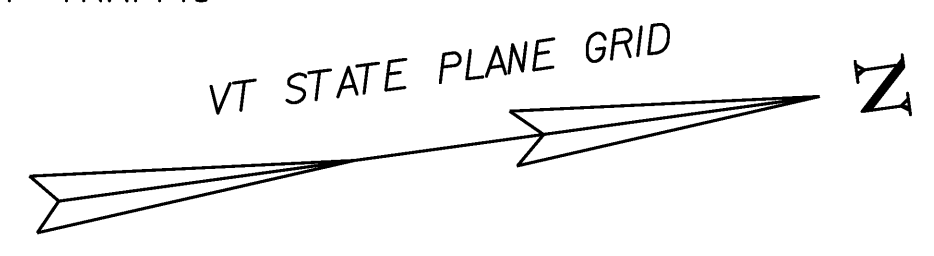











NOTE - TRAFFIC CONTROL PLANS ARE SHOWN USING THE ORIGINAL INTERSTATE PLANS


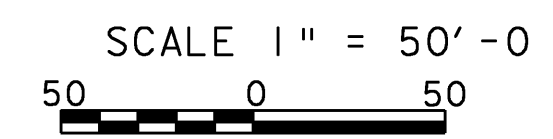
**NORTHBOUND CLOSURE  
TRAFFIC CONTROL SHEET 2**

PROJECT: <b>BERLIN</b>	PROJECT NO.: <b>IM 089-1 (20)</b>
DESIGN FILE NAME: 99a270\structures\s99a270bdr_detnb.dgn	PLOT DATE: 05-DEC-2007
IPARM FILE NAME: s99a270trafnb02.i	DESIGNED BY: G. SPILAK
SQUAD LEADER: C.P. WILLIAMS	DRAWN BY: C. MOONEY
NORTHBOUND CLOSURE SHEET 2	CHECKED BY: K.M. HIGGINS
	SHEET: 28 OF 104

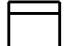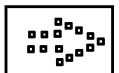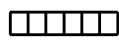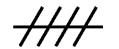

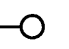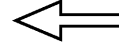**LEGEND**


-  - TYPE III BARRICADES.
  -  - PORTABLE ARROW BOARD
  -  - TEMPORARY TRAFFIC BARRIER
  -  - REMOVAL OF EXISTING PAVEMENT MARKING
  -  - REFLECTORIZED PLASTIC DRUM
  -  - TYPE I DELINEATOR (AMBER)
  -  - TYPE I DELINEATOR (WHITE)
  -  - FLOW OF TRAFFIC
  -  - PAVEMENT MARKING MASK
  -  - TEMPORARY 6" WHITE OR YELLOW LINE, TYPE II TAPE \*
- \* WHITE ON RIGHT, YELLOW ON LEFT WITH FLOW OF TRAFFIC

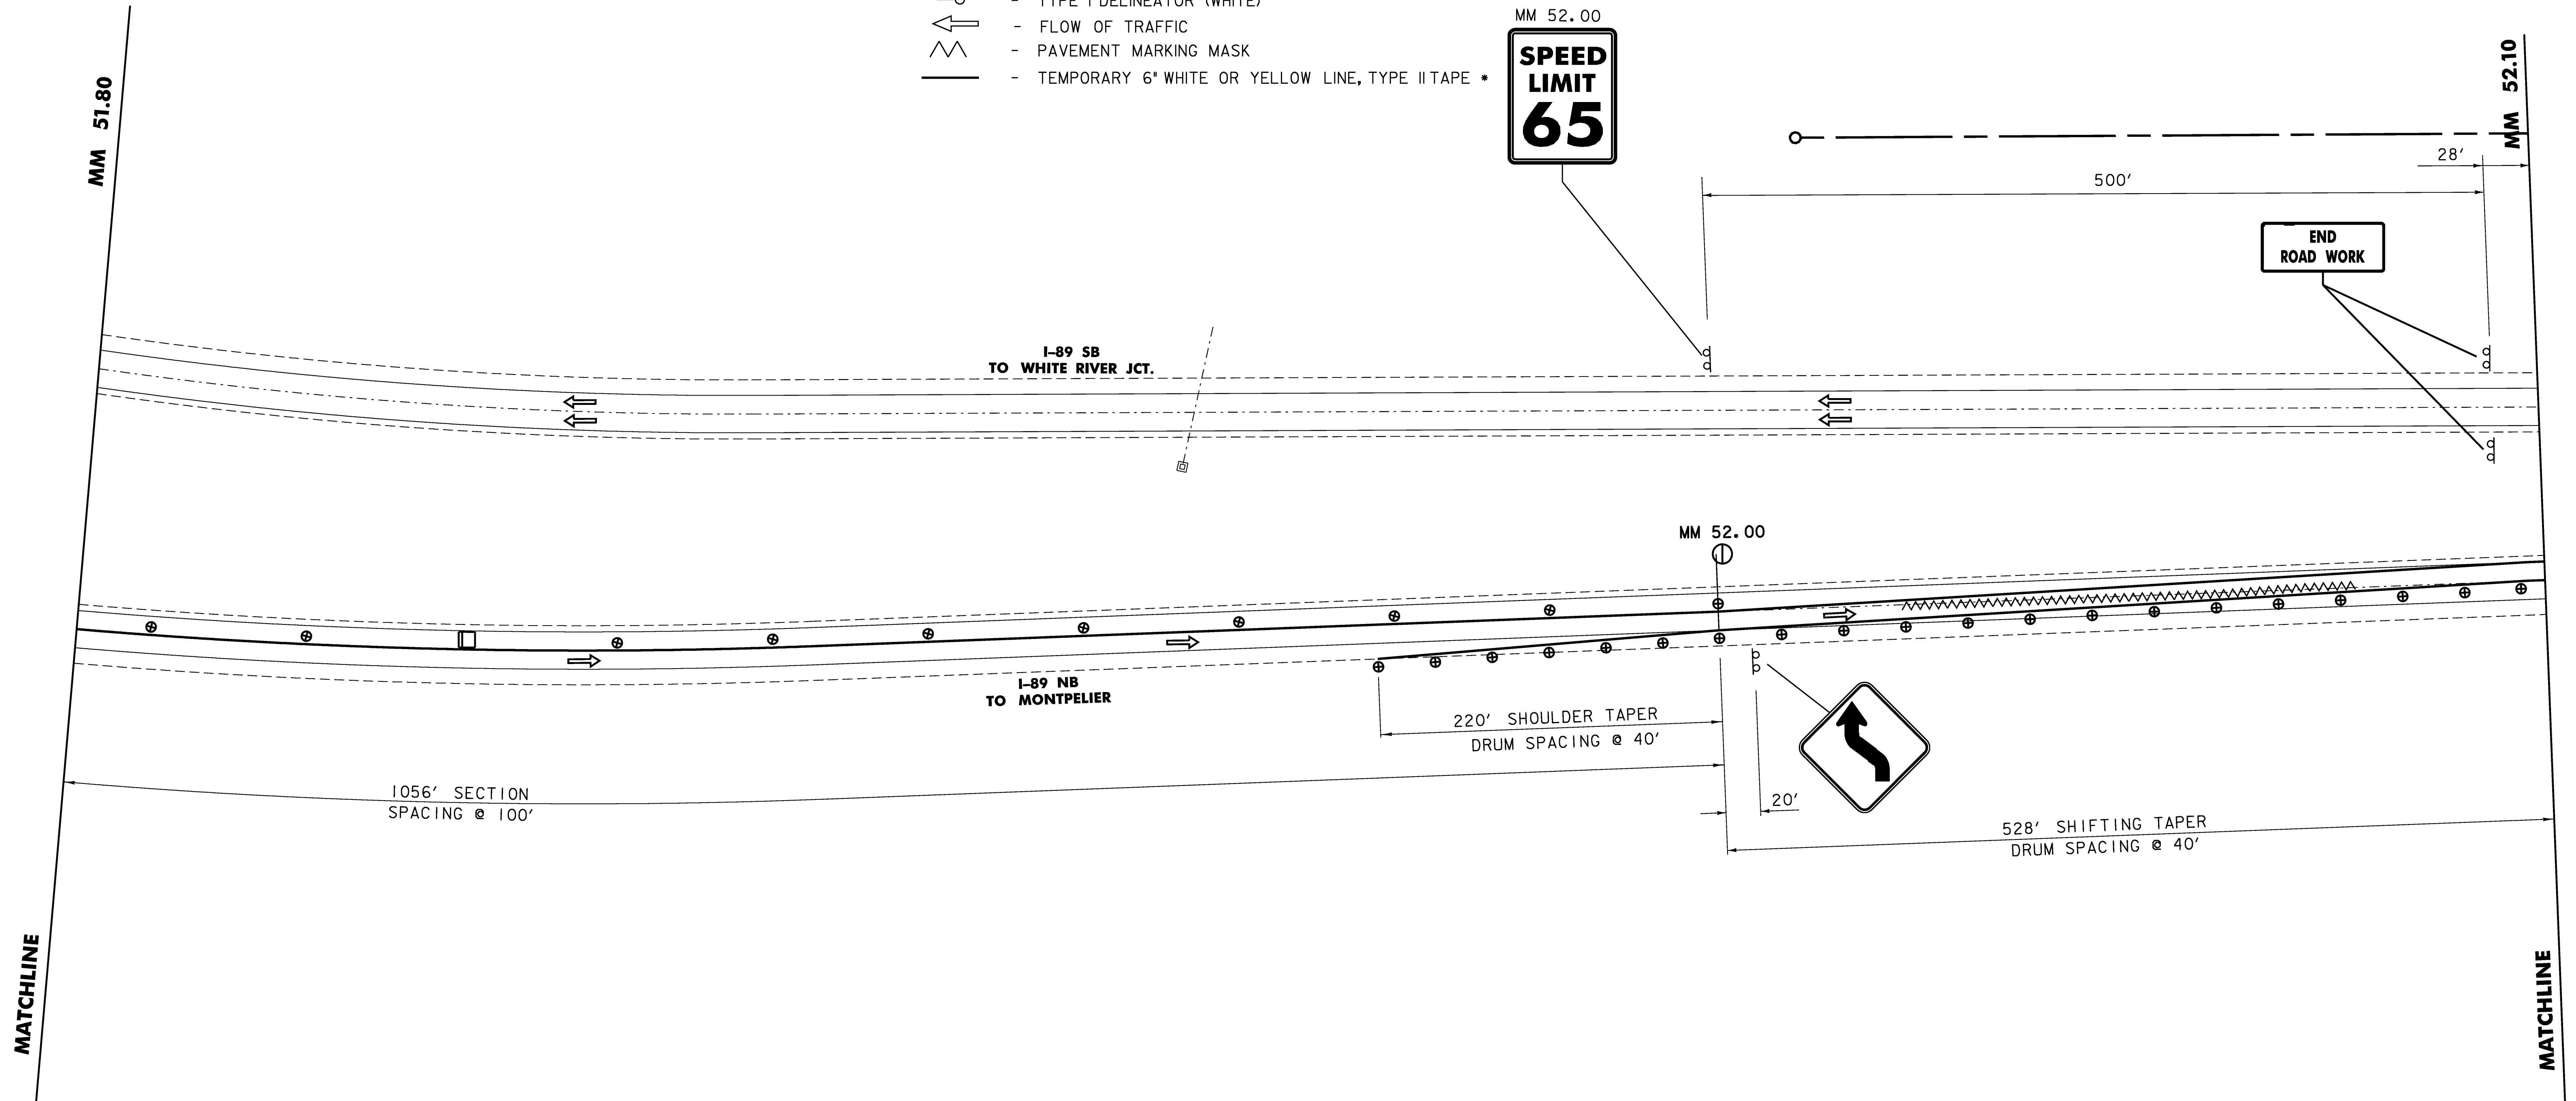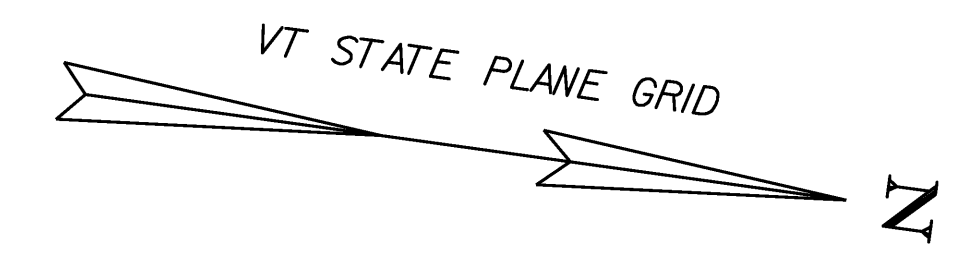

NOTE - TRAFFIC CONTROL PLANS ARE SHOWN USING THE ORIGINAL INTERSTATE PLANS


**NORTHBOUND CLOSURE  
TRAFFIC CONTROL SHEET 3**

PROJECT: <b>BERLIN</b>	PROJECT NO. : <b>IM 089-1 (20)</b>
DESIGN FILE NAME: 99a270\structures\s99a270bdr_detnb.dgn	PLOT DATE: 05-DEC-2007
IPARM FILE NAME: s99a270trafnb03.i	DESIGNED BY: G. SPILAK
SQUAD LEADER: C.P. WILLIAMS	DRAWN BY: C. MOONEY
NORTHBOUND CLOSURE SHEET 3	CHECKED BY: K. M. HIGGINS
	SHEET: 29 OF 104

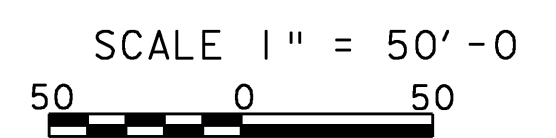

**LEGEND**

- ☐ - TYPE III BARRICADES.
- ▣ - PORTABLE ARROW BOARD
- ▤ - TEMPORARY TRAFFIC BARRIER
- /// - REMOVAL OF EXISTING PAVEMENT MARKING
- ⊕ - REFLECTORIZED PLASTIC DRUM
- - TYPE I DELINEATOR ( AMBER )
- - TYPE I DELINEATOR ( WHITE )
- - FLOW OF TRAFFIC
- ⋈ - PAVEMENT MARKING MASK
- - TEMPORARY 6" WHITE OR YELLOW LINE, TYPE II TAPE \*
- \* WHITE ON RIGHT, YELLOW ON LEFT WITH FLOW OF TRAFFIC

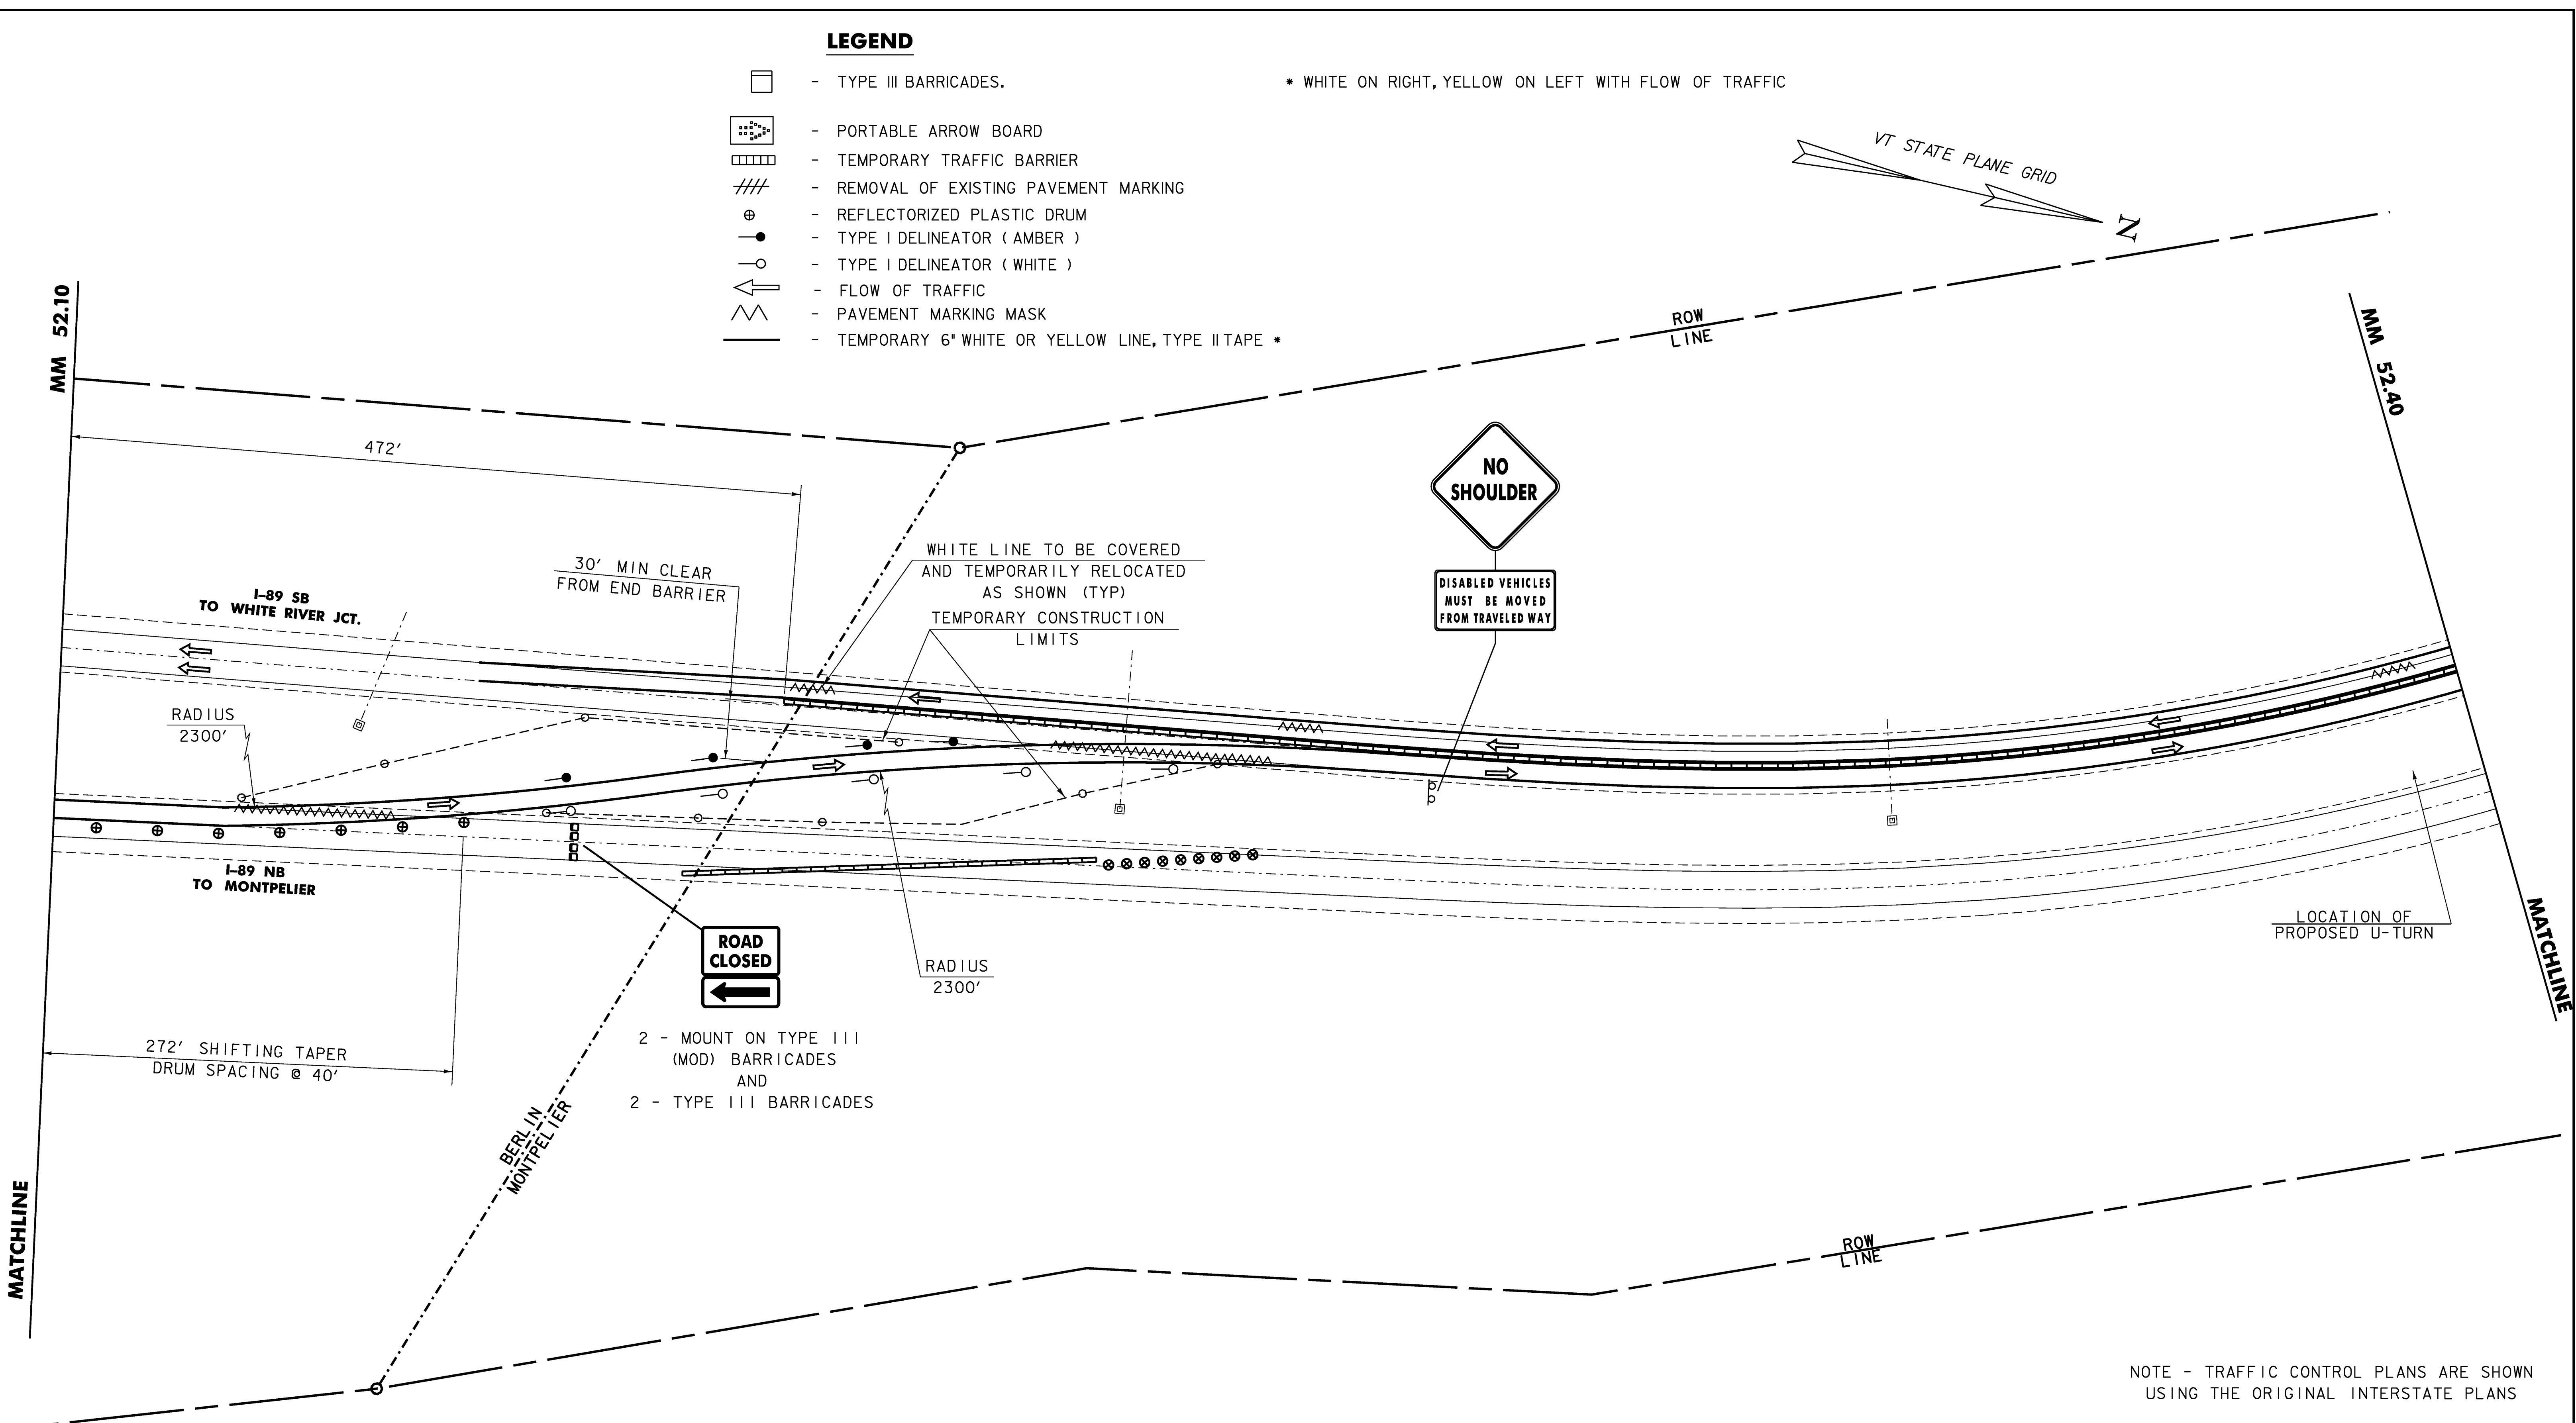













NOTE - TRAFFIC CONTROL PLANS ARE SHOWN USING THE ORIGINAL INTERSTATE PLANS

**NORTHBOUND CLOSURE  
TRAFFIC CONTROL SHEET 4**

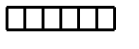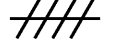PROJECT: <b>BERLIN</b>	PROJECT NO.: <b>IM 089-1 (20)</b>
DESIGN FILE NAME: s99a270\structures\s99a270bdr_detnb.dgn	PLOT DATE: 05-DEC-2007
IPARM FILE NAME: s99a270trafnb04.i	DESIGNED BY: G. SPILAK
SQUAD LEADER: C.P. WILLIAMS	DRAWN BY: C. MOONEY
NORTHBOUND CLOSURE SHEET 4	CHECKED BY: K.M. HIGGINS
	SHEET: 30 OF 104

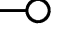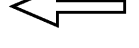SCALE 1" = 50'-0"  
50 0 50


- LEGEND**
-  - TYPE III BARRICADES.
  -  - PORTABLE ARROW BOARD
  -  - TEMPORARY TRAFFIC BARRIER
  -  - REMOVAL OF EXISTING PAVEMENT MARKING
  -  - REFLECTORIZED PLASTIC DRUM
  -  - TYPE I DELINEATOR ( AMBER )
  -  - TYPE I DELINEATOR ( WHITE )
  -  - FLOW OF TRAFFIC
  -  - PAVEMENT MARKING MASK
  -  - TEMPORARY 6" WHITE OR YELLOW LINE, TYPE II TAPE \*
- \* WHITE ON RIGHT, YELLOW ON LEFT WITH FLOW OF TRAFFIC

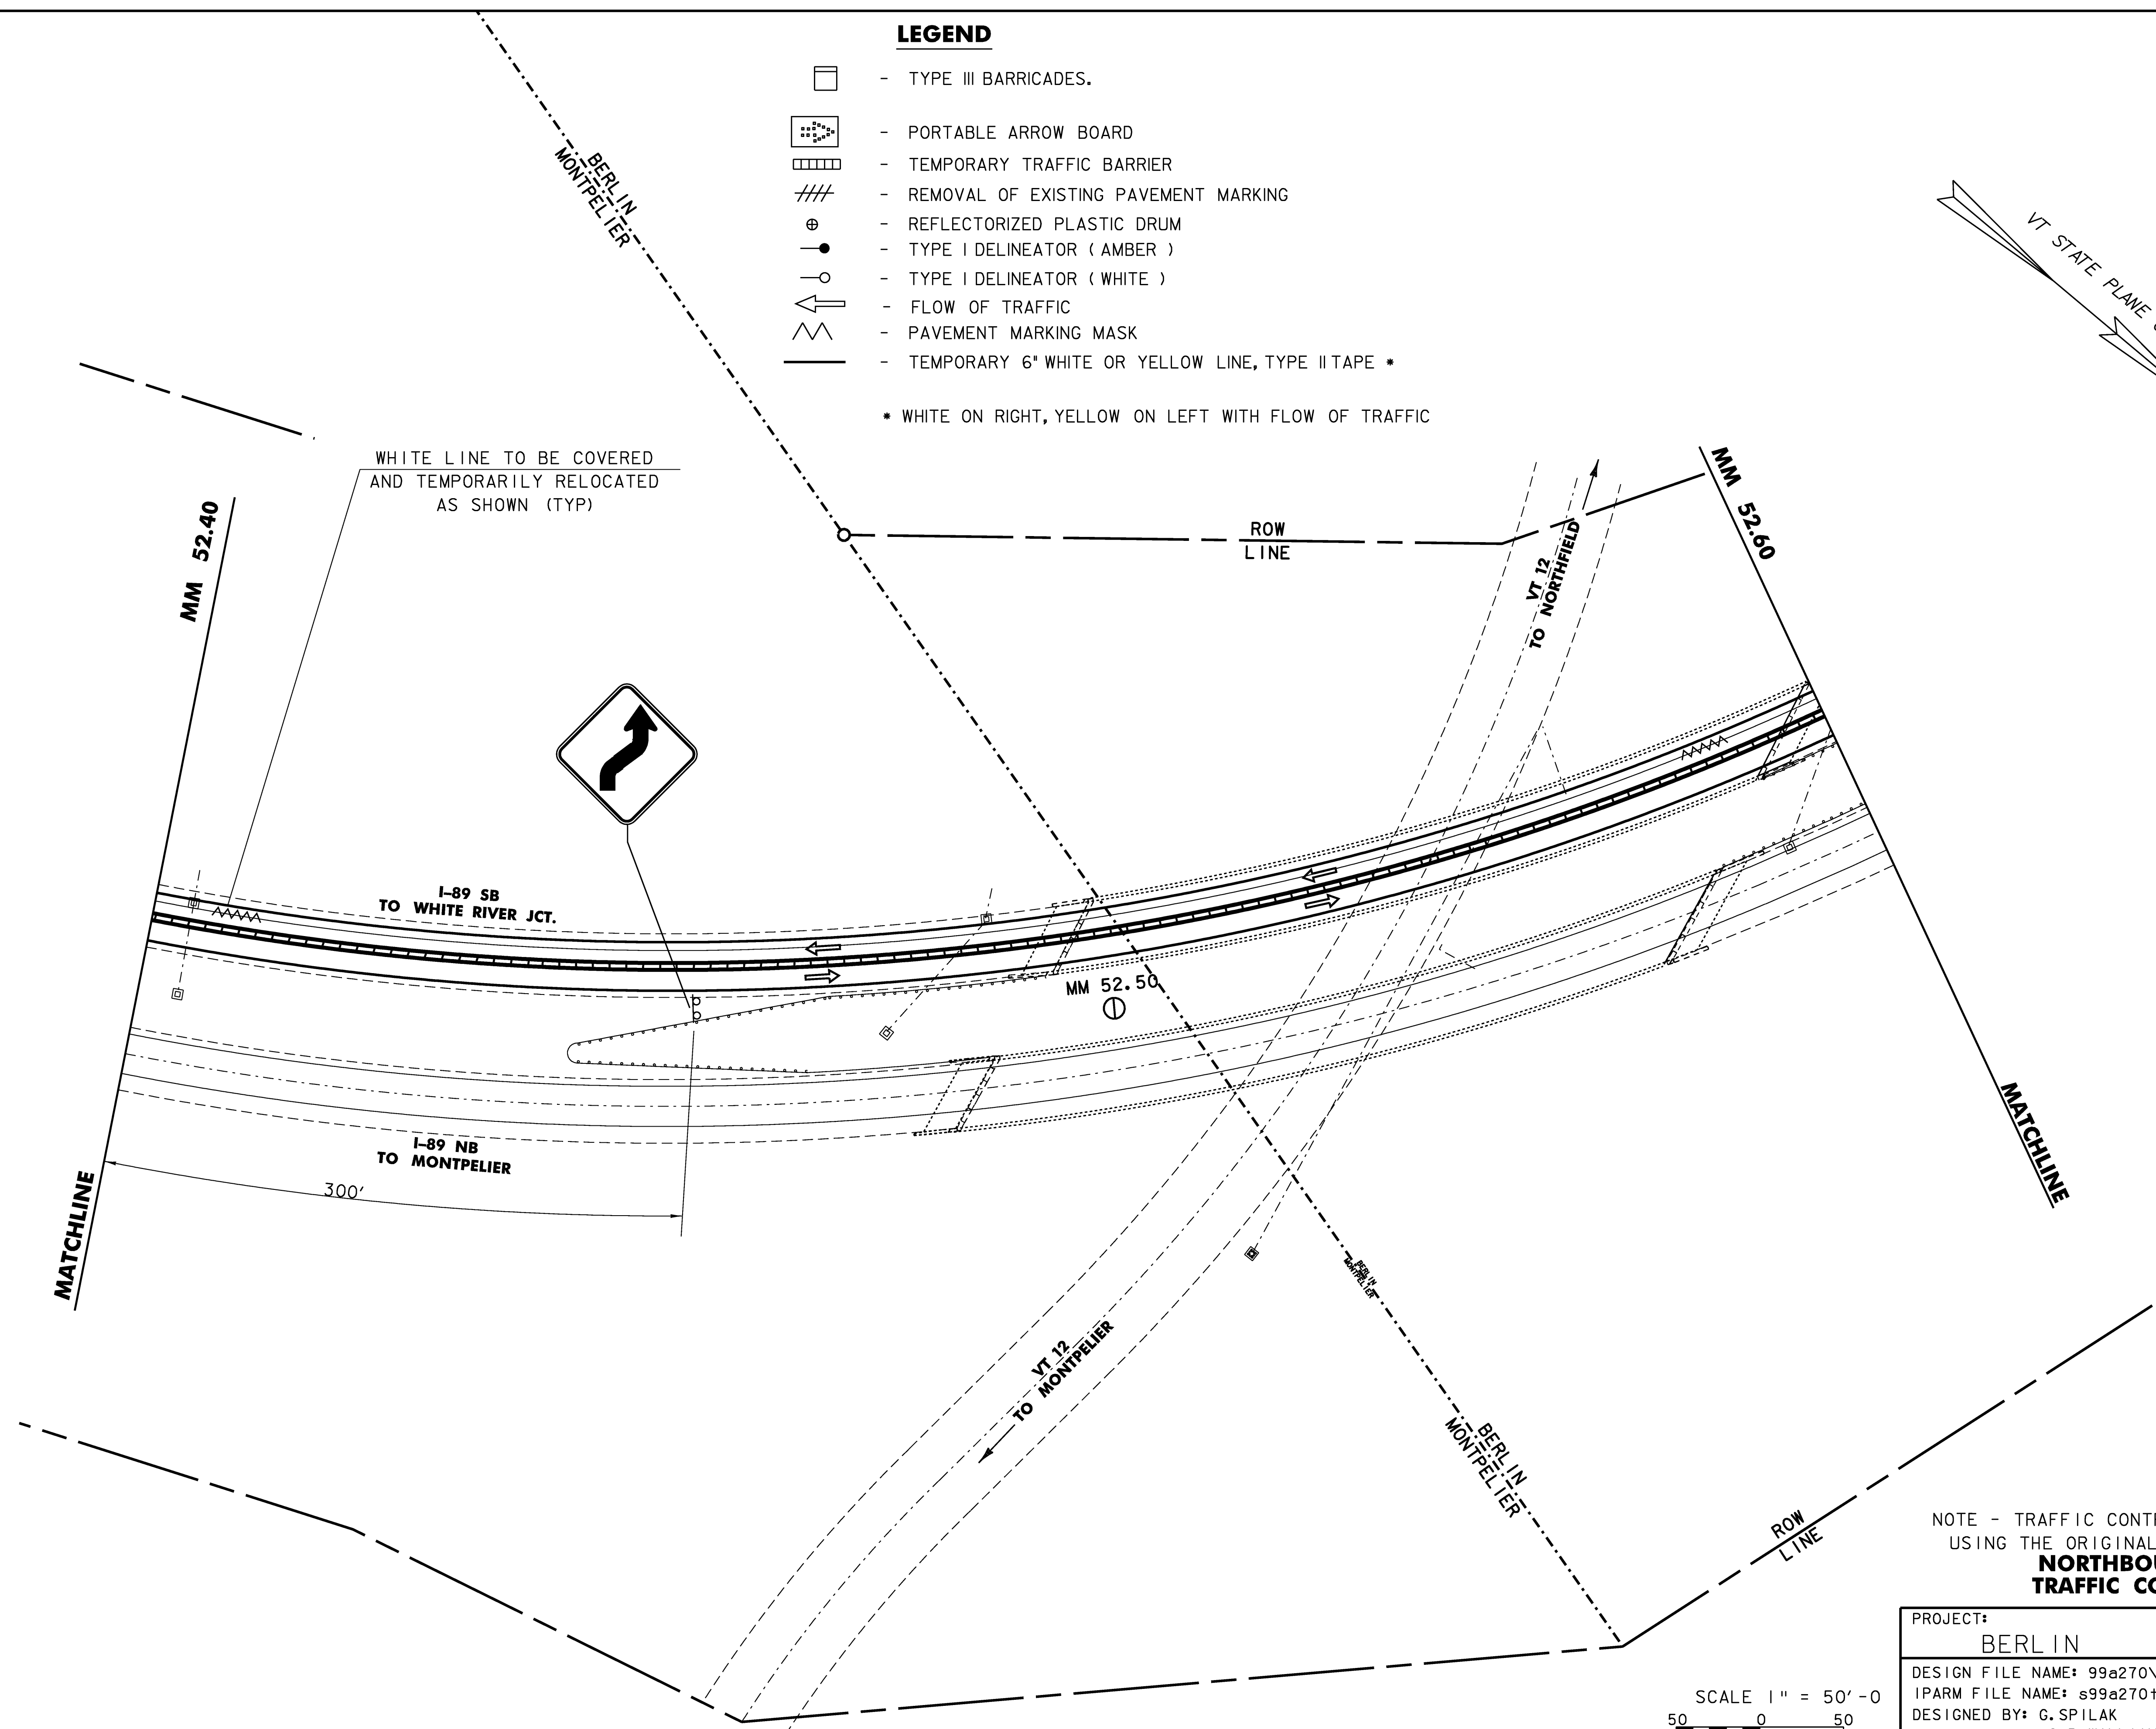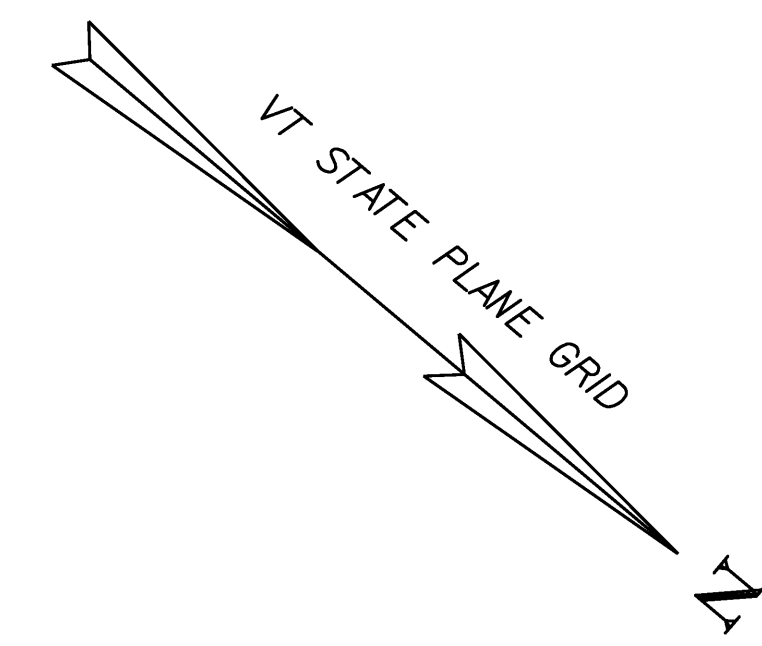




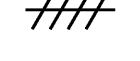
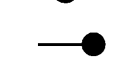
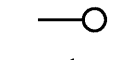

 


NOTE - TRAFFIC CONTROL PLANS ARE SHOWN USING THE ORIGINAL INTERSTATE PLANS

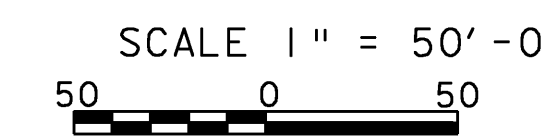**NORTHBOUND CLOSURE TRAFFIC CONTROL SHEET 5**



PROJECT:	BERLIN	PROJECT NO.:	IM 089-1 (20)
DESIGN FILE NAME:	99a270\structures\s99a270bdr_detnb.dgn	PLOT DATE:	05-DEC-2007
IPARM FILE NAME:	s99a270trafnb05.i	DESIGNED BY:	G. SPILAK
		DRAWN BY:	C. MOONEY
		SQUAD LEADER:	C. P. WILLIAMS
		CHECKED BY:	K. M. HIGGINS
		NORTHBOUND CLOSURE SHEET 5	SHEET: 31 OF 104



**LEGEND**


-  - TYPE III BARRICADES.
  -  - PORTABLE ARROW BOARD
  -  - TEMPORARY TRAFFIC BARRIER
  -  - REMOVAL OF EXISTING PAVEMENT MARKING
  -  - REFLECTORIZED PLASTIC DRUM
  -  - TYPE I DELINEATOR ( AMBER )
  -  - TYPE I DELINEATOR ( WHITE )
  -  - FLOW OF TRAFFIC
  -  - PAVEMENT MARKING MASK
  -  - TEMPORARY 6" WHITE OR YELLOW LINE, TYPE II TAPE \*
- \* WHITE ON RIGHT, YELLOW ON LEFT WITH FLOW OF TRAFFIC

WHITE LINE TO BE COVERED AND TEMPORARILY RELOCATED AS SHOWN (TYP)

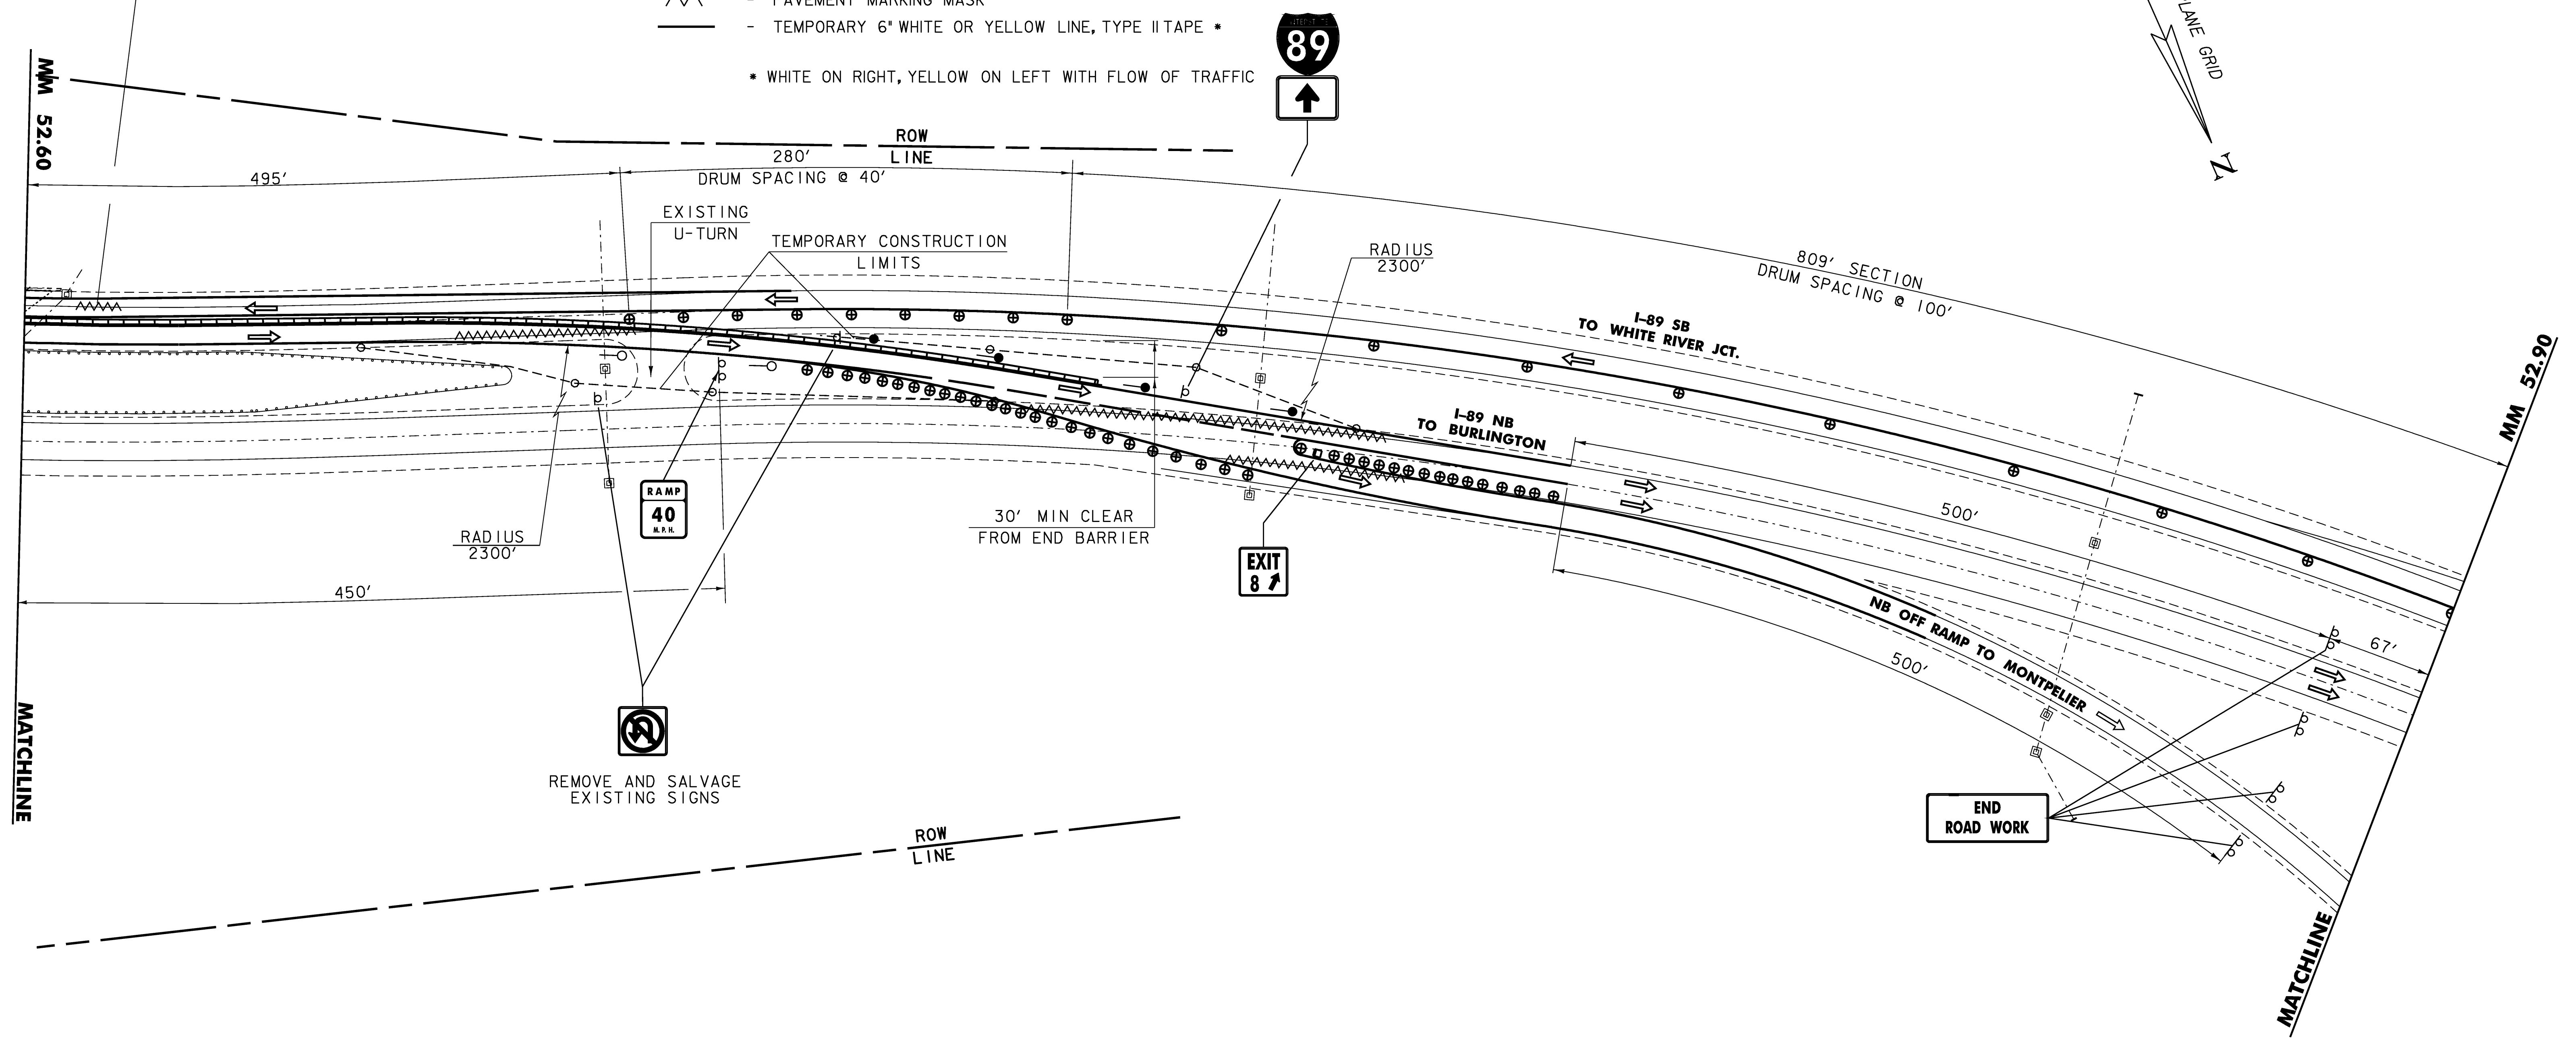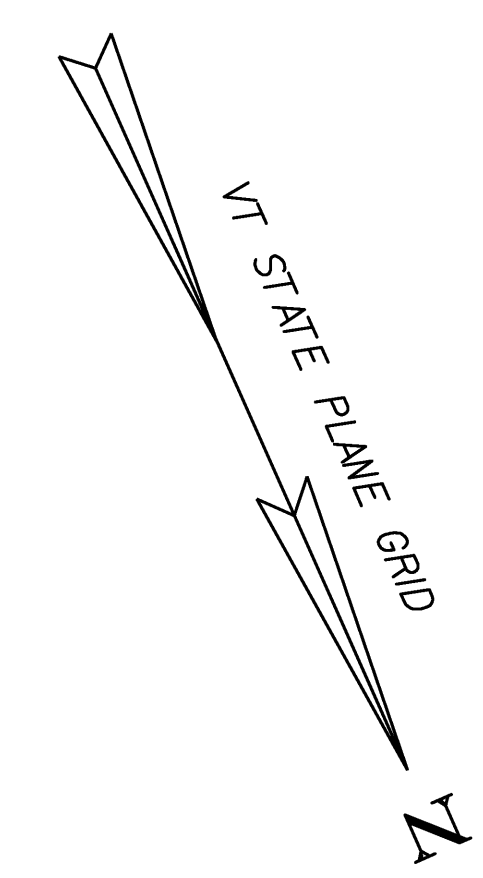


**NORTHBOUND CLOSURE TRAFFIC CONTROL SHEET 6**


NOTE - TRAFFIC CONTROL PLANS ARE SHOWN USING THE ORIGINAL INTERSTATE PLANS

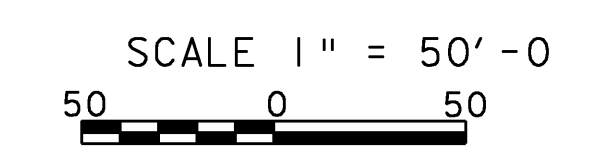

PROJECT: <b>BERLIN</b>	PROJECT NO.: <b>IM 089-1 (20)</b>
DESIGN FILE NAME: 99a270\structures\s99a270bdr_detnb.dgn	PLOT DATE: 05-DEC-2007
IPARM FILE NAME: s99a270trafnb06.i	DRAWN BY: C. MOONEY
DESIGNED BY: G. SPILAK	CHECKED BY: K. M. HIGGINS
SQUAD LEADER: C. P. WILLIAMS	SHEET: 32 OF 104
NORTHBOUND CLOSURE SHEET 6	

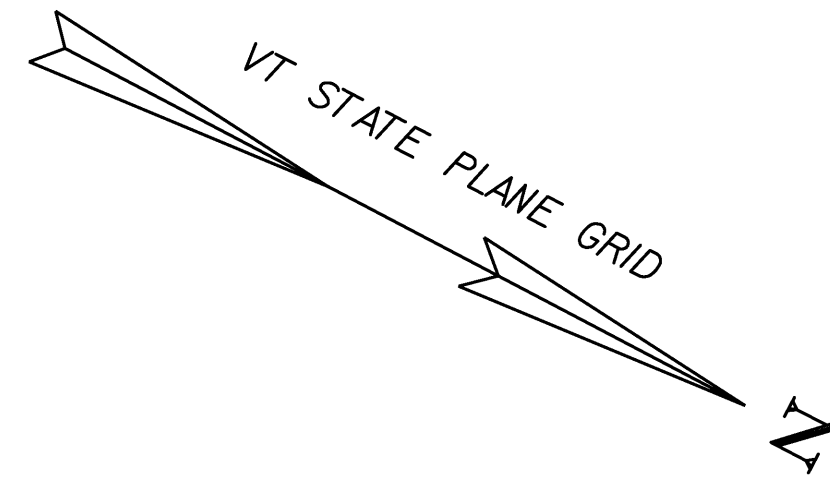


- LEGEND**
- TYPE III BARRICADES.
  - PORTABLE ARROW BOARD
  - TEMPORARY TRAFFIC BARRIER
  - REMOVAL OF EXISTING PAVEMENT MARKING
  - REFLECTORIZED PLASTIC DRUM
  - TYPE I DELINEATOR ( AMBER )
  - TYPE I DELINEATOR ( WHITE )
  - FLOW OF TRAFFIC
  - PAVEMENT MARKING MASK
  - TEMPORARY 6" WHITE OR YELLOW LINE, TYPE II TAPE •
- WHITE ON RIGHT, YELLOW ON LEFT WITH FLOW OF TRAFFIC

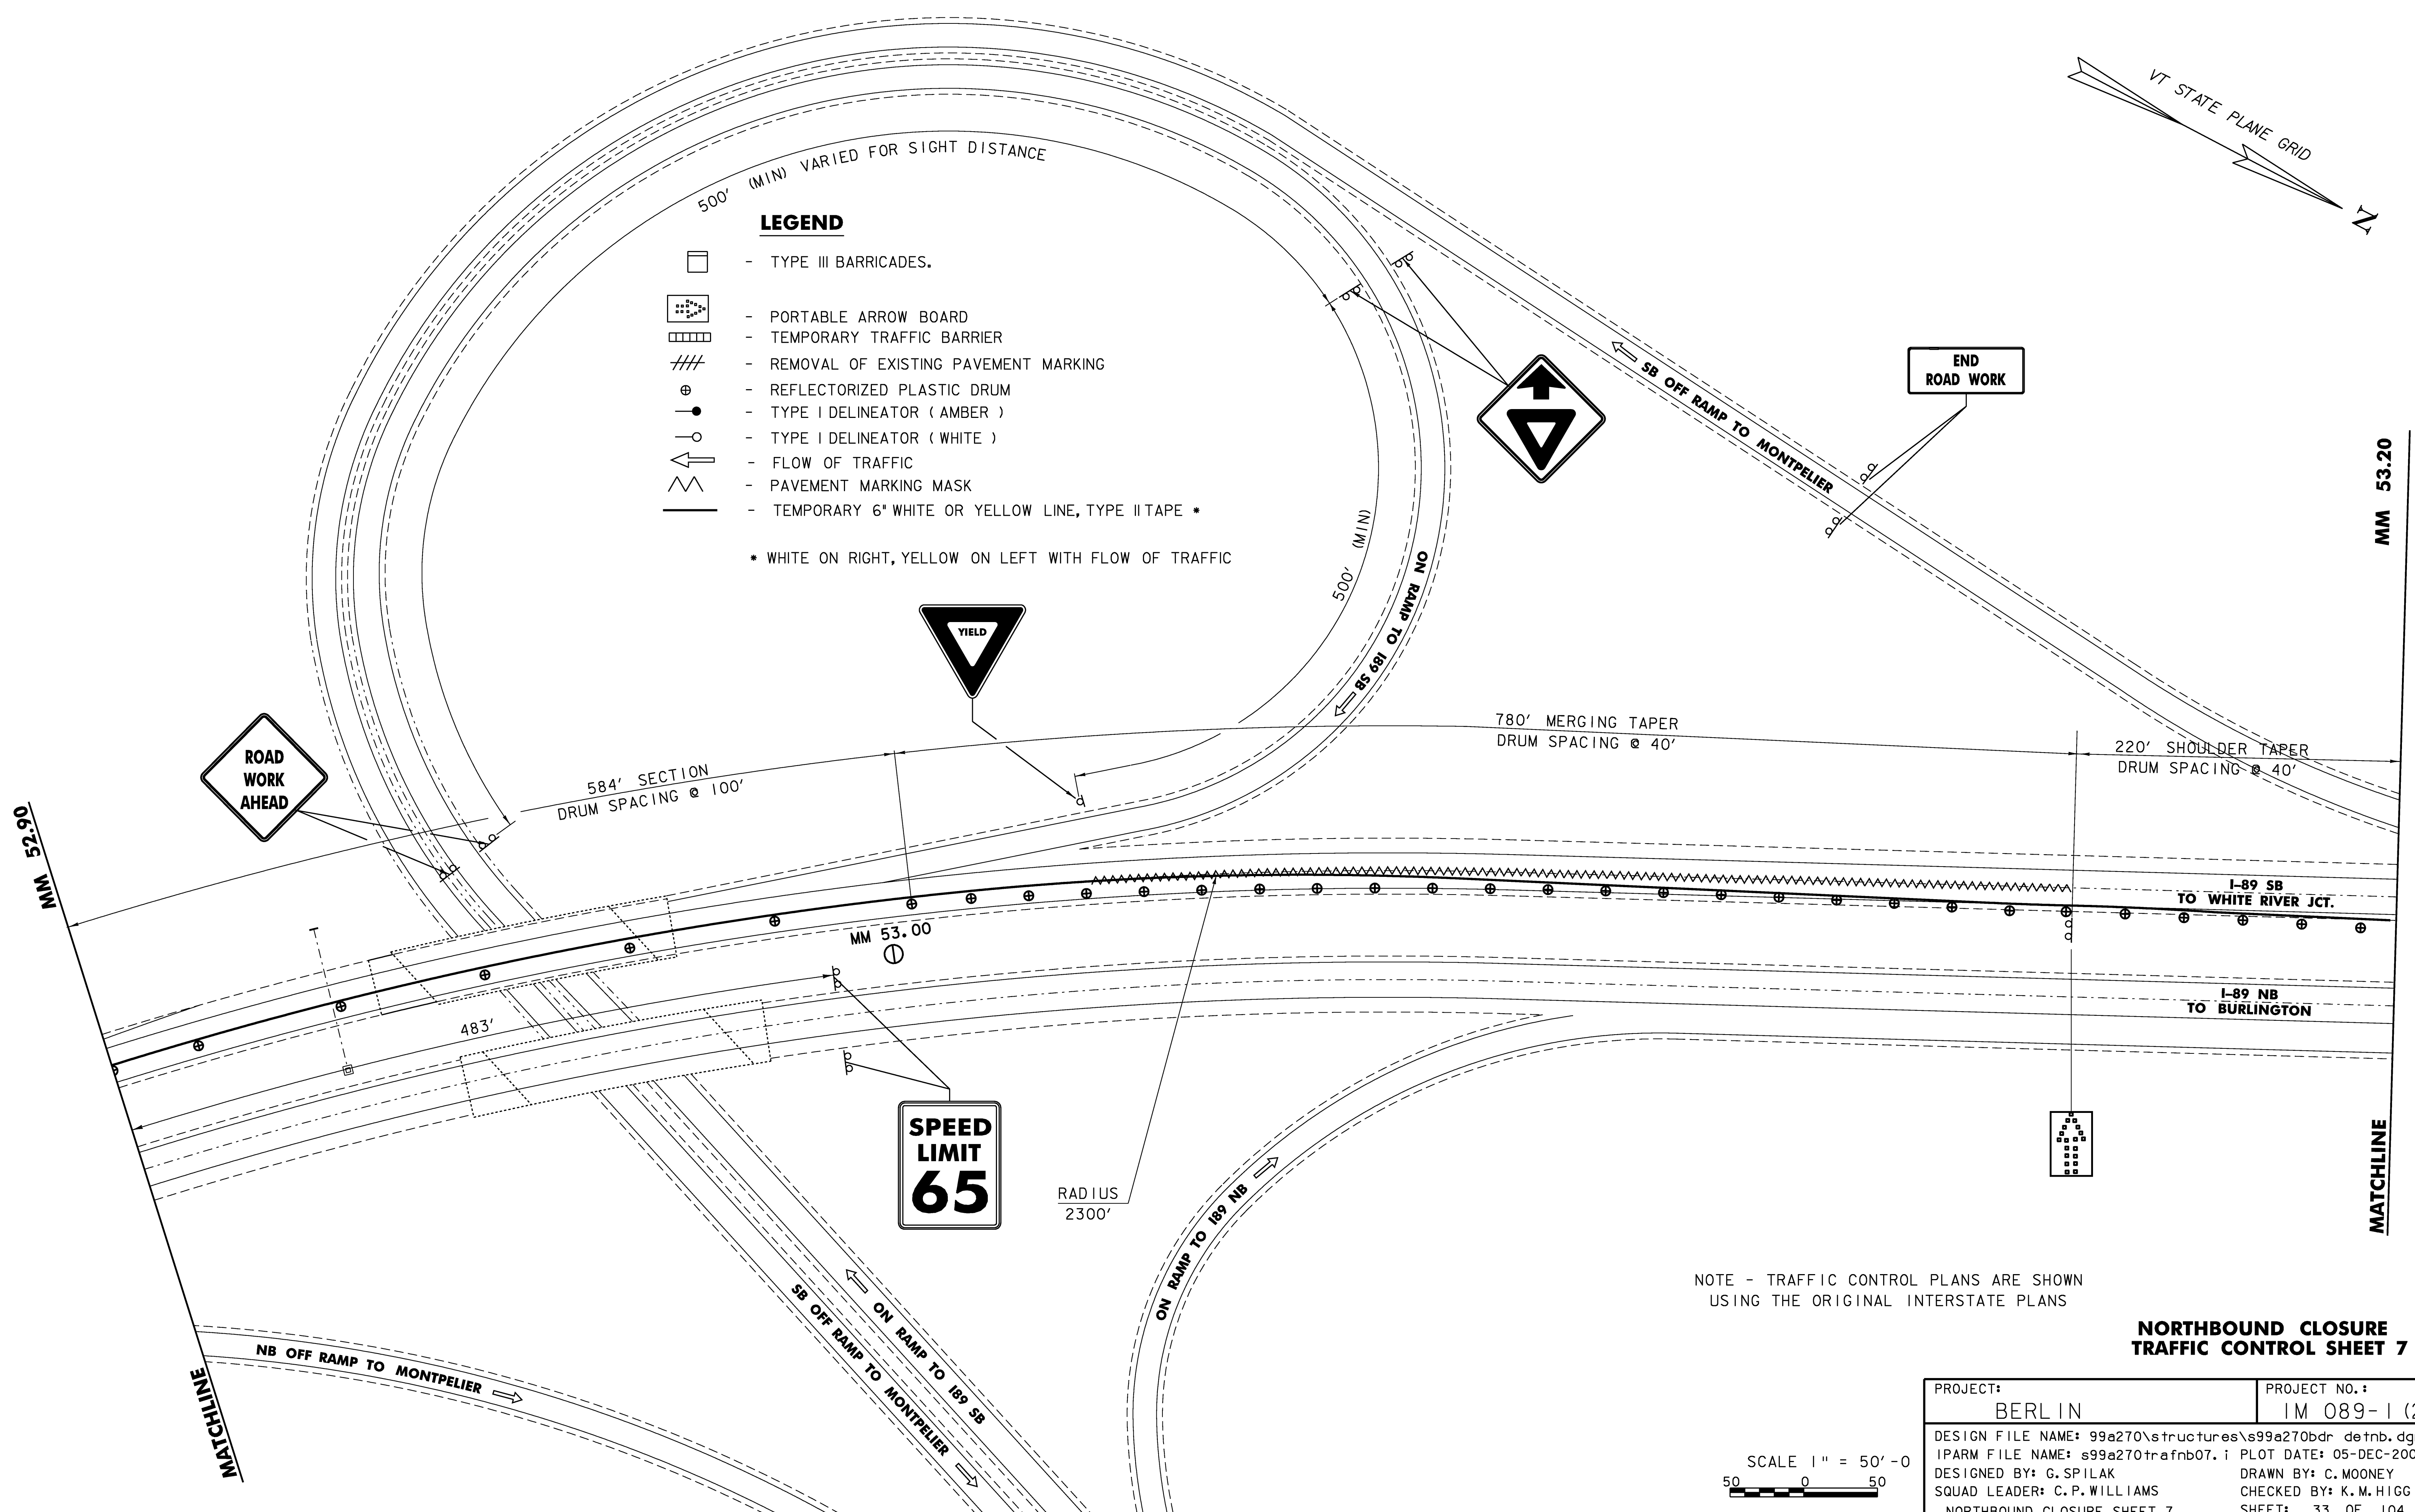

NOTE - TRAFFIC CONTROL PLANS ARE SHOWN USING THE ORIGINAL INTERSTATE PLANS

**NORTHBOUND CLOSURE TRAFFIC CONTROL SHEET 7**

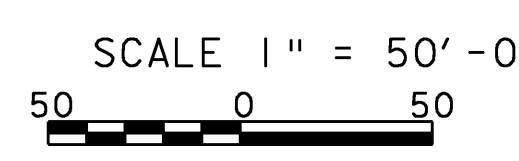


PROJECT: <b>BERLIN</b>	PROJECT NO.: <b>IM 089-1 (20)</b>
DESIGN FILE NAME: 99a270\structures\s99a270bdr_detnb.dgn	PLOT DATE: 05-DEC-2007
IPARM FILE NAME: s99a270trafnb07.i	DESIGNED BY: G. SPILAK
SQUAD LEADER: C.P. WILLIAMS	DRAWN BY: C. MOONEY
NORTHBOUND CLOSURE SHEET 7	CHECKED BY: K.M. HIGGINS
	SHEET: 33 OF 104

**LEGEND**

← - FLOW OF TRAFFIC

MM 53.20

MATCHLINE


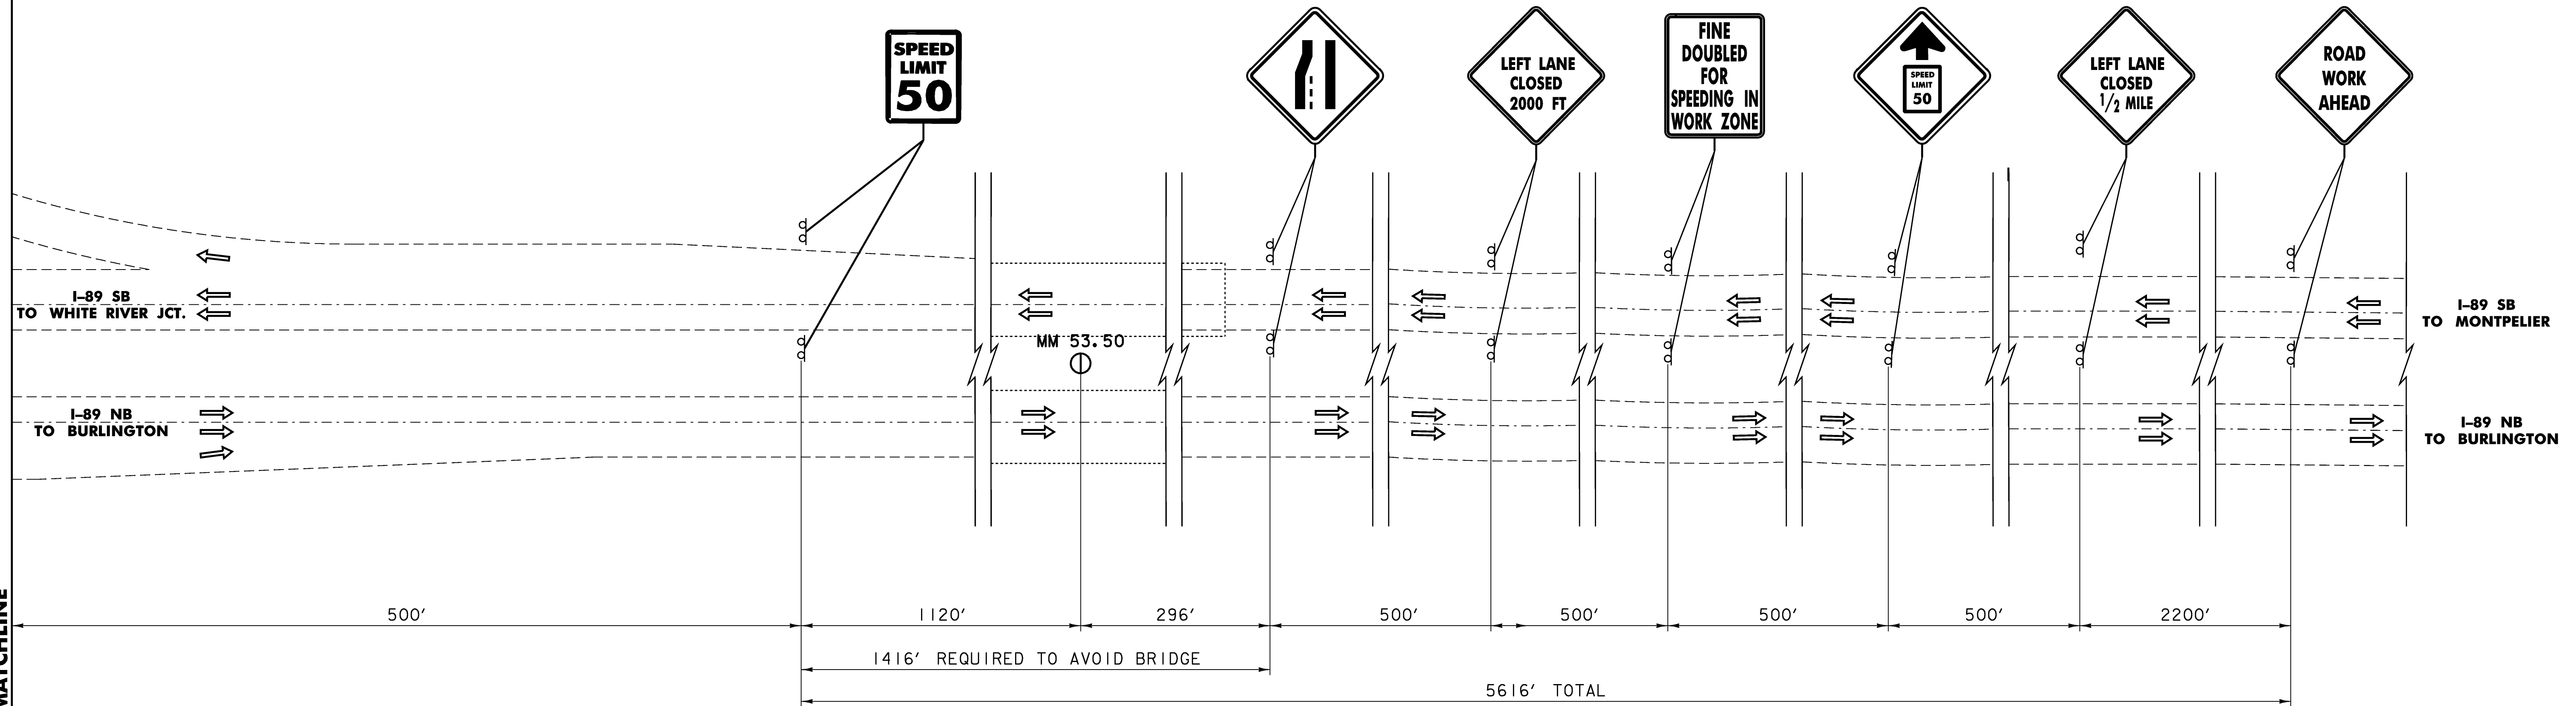


**APPROACH SIGNS**  
**NORTHBOUND CLOSURE**  
**TRAFFIC CONTROL SHEET 8**

PROJECT: BERLIN	PROJECT NO.: IM 089-1 (20)
DESIGN FILE NAME: 99a270\structures\s99a270bdr_detnb.dgn	PLOT DATE: 05-DEC-2007
IPARM FILE NAME: s99a270trafnb08.i	DRAWN BY: C. MOONEY
DESIGNED BY: G. SPILAK	CHECKED BY: K. M. HIGGINS
SQUAD LEADER: C. P. WILLIAMS	SHEET: 34 OF 104
NORTHBOUND CLOSURE SHEET 8	

SCALE 1" = 50'-0"  
 50 0 50


NOTE - TRAFFIC CONTROL PLANS ARE SHOWN USING THE ORIGINAL INTERSTATE PLANS

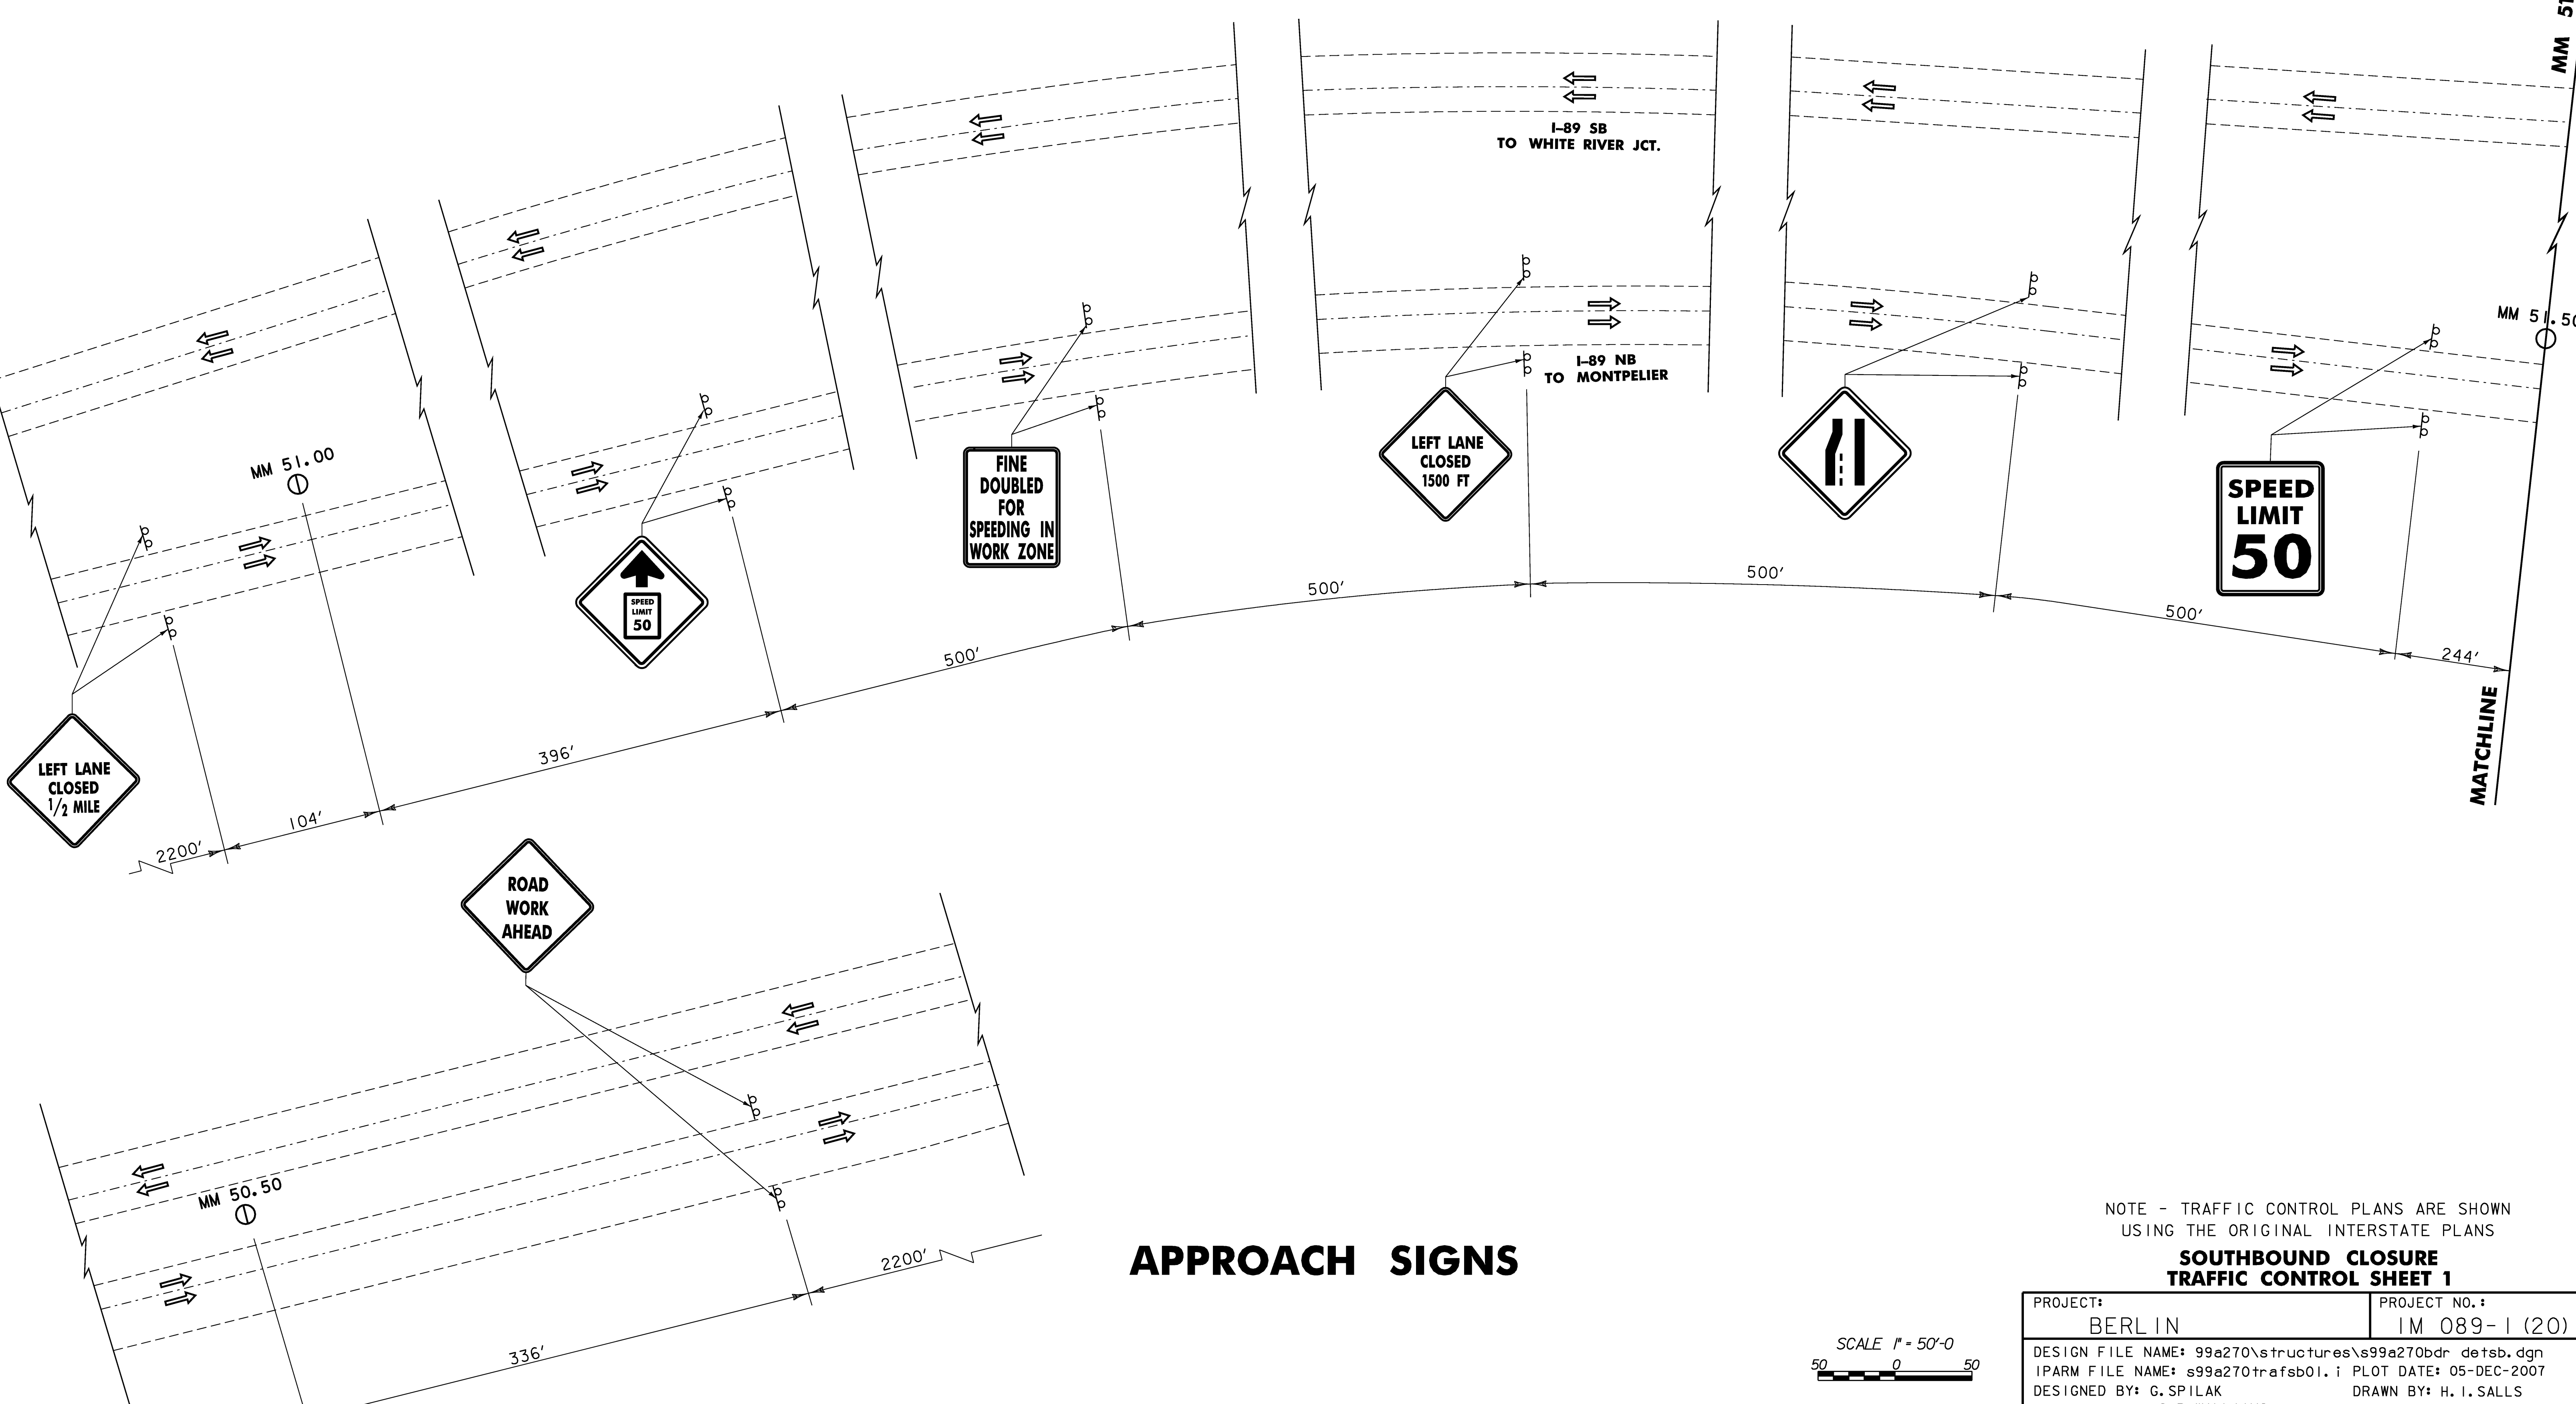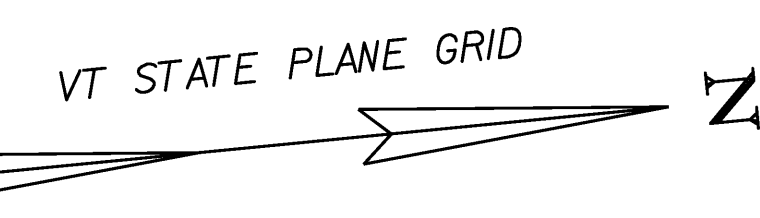
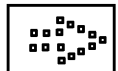
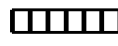
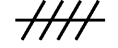








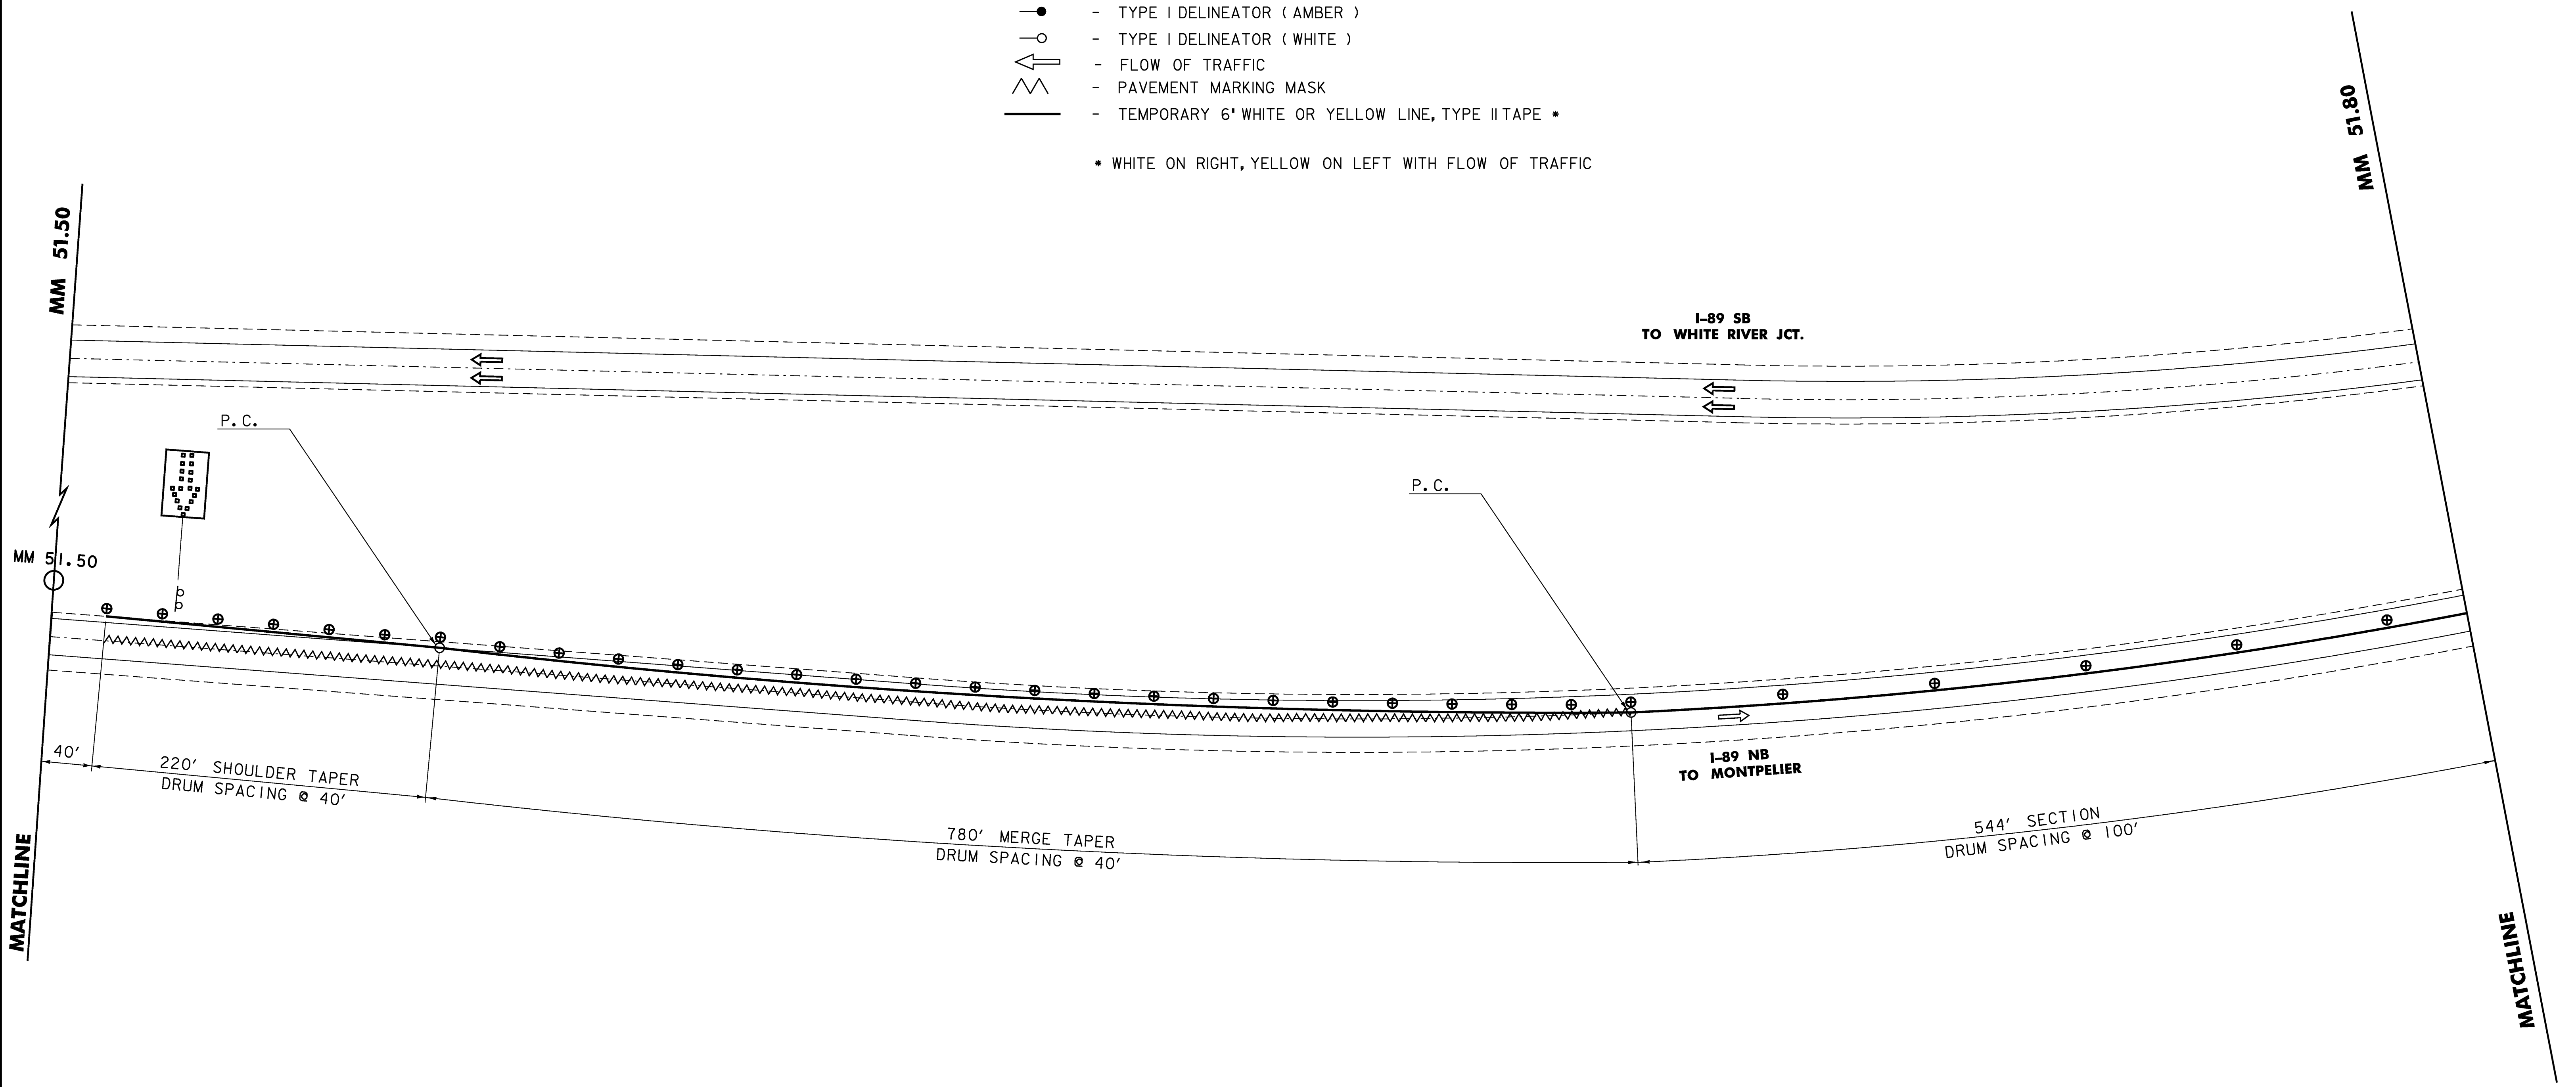
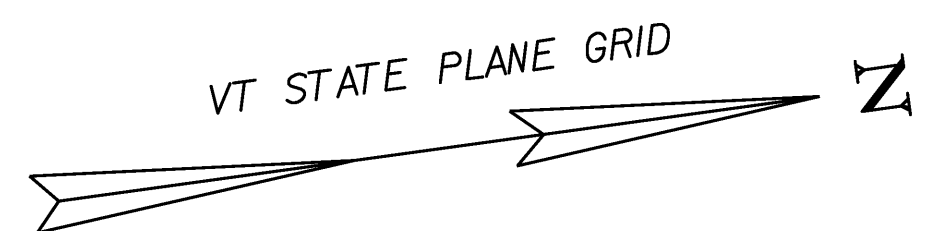
NOTE - TRAFFIC CONTROL PLANS ARE SHOWN USING THE ORIGINAL INTERSTATE PLANS

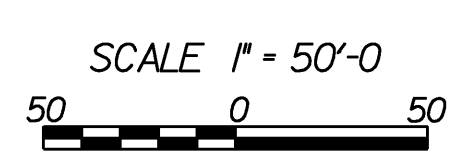**SOUTHBOUND CLOSURE TRAFFIC CONTROL SHEET 1**

PROJECT: BERLIN	PROJECT NO.: IM 089-1 (20)
DESIGN FILE NAME: 99a270\structures\s99a270bdr_detsb.dgn	PLOT DATE: 05-DEC-2007
IPARM FILE NAME: s99a270trafsb01.i	DRAWN BY: H. I. SALLS
DESIGNED BY: G. SPILAK	CHECKED BY: K. M. HIGGINS
SQUAD LEADER: C. P. WILLIAMS	SHEET: 35 OF 104
SOUTHBOUND CLOSURE SHEET 1	

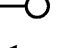


- LEGEND**
-  - TYPE III BARRICADES.
  -  - PORTABLE ARROW BOARD
  -  - TEMPORARY TRAFFIC BARRIER
  -  - REMOVAL OF EXISTING PAVEMENT MARKING
  -  - REFLECTORIZED PLASTIC DRUM
  -  - TYPE I DELINEATOR ( AMBER )
  -  - TYPE I DELINEATOR ( WHITE )
  -  - FLOW OF TRAFFIC
  -  - PAVEMENT MARKING MASK
  -  - TEMPORARY 6" WHITE OR YELLOW LINE, TYPE II TAPE \*
- \* WHITE ON RIGHT, YELLOW ON LEFT WITH FLOW OF TRAFFIC










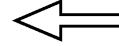


NOTE - TRAFFIC CONTROL PLANS ARE SHOWN USING THE ORIGINAL INTERSTATE PLANS


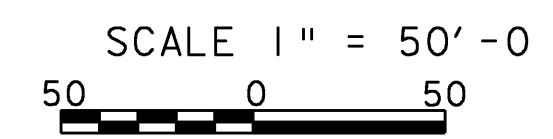
**SOUTHBOUND CLOSURE  
TRAFFIC CONTROL SHEET 2**

PROJECT: <b>BERLIN</b>	PROJECT NO.: <b>IM 089-1 (20)</b>
DESIGN FILE NAME: 99a270\structures\s99a270bdr_detsb.dgn	IPARM FILE NAME: s99a270trafsb02.i PLOT DATE: 05-DEC-2007
DESIGNED BY: G. SPILAK	DRAWN BY: H. I. SALLS
SQUAD LEADER: C.P. WILLIAMS	CHECKED BY: K.M. HIGGINS
SOUTHBOUND CLOSURE SHEET 2	SHEET: 36 OF 104

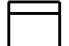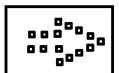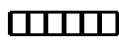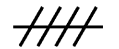

**LEGEND**


-  - TYPE III BARRICADES.
  -  - PORTABLE ARROW BOARD
  -  - TEMPORARY TRAFFIC BARRIER
  -  - REMOVAL OF EXISTING PAVEMENT MARKING
  -  - REFLECTORIZED PLASTIC DRUM
  -  - TYPE I DELINEATOR ( AMBER )
  -  - TYPE I DELINEATOR ( WHITE )
  -  - FLOW OF TRAFFIC
  -  - PAVEMENT MARKING MASK
  -  - TEMPORARY 6" WHITE OR YELLOW LINE, TYPE II TAPE \*
- \* WHITE ON RIGHT, YELLOW ON LEFT WITH FLOW OF TRAFFIC

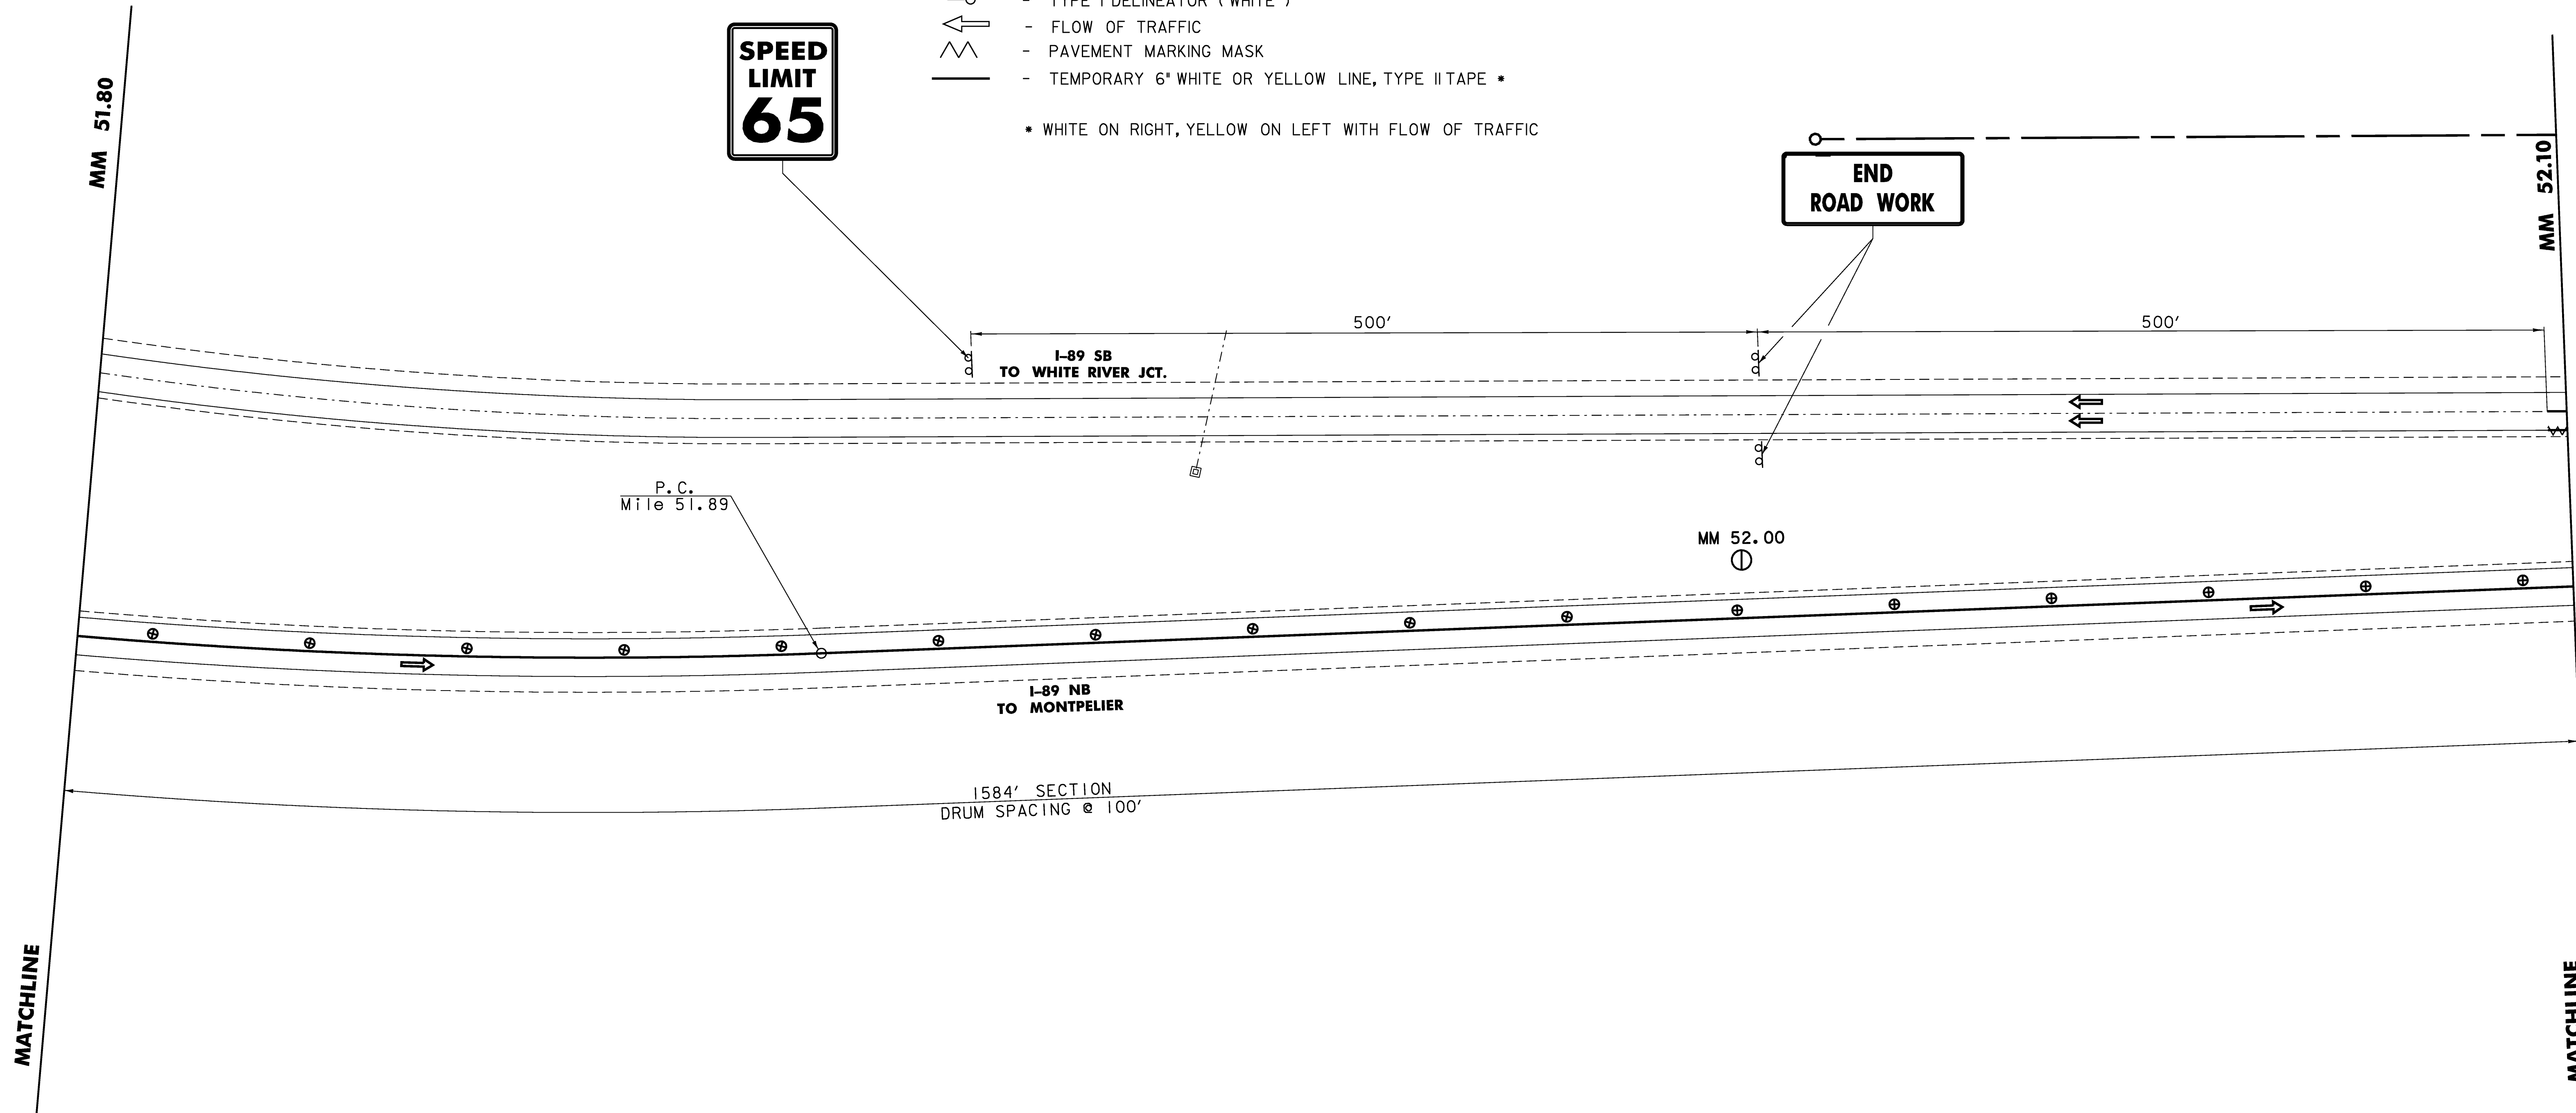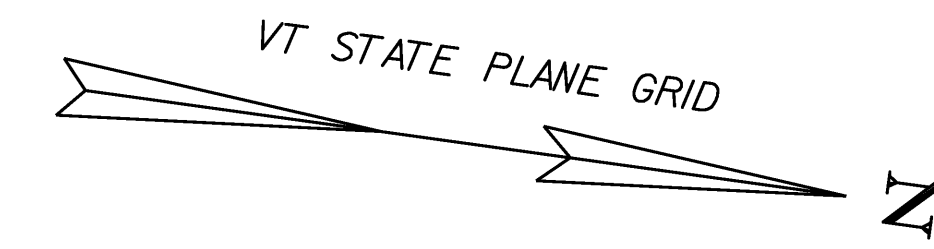


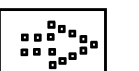
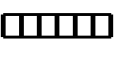
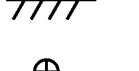

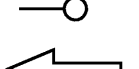

 


NOTE - TRAFFIC CONTROL PLANS ARE SHOWN USING THE ORIGINAL INTERSTATE PLANS


**SOUTHBOUND CLOSURE TRAFFIC CONTROL SHEET 3**

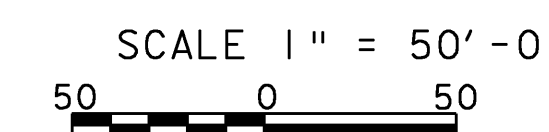PROJECT: <b>BERLIN</b>	PROJECT NO. : <b>IM 089-1 (20)</b>
DESIGN FILE NAME: 99a270\structures\s99a270bdr_detsb.dgn	PLOT DATE: 05-DEC-2007
IPARM FILE NAME: s99a270trafsb03.i	DRAWN BY: H. I. SALLS
DESIGNED BY: G. SPILAK	CHECKED BY: K. M. HIGGINS
SQUAD LEADER: C. P. WILLIAMS	SHEET: 37 OF 104
SOUTHBOUND CLOSURE SHEET 3	



**LEGEND**


-  - TYPE III BARRICADES.
  -  - PORTABLE ARROW BOARD
  -  - TEMPORARY TRAFFIC BARRIER
  -  - REMOVAL OF EXISTING PAVEMENT MARKING
  -  - REFLECTORIZED PLASTIC DRUM
  -  - TYPE I DELINEATOR ( AMBER )
  -  - TYPE I DELINEATOR ( WHITE )
  -  - FLOW OF TRAFFIC
  -  - PAVEMENT MARKING MASK
  -  - TEMPORARY 6" WHITE OR YELLOW LINE, TYPE II TAPE \*
- \* WHITE ON RIGHT, YELLOW ON LEFT WITH FLOW OF TRAFFIC

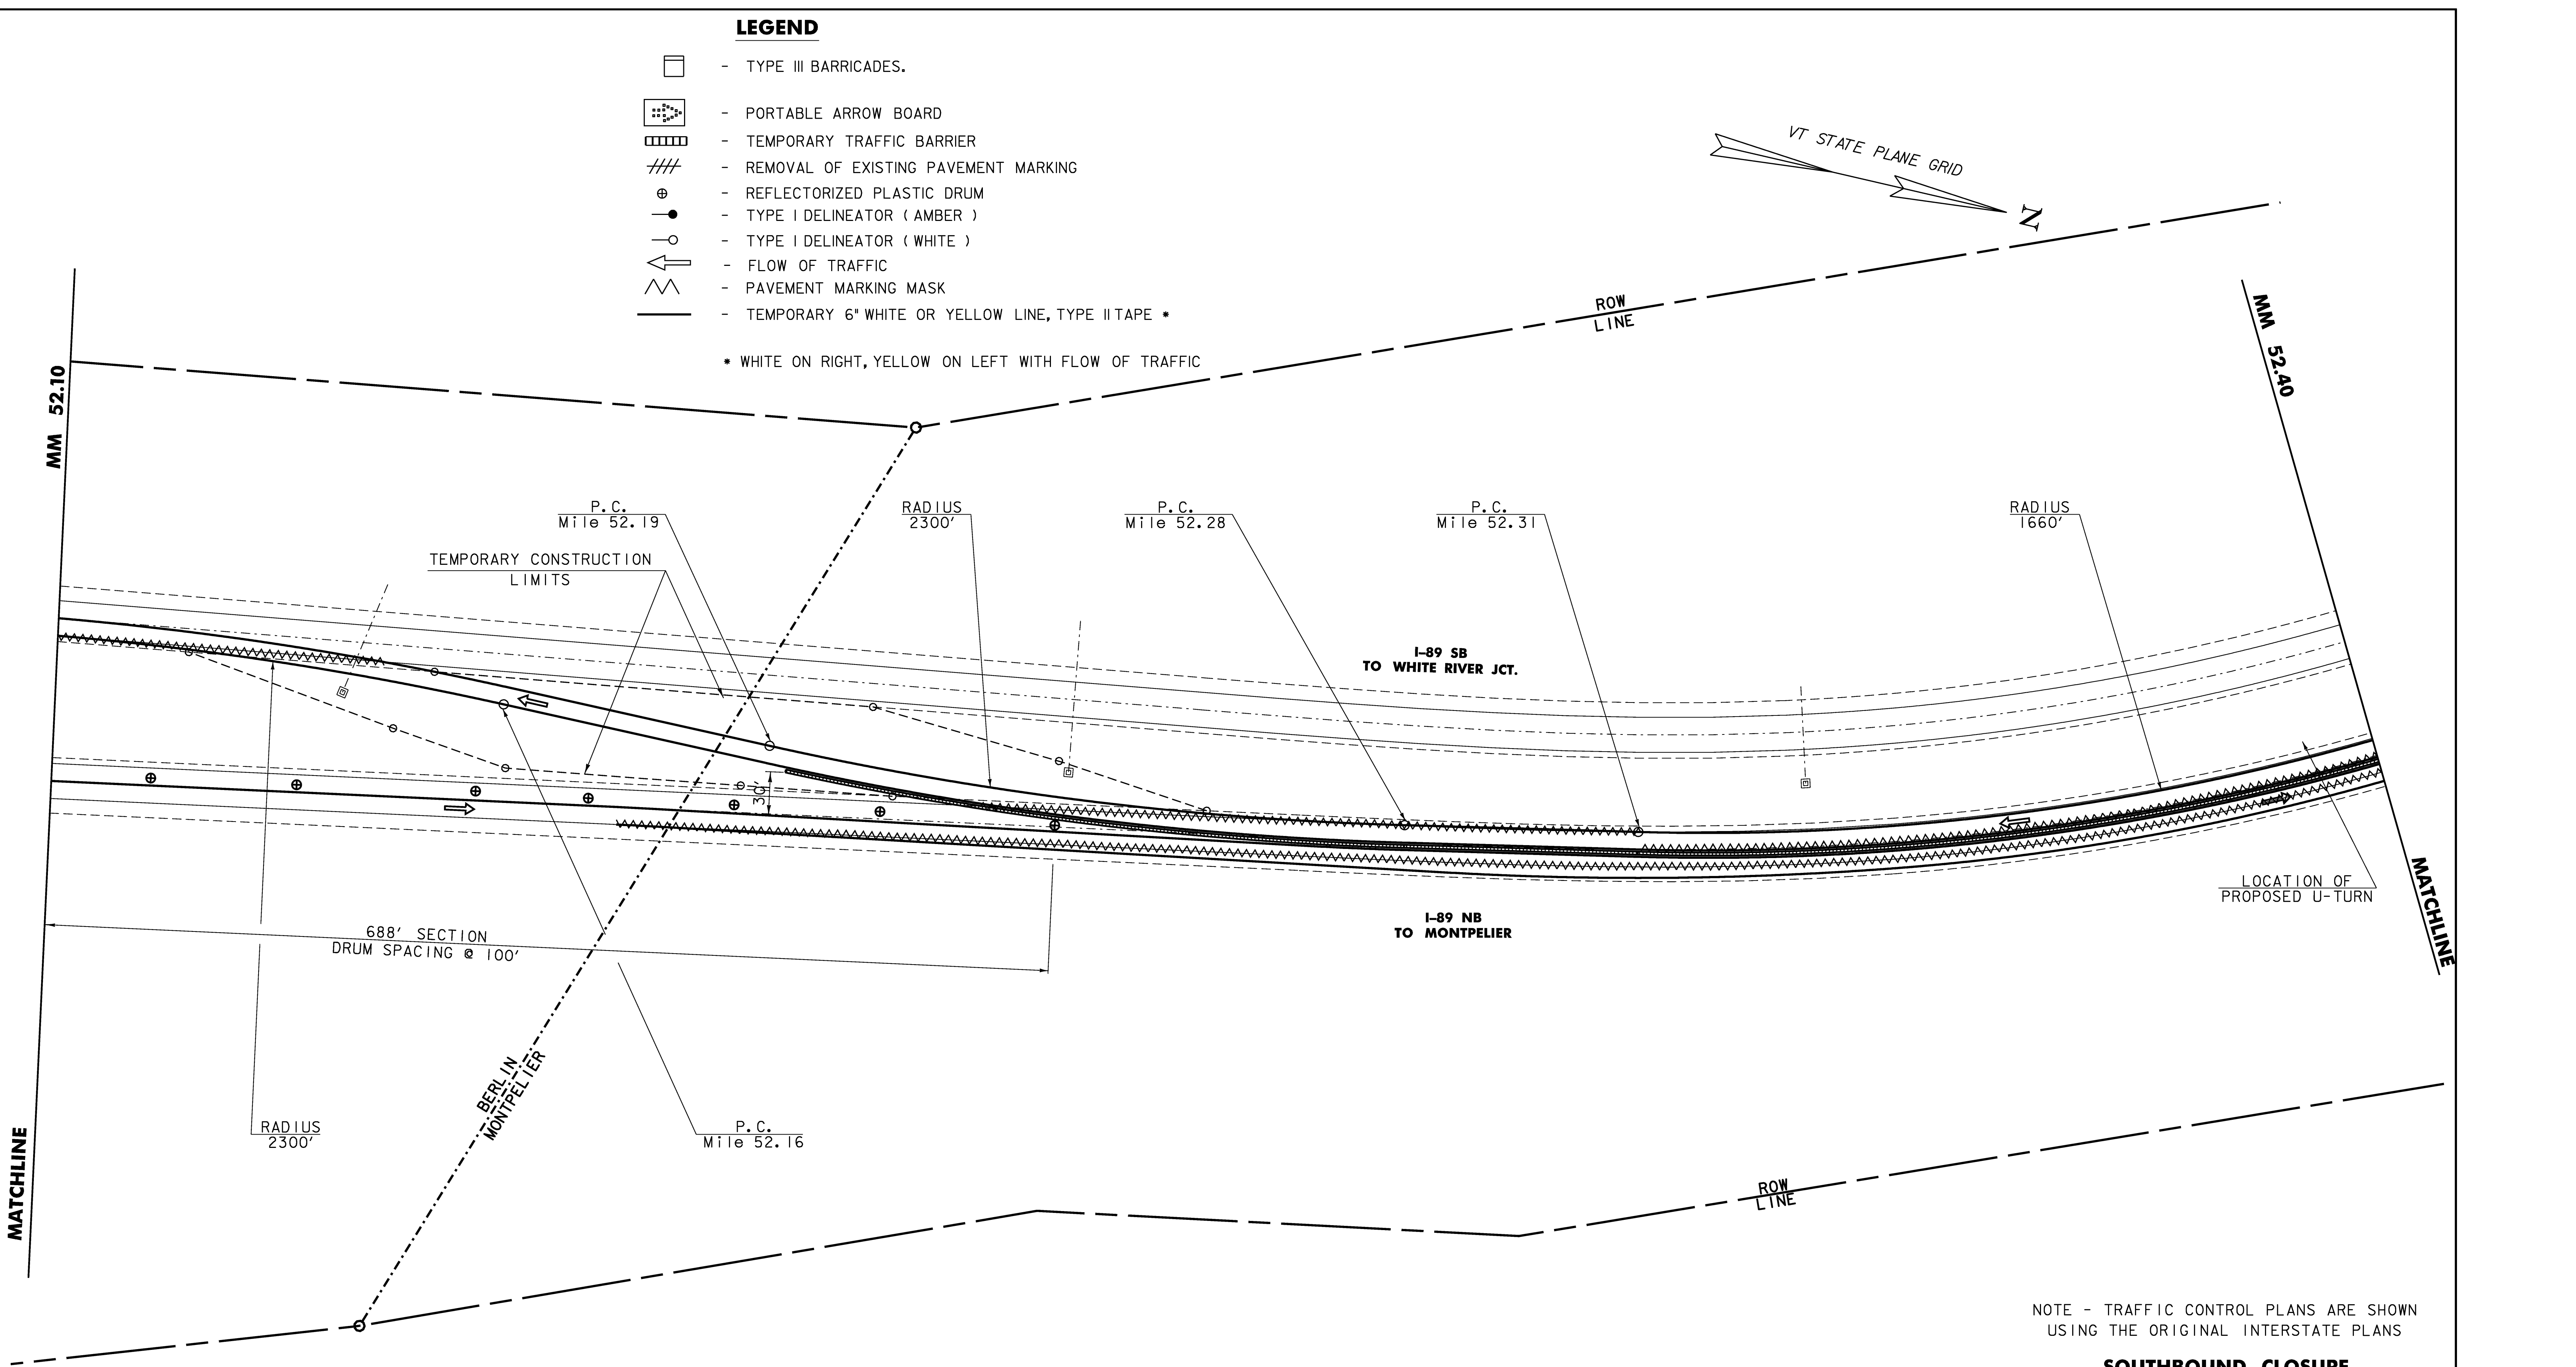






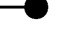
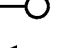



NOTE - TRAFFIC CONTROL PLANS ARE SHOWN USING THE ORIGINAL INTERSTATE PLANS

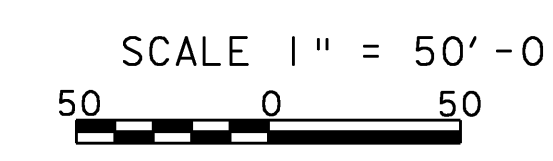**SOUTHBOUND CLOSURE  
TRAFFIC CONTROL SHEET 4**



PROJECT: <b>BERLIN</b>	PROJECT NO.: <b>IM 089-1 (20)</b>
DESIGN FILE NAME: 99a270\structures\99a270bdr_detsb.dgn	PLOT DATE: 05-DEC-2007
IPARM FILE NAME: s99a270trafsb04.i	DESIGNED BY: G. SPILAK
SQUAD LEADER: C.P. WILLIAMS	DRAWN BY: H. I. SALLS
SOUTHBOUND CLOSURE SHEET 4	CHECKED BY: K.M. HIGGINS
	SHEET: 38 OF 104

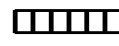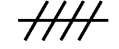

**LEGEND**

-  - TYPE III BARRICADES.
-  - PORTABLE ARROW BOARD
-  - TEMPORARY TRAFFIC BARRIER
-  - REMOVAL OF EXISTING PAVEMENT MARKING
-  - REFLECTORIZED PLASTIC DRUM
-  - TYPE I DELINEATOR ( AMBER )
-  - TYPE I DELINEATOR ( WHITE )
-  - FLOW OF TRAFFIC
-  - PAVEMENT MARKING MASK
-  - TEMPORARY 6' WHITE OR YELLOW LINE, TYPE II TAPE \*


\* WHITE ON RIGHT, YELLOW ON LEFT WITH FLOW OF TRAFFIC

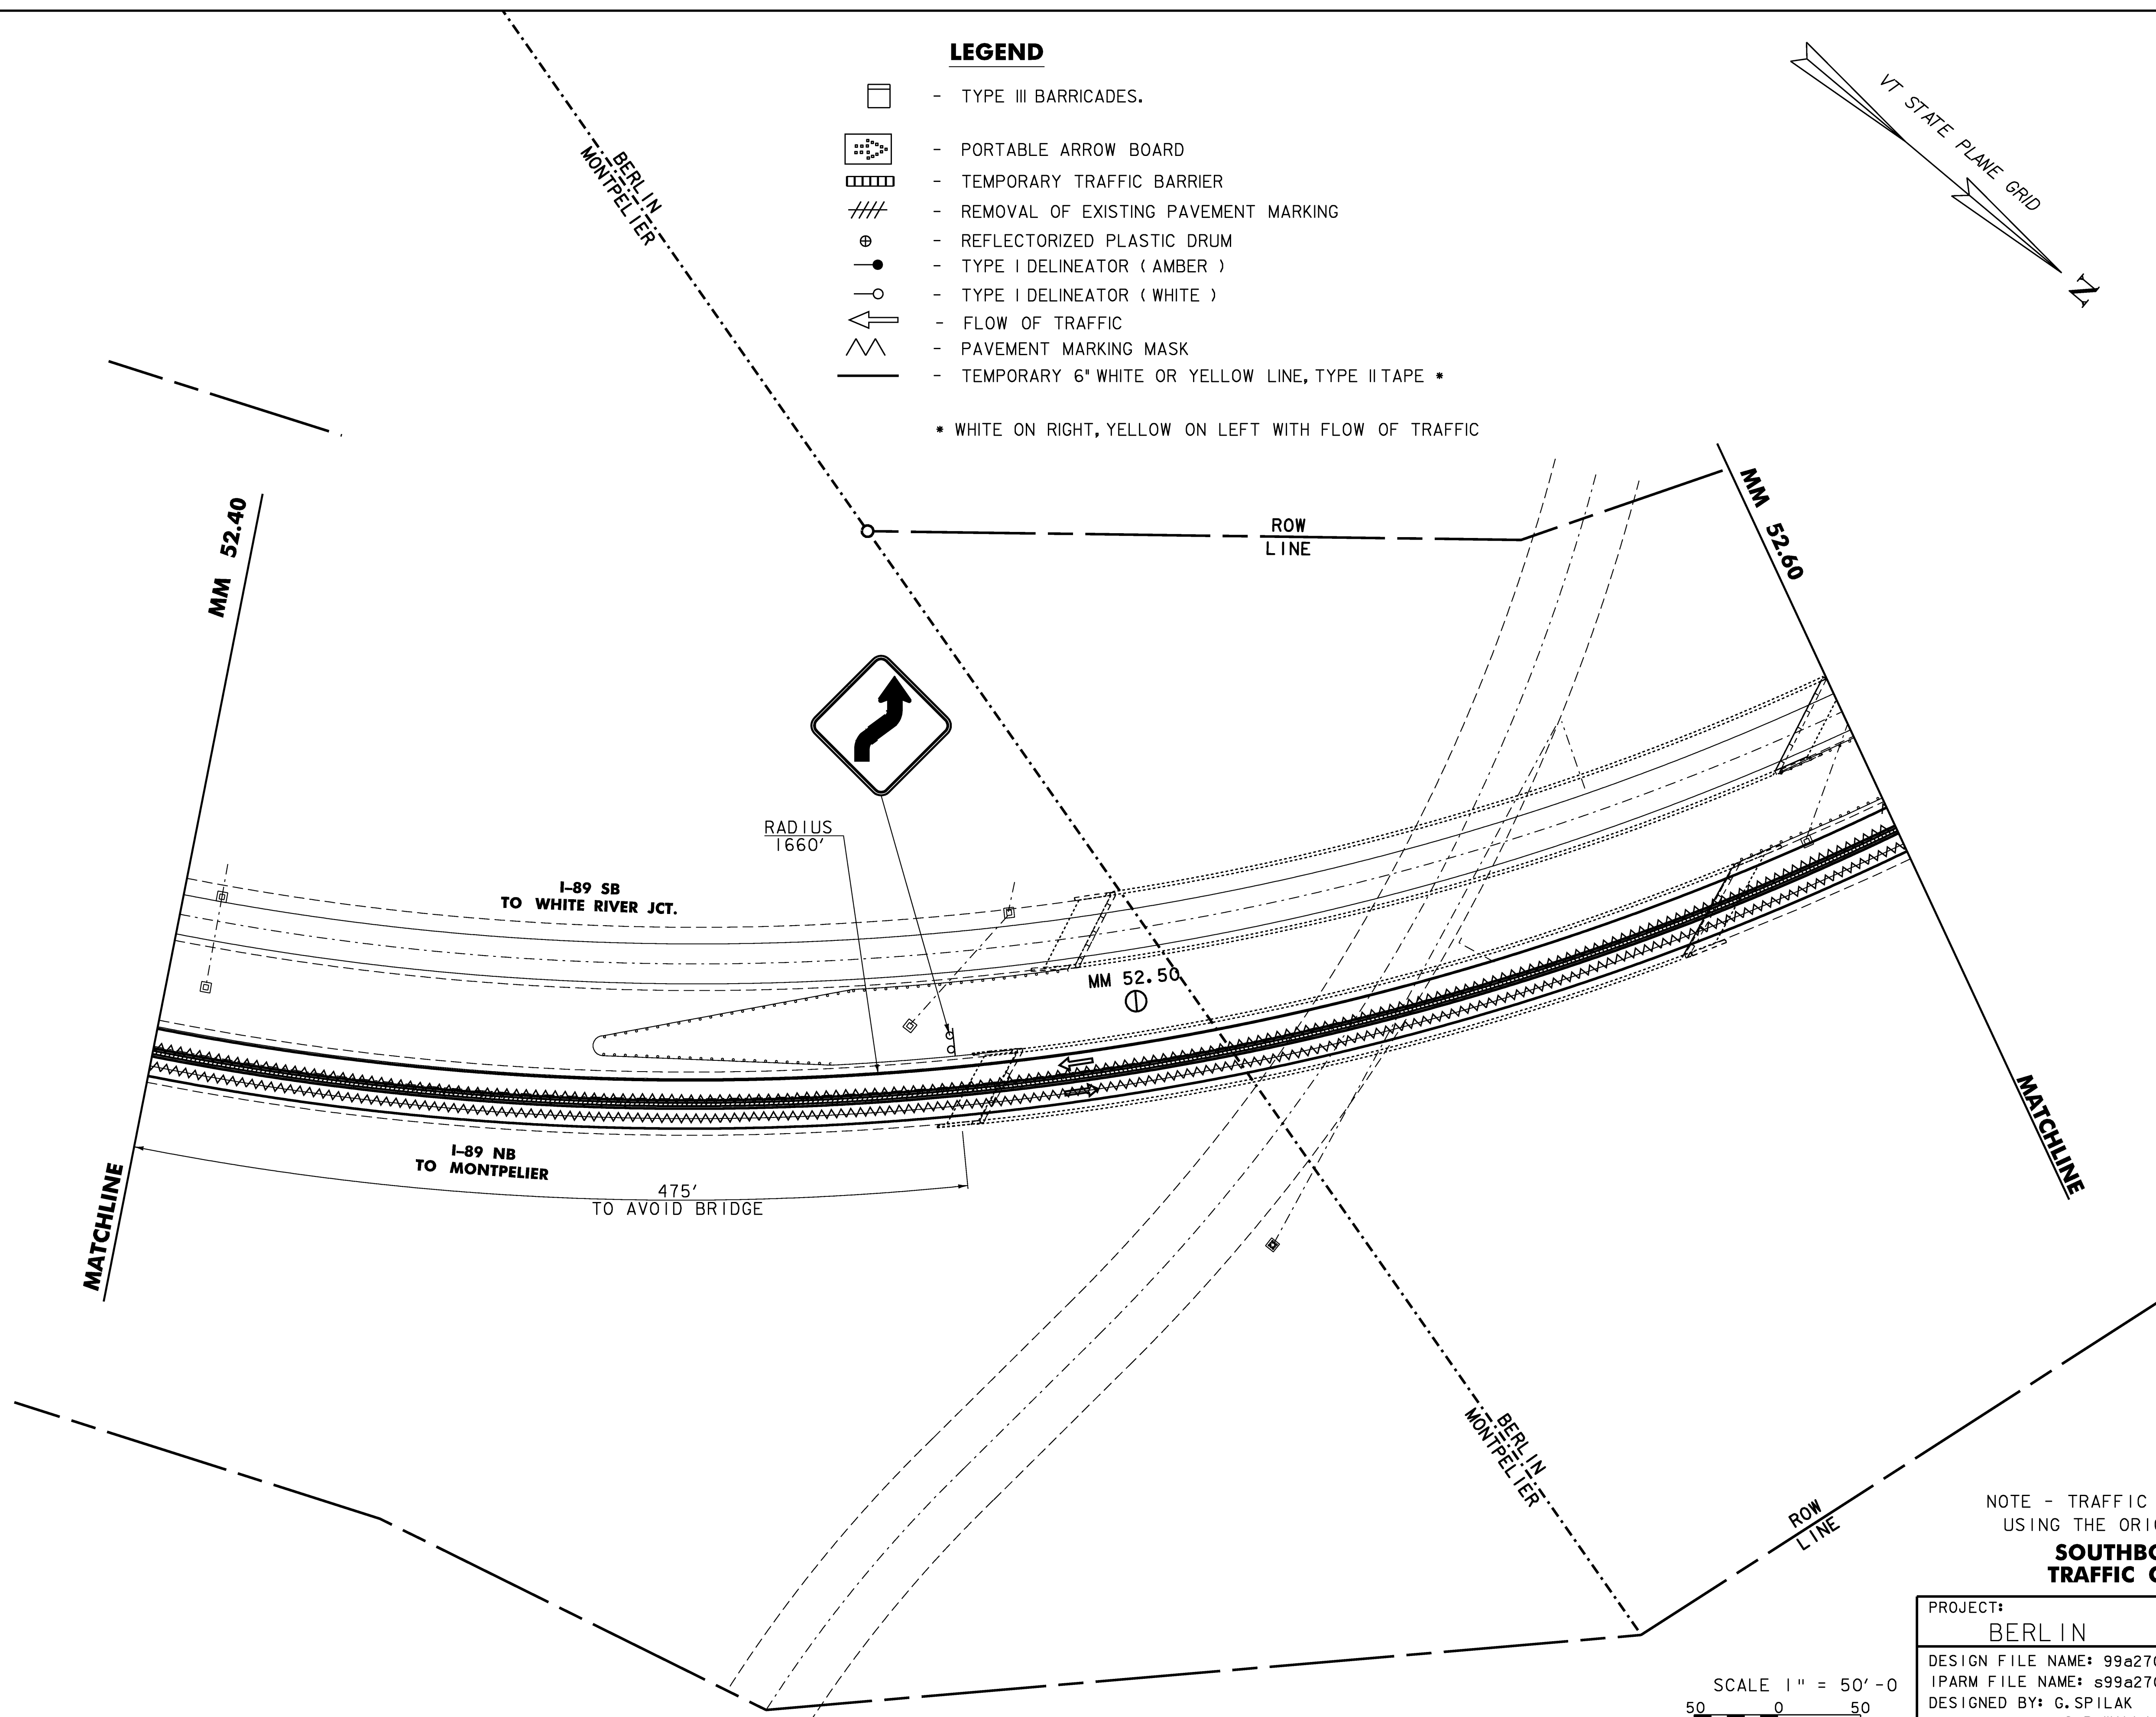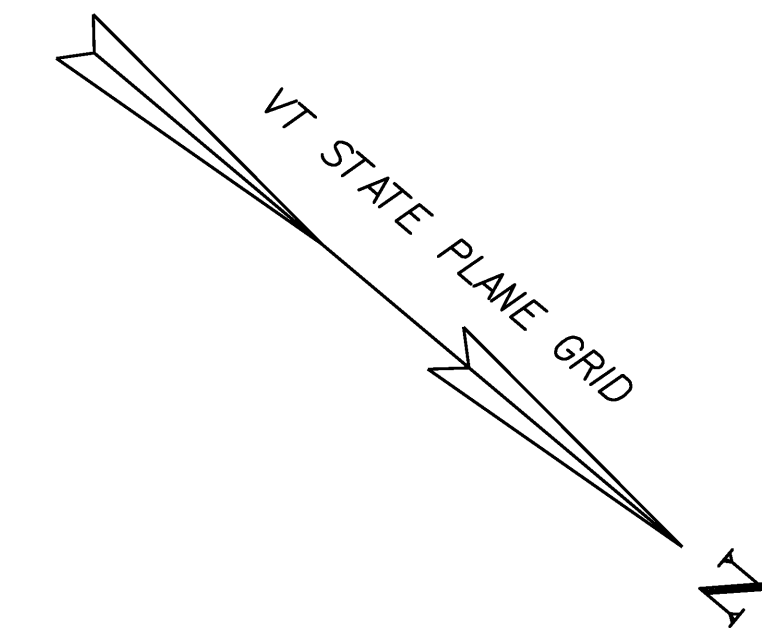







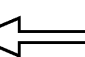



NOTE - TRAFFIC CONTROL PLANS ARE SHOWN USING THE ORIGINAL INTERSTATE PLANS

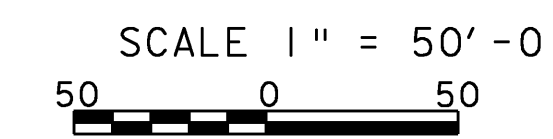**SOUTHBOUND CLOSURE TRAFFIC CONTROL SHEET 5**


PROJECT:	BERLIN	PROJECT NO.:	IM 089-1 (20)
DESIGN FILE NAME:	99a270\structures\s99a270bdr_detsb.dgn	PLOT DATE:	05-DEC-2007
IPARM FILE NAME:	s99a270trafsb05.i	DESIGNED BY:	G. SPILAK
		DRAWN BY:	H. I. SALLS
		SQUAD LEADER:	C. P. WILLIAMS
		CHECKED BY:	K. M. HIGGINS
		SOUTHBOUND CLOSURE SHEET 5	SHEET: 39 OF 104

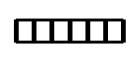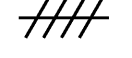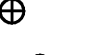

**LEGEND**

-  - TYPE III BARRICADES.
-  - PORTABLE ARROW BOARD
-  - TEMPORARY TRAFFIC BARRIER
-  - REMOVAL OF EXISTING PAVEMENT MARKING
-  - REFLECTORIZED PLASTIC DRUM
-  - TYPE I DELINEATOR (AMBER)
-  - TYPE I DELINEATOR (WHITE)
-  - FLOW OF TRAFFIC
-  - PAVEMENT MARKING MASK
-  - TEMPORARY 6' WHITE OR YELLOW LINE, TYPE II TAPE \*

\* WHITE ON RIGHT, YELLOW ON LEFT WITH FLOW OF TRAFFIC

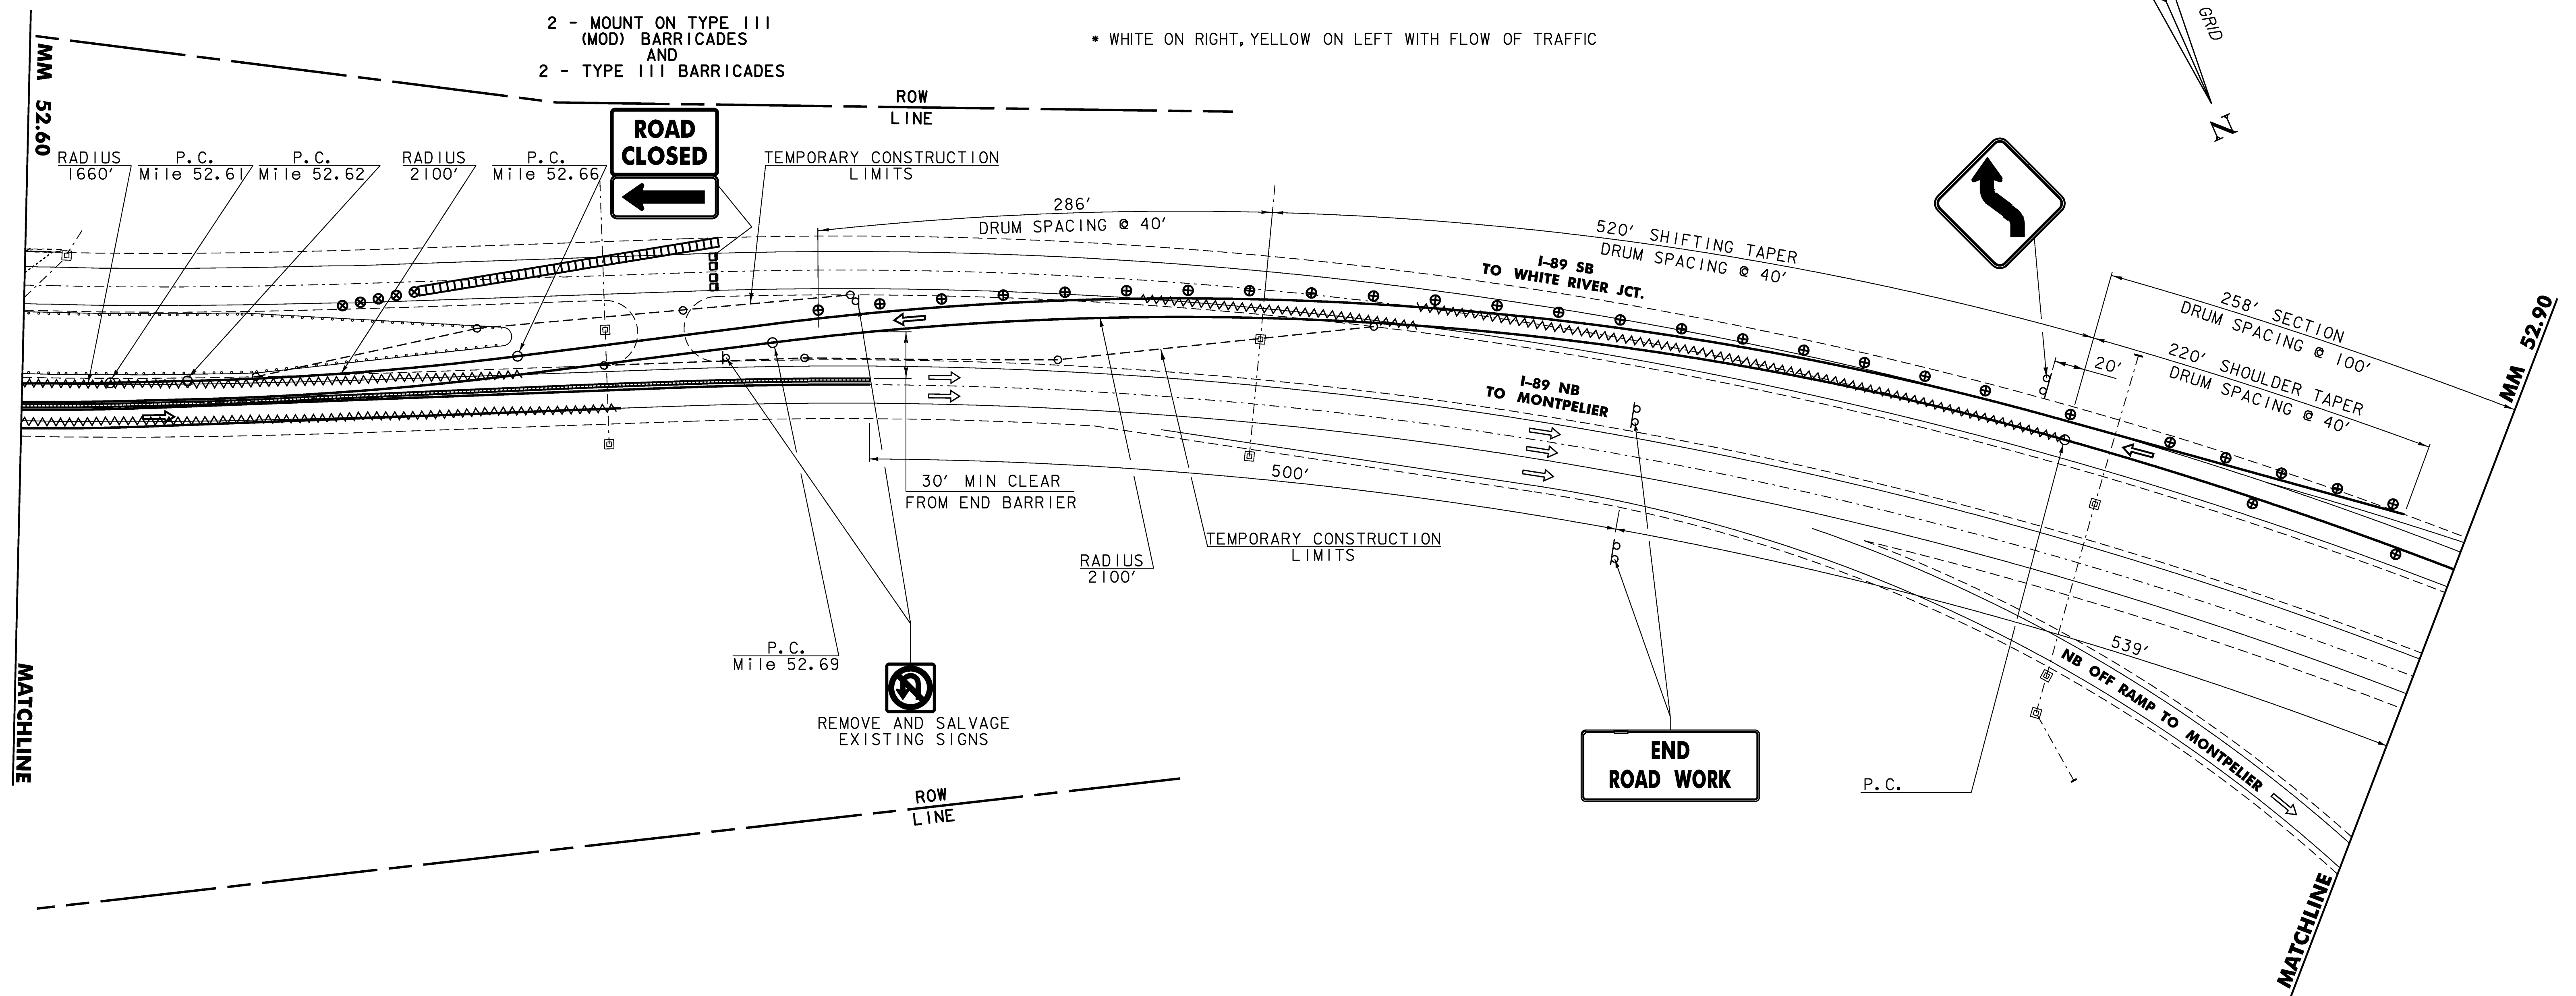


**SOUTHBOUND CLOSURE  
TRAFFIC CONTROL SHEET 6**

NOTE - TRAFFIC CONTROL PLANS ARE SHOWN  
USING THE ORIGINAL INTERSTATE PLANS

SCALE 1" = 50'-0"  
50 0 50


PROJECT: <b>BERLIN</b>	PROJECT NO.: <b>IM 089-1 (20)</b>
DESIGN FILE NAME: 99a270\structures\s99a270bdr_detsb.dgn	PLOT DATE: 05-DEC-2007
IPARM FILE NAME: s99a270trafsb06.i	DRAWN BY: H. I. SALLS
DESIGNED BY: G. SPILAK	CHECKED BY: K. M. HIGGINS
SQUAD LEADER: C. P. WILLIAMS	SHEET: 40 OF 104
SOUTHBOUND CLOSURE SHEET 6	

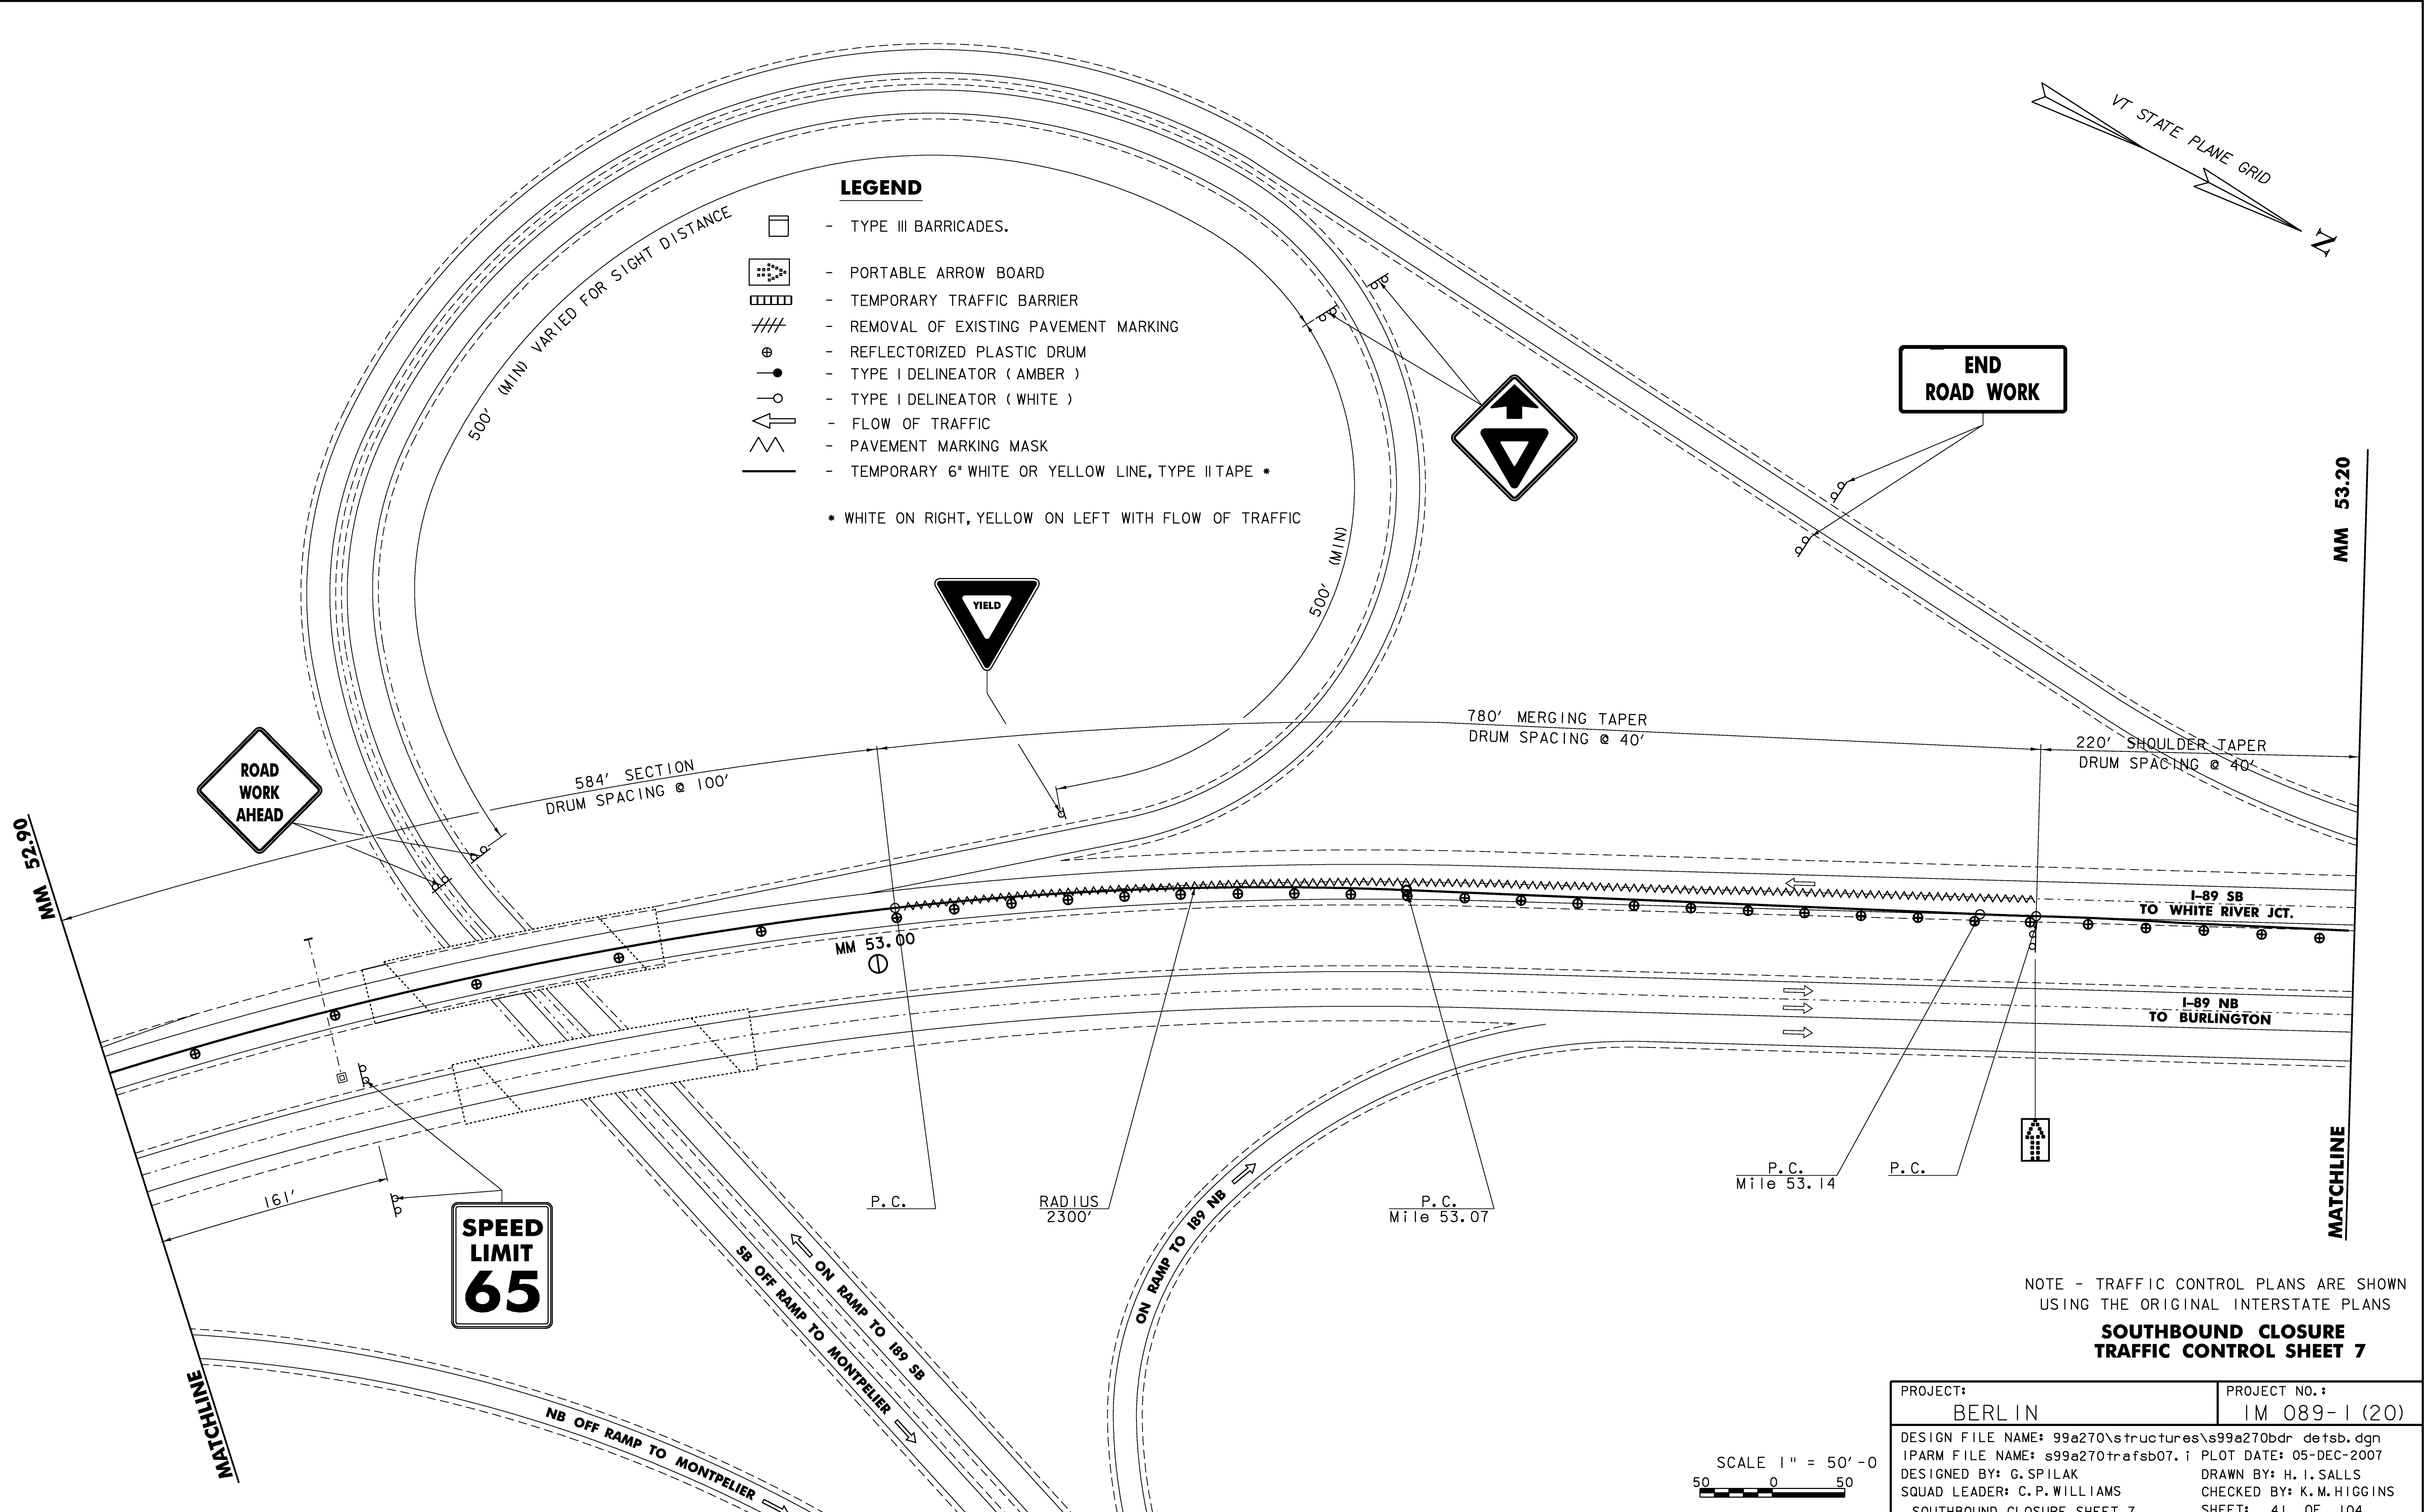

NOTE - TRAFFIC CONTROL PLANS ARE SHOWN USING THE ORIGINAL INTERSTATE PLANS

**SOUTHBOUND CLOSURE TRAFFIC CONTROL SHEET 7**

PROJECT: <b>BERLIN</b>	PROJECT NO.: <b>IM 089-1 (20)</b>
DESIGN FILE NAME: 99a270\structures\s99a270bdr_detsb.dgn	PLOT DATE: 05-DEC-2007
IPARM FILE NAME: s99a270trafsb07.i	DESIGNED BY: G. SPILAK
SQUAD LEADER: C.P. WILLIAMS	DRAWN BY: H. I. SALLS
SOUTHBOUND CLOSURE SHEET 7	CHECKED BY: K.M. HIGGINS
	SHEET: 41 OF 104

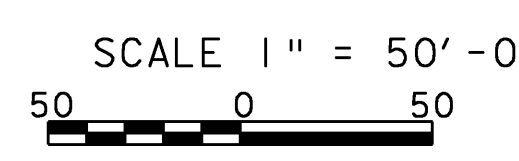


MM 53.20

MATCHLINE


**LEGEND**

← - FLOW OF TRAFFIC

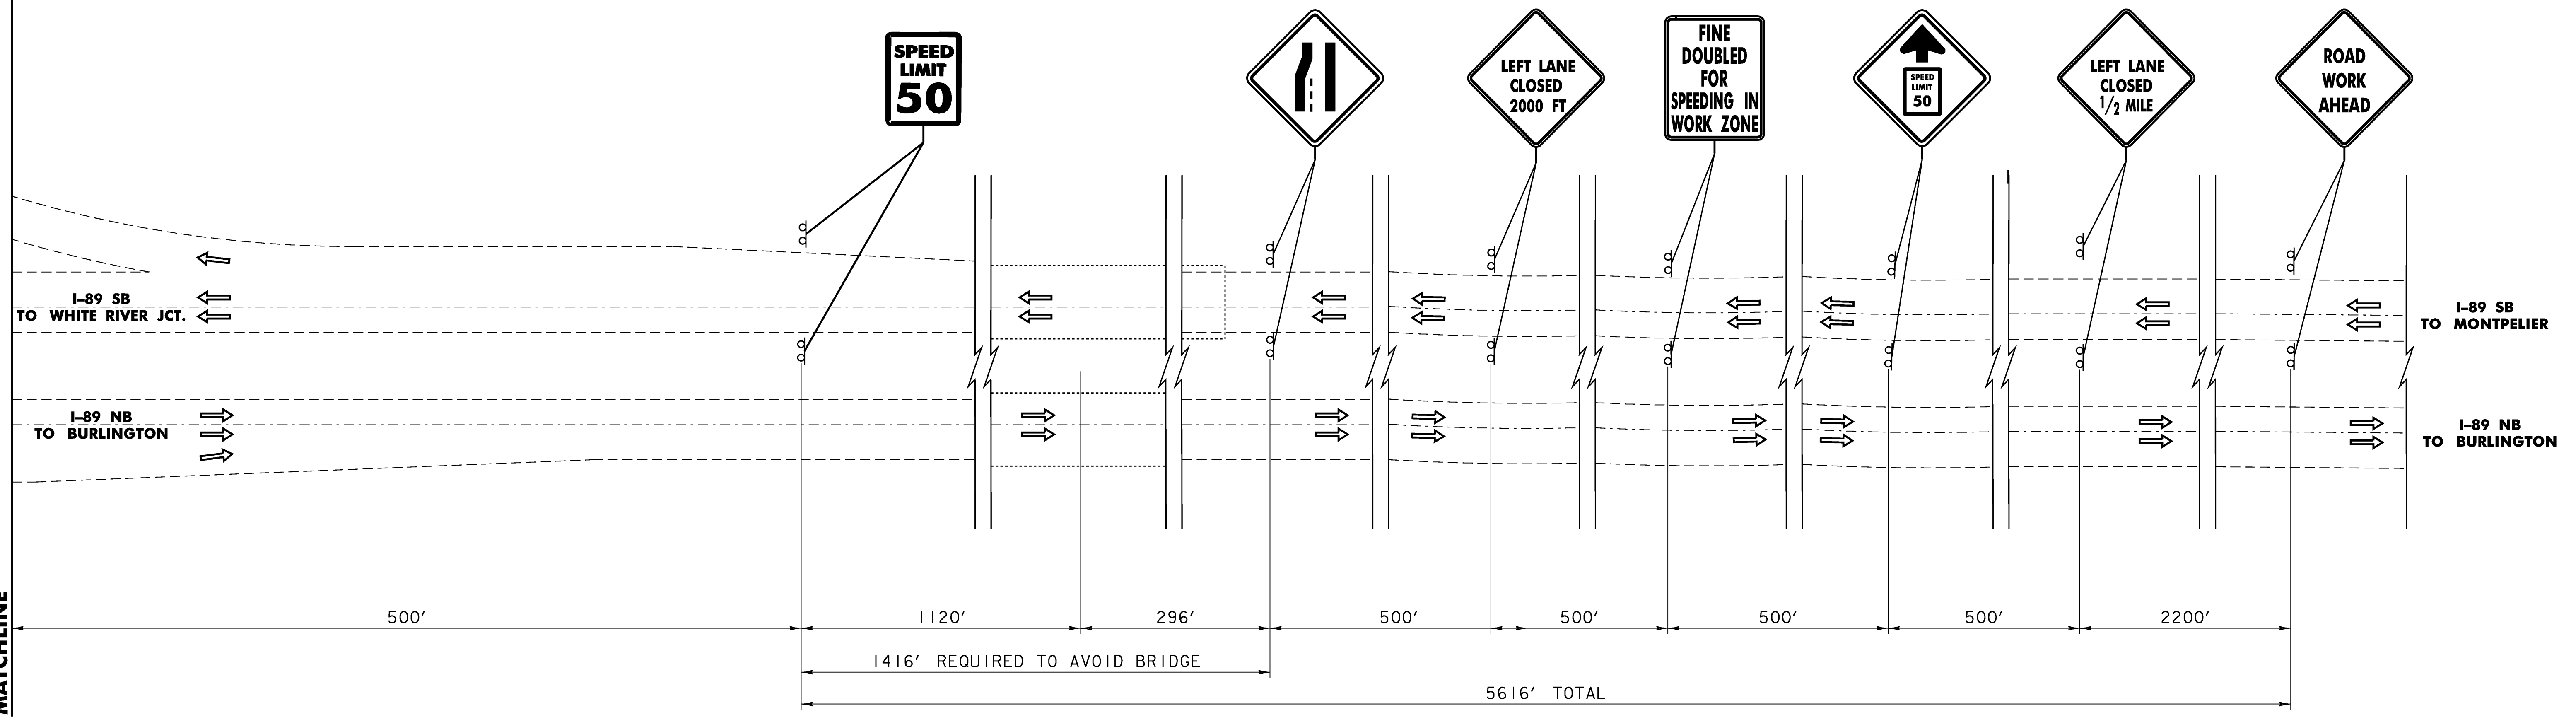


**APPROACH SIGNS**  
**SOUTHBOUND CLOSURE**  
**TRAFFIC CONTROL SHEET 8**

PROJECT:	BERLIN	PROJECT NO.:	IM 089-1 (20)
DESIGN FILE NAME:	99a270\structures\s99a270bdr_detsb.dgn	PLOT DATE:	05-DEC-2007
IPARM FILE NAME:	s99a270trafsb08.i	DESIGNED BY:	G. SPILAK
		DRAWN BY:	H. I. SALLS
		SQUAD LEADER:	C. P. WILLIAMS
		CHECKED BY:	K. M. HIGGINS
		SOUTHBOUND CLOSURE SHEET 8	SHEET: 42 OF 104

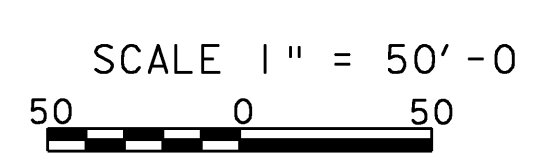


NOTE - TRAFFIC CONTROL PLANS ARE SHOWN USING THE ORIGINAL INTERSTATE PLANS

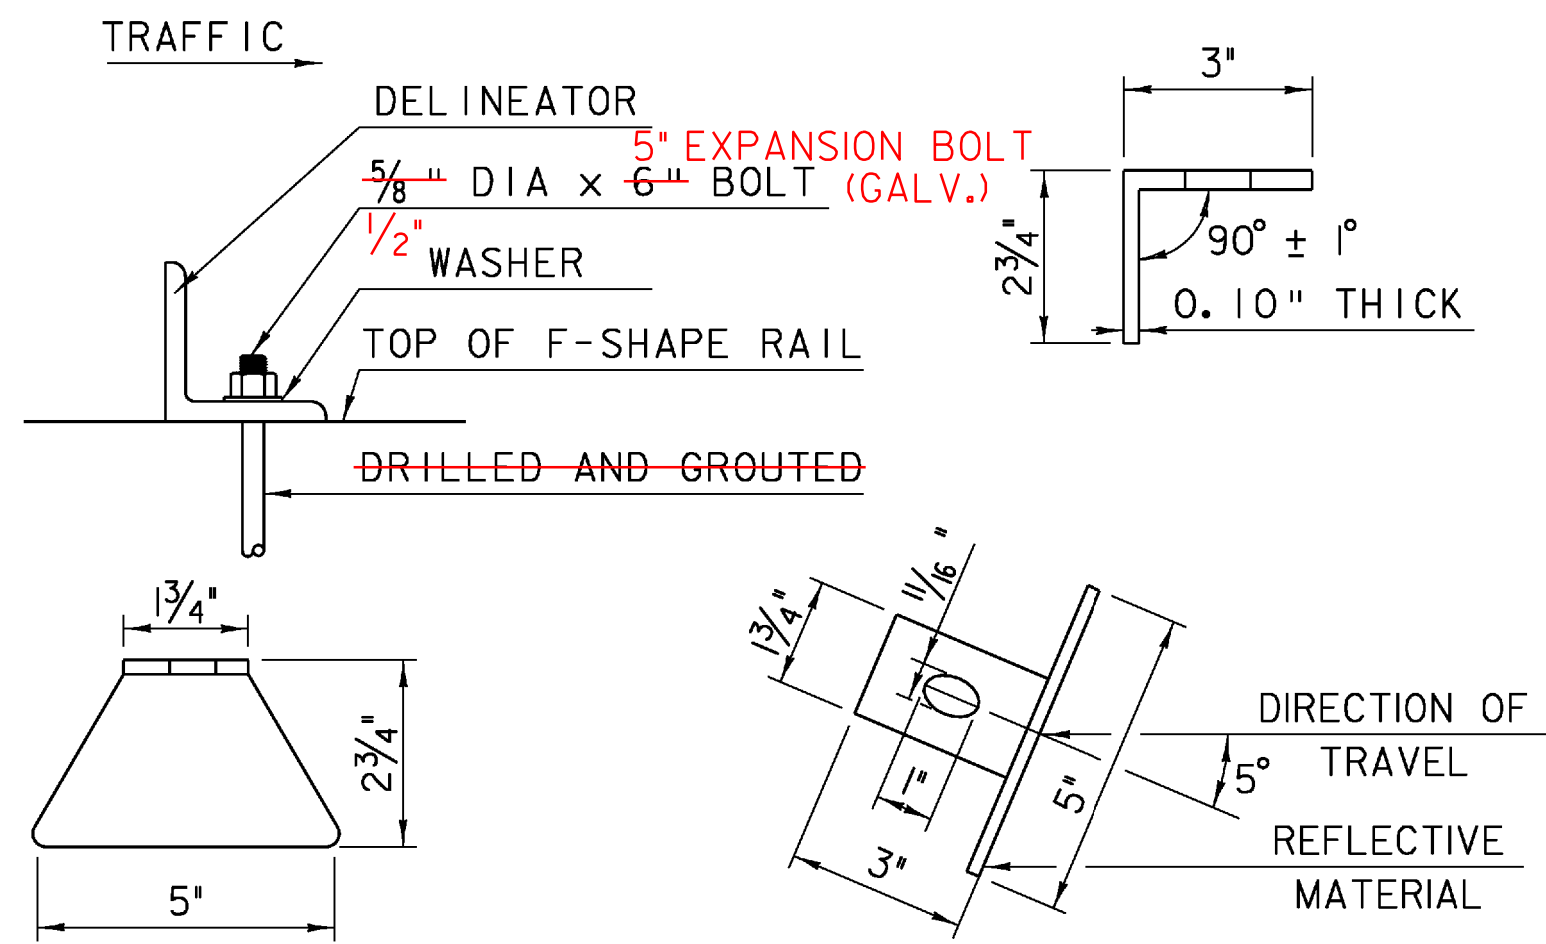

**DELINEATOR NOTES**


NTS

1. PAYMENT FOR DELINEATORS SHALL BE INCLUDED IN THE UNIT PRICE BID FOR ITEM #900.640 SPECIAL PROVISION, (BRIDGE RAILING, F-SHAPE CONCRETE).
2. DELINEATORS SHALL BE EVENLY SPACED ACROSS THE ENTIRE LENGTH OF BRIDGE RAILING BUT NOT WITHIN 2' OF ANY JOINT OPENING NOR A SPACING OF MORE THAN 30'.
3. DELINEATORS SHALL BE AMBER OR WHITE WITH AMBER ON THE MEDIAN SIDE.

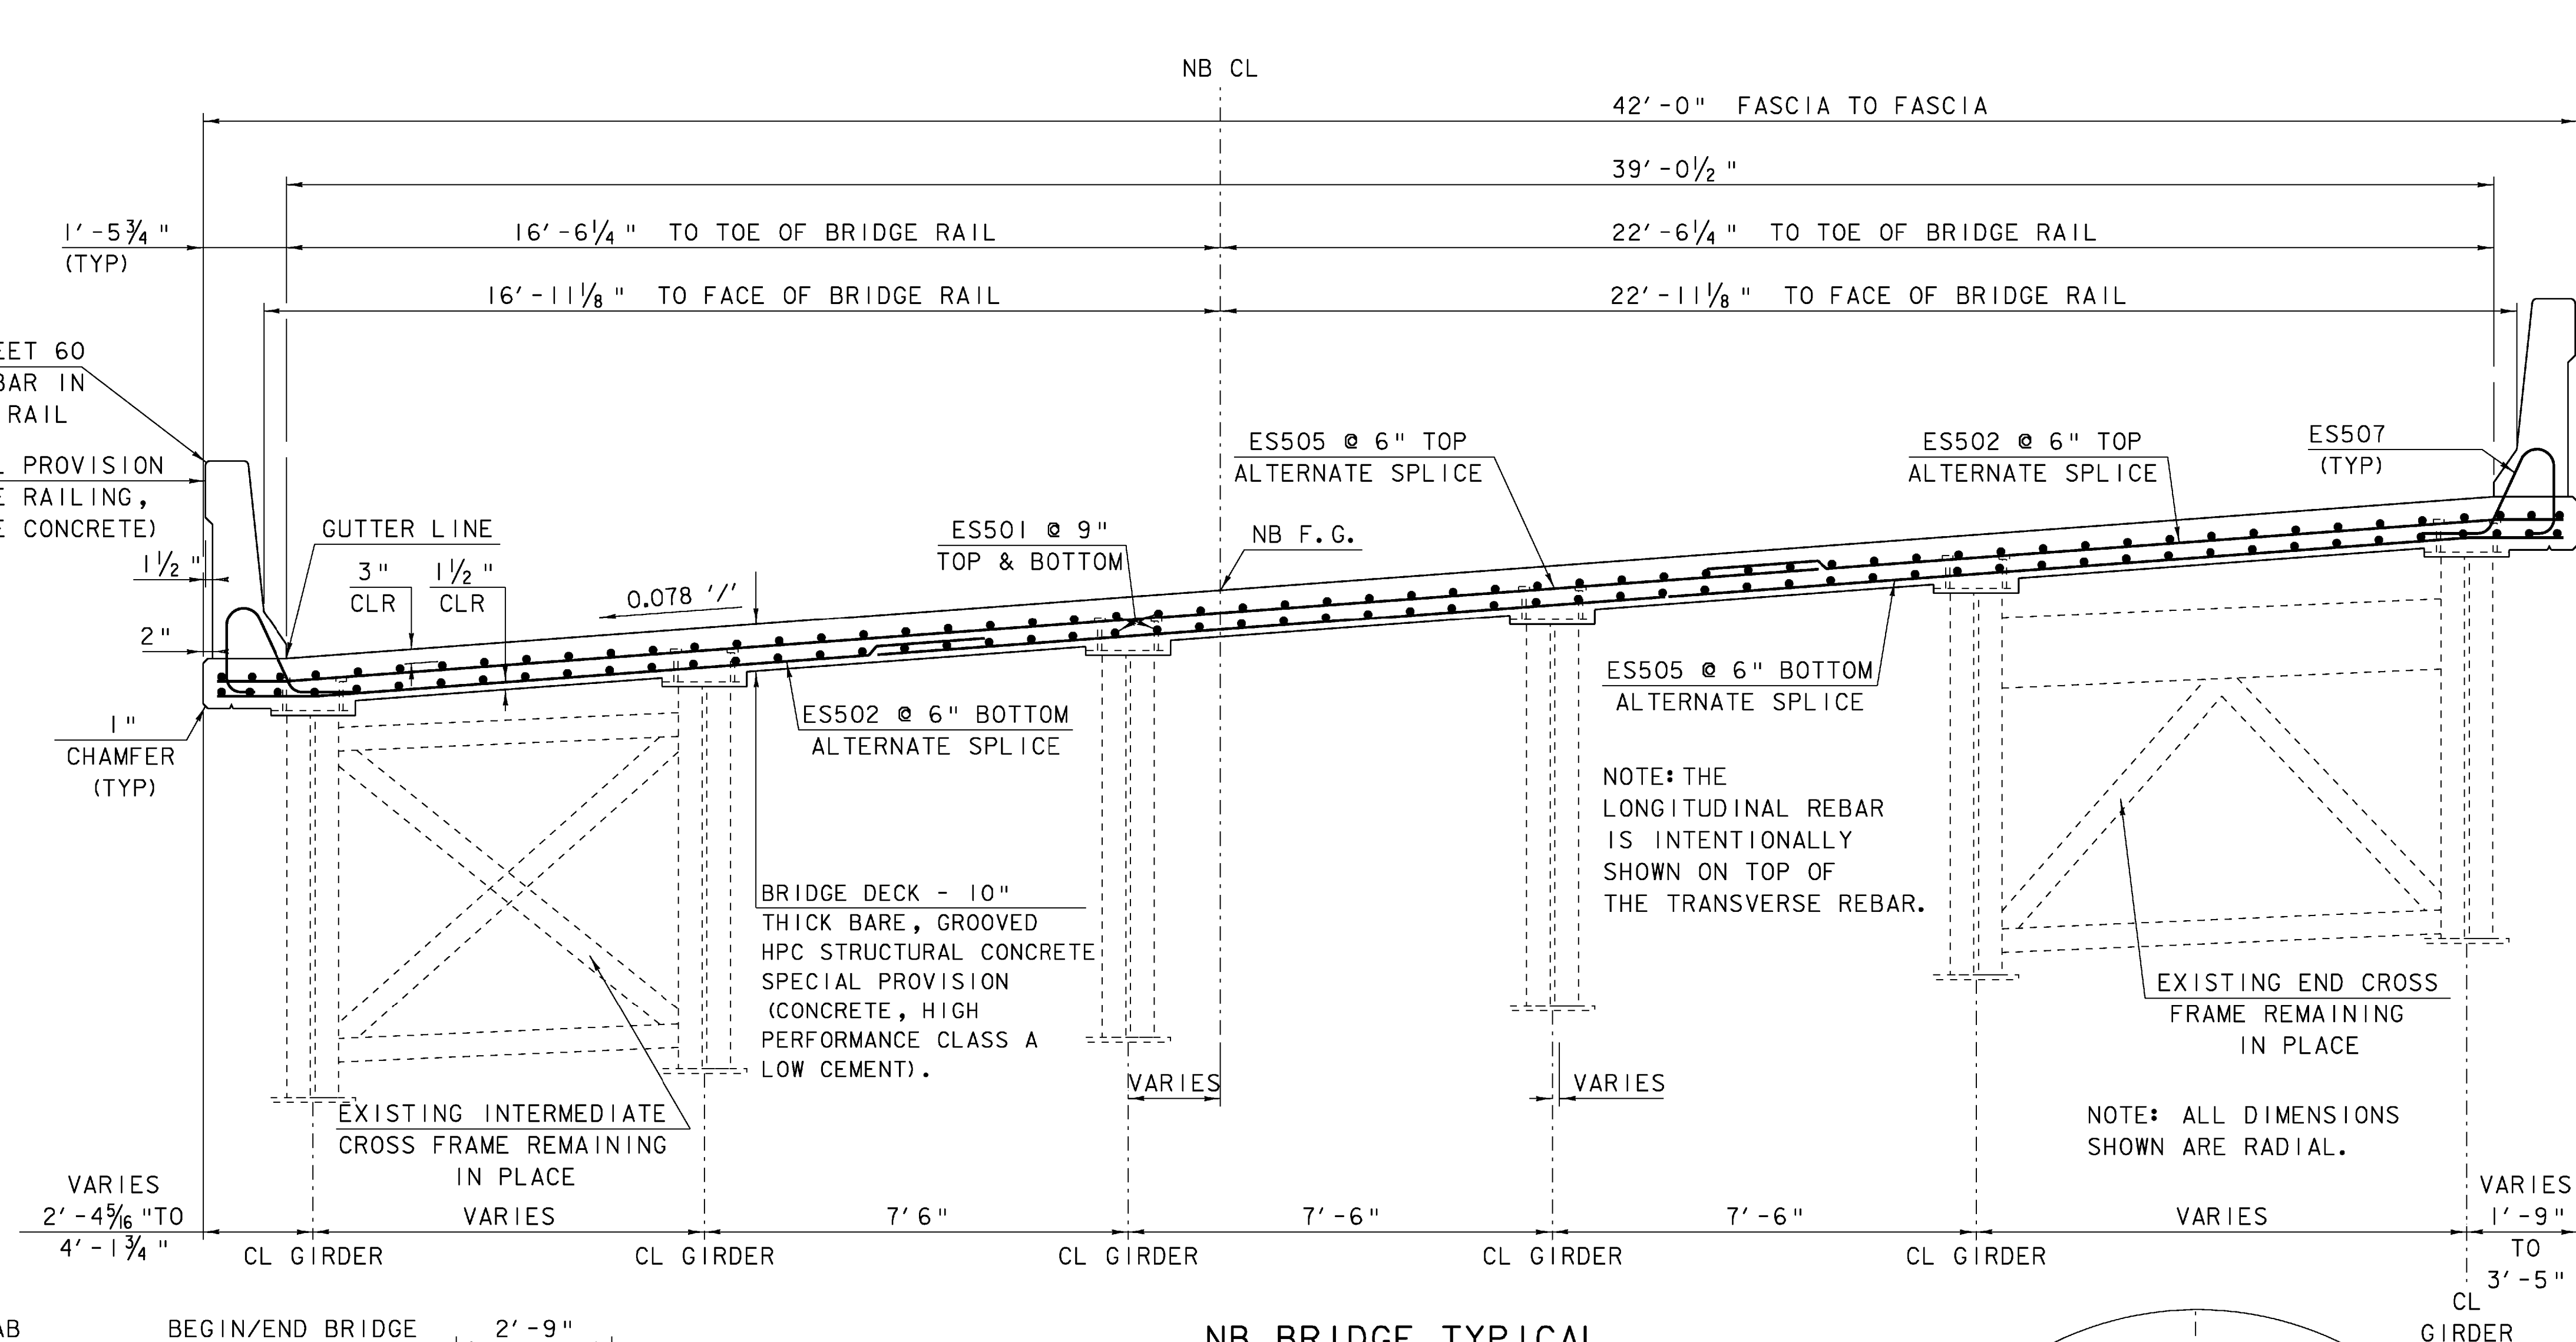


**NB BRIDGE TYPICAL**

SCALE: 1/2" = 1'-0"

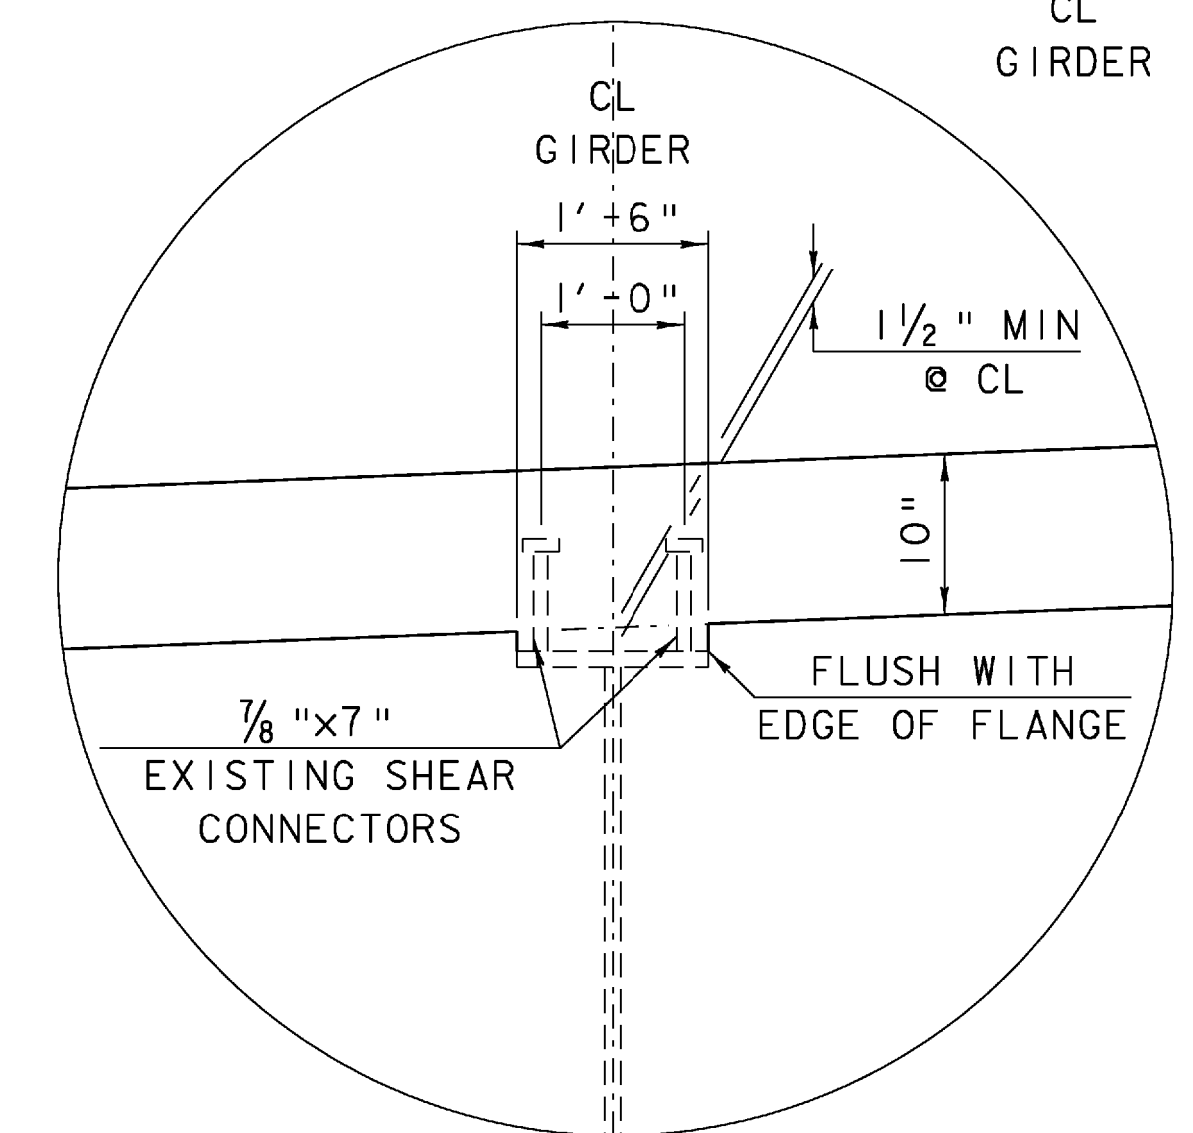


**HAUNCH DETAIL**

NTS  
SEE NOTE 4 ON SHEET 10

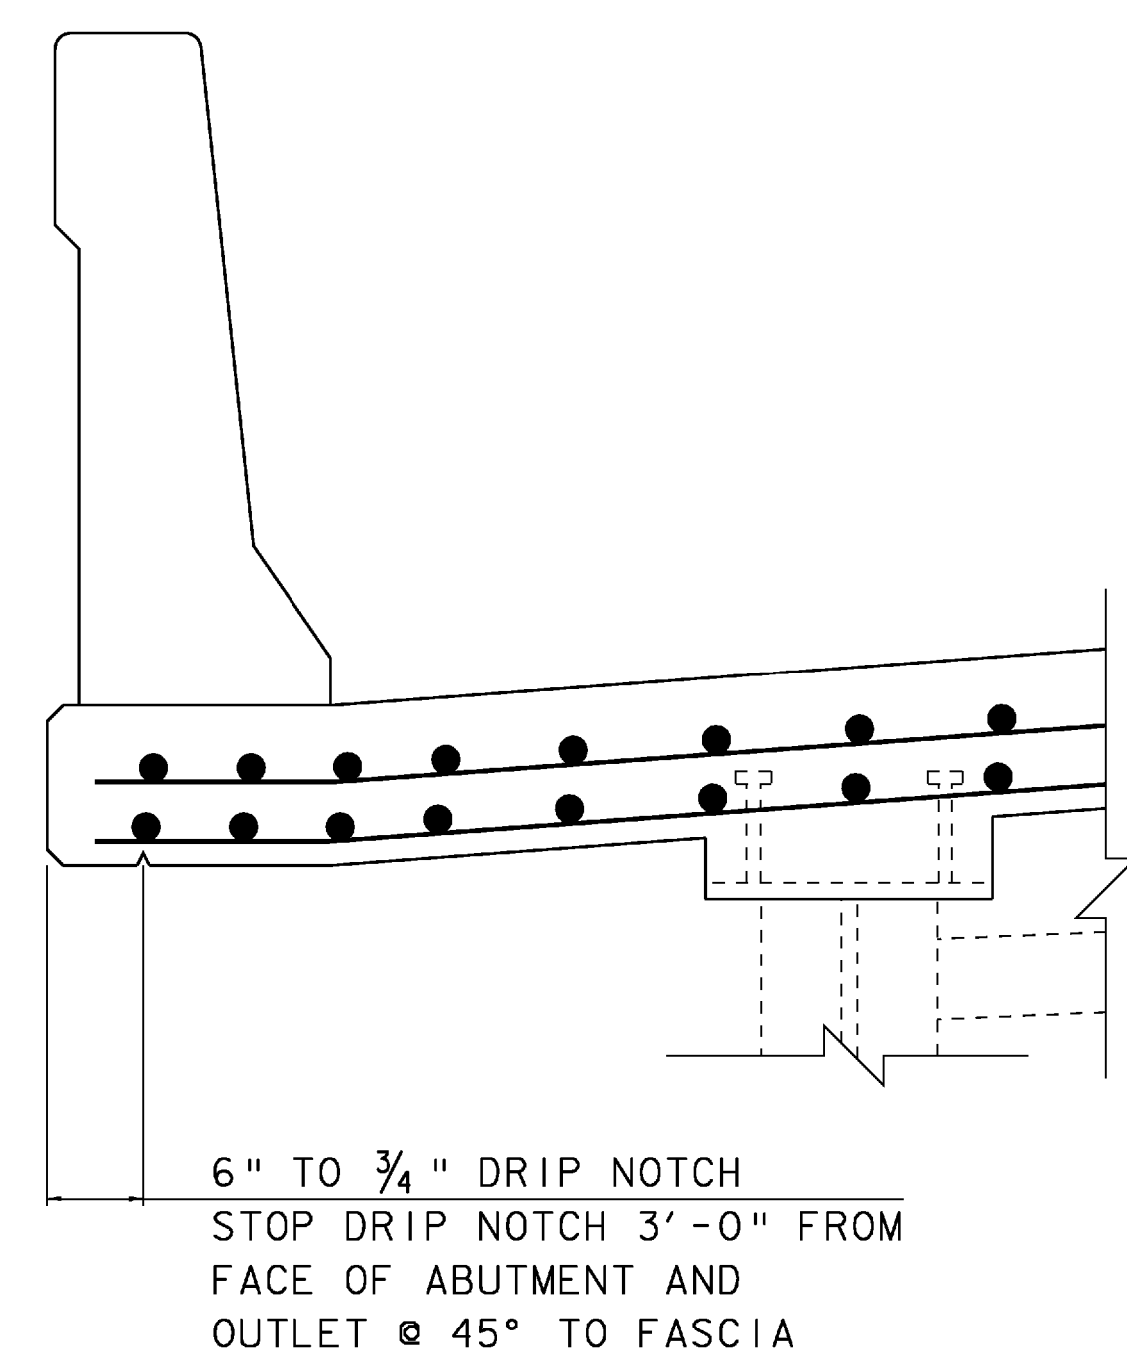

**DRIP NOTCH DETAIL**


SCALE: 1"=2'-0"

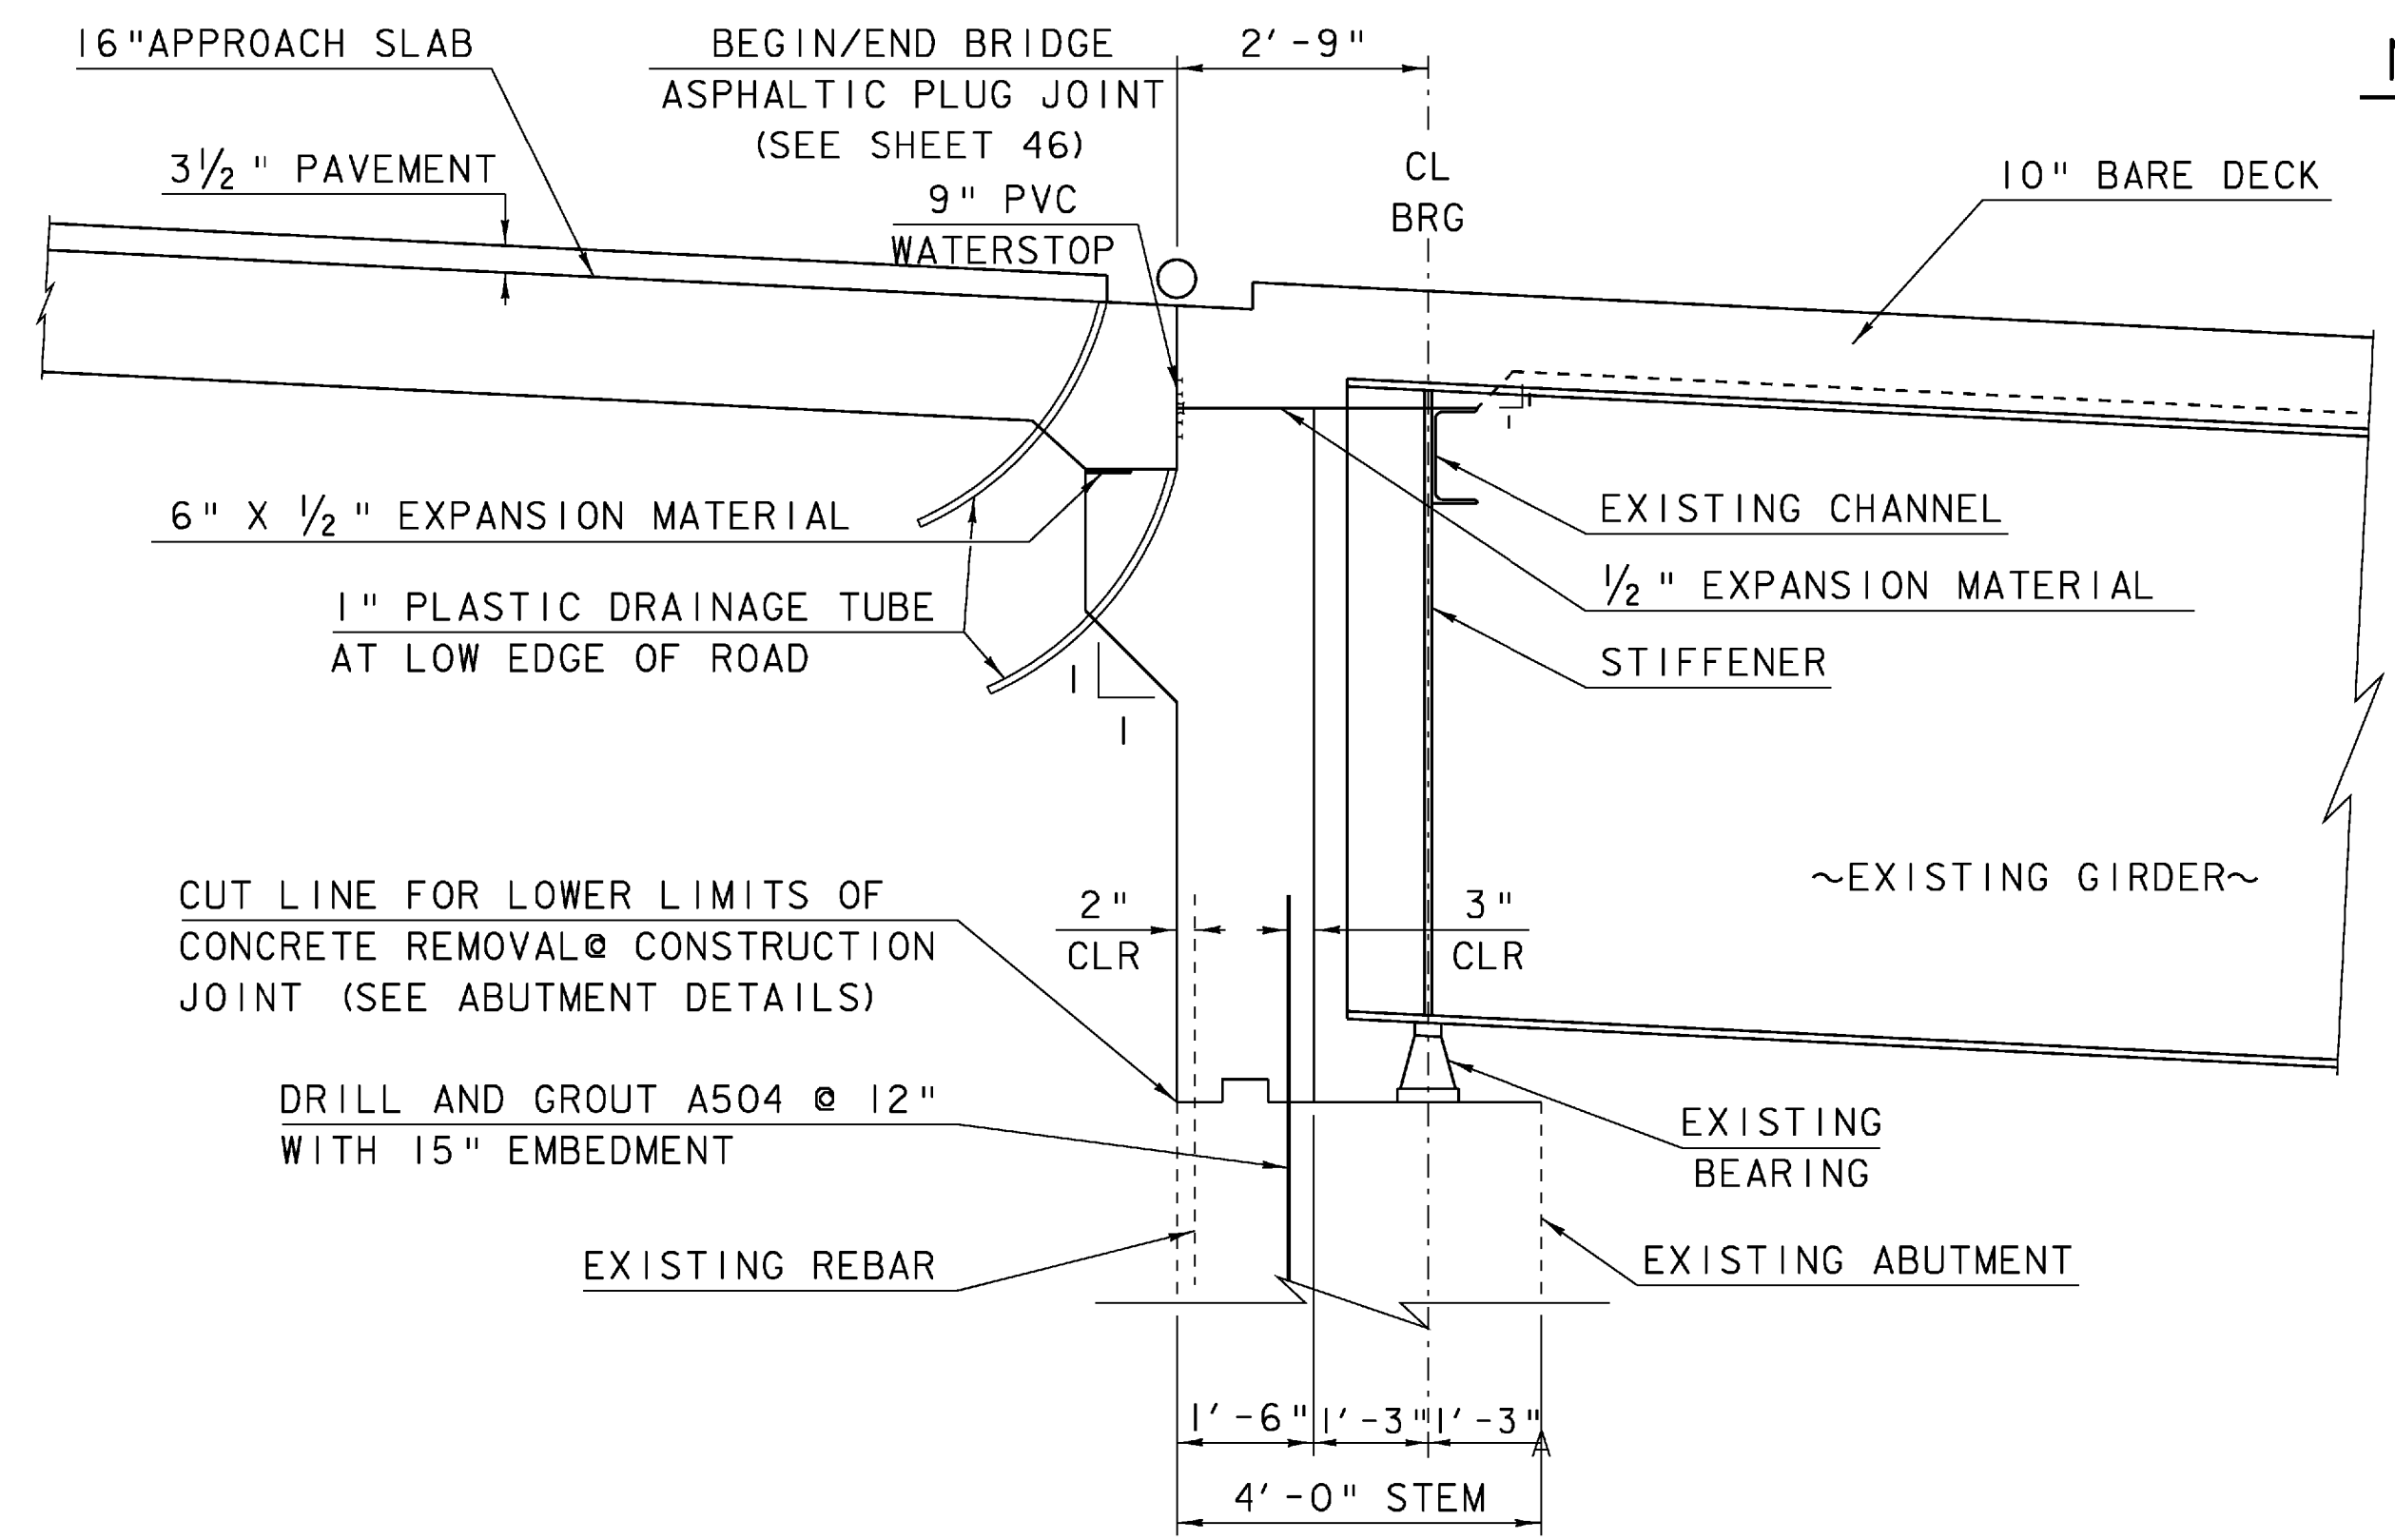







**END OF BRIDGE DETAIL**

SCALE: 1"=2'-0"

NOTE:  
1/2" EXPANSION MATERIAL, PVC WATERSTOP, PLASTIC DRAINAGE TUBE, AND BOND BREAKER SHALL BE INCIDENTAL TO ITEM #501.34 "CONCRETE, HIGH PERFORMANCE CLASS B".

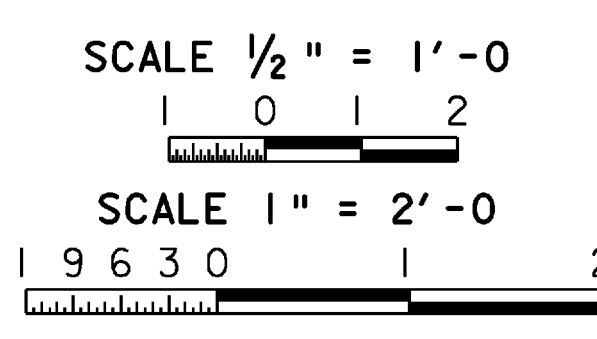


PROJECT:	BERLIN	PROJECT NO.:	IM 089-1 (20)
DESIGN FILE NAME:	99a270\structures\99a270typ.dgn		
IPARM FILE NAME:	s00a270br idgetyp. iPLOT DATE: 05-DEC-2007		
DESIGNED BY:	G. SPILAK	DRAWN BY:	R. PELLETT
SQUAD LEADER:	C. P. WILLIAMS	CHECKED BY:	R. S. YOUNG
BRIDGE TYPICAL SECTION		SHEET:	43 OF 104

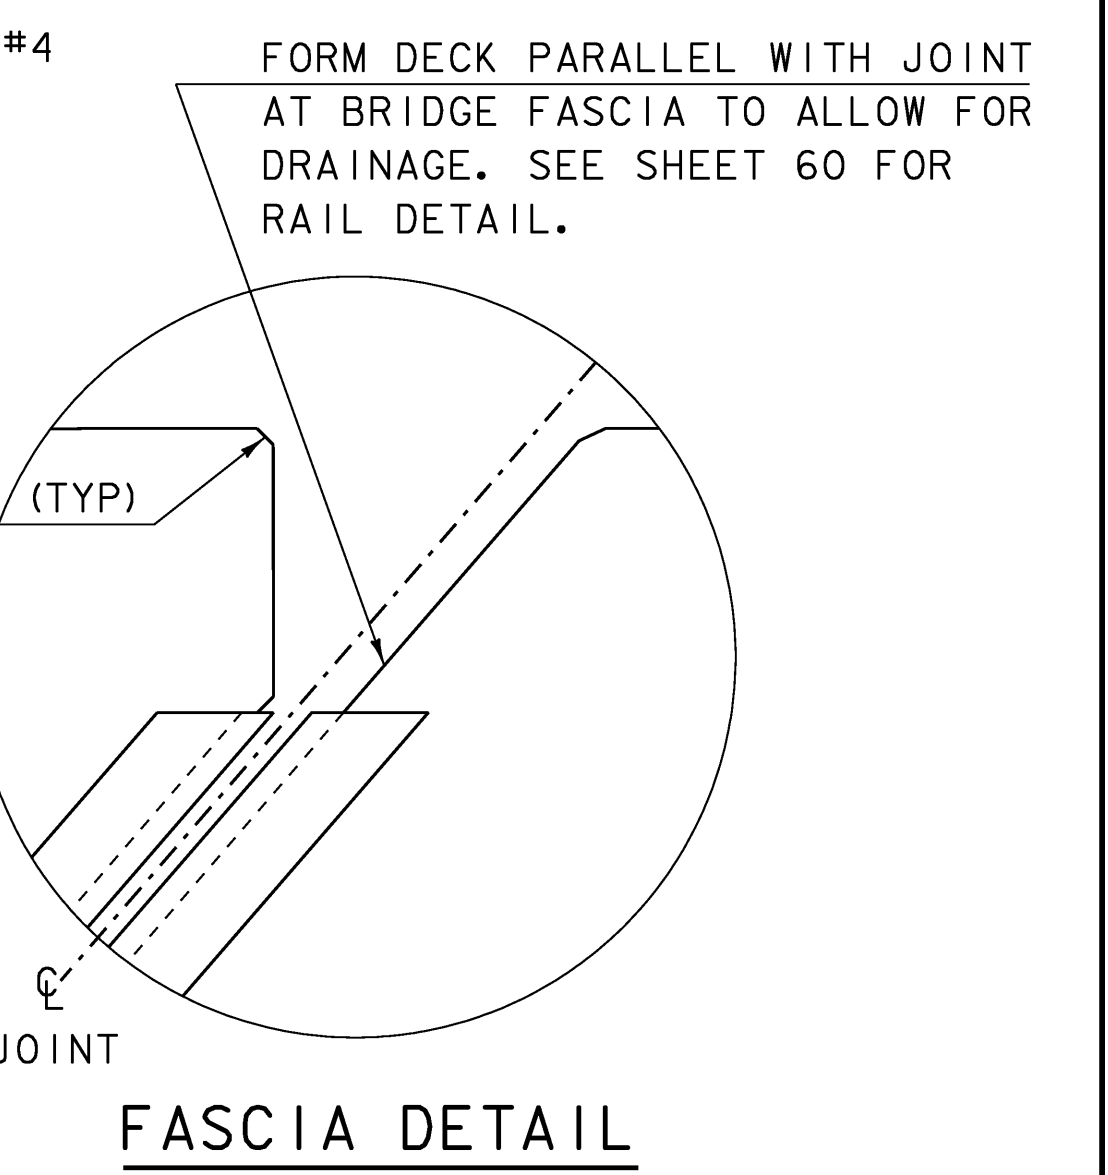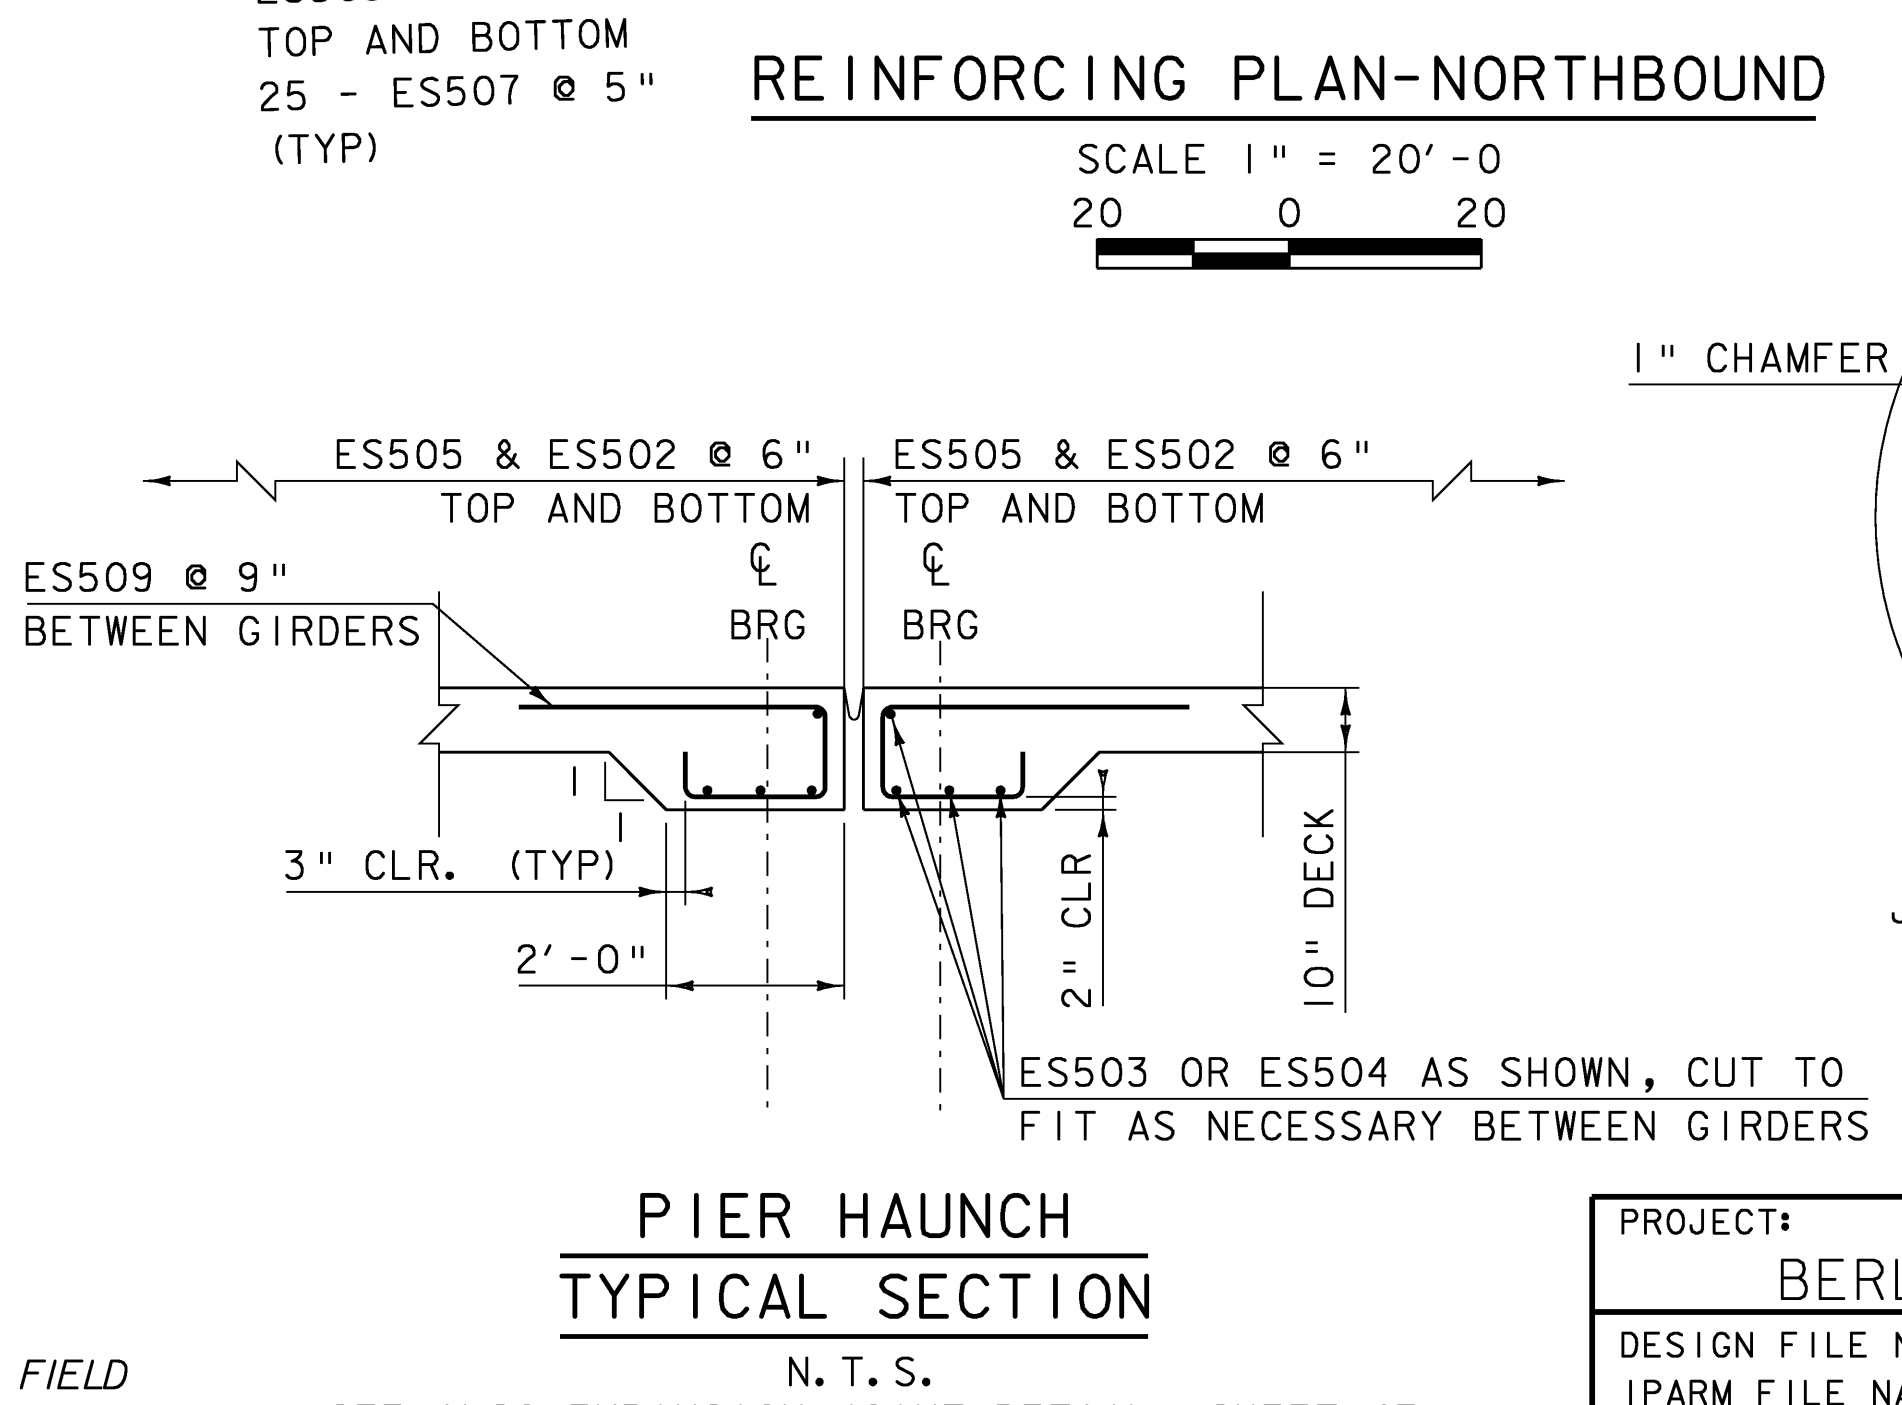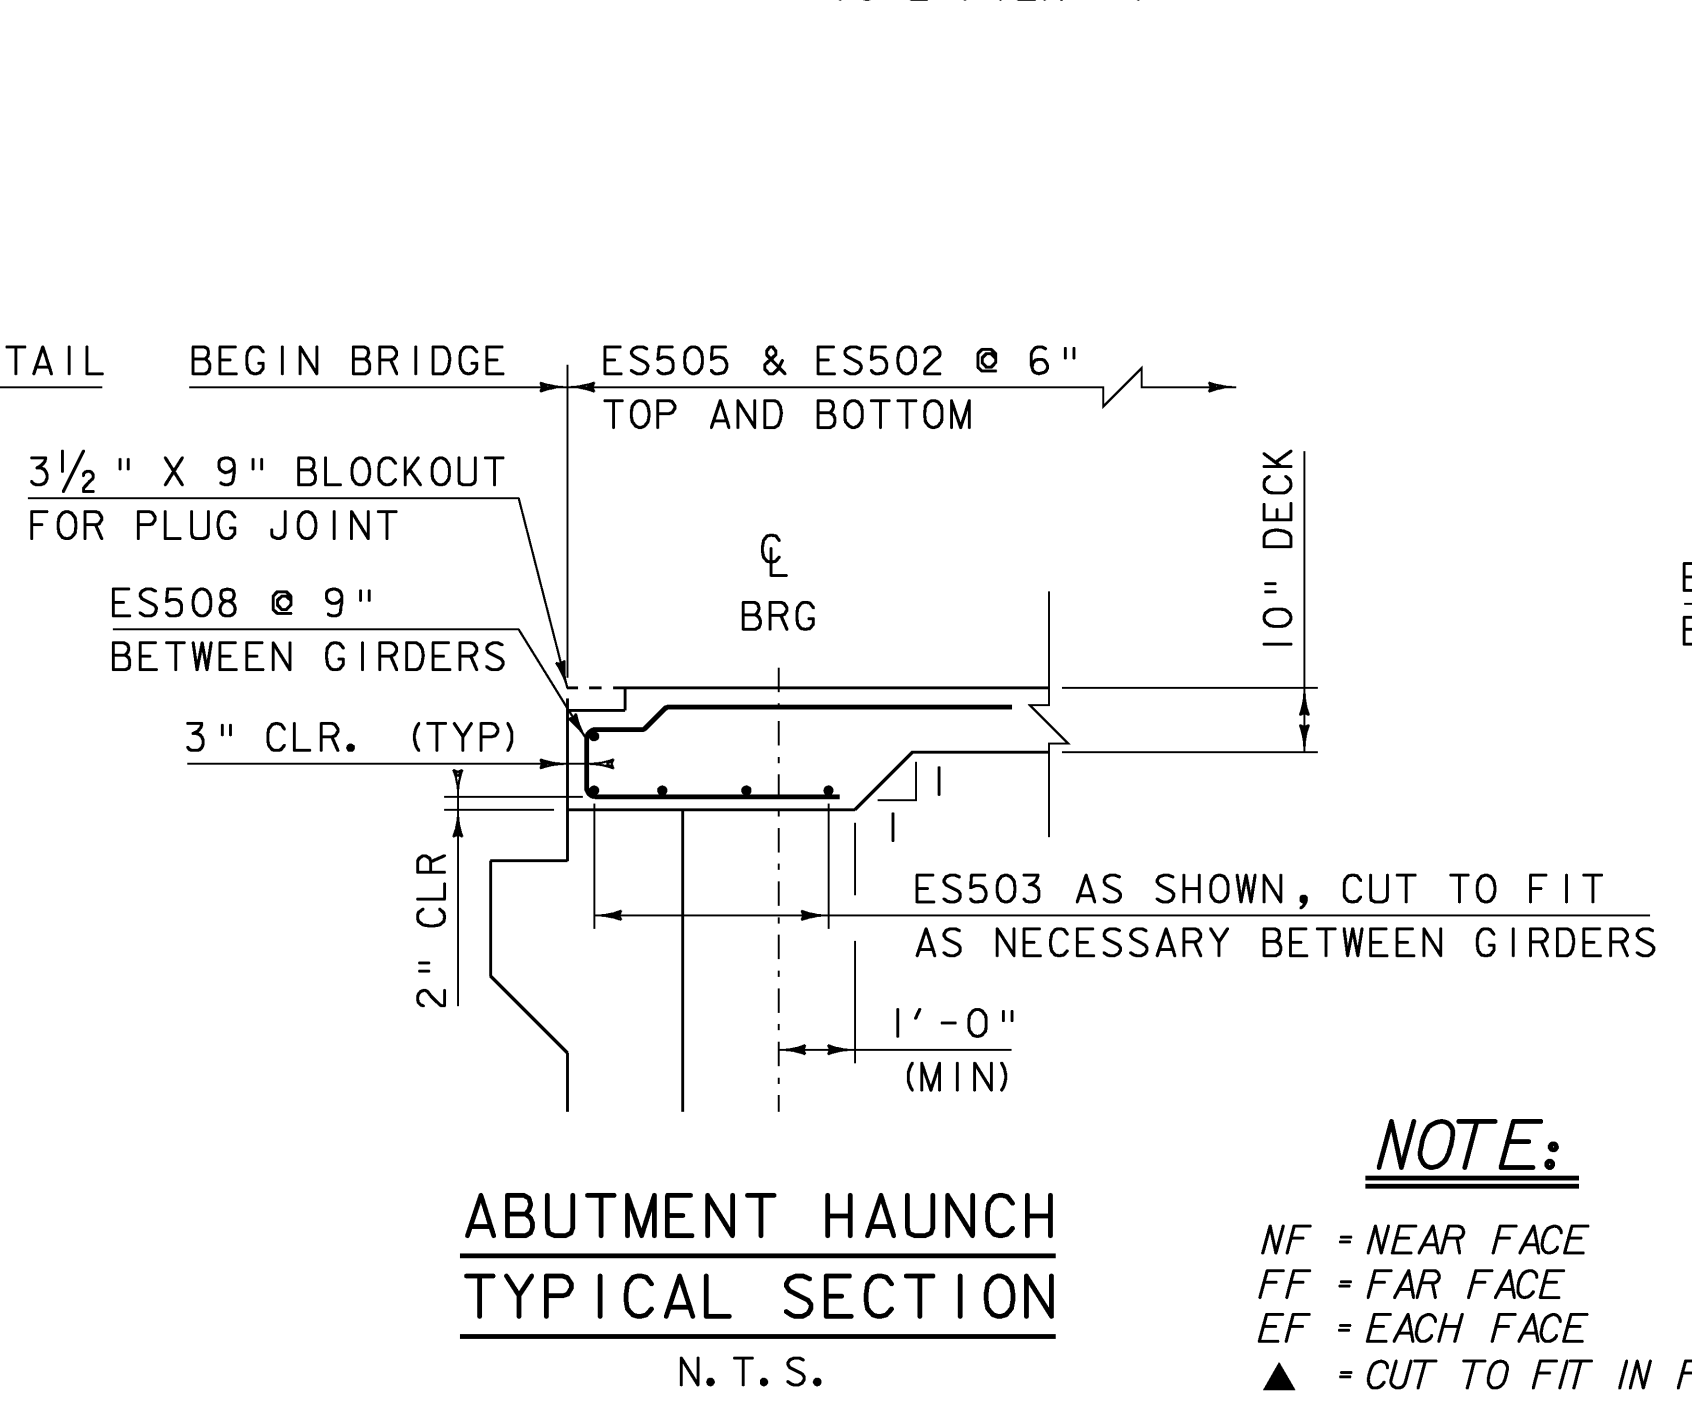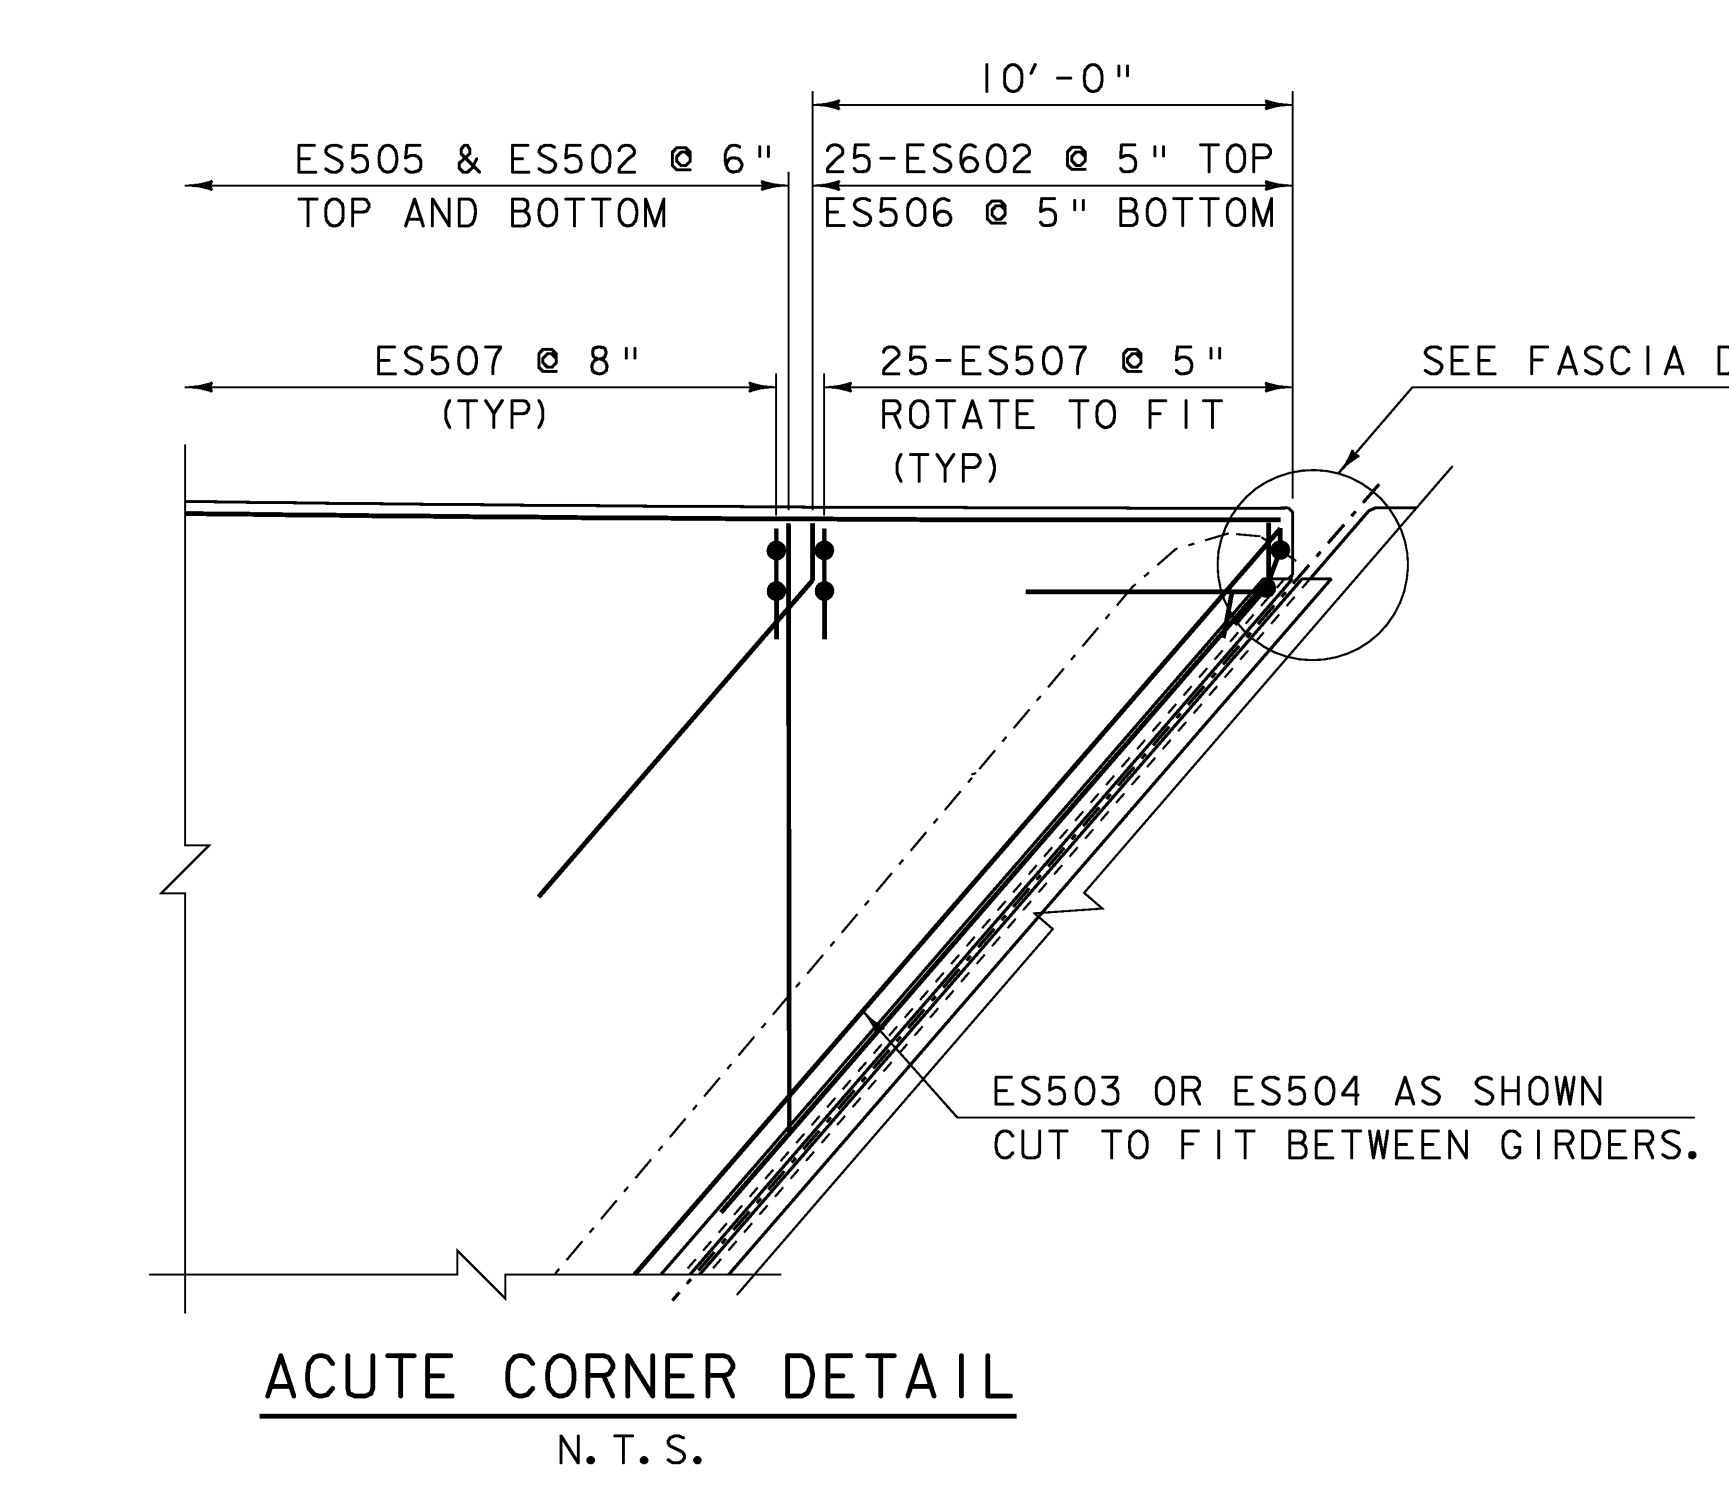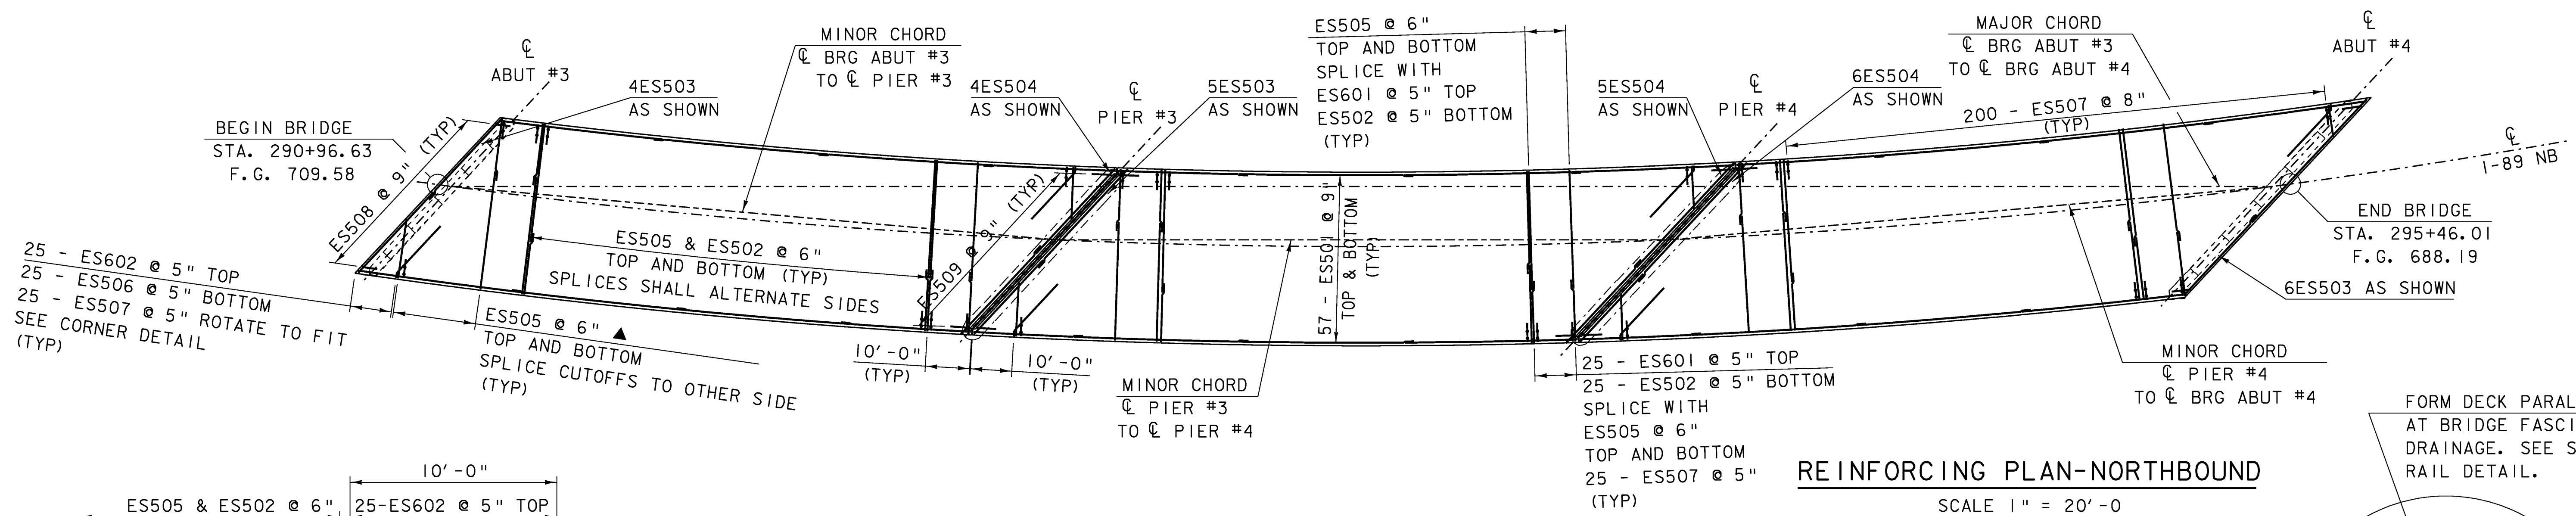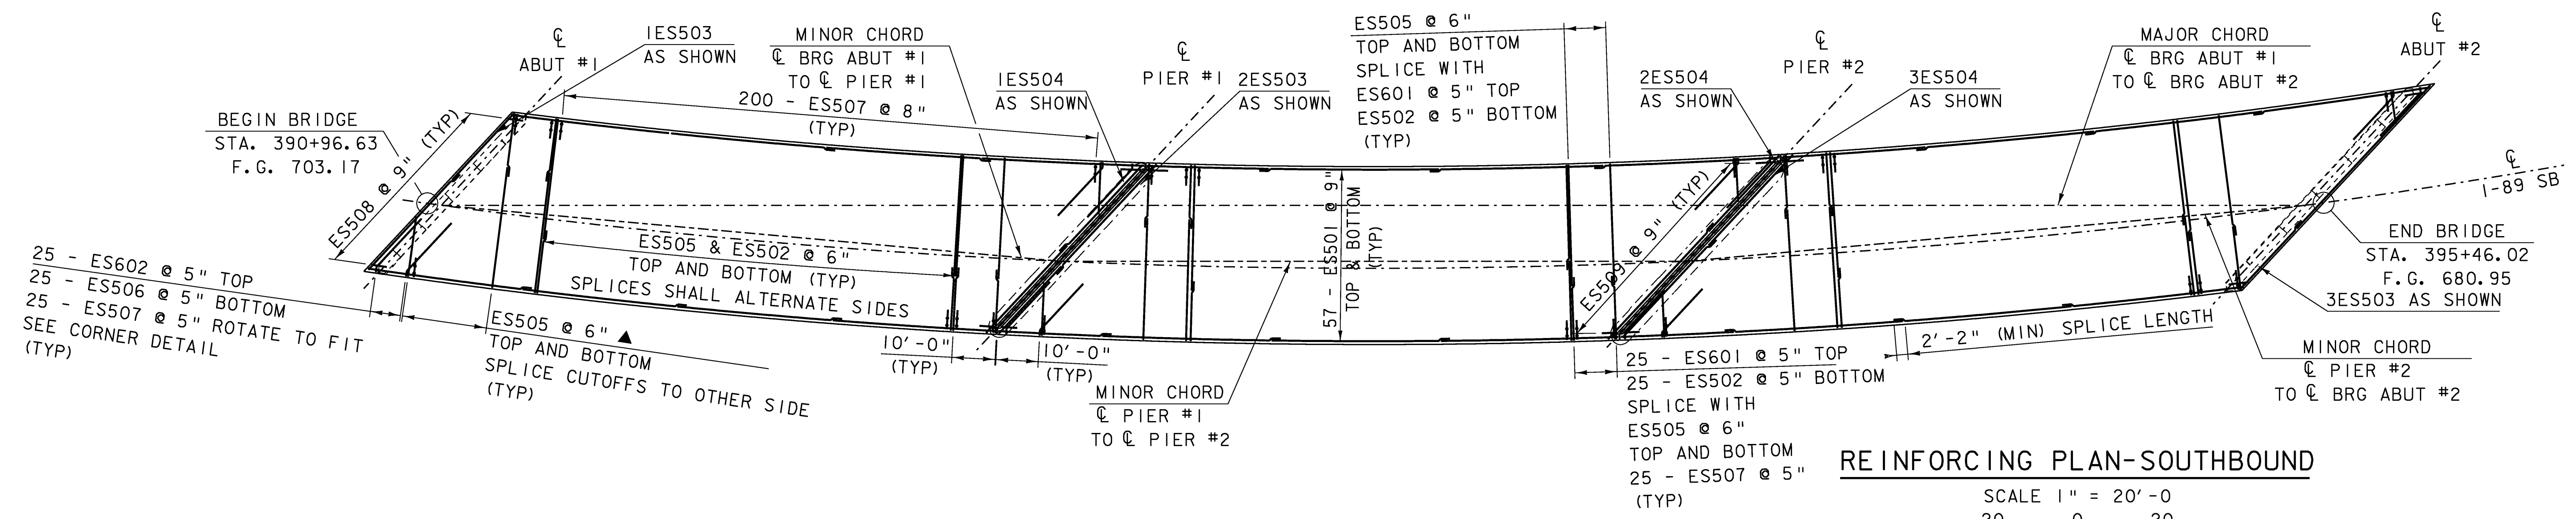


**NOTE:**  
NF = NEAR FACE  
FF = FAR FACE  
EF = EACH FACE  
▲ = CUT TO FIT IN FIELD  
3" CLR. UNLESS OTHERWISE SPECIFIED ON THE PLANS.

SEE ALSO EXPANSION JOINT DETAIL, SHEET 47

PROJECT: <b>BERLIN</b>	PROJECT NO.: <b>IM 089-1 (20)</b>
DESIGN FILE NAME: 99a270/structures/99a270deck.dgn	PLOT DATE: 05-DEC-2007
IPARM FILE NAME: 99a270deck.i	DRAWN BY: C. MOONEY
DESIGNED BY: G. SPILAK	CHECKED BY: R. S. YOUNG
SQUAD LEADER: C. P. WILLIAMS	SHEET: 44 OF 104
DECK REINFORCING PLAN	

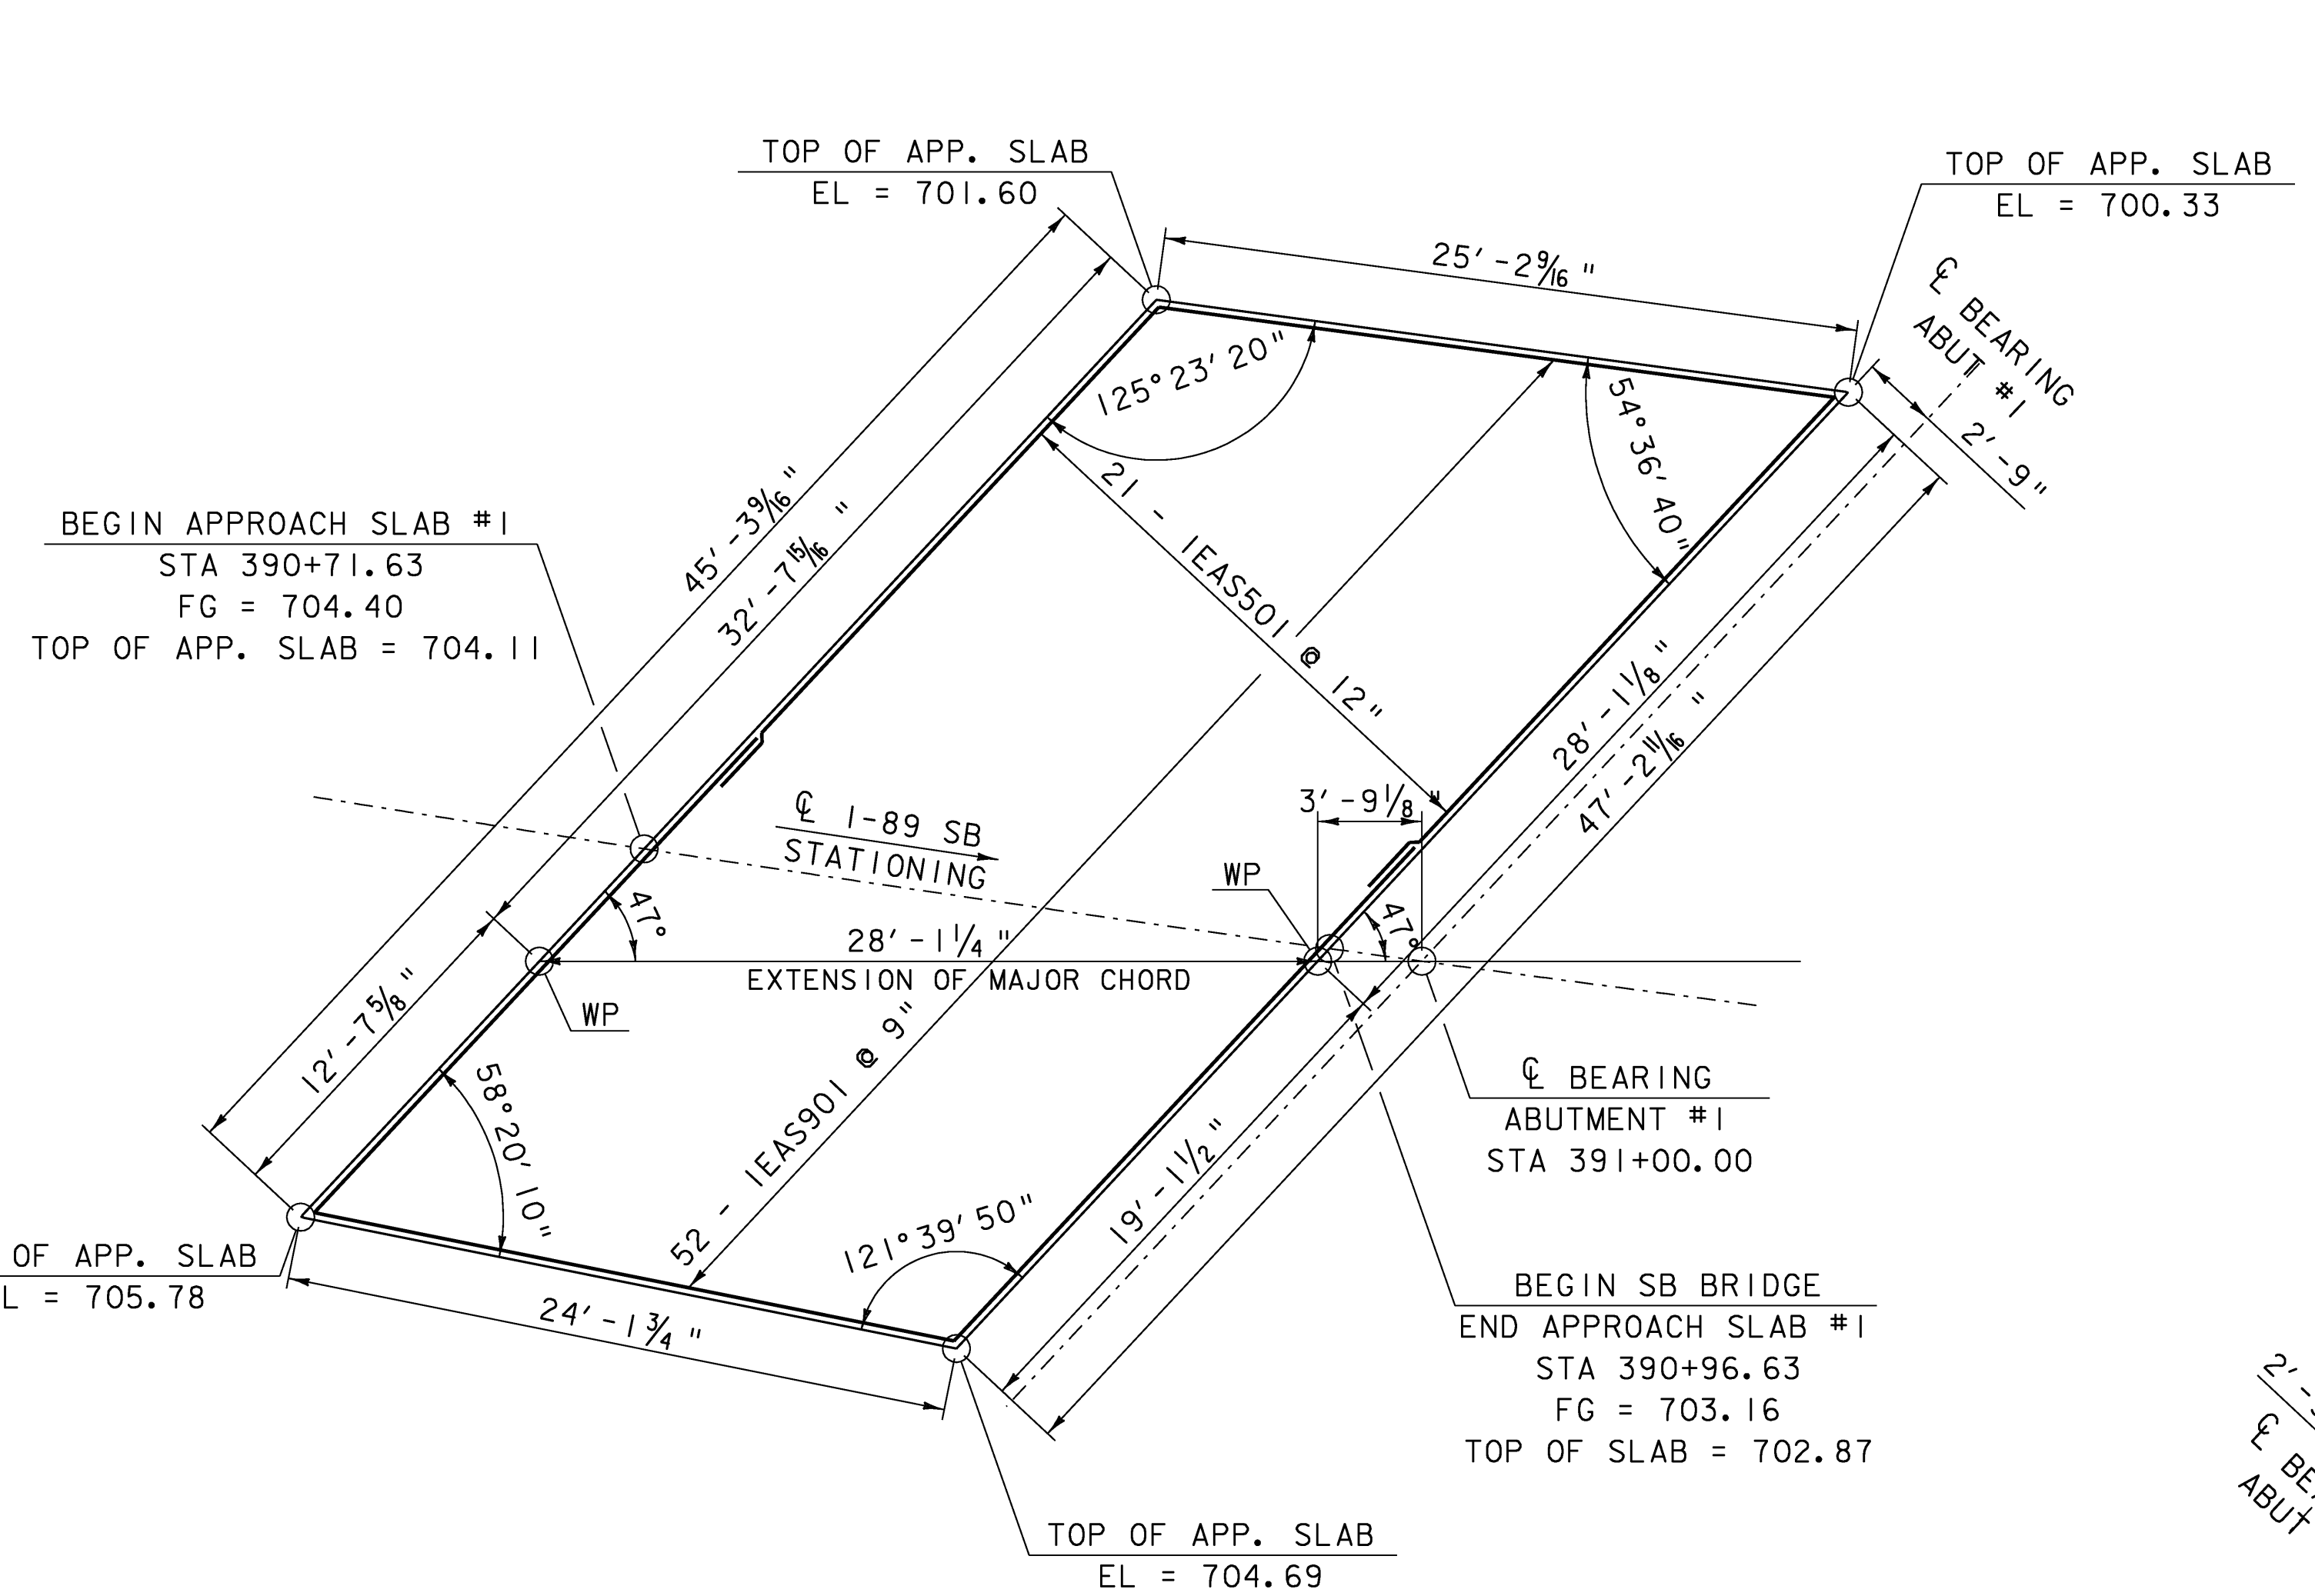


**PLAN VIEW  
APPROACH SLAB #1**  
SCALE 3/16" = 1'-0"

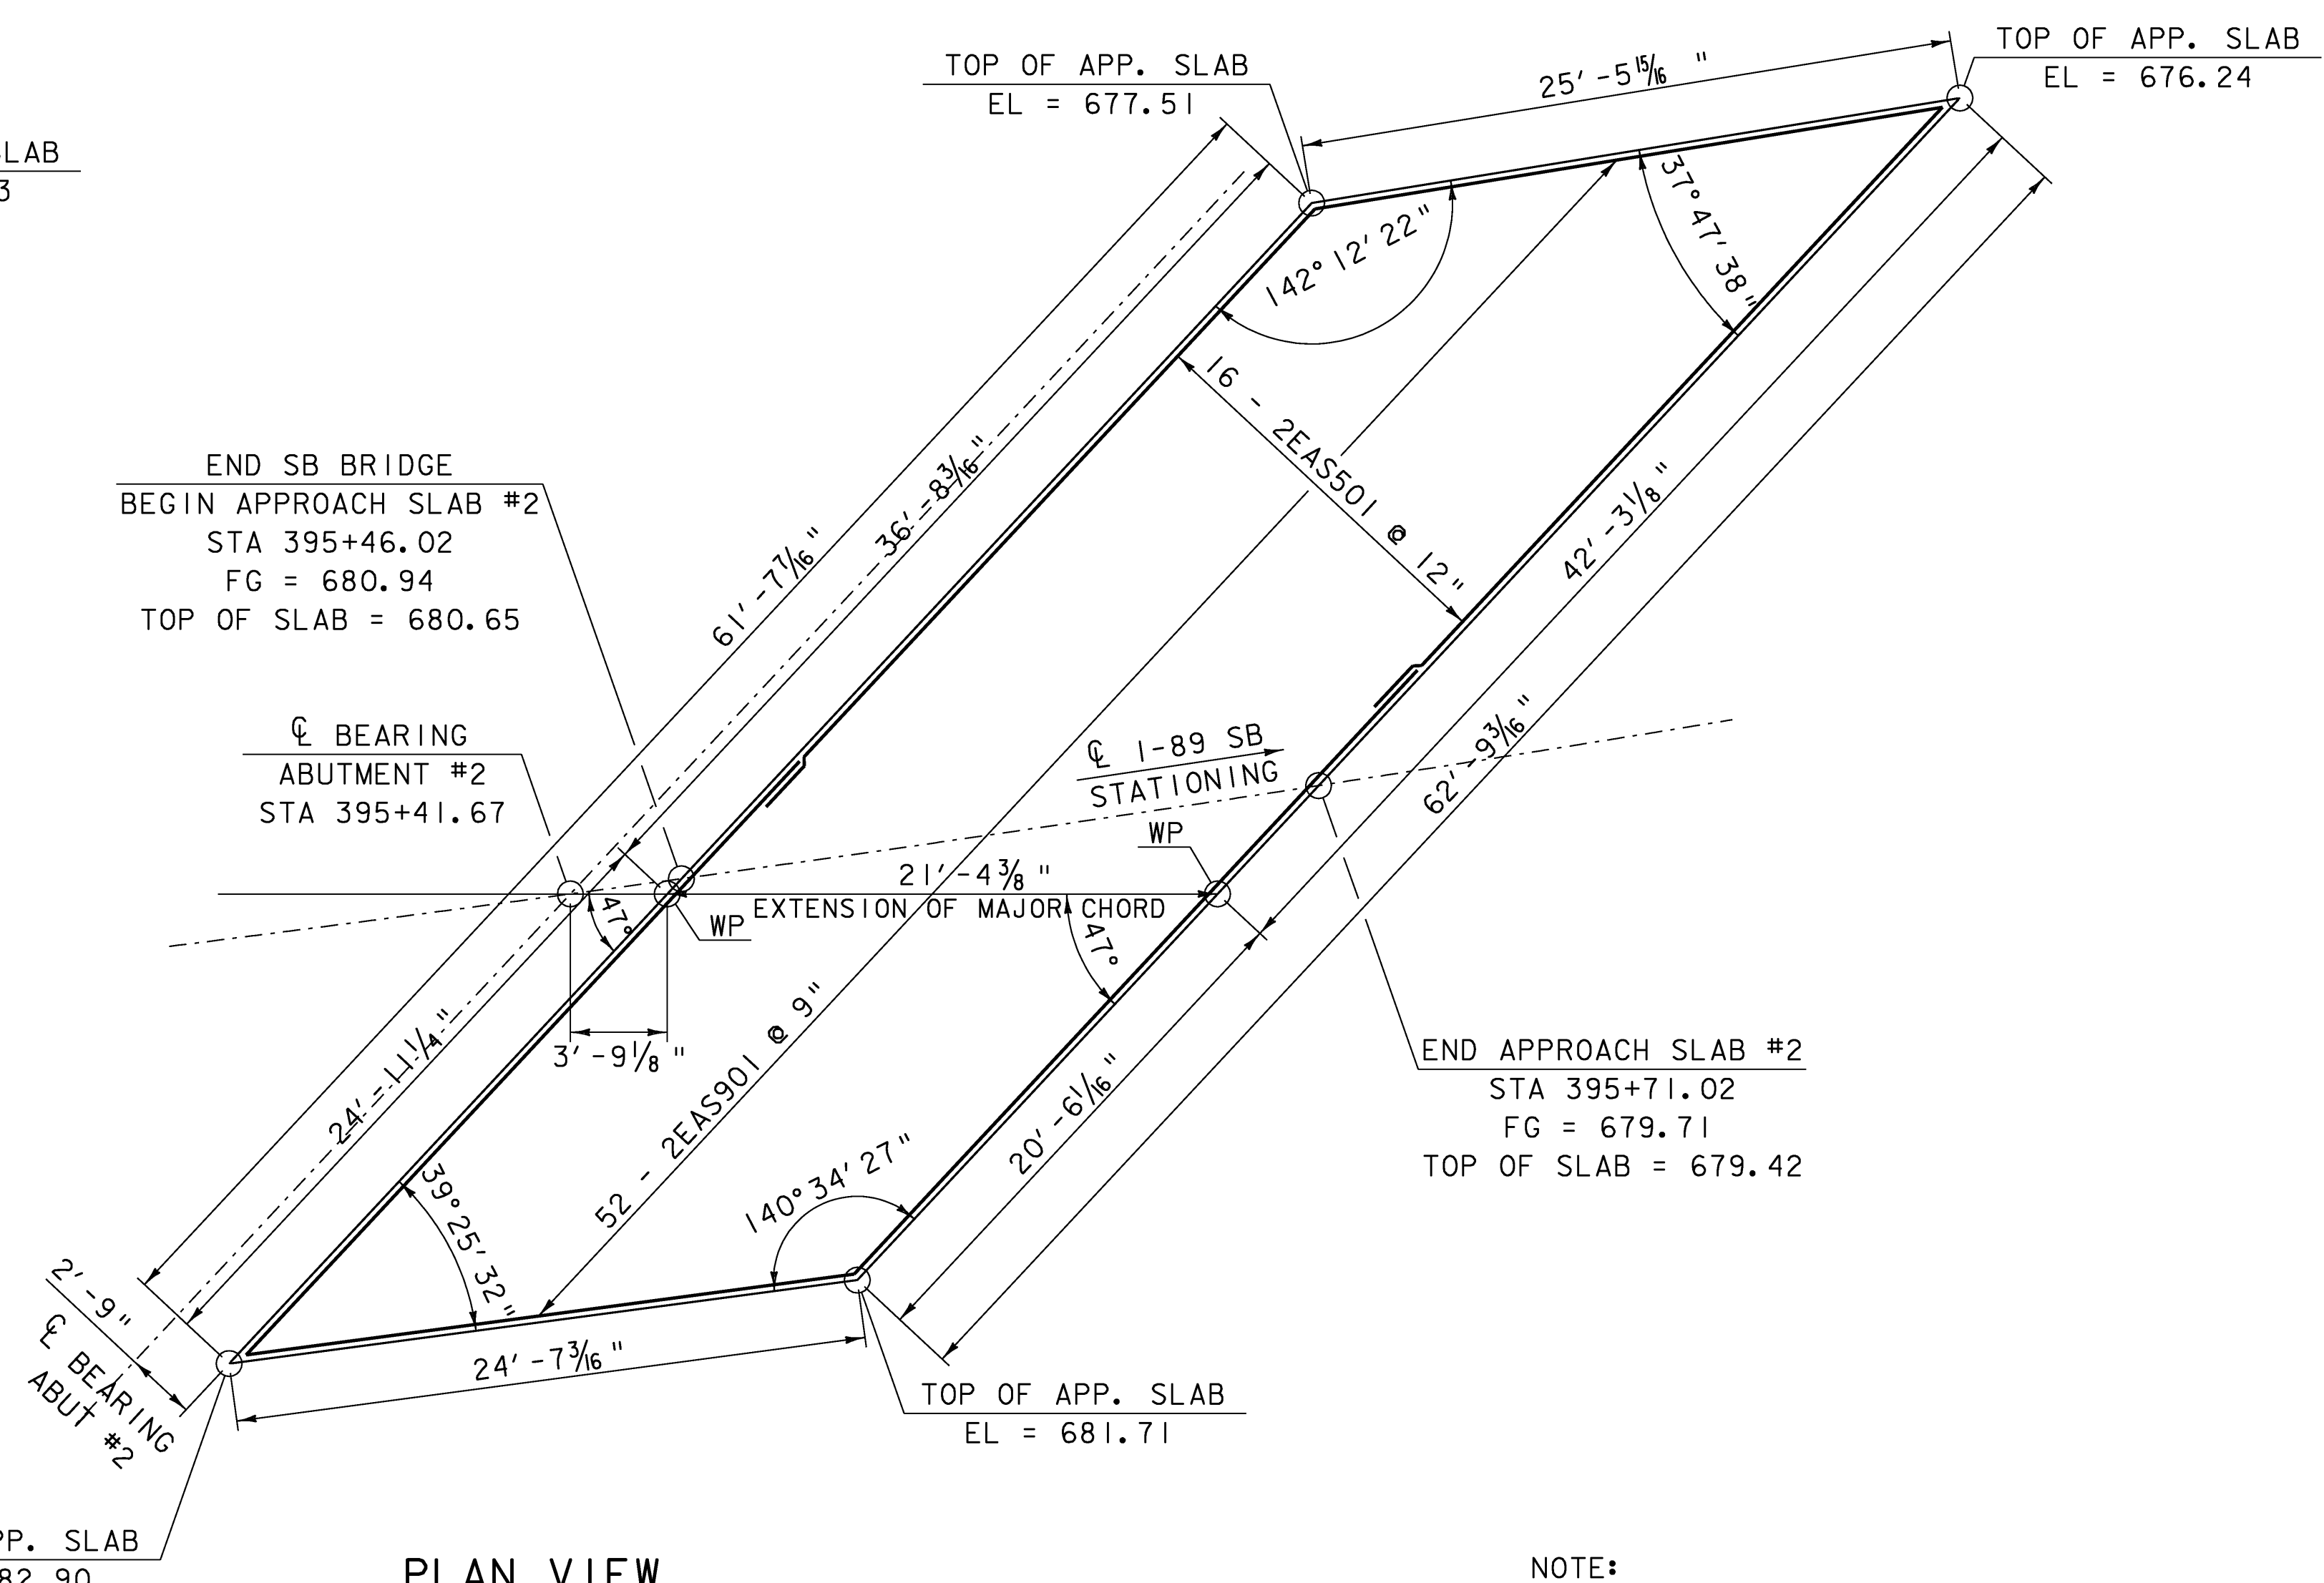


**PLAN VIEW  
APPROACH SLAB #2**  
SCALE 3/16" = 1'-0"

NOTE:  
1/2" EXPANSION MATERIAL, PVC WATERSTOP,  
PLASTIC DRAINAGE TUBE, AND BOND BREAKER  
SHALL BE INCIDENTAL TO ITEM #501.34  
"CONCRETE, HIGH PERFORMANCE CLASS B".

NOTES:  
NF = NEAR FACE  
FF = FAR FACE  
EF = EACH FACE  
▲ = CUT TO FIT IN FIELD  
  
3" CLR. UNLESS OTHERWISE  
SPECIFIED ON THE PLANS  
  
ALL LAPS ARE MIN. 2'-2" UNLESS  
OTHERWISE NOTED ON PLANS.  
  
ES901 BARS SHALL BE PLACED  
PARALLEL TO THE LONGEST SIDE

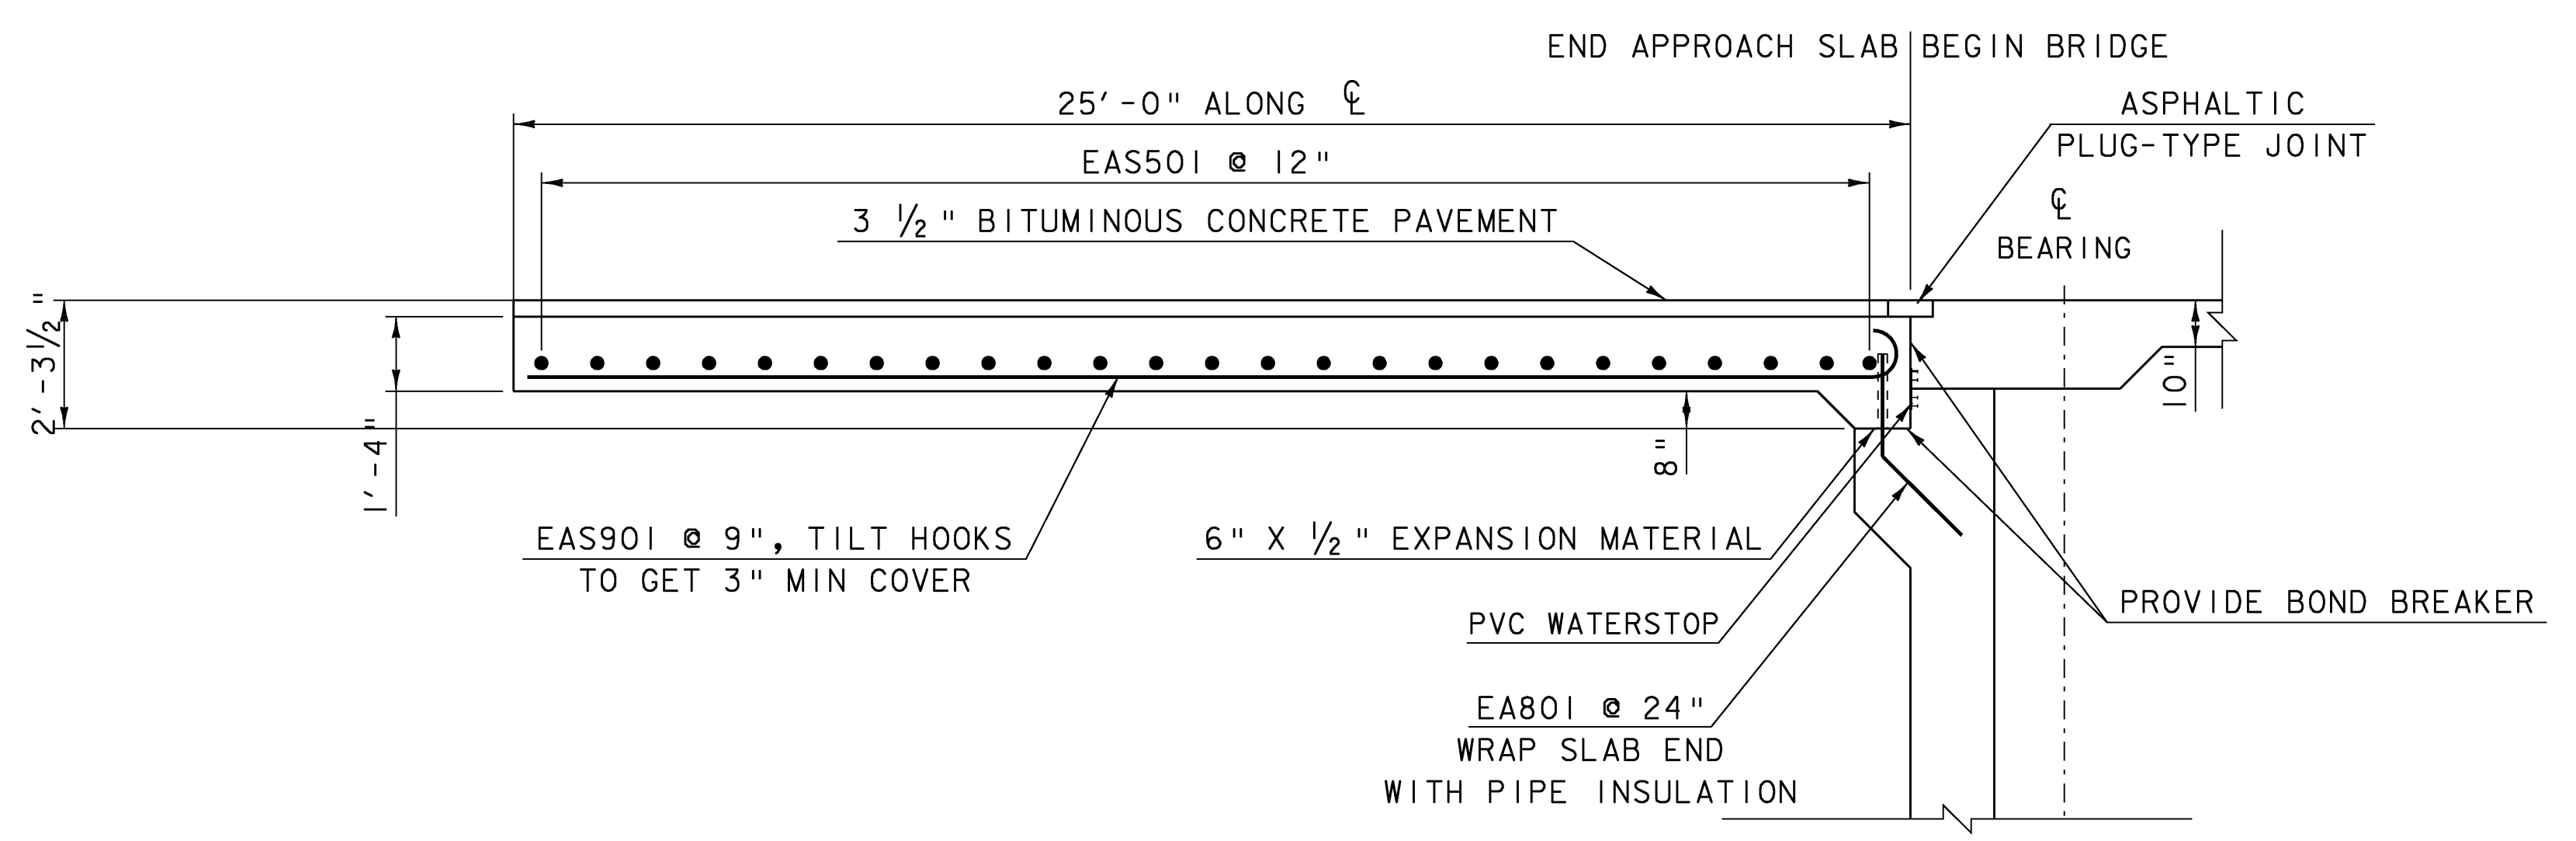




**APPROACH SLAB TYPICAL SECTION**  
SCALE 3/16" = 1'-0"

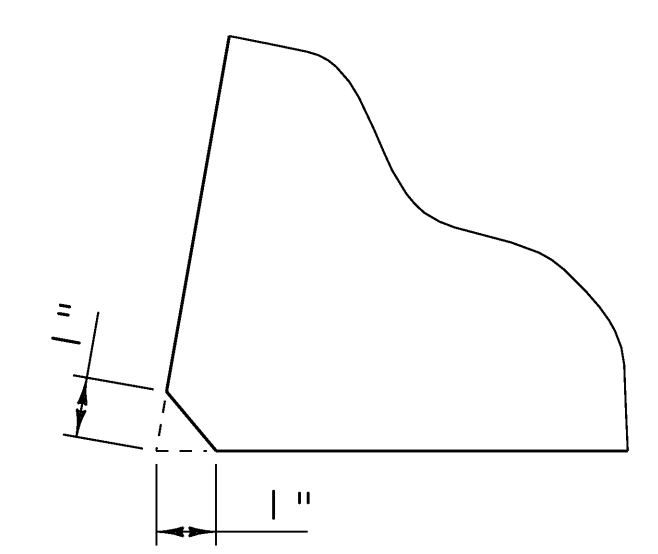

**ACUTE CORNER DETAIL**  
N. T. S.

SCALE 3/8" = 1'-0"      SCALE 3/16" = 1'-0"  
1 0 1 2 3 4      1 0 2 4 6 8

PROJECT: <b>BERLIN</b>	PROJECT NO.: <b>IM 089-1 (20)</b>
DESIGN FILE NAME: 99a270/structures/99a270aps.dgn	PLOT DATE: 05-DEC-2007
IPARM FILE NAME: 99a270apsSB.i	DRAWN BY: E.L. RUSTAY
DESIGNED BY: E.L. RUSTAY	CHECKED BY: R.S. YOUNG
SQUAD LEADER: C.P. WILLIAMS	SHEET: 45 OF 104
APPROACH SLAB #1 & #2 DETAILS	

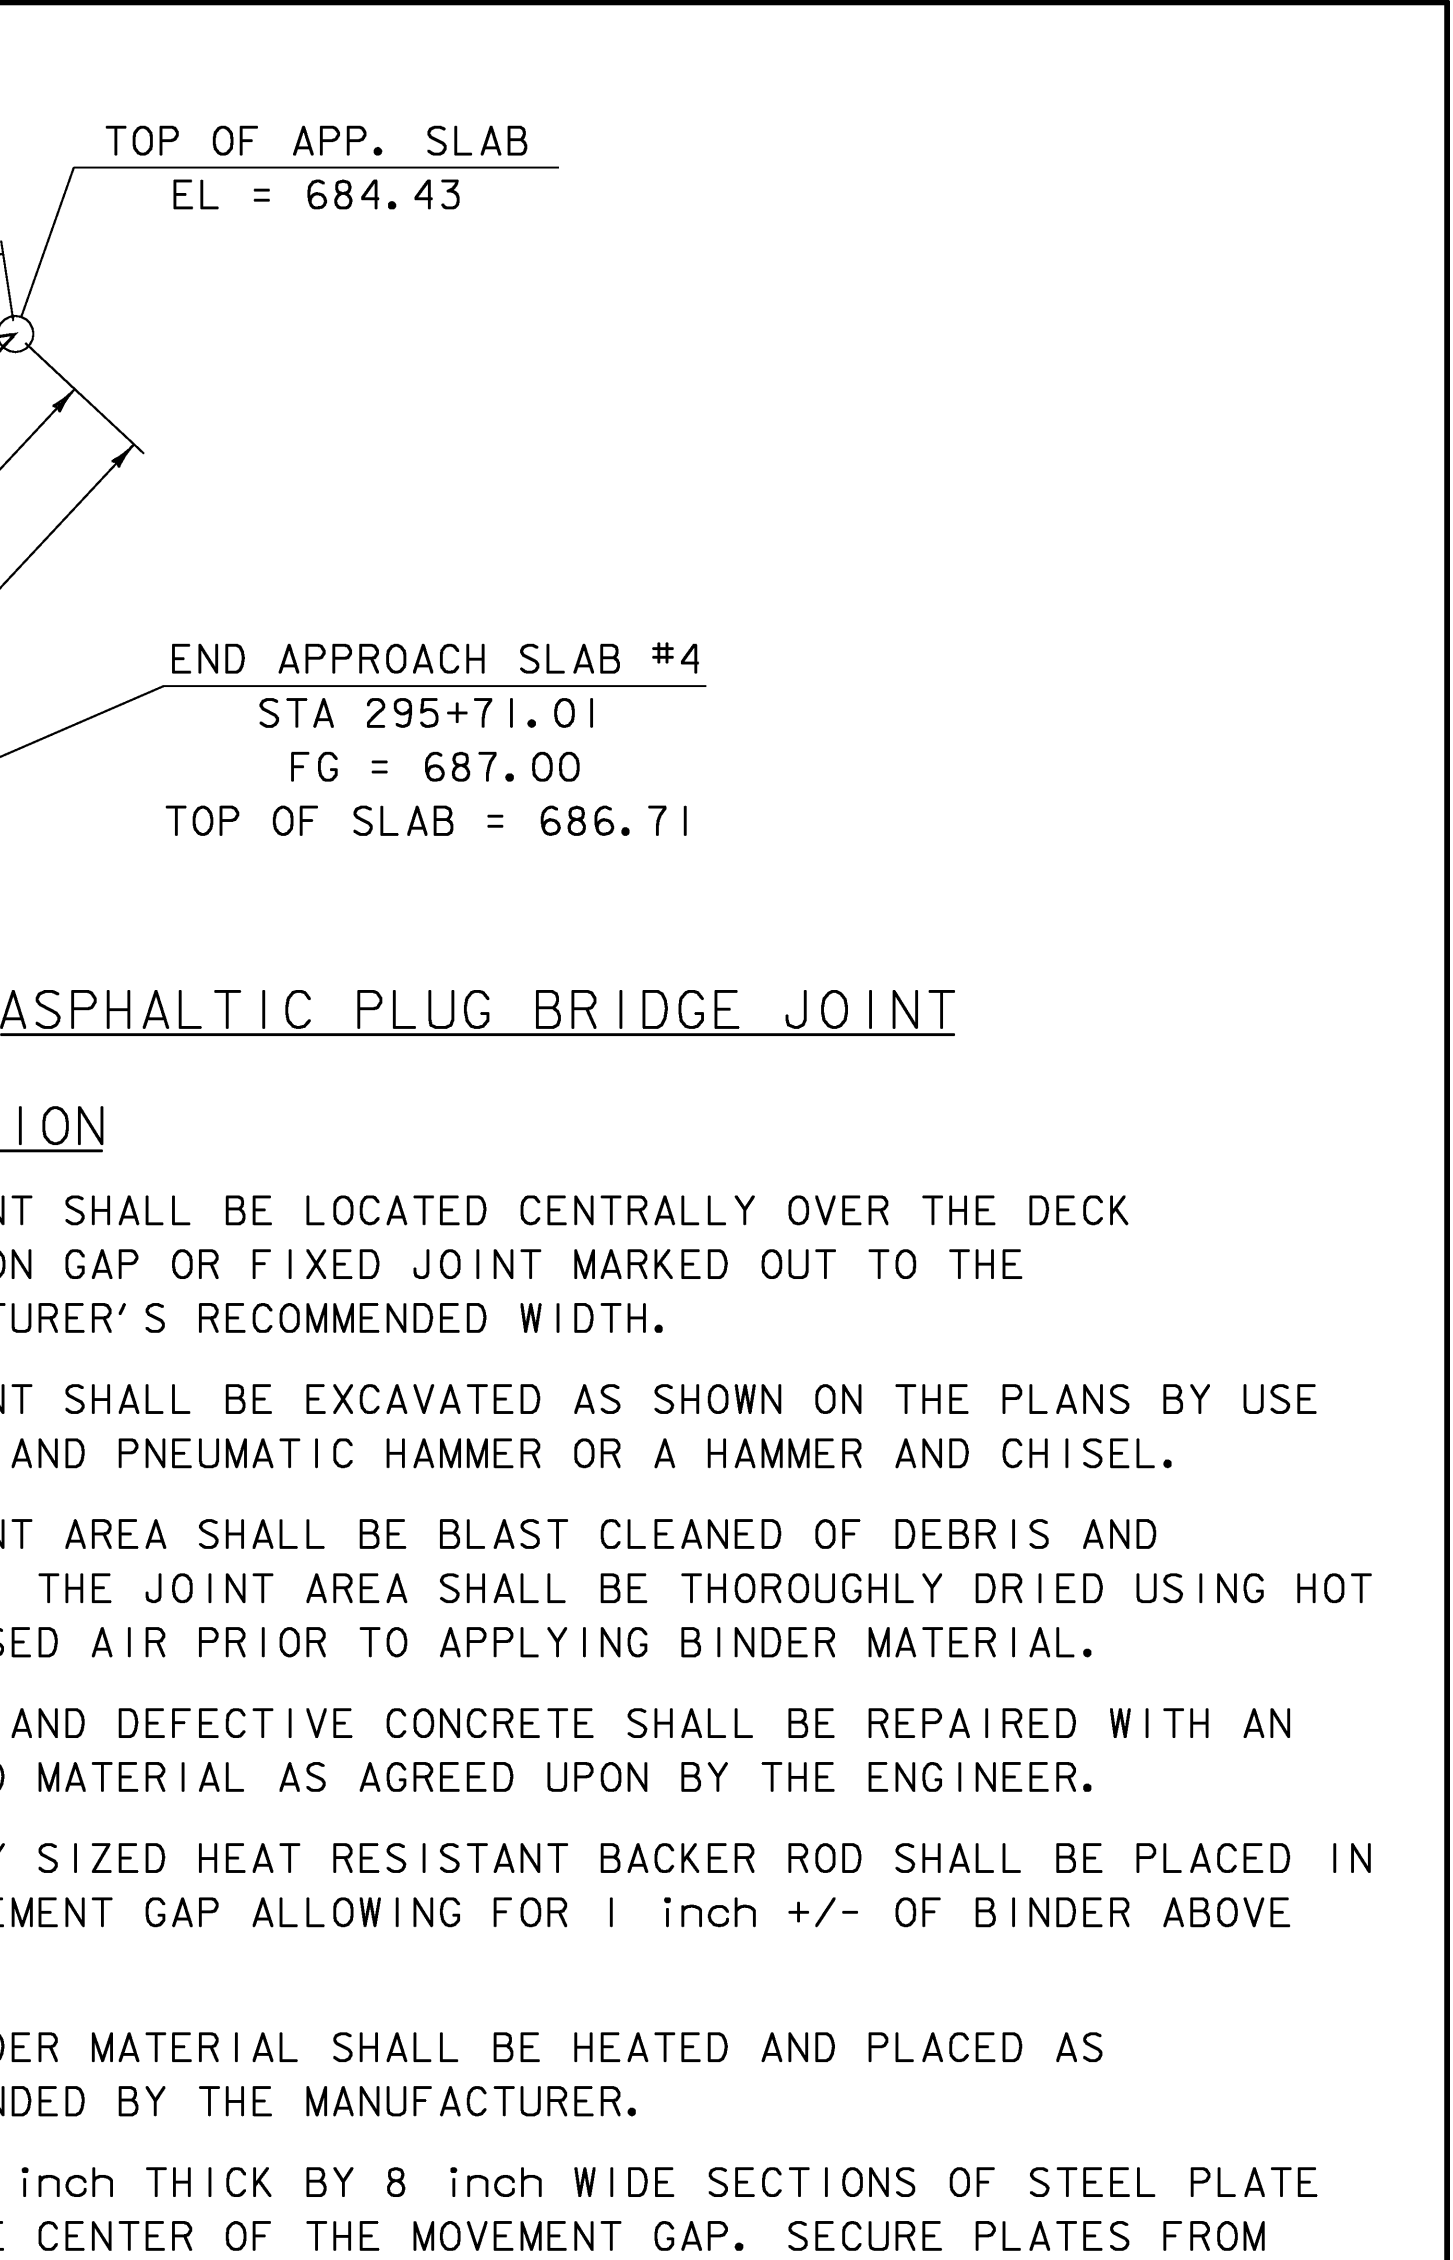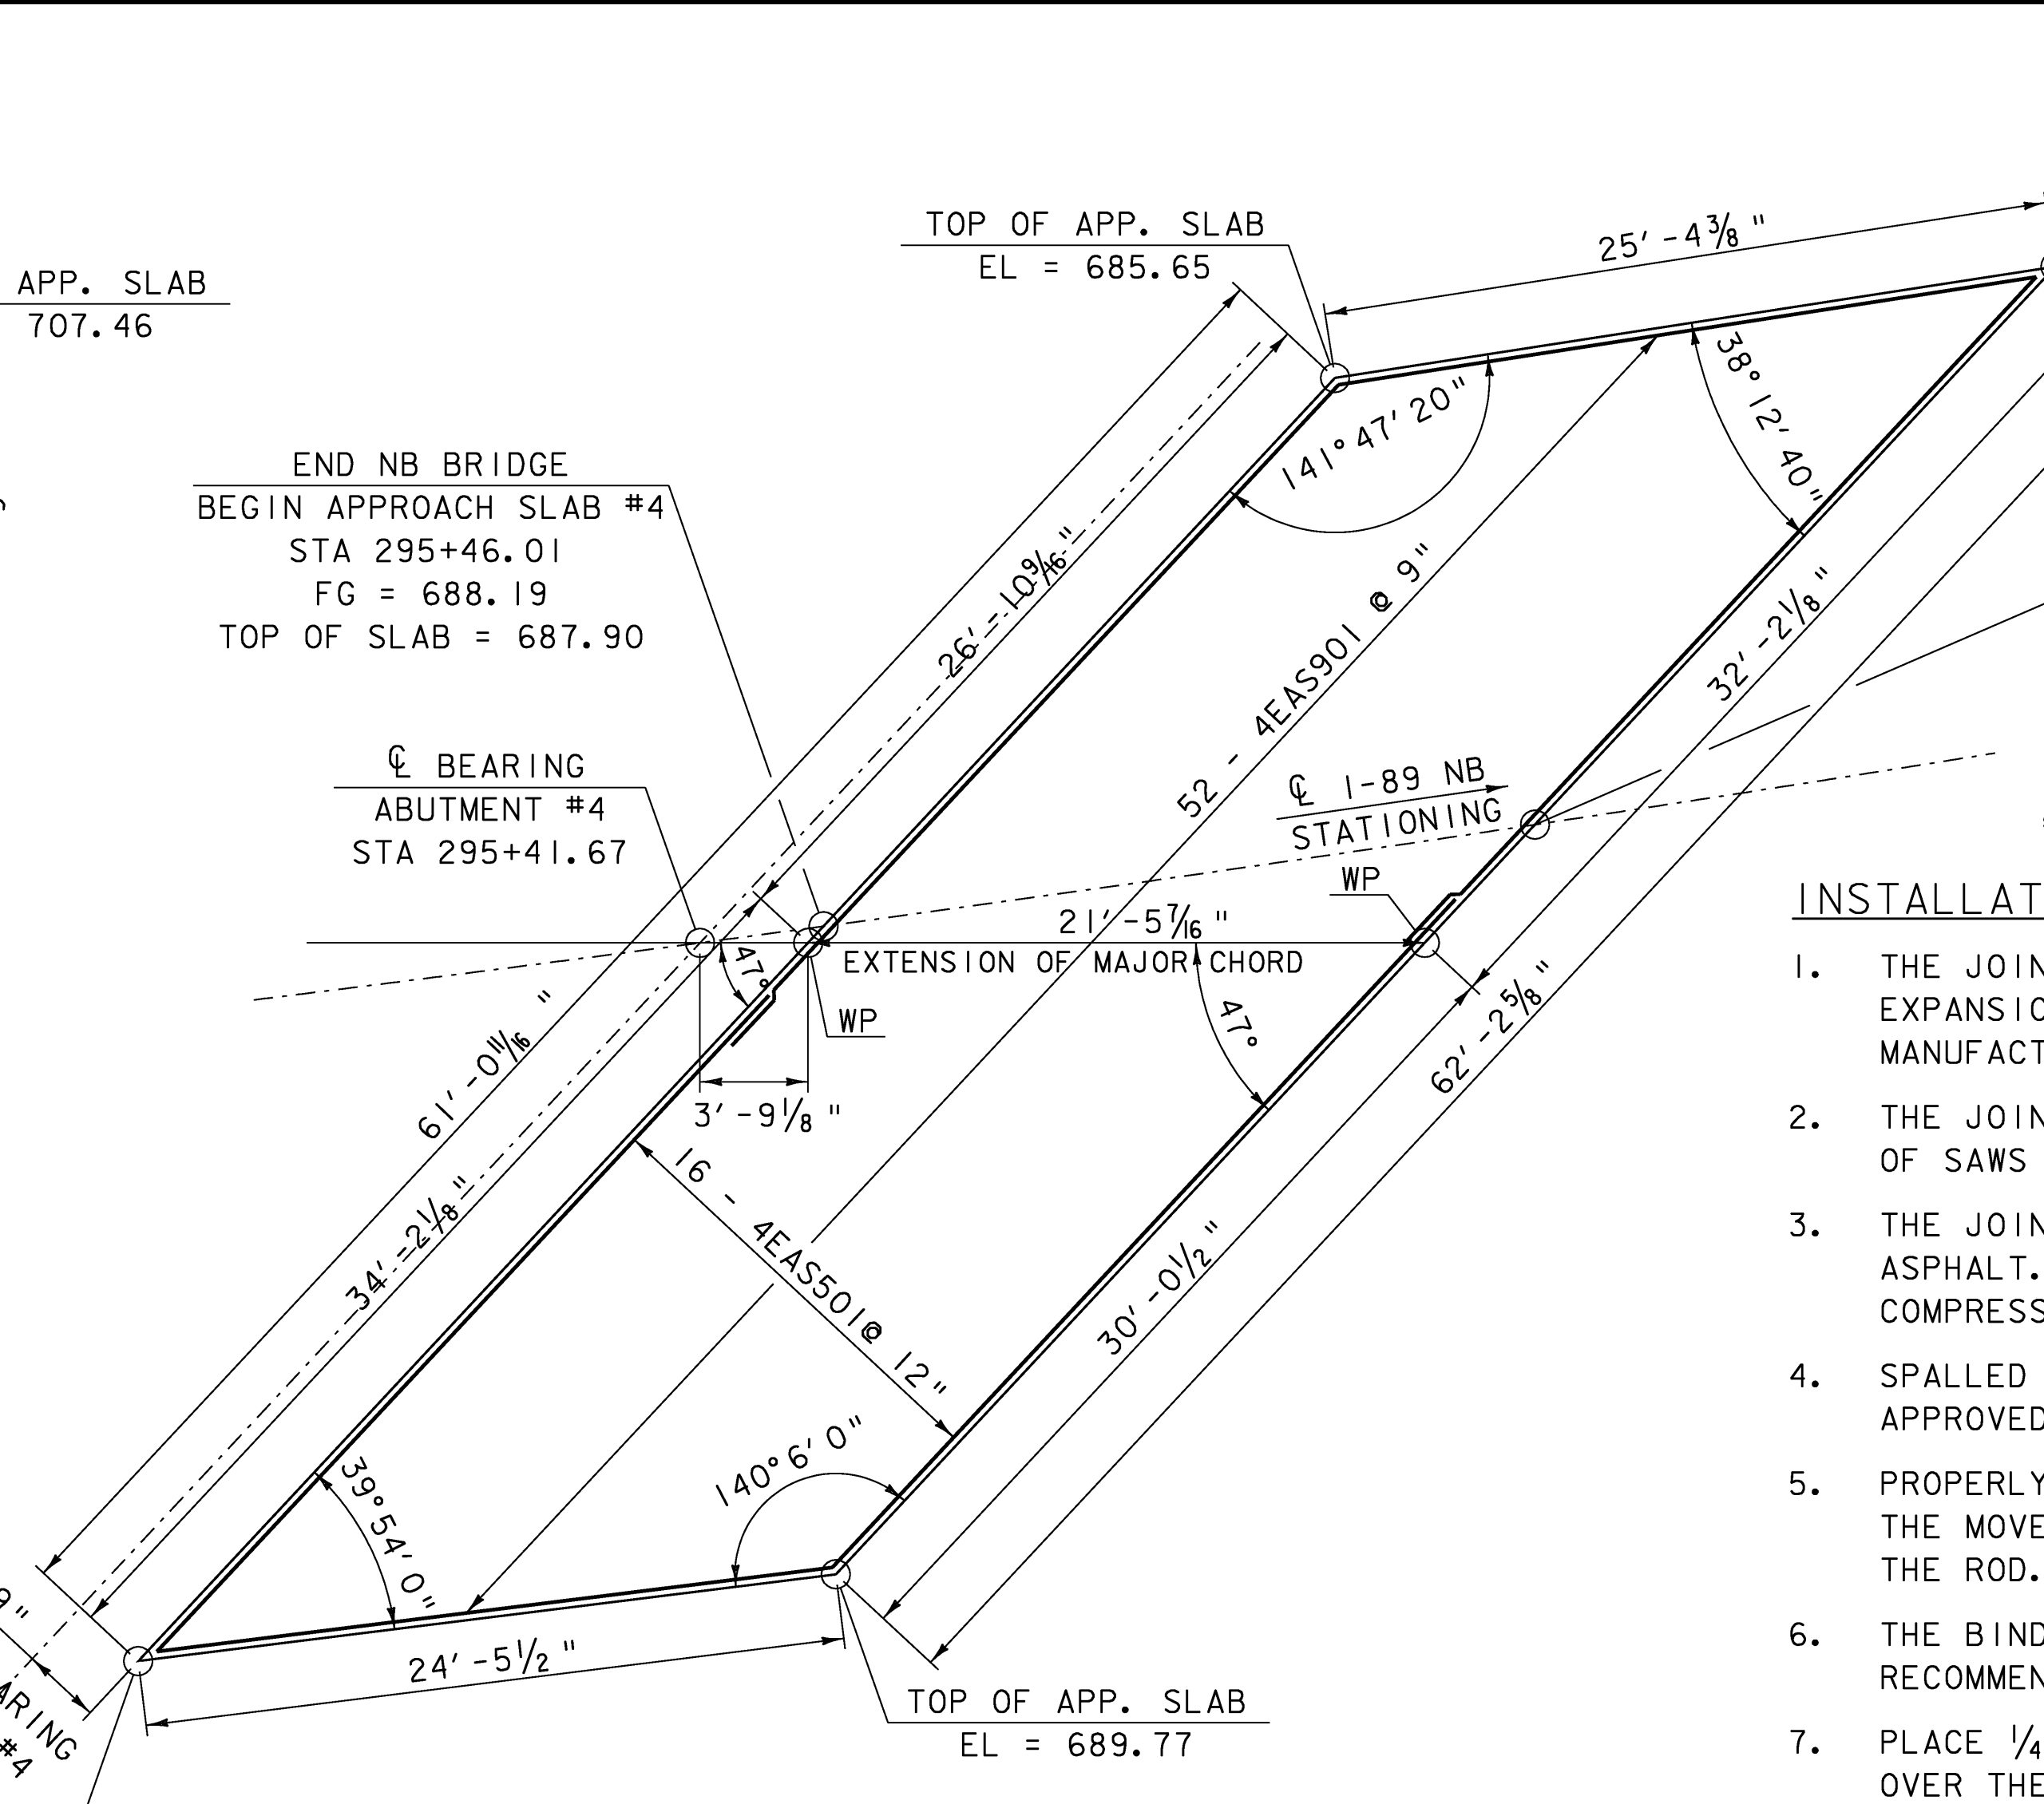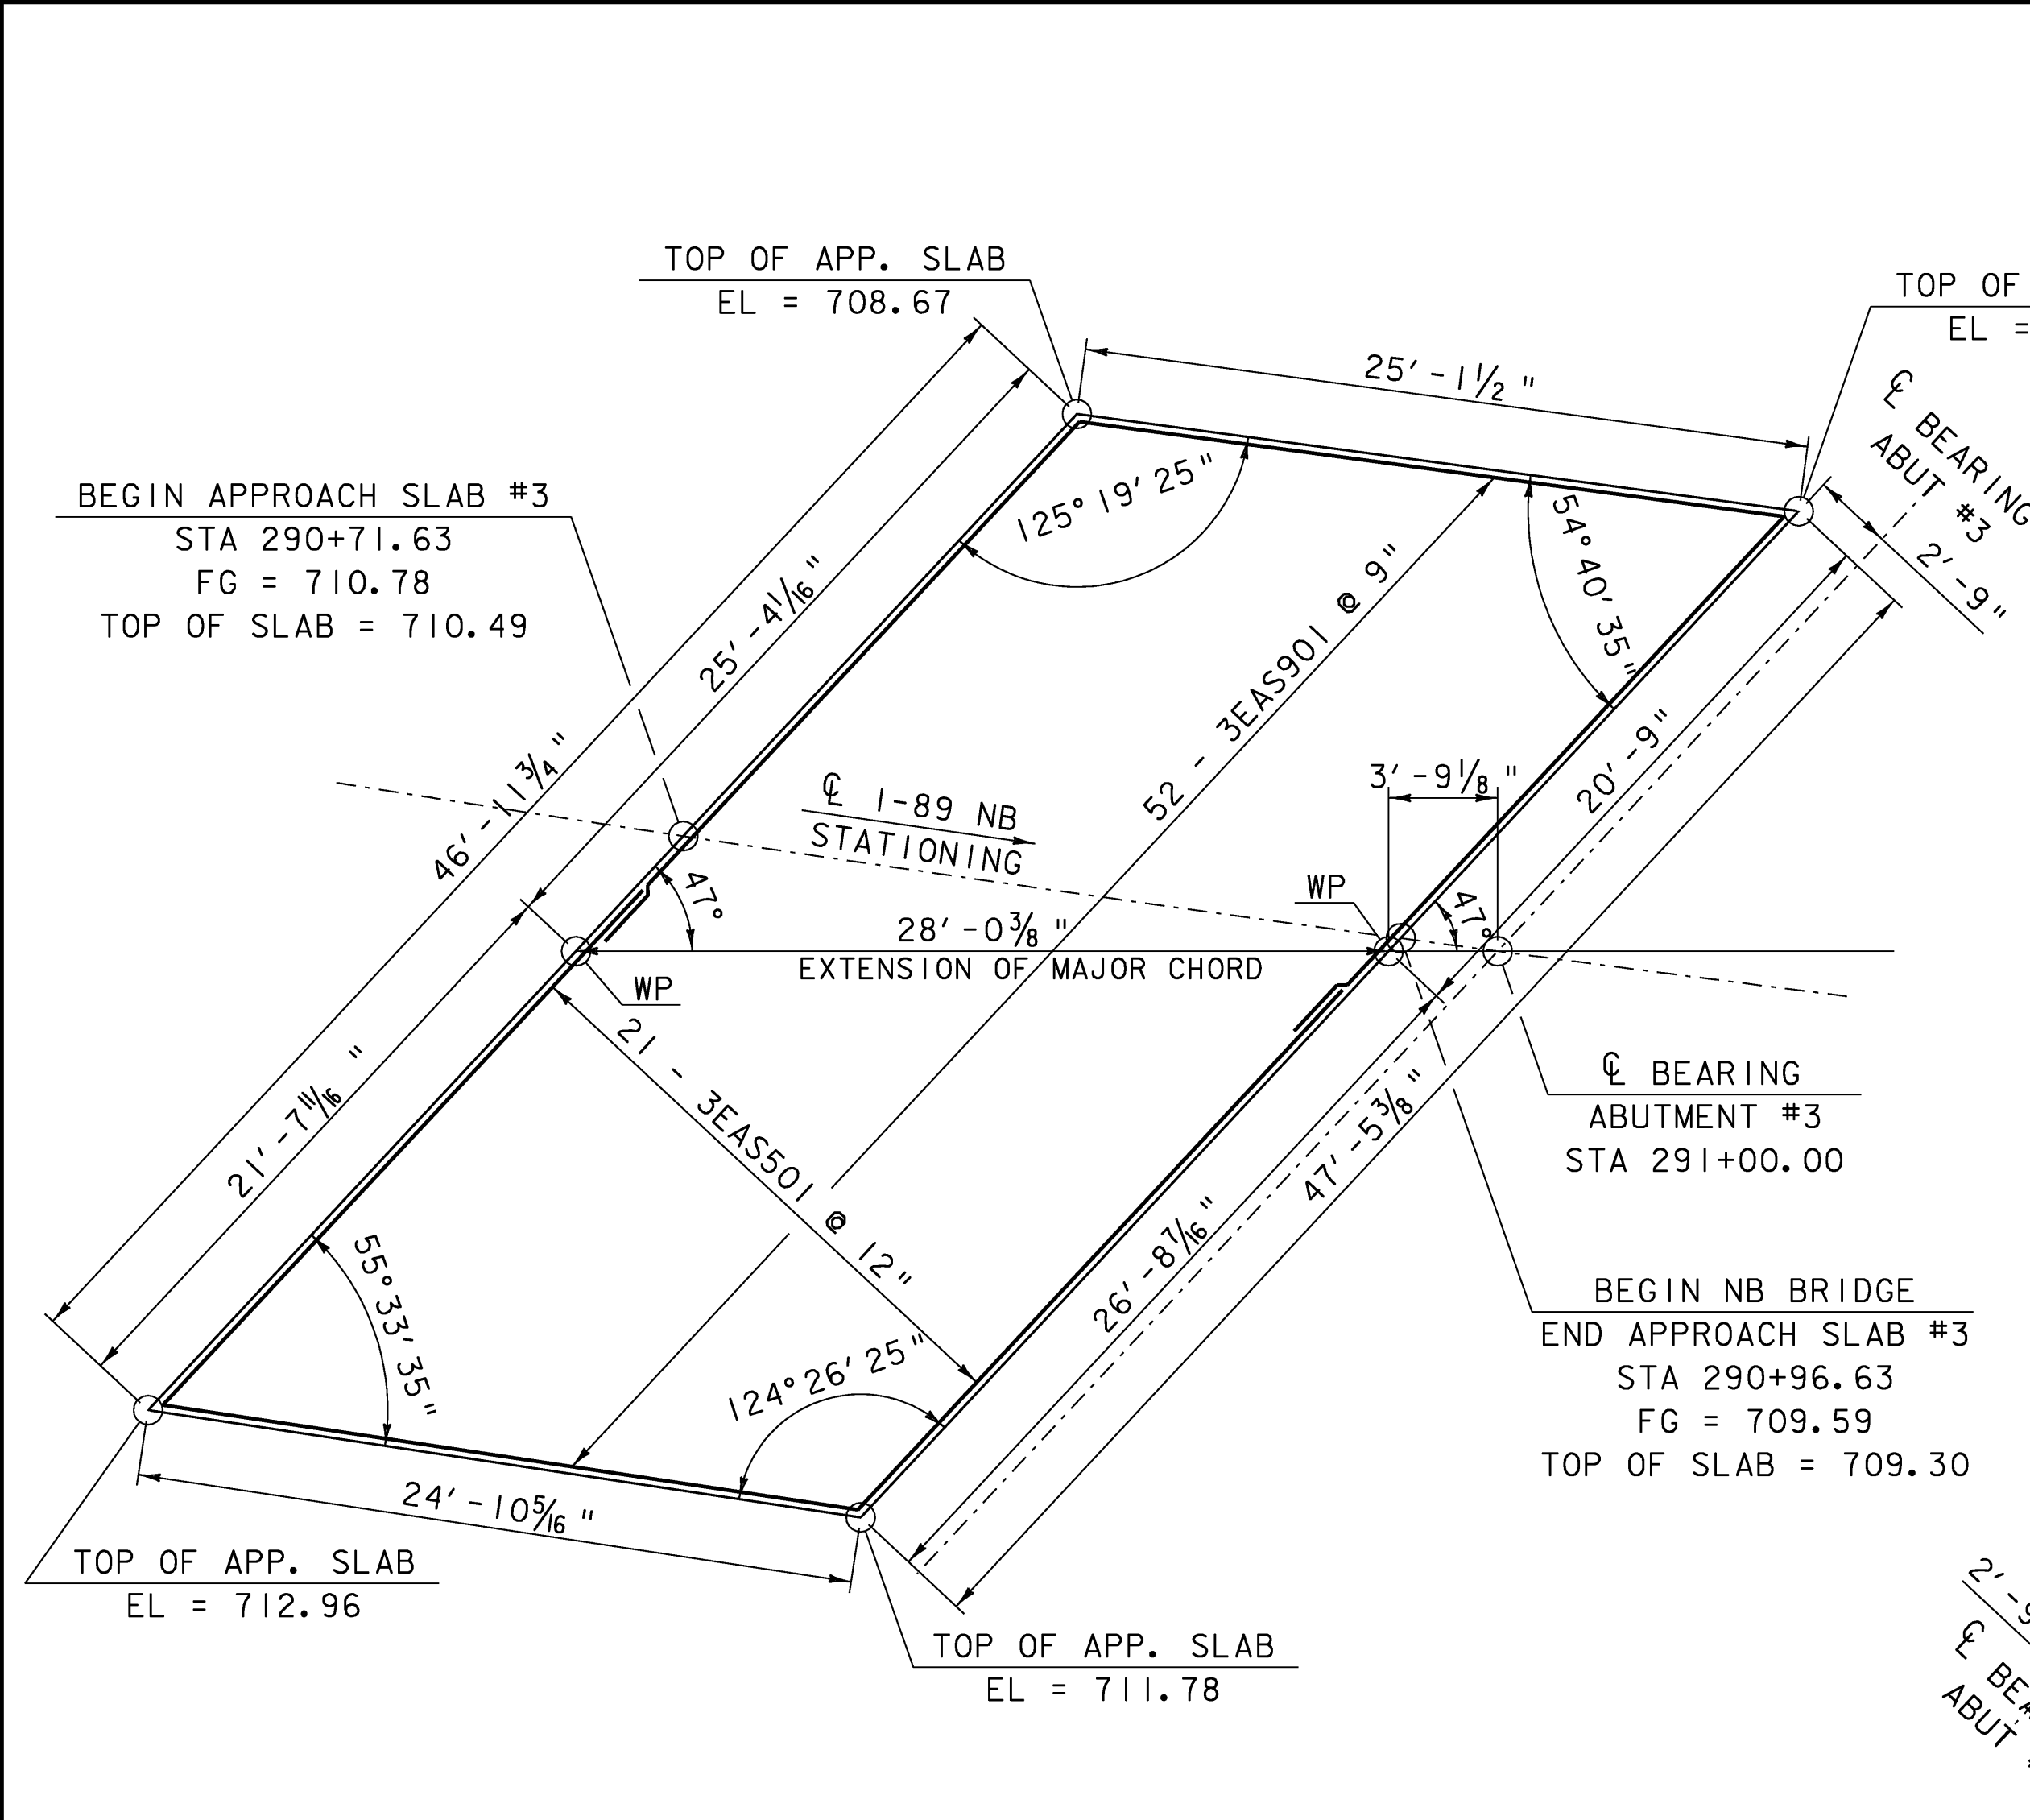

**PLAN VIEW**  
**APPROACH SLAB #3**  
SCALE 3/16" = 1'-0"

**PLAN VIEW**  
**APPROACH SLAB #4**  
SCALE 3/16" = 1'-0"

**ASPHALTIC PLUG BRIDGE JOINT**

**INSTALLATION**


1. THE JOINT SHALL BE LOCATED CENTRALLY OVER THE DECK EXPANSION GAP OR FIXED JOINT MARKED OUT TO THE MANUFACTURER'S RECOMMENDED WIDTH.
2. THE JOINT SHALL BE EXCAVATED AS SHOWN ON THE PLANS BY USE OF SAWS AND PNEUMATIC HAMMER OR A HAMMER AND CHISEL.
3. THE JOINT AREA SHALL BE BLAST CLEANED OF DEBRIS AND ASPHALT. THE JOINT AREA SHALL BE THOROUGHLY DRIED USING HOT COMPRESSED AIR PRIOR TO APPLYING BINDER MATERIAL.
4. SPALLED AND DEFECTIVE CONCRETE SHALL BE REPAIRED WITH AN APPROVED MATERIAL AS AGREED UPON BY THE ENGINEER.
5. PROPERLY SIZED HEAT RESISTANT BACKER ROD SHALL BE PLACED IN THE MOVEMENT GAP ALLOWING FOR 1 inch +/- OF BINDER ABOVE THE ROD.
6. THE BINDER MATERIAL SHALL BE HEATED AND PLACED AS RECOMMENDED BY THE MANUFACTURER.
7. PLACE 1/4 inch THICK BY 8 inch WIDE SECTIONS OF STEEL PLATE OVER THE CENTER OF THE MOVEMENT GAP. SECURE PLATES FROM MOVING BY INSERTING LOCATING PINS THROUGH THE PRE-STAMPED HOLES INTO BACKER ROD AND COVER WITH HOT BINDER.
  - a. THE STEEL PLATES MAY BE OMITTED WHERE THE APPROACH SLAB IS COVERED WITH A STONE BASE OR BITUMINOUS PAVEMENT AND VERTICAL MOVEMENT OF THE PLATES MIGHT OCCUR.
8. THE BINDER MATERIAL AND AGGREGATE SHALL BE HEATED AND MIXED AS RECOMMENDED BY THE MANUFACTURER.
9. THE INSTALLATION OF MATERIAL, COMPACTION, AND TOPCOATING SHALL BE AS RECOMMENDED BY THE MANUFACTURER.
10. IMMEDIATELY AFTER TOPCOATING, AN ANTI-SKID MATERIAL SHALL BE CAST OVER THE JOINT TO REDUCE THE RISK OF TRACKING.
11. JOINT SHALL BE PROTECTED FROM TRAFFIC UNTIL THE MATERIAL HAS COOLED TO 125°F +/-.

**WEATHER LIMITATIONS.**


- BINDER MATERIAL SHALL BE APPLIED ONLY WHEN THE FOLLOWING CONDITIONS PREVAIL:
- (a) THE AMBIENT AIR TEMPERATURE IS AT LEAST 50°F AND RISING.
  - (b) THE ROAD SURFACE IS SUFFICIENTLY DRY.
  - (c) WEATHER CONDITIONS OR OTHER CONDITIONS ARE FAVORABLE AND ARE EXPECTED TO REMAIN SO FOR THE PERFORMANCE OF SATISFACTORY WORK.

**NOTES:**  
 NF = NEAR FACE  
 FF = FAR FACE  
 EF = EACH FACE  
 ▲ = CUT TO FIT IN FIELD  
 3" CLR. UNLESS OTHERWISE SPECIFIED ON THE PLANS  
 ALL LAPS ARE 2'-2" UNLESS OTHERWISE NOTED ON PLANS.

ES901 BARS SHALL BE PLACED PARALLEL TO THE LONGEST SIDE

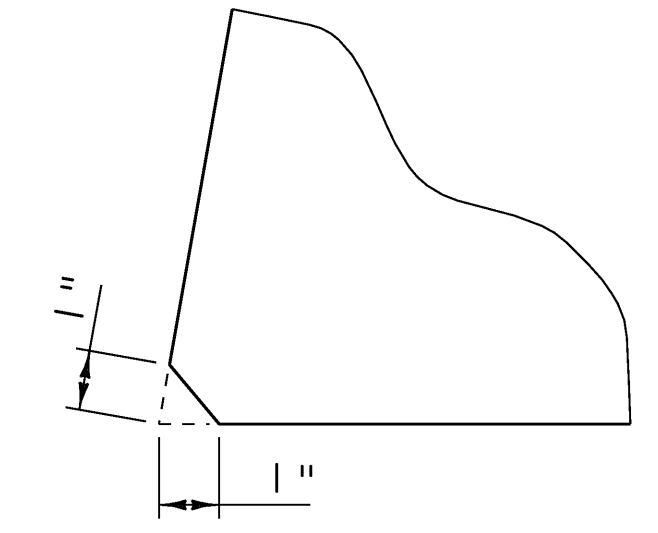


**ACUTE CORNER DETAIL**  
N. T. S.

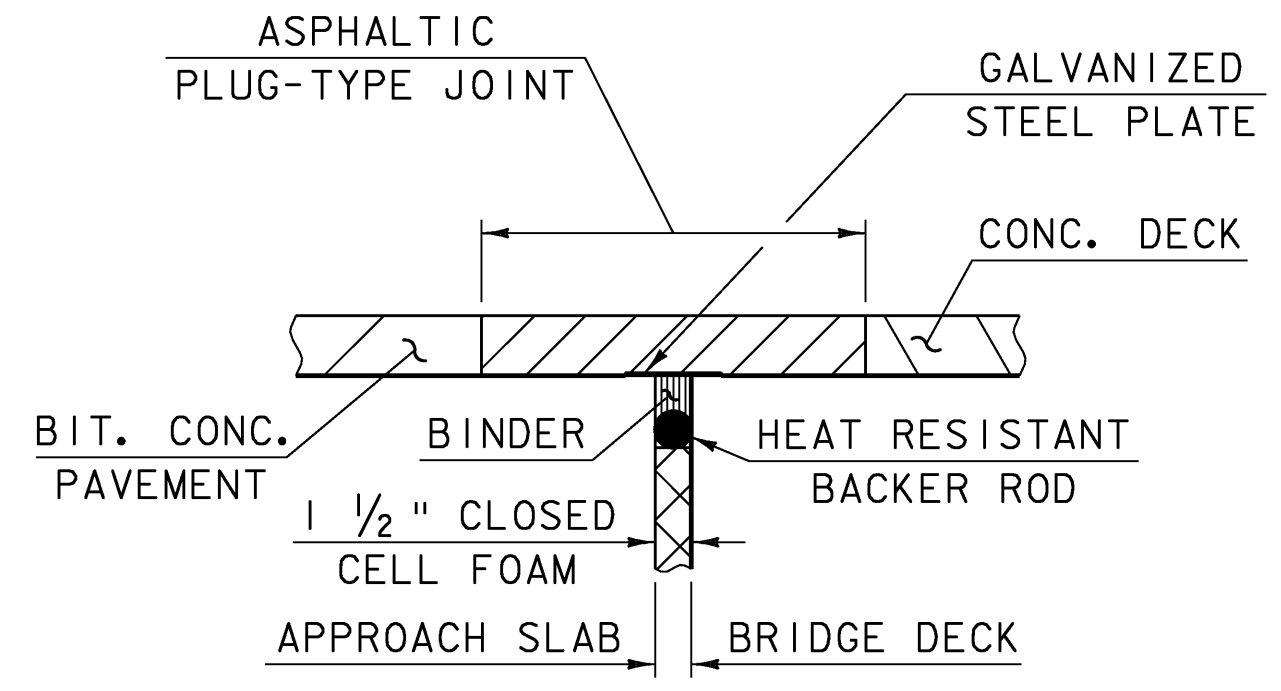


**ASPHALTIC PLUG-TYPE JOINT DETAIL**  
N. T. S.

SCALE 3/16" = 1'-0"  
1 0 2 4 6 8


PROJECT: <b>BERLIN</b>	PROJECT NO.: <b>IM 089-1 (20)</b>
DESIGN FILE NAME: 99a270/structures/99a270aps.dgn	PLOT DATE: 05-DEC-2007
IPARM FILE NAME: 99a270apsNB.i	DRAWN BY: E.L. RUSTAY
DESIGNED BY: E.L. RUSTAY	CHECKED BY: R.S. YOUNG
SQUAD LEADER: C.P. WILLIAMS	SHEET: 46 OF 104
APPROACH SLAB #3 & #4 DETAILS	

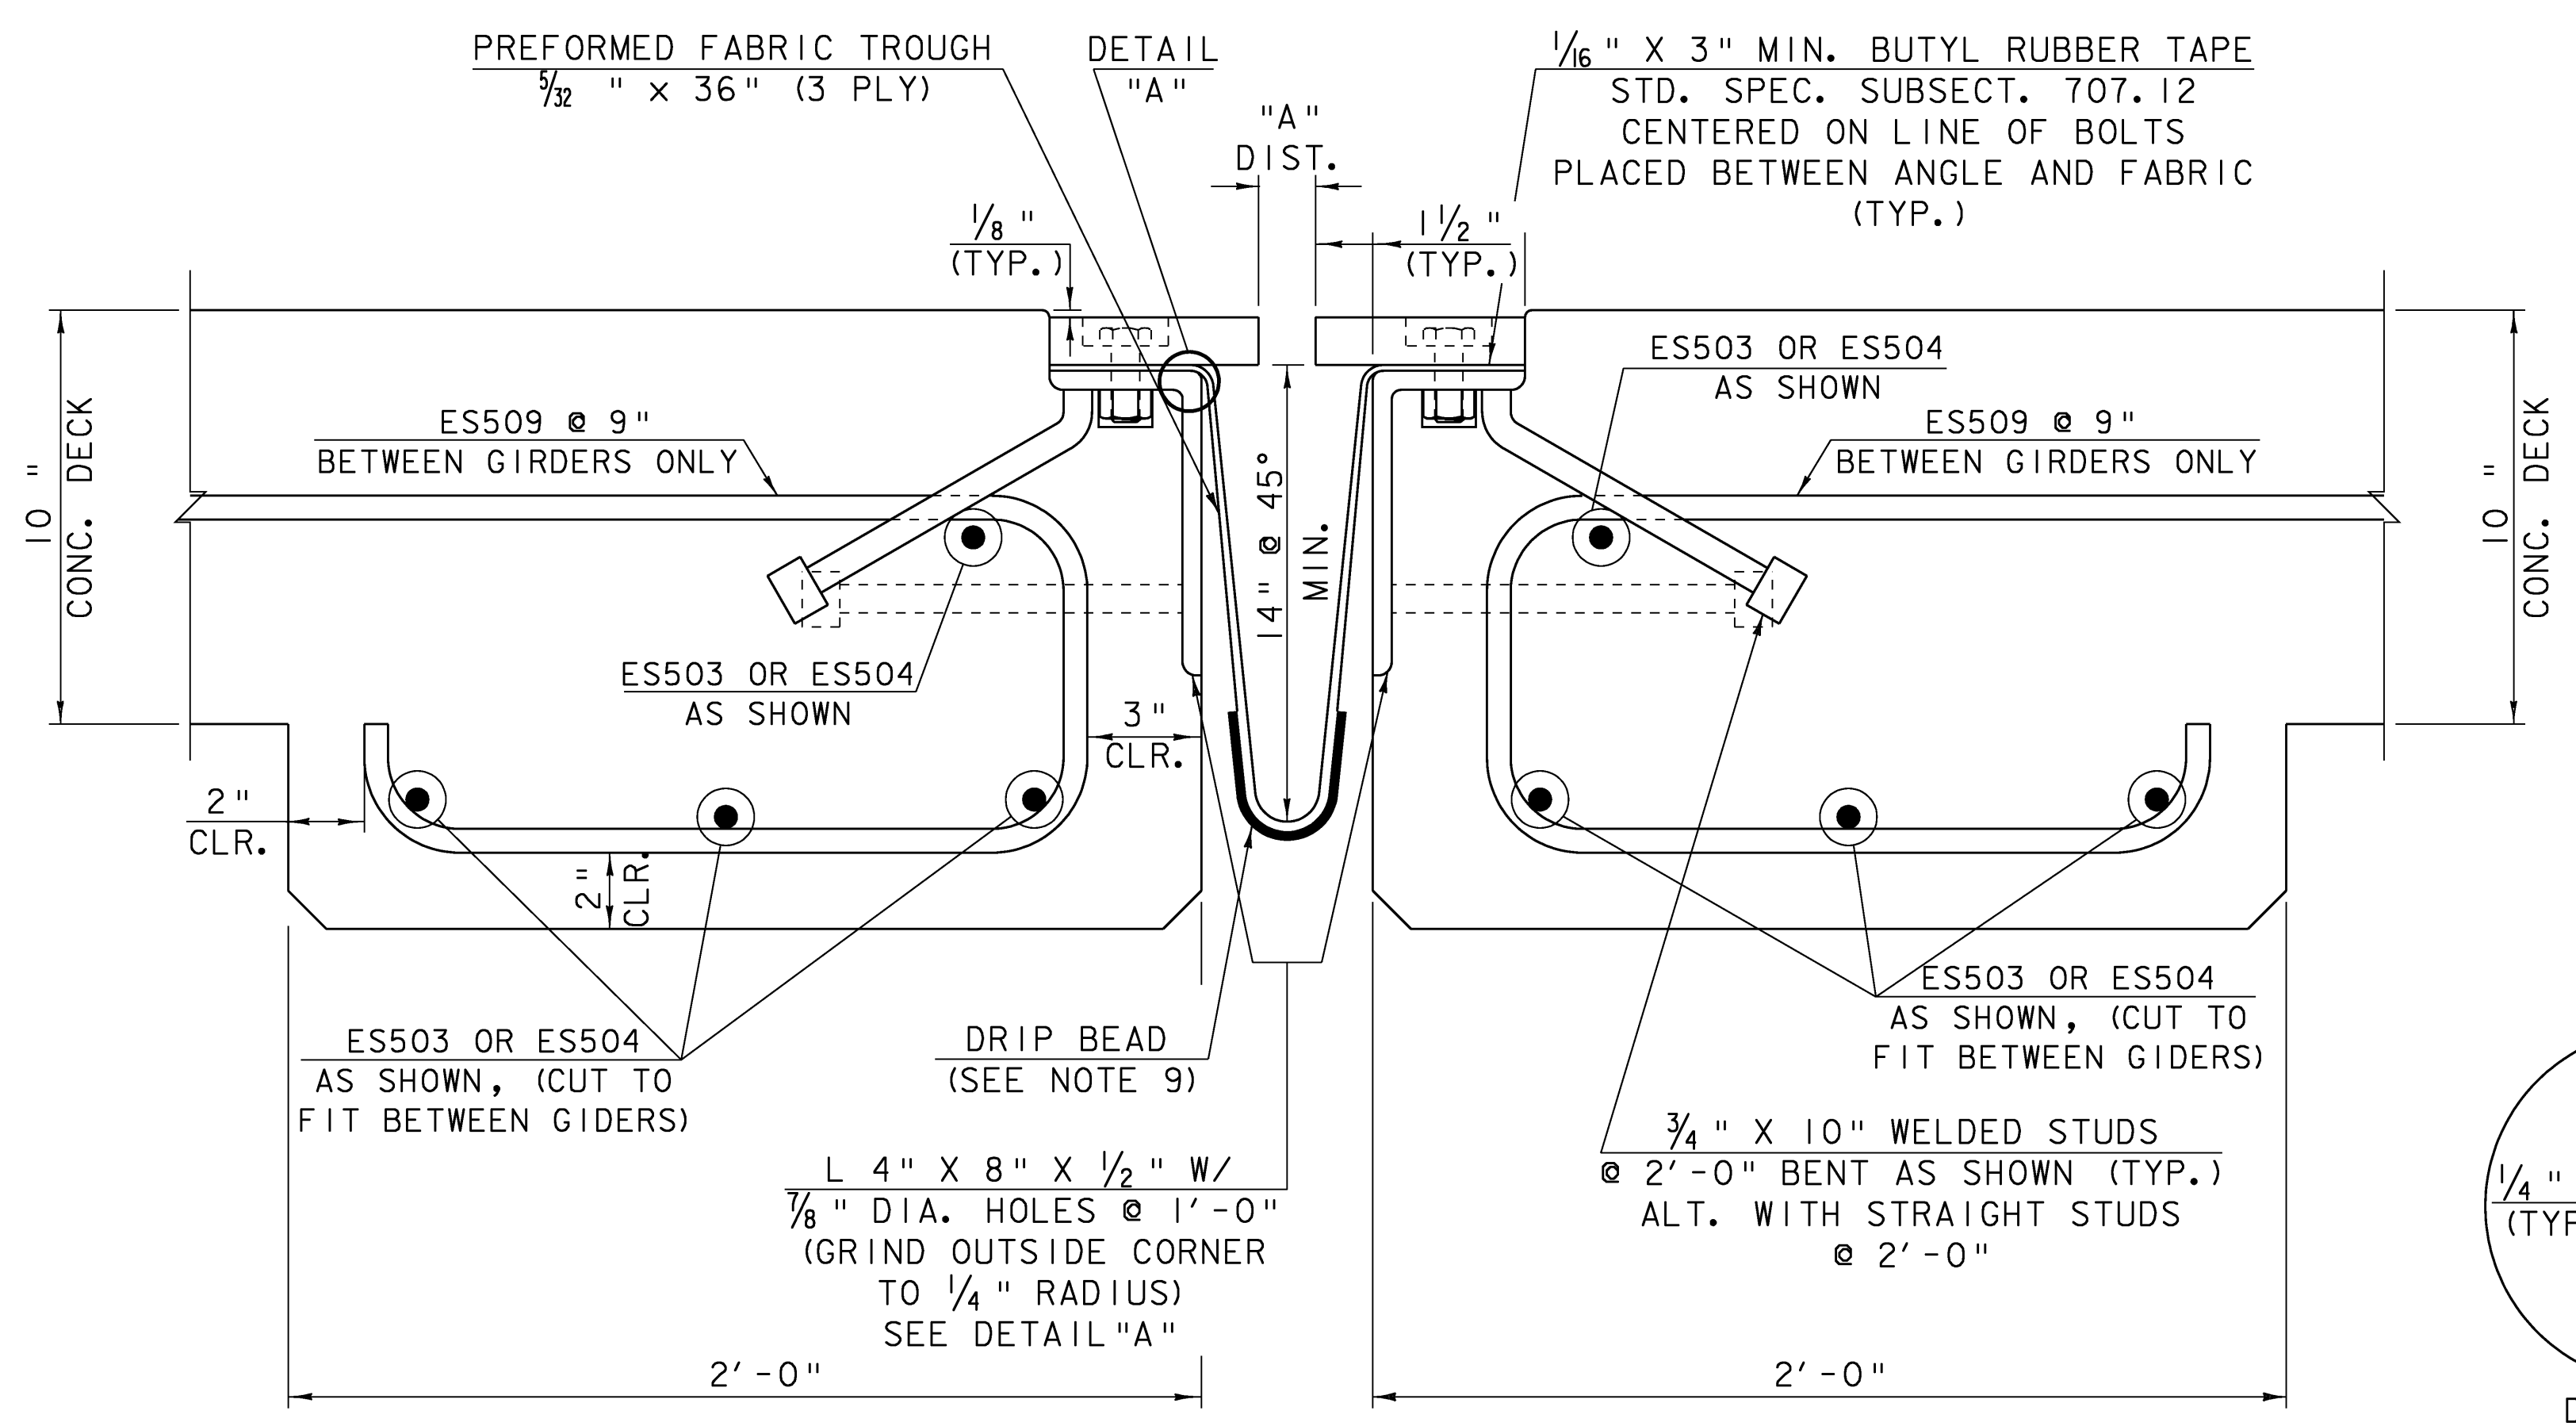

**TYPICAL SECTION BETWEEN GIRDERS**  
(NORMAL TO  $\perp$  BEARING)  
N. T. S.

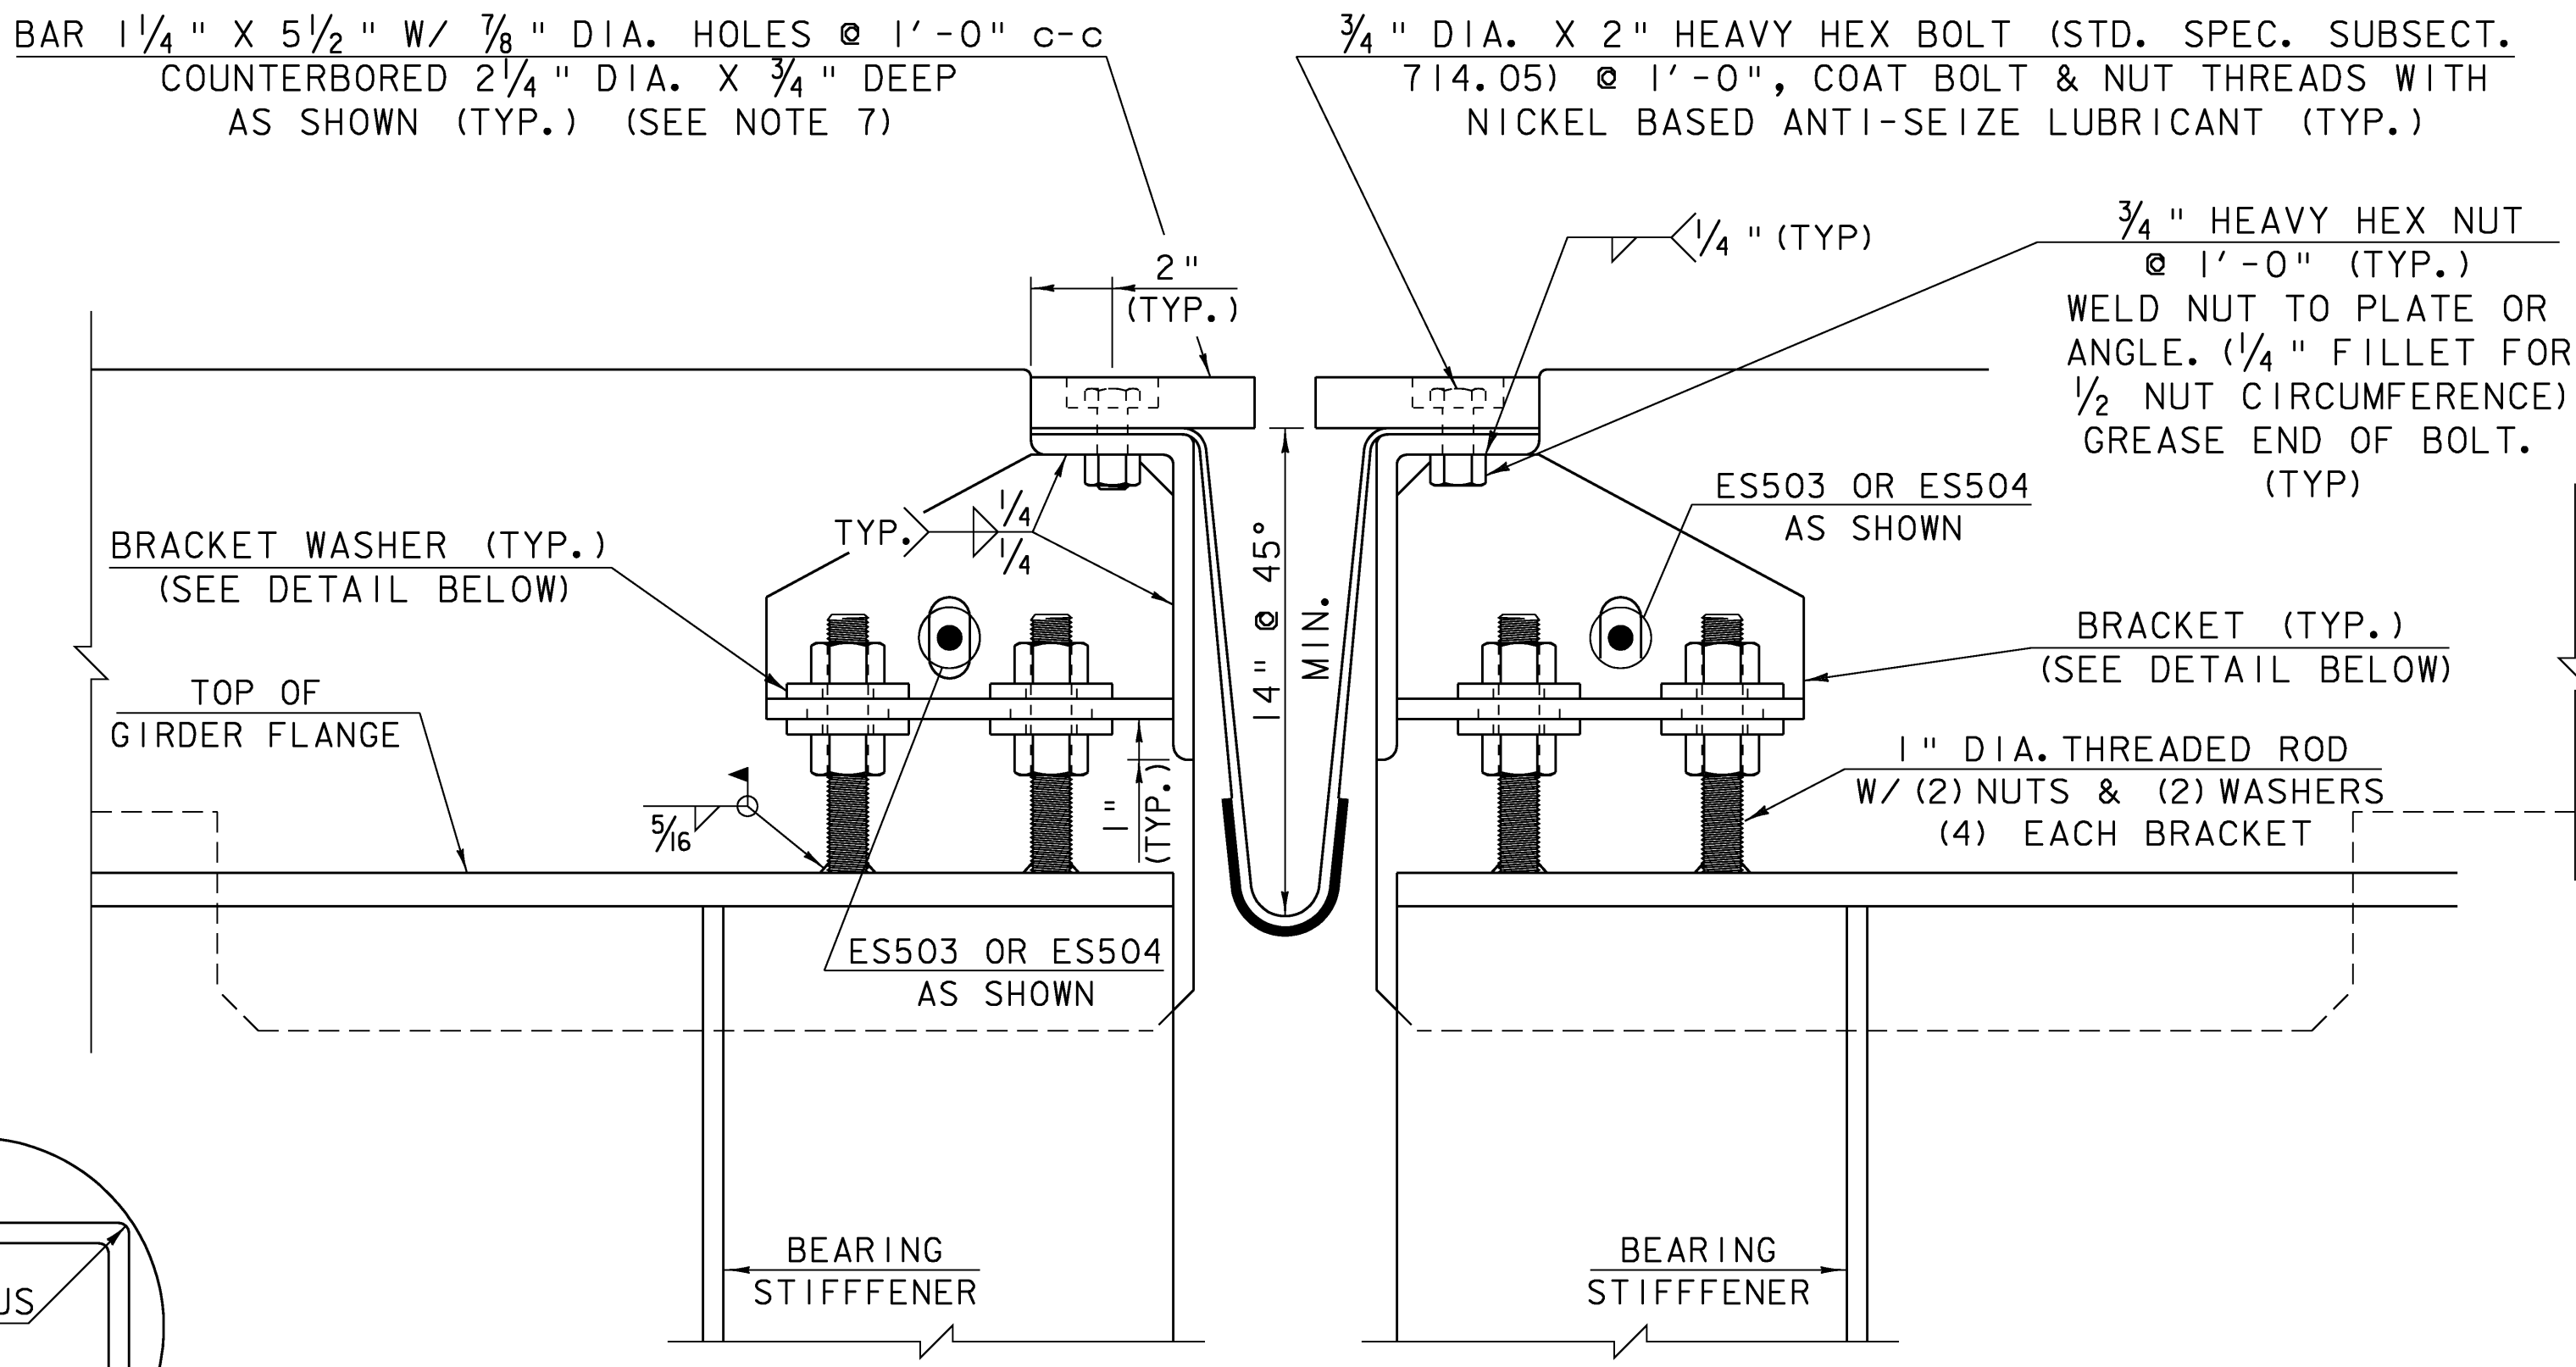


**TYPICAL SECTION AT GIRDERS**  
(NORMAL TO  $\perp$  BEARING)  
N. T. S.

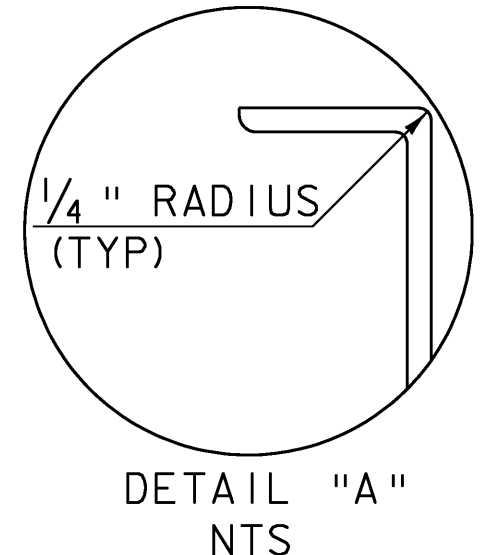


DETAIL "A"  
N.T.S.

1. DETAILS ON THIS SHEET ARE FOR ITEM 516.11 "BRIDGE EXPANSION JOINT (VERMONT)".
2. PREFORMED FABRIC MATERIAL SHALL BE CONTINUOUS FOR THE FULL LENGTH OF THE JOINT.
3. THE FINAL FINISH OF THE EXPANSION DEVICE SHALL BE COVERED DURING THE PLACING OF BRIDGE DECK CONCRETE.
4. ALL STEEL COMPONENTS SHALL BE GALVANIZED OR METALIZED AND MEET THE REQUIREMENTS OF SUBSECTION 516.02. THREADED RODS SHALL CONFORM TO THE REQUIREMENTS OF 714.04. THE 1/2"x9"x6" PLATE AND WELDED STUD ASSEMBLY MAY BE SUPPLIED WITHOUT GALVANIZING OR METALIZING.
5. THE ITEM "BRIDGE EXPANSION JOINT (VERMONT)" SHALL INCLUDE THE FABRICATION AND ERECTION OF THE COMPLETE JOINT ASSEMBLY INCLUDING ALL STEEL PLATES, BRACKETS, ANGLES, WELDED STUDS OR RODS, PREFORMED FABRIC DRAIN TROUGH MATERIAL AND PLASTIC DRAIN TUBES, BUTYL RUBBER TAPE AND ANY OTHER MISCELLANEOUS MATERIAL NECESSARY TO INSTALL JOINT.
6. THE 4" X 8" X 1/2" ANGLES SHALL BE FURNISHED AS ONE CONTINUOUS PIECE. THE 1 1/4" X 5 1/2" BARS EACH SIDE OF THE JOINT SHALL BE PROVIDED IN TWO EQUAL LENGTHS.
7. FILL COUNTERBORED HOLES WITH HOT Poured JOINT SEALER (STD. SPEC. 707.04) AFTER BOLT INSTALLATION. PAYMENT FOR THE WORK SHALL BE INCIDENTAL TO ITEM 516.11 "BRIDGE EXPANSION JOINT, VERMONT".
8. THE EXPANSION JOINT SHALL BE SHOP ASSEMBLED AND SHIPPED AS ONE UNIT.
9. A DRIP BEAD OF 1/4" X 7" STRIP OF PREFORMED FABRIC MATERIAL SHALL BE CEMENTED TO THE BOTTOM OF THE FABRIC TROUGH USING AN ADHESIVE APPROVED BY THE MANUFACTURER. THE DRIP BEAD SHALL BE APPLIED 1" FROM THE DOWNSPOUT END OF THE TROUGH.


10. FABRIC TROUGH SHALL BE THOROUGHLY CLEANED AND FLUSHED AFTER PAVING OPERATION.
11. PRIOR TO GALVANIZING OR METALIZING, ALL CORNERS AND EDGES OF STEEL PLATES, SHAPES, ETC., SHALL BE GROUND TO A 1/16 INCH RADIUS.
12. TEMPORARY SHIPPING ATTACHMENTS SHALL BE ATTACHED BY BOLTING; WELDING WILL NOT BE PERMITTED.
13. PROJECTING THREADS OF THE 3/4" BOLTS IN THE JOINT SHALL BE GREASED BY THE CONTRACTOR PRIOR TO PLACING ADJACENT CONCRETE. THIS WILL FACILITATE BOLT REMOVAL IF REQUIRED IN THE FUTURE.
14. SEE "EXPANSION JOINT AT PIER", SHEETS 48-51, FOR "A" DISTANCE

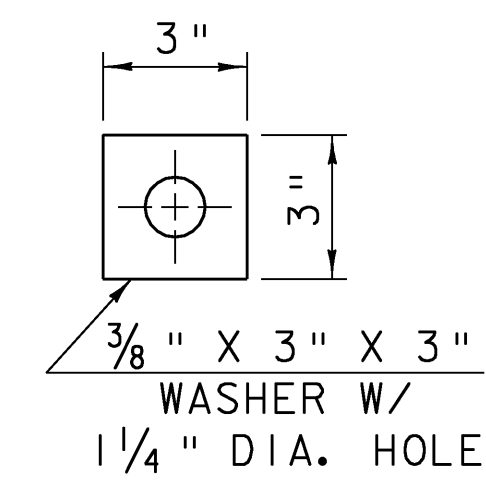


**WASHER FOR BRACKET**  
SCALE: 3" = 1'-0"

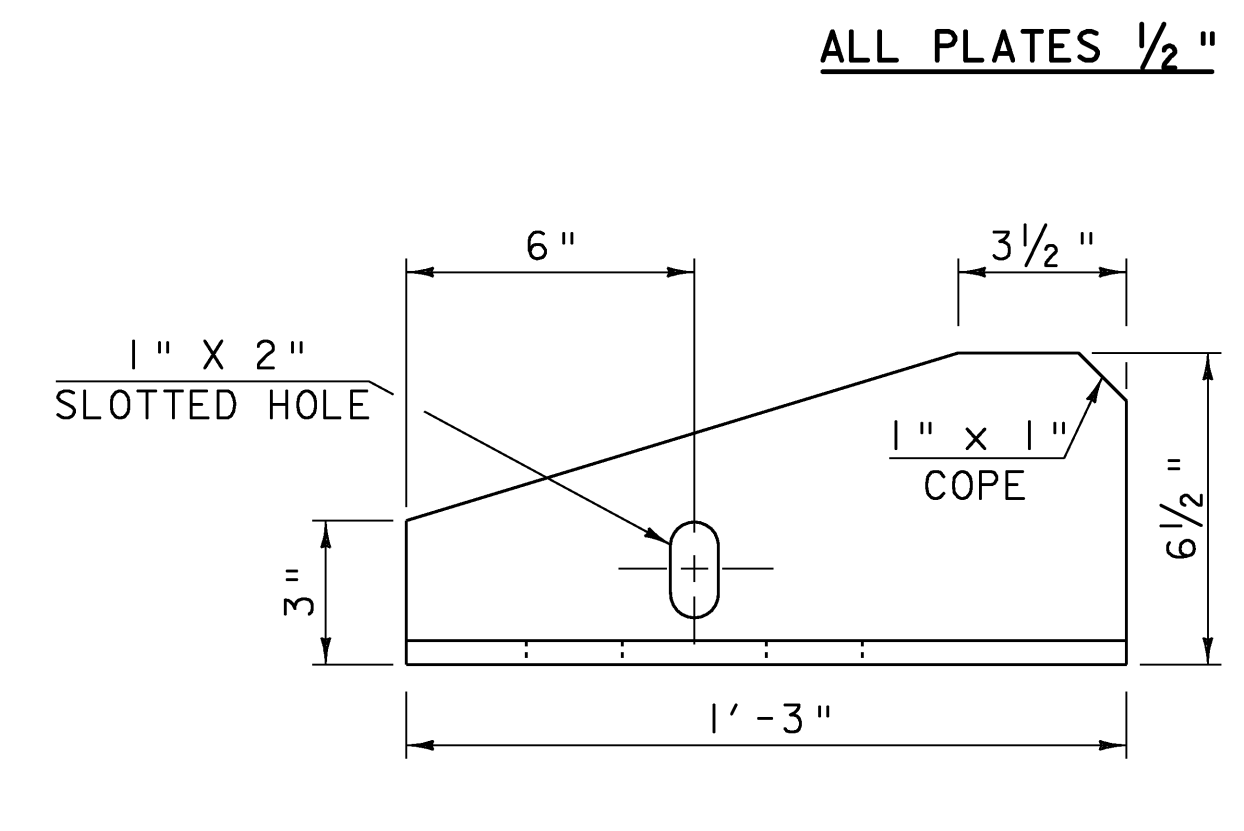

**BRACKET ELEVATION**  
SCALE: 3" = 1'-0"

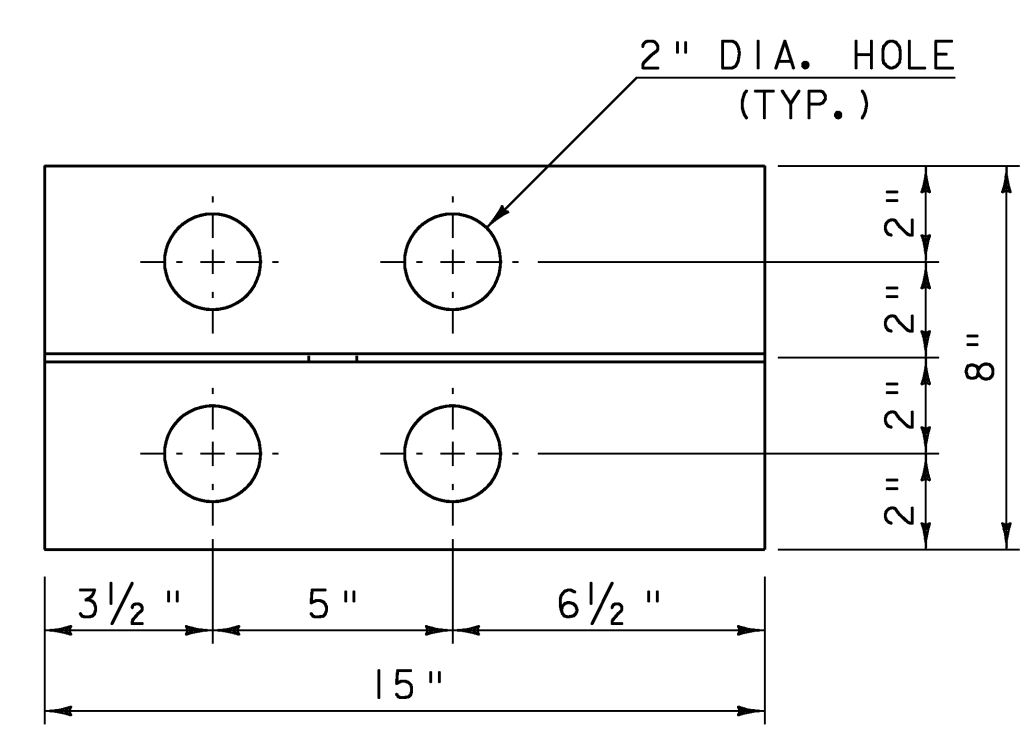


**BRACKET PLAN**  
SCALE: 3" = 1'-0"

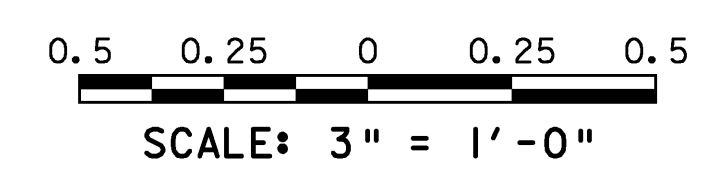

**EXPANSION JOINT DETAILS**

PROJECT: BERLIN	PROJECT NO.: IM 089-1 (20)
DESIGN FILE NAME: 99a270\structures\99a270vtjoint.dgn	PLOT DATE: 05-DEC-2007
IPARM FILE NAME: S99a270vtjoint.i	DESIGNED BY: VAOT
SQUAD LEADER: C.P. WILLIAMS	DRAWN BY: M. FESSEL
EXPANSION JOINT DETAILS	CHECKED BY: R. S. YOUNG
	SHEET: 47 OF 104

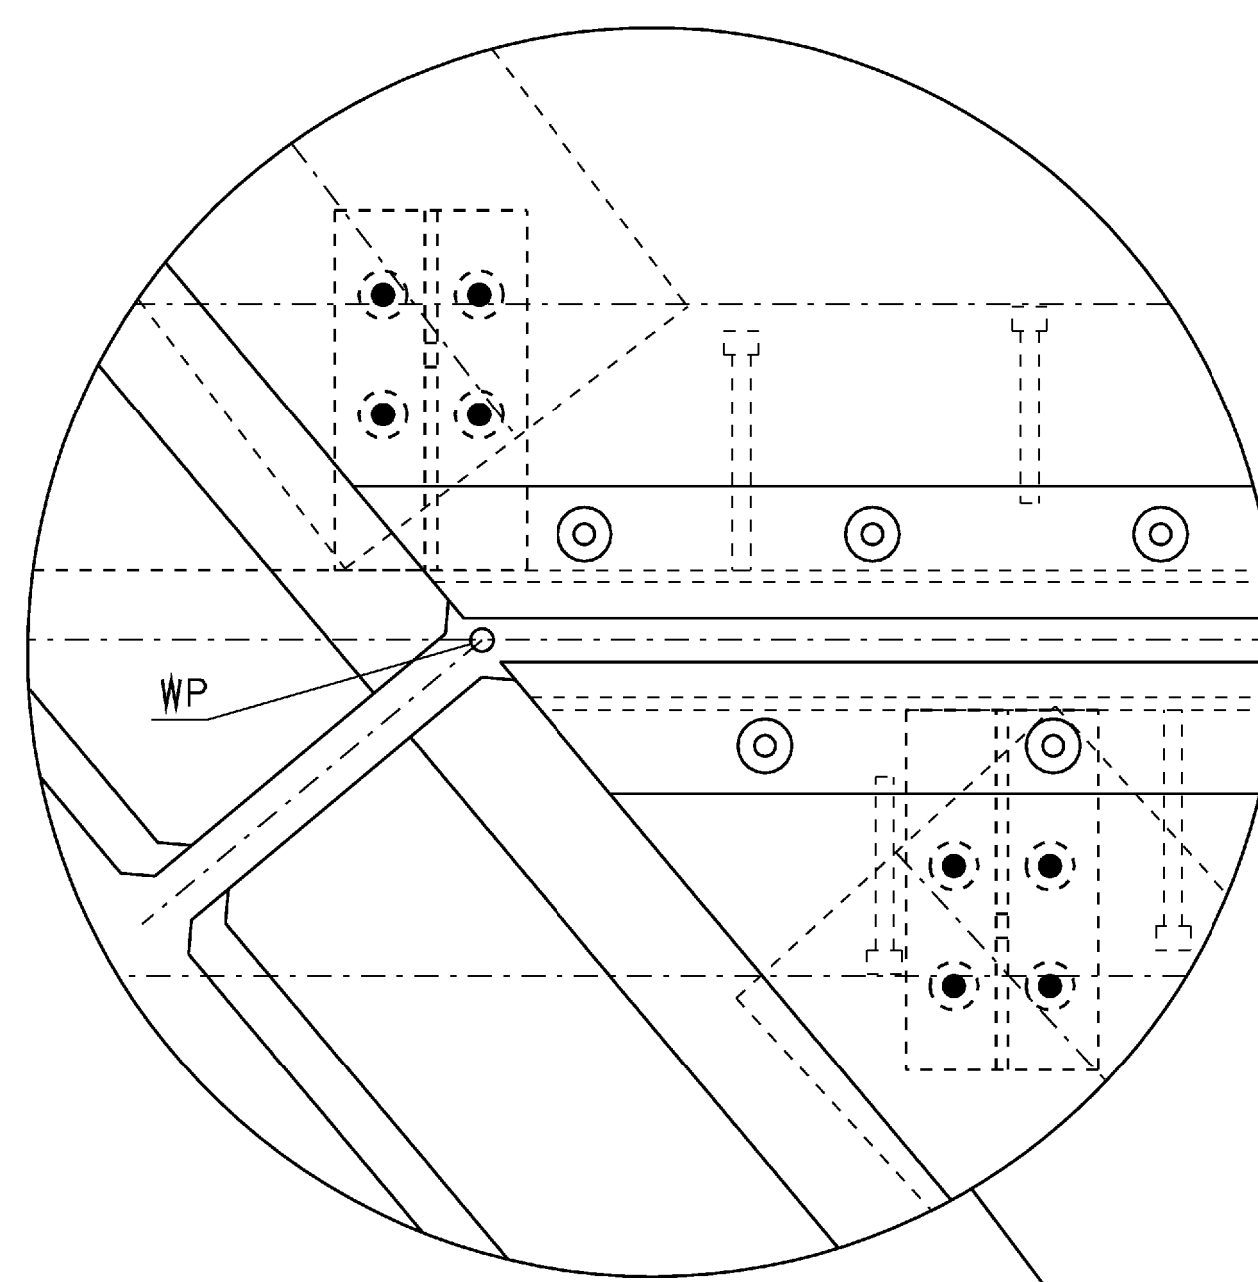


TYPICAL BRACKET DETAIL

SCALE 1 1/2" = 1'-0"  
 9 6 3 0

JOINT WORK POINTS						
WORK PT.	PIER	STATION	ELEV.	OFFSET	COORDINATES	
					N	E
#1	1	392+32.80	697.71	RT. 16'-6 1/4"	36790.35	17135.53
#2	1	392+46.67	695.74	0	36785.55	17114.45
#3	1	392+66.21	693.01	LT. 22'-6 1/4"	36778.95	17085.47



TEMP	"A" DIST.	"B" DIST.
105°F	1/2"	1 1/16"
90°F	3/4"	1"
75°F	1"	1 5/16" 3/8"
60°F	1 5/16"	1 3/4" 1/16"
45°F	1 9/16"	2 1/16"
30°F	1 11/16"	2 3/8"
15°F	2 1/16"	2 3/4"
0°F	2 3/8"	3 1/8" 1/16"
-15°F	2 5/8"	3 1/2" 1/16"

"A" IS THE SETTING AFTER DEAD LOADS ARE PUT IN PLACE.

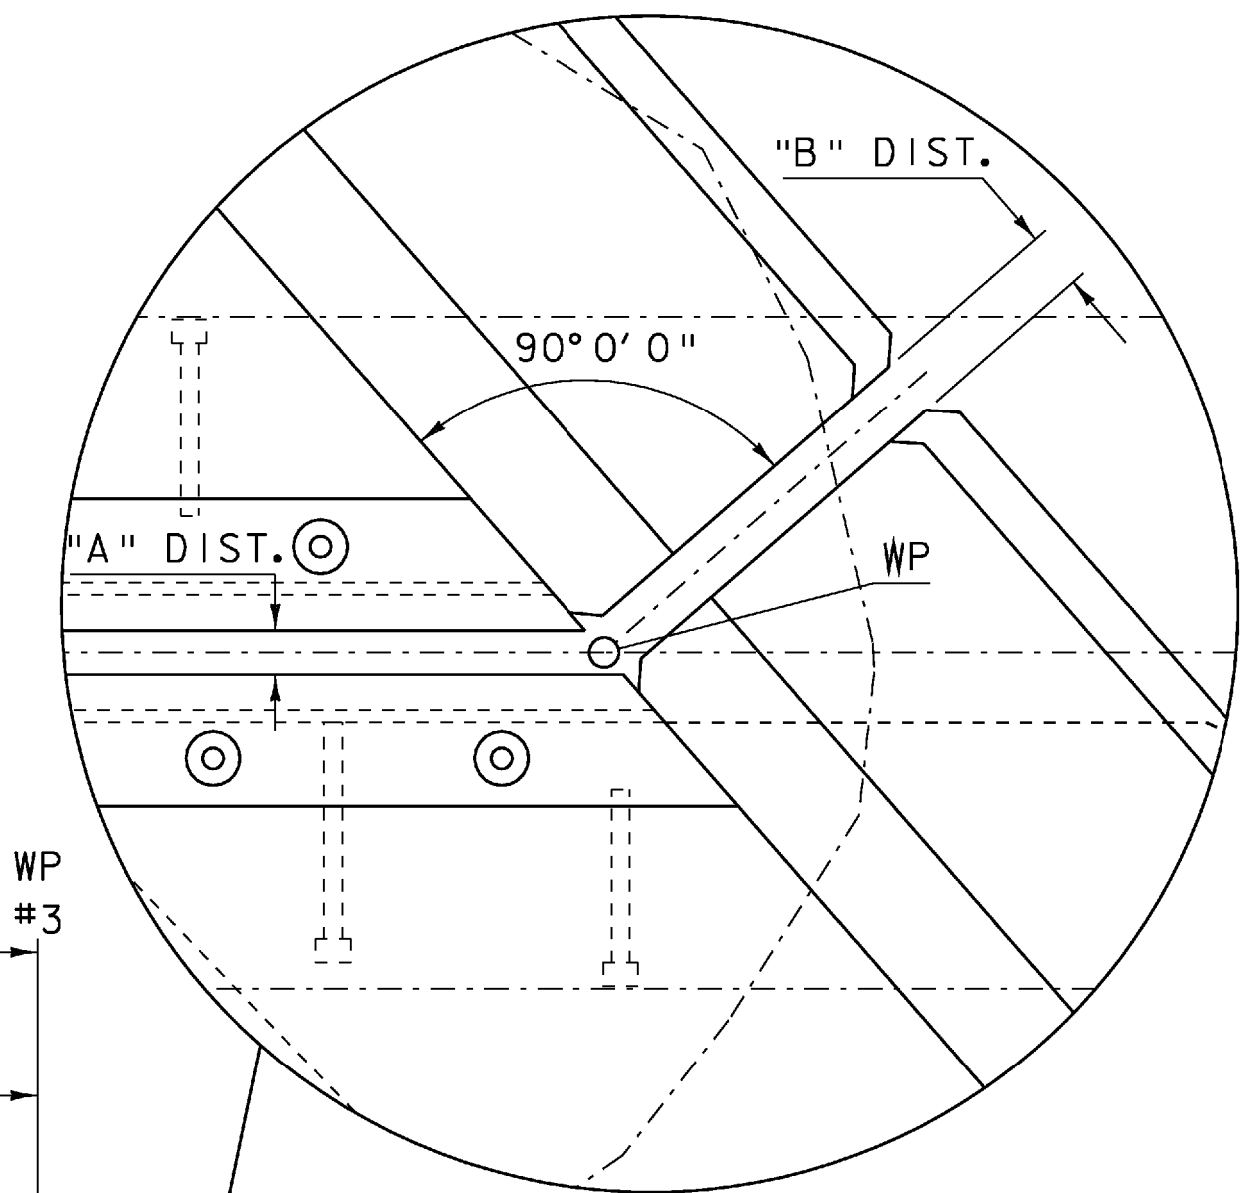

FASCIA DETAIL AT JOINT (TYP)

SCALE 1 1/2" = 1'-0"  
 9 6 3 0

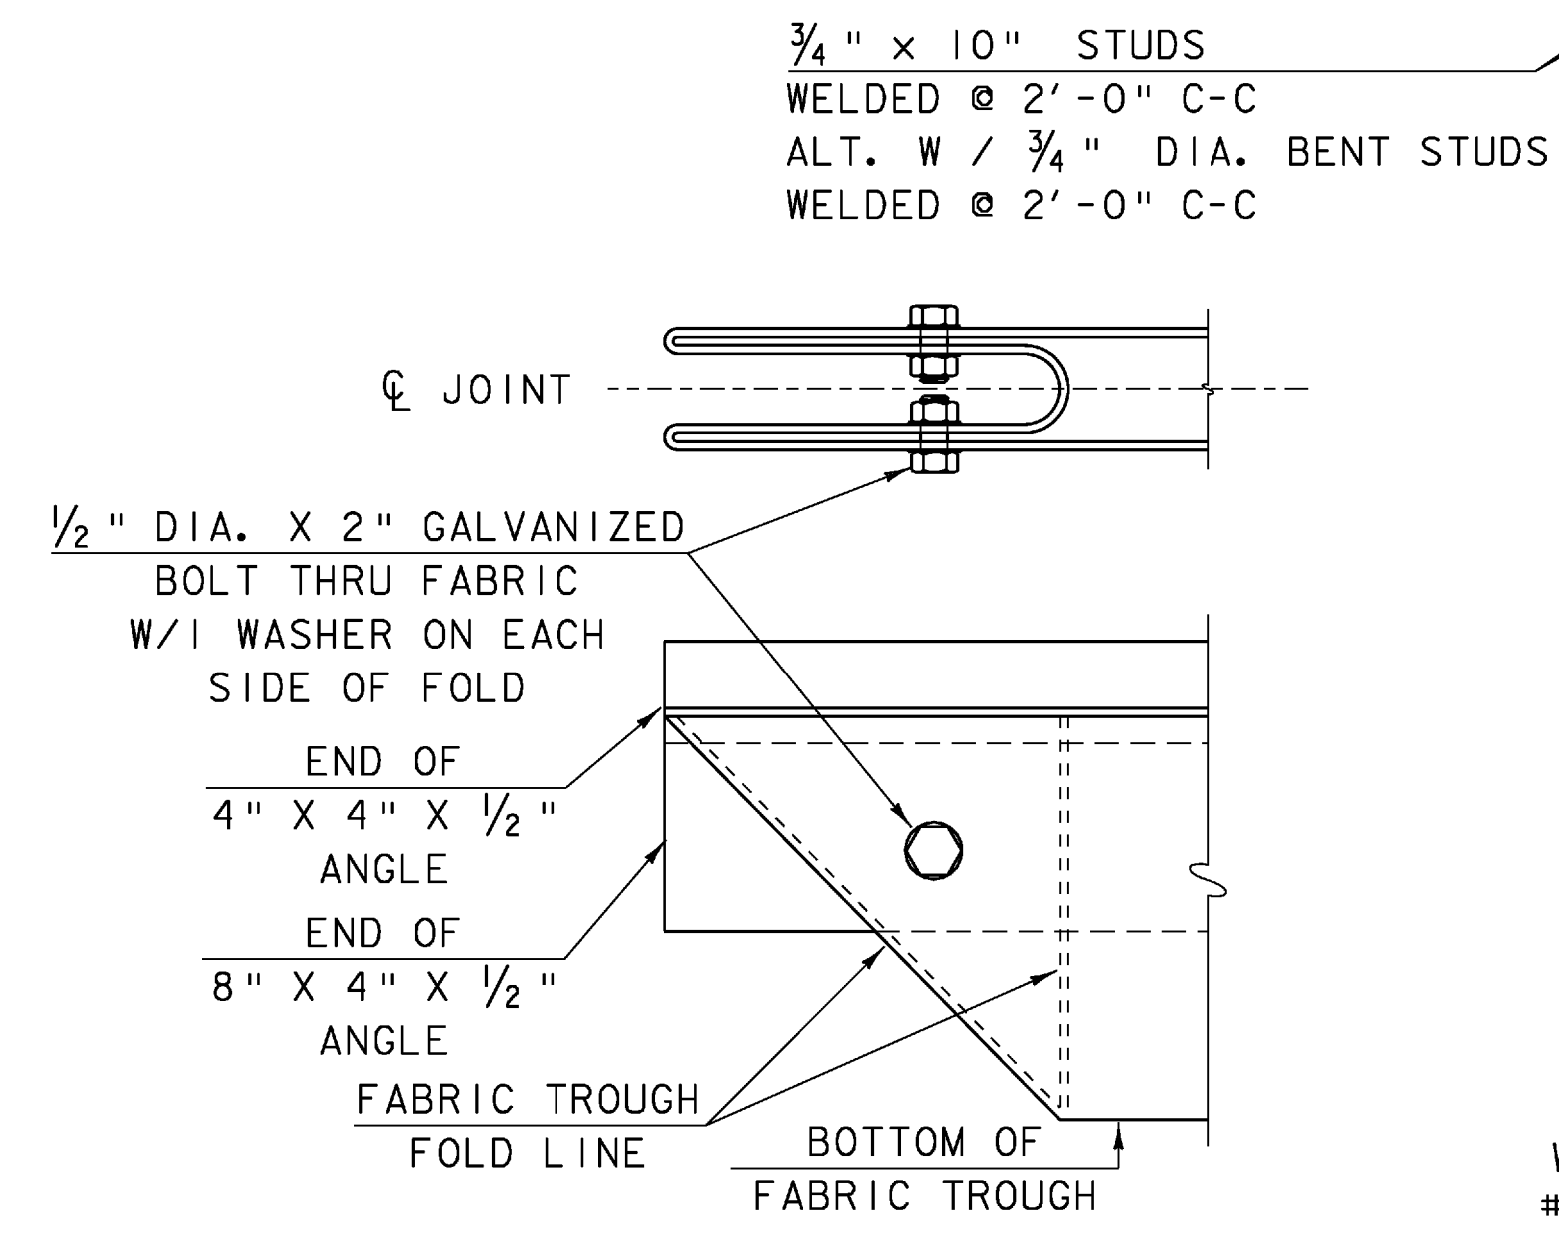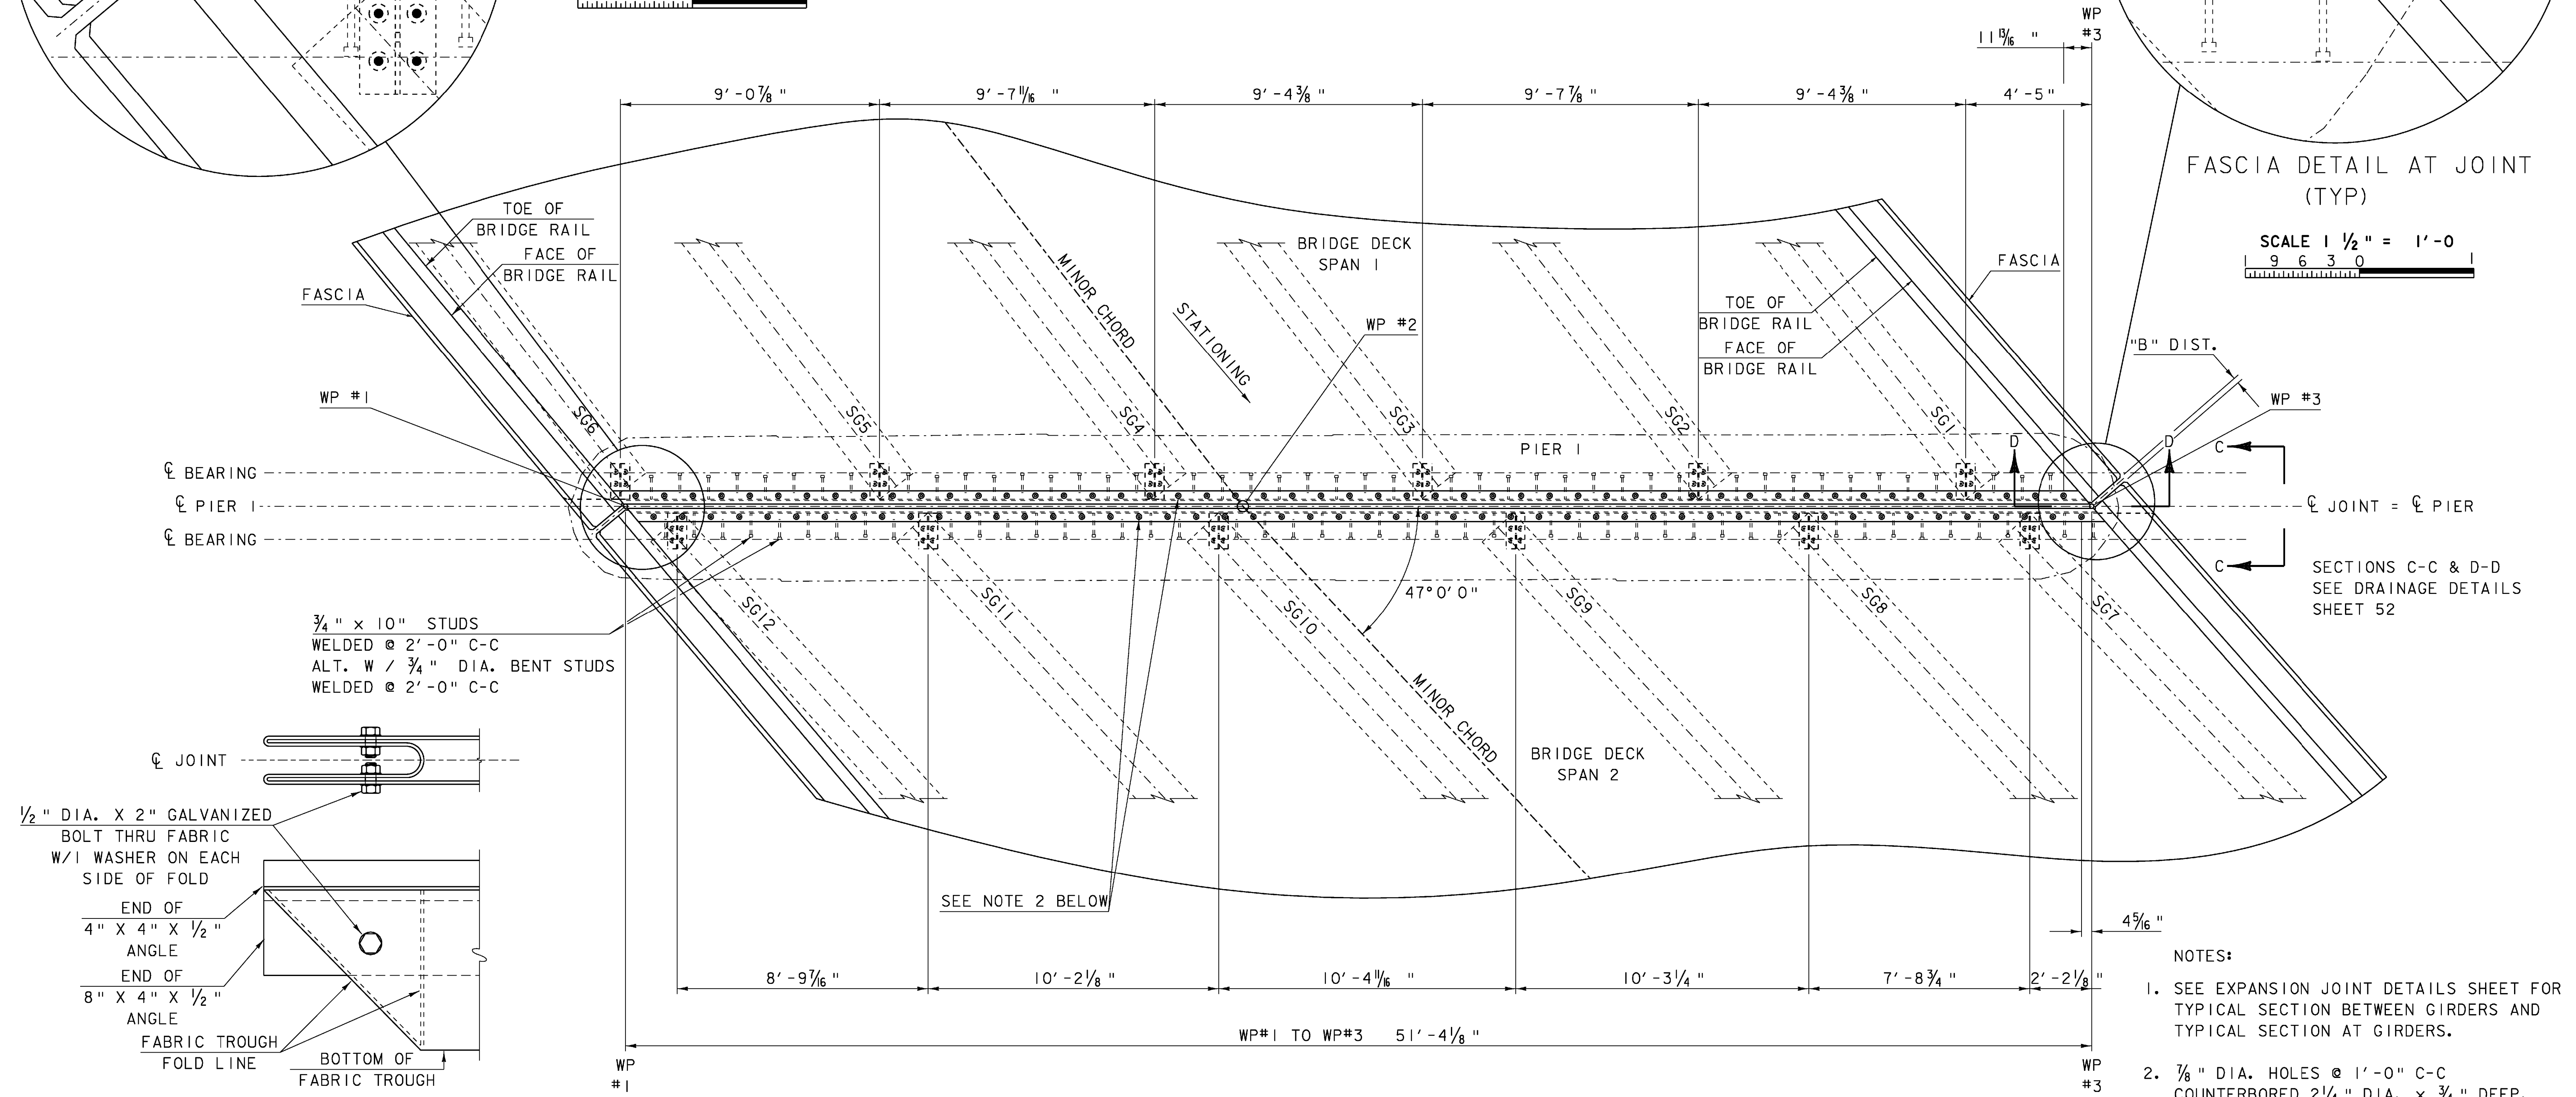

FOLDED TROUGH END DETAILS

NOT TO SCALE

NOTE: TROUGH FOLDED ON HIGH SIDE OF BRIDGE ONLY

EXPANSION JOINT @ PIER 1

SCALE 3/8" = 1'-0"  
 1 0 1 2 3 4


- NOTES:
- SEE EXPANSION JOINT DETAILS SHEET FOR TYPICAL SECTION BETWEEN GIRDERS AND TYPICAL SECTION AT GIRDERS.
  - 7/8" DIA. HOLES @ 1'-0" C-C COUNTERBORED 2 1/4" DIA. x 3/4" DEEP.

PROJECT: BERLIN	PROJECT NO.: IM 089-1 (20)
DESIGN FILE NAME: s99a270\structures\s99a270vt\joint.dgn	PLOT DATE: 05-DEC-2007
IPARM FILE NAME: S99a270vt\joint1.i	DRAWN BY: M. FESSEL
DESIGNED BY: VAOT	CHECKED BY: R.S. YOUNG
SQUAD LEADER: C.P. WILLIAMS	SHEET: 48 OF 104
EXPANSION JOINT @ PIER 1	

JOINT WORK POINTS						
WORK PT.	PIER	STATION	ELEV.	OFFSET	COORDINATES	
					N	E
#4	2	393+78.39	690.51	RT. 16' - 6 1/4"	36874.04	17014.66
#5	2	393+95.00	688.41	0	36868.82	16991.76
#6	2	394+18.49	685.48	LT. 22' - 6 1/4"	36861.61	16960.15

TEMP	"A" DIST.	"B" DIST.
105°F	1/2"	11/16" 3/4"
90°F	5/8"	+ 1/8"
75°F	3/4"	+ 1/16"
60°F	7/8"	+ 3/16" 1/4"
45°F	15/16"	1 1/4" 1/16"
30°F	1 1/16"	1 7/16" 9/16"
15°F	1 3/16"	1 9/16" 3/4"
0°F	1 5/16"	1 3/4" 15/16"
-15°F	1 7/16"	+ 15/16" 2 1/8"

"A" IS THE SETTING AFTER DEAD LOADS ARE PUT IN PLACE.

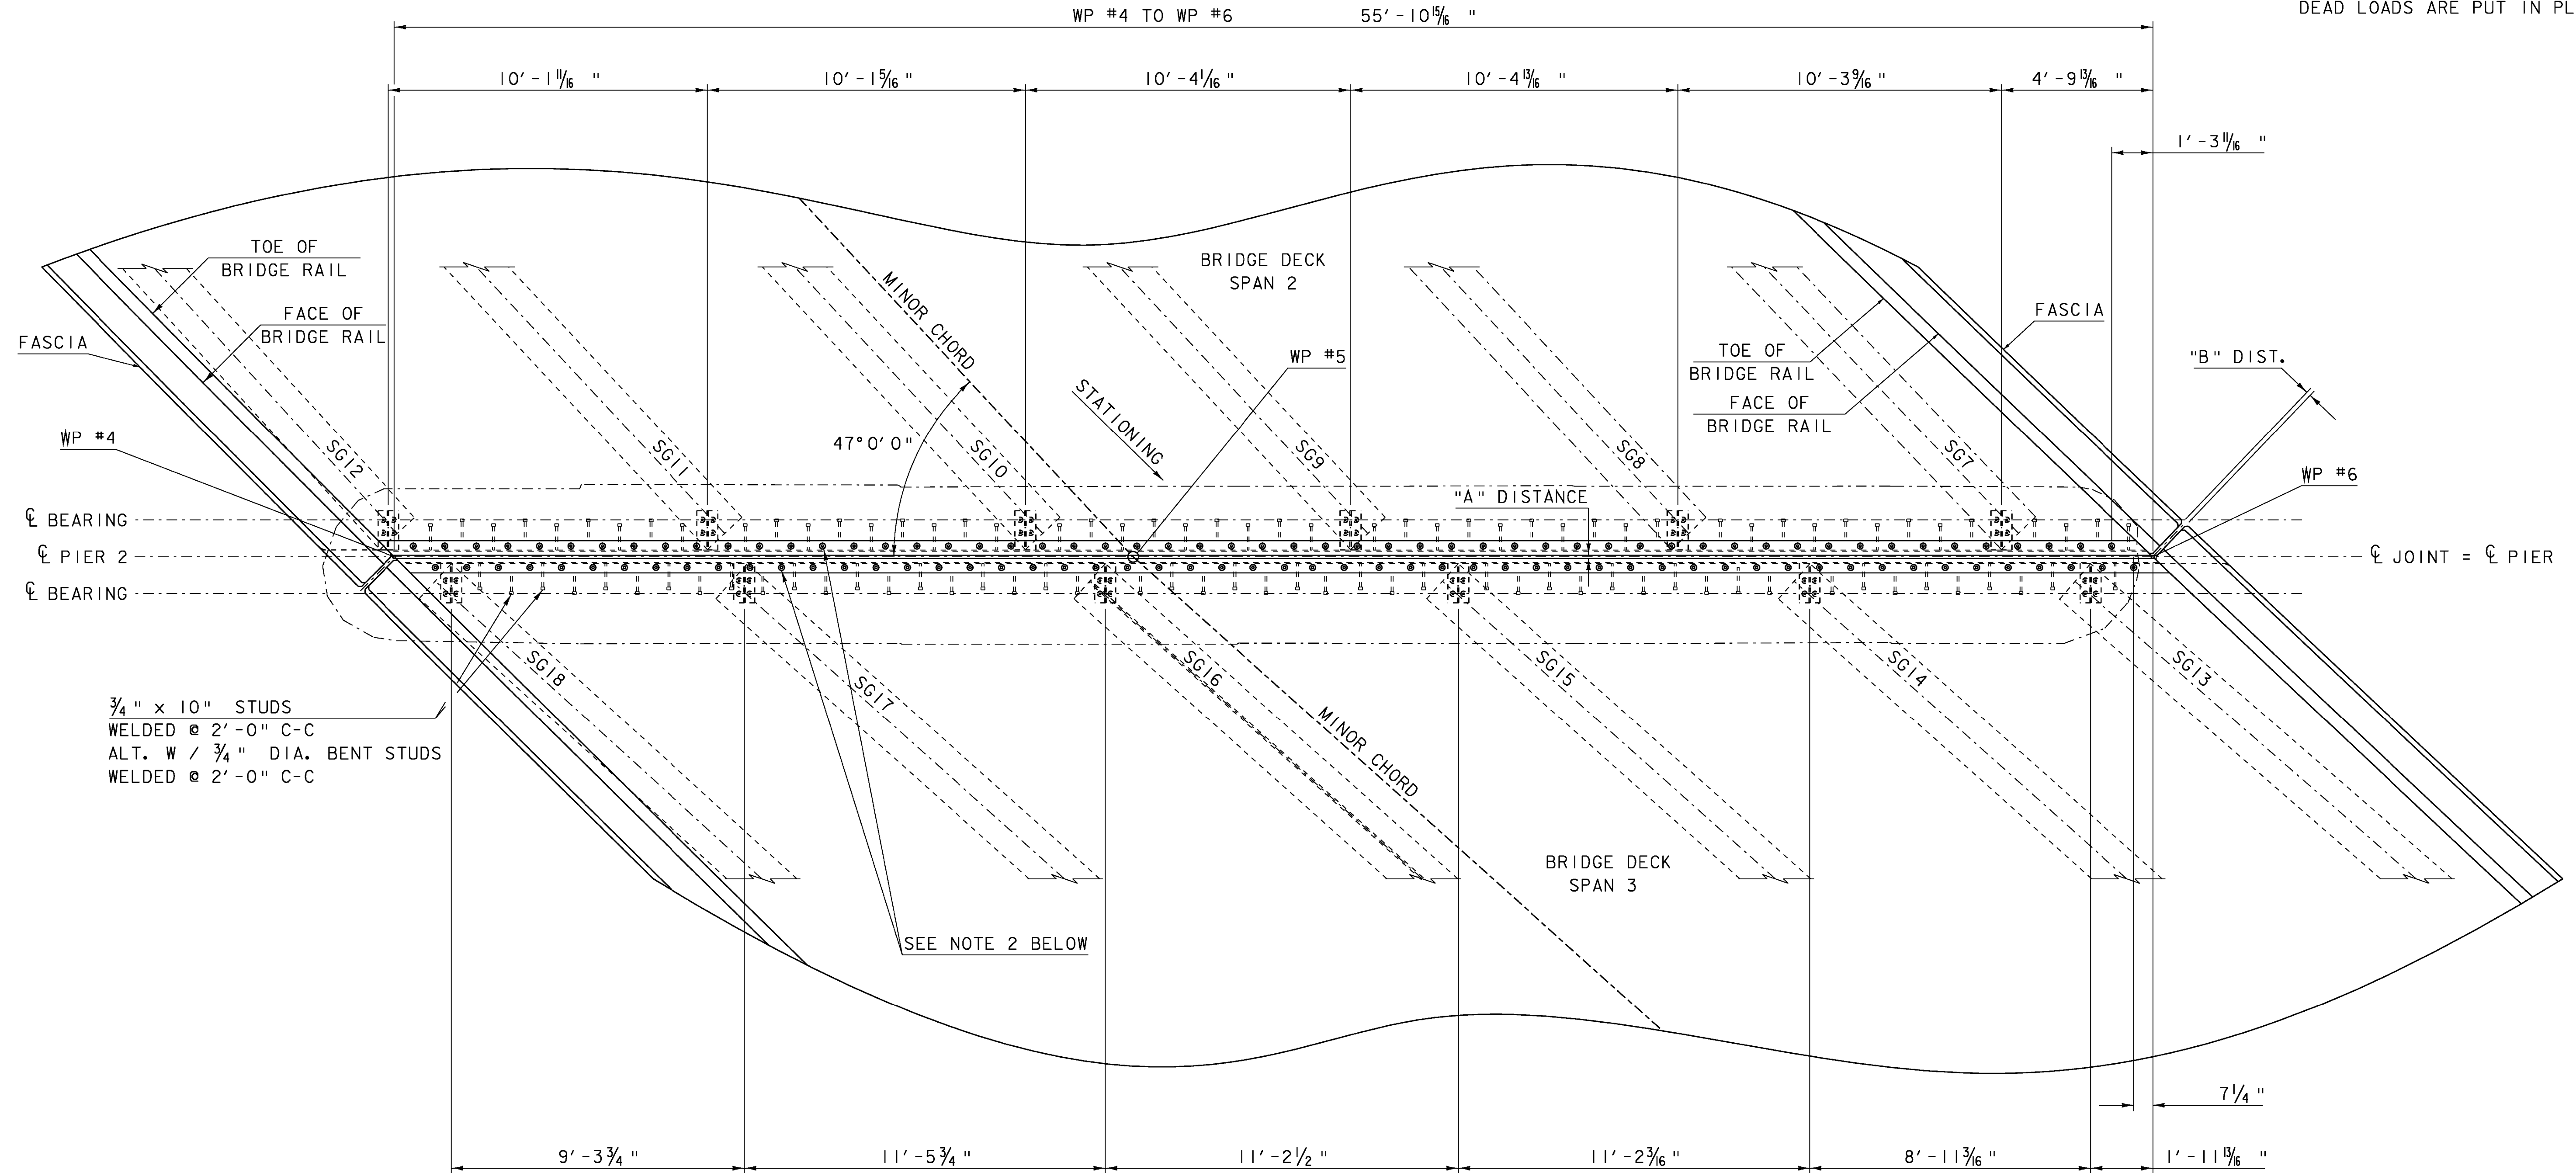

- NOTES:
- SEE EXPANSION JOINT DETAILS SHEET FOR TYPICAL SECTION BETWEEN GIRDERS AND TYPICAL SECTION AT GIRDERS.
  - 7/8" DIA. HOLES @ 1'-0" C-C COUNTERBORED 2 1/4" DIA. x 3/4" DEEP.


EXPANSION JOINT @ PIER 2  
 SCALE 3/8" = 1'-0"  
 1 0 1 2 3 4

PROJECT: BERLIN	PROJECT NO. # IM 089-1 (20)
DESIGN FILE NAME: s99a270\structures\s99a270vt\joint.dgn	PLOT DATE: 05-DEC-2007
IPARM FILE NAME: s99a270vt\joint2.1	DRAWN BY: M. FESSEL
DESIGNED BY: VAOT	CHECKED BY: R. S. YOUNG
SQUAD LEADER: C. P. WILLIAMS	SHEET: 49 OF 104
EXPANSION JOINT @ PIER 2	

JOINT WORK POINTS						
WORK PT.	PIER	STATION	ELEV.	OFFSET	COORDINATES	
					N	E
#7	3	292+27.81	705.09	RT. 22'-6 1/4"	36809.89	17247.72
#8	3	292+46.67	702.44	0	36804.39	17218.78
#9	3	292+60.95	700.46	LT. 16'-6 1/4"	36800.32	17197.37

TEMP	"A" DIST.	"B" DIST.
105°F	1/2"	1/16"
90°F	3/4"	1"
75°F	1"	1 5/16" 3/8"
60°F	1 5/16"	1 3/4" 1/16"
45°F	1 9/16"	2 1/16"
30°F	1 13/16"	2 3/8"
15°F	2 1/16"	2 3/4"
0°F	2 3/8"	3 1/8" 1/16"
-15°F	2 5/8"	3 1/2" 1/16"

"A" IS THE SETTING AFTER DEAD LOADS ARE PUT IN PLACE.

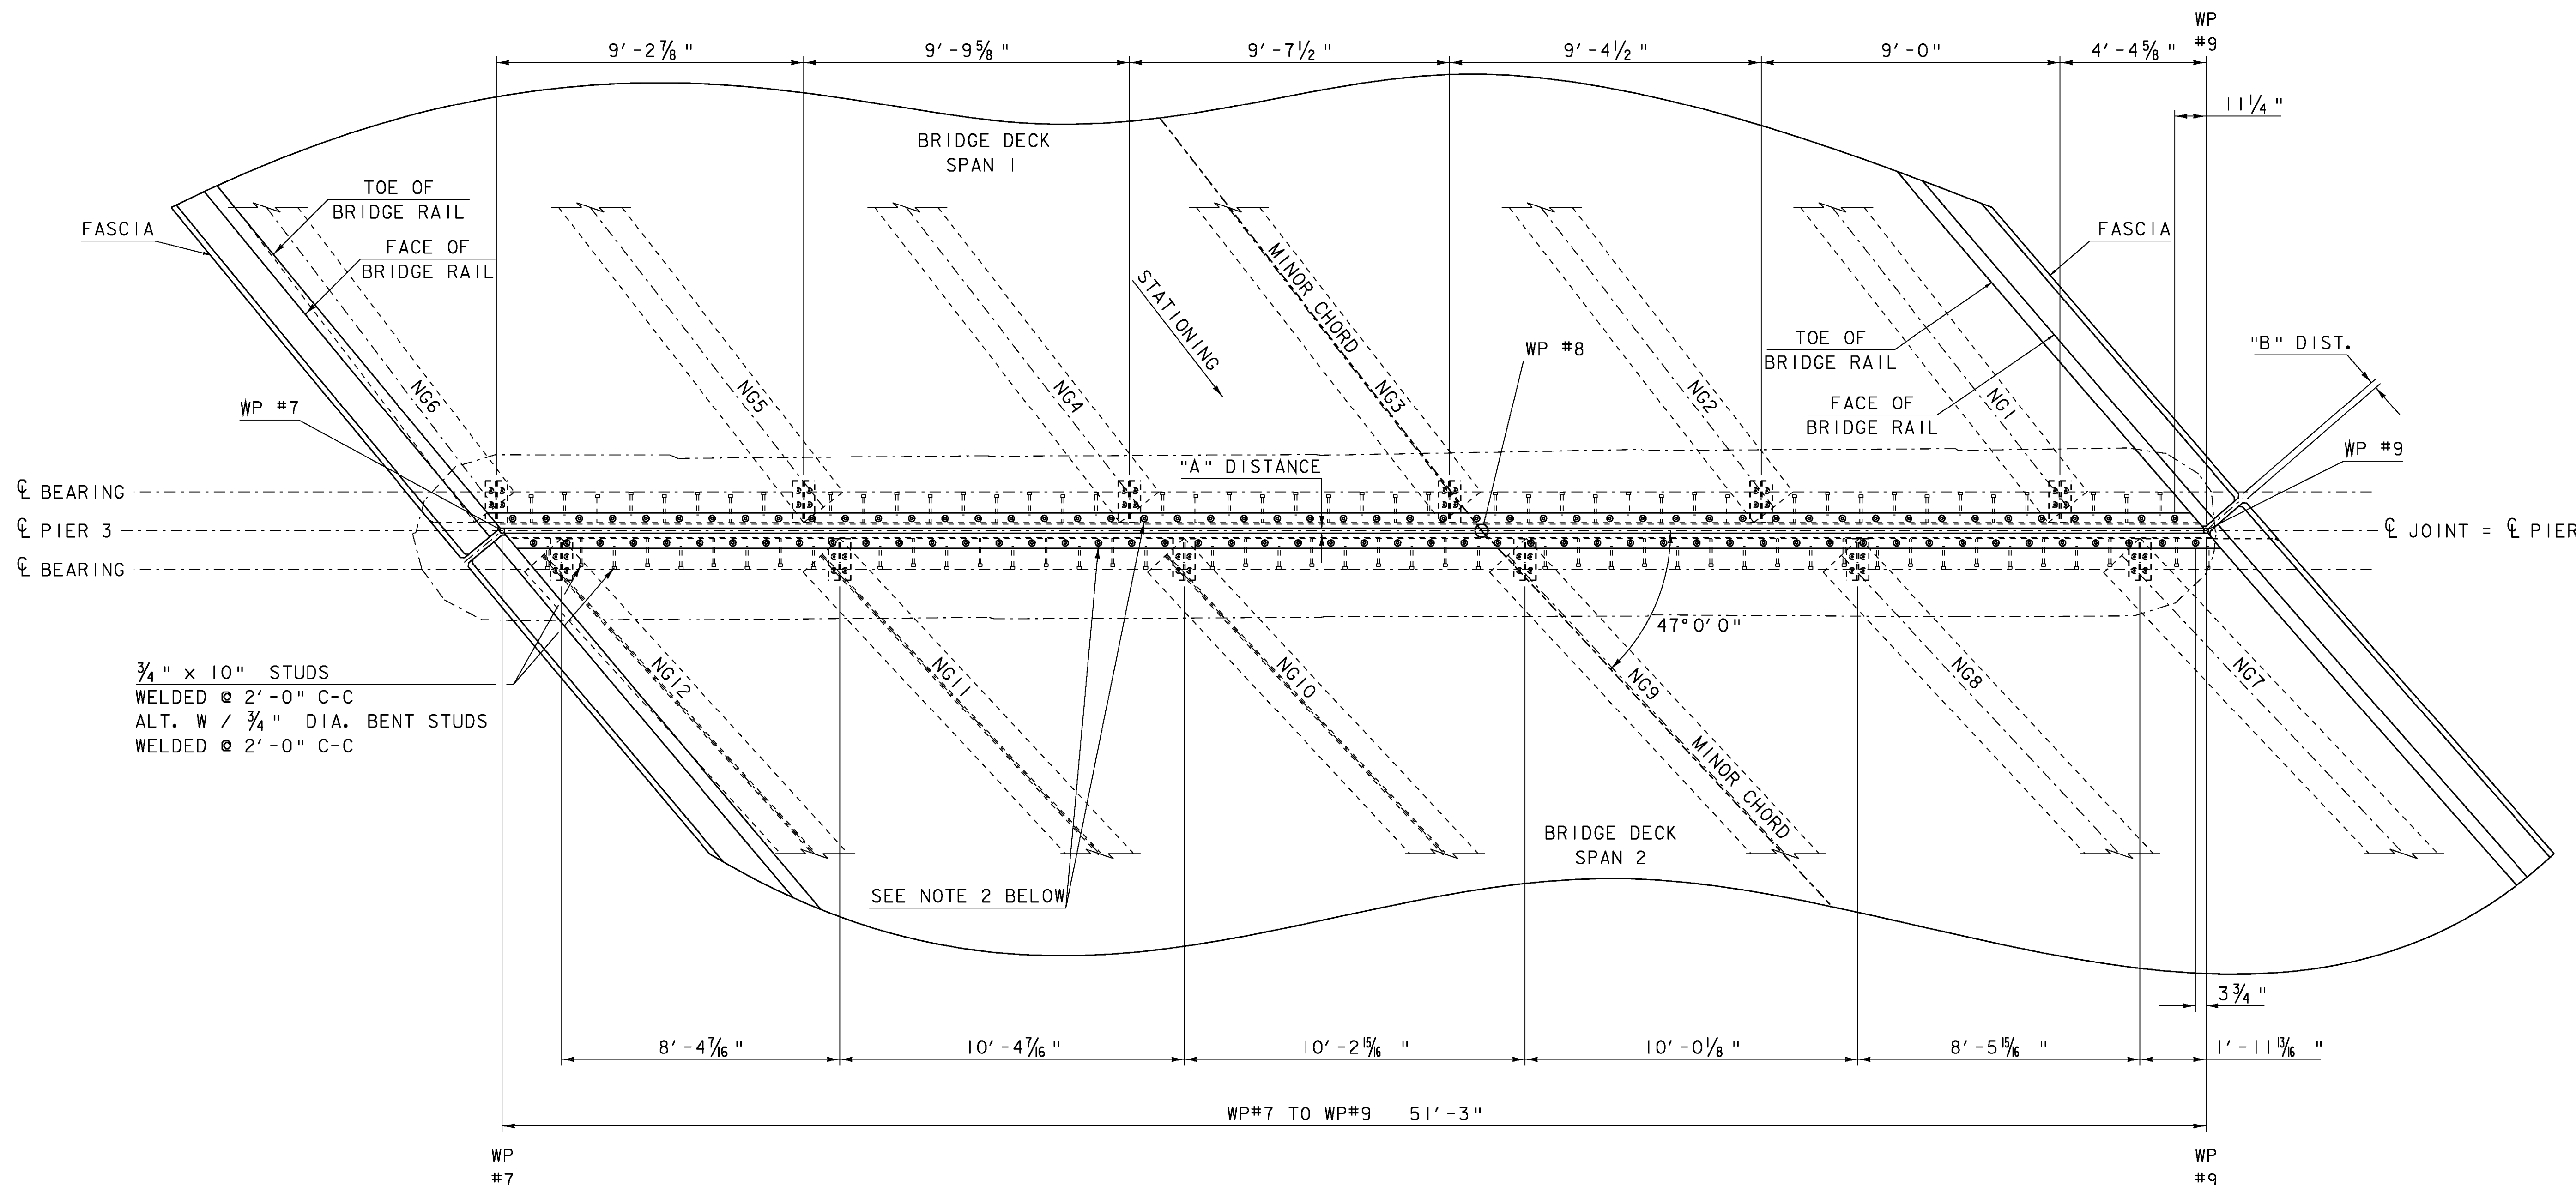


3/4" x 10" STUDS  
WELDED @ 2'-0" C-C  
ALT. W / 3/4" DIA. BENT STUDS  
WELDED @ 2'-0" C-C

SEE NOTE 2 BELOW

- NOTES:
- SEE EXPANSION JOINT DETAILS SHEET FOR TYPICAL SECTION BETWEEN GIRDERS AND TYPICAL SECTION AT GIRDERS.
  - 7/8" DIA. HOLES @ 1'-0" C-C COUNTERBORED 2 1/4" DIA. x 3/4" DEEP.

EXPANSION JOINT @ PIER 3

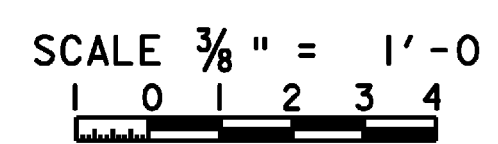


PROJECT: BERLIN	PROJECT NO.: IM 089-1 (20)
DESIGN FILE NAME: s99a270\structures\s99a270vt\joint.dgn	PLOT DATE: 05-DEC-2007
IPARM FILE NAME: s99a270vt\joint3.i	DRAWN BY: M. FESSEL
DESIGNED BY: VAOT	CHECKED BY: R. S. YOUNG
SQUAD LEADER: C.P. WILLIAMS	SHEET: 50 OF 104
EXPANSION JOINT @ PIER 3	

JOINT WORK POINTS						
WORK PT.	PIER	STATION	ELEV.	OFFSET	COORDINATES	
					N	E
#10	4	293+72.51	698.20	RT. 22'-6 1/4"	36898.00	17130.55
#11	4	293+95.00	695.38	0	36892.04	17099.17
#12	4	294+12.09	693.27	LT. 16'-6 1/4"	36887.61	17075.88

TEMP	"A" DIST.	"B" DIST.
105°F	1/2"	1/16" 3/4
90°F	5/8"	+ 7/8
75°F	3/4"	+ 1 1/16
60°F	7/8"	+ 3/16" 1/4
45°F	1 5/16"	1 1/4" 1/16
30°F	1 1/16"	1 7/16" 9/16
15°F	1 3/16"	1 9/16" 3/4
0°F	1 5/16"	1 7/16" 15/16
-15°F	1 7/16"	+ 15/16" 2 1/8

"A" IS THE SETTING AFTER DEAD LOADS ARE PUT IN PLACE.

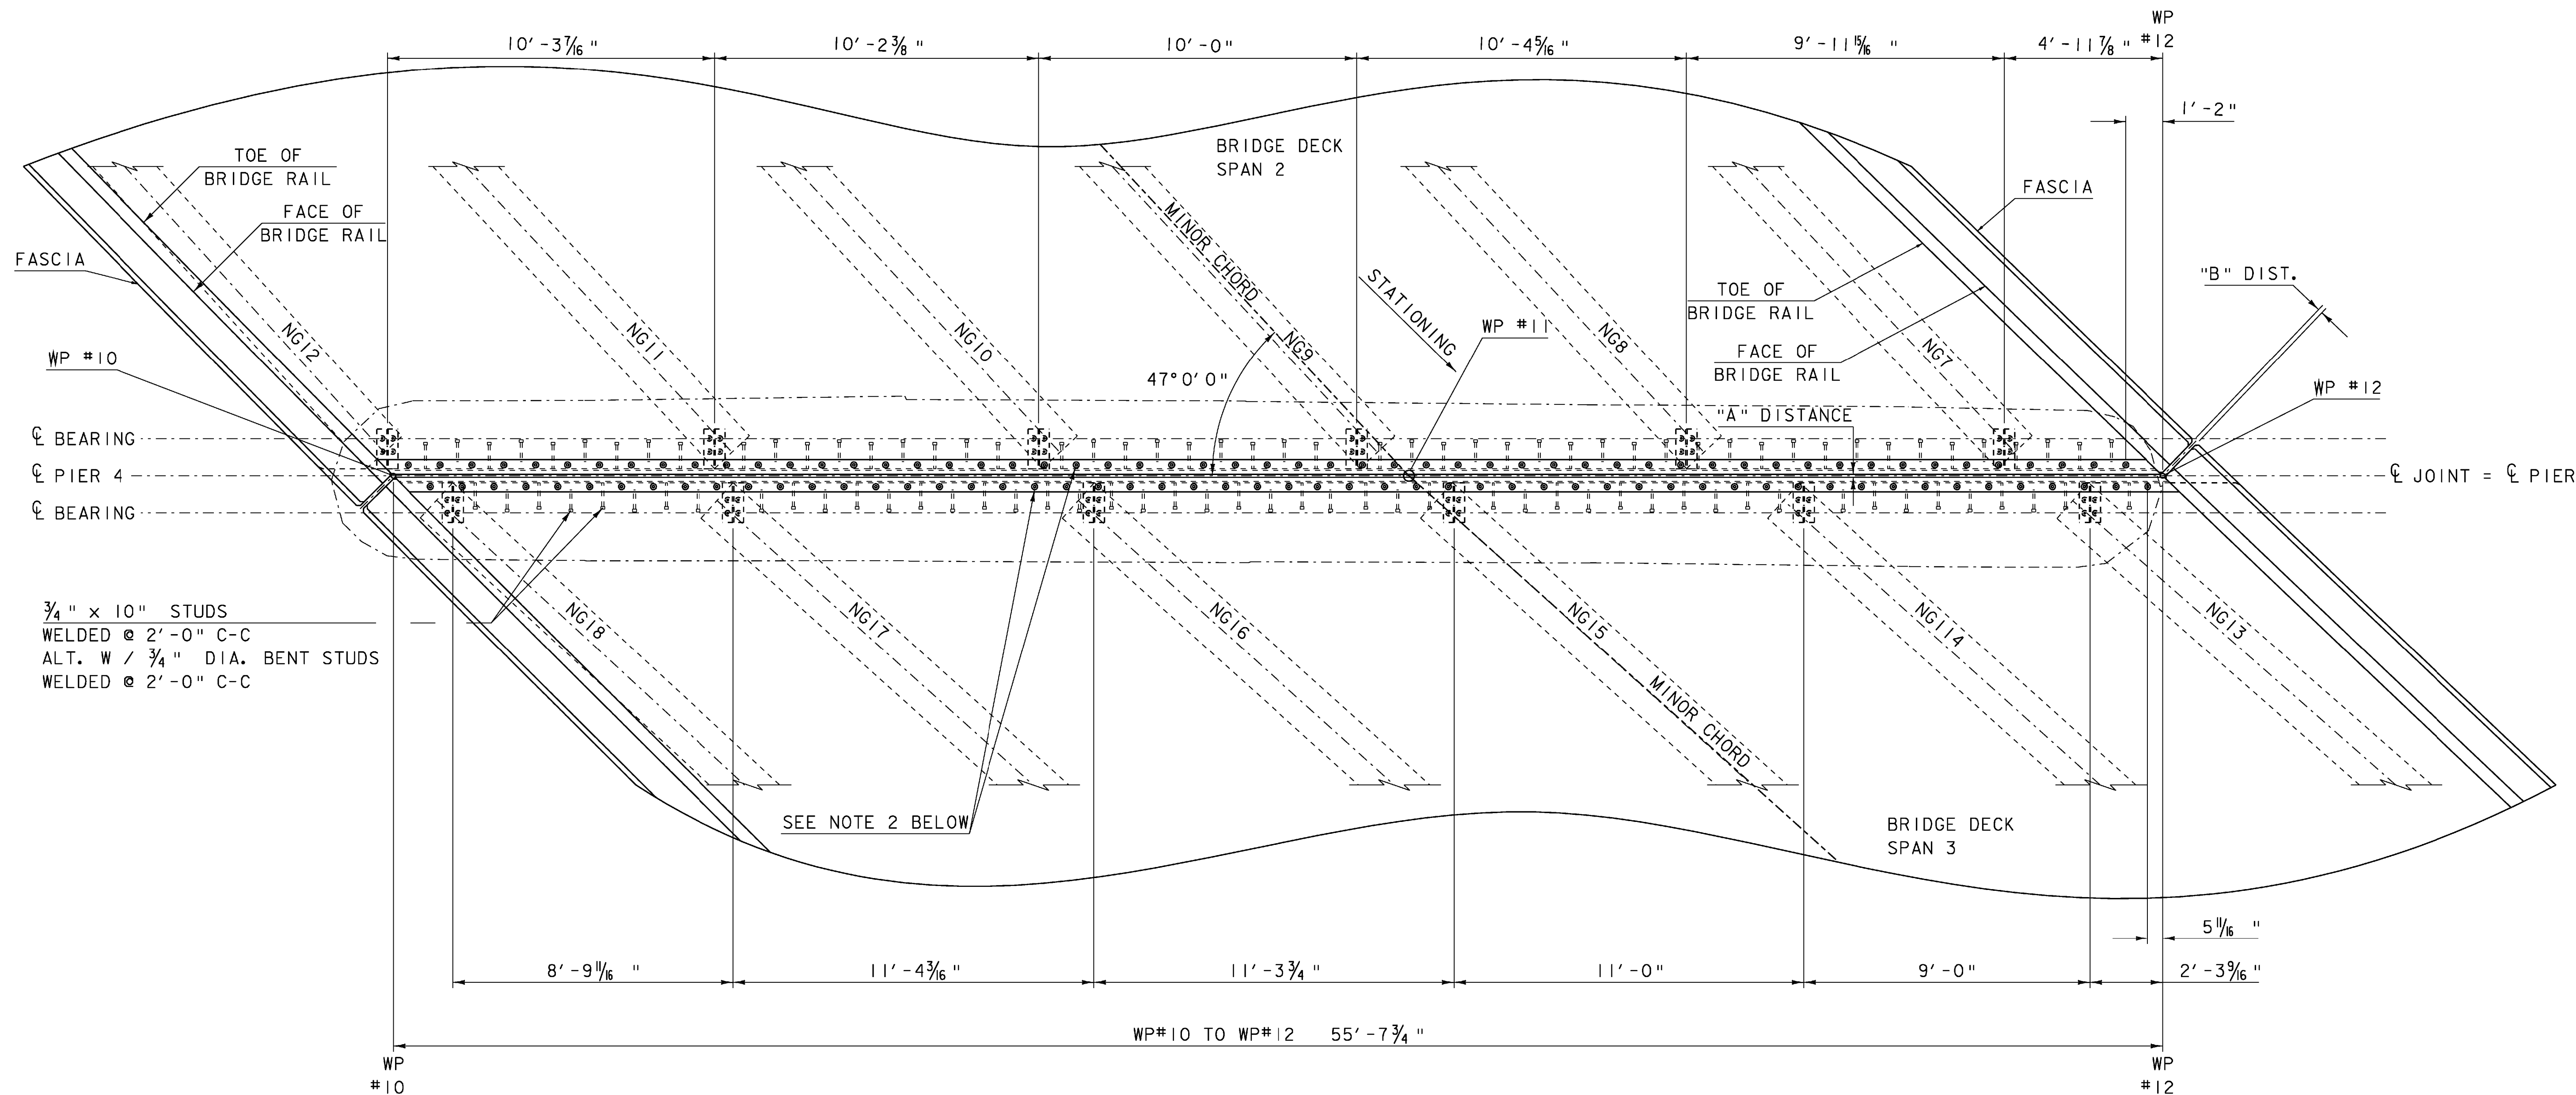

3/4" x 10" STUDS  
 WELDED @ 2'-0" C-C  
 ALT. W / 3/4" DIA. BENT STUDS  
 WELDED @ 2'-0" C-C

SEE NOTE 2 BELOW

NOTES:

- SEE EXPANSION JOINT DETAILS SHEET FOR TYPICAL SECTION BETWEEN GIRDERS AND TYPICAL SECTION AT GIRDERS.
- 7/8" DIA. HOLES @ 1'-0" C-C COUNTERBORED 2 1/4" DIA. x 3/4" DEEP.


EXPANSION JOINT @ PIER 4

SCALE 3/8" = 1'-0"  
 1 0 1 2 3 4


PROJECT: BERLIN	PROJECT NO.: IM 089-1 (20)
DESIGN FILE NAME: s99a270\structures\s99a270vt\joint.dgn	PLOT DATE: 05-DEC-2007
IPARM FILE NAME: s99a270vt\joint4.i	DRAWN BY: M. FESSEL
DESIGNED BY: VAOT	CHECKED BY: R. S. YOUNG
SQUAD LEADER: C.P. WILLIAMS	SHEET: 51 OF 104
EXPANSION JOINT @ PIER 4	

DRAINAGE SYSTEM NOTES


1. ALL PLATES, BARS, OR ANGLES USED FOR DOWNSPOUT ATTACHMENT SHALL CONFORM TO AASHTO M 270M/M 270, GRADE 36 AND SHALL BE GALVANIZED PER AASHTO M 111M/M 111.
2. ALL BOLTS AND RELATED HARDWARE SHALL BE ASTM A307 AND SHALL BE GALVANIZED IN ACCORDANCE WITH AASHTO M 232M/M 232.
3. REMOVAL AND REPLACEMENT OF THE DRAINAGE SYSTEM SHALL BE PAID FOR UNDER ITEM 900.640 "SPECIAL PROVISION (BRIDGE FIBERGLASS DRAIN SYSTEM)." SEE SPECIAL PROVISIONS FOR MORE INFORMATION.
4. THE STONE FILL CHANNEL SHALL BE CONSTRUCTED LIKE RIPRAP OUTLET PROTECTION EXAMPLE (SEE EPSC DETAIL SHEET 2). PAYMENT FOR THE STONE FILL SHALL BE UNDER THE ITEM 613.11, "STONE FILL, TYPE 11." PAYMENT FOR THE CONCRETE PAD SHALL BE UNDER ITEM 501.34, "CONCRETE, HIGH PERFORMANCE CLASS B". PAYMENT FOR GEOTEXTILE SHALL BE UNDER ITEM 649.31, "GEOTEXTILE UNDER STONE FILL". PAYMENT FOR EXCAVATION SHALL BE INCLUDED UNDER ITEM 203.15 "COMMON EXCAVATION".
5. THE INSTALLATION OF THE FIBERGLASS PIPE SHALL OCCUR AFTER THE EXPANSION JOINT HAS BEEN SET, AND ANCHORED IN PLACE.

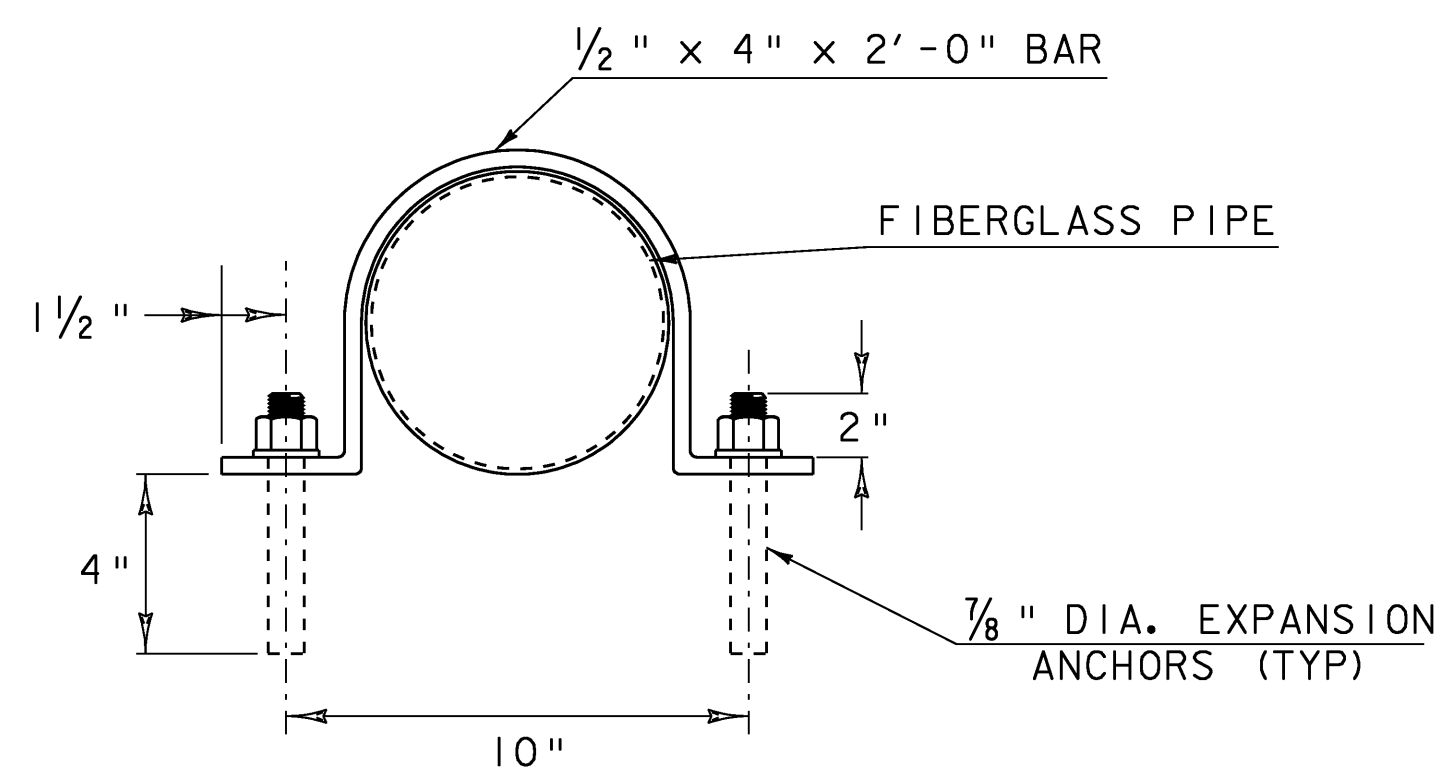


DETAILS FOR ATTACHING DOWNSPOUT TO PIER

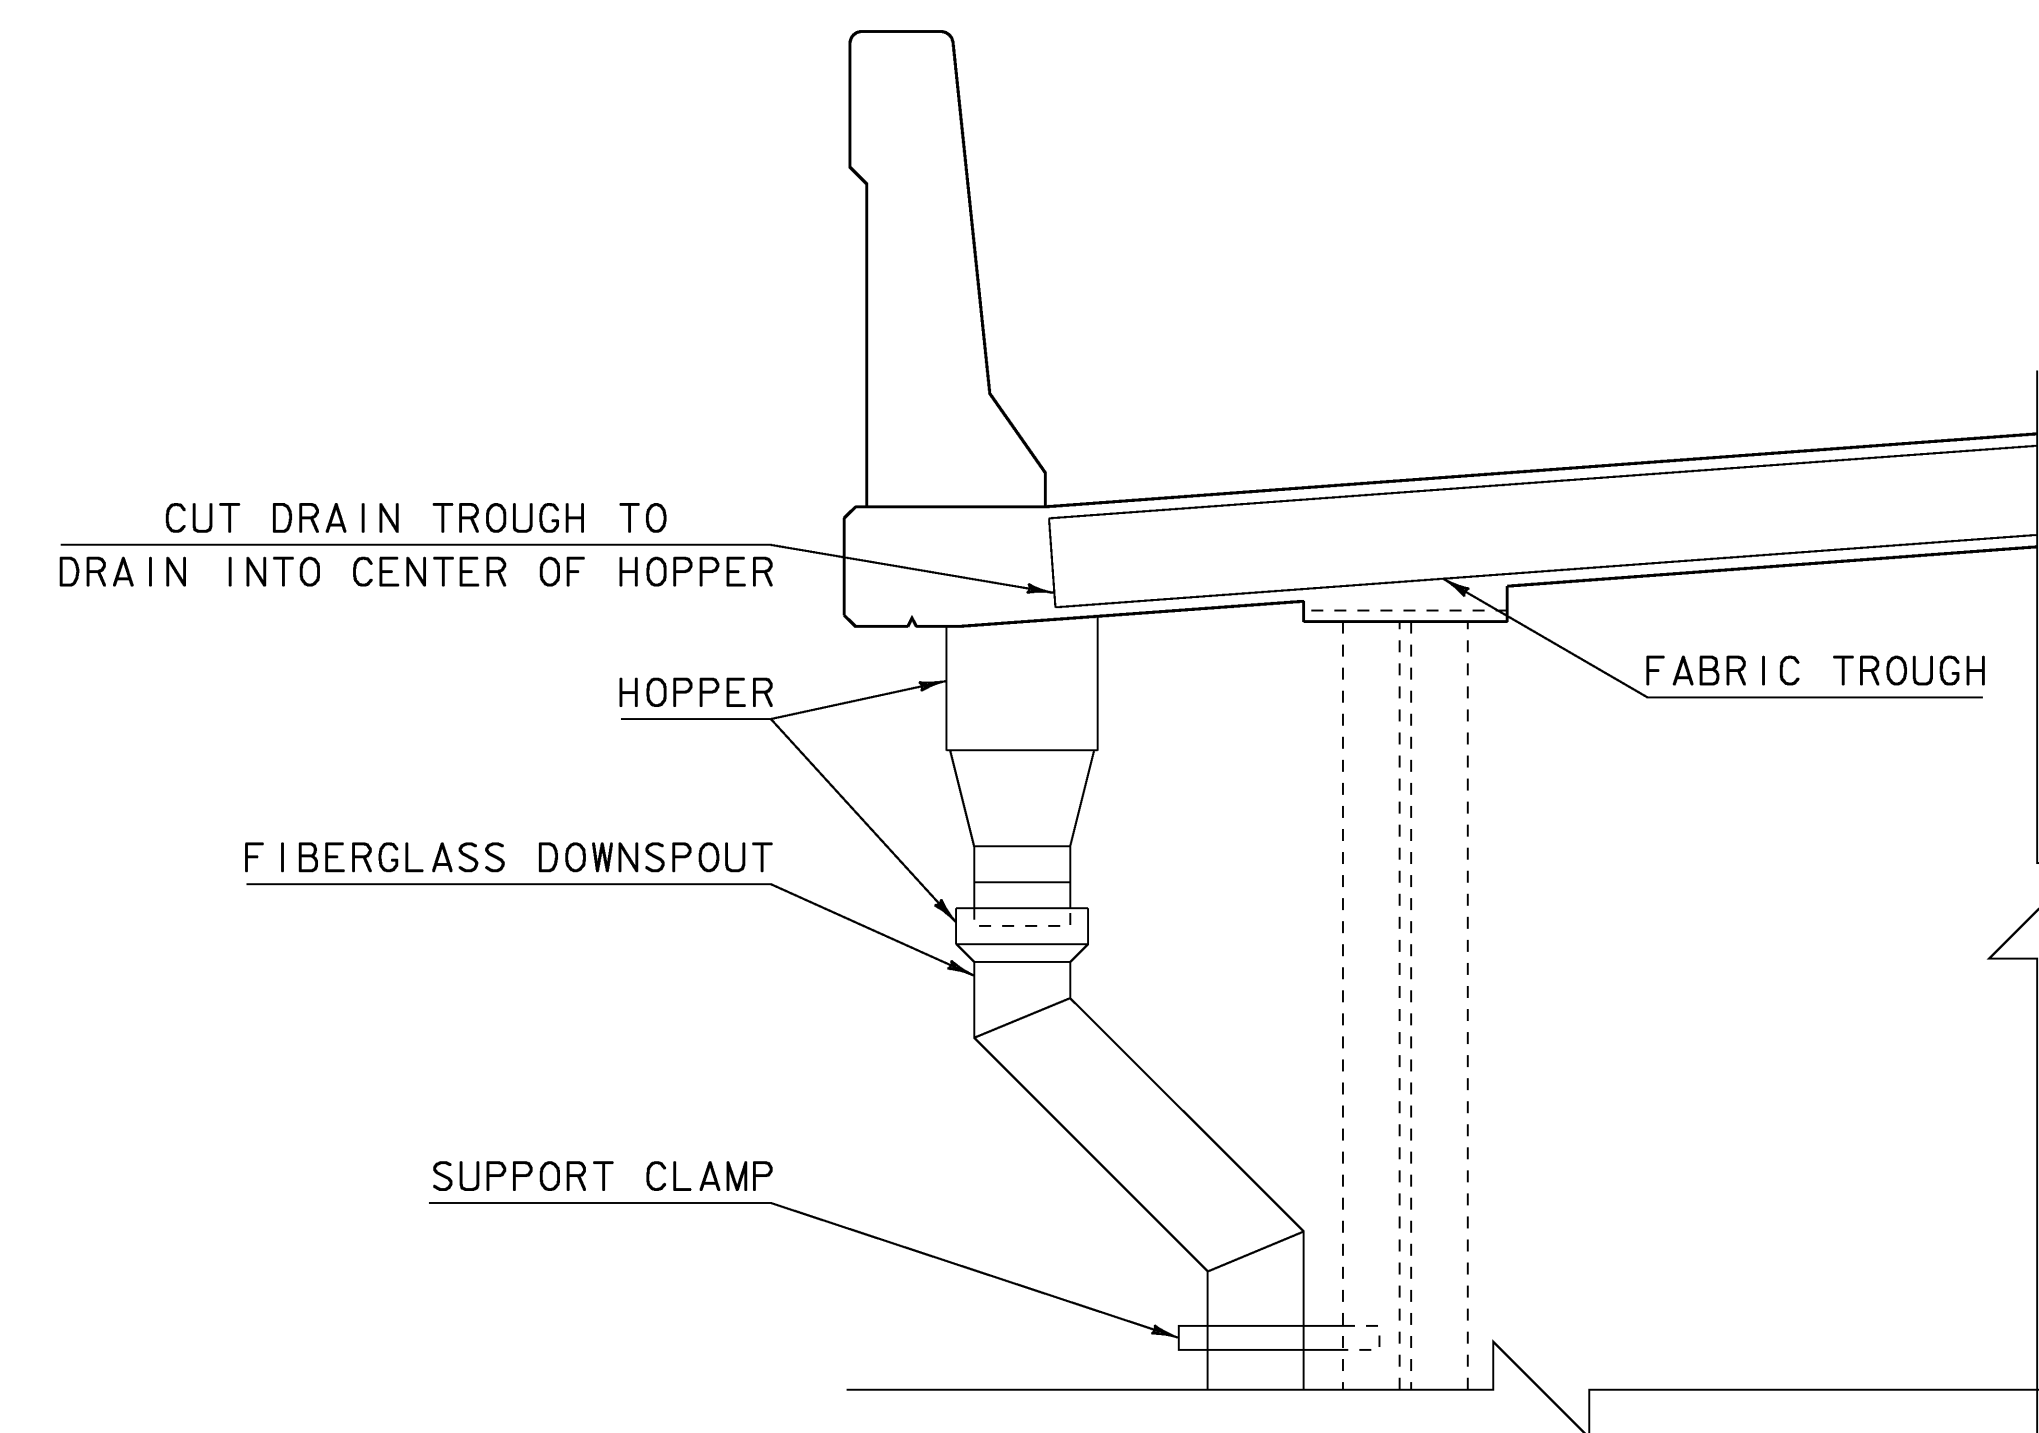


SECTION D-D W/ DRAINAGE SYSTEM  
(SEE PIER #1 EXPANSION JOINT DETAIL, SHEET 48)

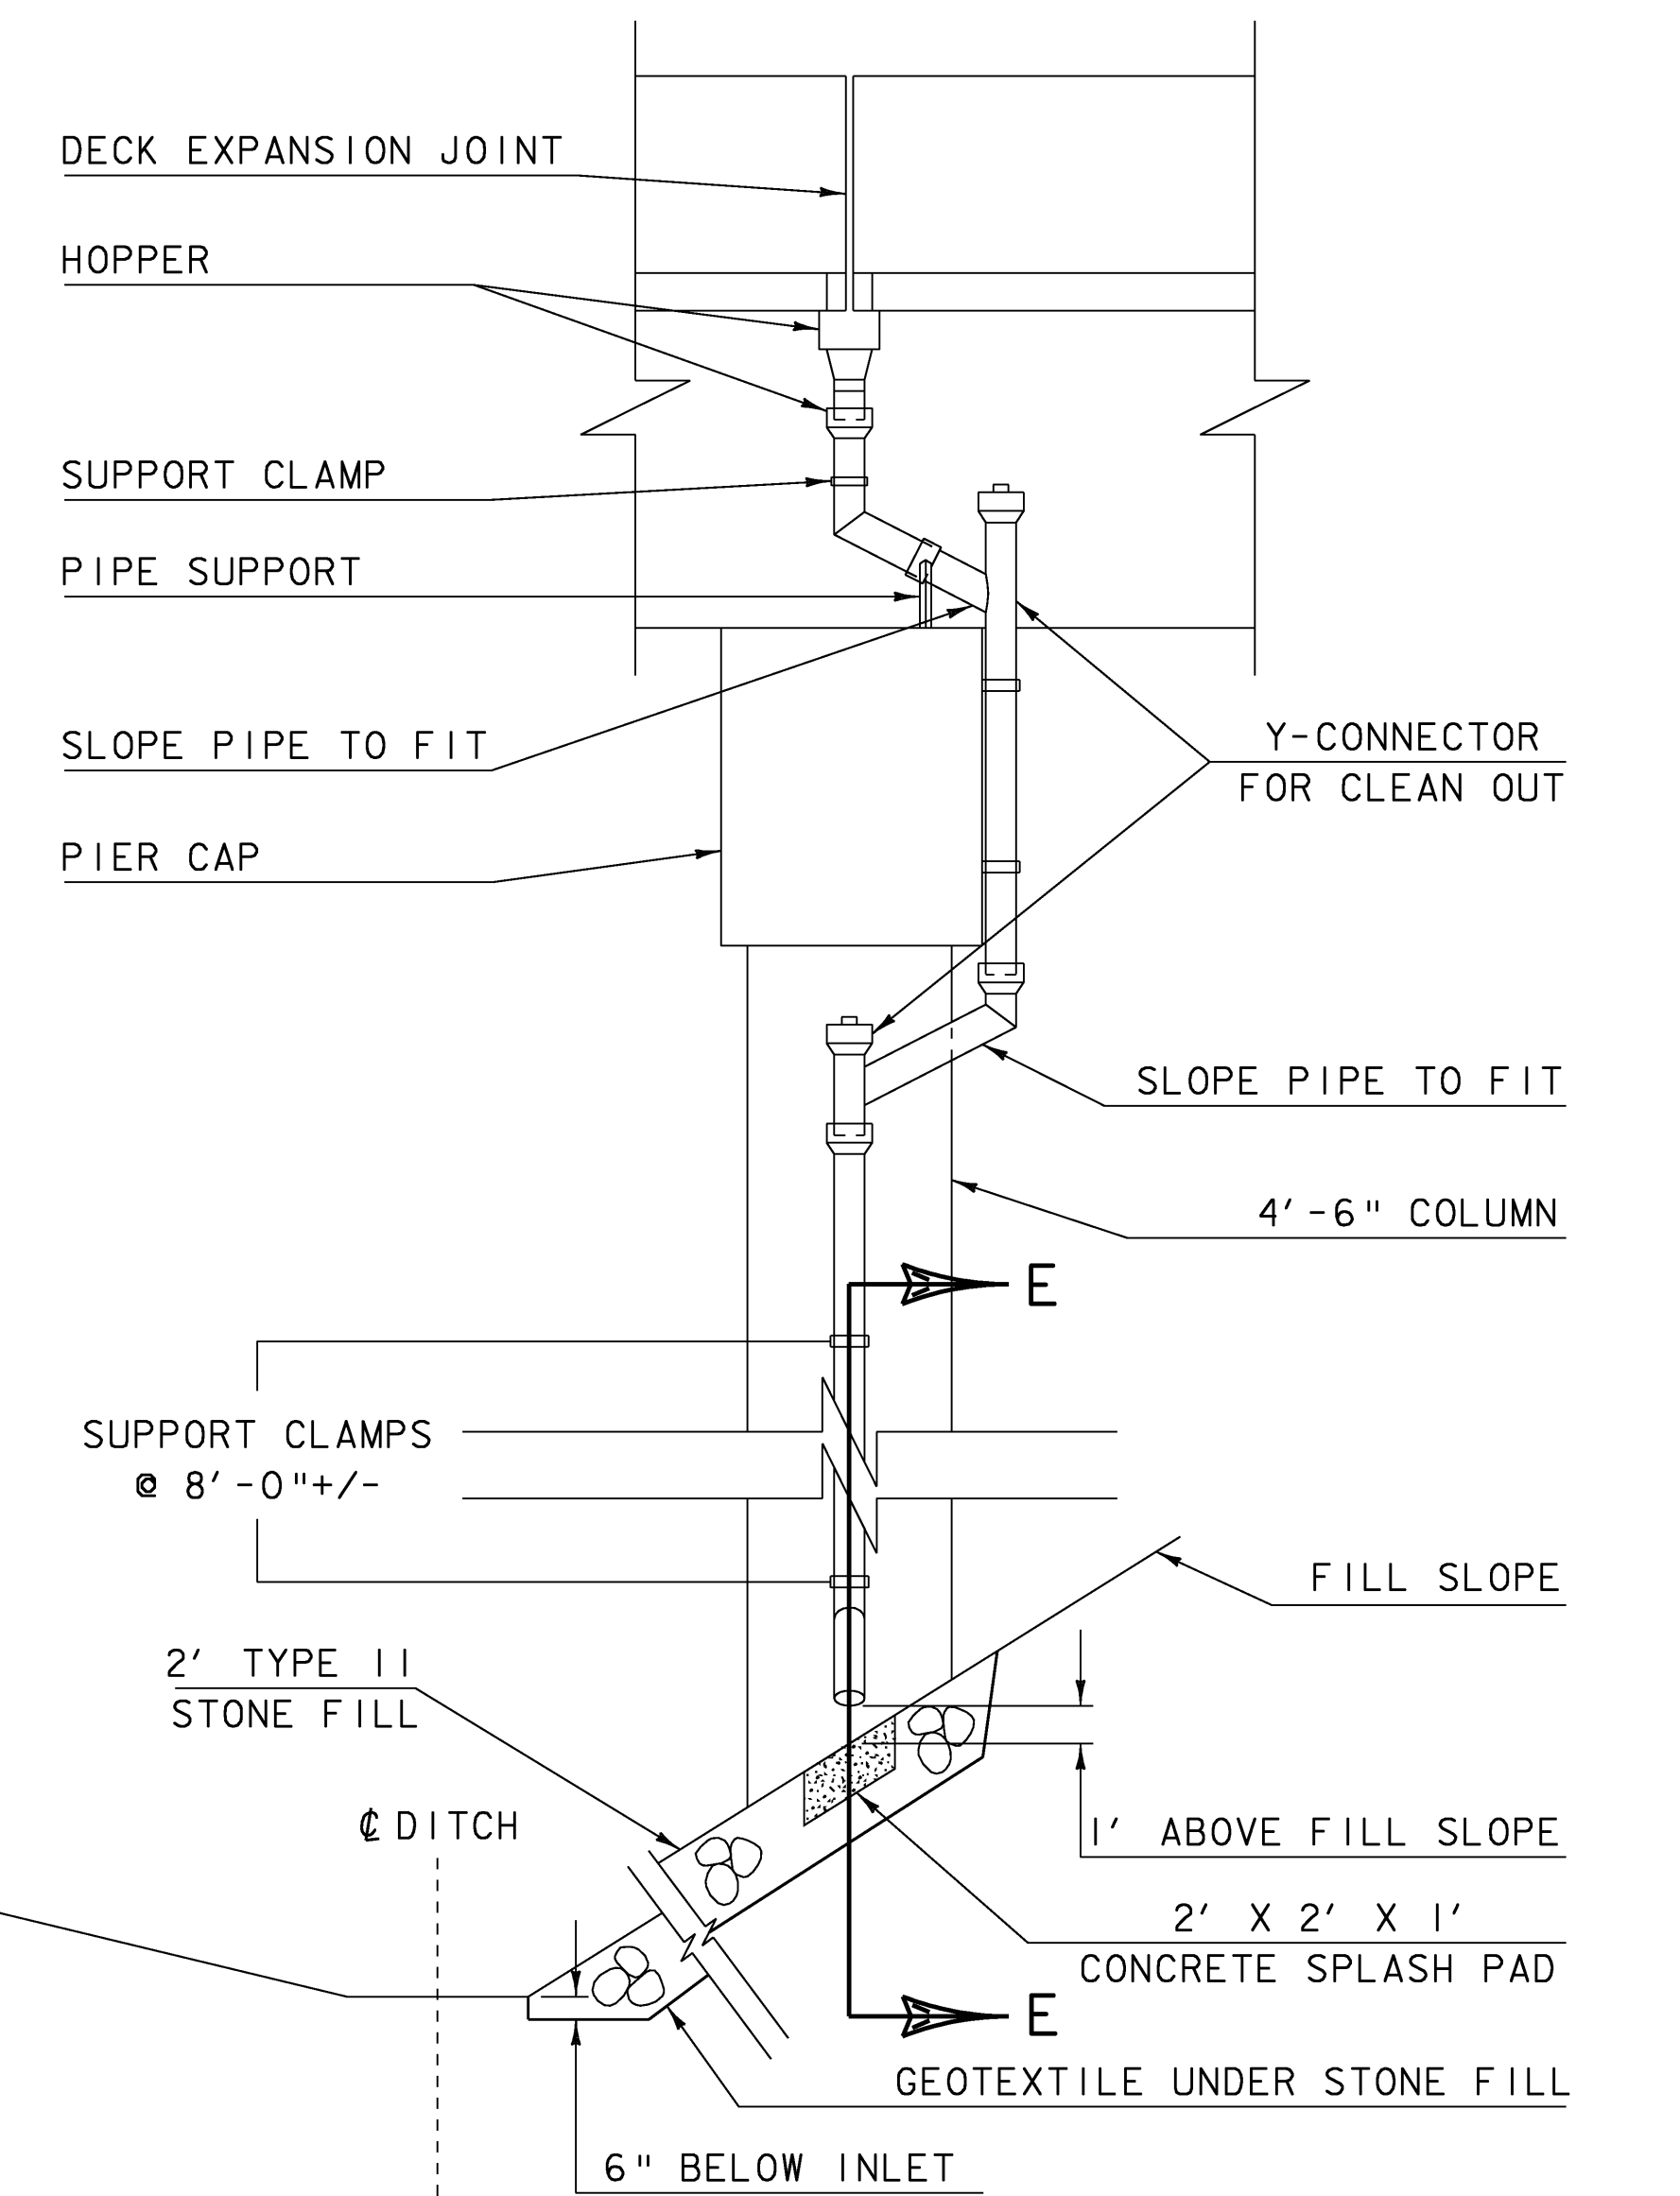

SECTION C-C W/ DRAINAGE SYSTEM  
(SEE PIER #1 EXPANSION JOINT DETAIL, SHEET 48)  
N. T. S.

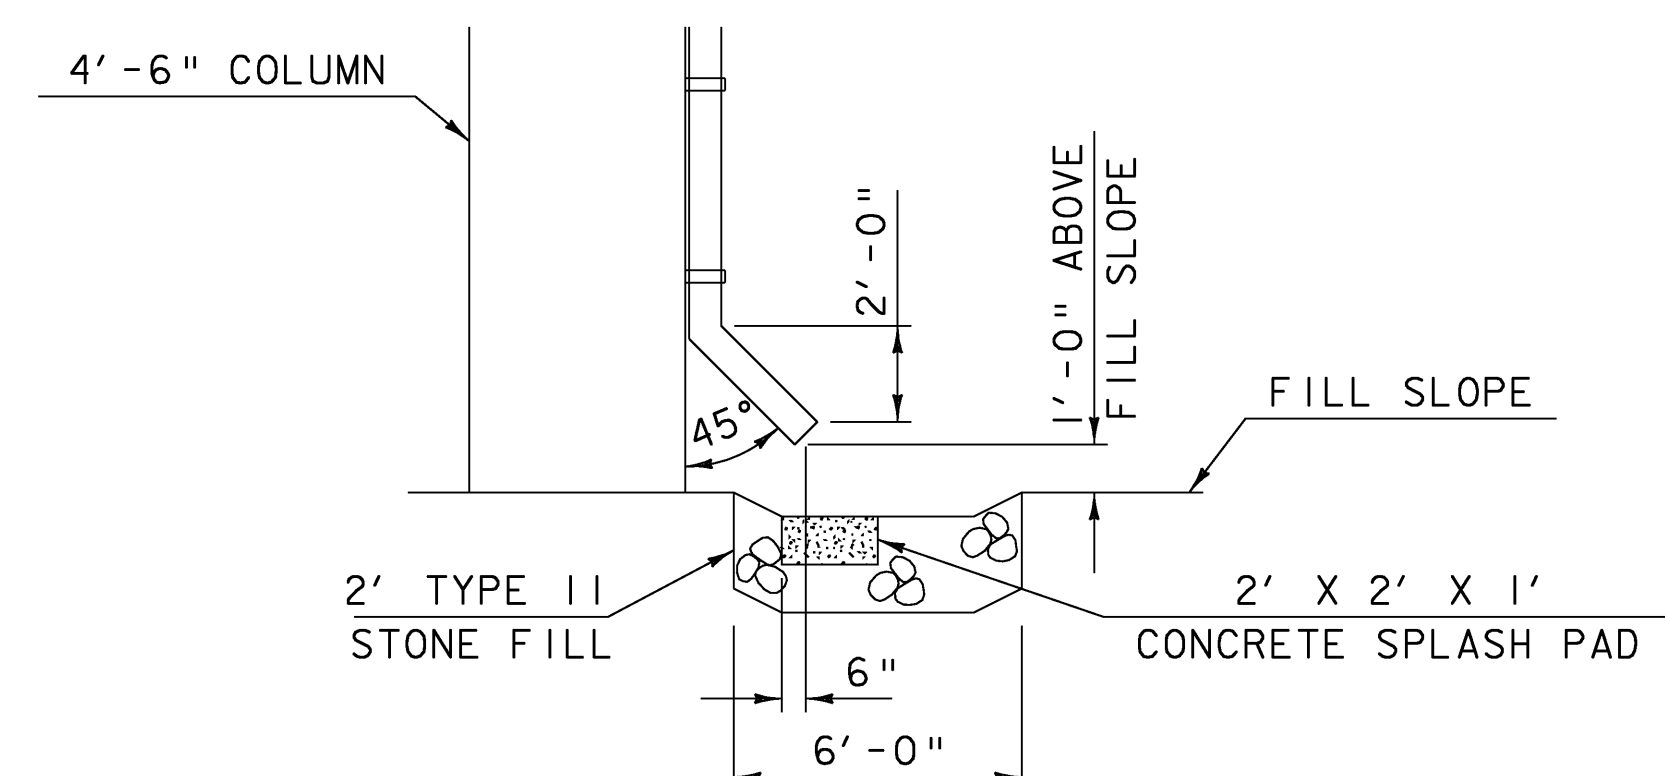




SECTION E-E  
N. T. S.

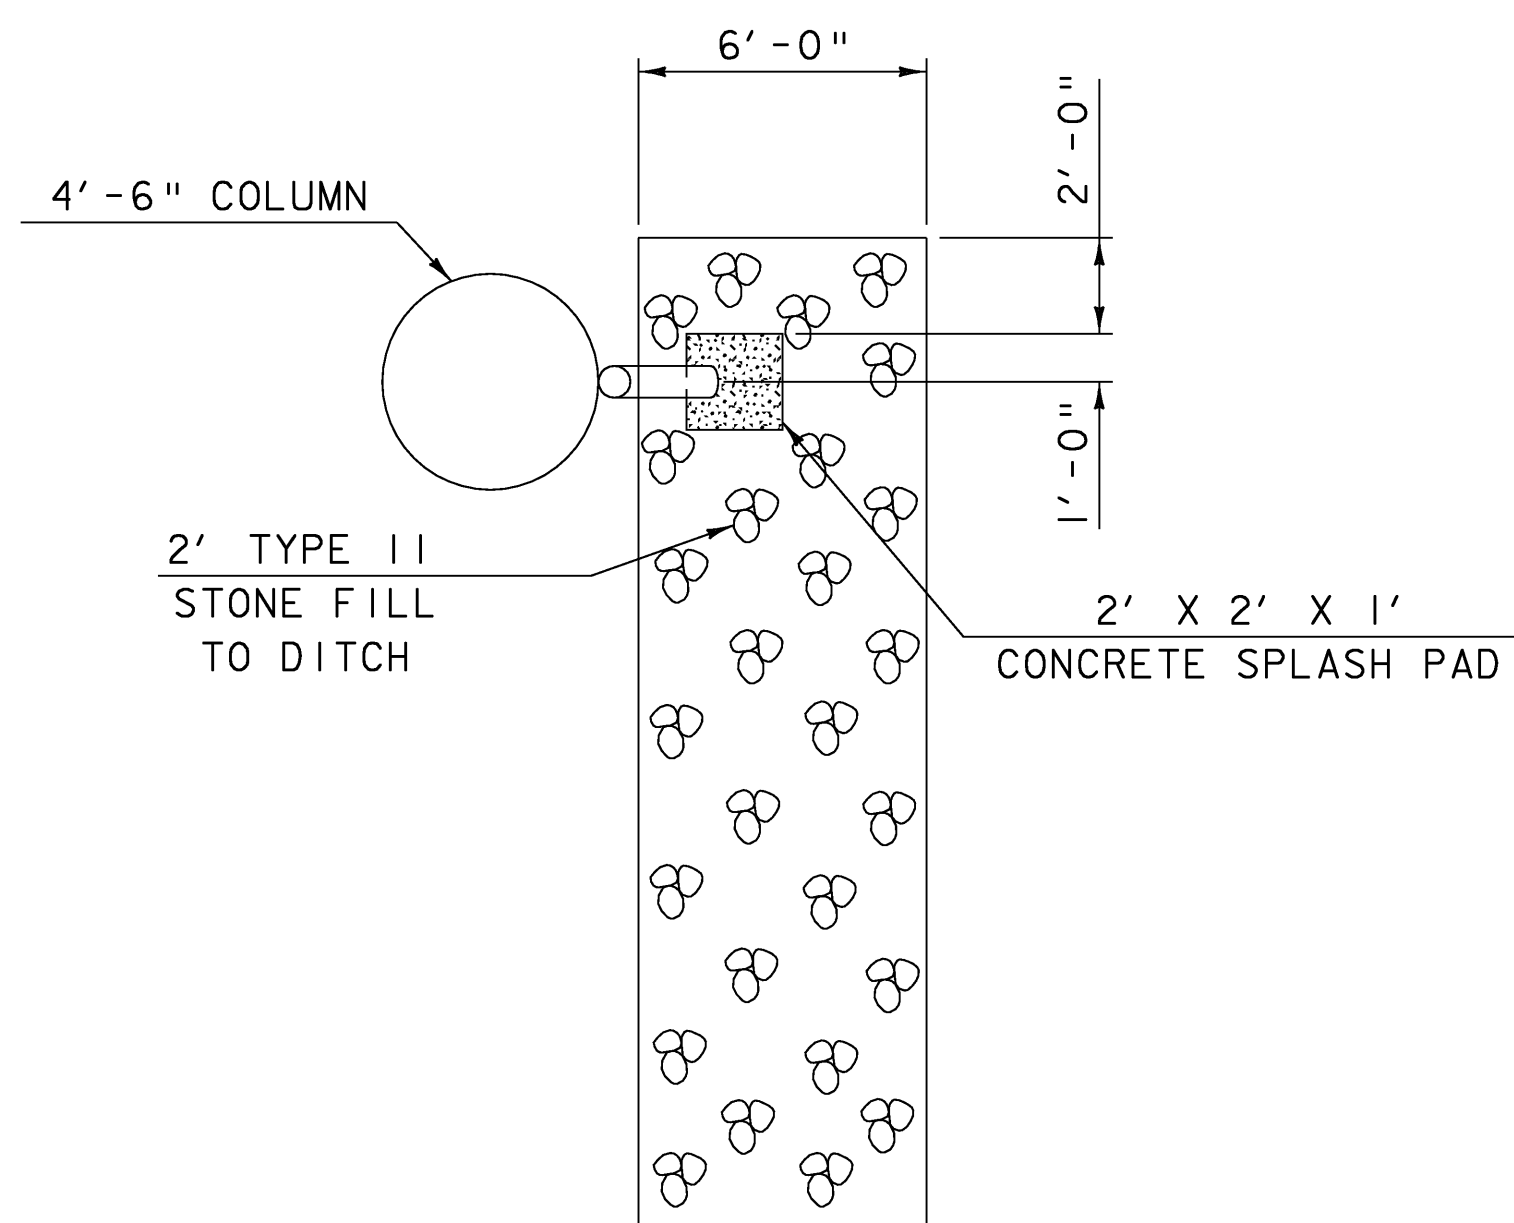

PLAN OF PIER DRAINAGE  
N. T. S.

APPROX. EDGE OF PAVEMENT VT 12

PROJECT: BERLIN	PROJECT NO.: IM 089-1 (20)
DESIGN FILE NAME: 99a270\structures\s99a270drain.dgn	PLOT DATE: 17-DEC-2007
IPARM FILE NAME: s00a270drain.i	DRAWN BY: C. MOONEY
DESIGNED BY: G. SPILAK	CHECKED BY: R. S. YOUNG
SQUAD LEADER: C. P. WILLIAMS	SHEET: 52 OF 104
DRAINAGE DETAILS	

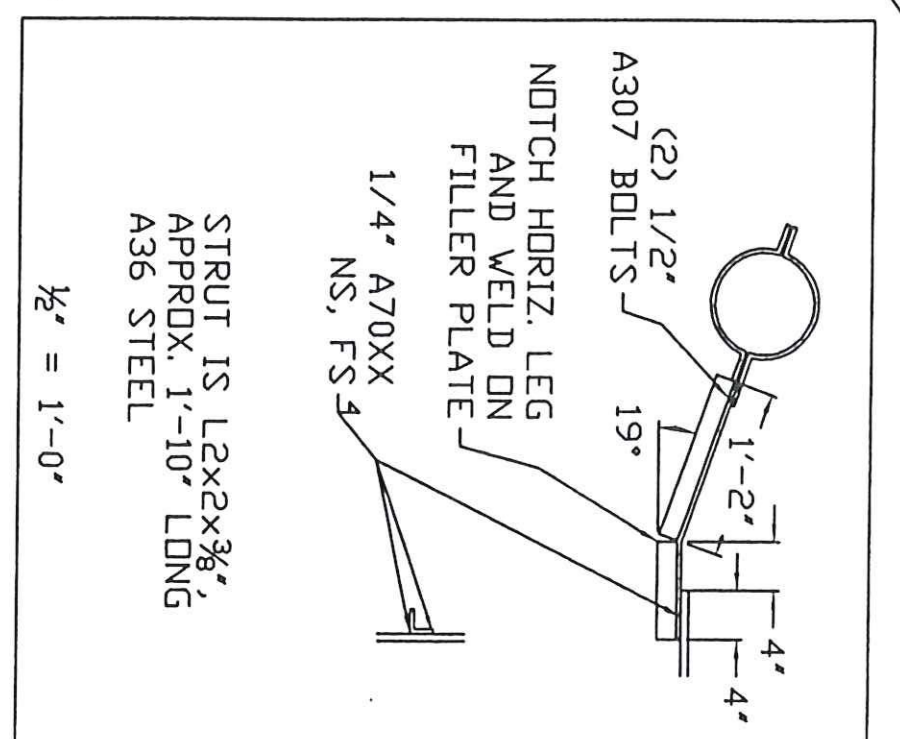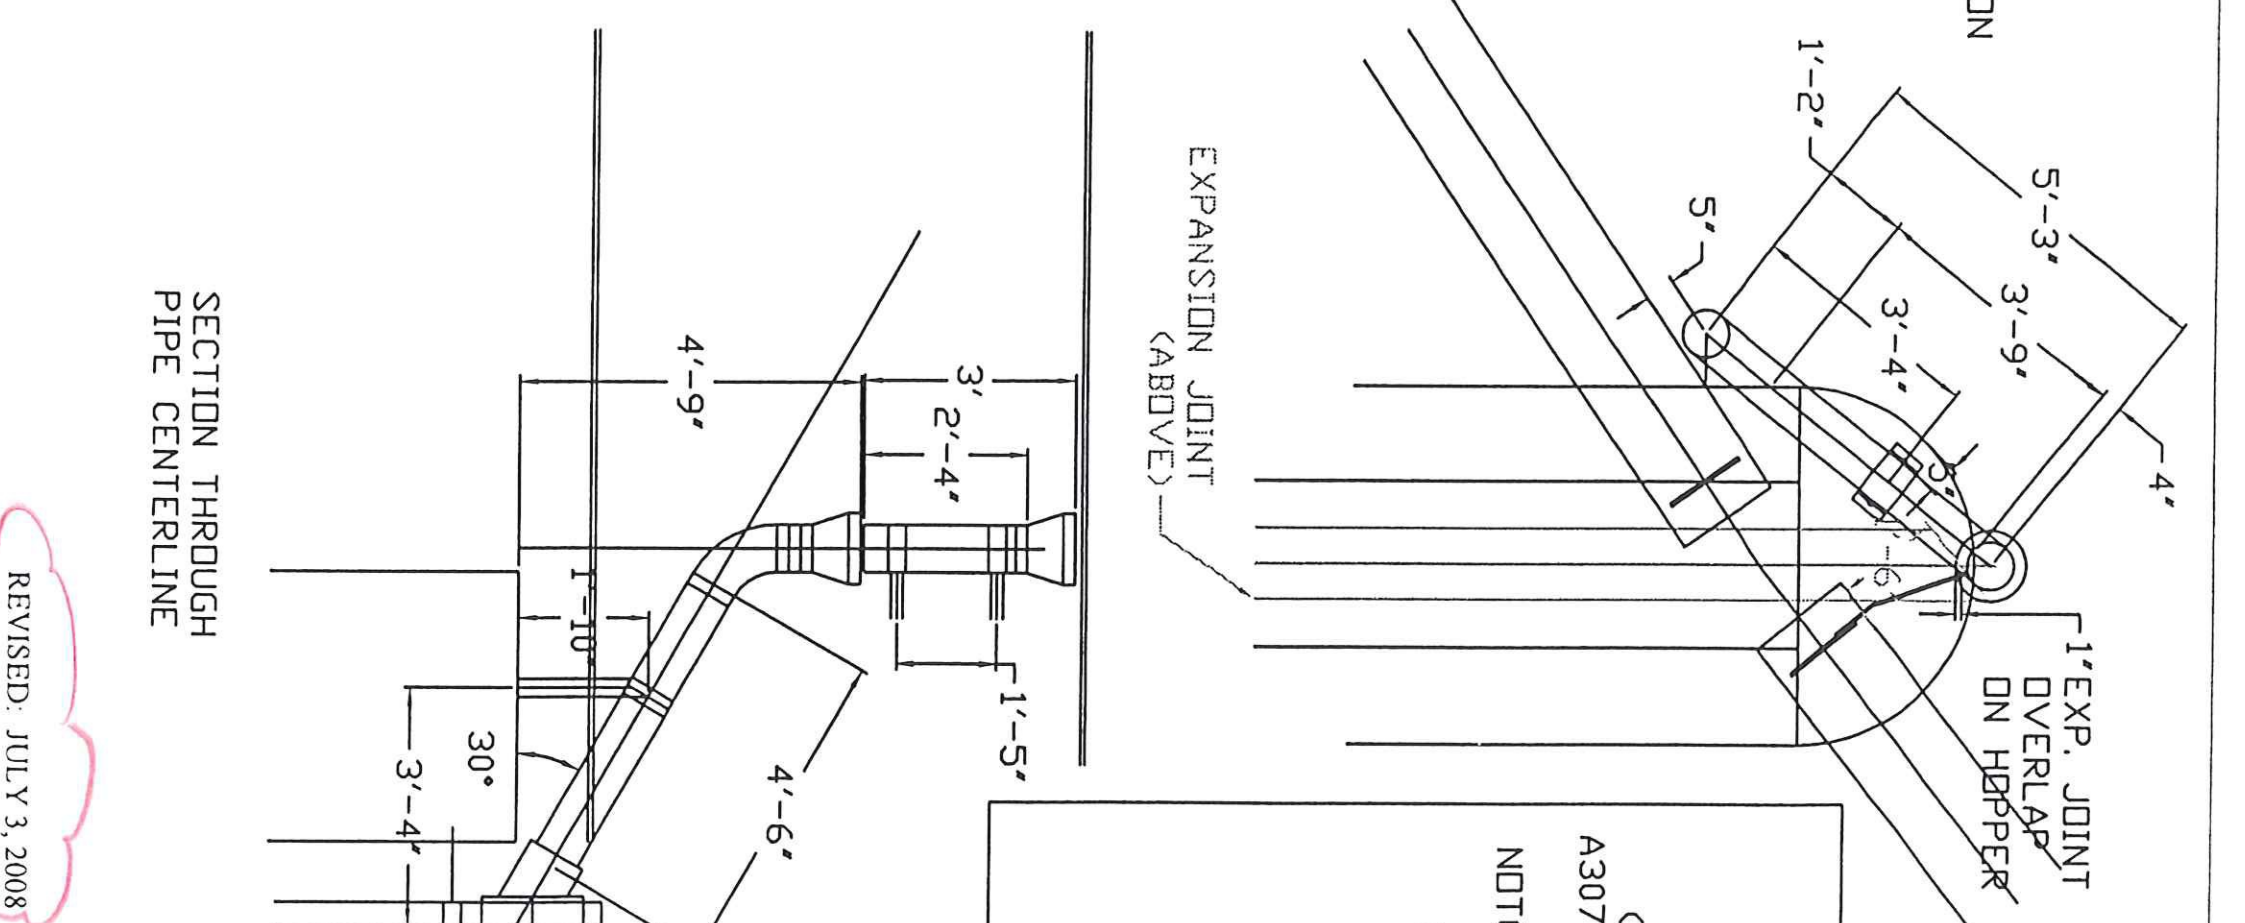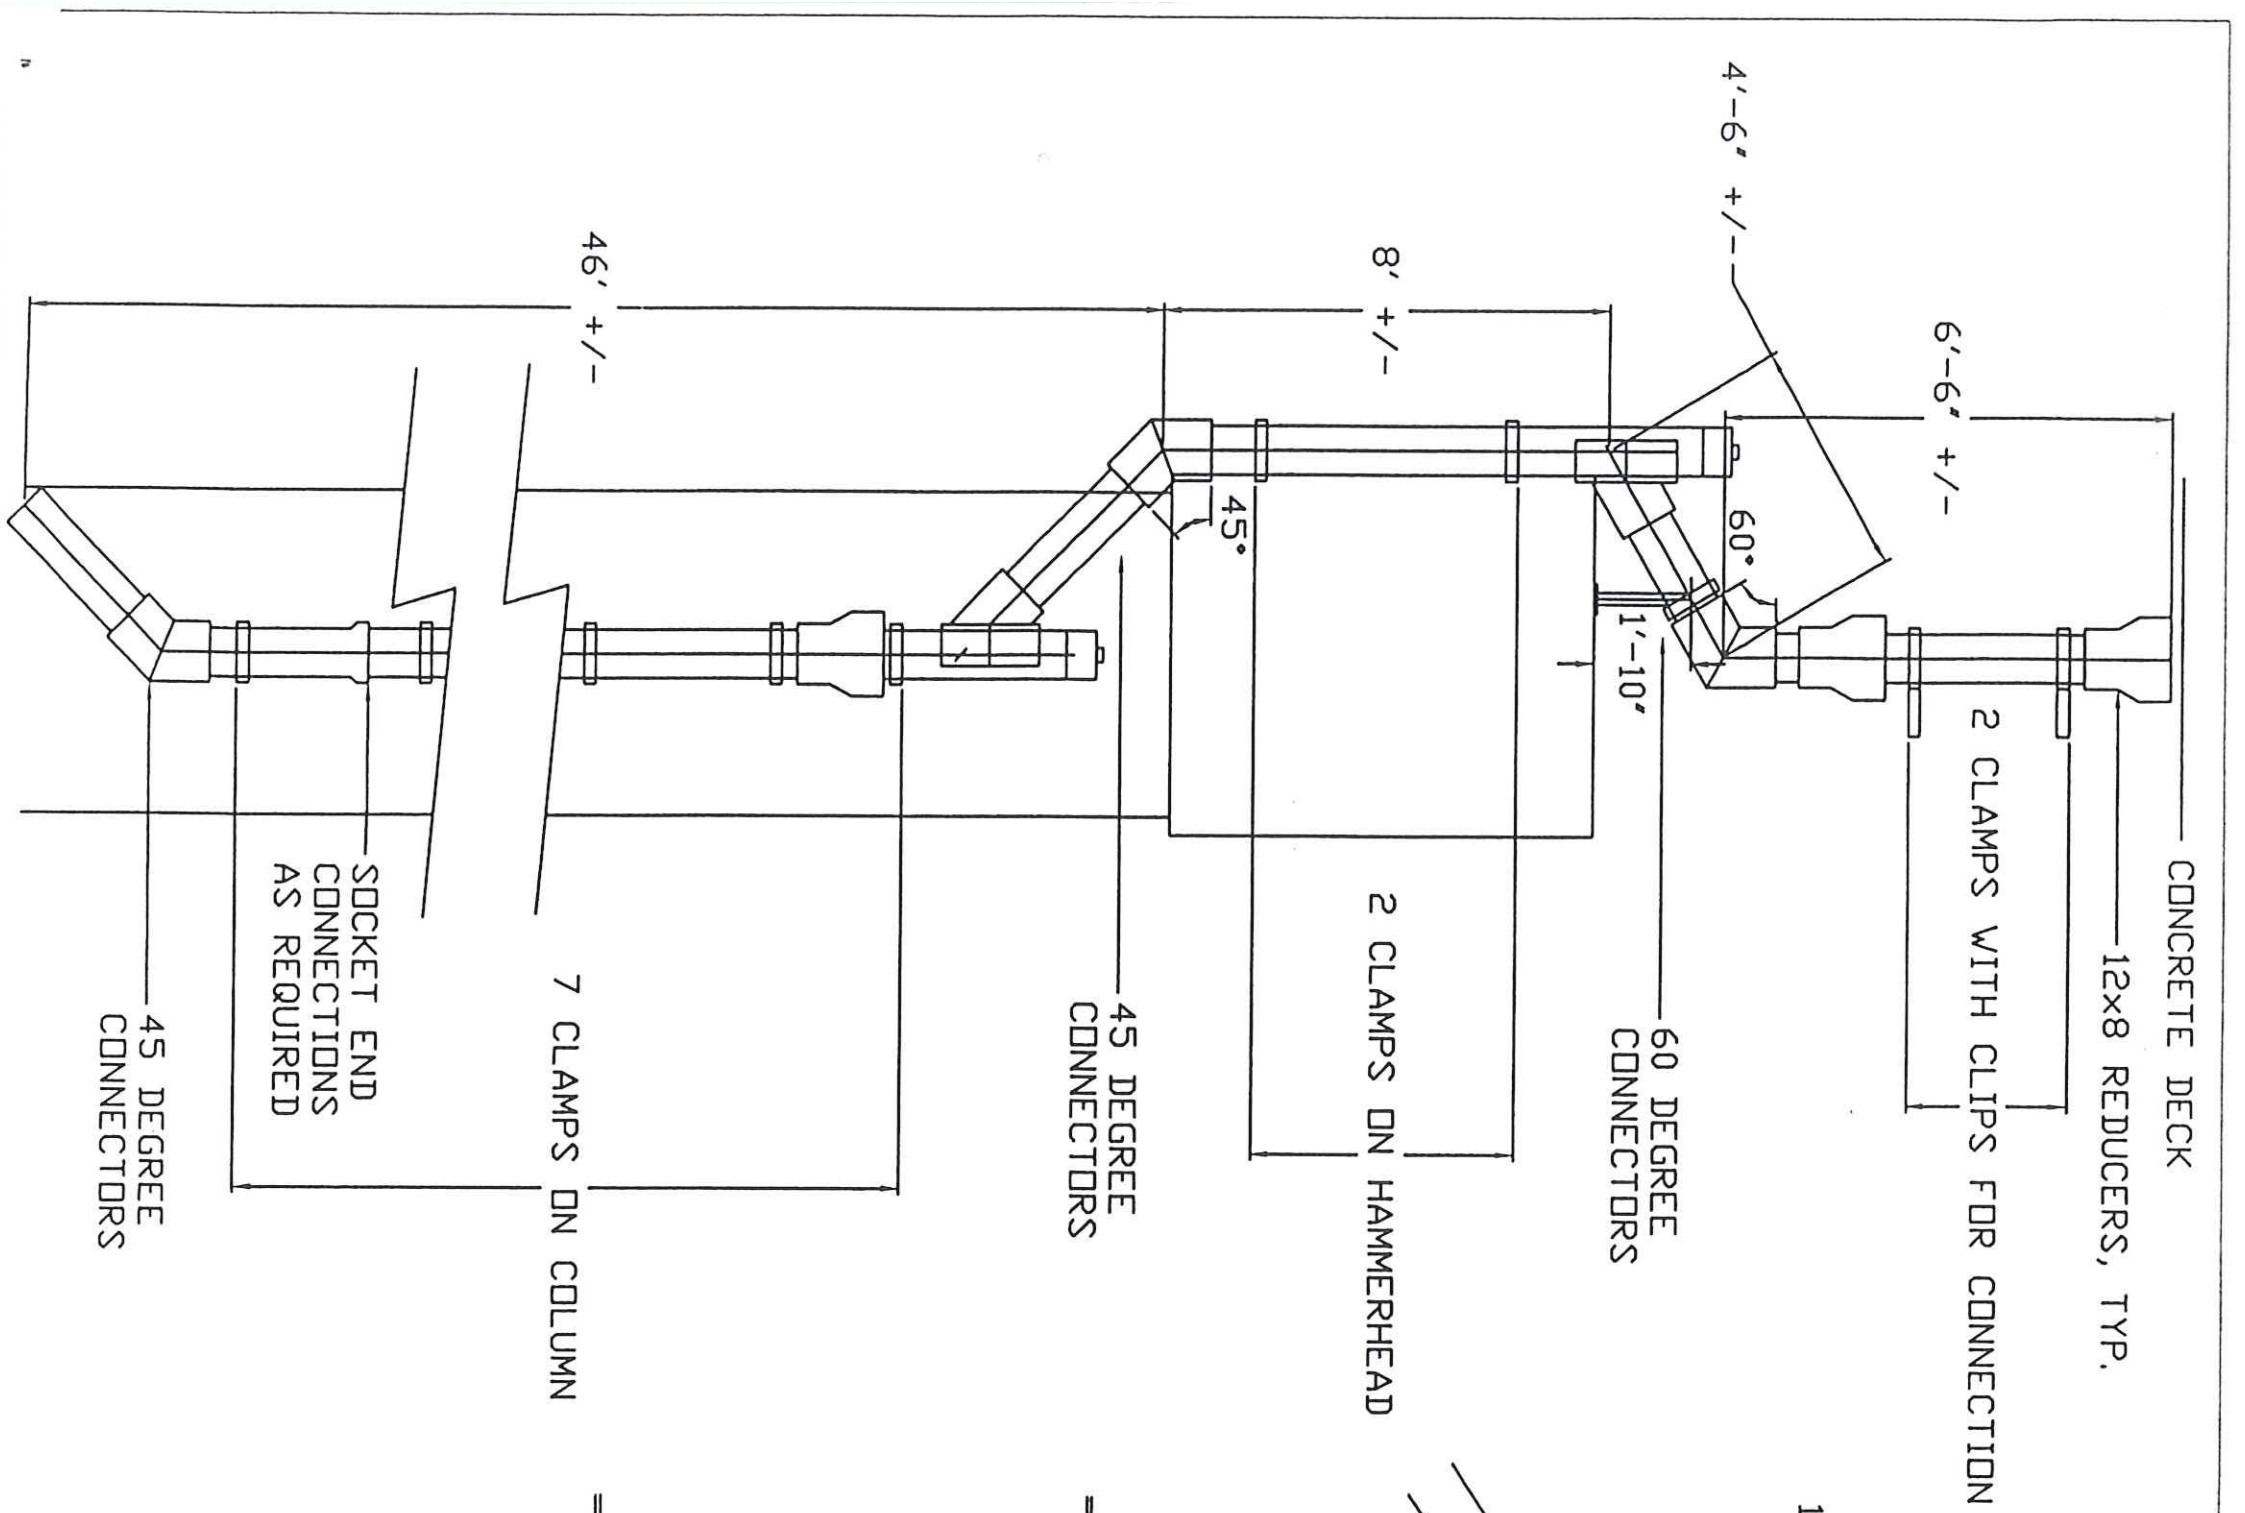


NOTE: ALL DIMENSIONS GIVEN ARE APPROXIMATE. FIELD FIT-UP IS REQUIRED TO MAINTAIN HOPPER LOCATION UNDER EXPANSION JOINT.


SECTION THROUGH PIPE CENTERLINE

TITLE: FIBERGLASS DRAINAGE PIPE  
 PROJECT: BERLIN, VT AC IM 089-1 (20)  
 SHEET 1 of 1  
 SCALE: 1/4" = 1'-0"  
 DATE: JUNE 30, 2008  
 BECK & BELLICO, INC.  
 150 MAIN ST. DANVER, VT 05172


REVISED: JULY 3, 2008  
 AS BUILT

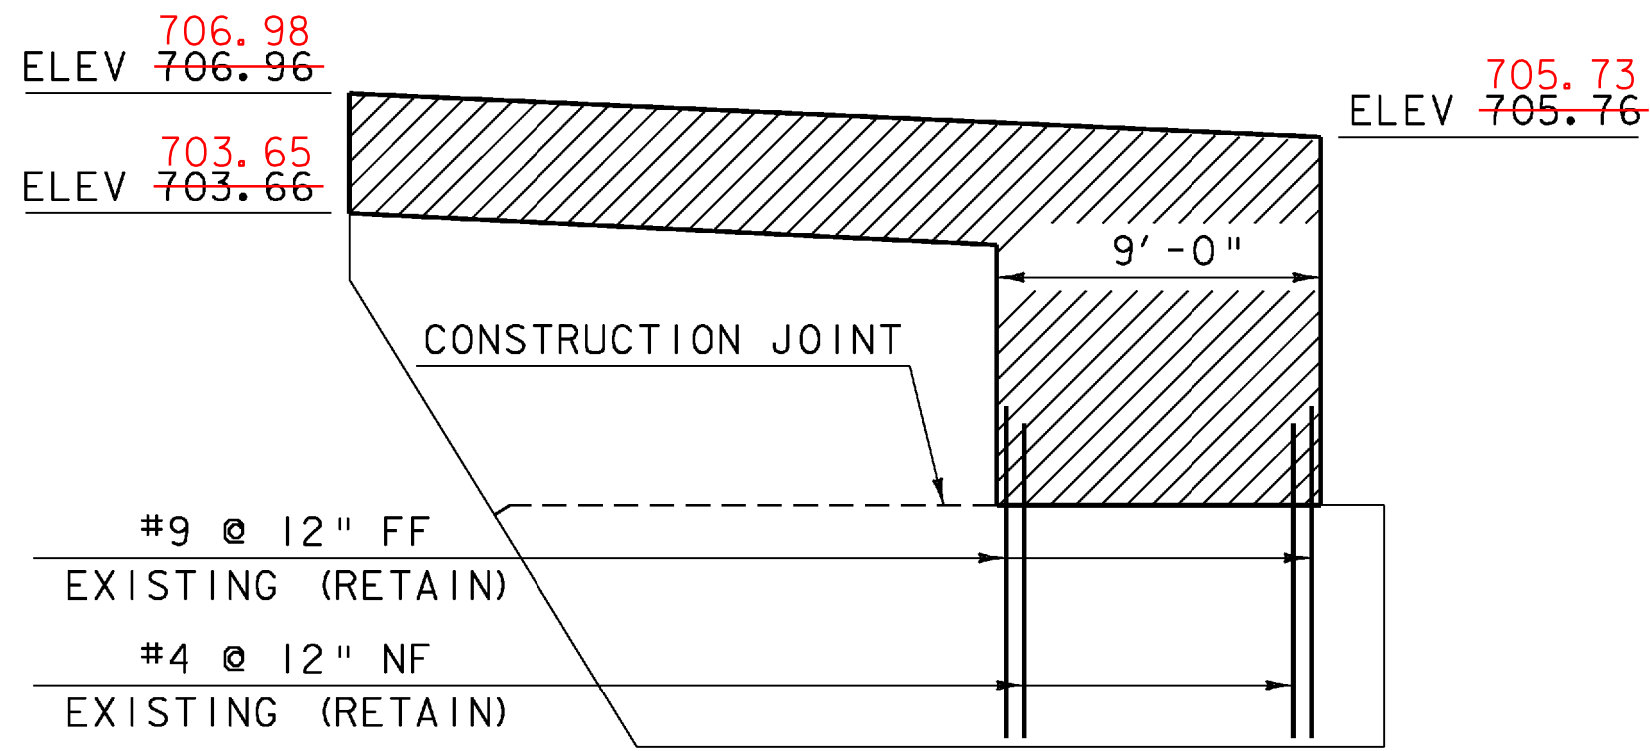


WINGWALL #2 CONCRETE REMOVAL LIMITS  
ELEVATION VIEW

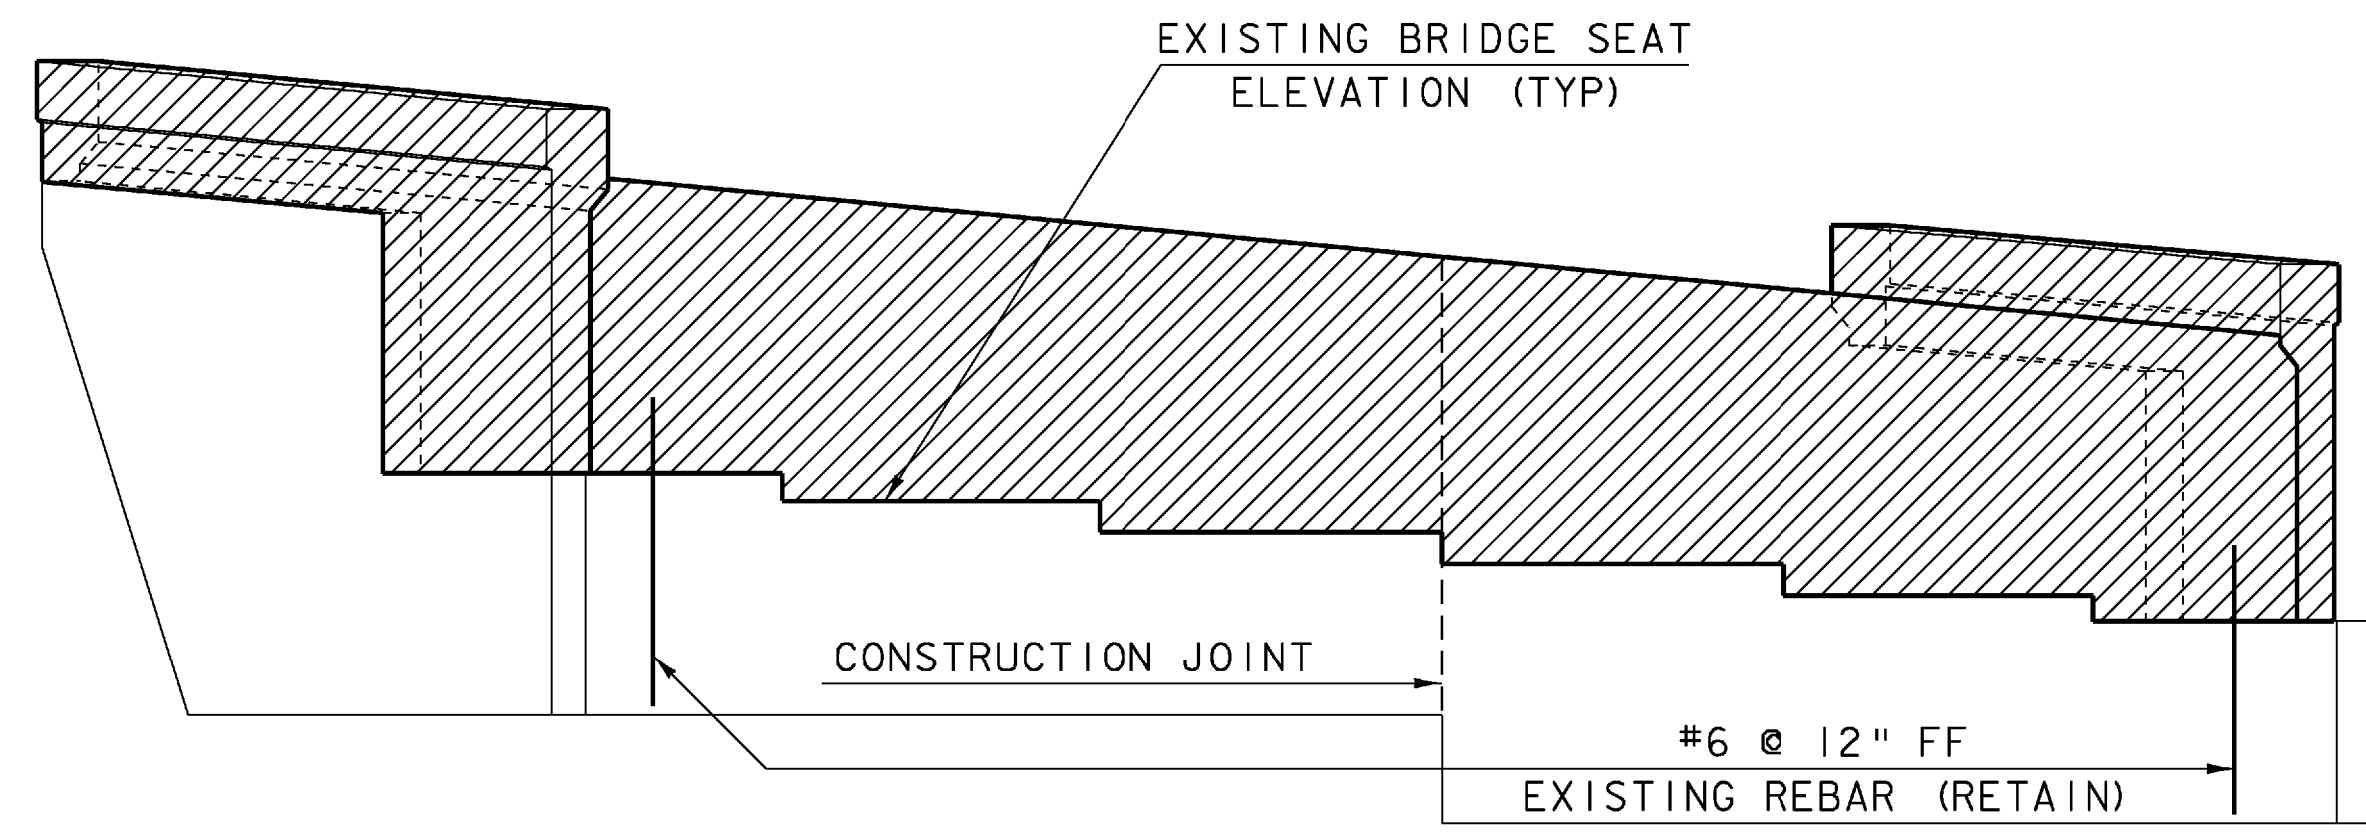


ABUTMENT #1 CONCRETE REMOVAL LIMITS  
ELEVATION VIEW

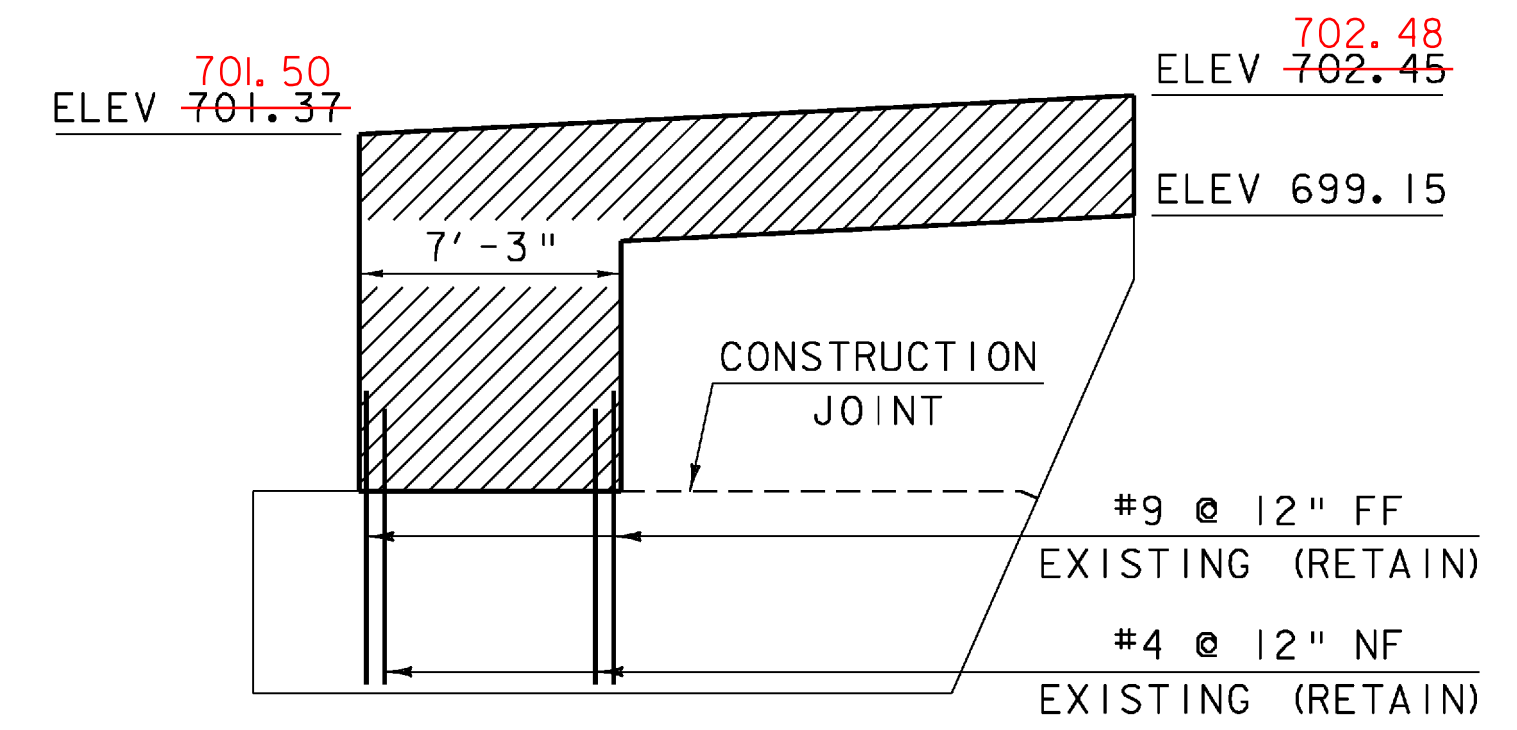


WINGWALL #1 CONCRETE REMOVAL LIMITS  
ELEVATION VIEW

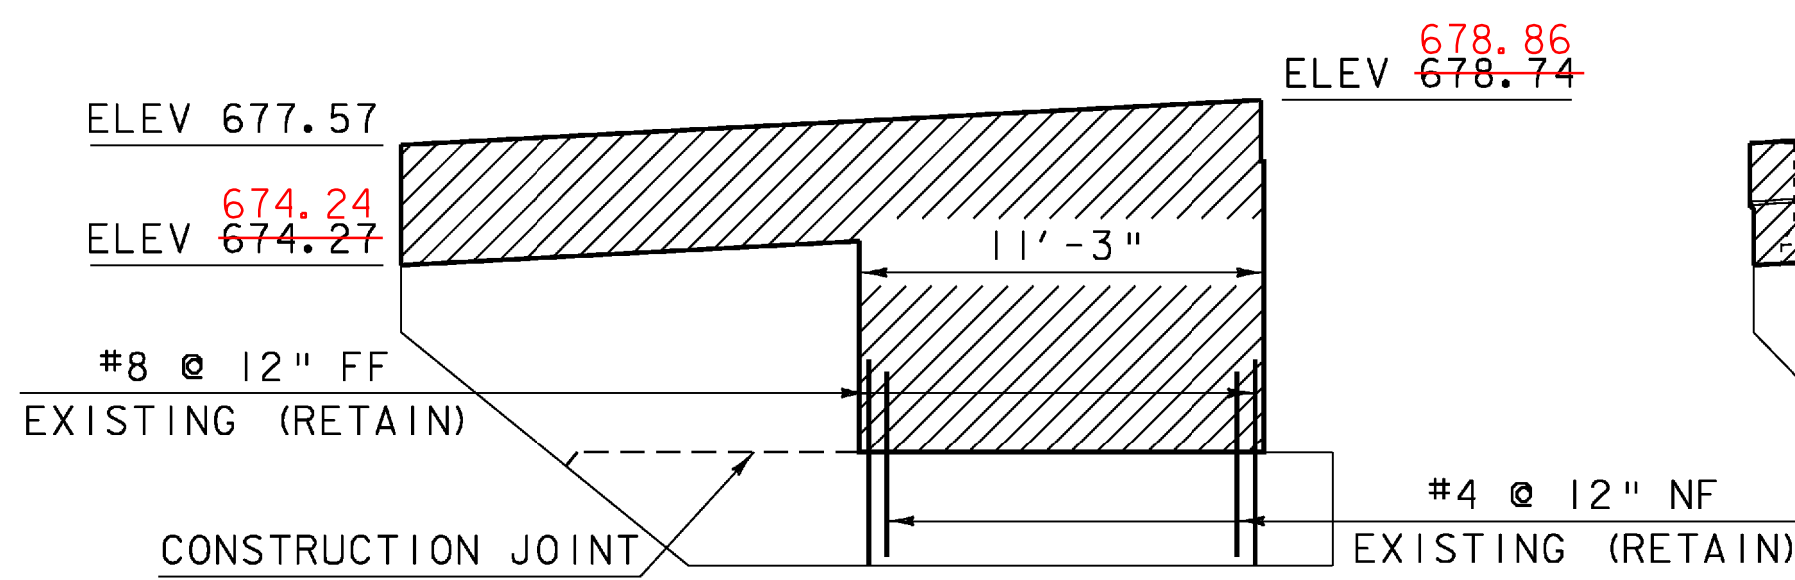

WINGWALL #3 CONCRETE REMOVAL LIMITS  
ELEVATION VIEW

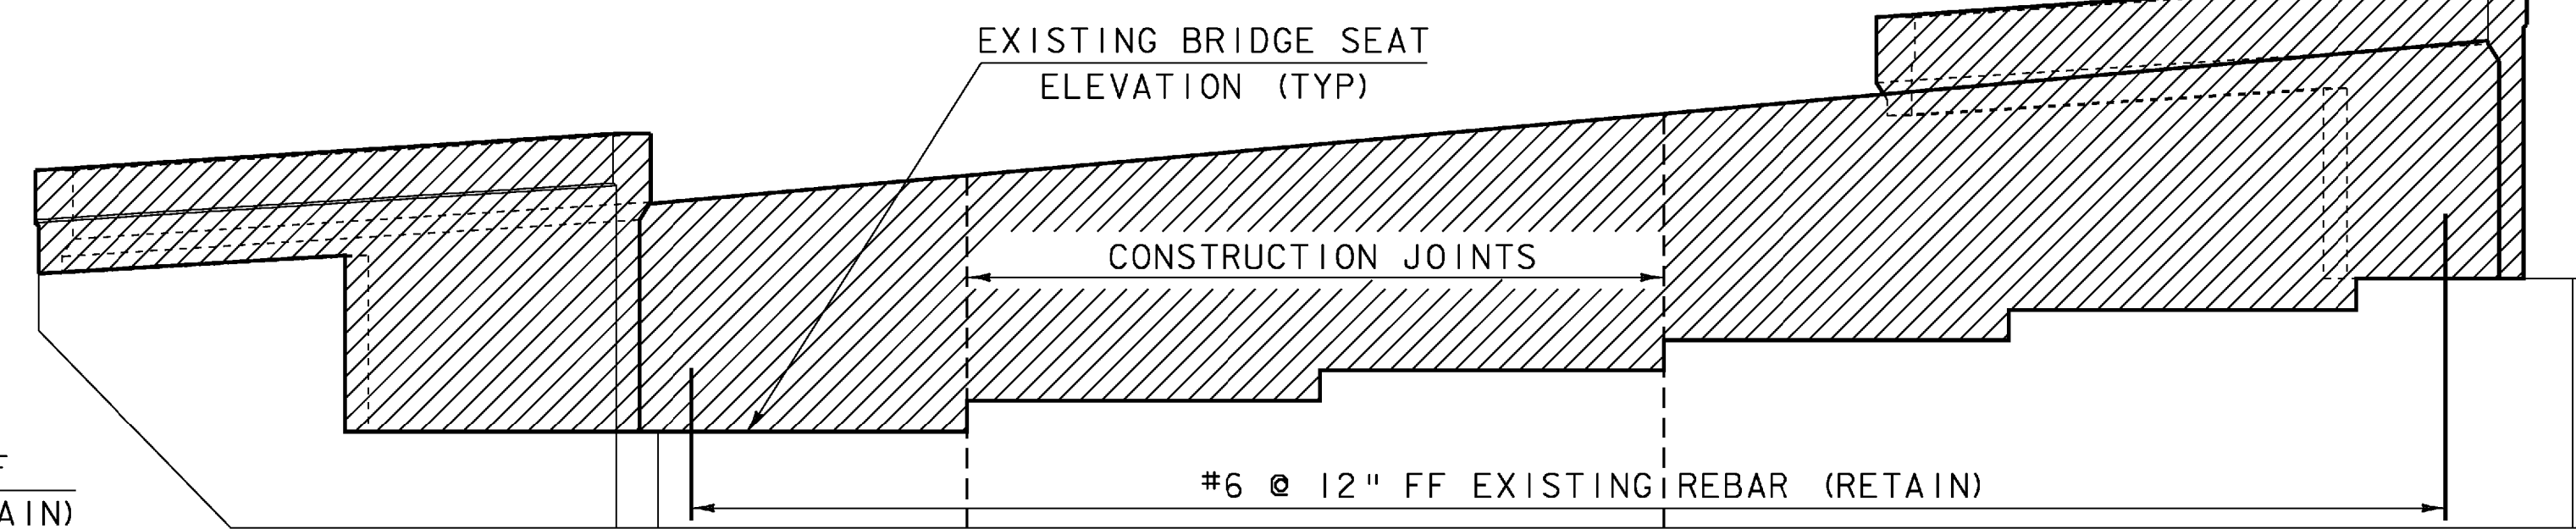


ABUTMENT #2 CONCRETE REMOVAL LIMITS  
ELEVATION VIEW

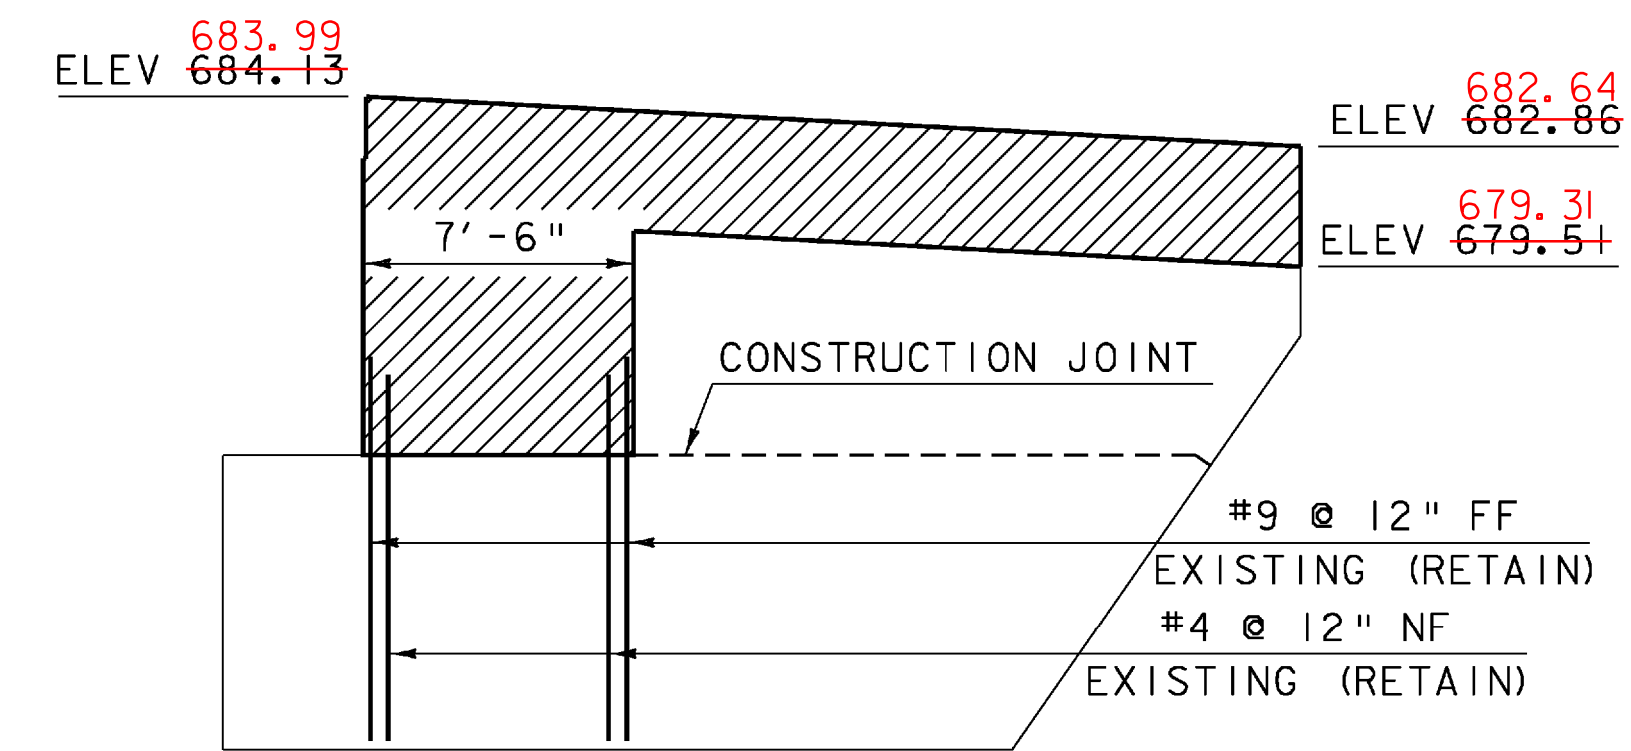


WINGWALL #4 CONCRETE REMOVAL LIMITS  
ELEVATION VIEW

NOTE:  
ALL EXISTING CONCRETE SHALL BE REMOVED BY MEANS OF SAWCUTTING.  
SEE SHEET 55 FOR SECTION DETAILS


PROJECT: BERLIN	PROJECT NO. : IM 089-1 (20)
DESIGN FILE NAME: s99a270\structures\s99a270abut.dgn	
IPARM FILE NAME: s99a270abut12rem.iPLOT DATE: 05-DEC-2007	
DESIGNED BY: G. SPILAK	DRAWN BY: WEEBER
SQUAD LEADER: C.P. WILLIAMS	CHECKED BY: R. S. YOUNG
ABUTMENTS 1&2 REMOVAL LIMITS	SHEET: 53 OF 104

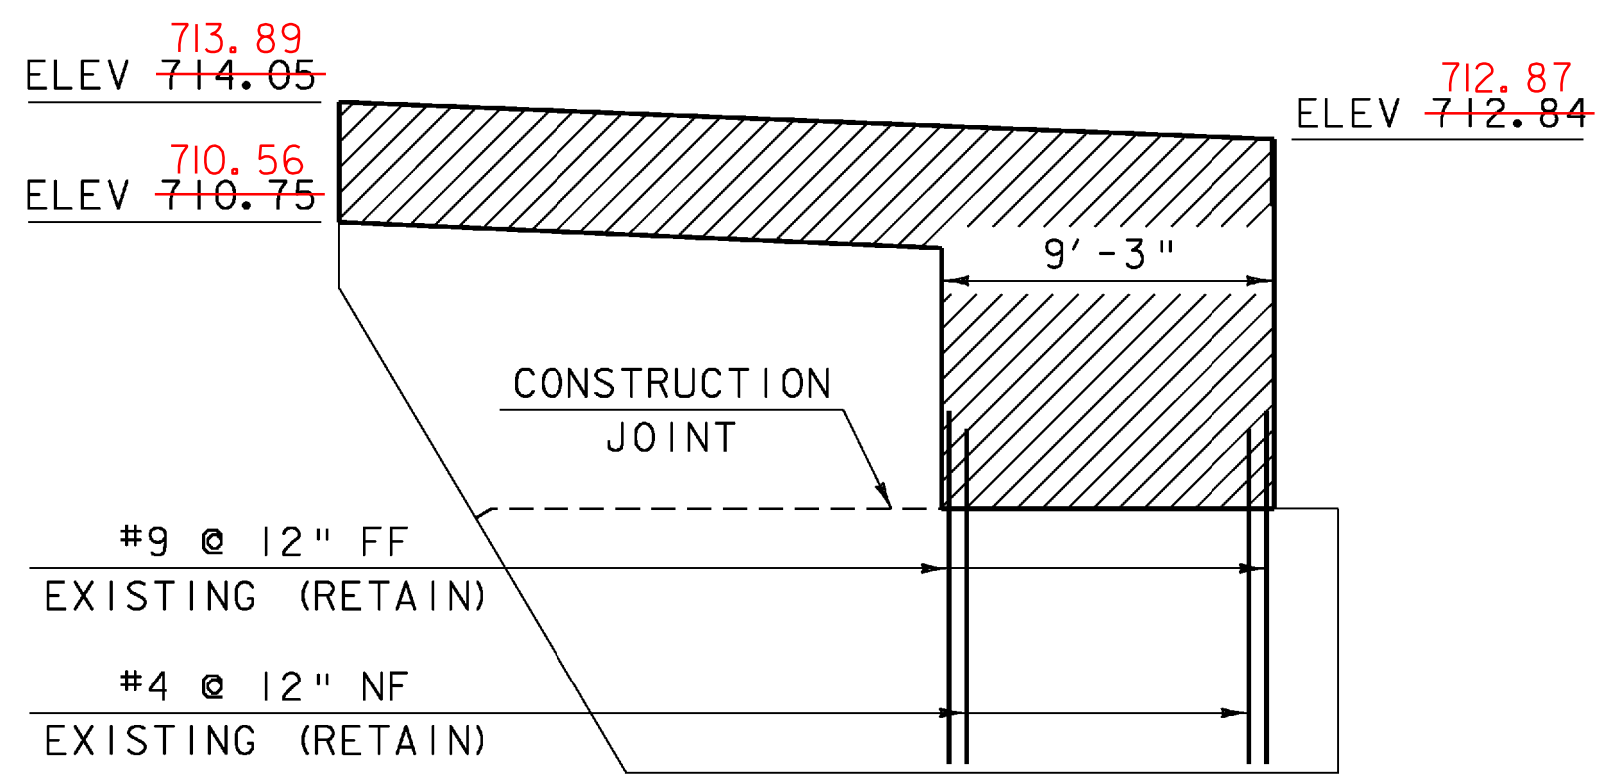


WINGWALL #6 CONCRETE REMOVAL LIMITS  
ELEVATION VIEW

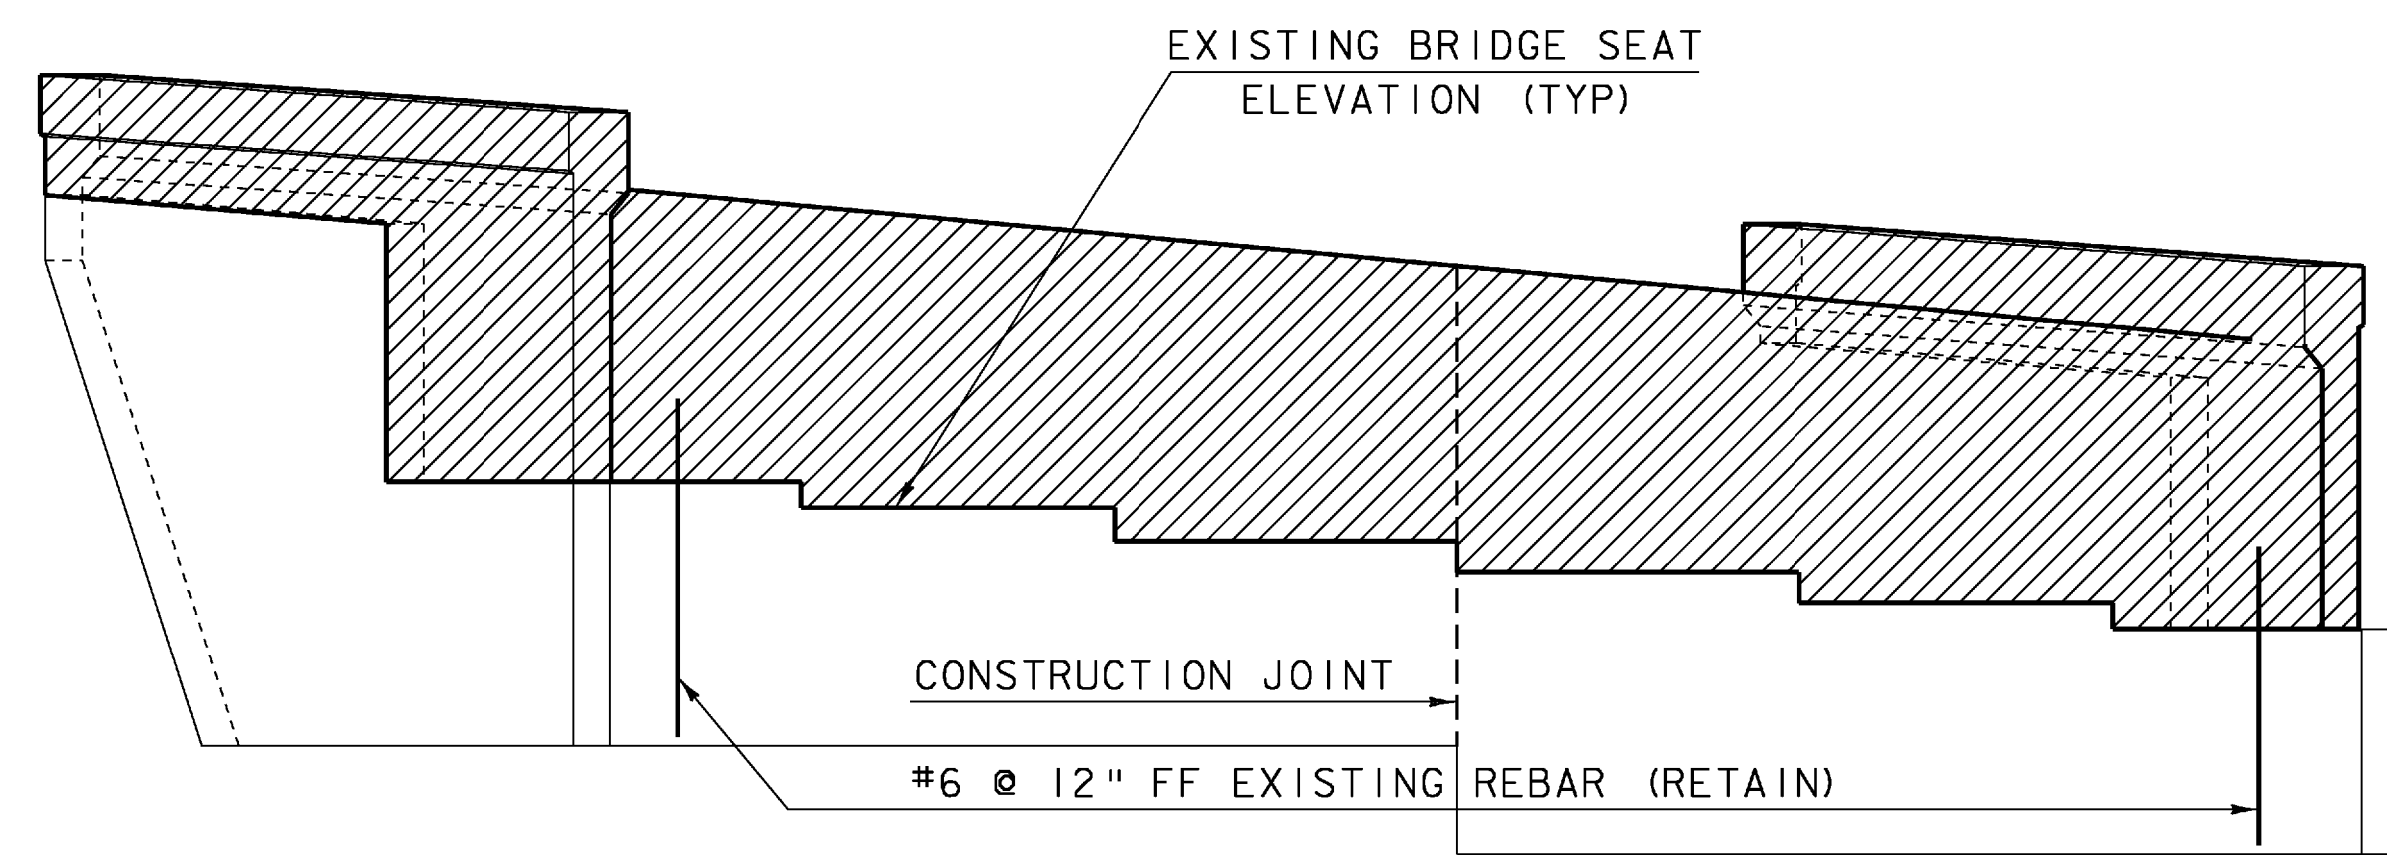


ABUTMENT #3 CONCRETE REMOVAL LIMITS  
ELEVATION VIEW

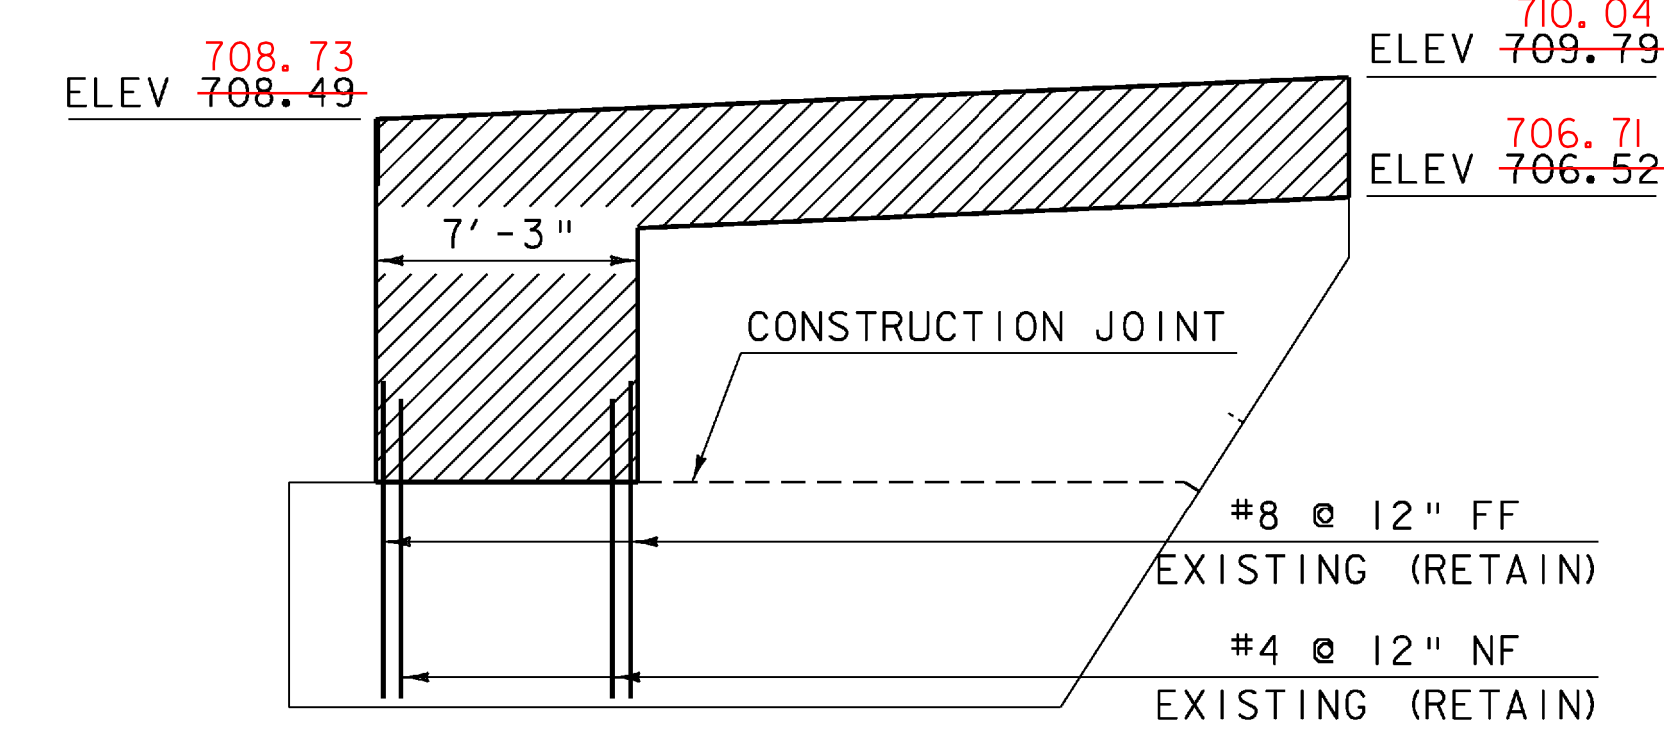


WINGWALL #5 CONCRETE REMOVAL LIMITS  
ELEVATION VIEW

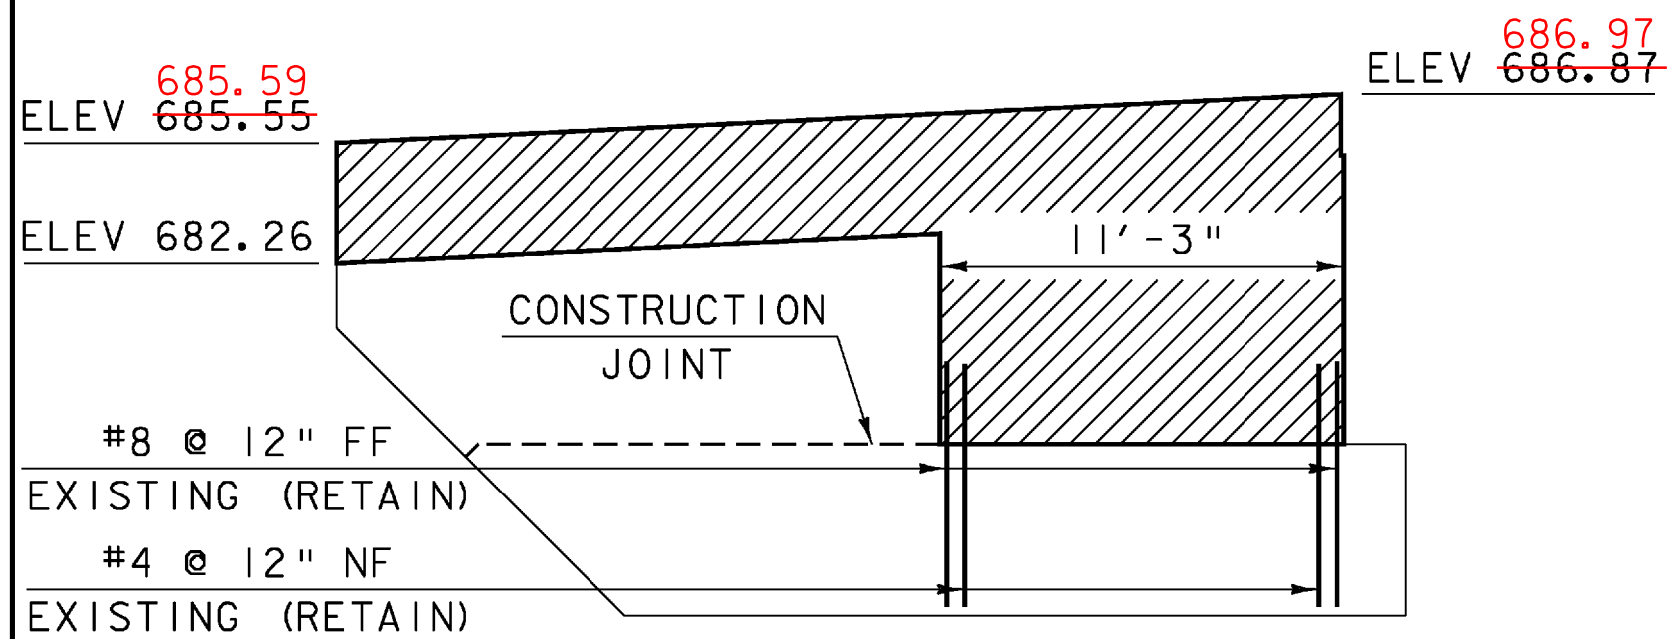

WINGWALL #7 CONCRETE REMOVAL LIMITS  
ELEVATION VIEW

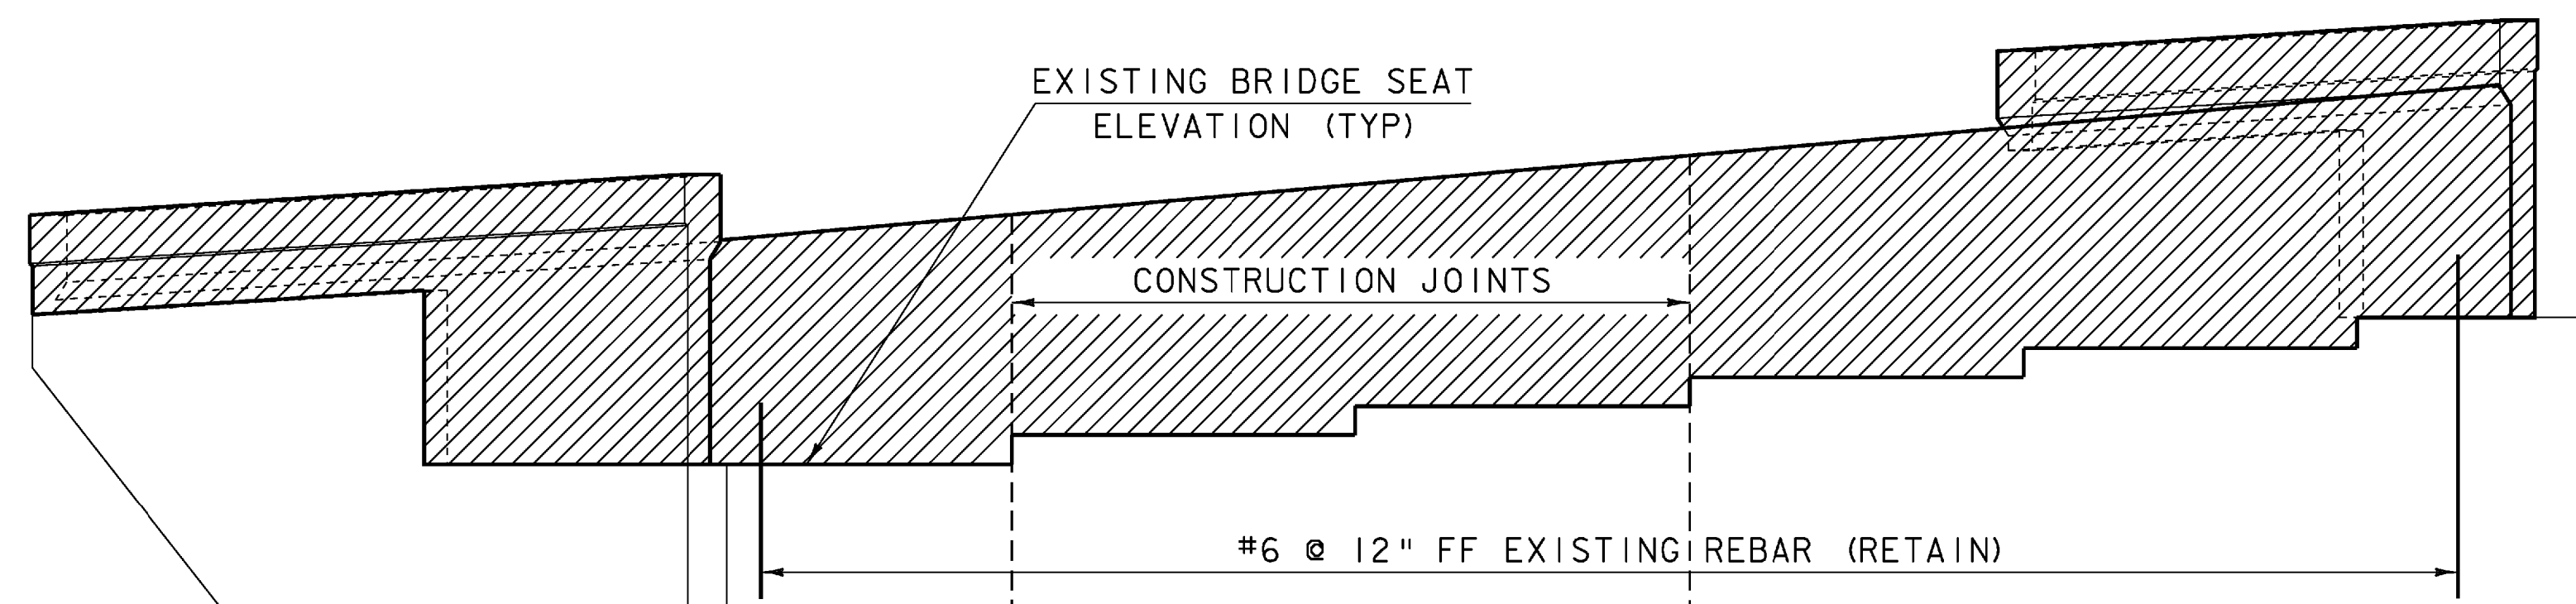


ABUTMENT #4 CONCRETE REMOVAL LIMITS  
ELEVATION VIEW

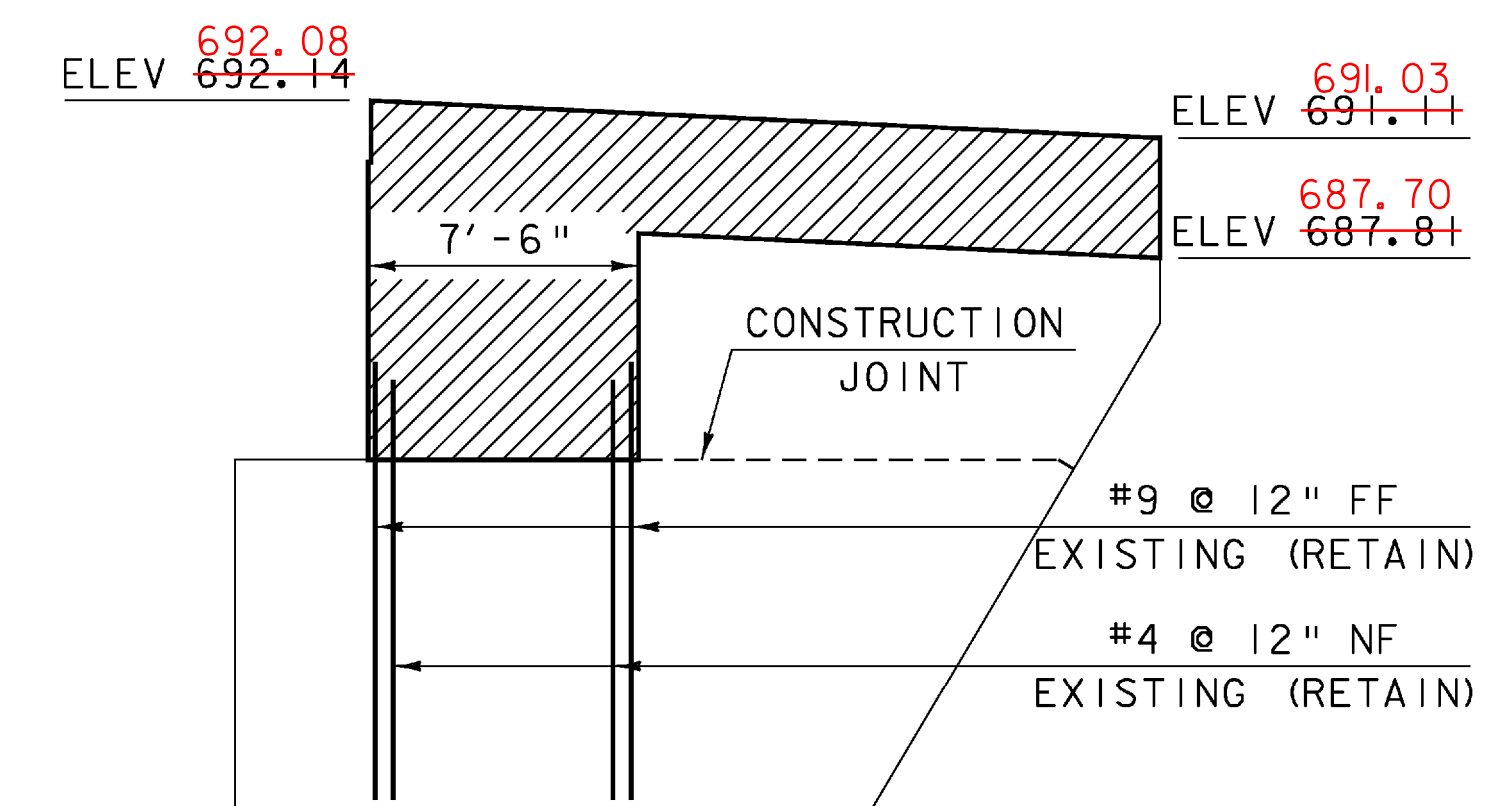

WINGWALL #8 CONCRETE REMOVAL LIMITS  
ELEVATION VIEW


NOTE:  
ALL EXISTING CONCRETE SHALL BE REMOVED BY MEANS OF SAWCUTTING.  
SEE SHEET 55 FOR SECTION DETAILS

PROJECT: BERLIN	PROJECT NO.: IM 089-1 (20)
DESIGN FILE NAME: s99a270\structures\s99a270abut.dgn	
IPARM FILE NAME: s99a270abut34rem.iPLOT DATE: 05-DEC-2007	
DESIGNED BY: G. SPILAK	DRAWN BY: WEEBER
SQUAD LEADER: C.P. WILLIAMS	CHECKED BY: R. S. YOUNG
ABUTMENTS 3&4 REMOVAL LIMITS	SHEET: 54 OF 104

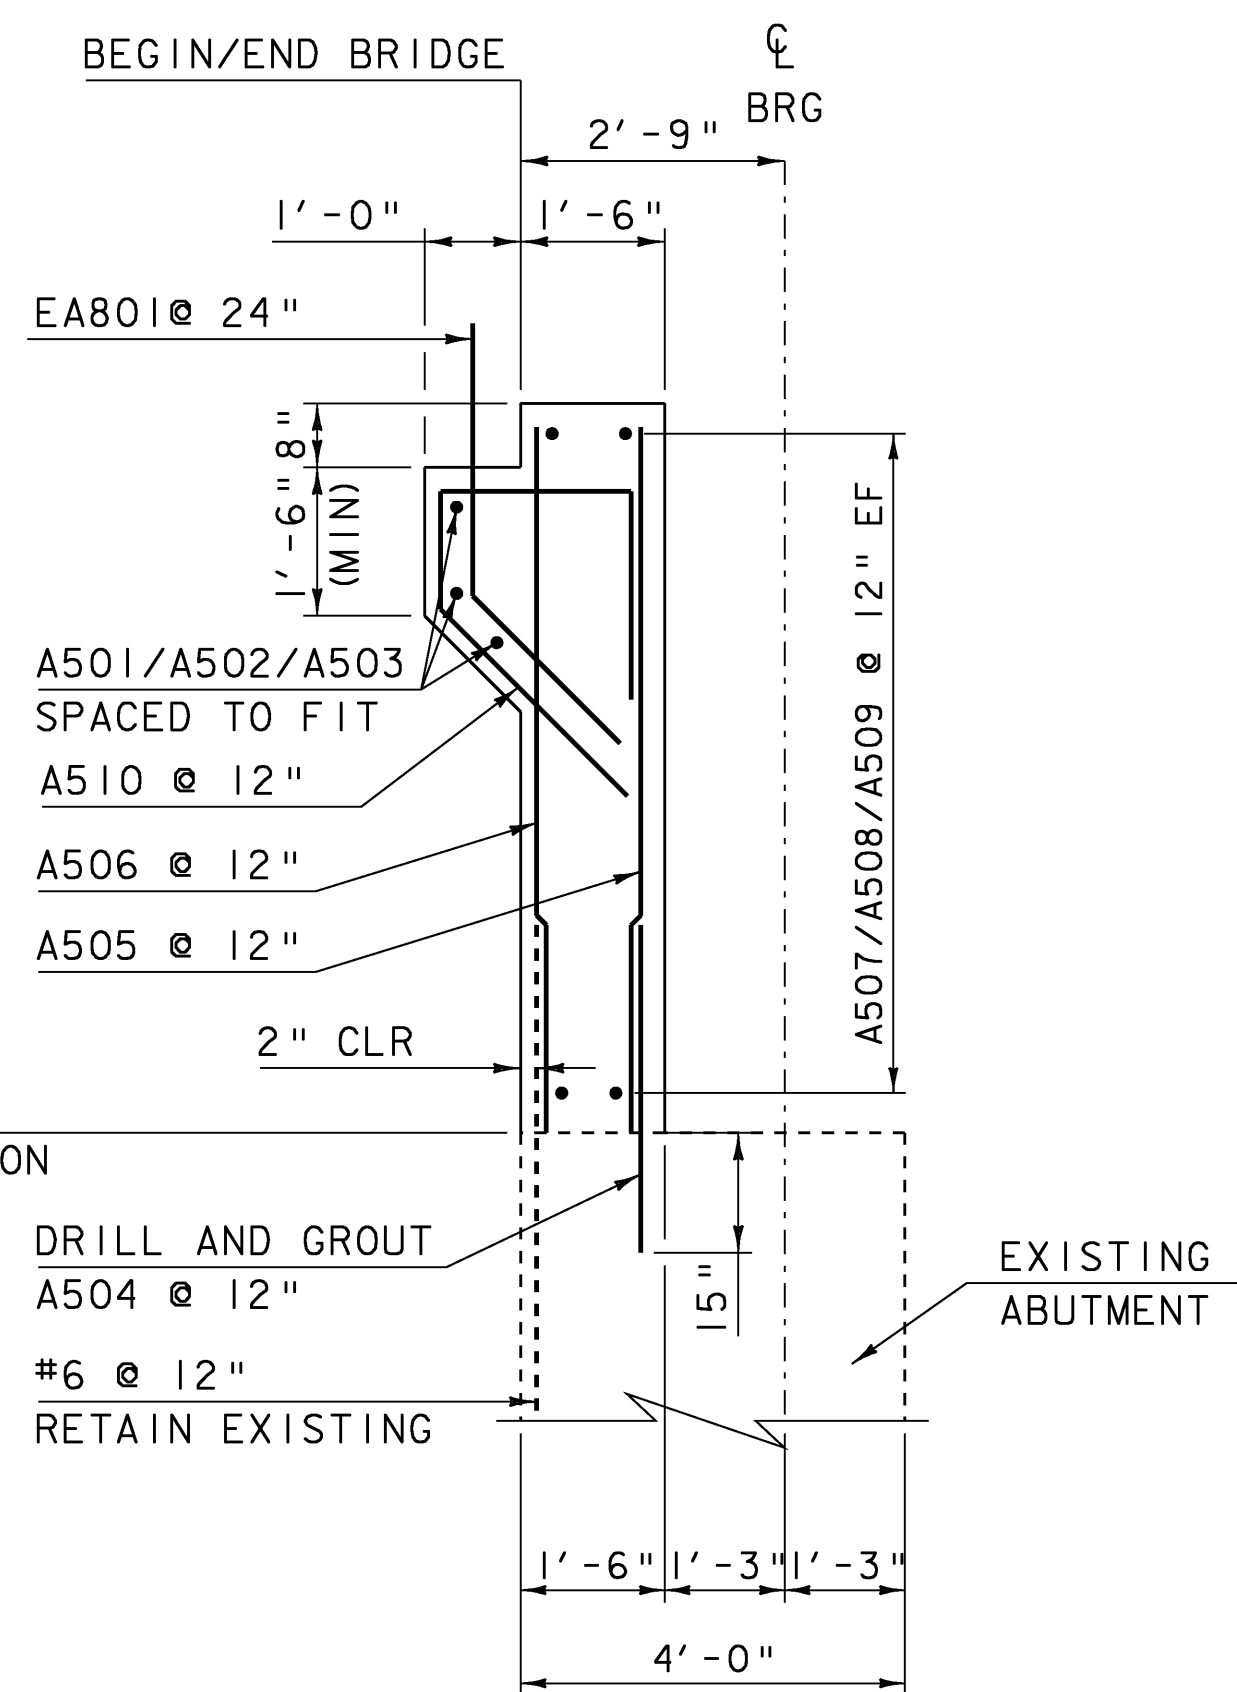


**ABUTMENT TYPICAL SECTION**

SCALE 1/2" = 1'-0"

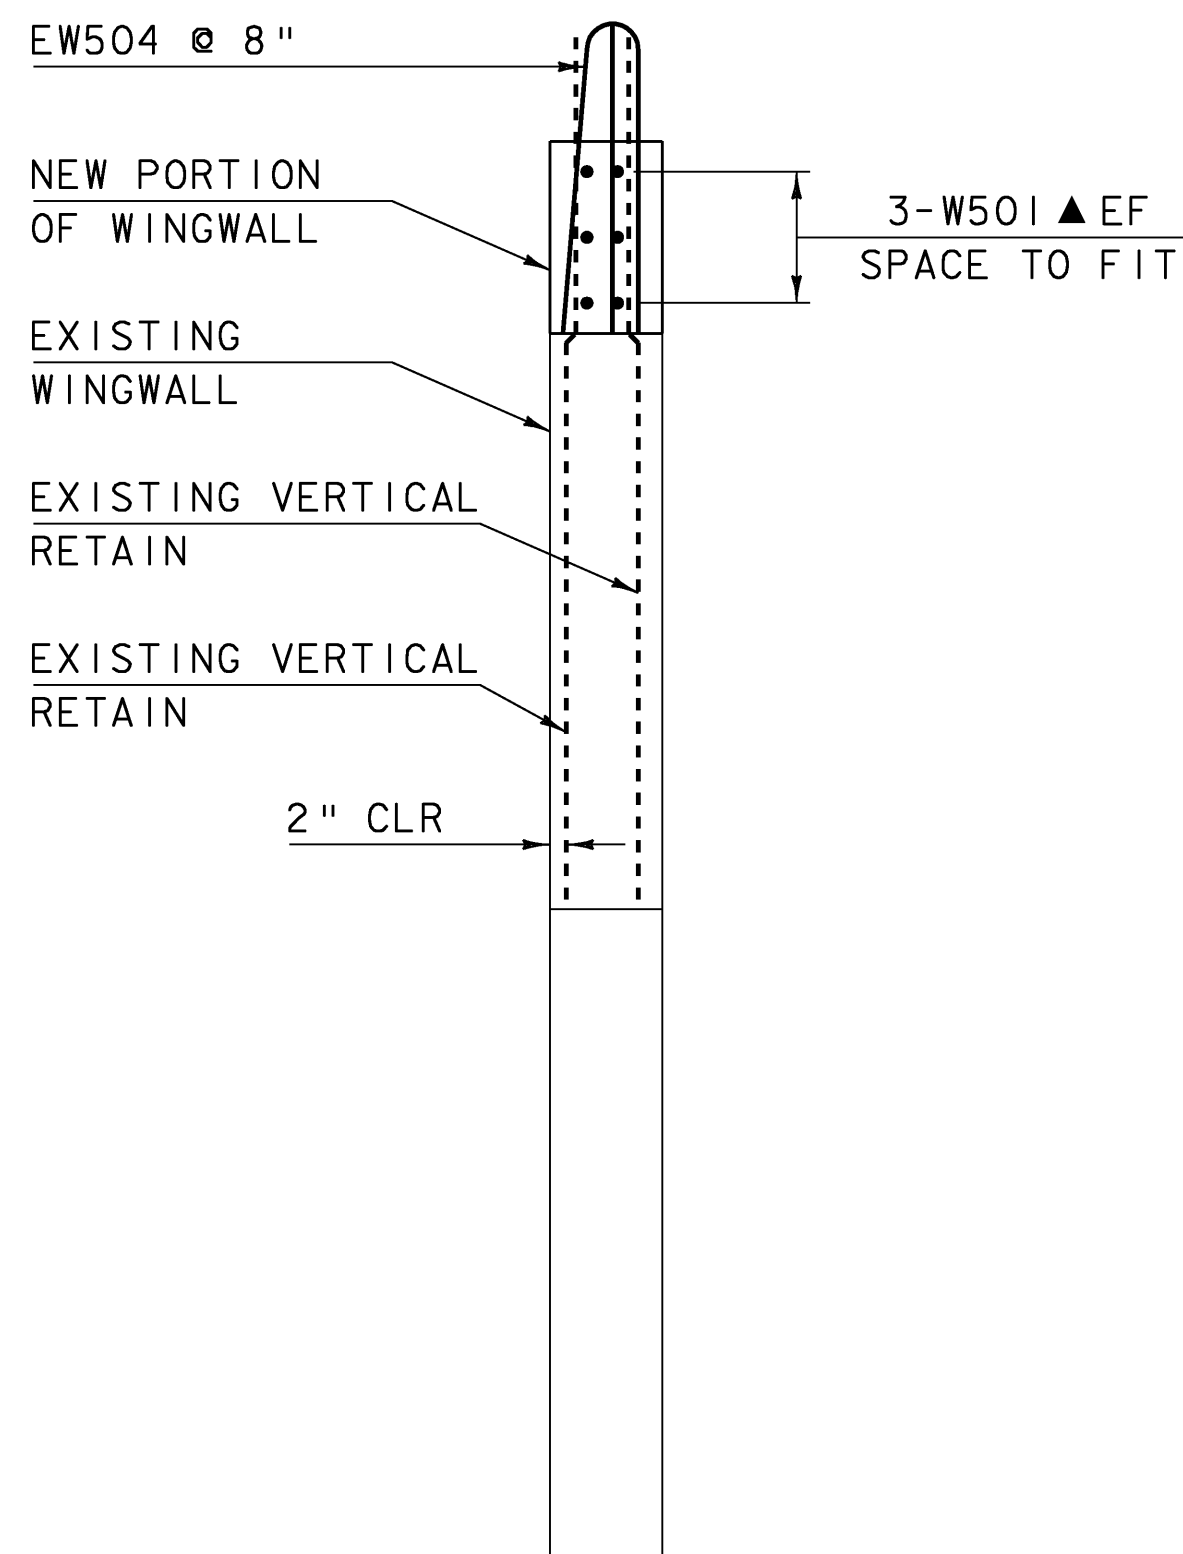


**END WINGWALL TYPICAL SECTION**

SCALE 1/2" = 1'-0"

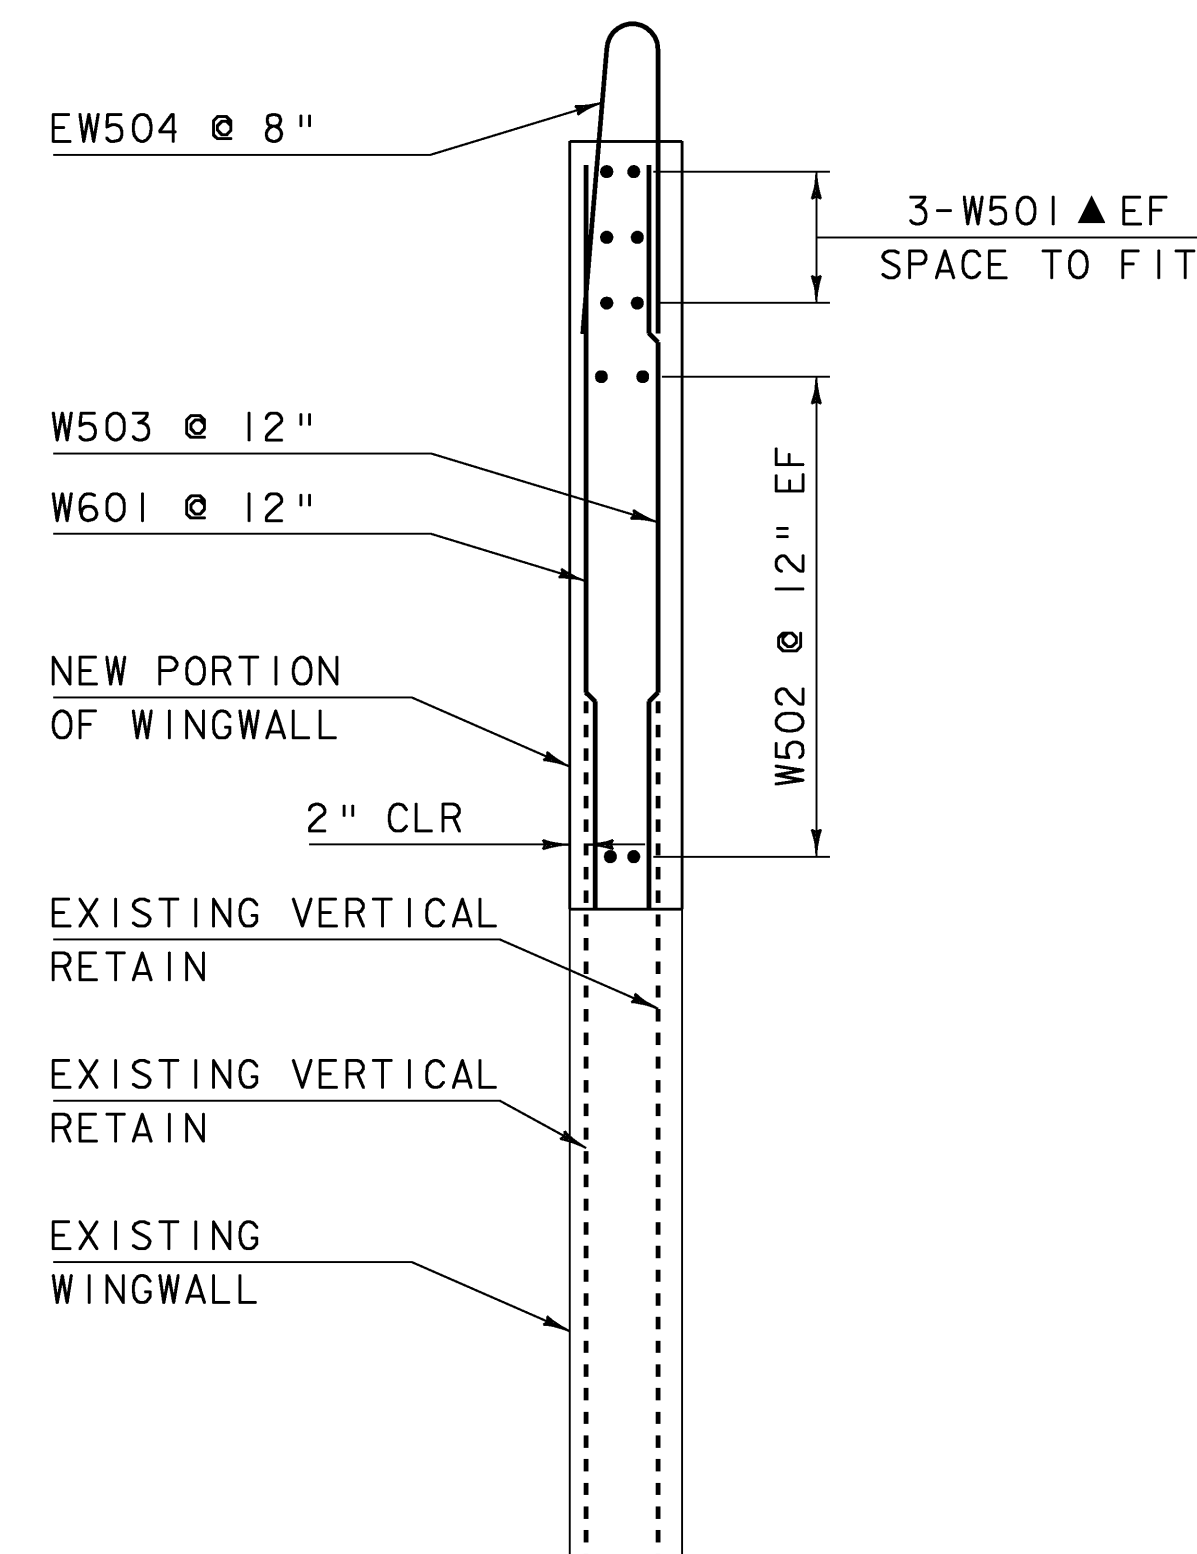


**WINGWALL TYPICAL SECTION NEAR BACKWALL**

SCALE 1/2" = 1'-0"

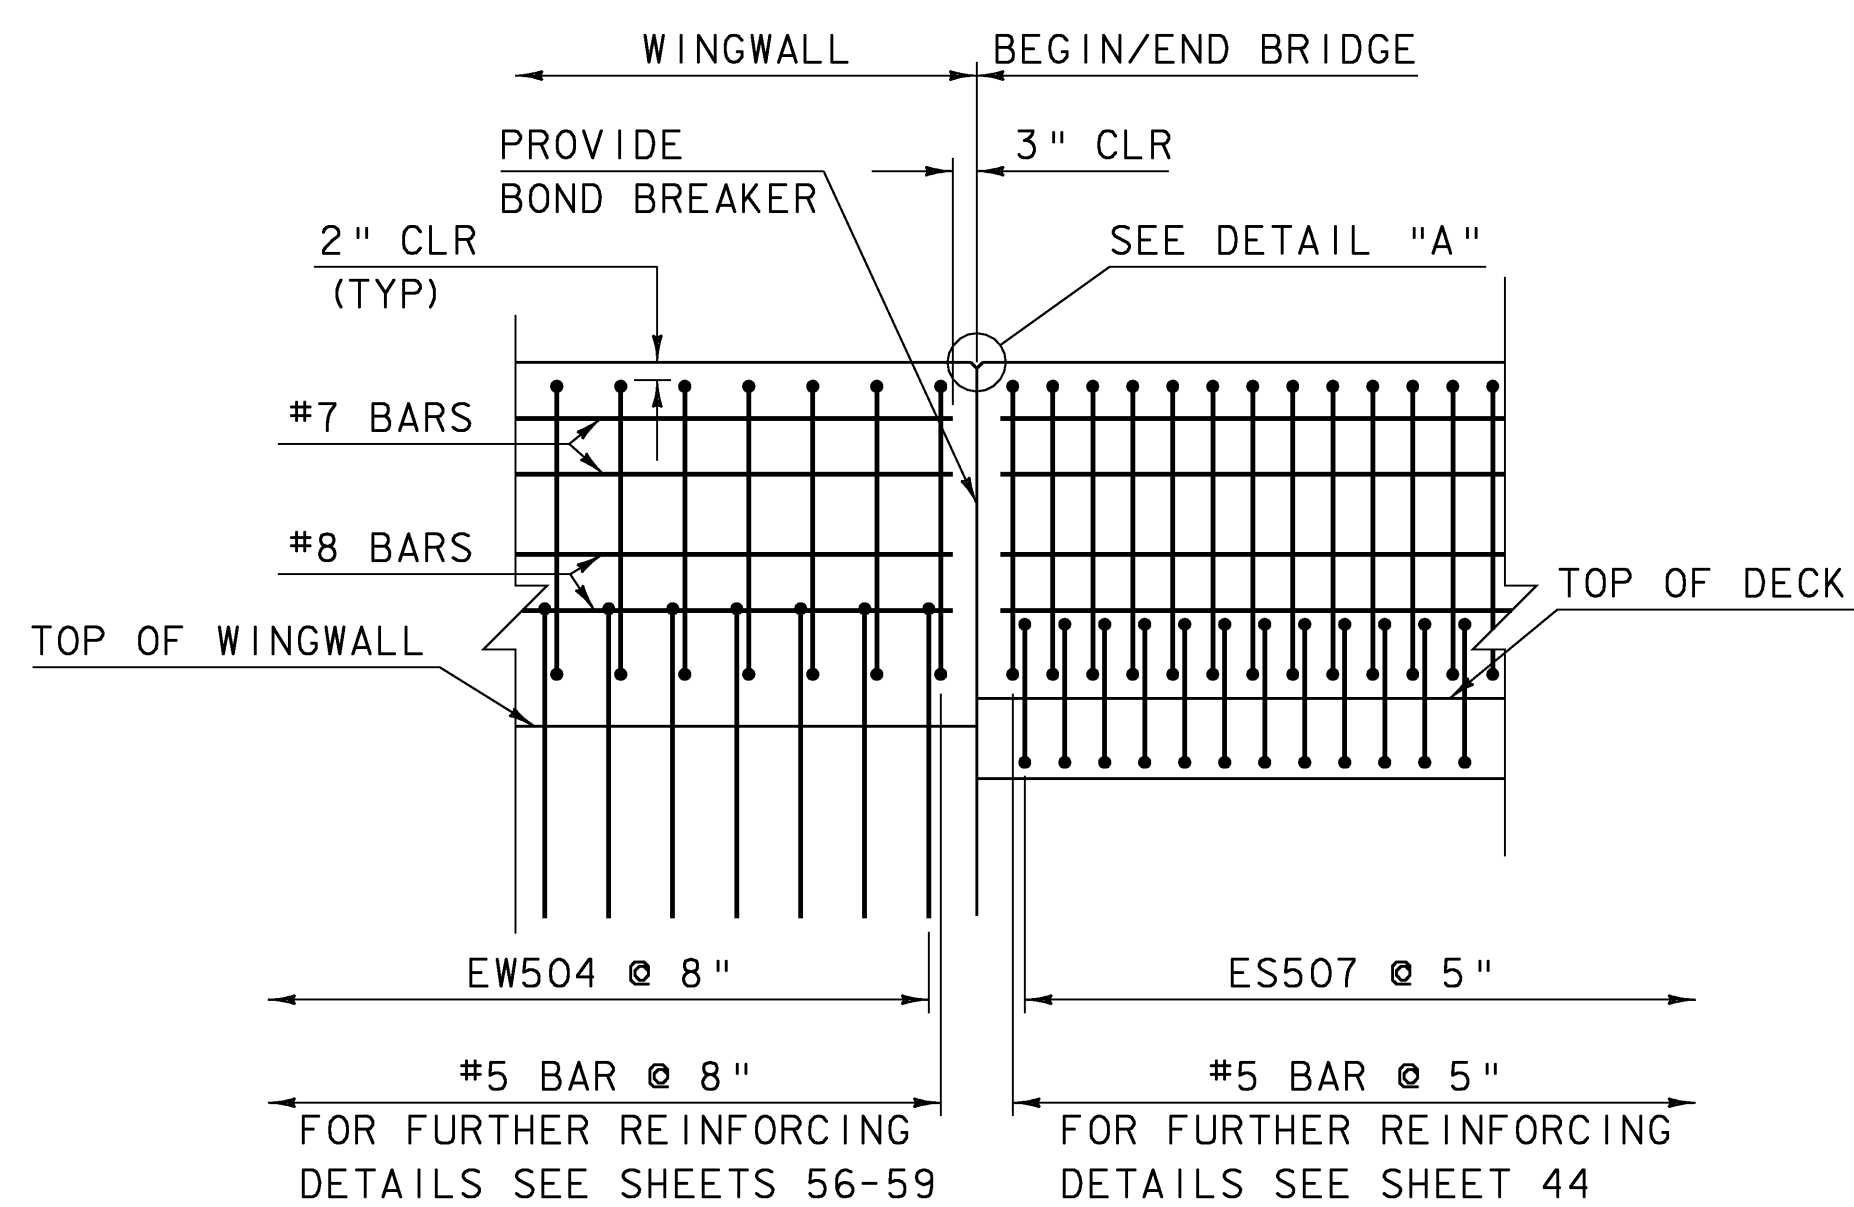


**F-SHAPE CONCRETE RAIL JOINT ELEVATION**

SCALE 1/2" = 1'-0"

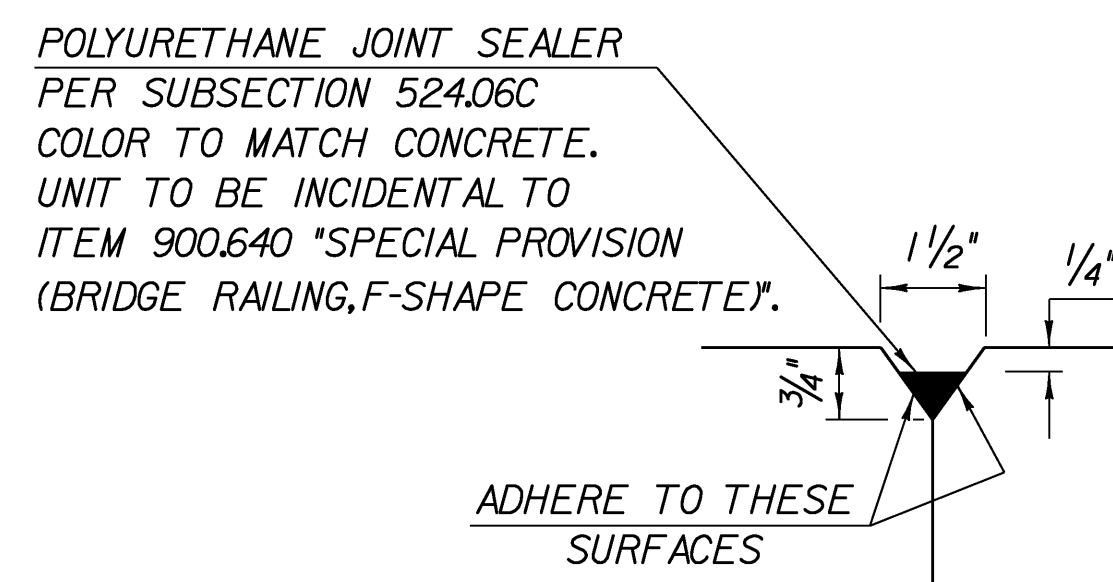

**DETAIL "A"**

SCALE 1/2" = 1'-0"

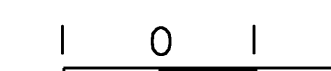

PROJECT: <b>BERLIN</b>	PROJECT NO.: <b>IM 089-1 (20)</b>
DESIGN FILE NAME: 99a270\structures\s99a270abut.dgn	
IPARM FILE NAME: s99a270abut typ. i PLOT DATE: 05-DEC-2007	
DESIGNED BY: G. SPILAK	DRAWN BY: WEEBER
SQUAD LEADER: C. P. WILLIAMS	CHECKED BY: R. S. YOUNG
ABUTMENT & WINGWALL TYP. SECTIONS SHEET: 55 OF 104	


CUT LINE FOR LOWER LIMITS OF CONCRETE REMOVAL AT CONSTRUCTION JOINT (SEE ABUTMENT DETAILS)

**NOTES:**


NF = NEAR FACE  
FF = FAR FACE  
EF = EACH FACE  
▲ = CUT TO FIT

3" CLEAR UNLESS OTHERWISE SPECIFIED ON PLANS.


ALL LAPS 2'-2" UNLESS OTHERWISE SPECIFIED ON PLANS.

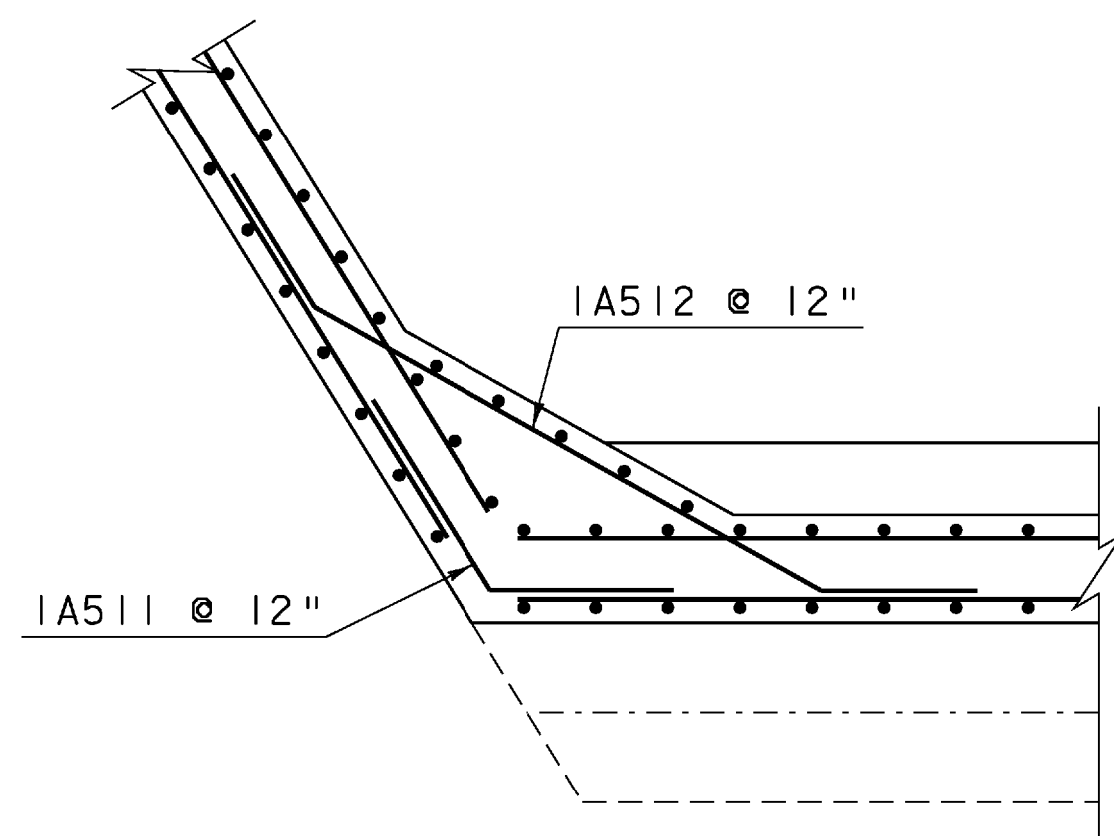


**WINGWALL #2  
CORNER DETAIL**  
SCALE 3/8" = 1'-0"

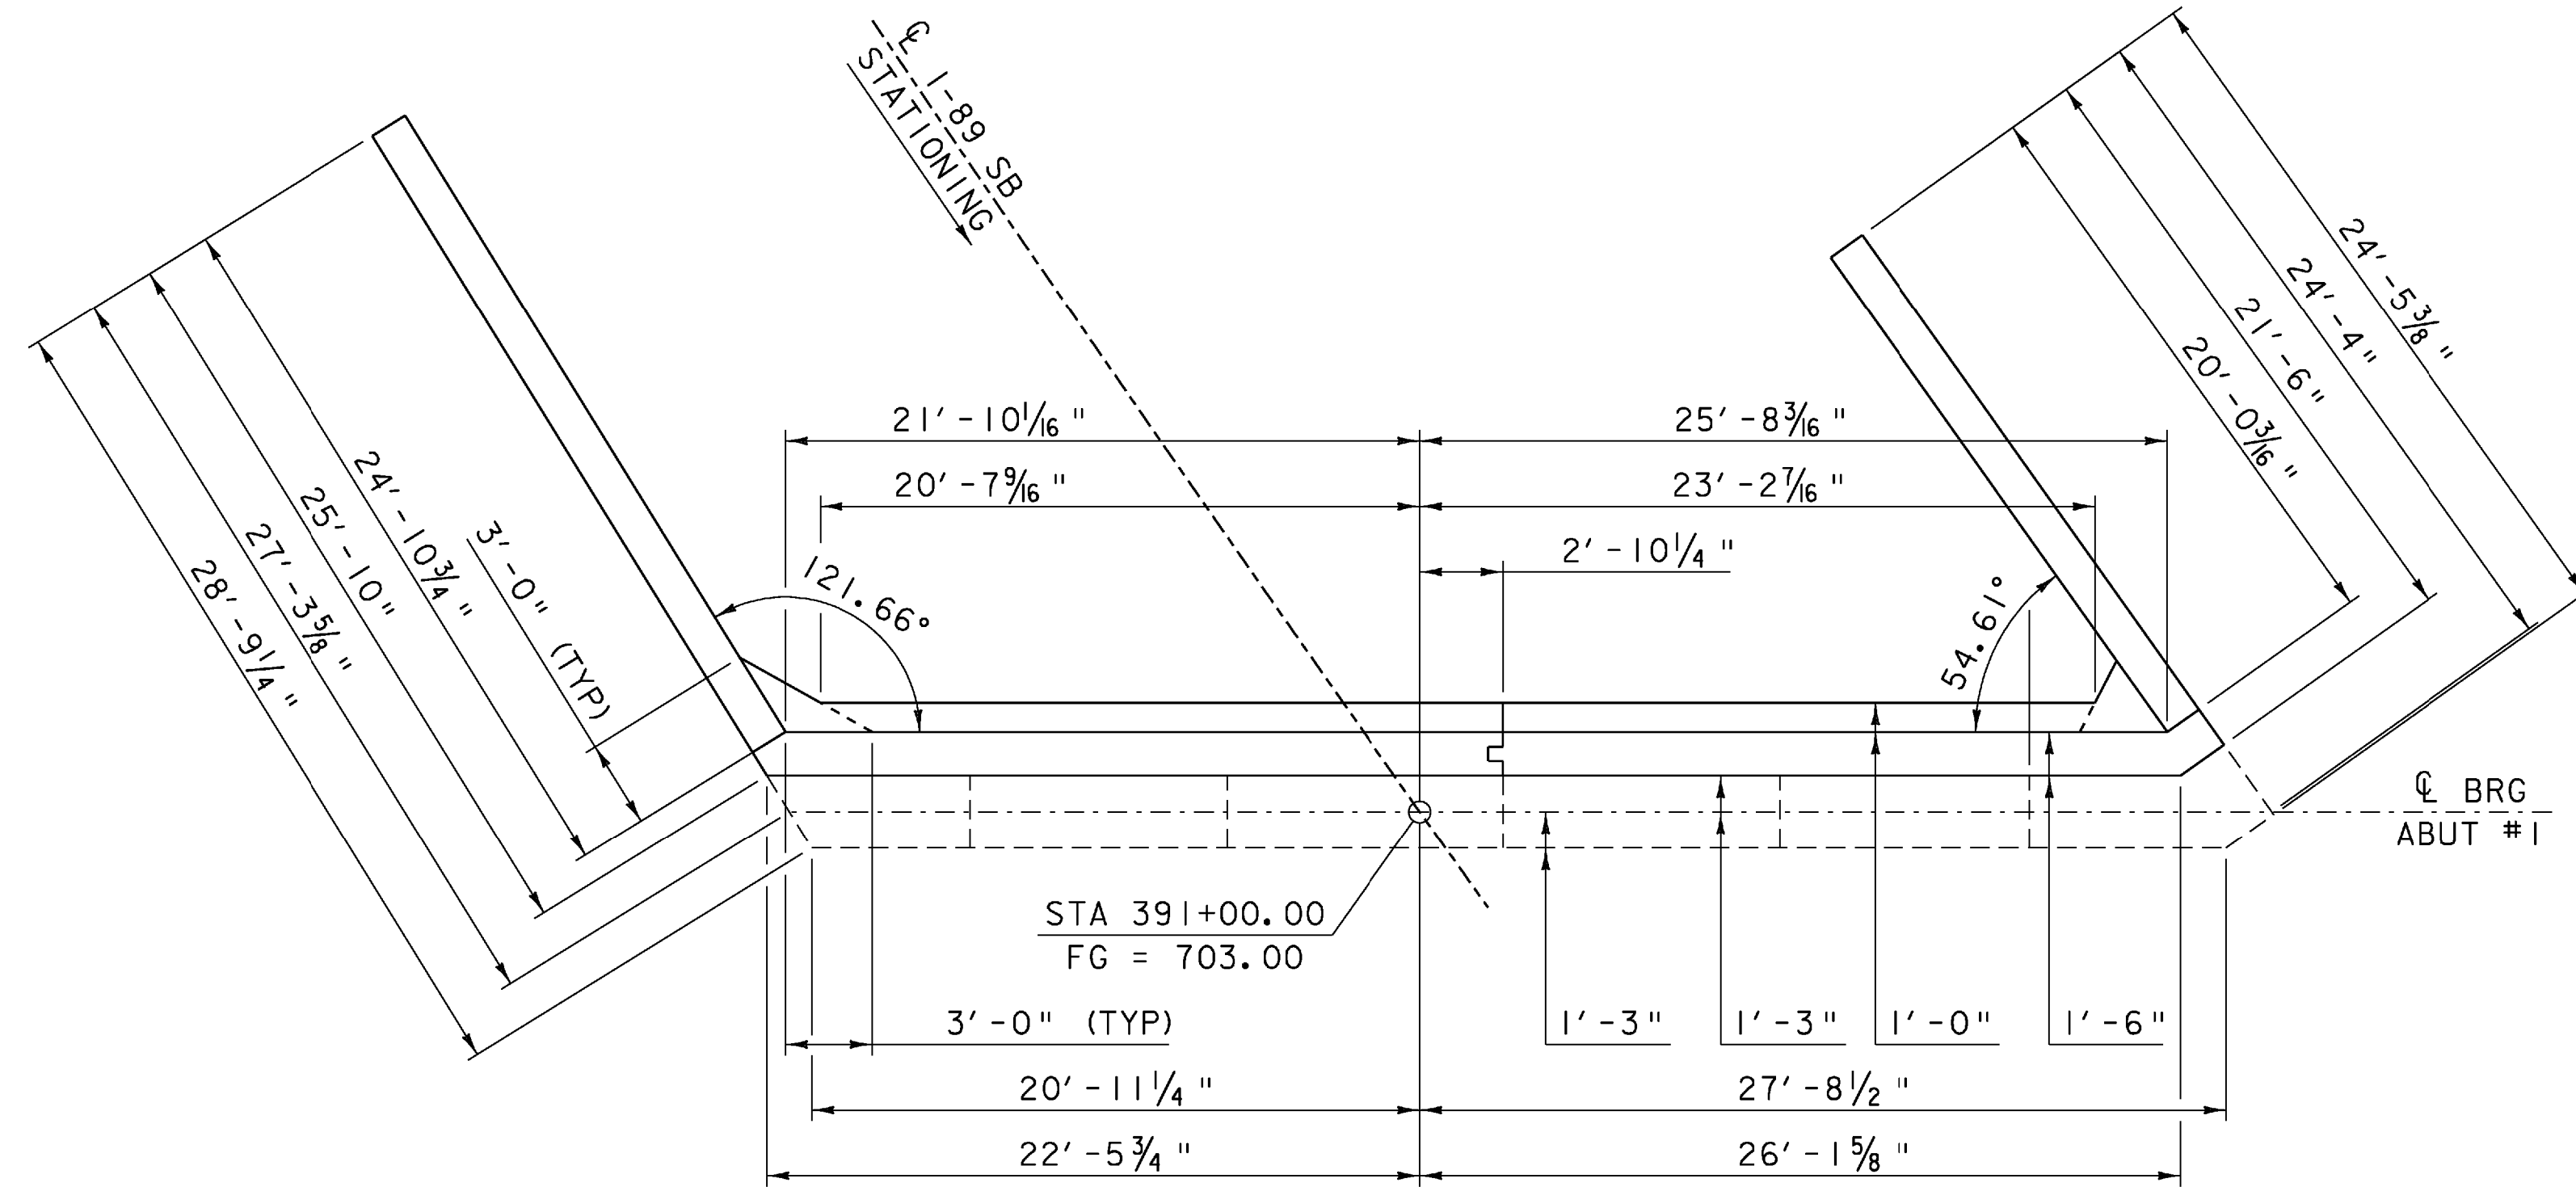


**ABUTMENT #1  
PLAN VIEW**  
SCALE 3/16" = 1'-0"

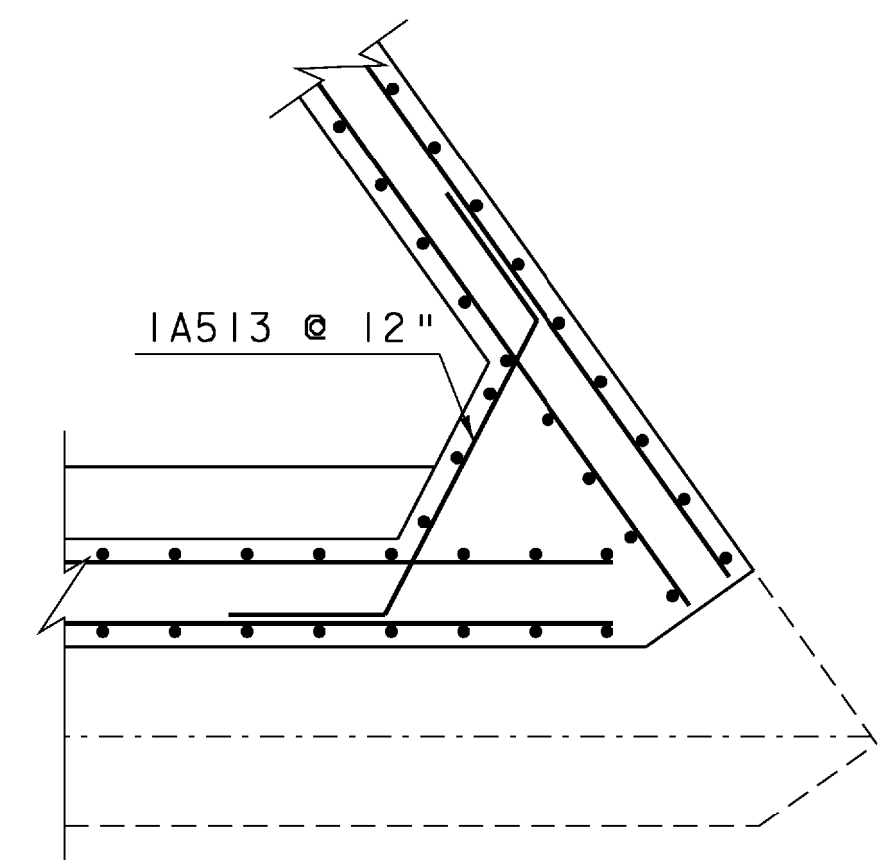


**WINGWALL #1  
CORNER DETAIL**  
SCALE 3/8" = 1'-0"

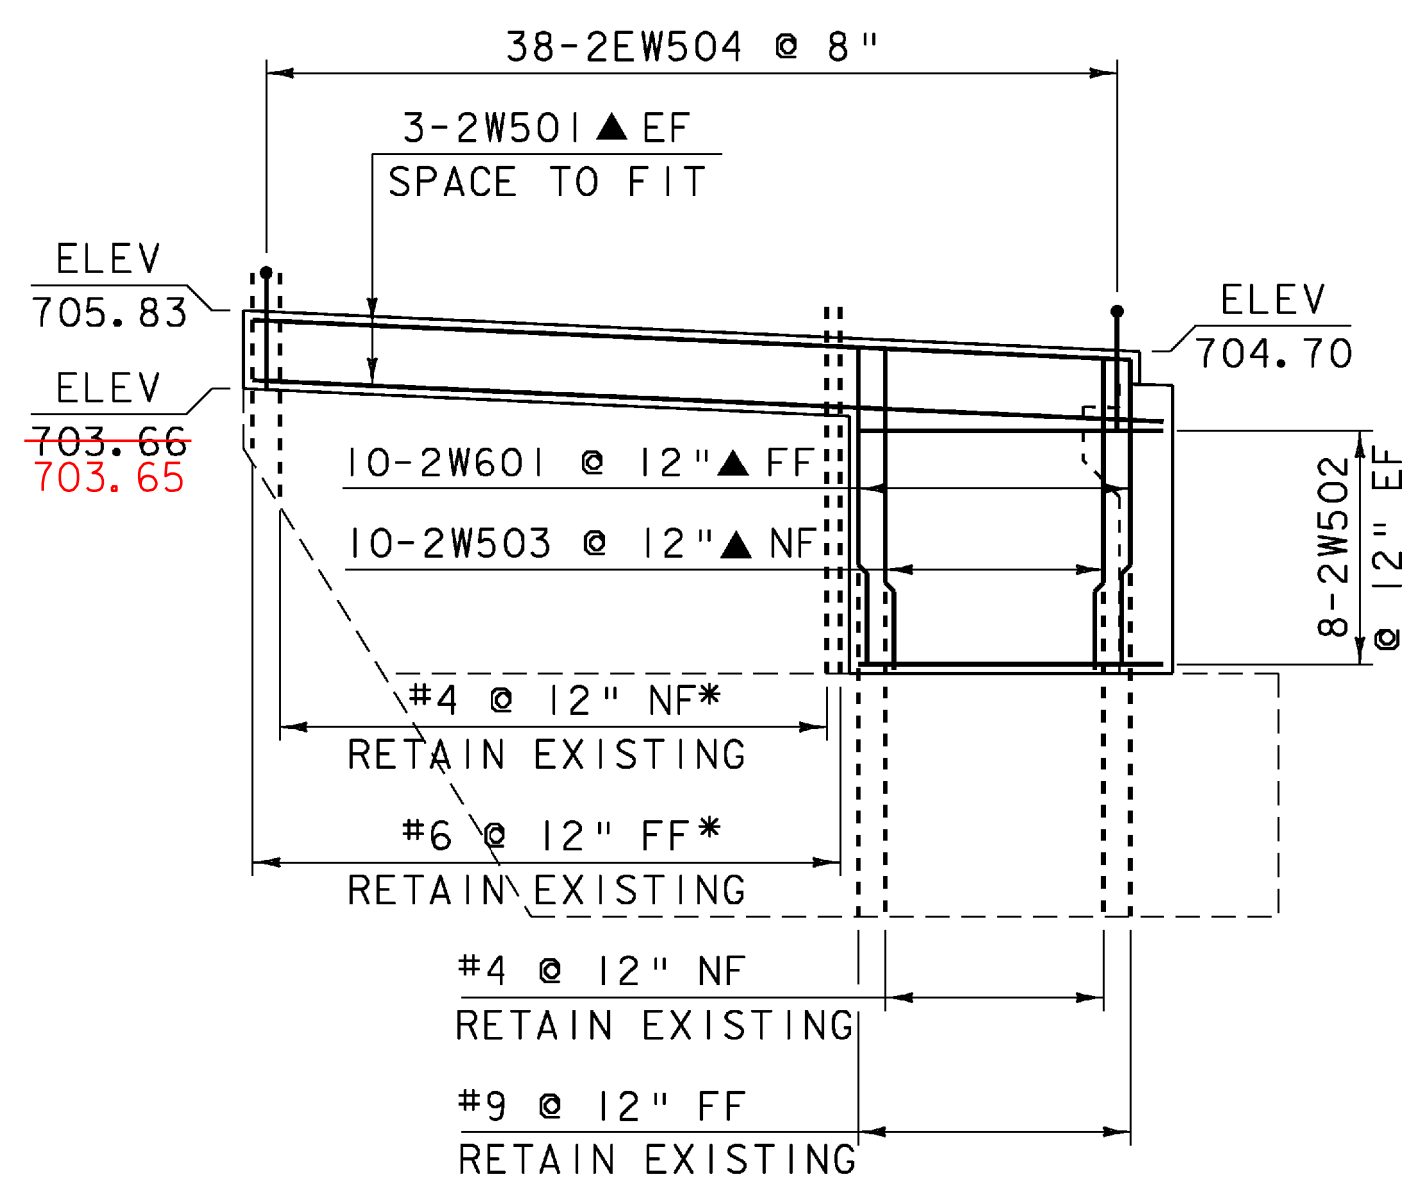

**WINGWALL #2  
ELEVATION VIEW**  
SCALE 3/16" = 1'-0"

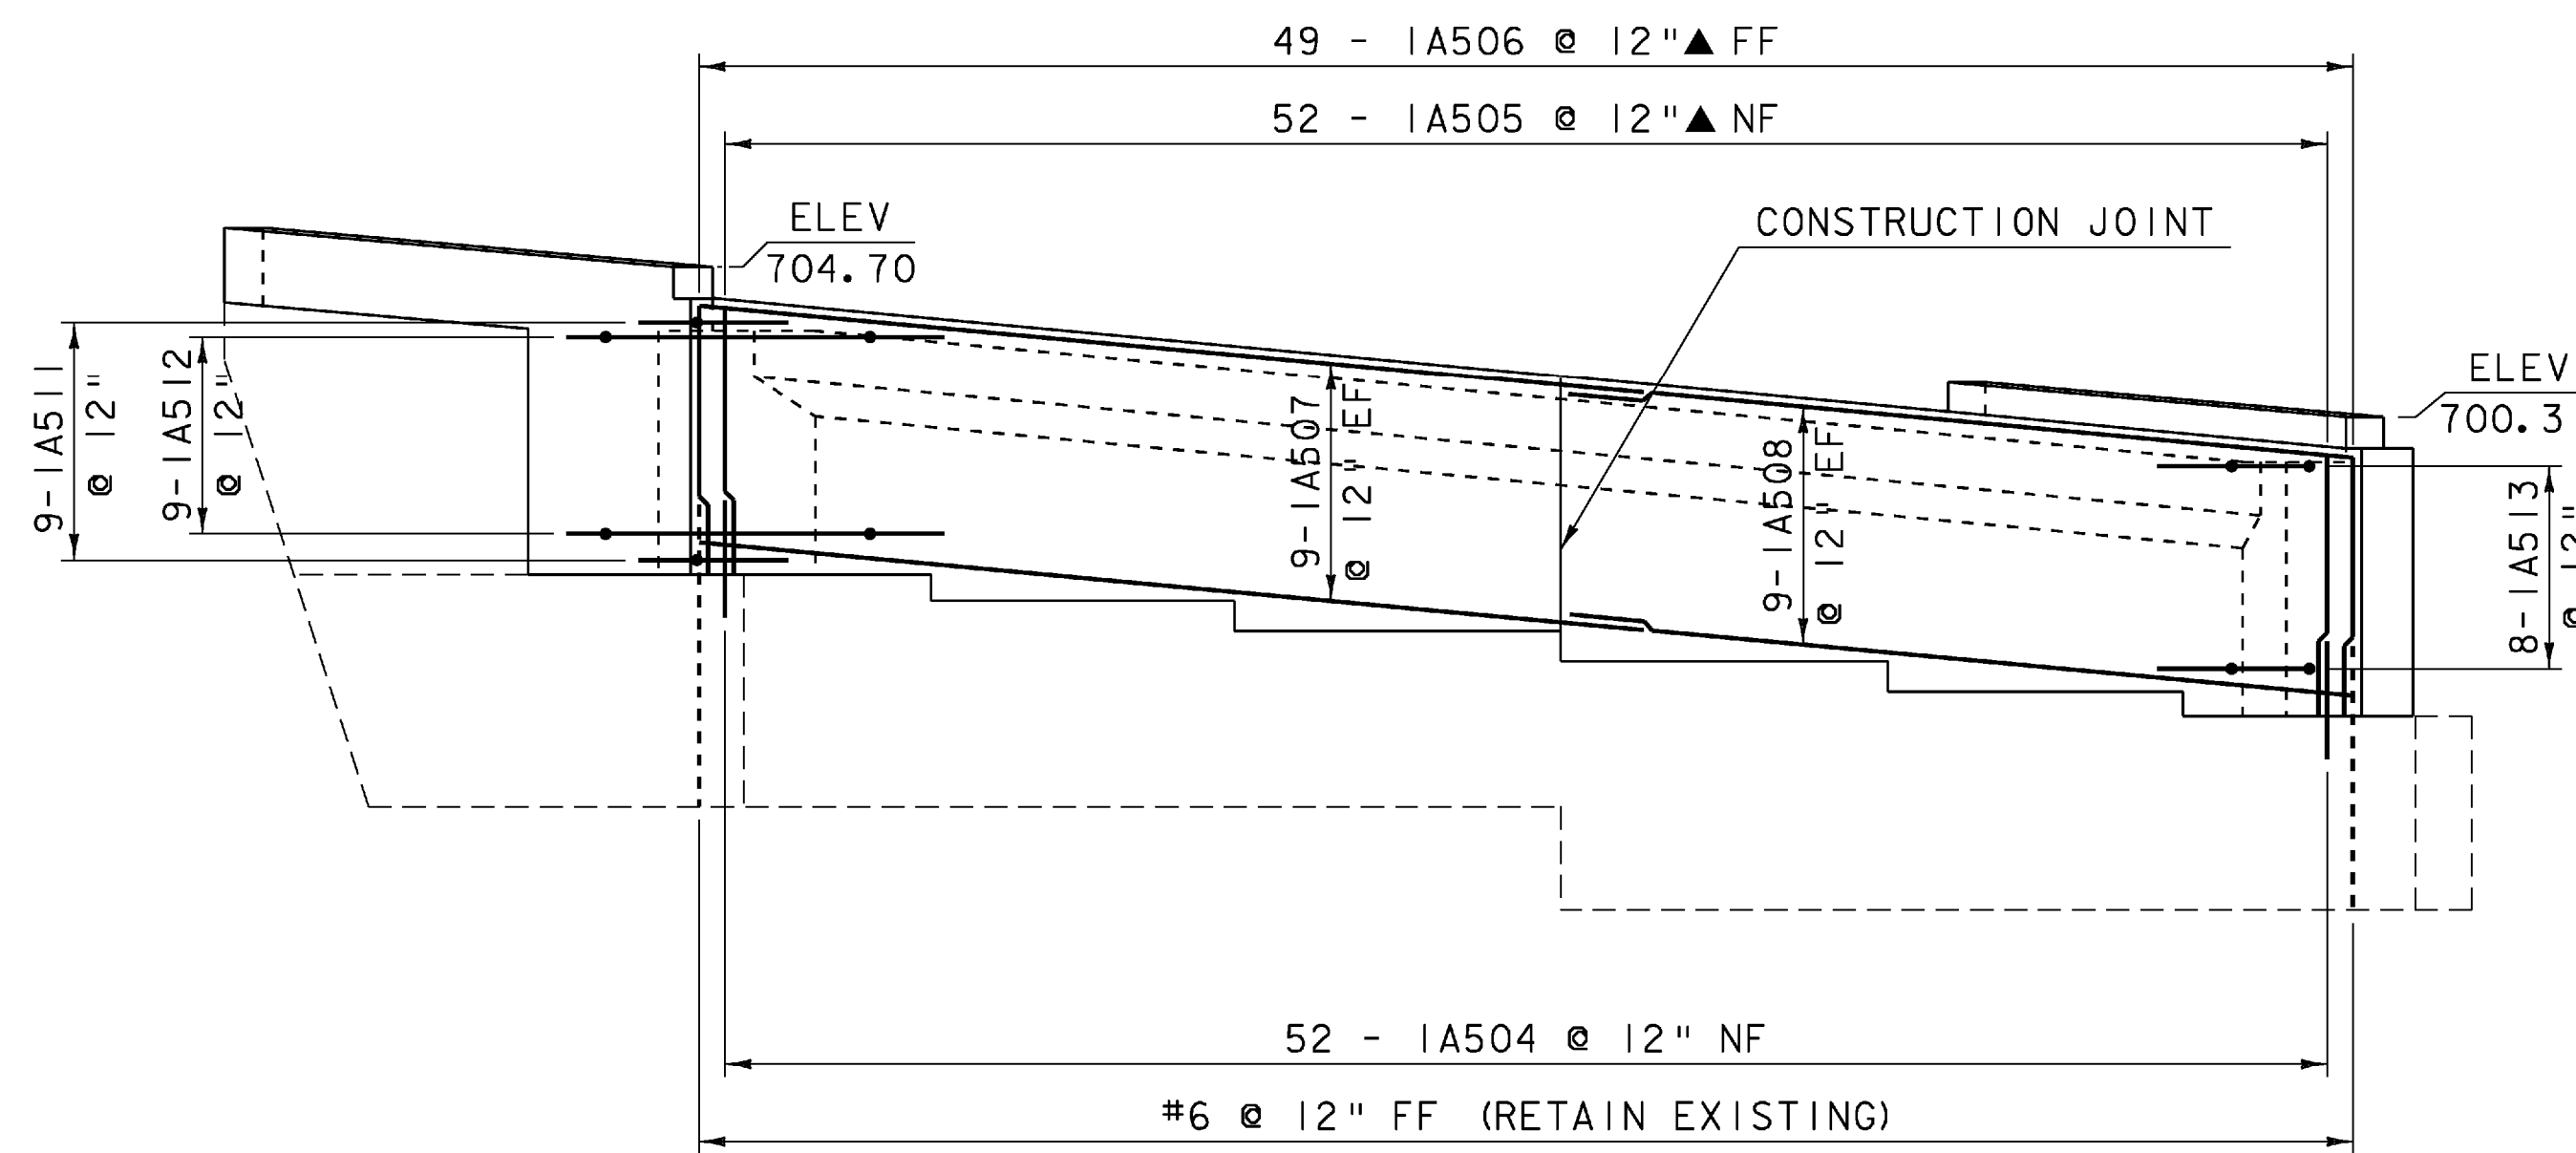

**ABUTMENT #1  
ELEVATION VIEW**  
SCALE 3/16" = 1'-0"

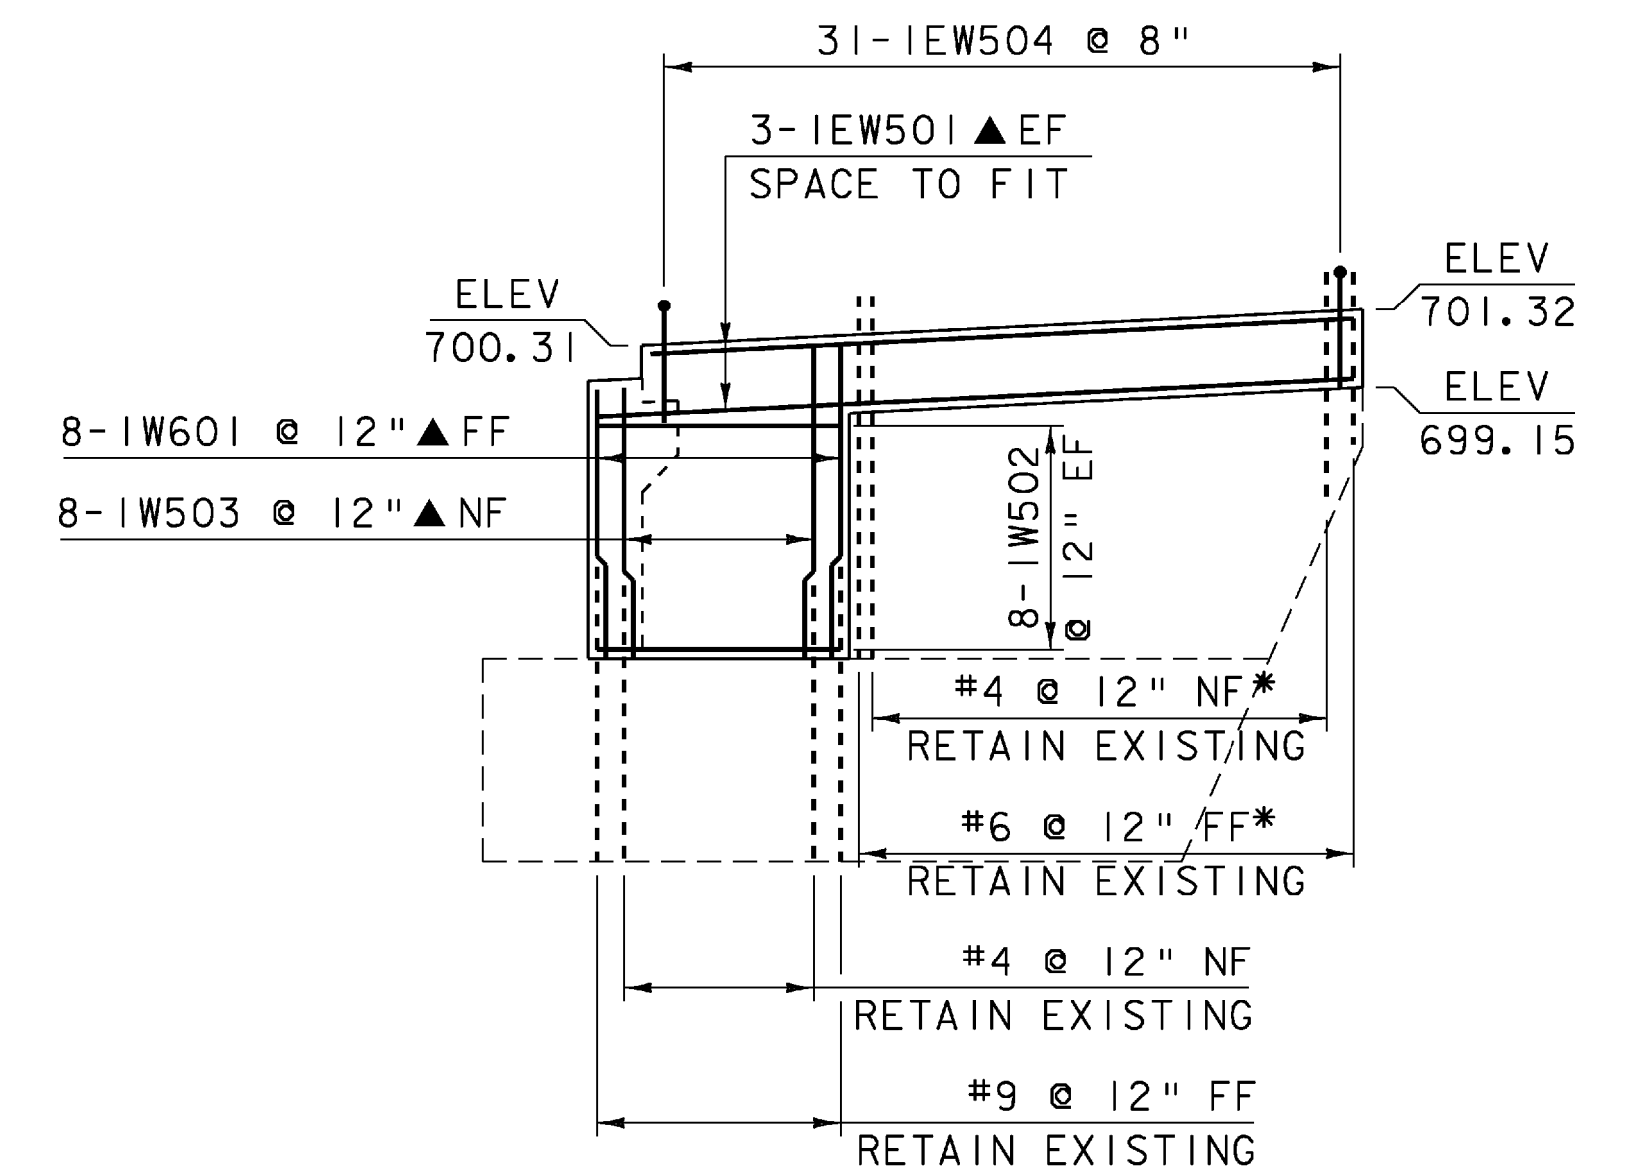

**WINGWALL #1  
ELEVATION VIEW**  
SCALE 3/16" = 1'-0"

**NOTES:**



- NF = NEAR FACE
- FF = FAR FACE
- EF = EACH FACE
- ▲ = CUT TO FIT

3" CLEAR UNLESS OTHERWISE SPECIFIED ON PLANS.


ALL LAPS 2'-2" UNLESS OTHERWISE SPECIFIED ON PLANS.

SEE SHEET 55 FOR SECTION DETAILS


\* IF EXISTING REINFORCING STEEL INTERFERES WITH NEW RAIL CONCRETE, BAR MAY BE BENT TO ACCOMMODATE NEW CONCRETE CLEARANCE REQUIREMENTS.

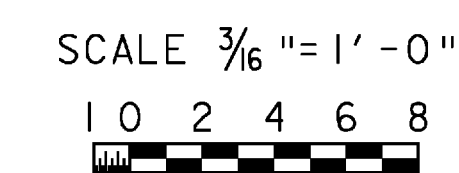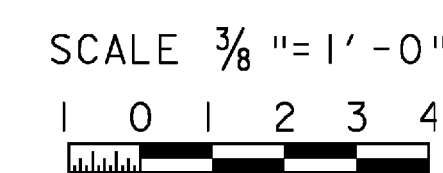


PROJECT: <b>BERLIN</b>	PROJECT NO. : <b>IM 089-1 (20)</b>
DESIGN FILE NAME: 99a270\structures\99a270abut.dgn	PLOT DATE: 05-DEC-2007
IPARM FILE NAME: s99a270abut1.i	DESIGNED BY: G. SPILAK
SQUAD LEADER: C.P. WILLIAMS	DRAWN BY: WEEBER
ABUTMENT #1 DETAILS	CHECKED BY: R. S. YOUNG
	SHEET: 56 OF 104

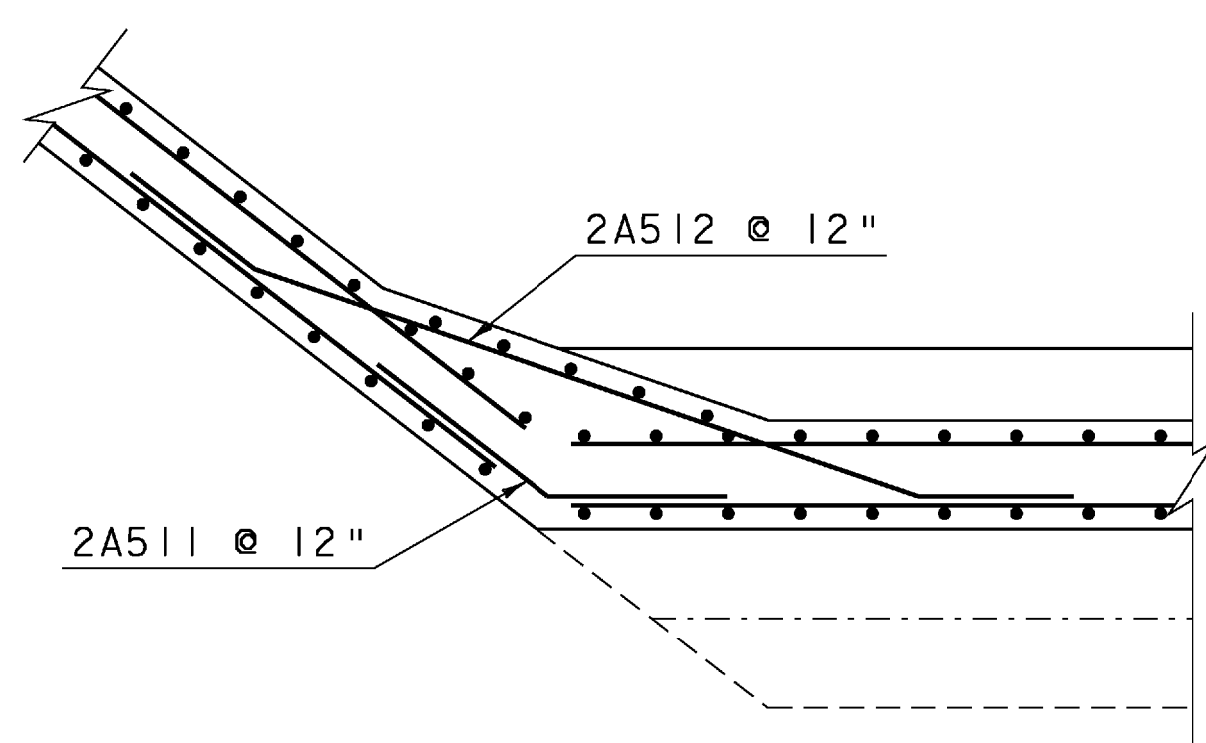


**WINGWALL #3  
CORNER DETAIL**  
SCALE 3/16" = 1'-0"

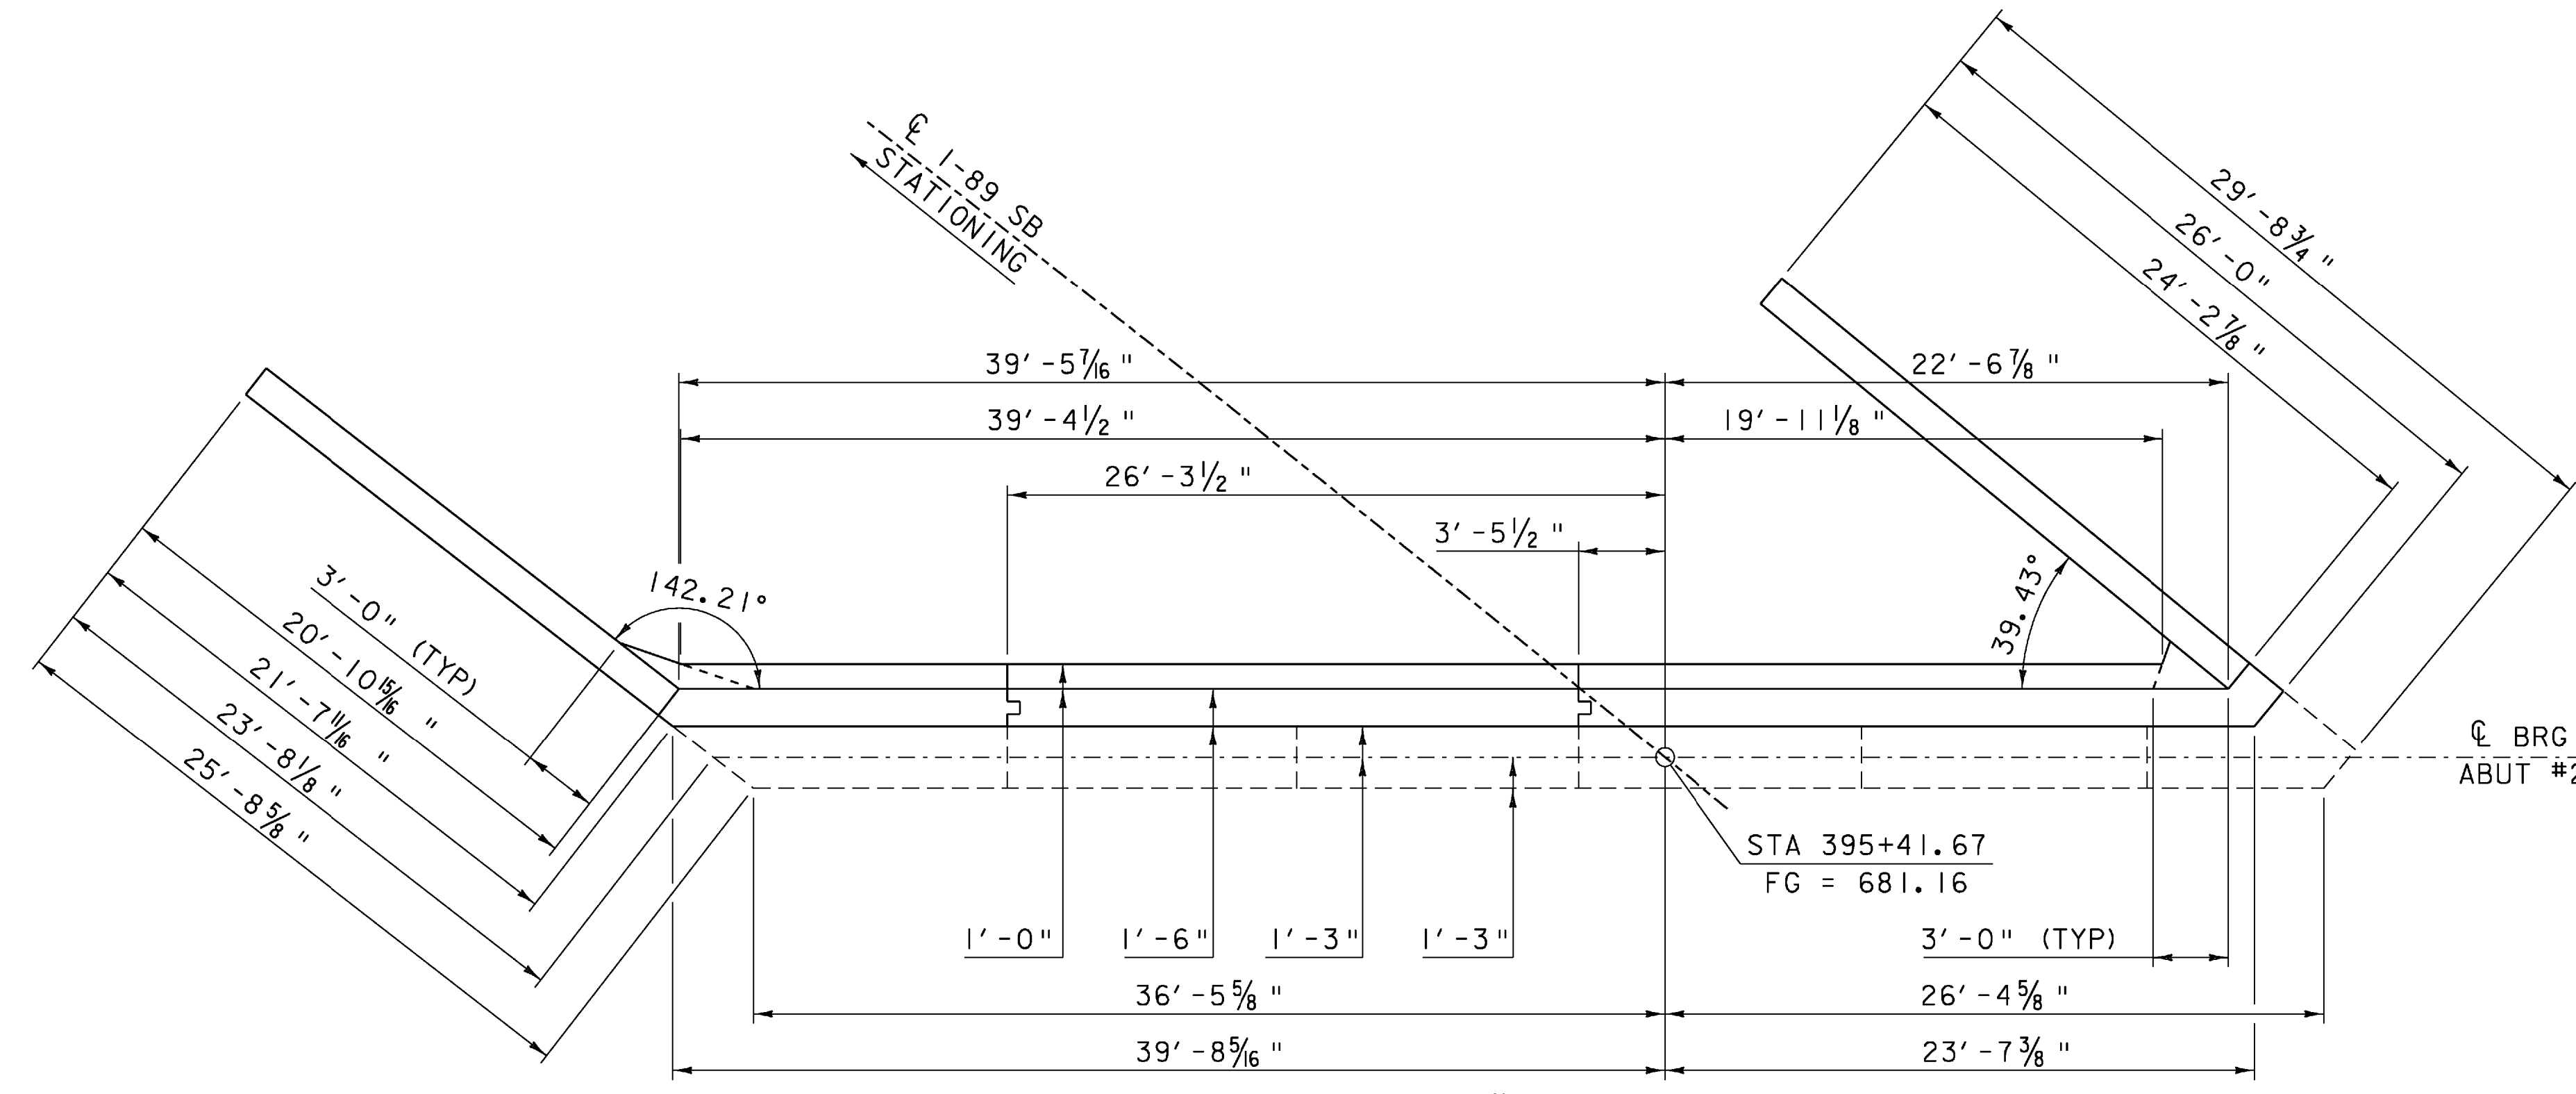


**ABUTMENT #2  
PLAN VIEW**  
SCALE 3/16" = 1'-0"

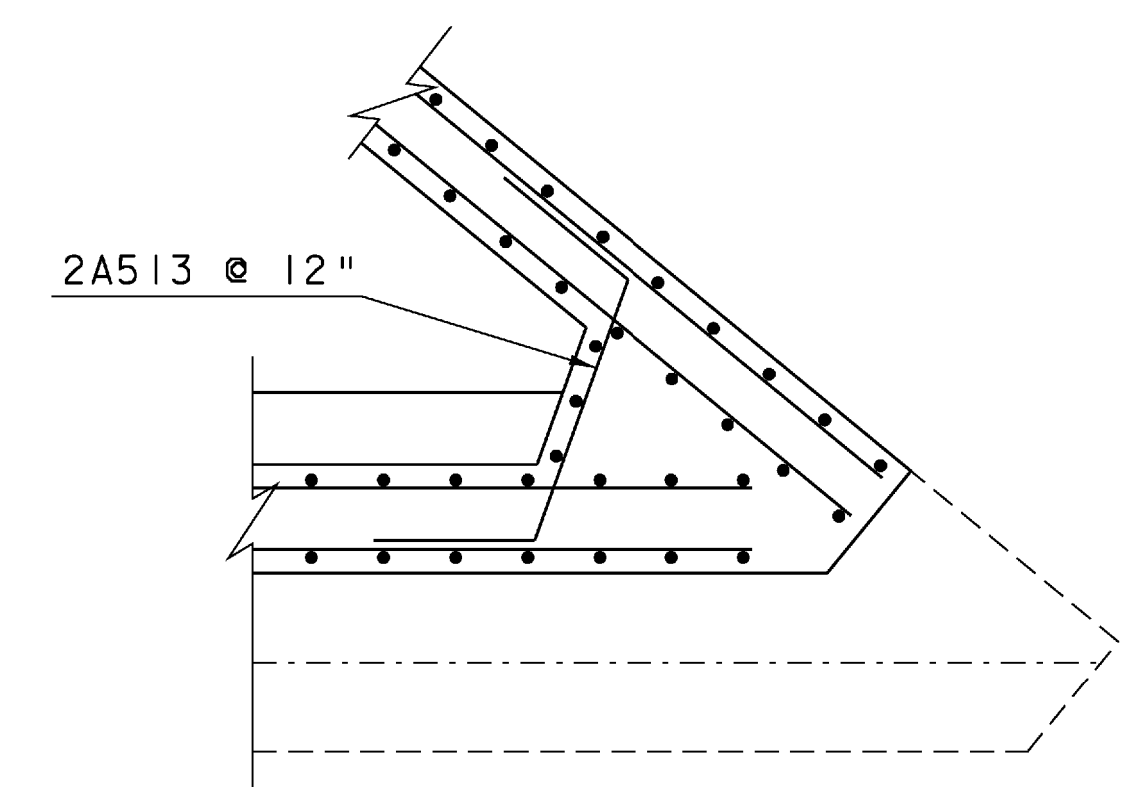


**WINGWALL #4  
CORNER DETAIL**  
SCALE 3/16" = 1'-0"

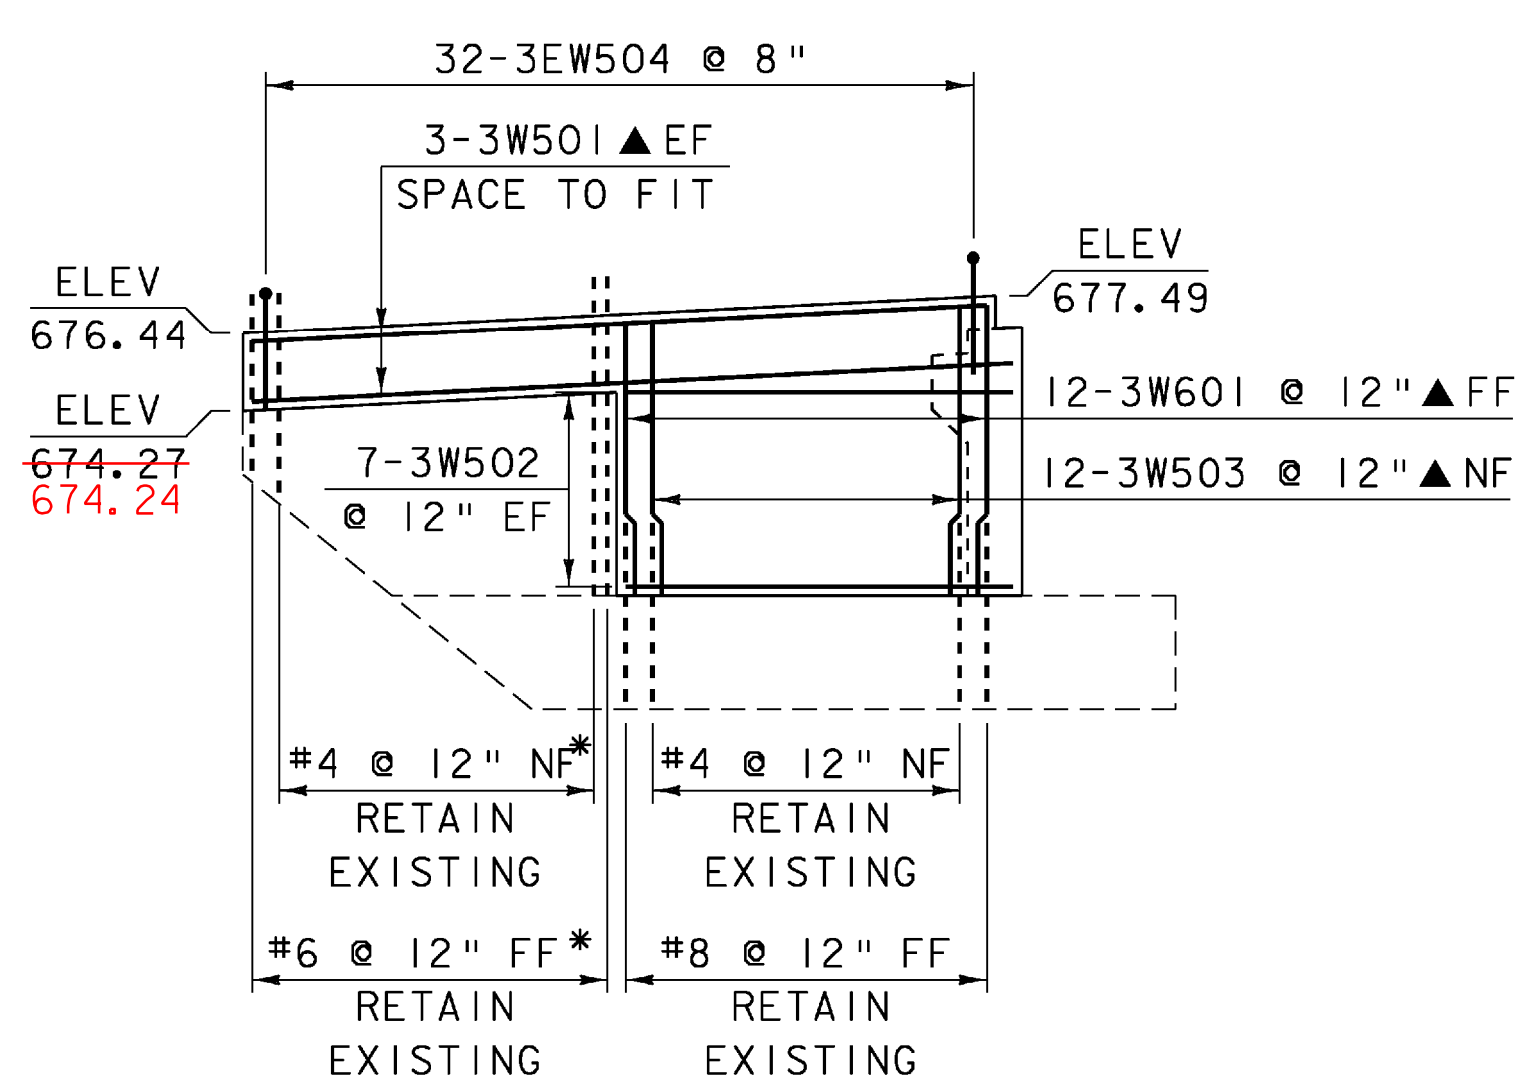

**WINGWALL #3  
ELEVATION VIEW**  
SCALE 3/16" = 1'-0"

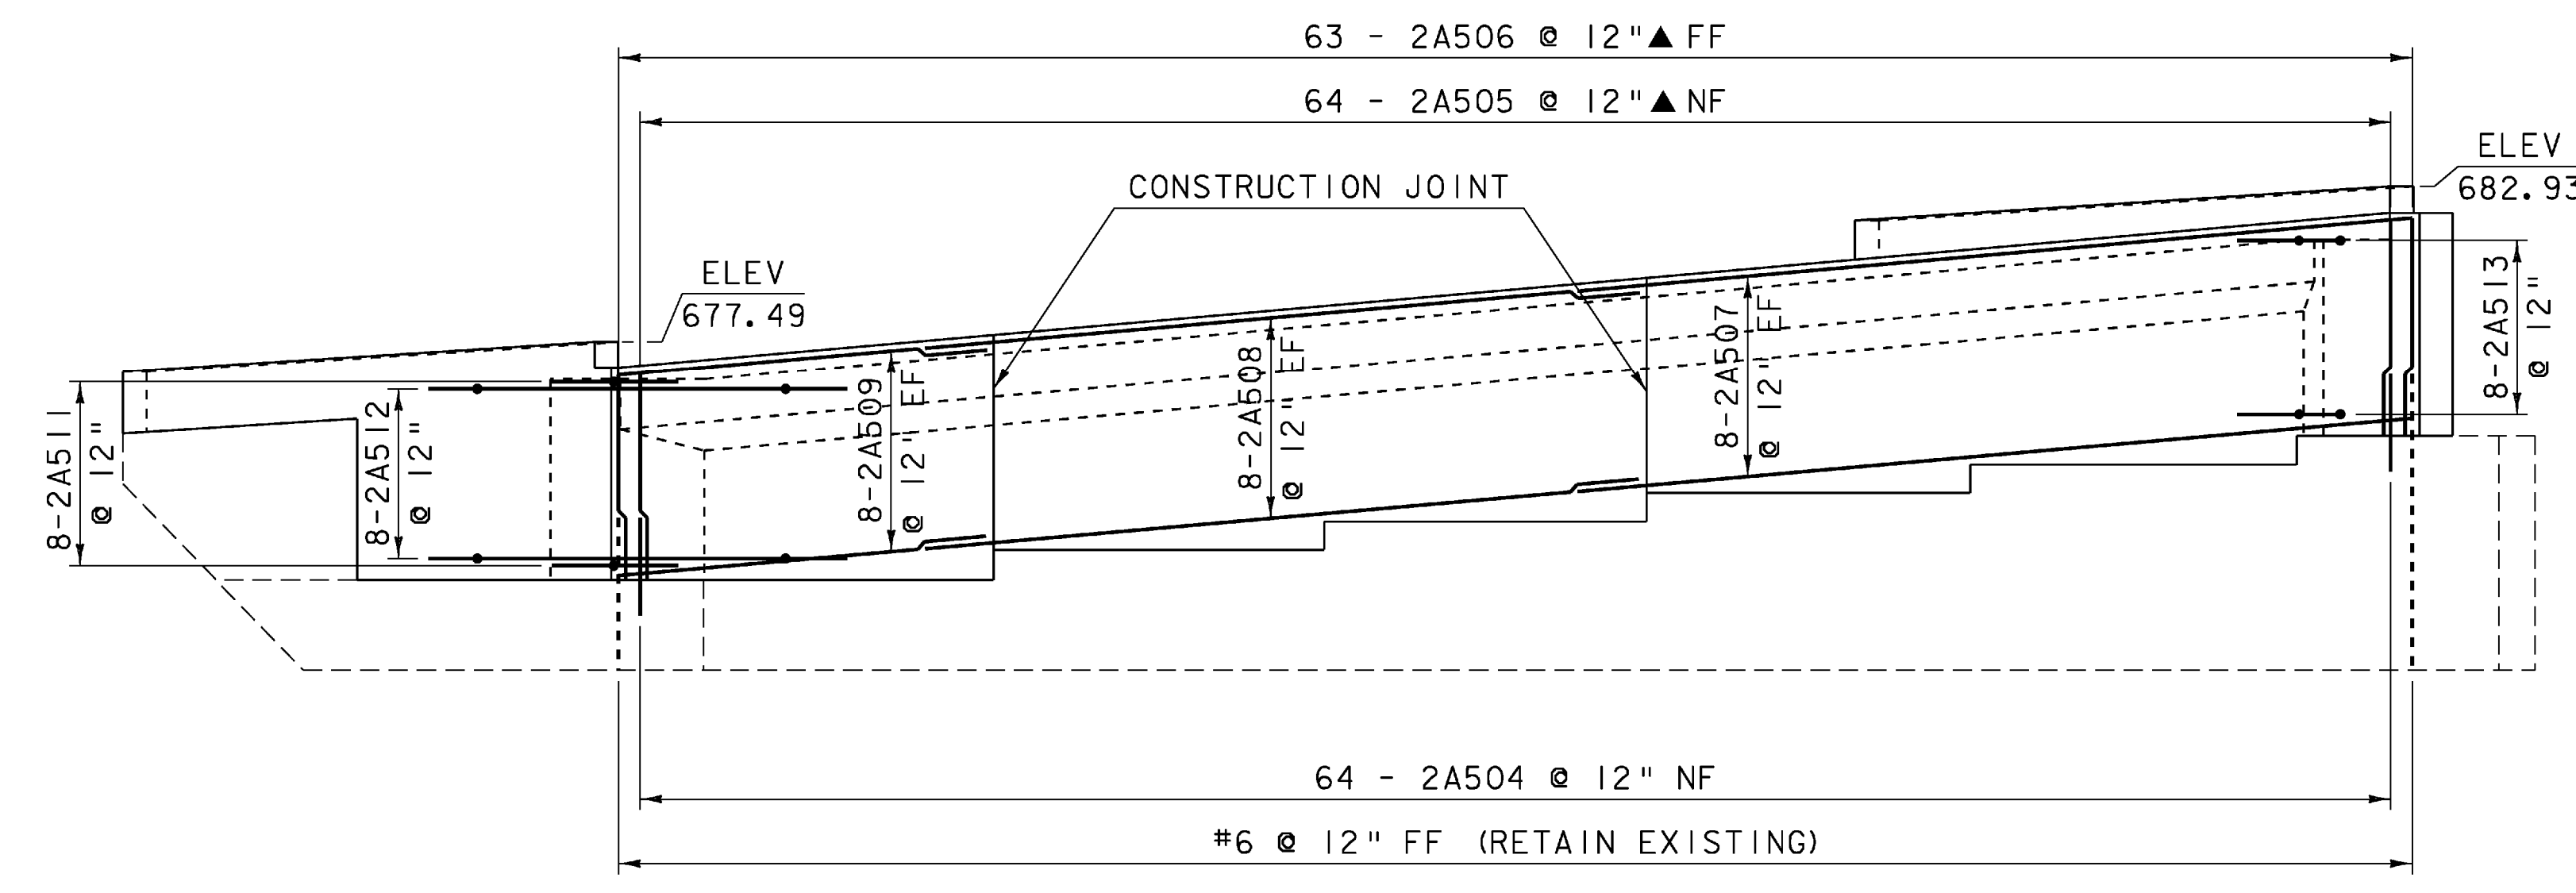

**ABUTMENT #2  
ELEVATION VIEW**  
SCALE 3/16" = 1'-0"

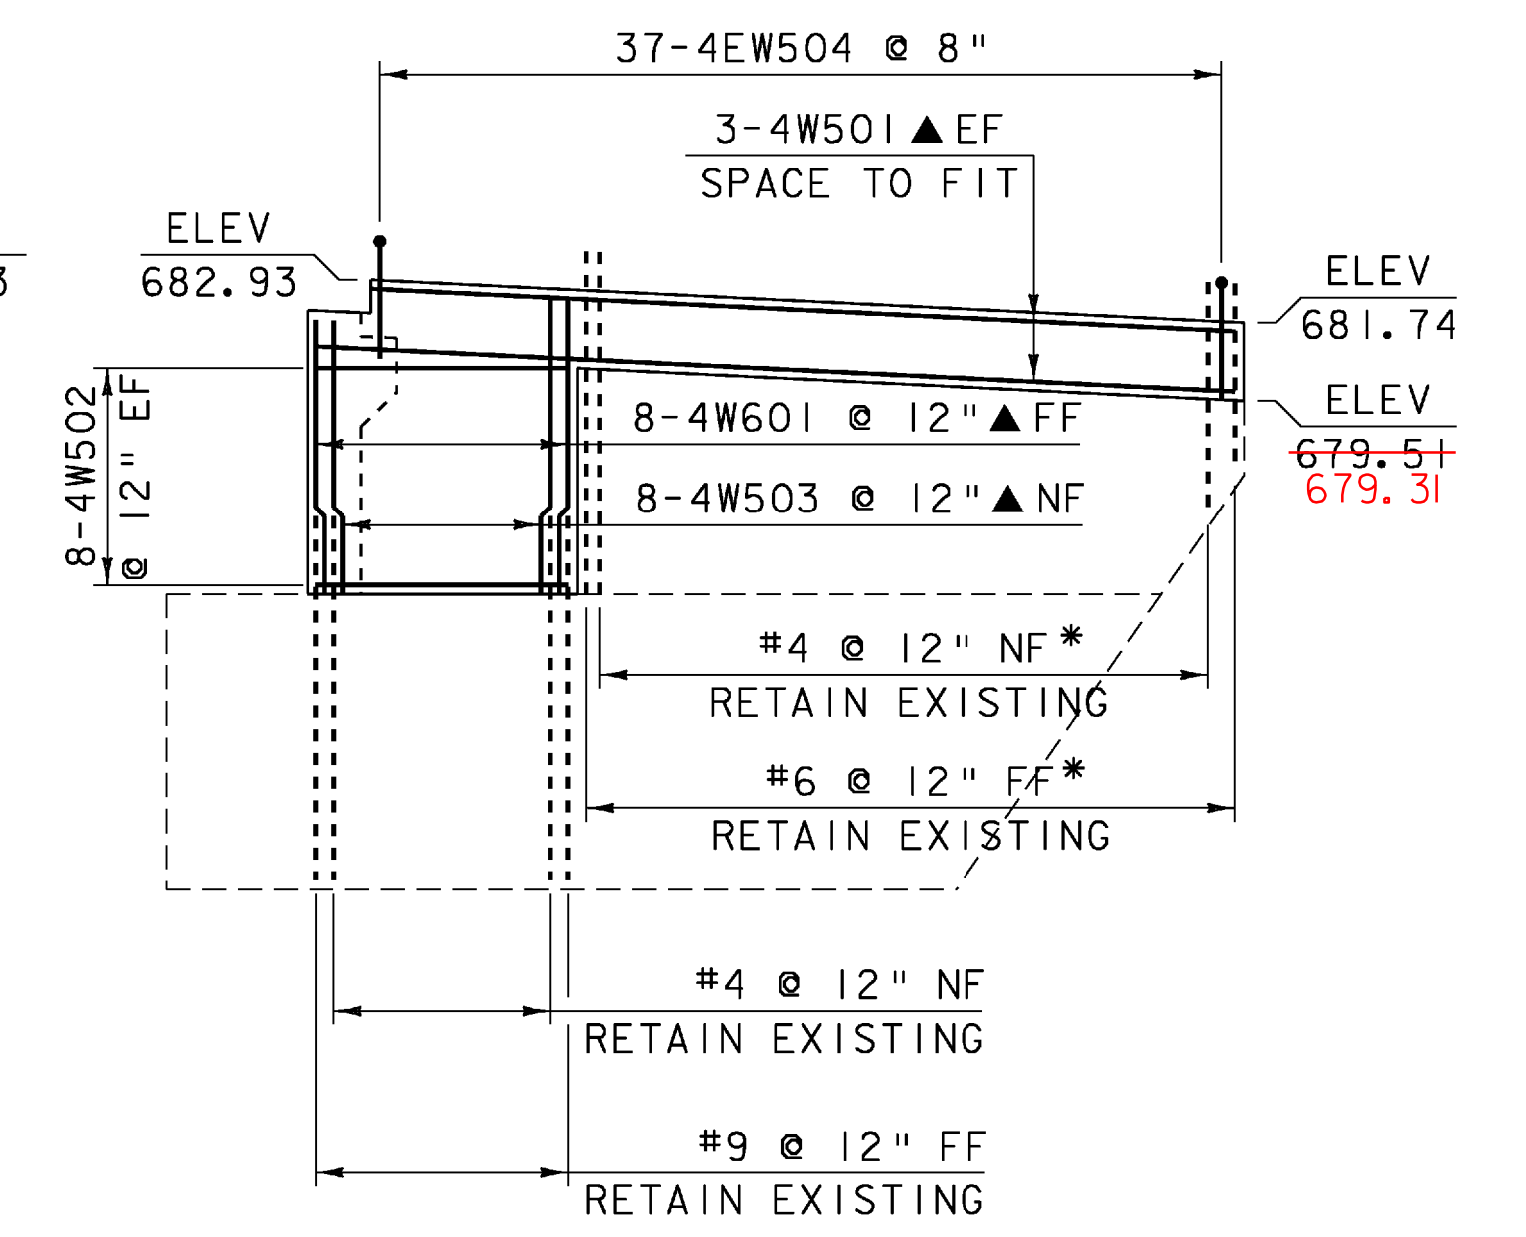


**WINGWALL #4  
ELEVATION VIEW**  
SCALE 3/16" = 1'-0"


**NOTES:**

NF = NEAR FACE  
FF = FAR FACE  
EF = EACH FACE  
▲ = CUT TO FIT  
  
3" CLEAR UNLESS OTHERWISE SPECIFIED ON PLANS.  
  
ALL LAPS 2'-2" UNLESS OTHERWISE SPECIFIED ON PLANS.


SEE SHEET 55 FOR SECTION DETAILS  
\* IF EXISTING REINFORCING STEEL INTERFERES WITH NEW RAIL CONCRETE, BAR MAY BE BENT TO ACCOMMODATE NEW CONCRETE CLEARANCE REQUIREMENTS.

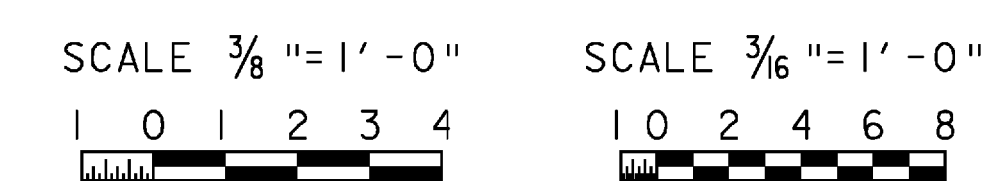


PROJECT: <b>BERLIN</b>		PROJECT NO. : <b>IM 089-1 (20)</b>	
DESIGN FILE NAME: s99a270\structures\s99a270abut.dgn	IPARM FILE NAME: s99a270abut2.i	DESIGNED BY: G.SPIILAK	PLANNED BY: WEEBER
SQUAD LEADER: C.P.WILLIAMS	ABUTMENT #2 DETAILS	CHECKED BY: R.S.YOUNG	SHEET: 57 OF 104

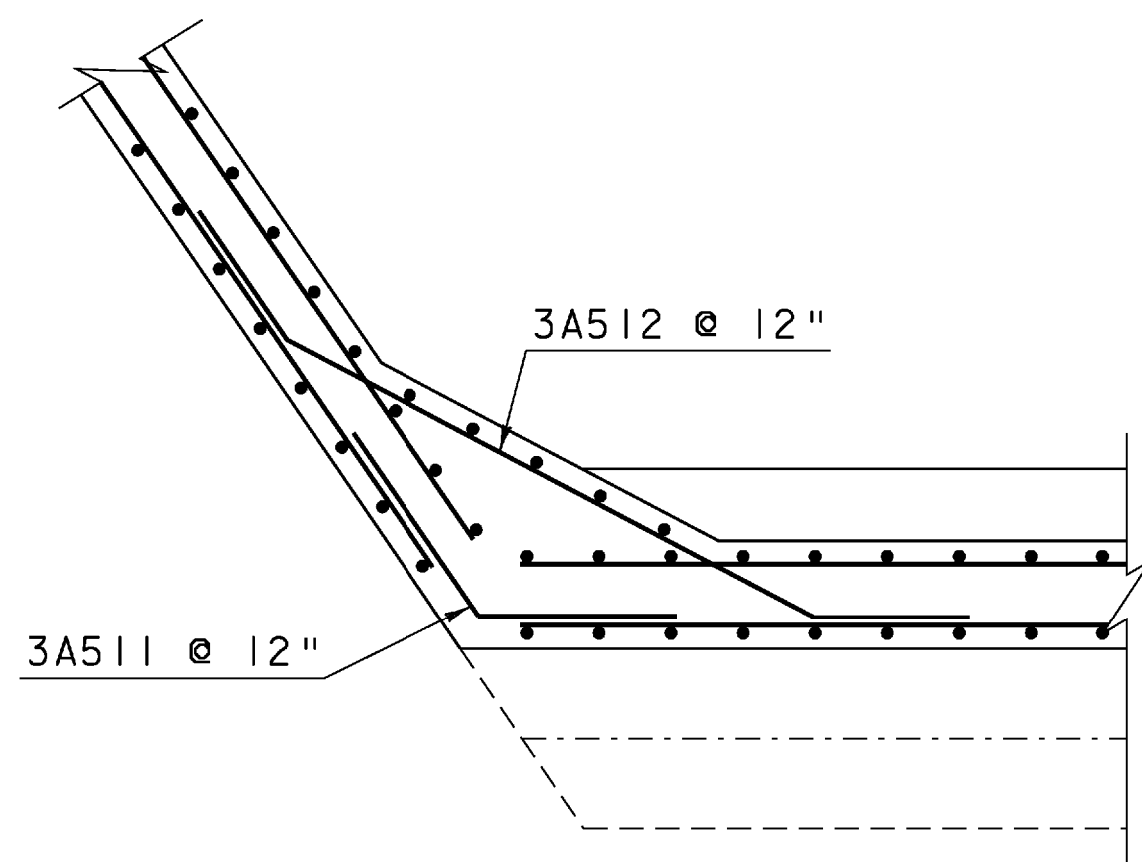


**WINGWALL #6  
CORNER DETAIL**  
SCALE 3/8" = 1'-0"

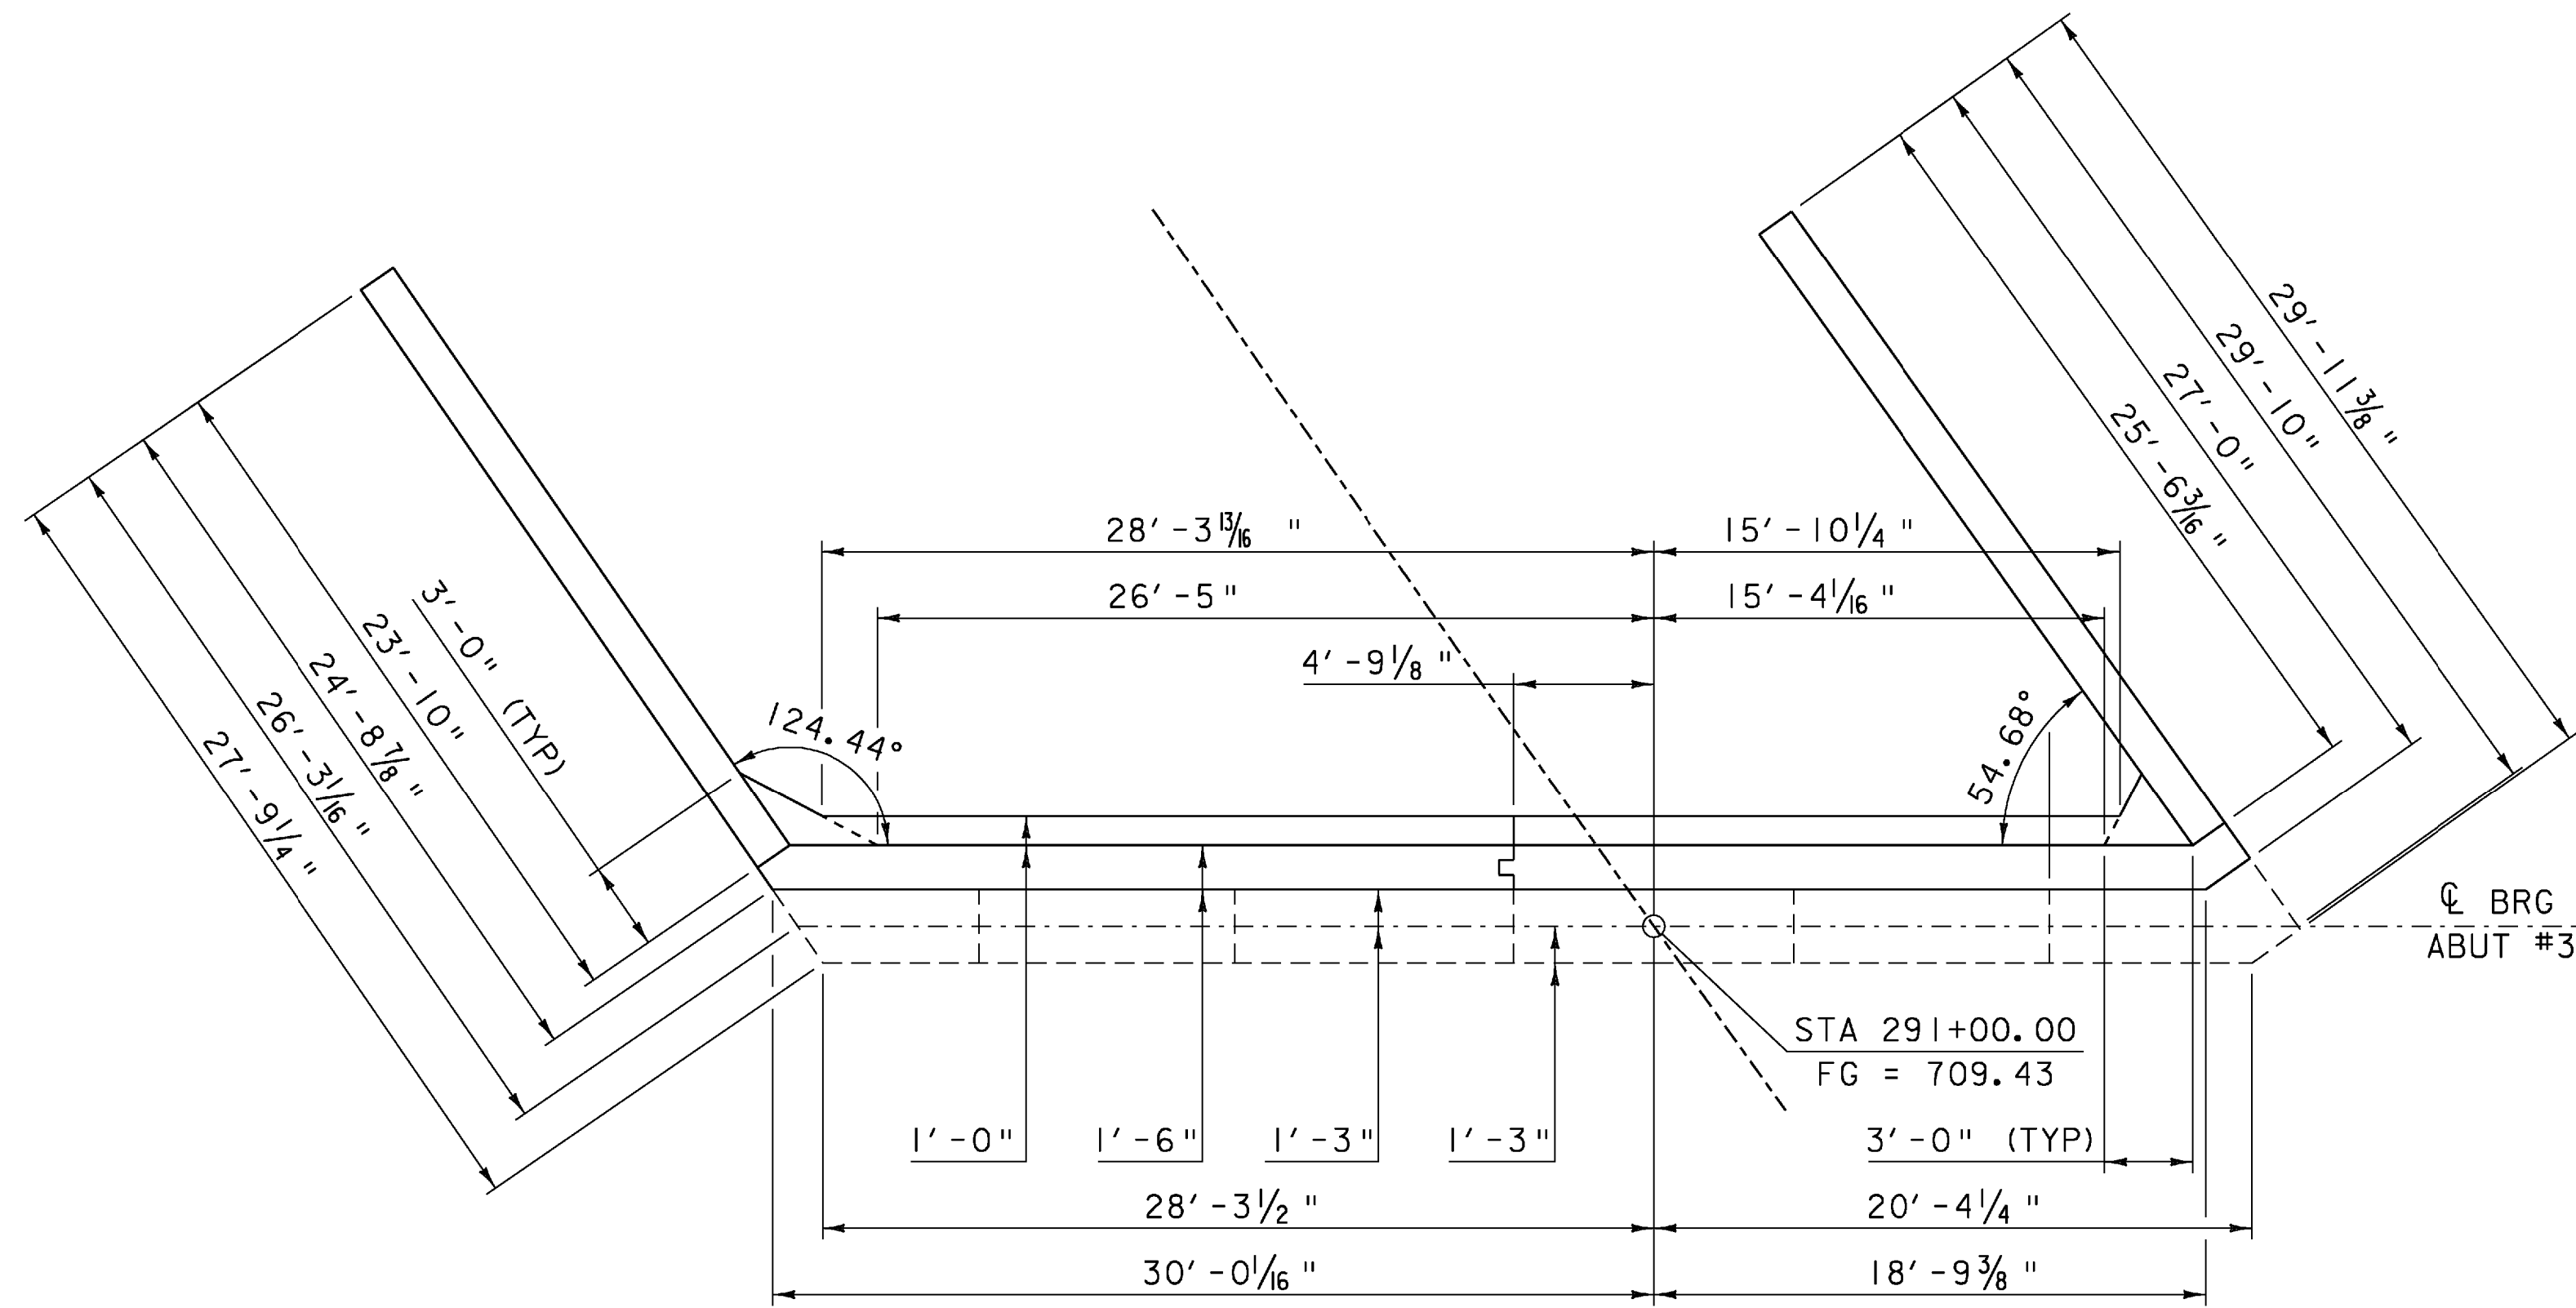


**ABUTMENT #3  
PLAN VIEW**  
SCALE 3/16" = 1'-0"

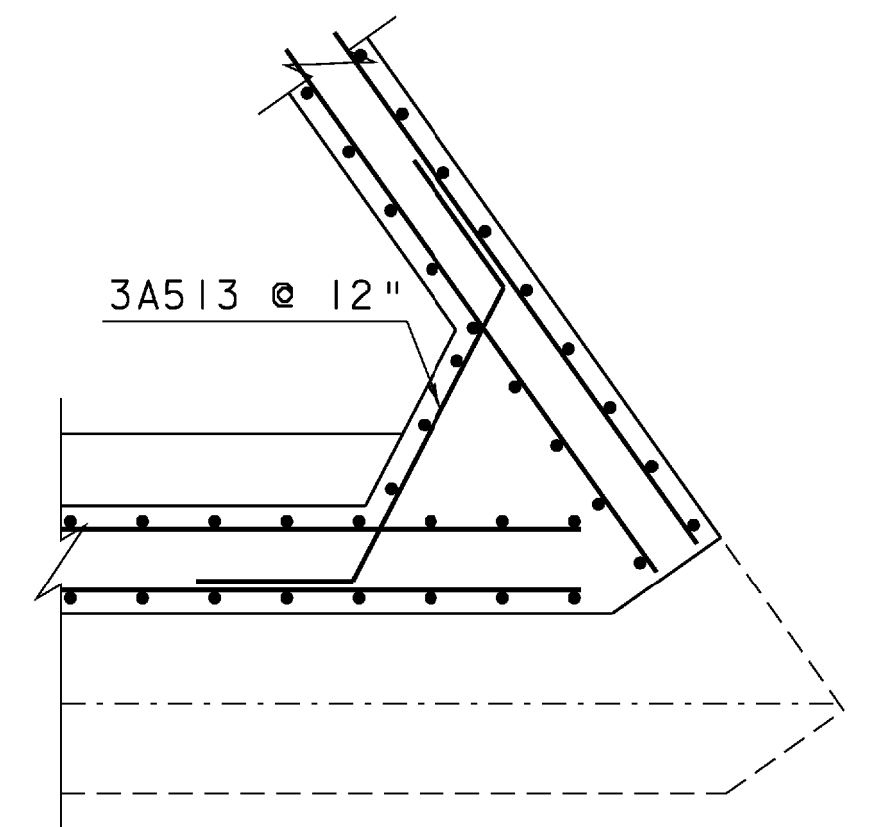


**WINGWALL #5  
CORNER DETAIL**  
SCALE 3/8" = 1'-0"

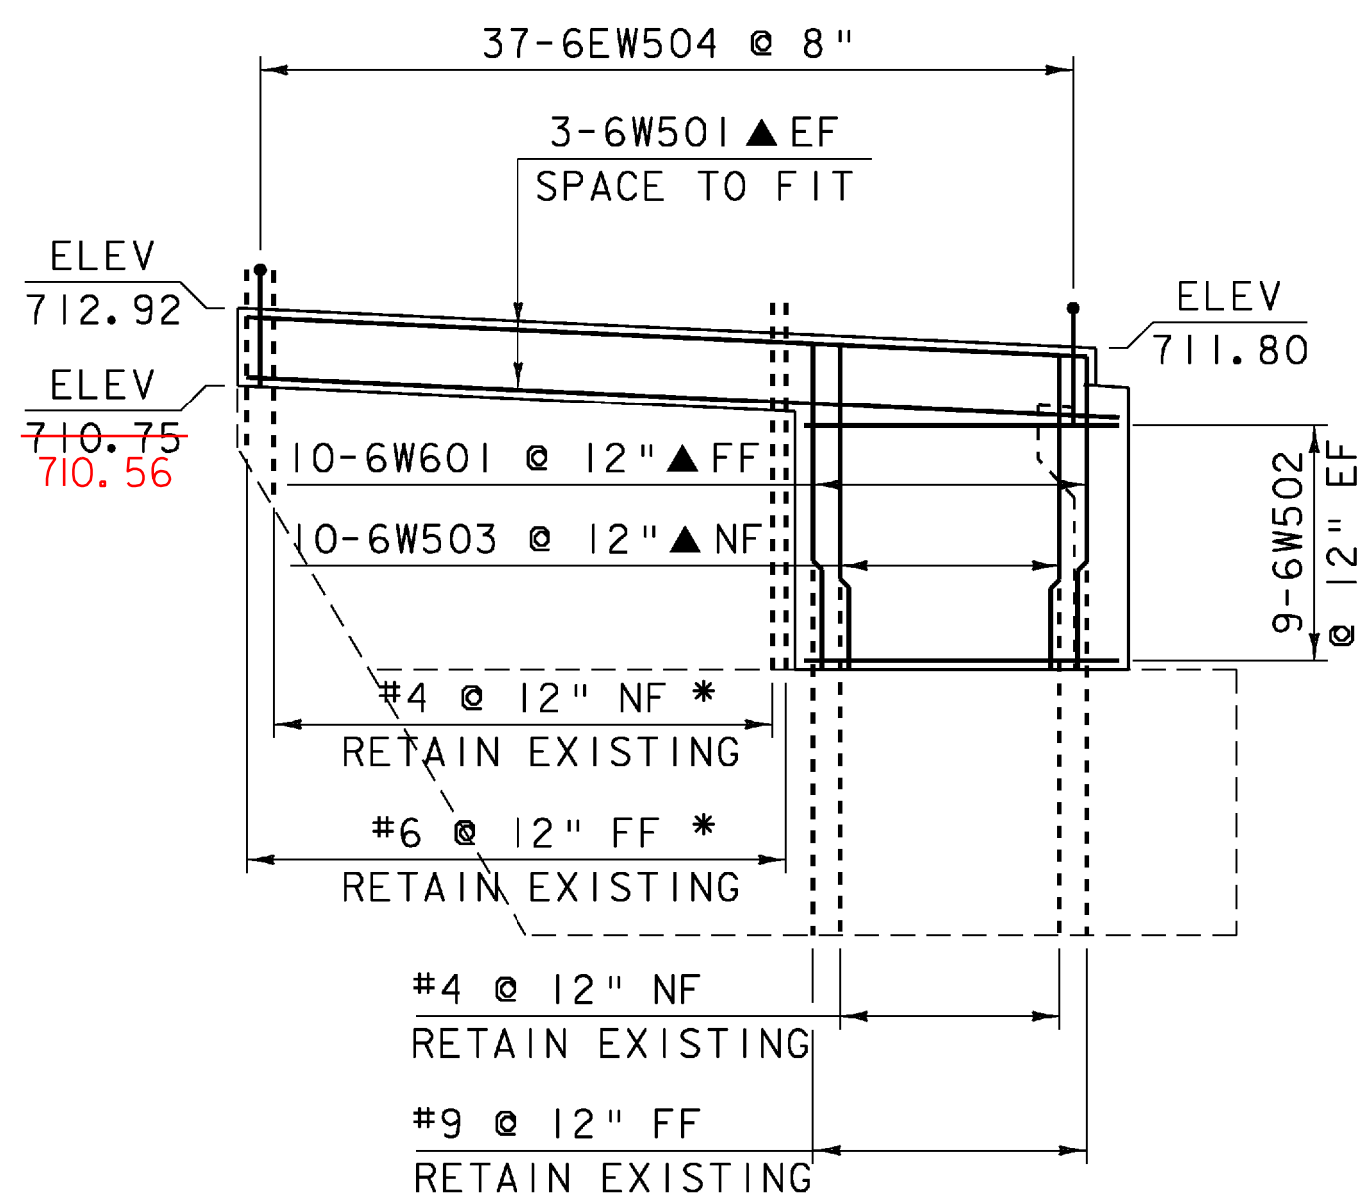

**WINGWALL #6  
ELEVATION VIEW**  
SCALE 3/16" = 1'-0"

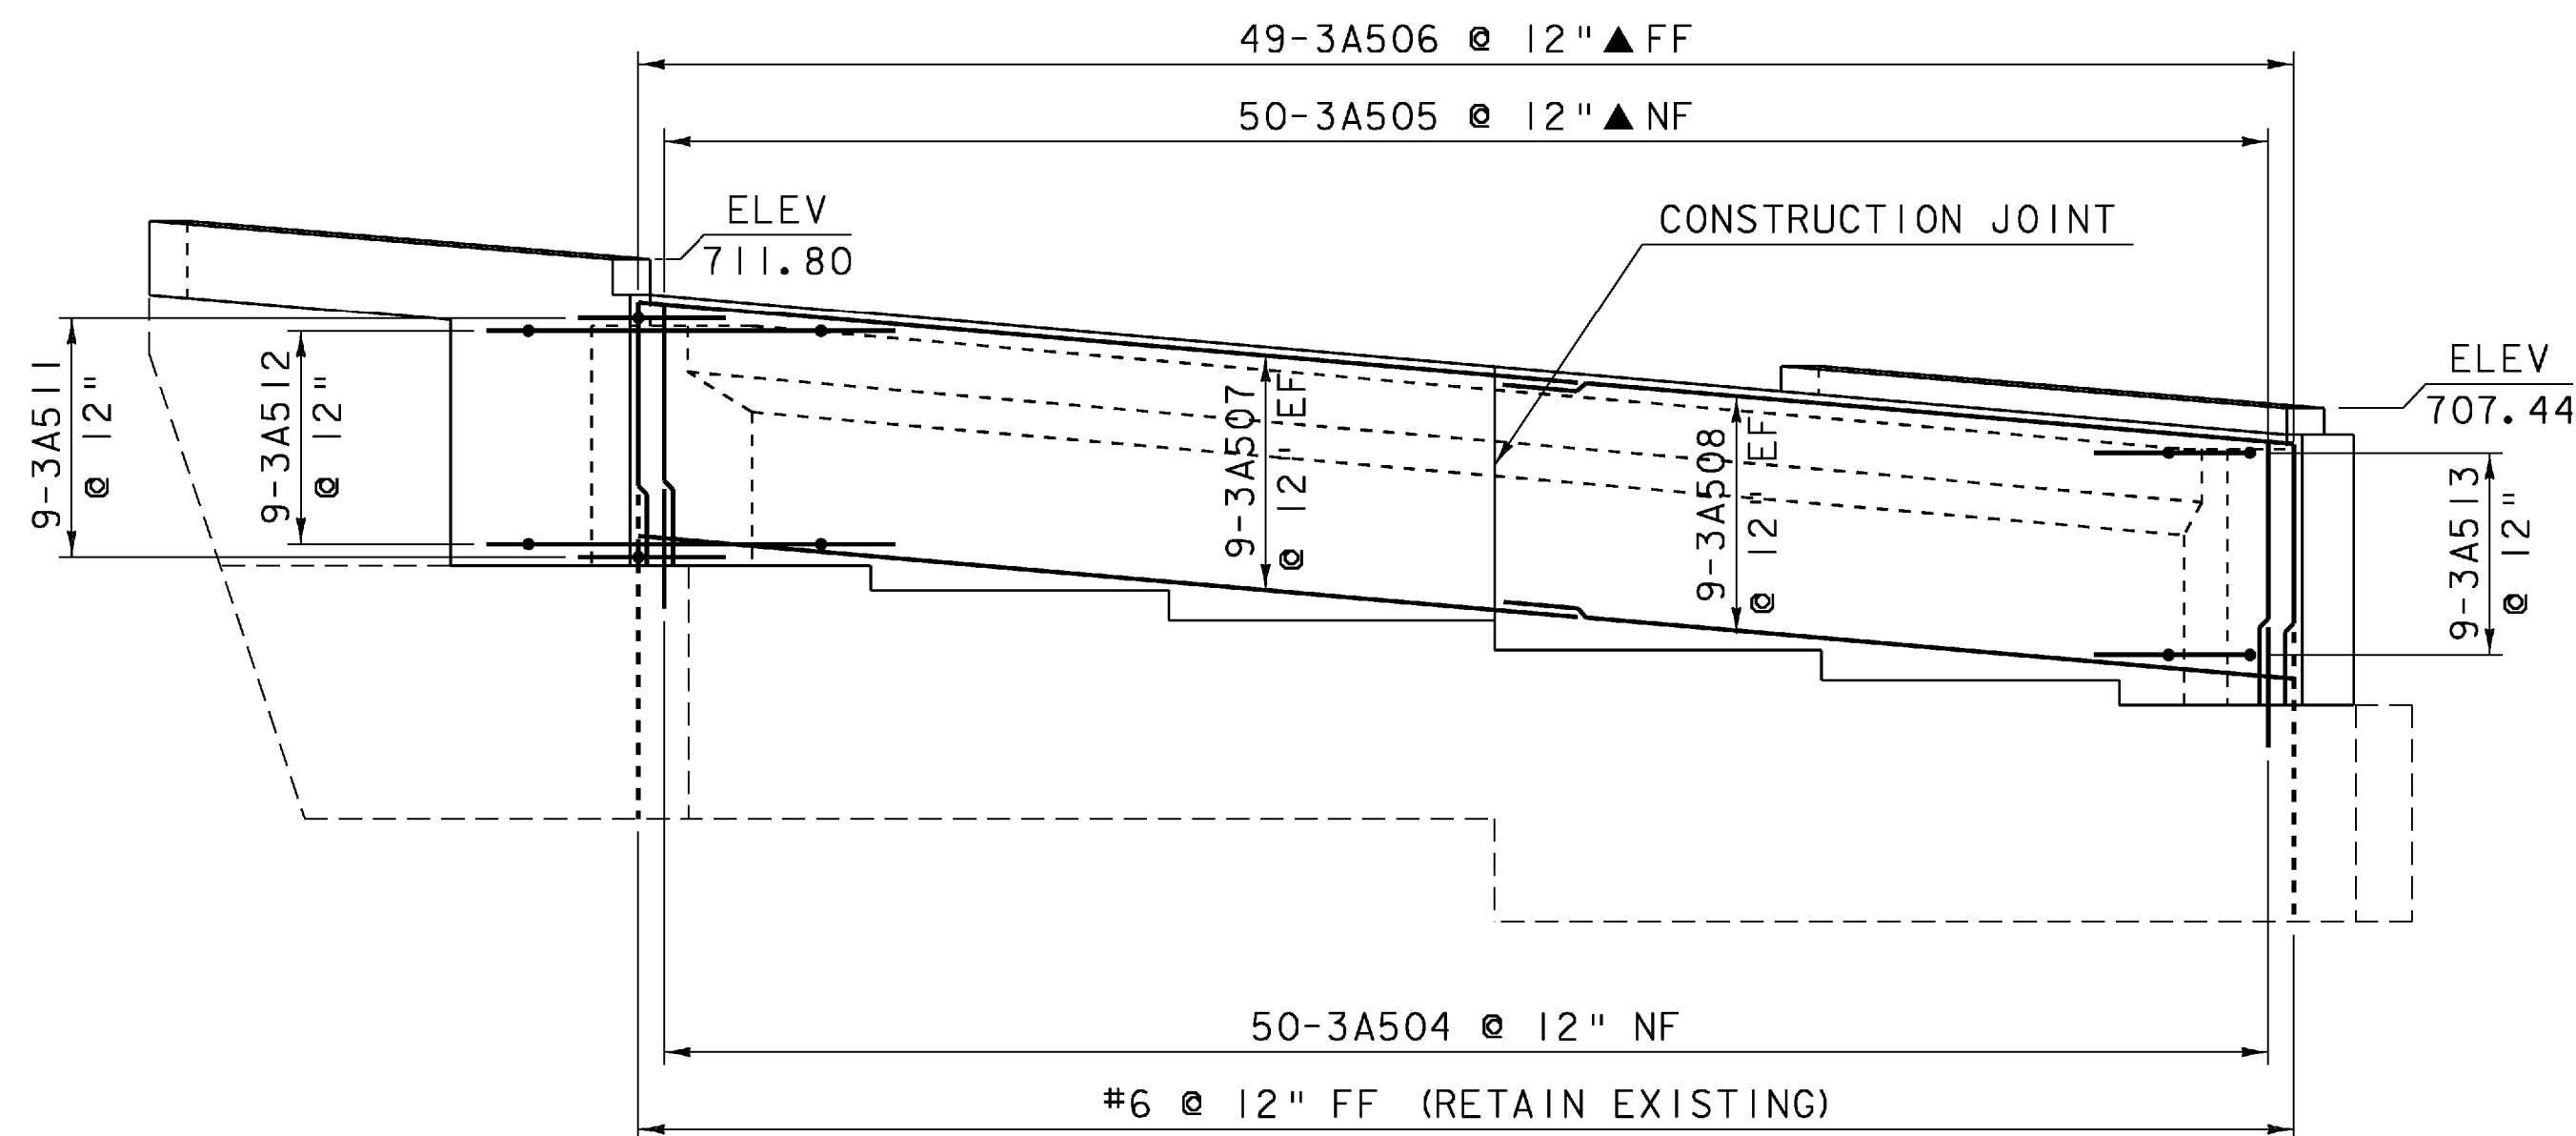

**ABUTMENT #3  
ELEVATION VIEW**  
SCALE 3/16" = 1'-0"

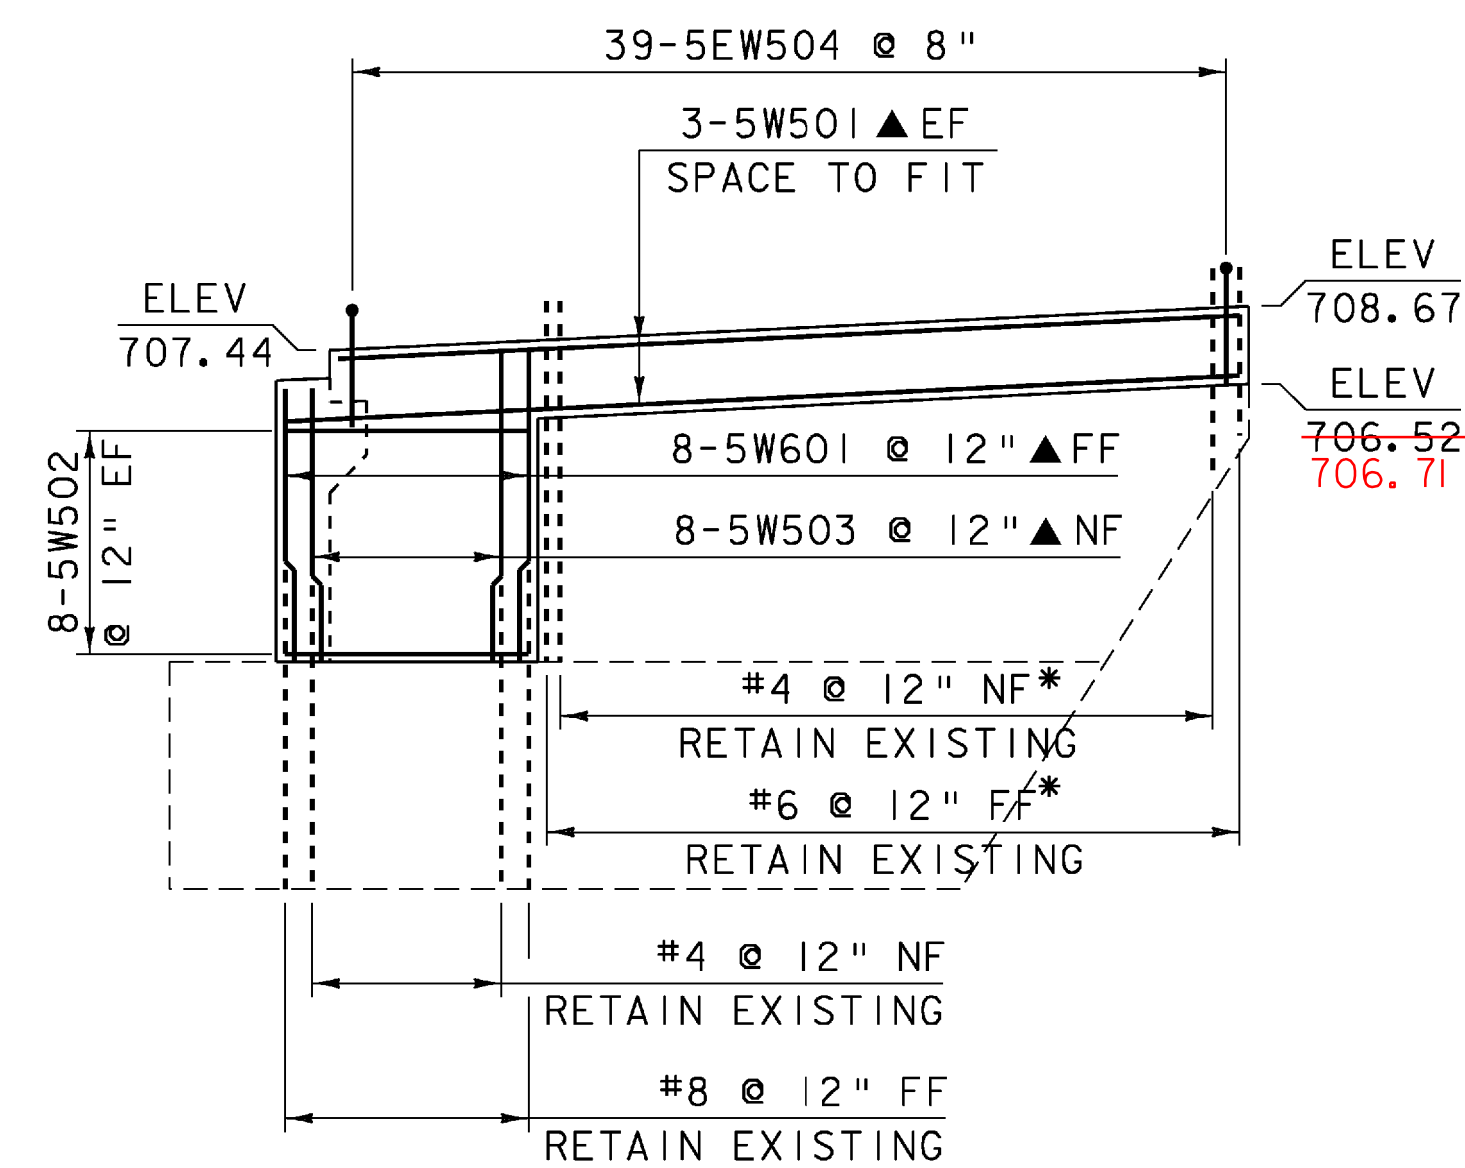

**WINGWALL #5  
ELEVATION VIEW**  
SCALE 3/16" = 1'-0"

**NOTES:**



- NF = NEAR FACE
- FF = FAR FACE
- EF = EACH FACE
- ▲ = CUT TO FIT

3" CLEAR UNLESS OTHERWISE SPECIFIED ON PLANS.


ALL LAPS 2'-2" UNLESS OTHERWISE SPECIFIED ON PLANS.

SEE SHEET 55 FOR SECTION DETAILS


\* IF EXISTING REINFORCING STEEL INTERFERES WITH NEW RAIL CONCRETE, BAR MAY BE BENT TO ACCOMMODATE NEW CONCRETE CLEARANCE REQUIREMENTS.

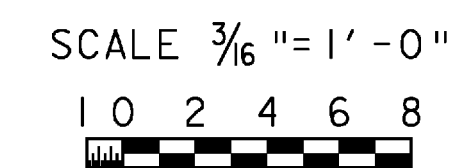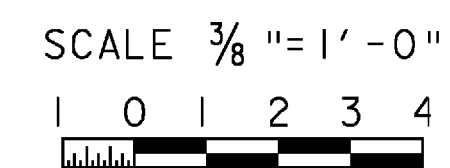


PROJECT: <b>BERLIN</b>	PROJECT NO.: <b>IM 089-1 (20)</b>
DESIGN FILE NAME: 99a270\structures\99a270abut.dgn	PLOT DATE: 05-DEC-2007
IPARM FILE NAME: s99a270abut3.i	DESIGNED BY: G.SPILAK
SQUAD LEADER: C.P.WILLIAMS	DRAWN BY: WEEBER
ABUTMENT #3 DETAILS	CHECKED BY: R.S. YOUNG
	SHEET: 58 OF 104

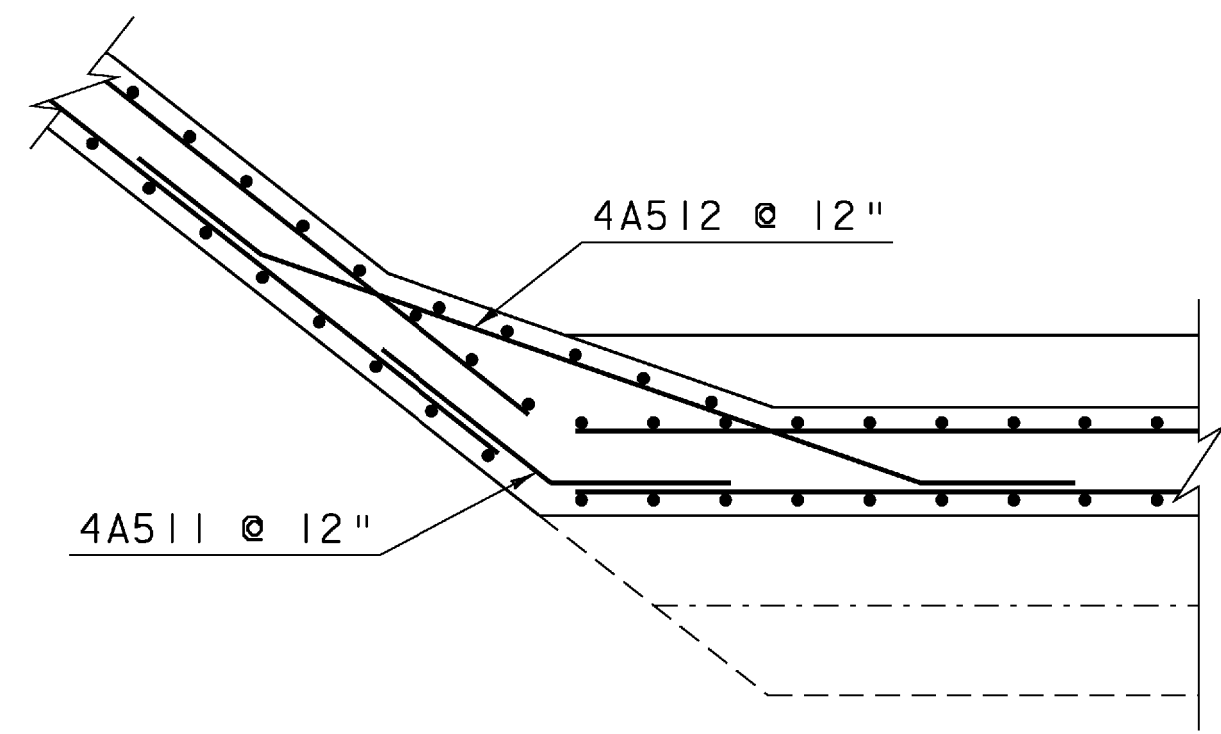


**WINGWALL #7  
CORNER DETAIL**  
SCALE 3/8" = 1'-0"

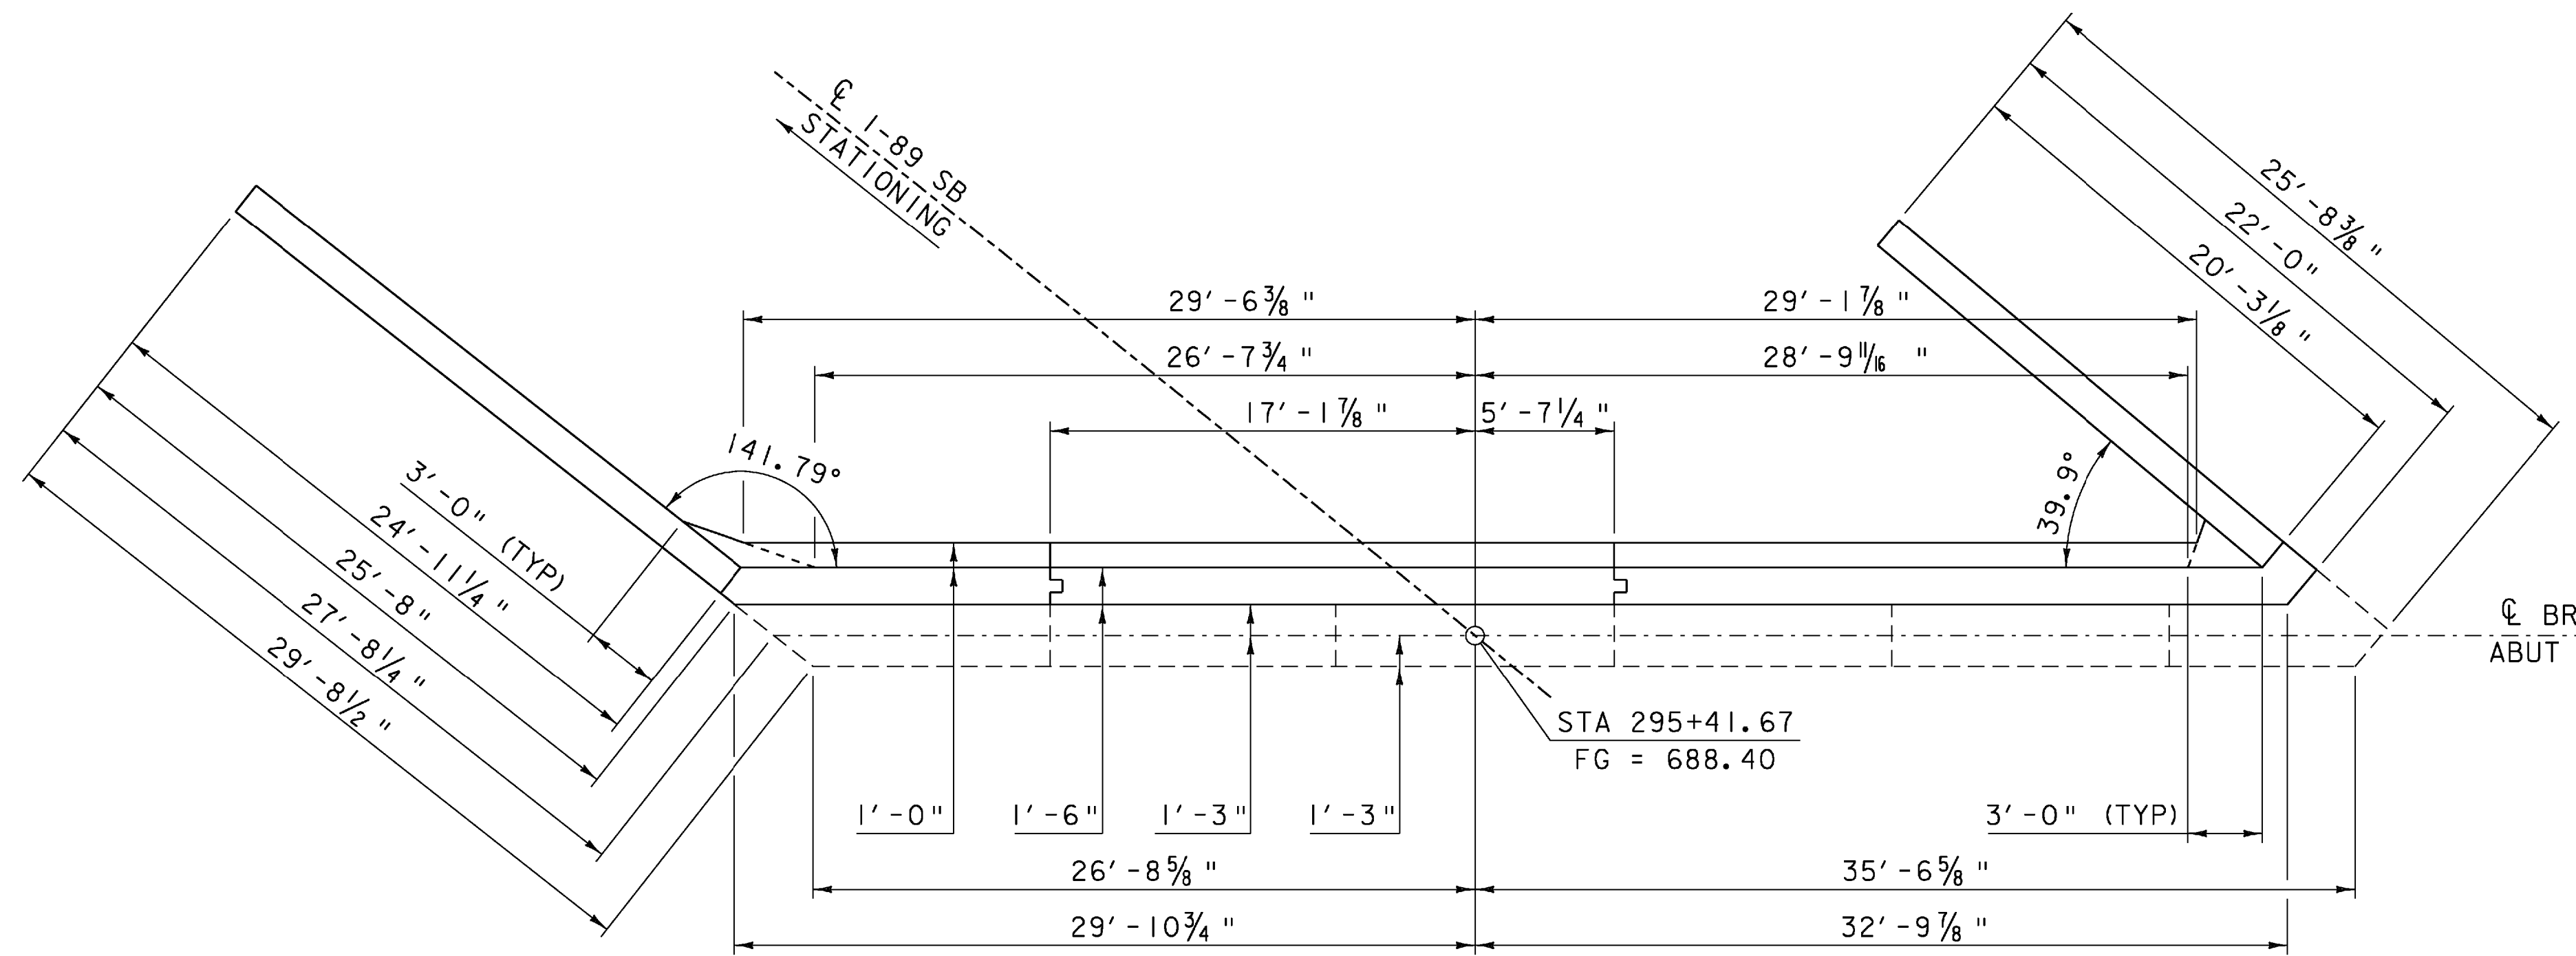


**ABUTMENT #4  
PLAN VIEW**  
SCALE 3/16" = 1'-0"

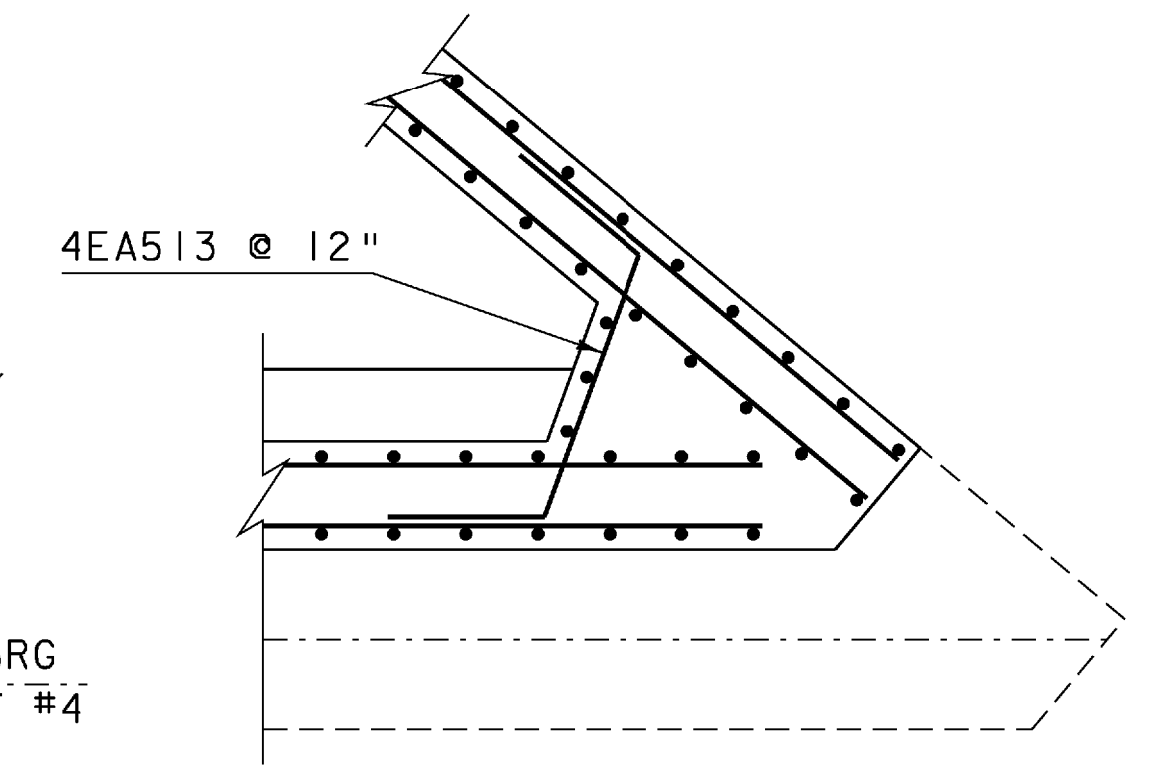


**WINGWALL #8  
CORNER DETAIL**  
SCALE 3/8" = 1'-0"

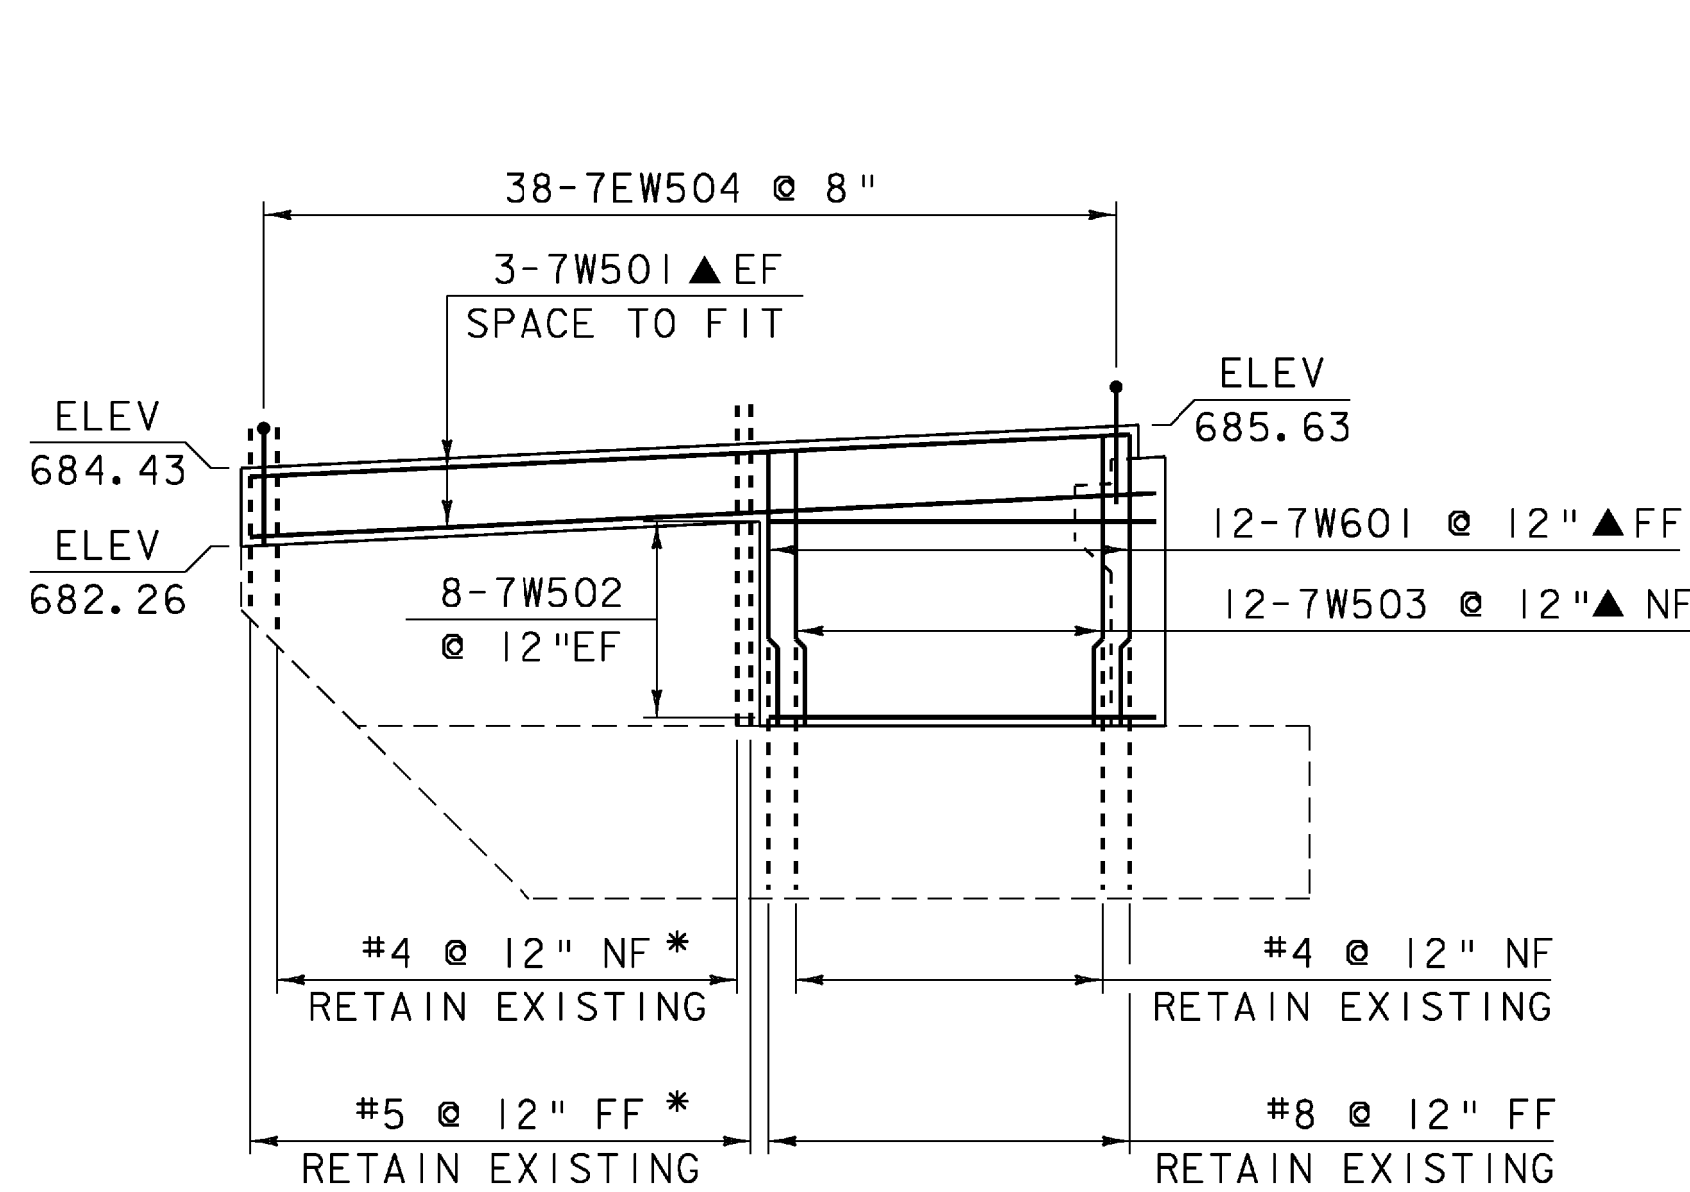

**WINGWALL #7  
ELEVATION VIEW**  
SCALE 3/16" = 1'-0"

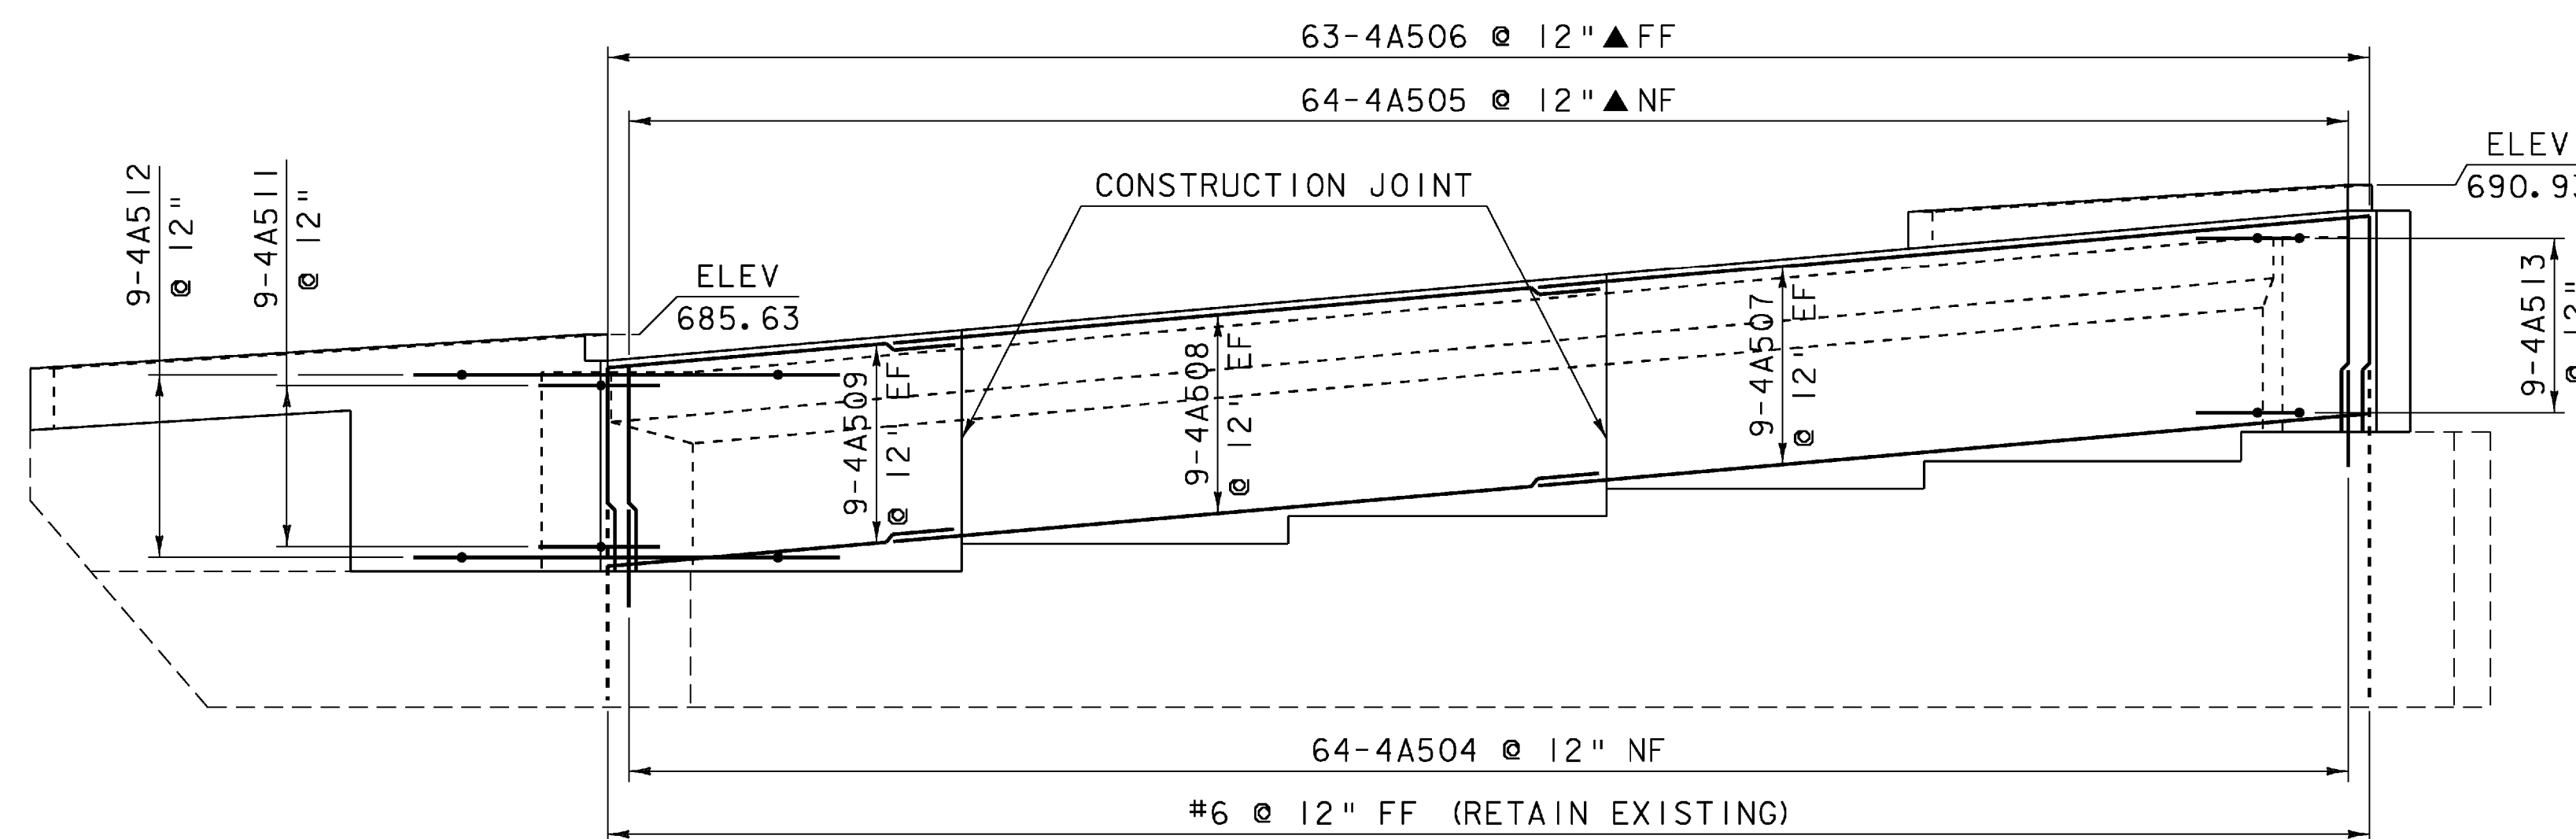


**ABUTMENT #4  
ELEVATION VIEW**  
SCALE 3/16" = 1'-0"

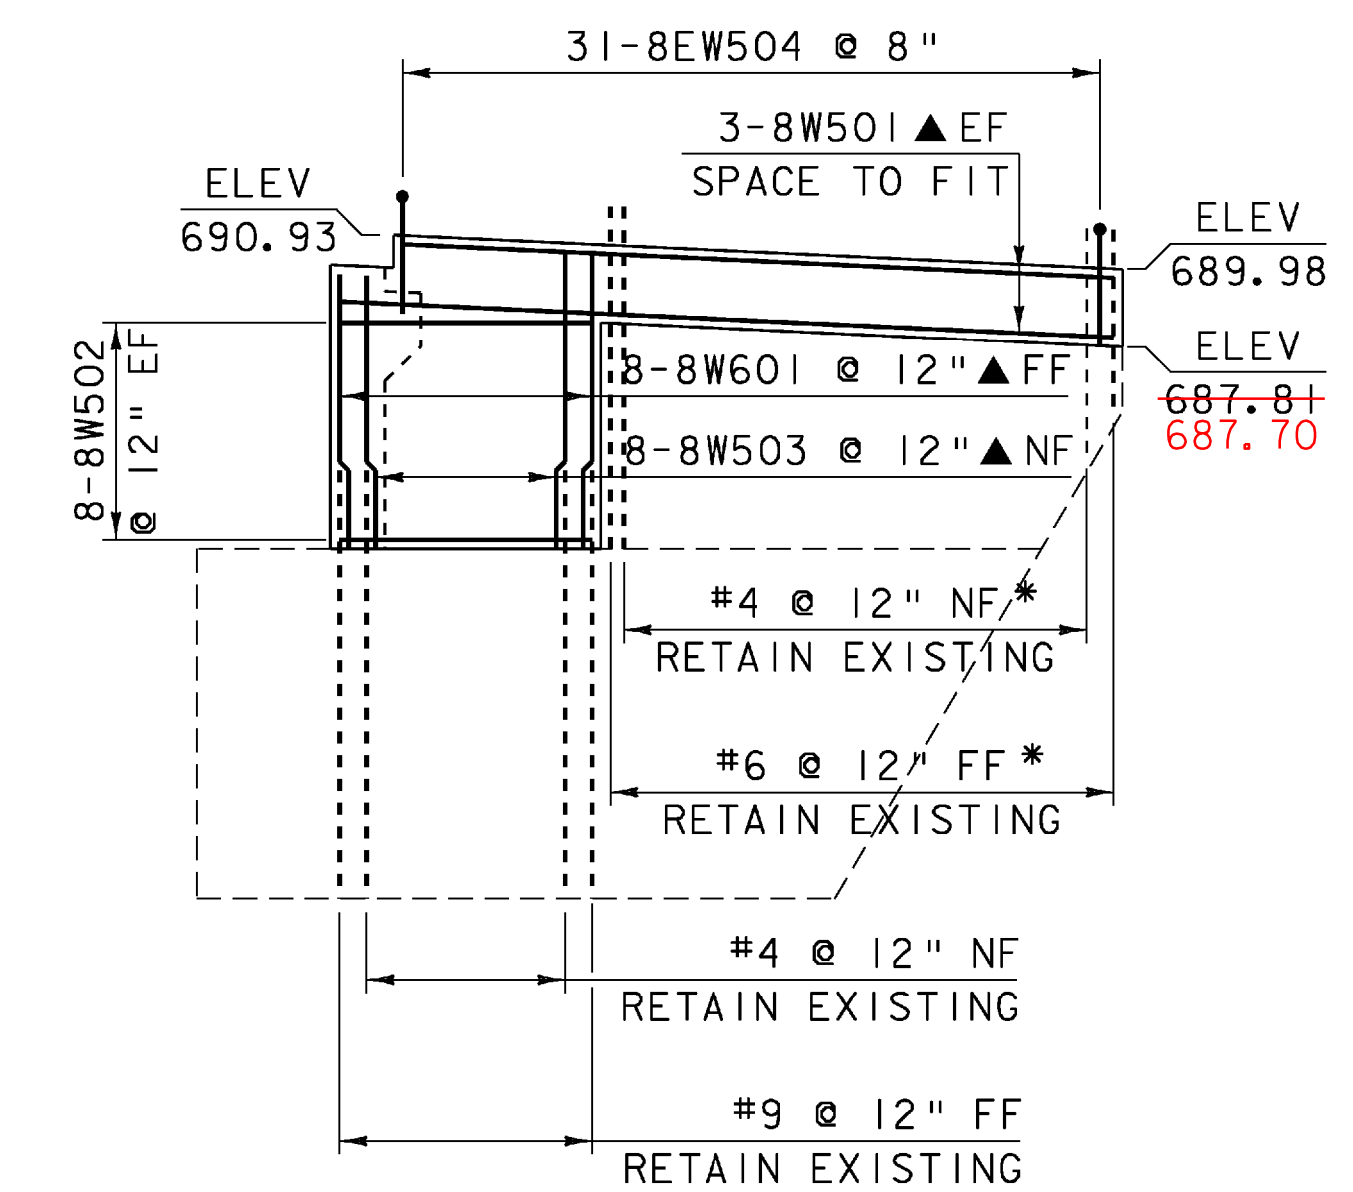


**WINGWALL #8  
ELEVATION VIEW**  
SCALE 3/16" = 1'-0"


**NOTES:**  
 NF = NEAR FACE  
 FF = FAR FACE  
 EF = EACH FACE  
 ▲ = CUT TO FIT  
 3" CLEAR UNLESS OTHERWISE SPECIFIED ON PLANS.  
 ALL LAPS 2'-2" UNLESS OTHERWISE SPECIFIED ON PLANS.  
 SEE SHEET 55 FOR SECTION DETAILS  
 \* IF EXISTING REINFORCING STEEL INTERFERES WITH NEW RAIL CONCRETE, BAR MAY BE BENT TO ACCOMMODATE NEW CONCRETE CLEARANCE REQUIREMENTS.

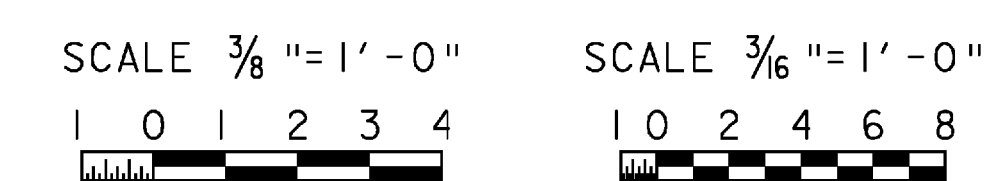

PROJECT: <b>BERLIN</b>	PROJECT NO.: <b>IM 089-1 (20)</b>
DESIGN FILE NAME: s99a270\structures\s99a270abut.dgn	PLOT DATE: 05-DEC-2007
IPARM FILE NAME: s99a270abut4.i	DRAWN BY: WEEBER
DESIGNED BY: G.SPILAK	CHECKED BY: R.S. YOUNG
SQUAD LEADER: C.P. WILLIAMS	SHEET: 59 OF 104
ABUTMENT #4 DETAILS	

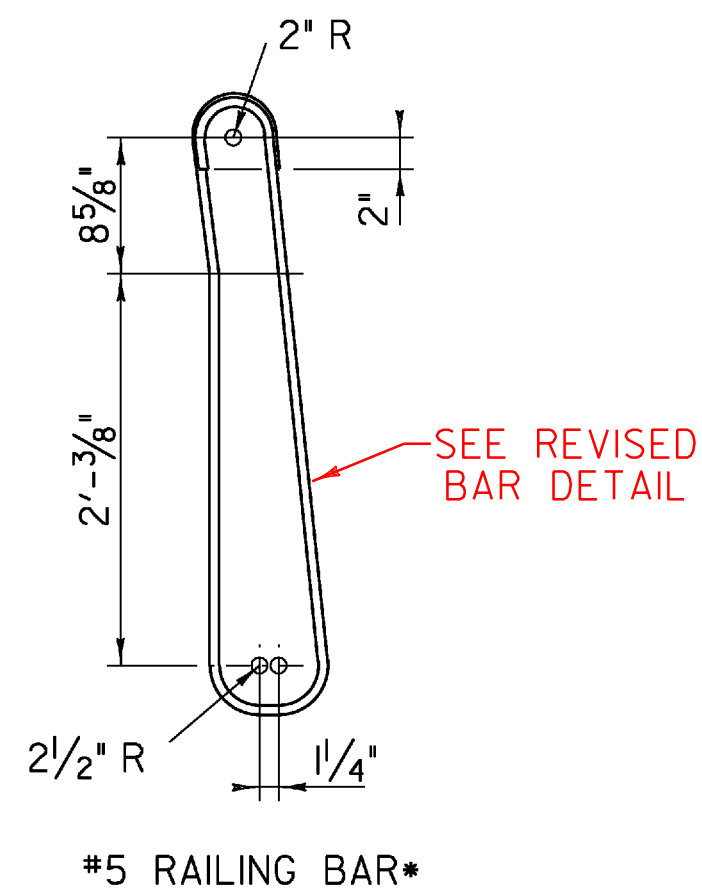


**BAR BENDING DETAIL**

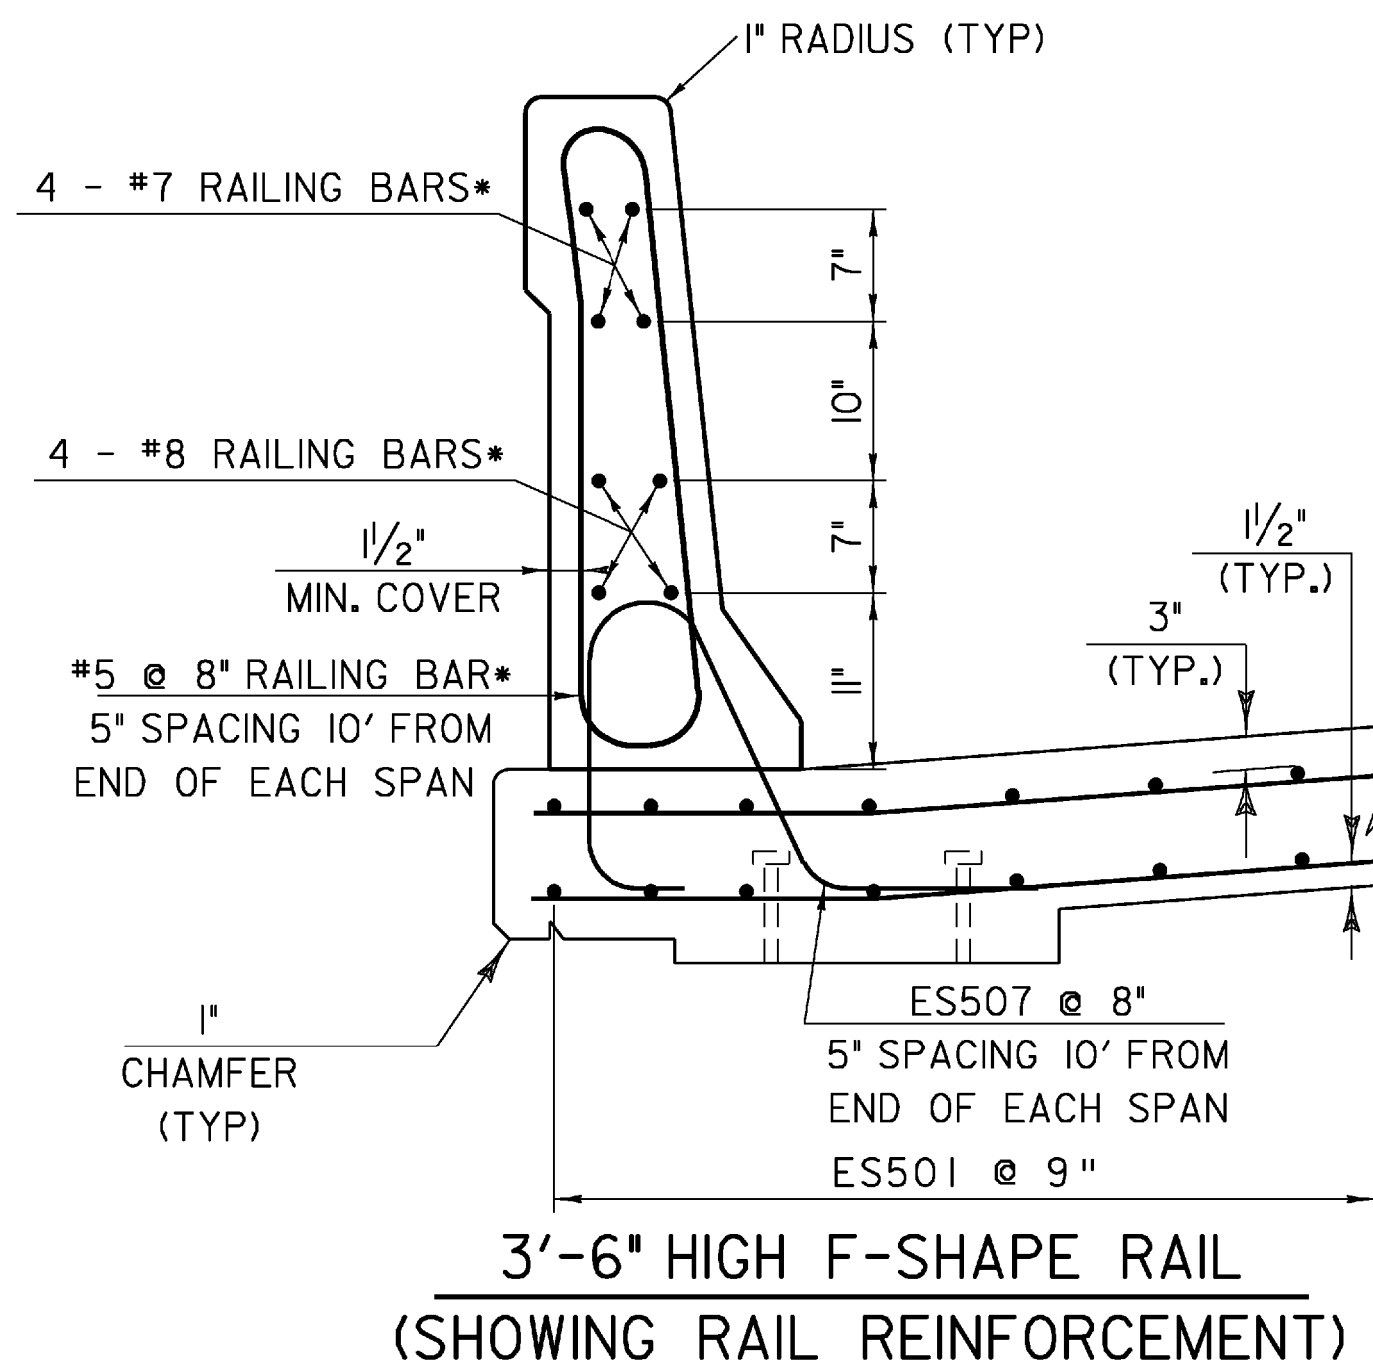


**3'-6" HIGH F-SHAPE RAIL (SHOWING RAIL REINFORCEMENT)**


\*THE RAILING BARS SHALL BE INCLUDED IN THE UNIT BID PRICE OF 900.640 SPECIAL PROVISION (BRIDGE RAILING, F-SHAPE CONCRETE).

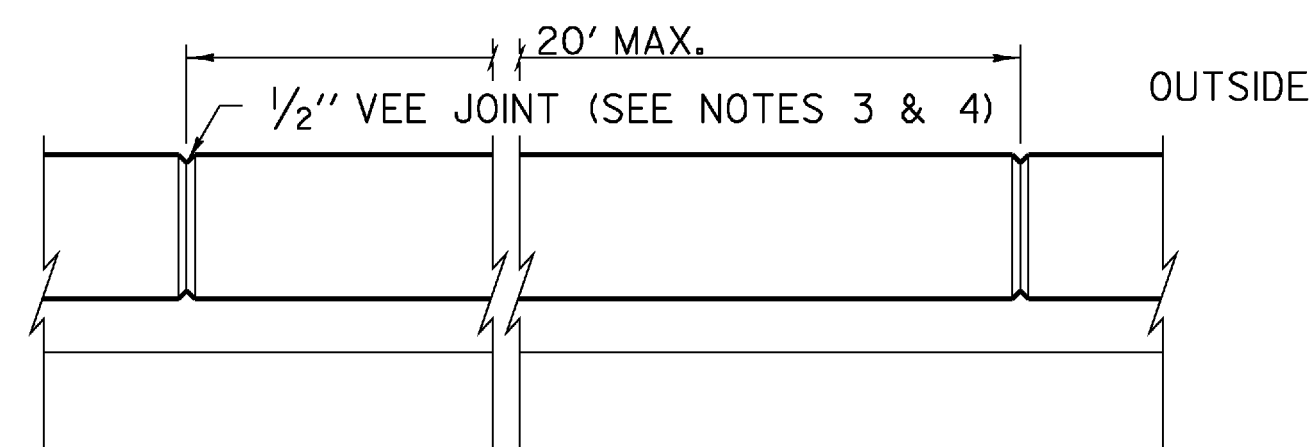

**PLAN VIEW OF RAIL**

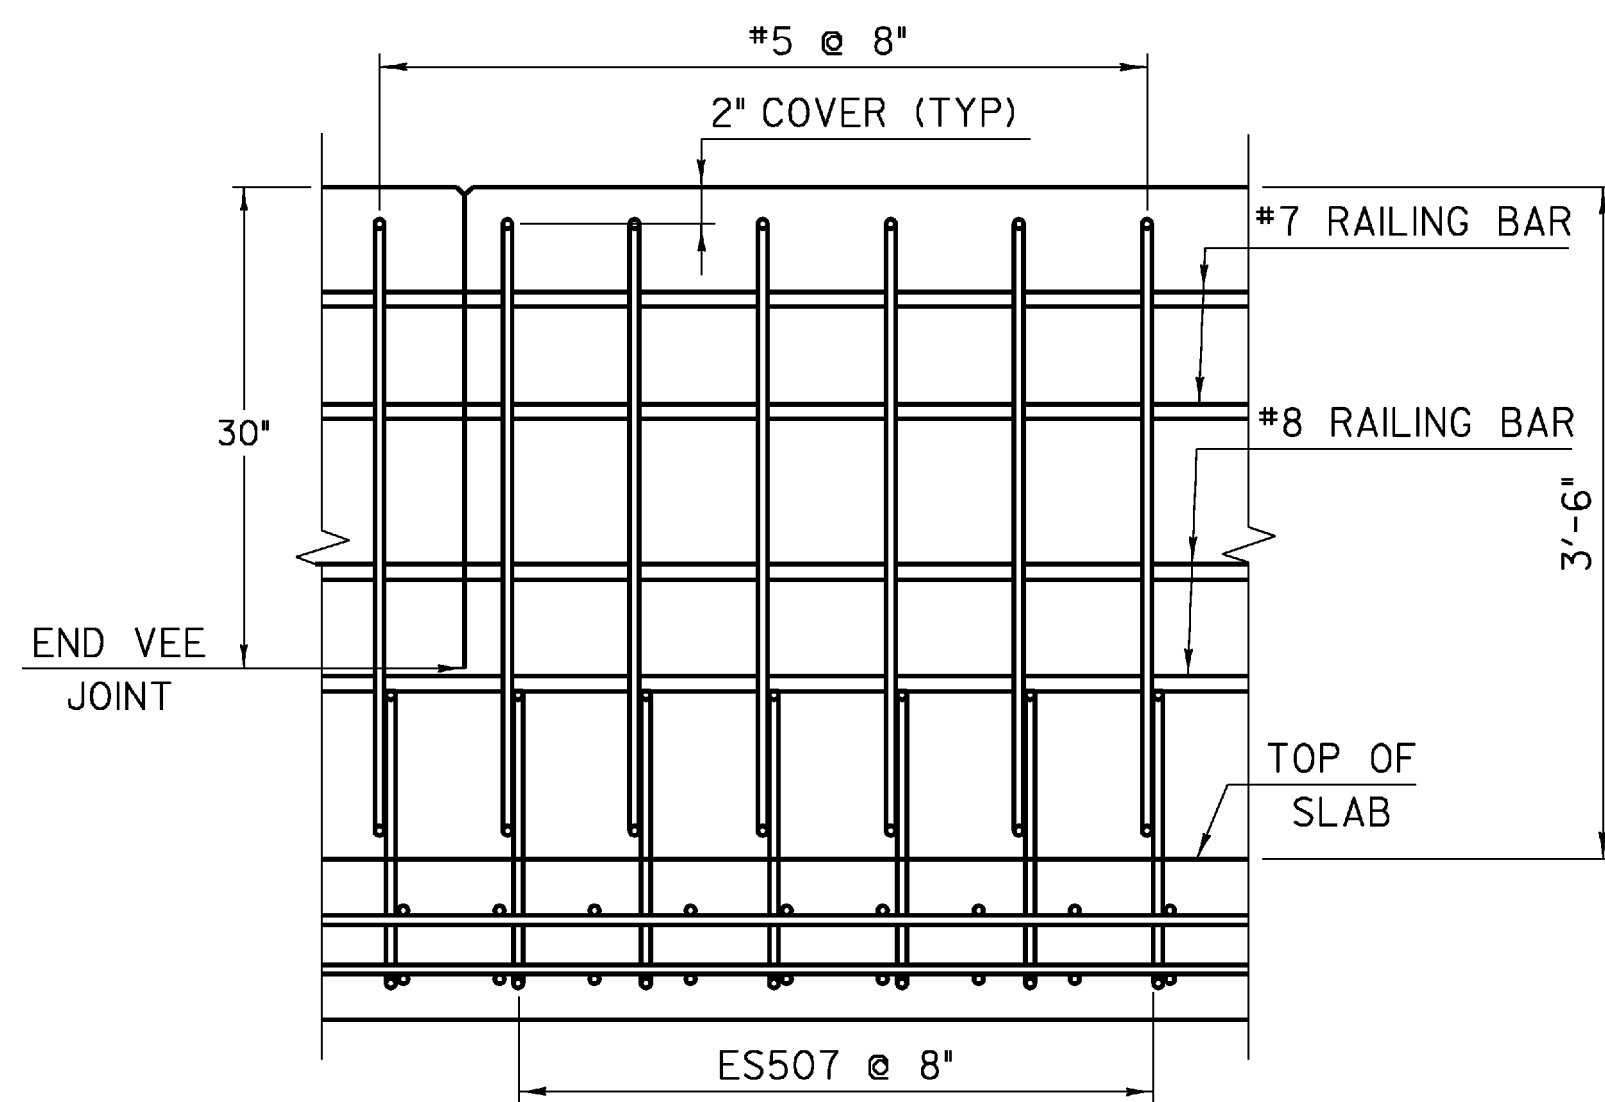


**ELEVATION (SHOWING RAIL & DECK REINFORCEMENT)**

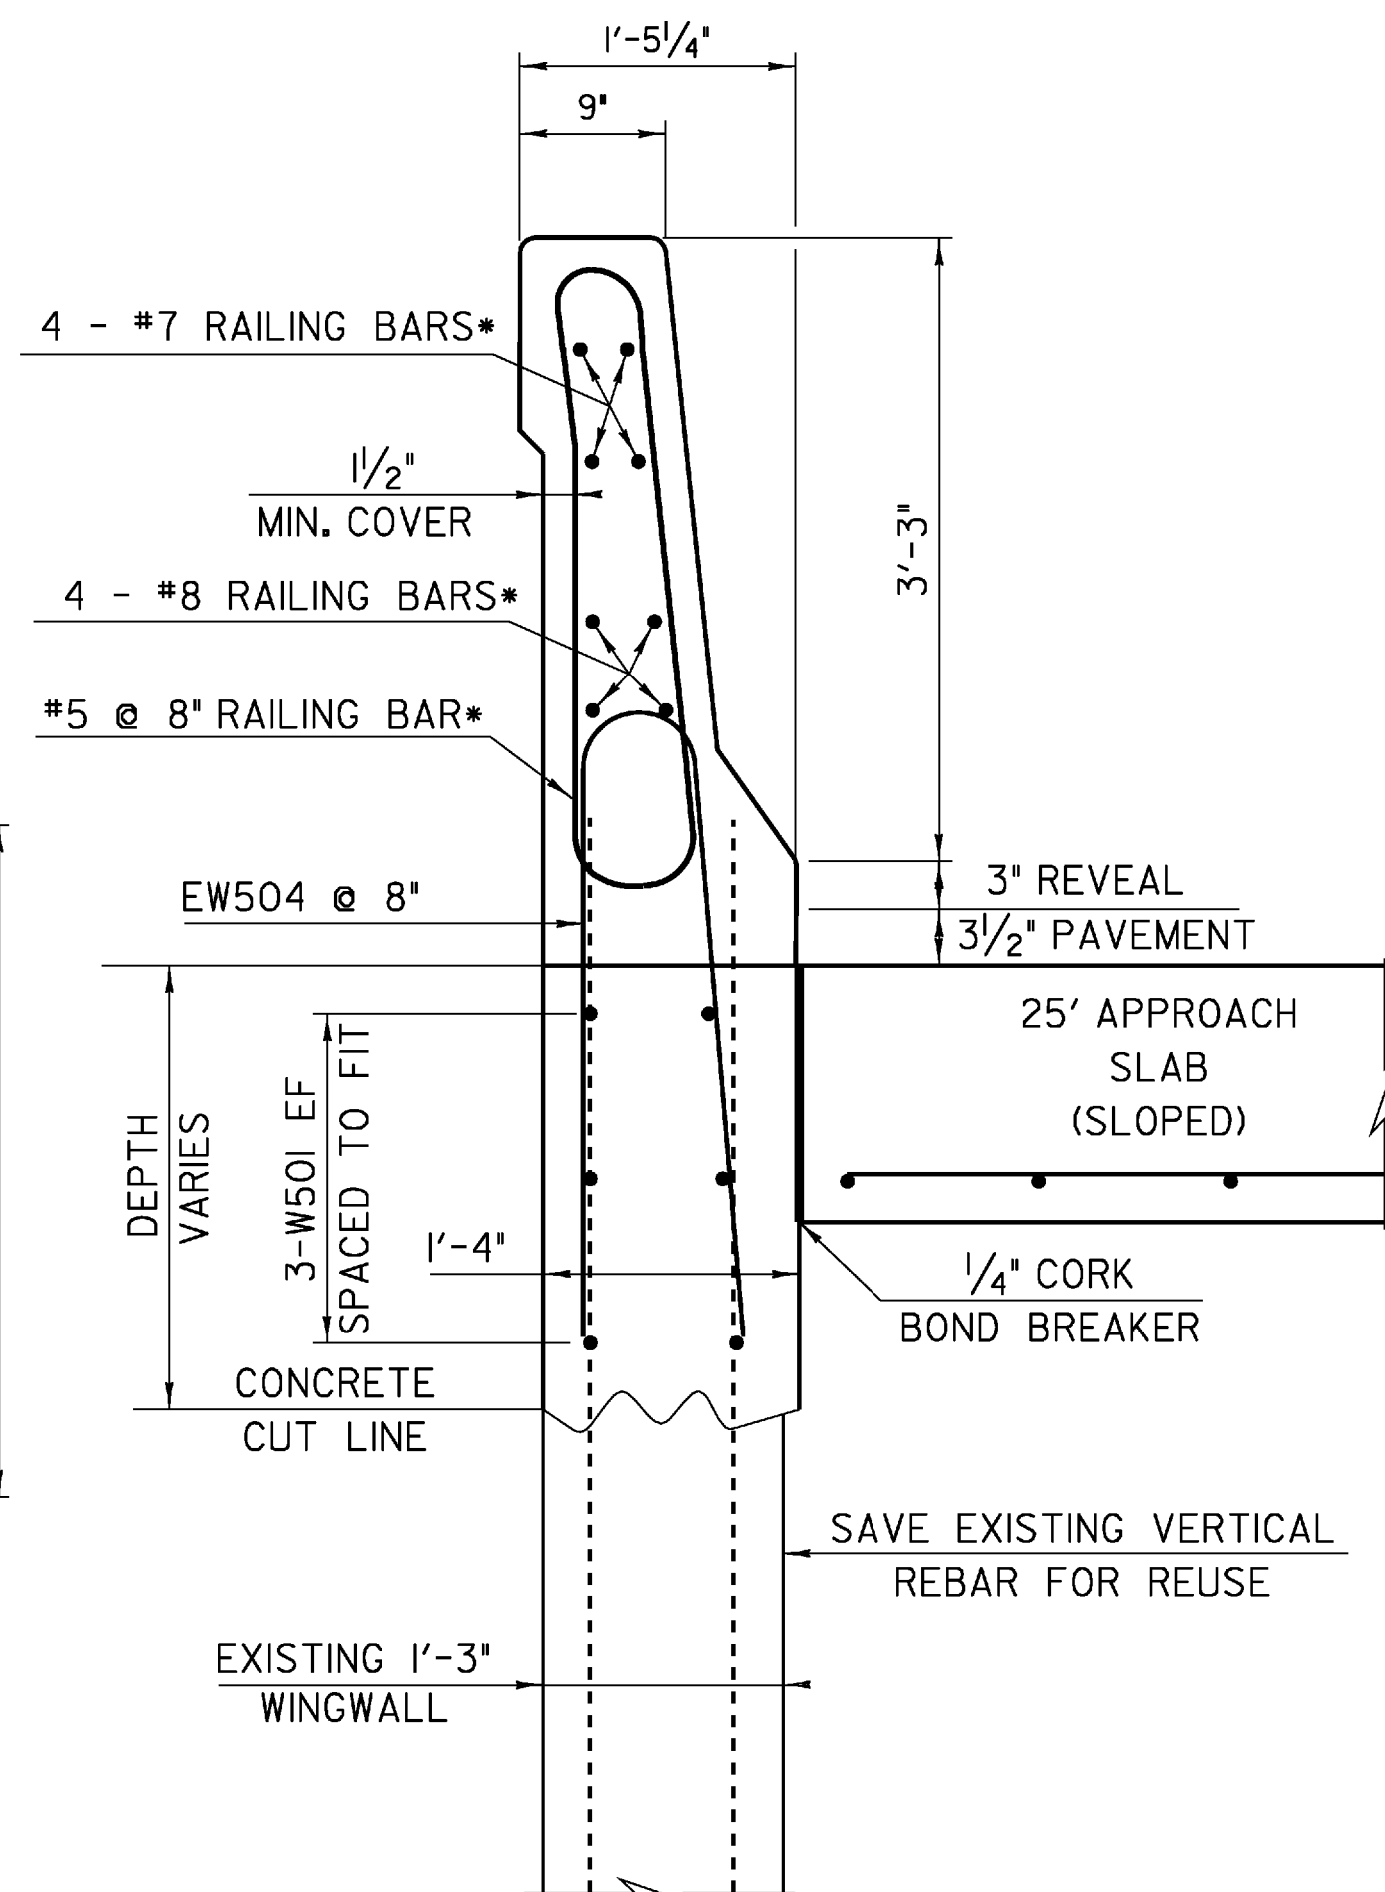


**3'-9 1/2" HIGH F-SHAPE RAIL (@ WINGWALLS)**

SEE NEW RAIL DETAIL ON SHEET 61 FOR CONCRETE DIMENSIONS

**MILEPOST PLAQUE MOUNTED ON RAIL SECTION**

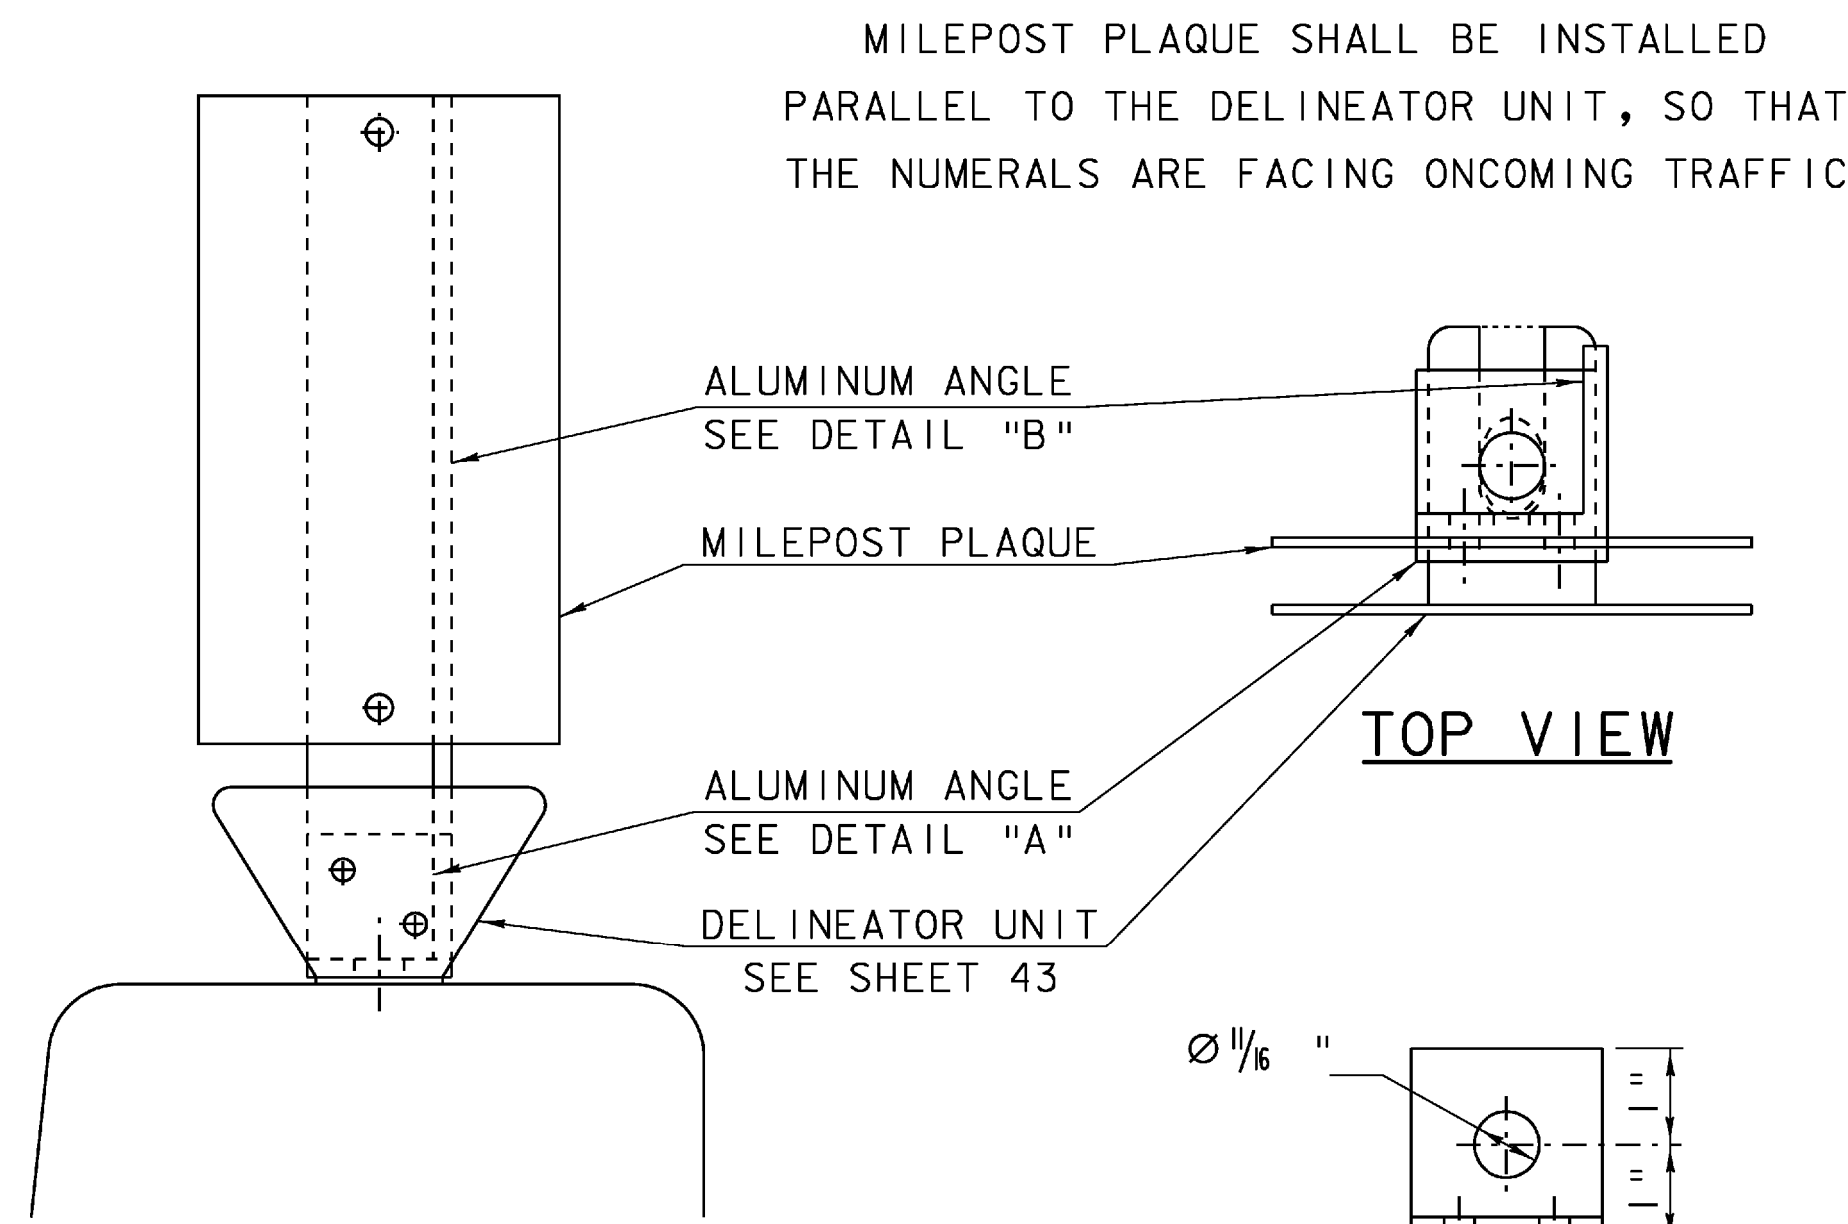


**TOP VIEW**

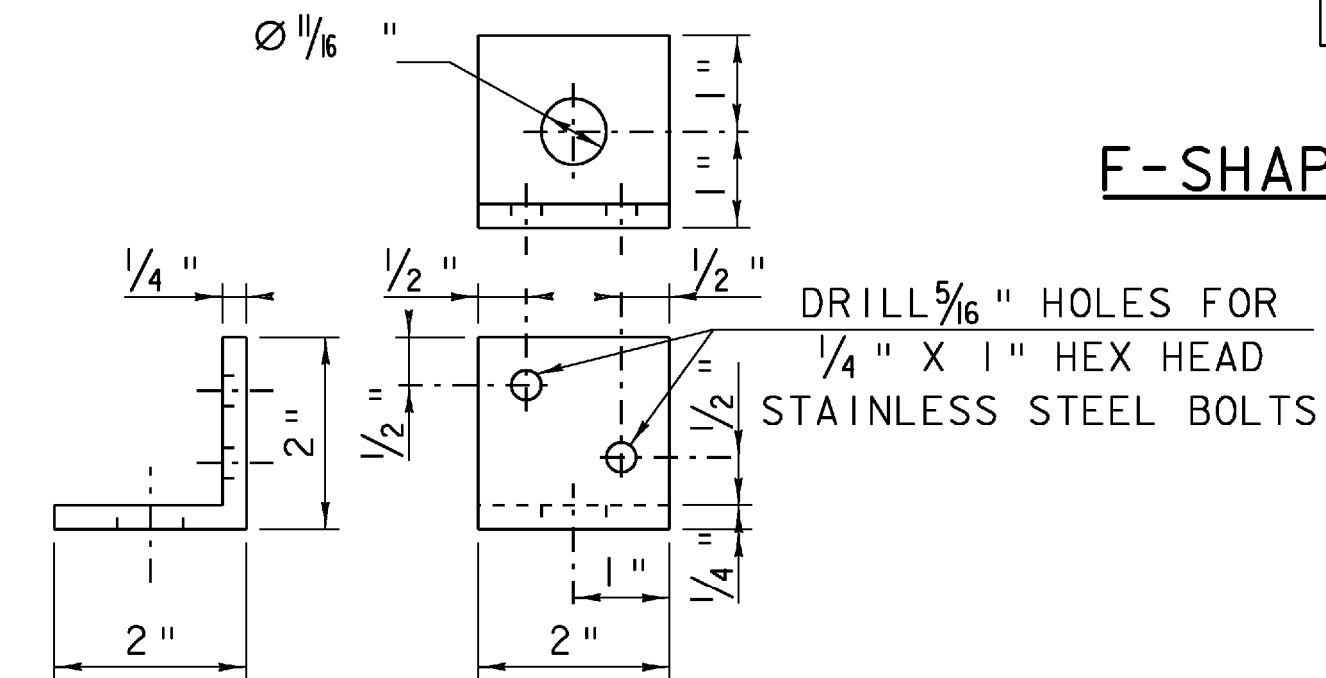

**DETAIL "A" ALUMINUM ANGLE**

ASTM B-308 ALLOY 6061 T6

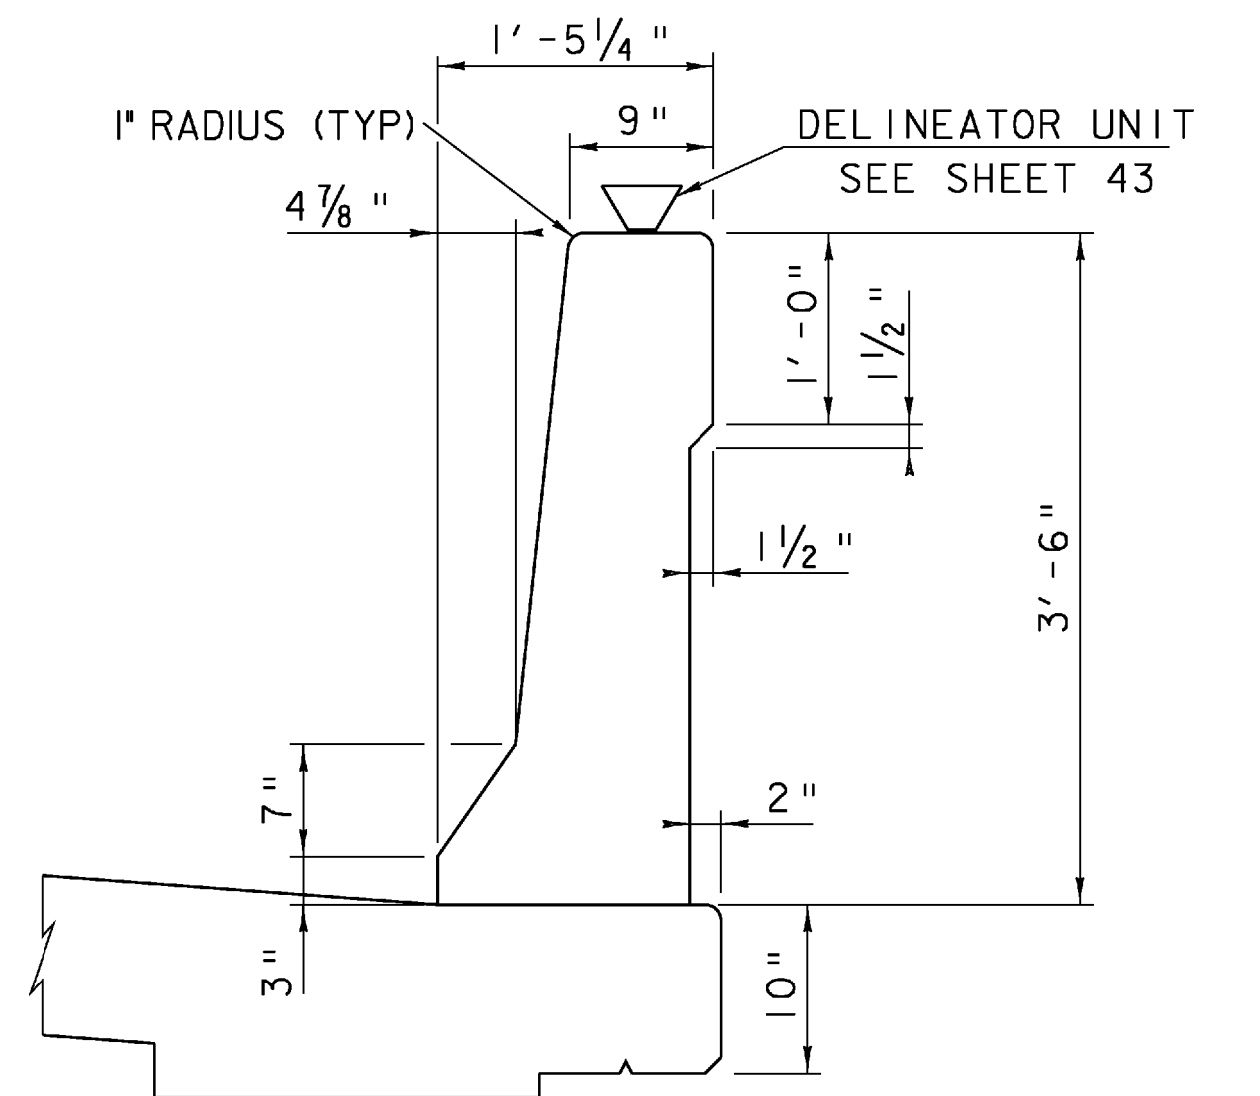


**F-SHAPE RAIL DETAIL ON BRIDGE**

MM	NORTHBOUND STATION	SOUTHBOUND STATION
5250	291+70.26	391+43.27
5255	294+41.51	394+06.89

**BRIDGE RAIL NOTES:**

1. RAIL MEETS TEST LEVEL 5 REQUIREMENTS OF NCHRP REPORT 350.
2. MATERIAL REQUIREMENTS FOR BRIDGE RAIL ONLY:
  - REINFORCING STEEL SHALL BE EPOXY COATED, GRADE 60, CONFORMING TO SUBSECTIONS 713.01 AND 713.07 (b).
  - CONCRETE SHALL BE PER SPECIFICATION 900.640 SPECIAL PROVISION (BRIDGE RAILING, F-SHAPE CONCRETE).
3. 1/2" VEE JOINTS SHALL BE PROVIDED IN EACH FACE OF THE CONCRETE RAIL AT INTERVALS NOT TO EXCEED 20 FEET.
4. THE 1/2" VEE JOINT SHALL END 30" FROM THE TOP OF THE CONCRETE RAIL.
5. THE BAR BENDING DETAILS FOR THE REINFORCING STEEL FOR THE CONCRETE RAIL HAS BEEN SHOWN ON THIS SHEET. THE #7 AND #8 RAILING BARS SHALL BE CONTINUOUS THROUGH THE VEE JOINT FOR THE LENGTH OF EACH BRIDGE SPAN.
6. A CONSTRUCTION JOINT SHALL BE FORMED AT BEGIN/END BRIDGE LOCATIONS.
7. ALL PERMANENTLY EXPOSED CONCRETE SHALL BE TREATED WITH SILANE IN ACCORDANCE WITH SECTION #514.
8. ALUMINUM ANGLES SHALL BE INCIDENTAL TO THE ITEM 900.640 "SPECIAL PROVISION (F-SHAPE CONCRETE RAIL)."

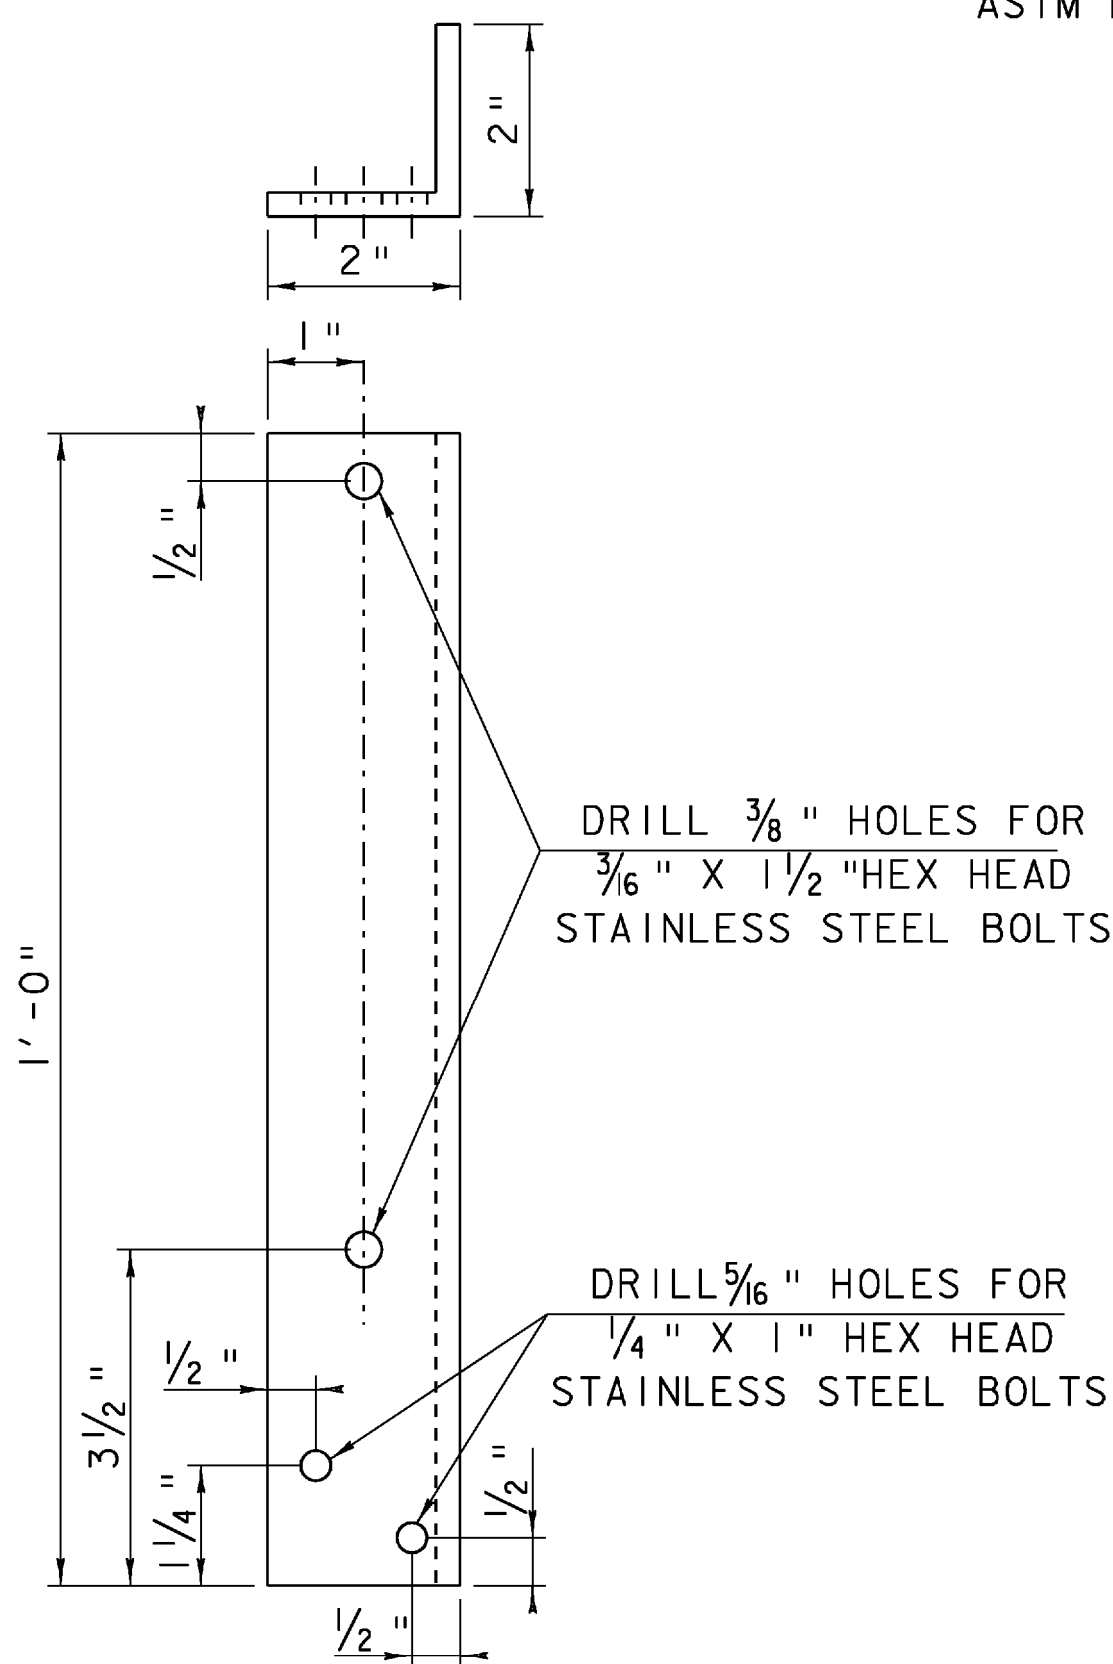


**DETAIL "B" ALUMINUM ANGLE**

ASTM B-308 ALLOY 6061- T6

ALL DETAILS NOT TO SCALE

PROJECT: BERLIN	PROJECT NO.: IM 089-1 (20)
DESIGN FILE NAME: 99a270\structures\99a270rail.dgn	PLOT DATE: 05-DEC-2007
IPARM FILE NAME: 99a270raildet.i	DESIGNED BY: G. SPILAK
SQUAD LEADER: C.P. WILLIAMS	CHECKED BY: R.S. YOUNG
BRIDGE RAIL DETAILS	SHEET: 60 OF 104

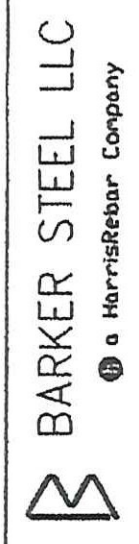

BARKER STEEL LLC  
a HarriaRebar Company


CANAAN

DATE	NO.	DESCRIPTION

DATE		SENT FOR

APPROVAL		

GRADE OF STEEL	CLASS.	CHURCH

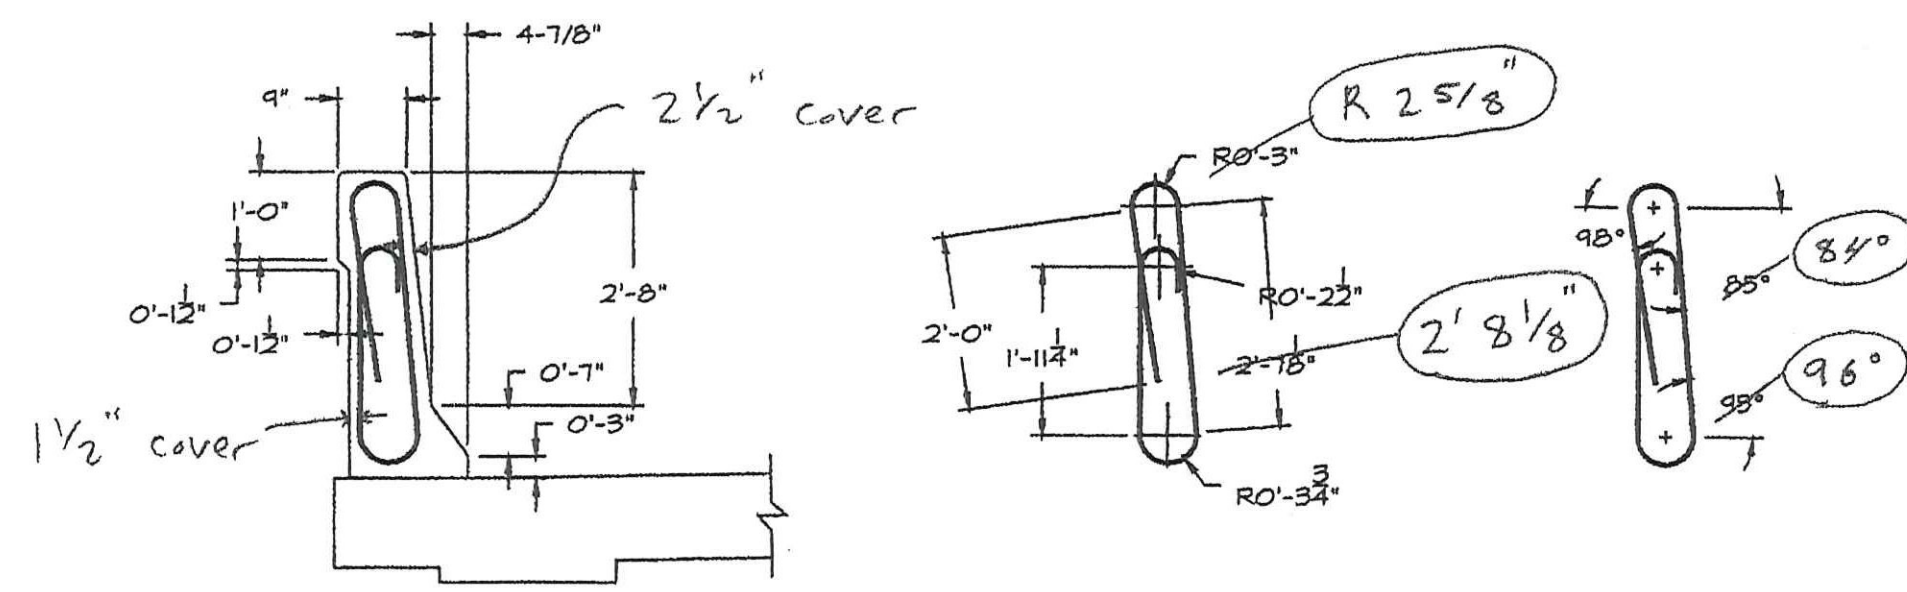


*Revised Bar Detail*

Note: All dimensions are to outside of bar.

Rev. 8-19-08 Beck + Bellucci


DRAWING CODES	BRIDGE RAILS REINFORCEMENT	CUSTOMER	VT BRIDGE RAILS PROJECT IN CD54-1 (20)	JOB NO.	VT RAIL
ARCHITECT		DRAWN BY:	CPS	APPR. DATE	
ENGINEER		REFERENCE DWS:	BERLIN VT	DATE SUB.	02/14/08

Rev. # 1 8/18/08

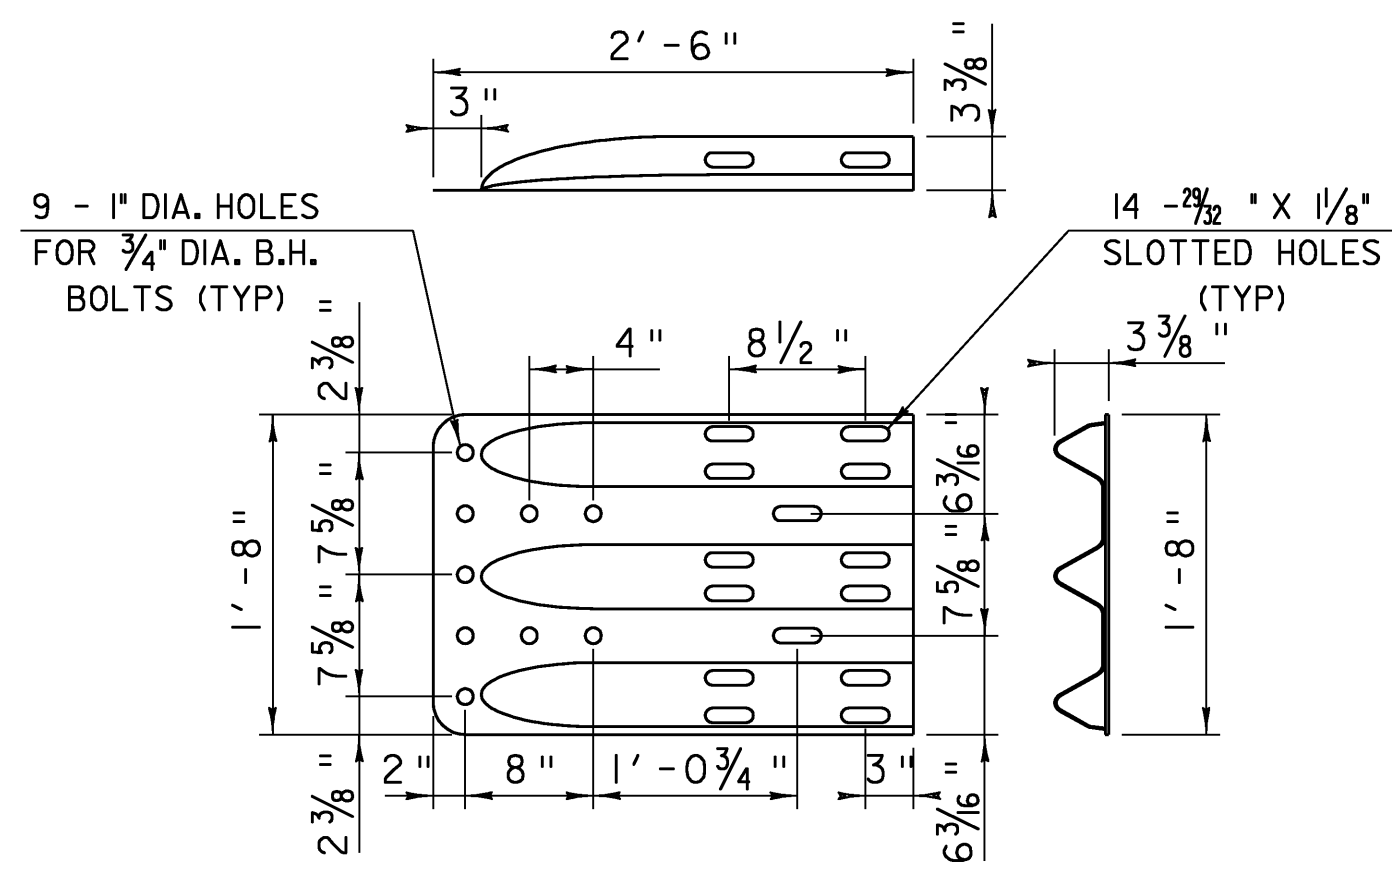


**THRIE-BEAM TERMINAL CONNECTOR  
BOLT TO CONCRETE BARRIER & THRIE-BEAM**

SCALE 1" = 1'-0"

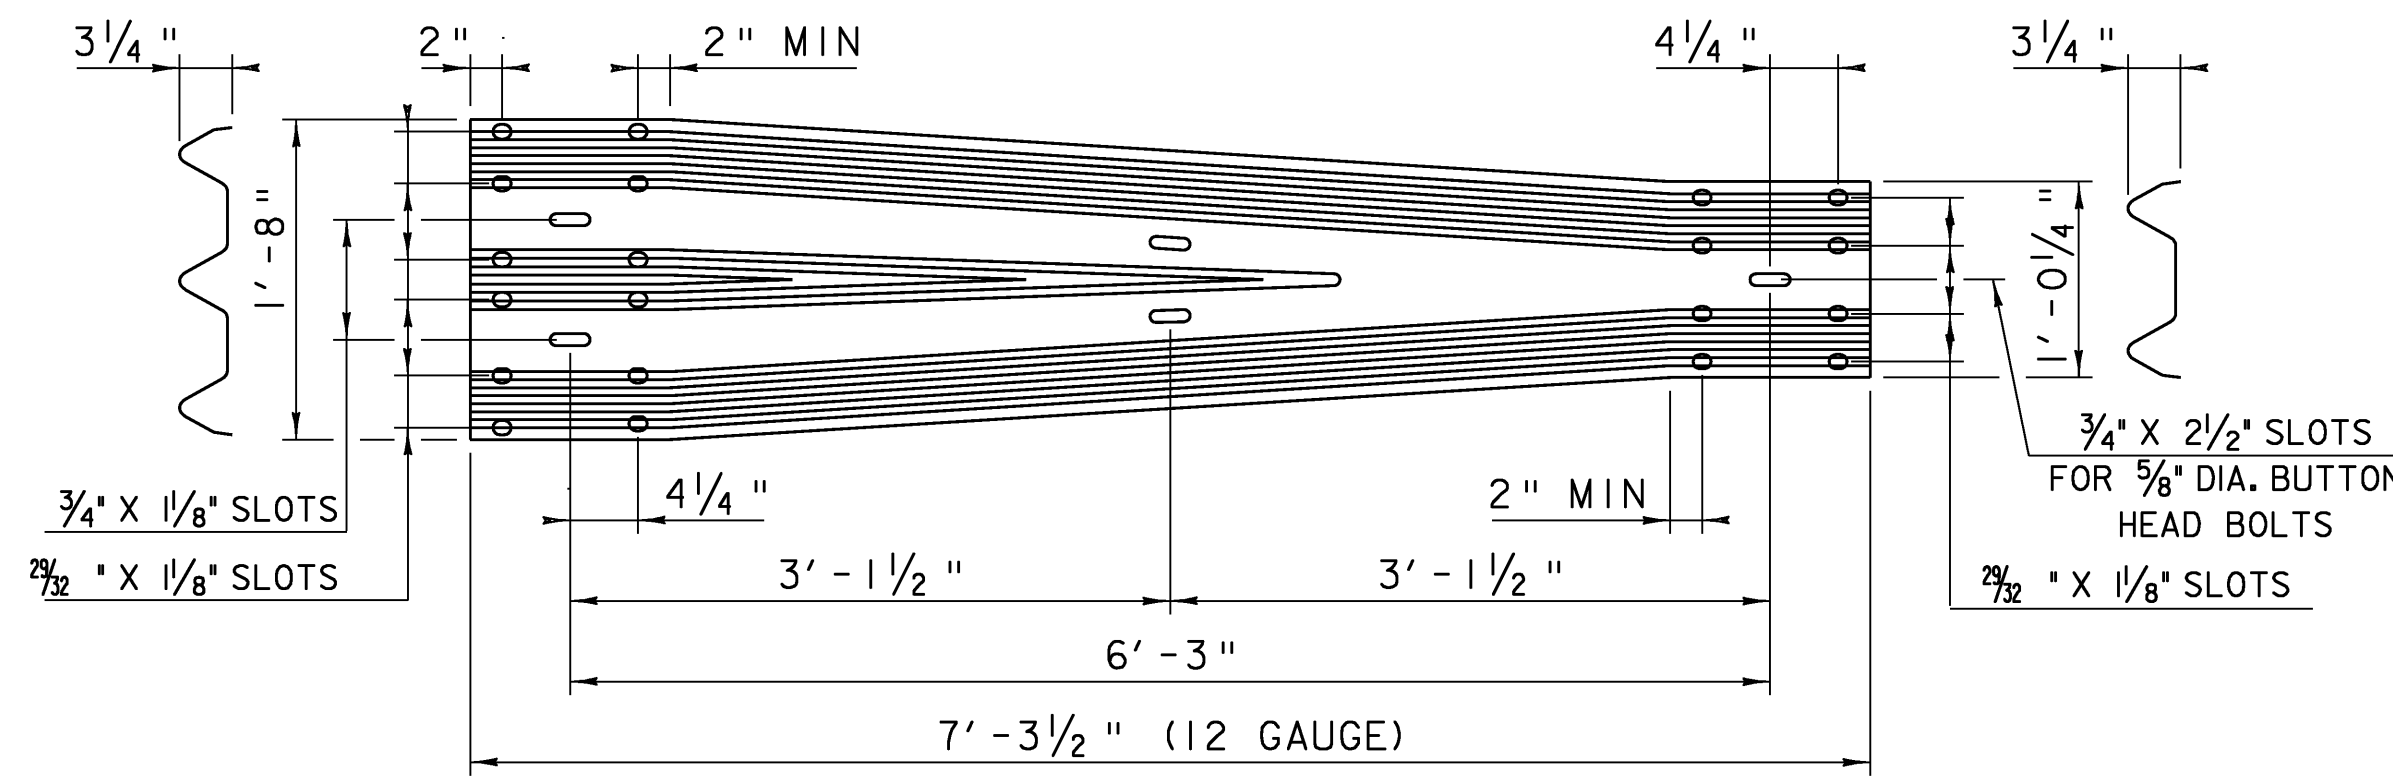

**THRIE-BEAM TO HDSB  
TRANSITION SECTION**

SCALE 1" = 1'-0"

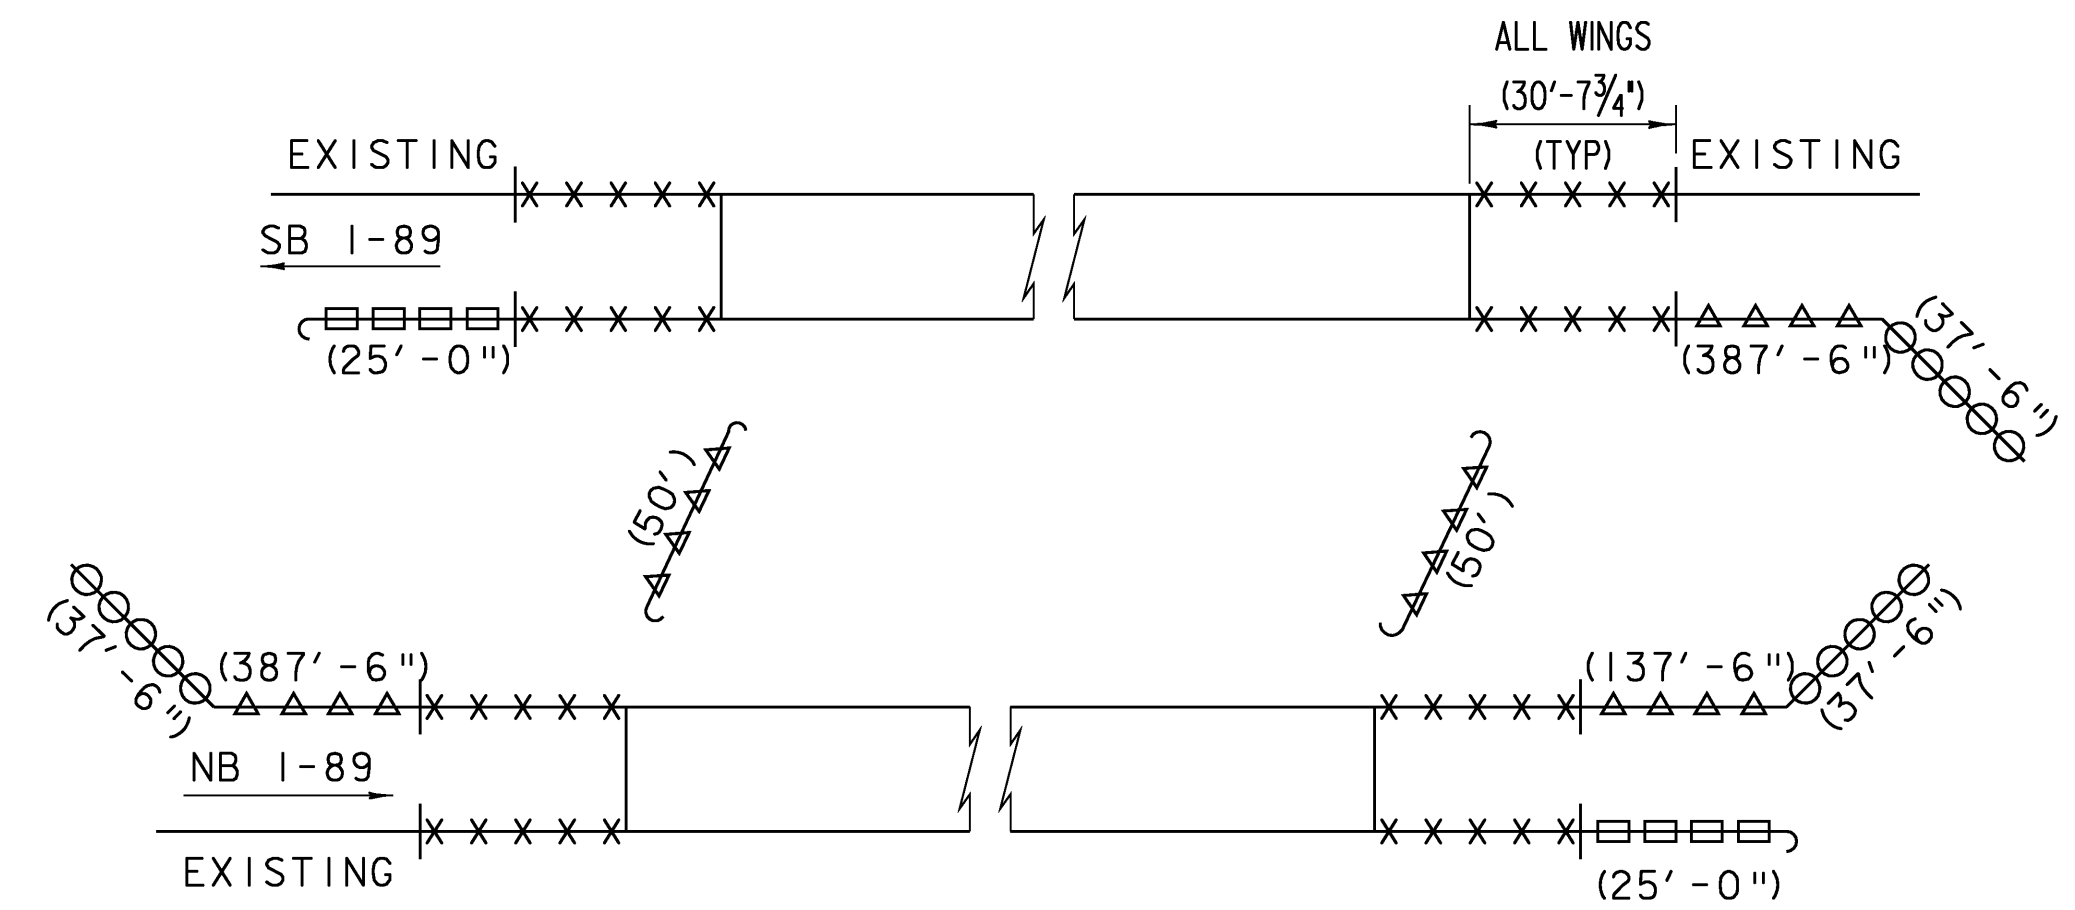


**RAIL PAY ITEMS**

NTS


- XXXXXX - SEE APPROACH SECTION BELOW
- ⊗ - MANUFACTURED TERMINAL SECTION, FLARED
- ▣ - HD STEEL BEAM GUARD RAIL, GALVANIZED, TRAILING END TERMINAL. SEE STANDARD G-1d
- ▲ - HD STEEL BEAM GUARD RAIL, GALVANIZED. SEE STANDARD G-1

NOTE: THRIE-BEAM TERMINAL CONNECTOR SHALL BE INCLUDED UNDER ITEM 900.620, SPECIAL PROVISION (GUARDRAIL APPROACH SECTION TO F-SHAPE CONCRETE RAIL). THRIE-BEAM CONNECTION PLATE SHALL BE INCIDENTAL TO ITEM 900.640, SPECIAL PROVISION (BRIDGE RAILING, F-SHAPE CONCRETE)

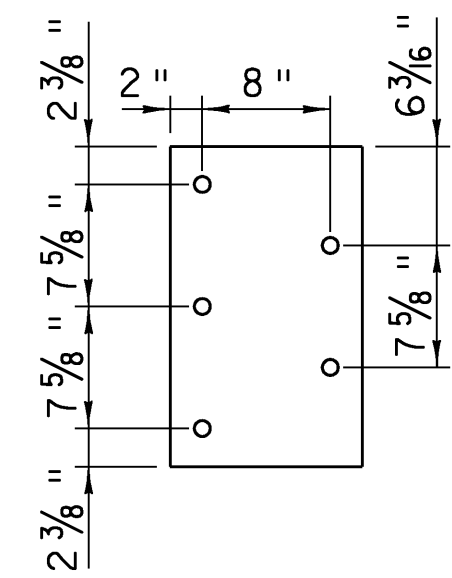


**ELEVATION THRIE-BEAM  
CONNECTION PLATE DETAIL**

SCALE 1" = 1'-0"

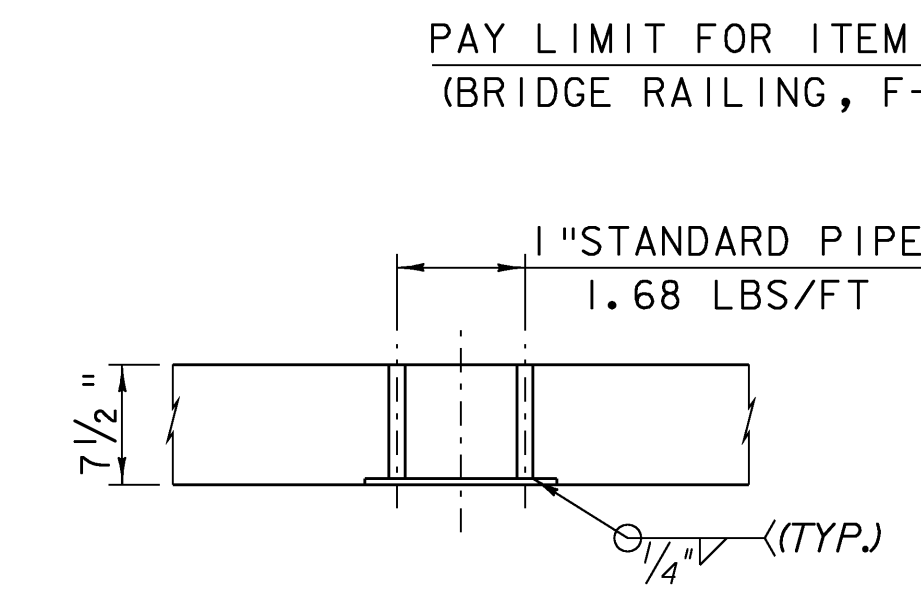


**PLAN THRIE-BEAM  
CONNECTION PLATE DETAIL**

SCALE 1" = 1'-0"

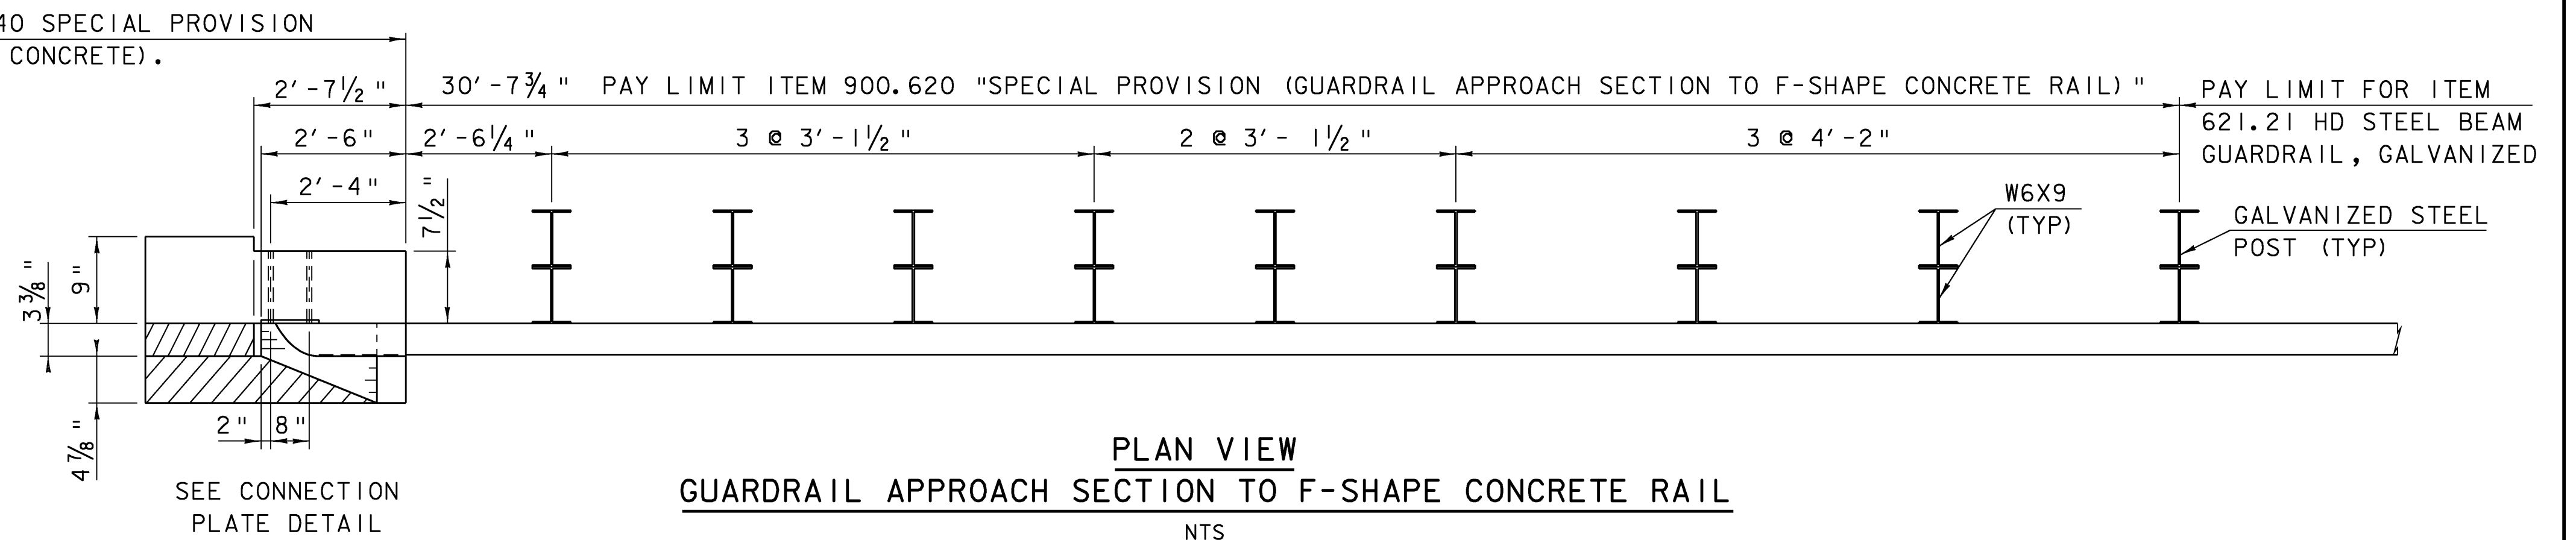


**PLAN VIEW  
GUARDRAIL APPROACH SECTION TO F-SHAPE CONCRETE RAIL**

NTS

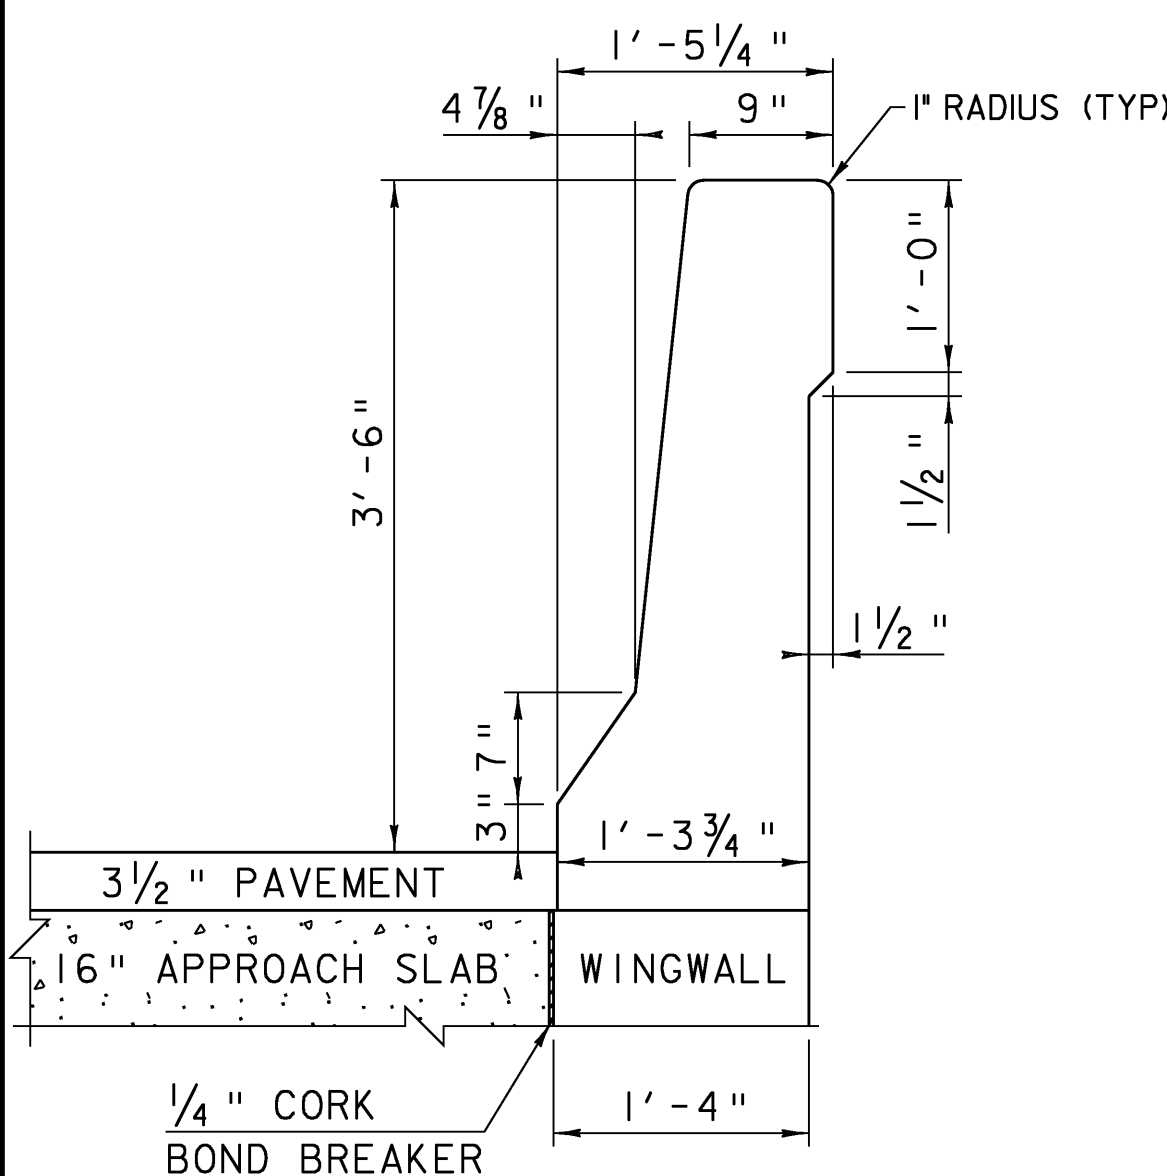


**SECTION G-G  
NEW RAIL DETAIL**

SCALE 1" = 1'-0"

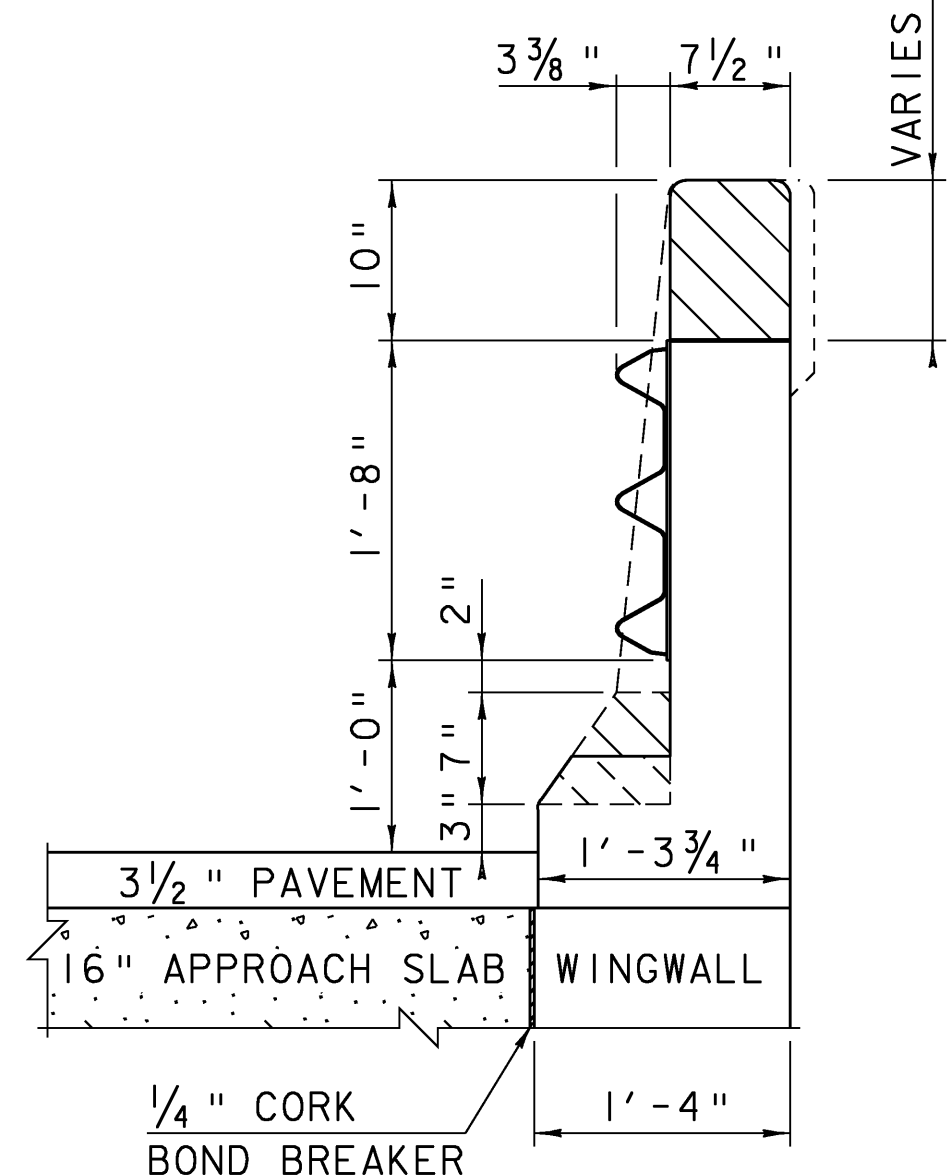

**SECTION F-F  
NEW RAIL DETAIL**


SCALE 1" = 1'-0"



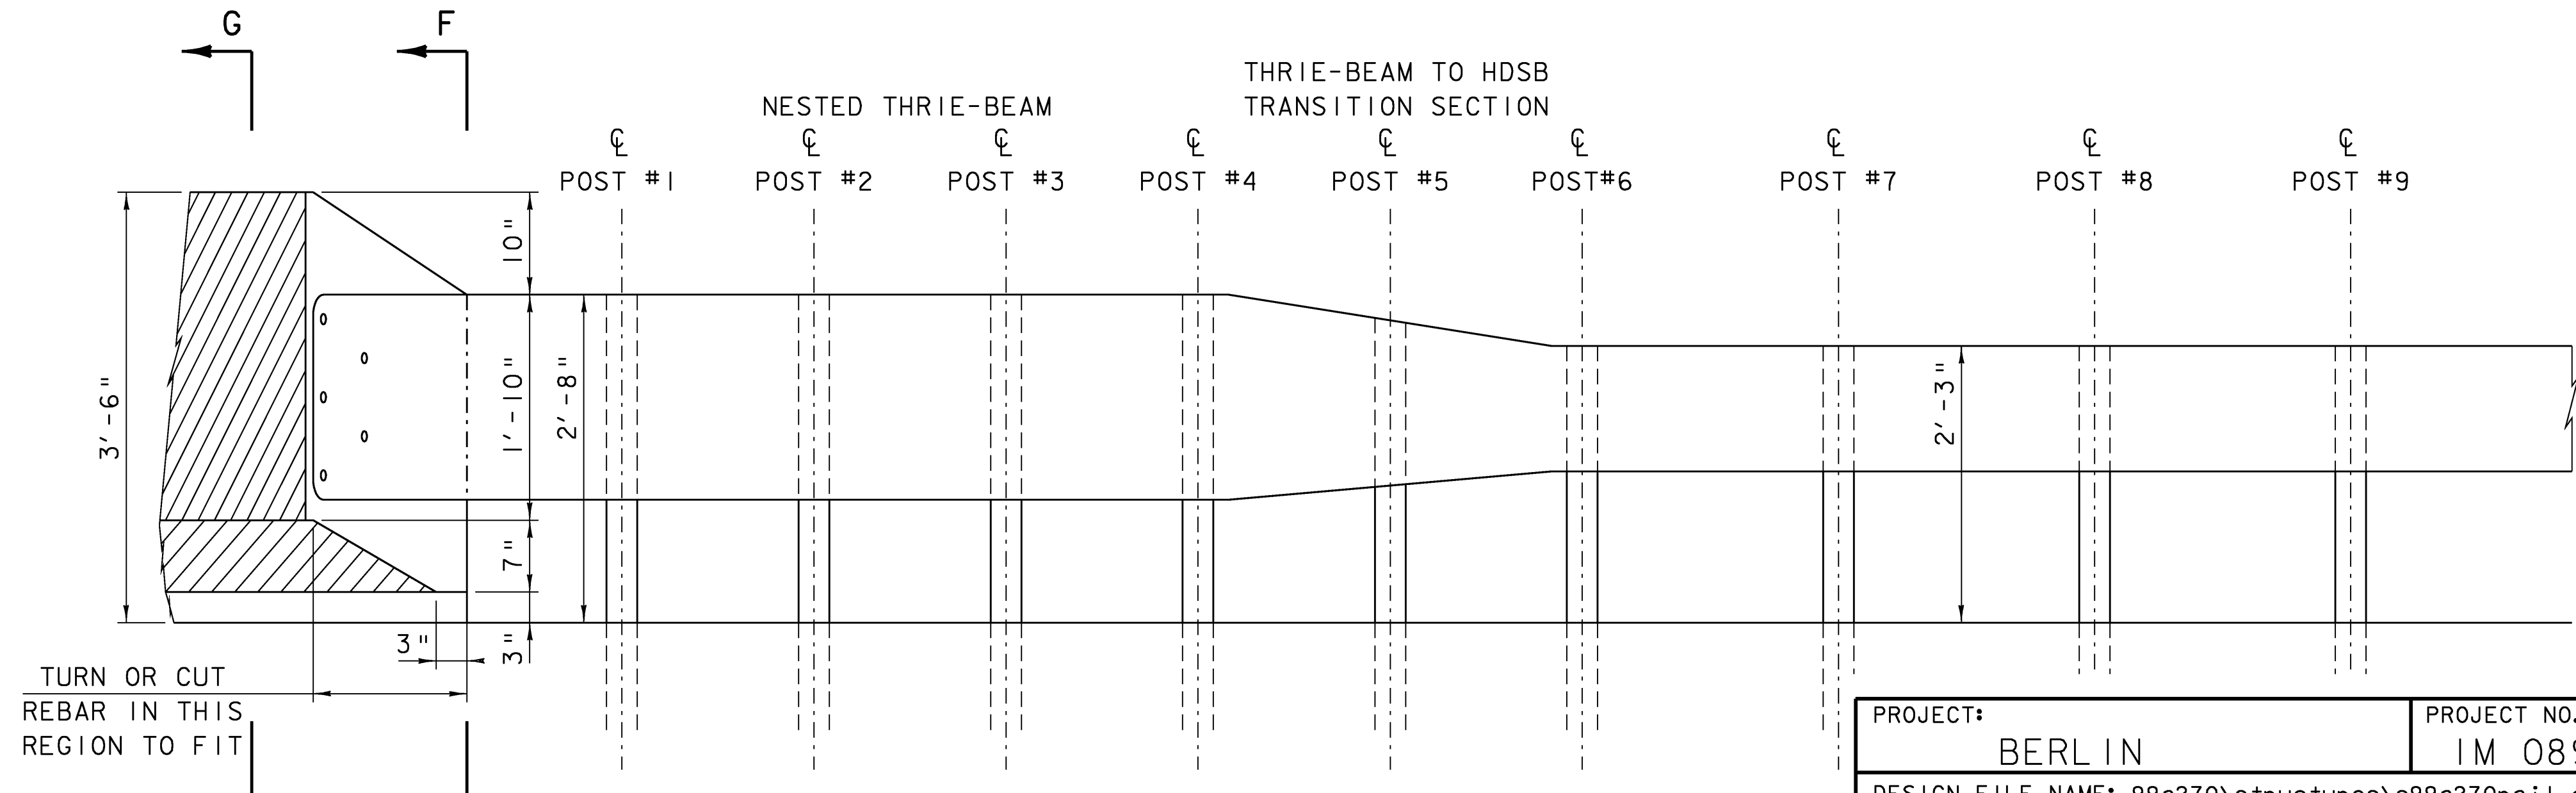


**ELEVATION VIEW  
GUARDRAIL APPROACH SECTION TO F-SHAPE CONCRETE RAIL**

NTS

PROJECT: <b>BERLIN</b>	PROJECT NO.: <b>IM 089-1 (20)</b>
DESIGN FILE NAME: s99a270\structures\s99a270rail.dgn	PLOT DATE: 05-DEC-2007
IPARM FILE NAME: s99a270railtran.i	DRAWN BY: S.MORIN
DESIGNED BY: G.SPILAK	CHECKED BY: R.S.YOUNG
SQUAD LEADER: C.P.WILLIAMS	
RAIL TRANSITION DETAILS	SHEET: 61 OF 104

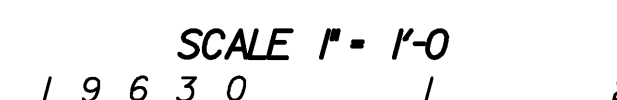

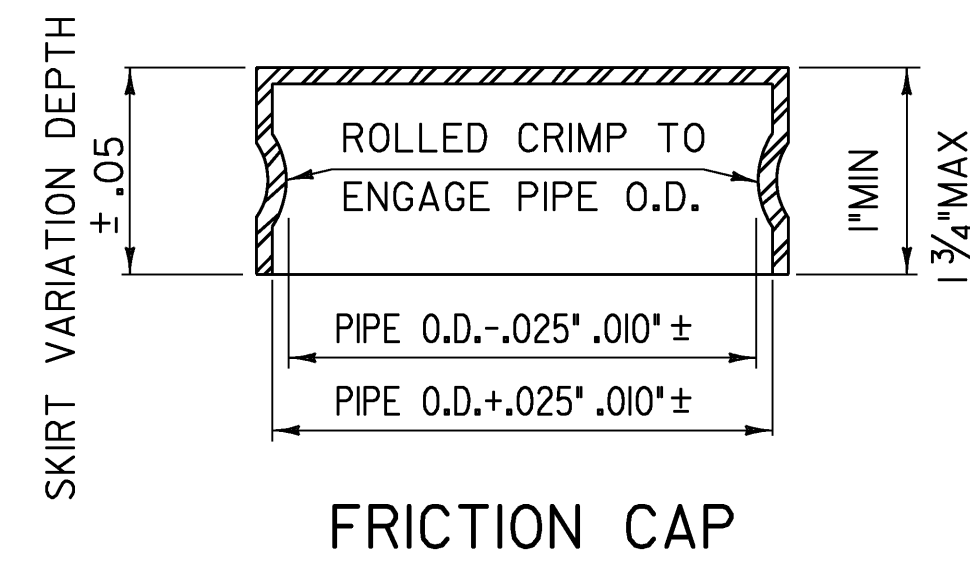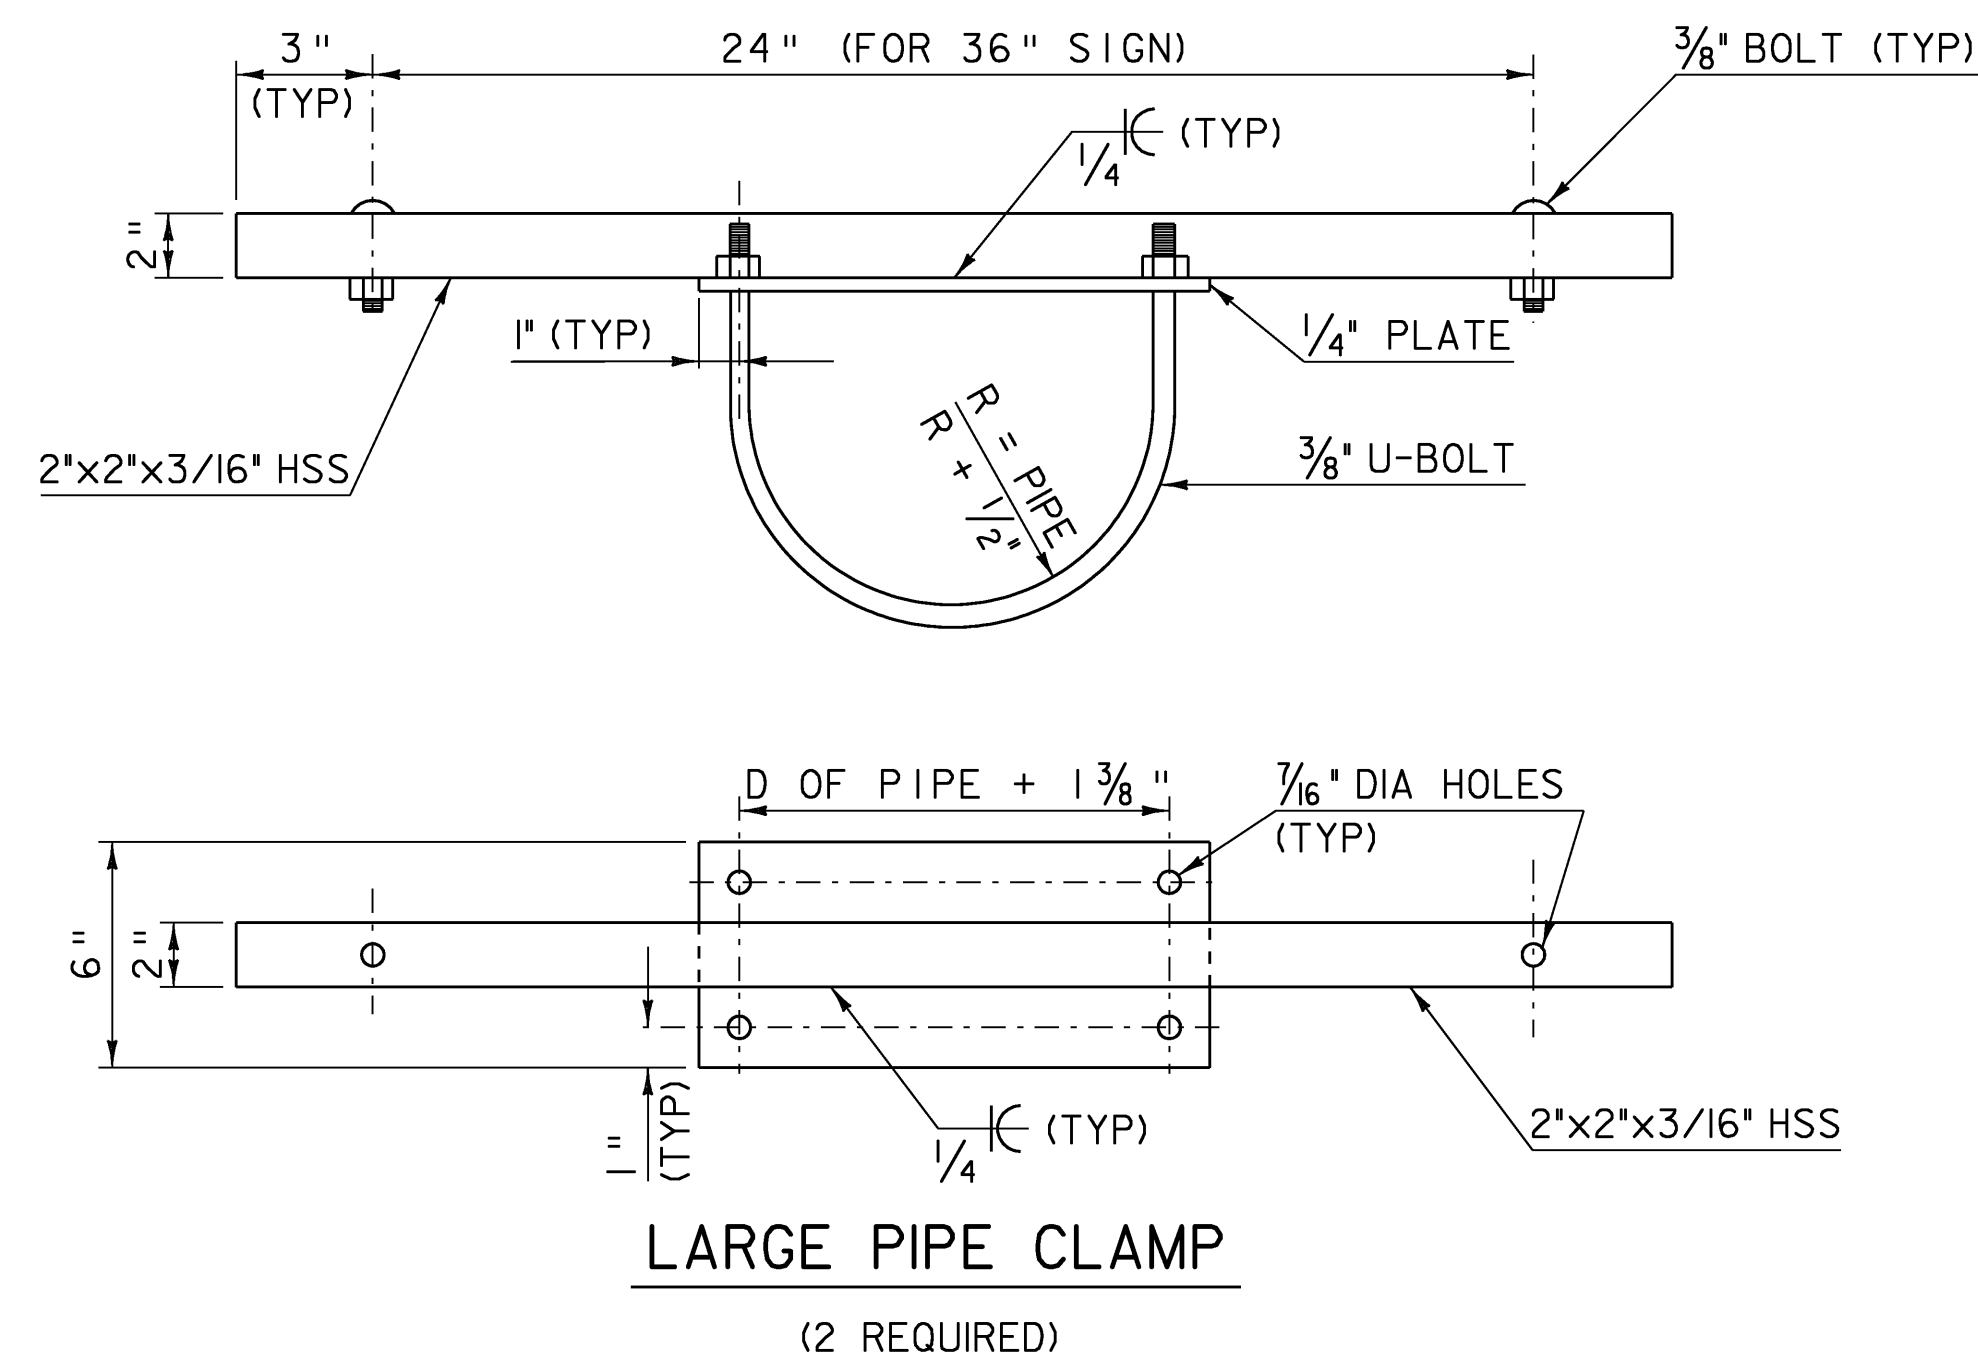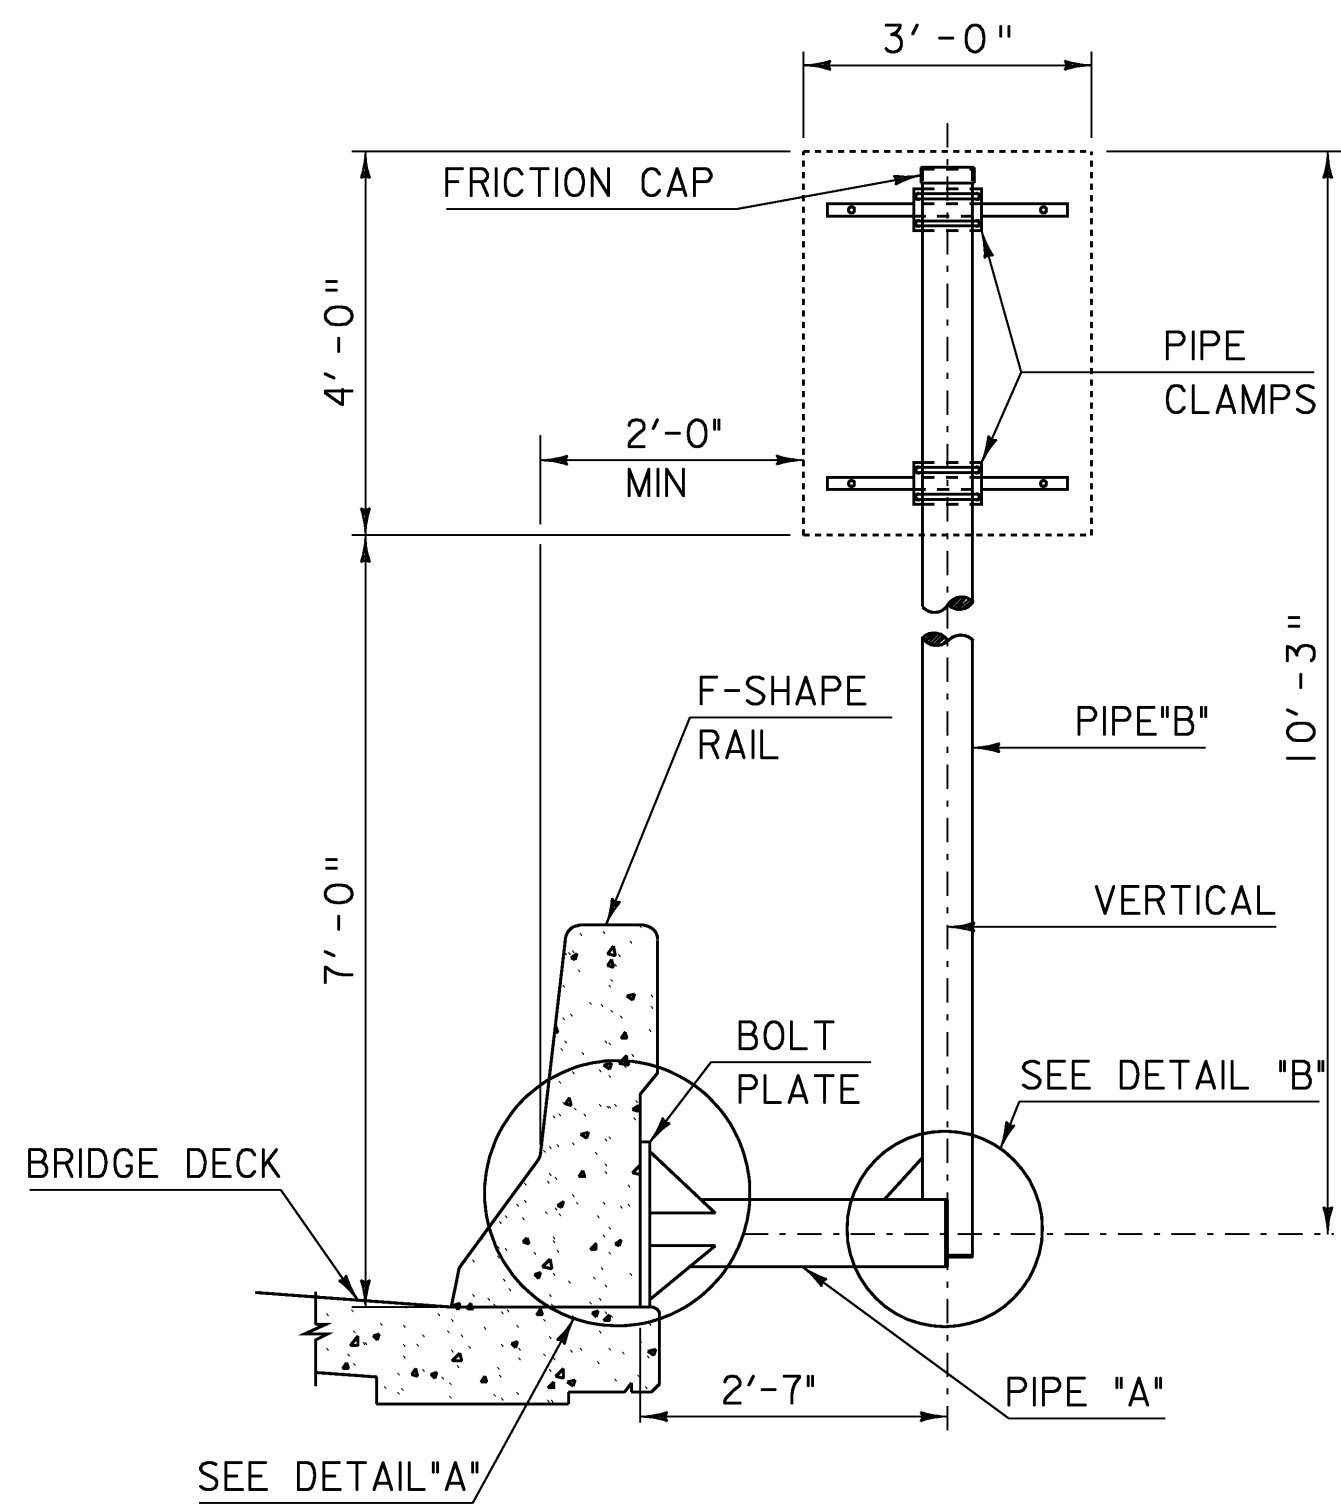


NOTE:  
FRICTION CAPS-MANUFACTURED FROM HOT OR COLD ROLLED STEEL SHEETS. SIZED FOR DRIVE FRICTION FIT, AND SO FORMED AS TO HAVE NO TENDENCY TO ROCK WHEN SEATED. THEY SHALL BE FREE OF SHARP INDENTATIONS AND EVIDENCE OF METAL FRACTURE, WITH RIMS REASONABLY STRAIGHT AND SMOOTH.

PIPE SIZES		
SIGN AREA S.F.	PIPE "A" SIZE	PIPE "B" SIZE
12	8.625" O. D. x 0.332" W. T.	4.500" O. D. x 0.337" W. T.




NOTES:

- FABRICATE SIGN MOUNTS SO SIGN SUPPORT PIPE IS VERTICAL.
- SIGN PANELS SHALL BE ATTACHED TO THE 2" HSS PIPE CLAMPS AND 4 1/2" DIA. PIPE ARM AS SHOWN.
- LOCK NUTS WITH NON-REVERSIBLE HIGH TENSILE STRENGTH STAINLESS STEEL LOCKING PINS SHALL BE USED ON BOLTS.
- THE BOLTS SHALL BE A307, AND SHALL NOT BE LESS THAN 4 1/2" IN LENGTH.
- PIPE AND STRUCTURAL TUBING FOR THE SIGN SUPPORT SHALL BE ASTM A500, GRADE B. PLATES SHALL BE ASTM A572, GRADE 50.
- SIGN SUPPORTS SHALL BE GALVANIZED AFTER FABRICATION ACCORDING TO SUBSECTION 516.04.
- TOOLS, LABOR, AND MATERIALS OR ANY OTHER INCIDENTALS NECESSARY TO EFFECT THE INSTALLATION OF THE SIGN SUPPORT TO THE CONCRETE BRIDGE RAIL SHALL BE PAID FOR UNDER THE ITEM 506.60, "STRUCTURAL STEEL".


BRIDGE MOUNTED SIGNS

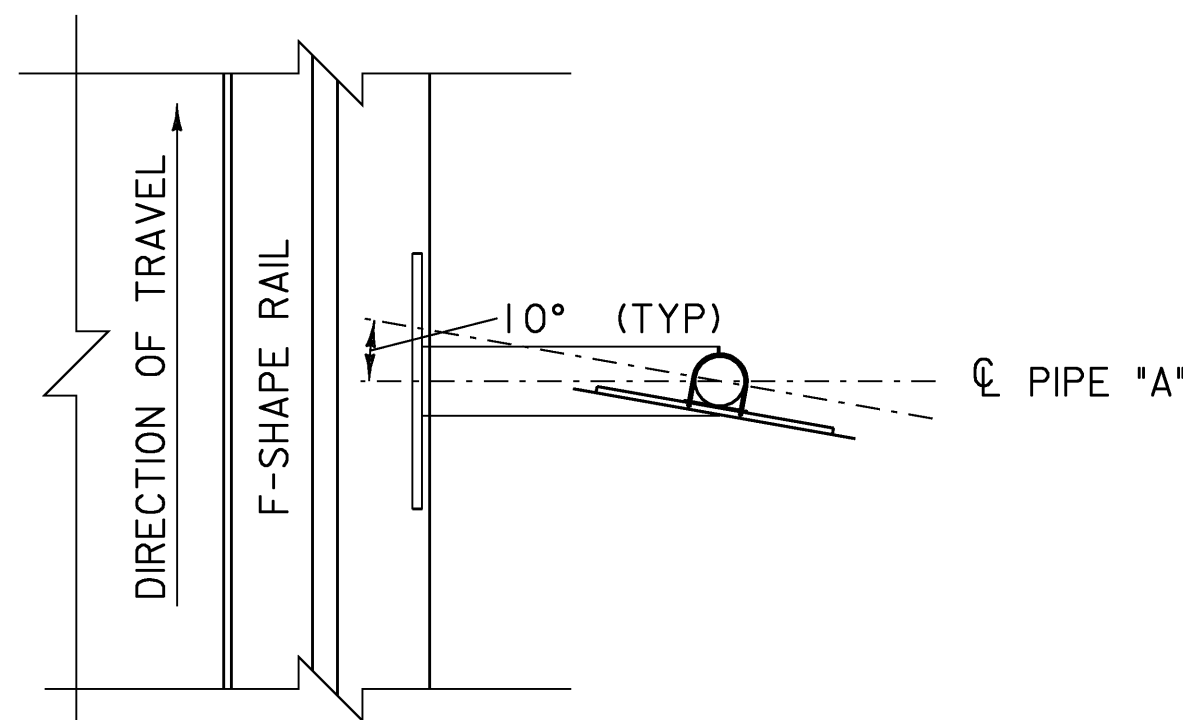

BRIDGE MOUNTED SIGN FACING

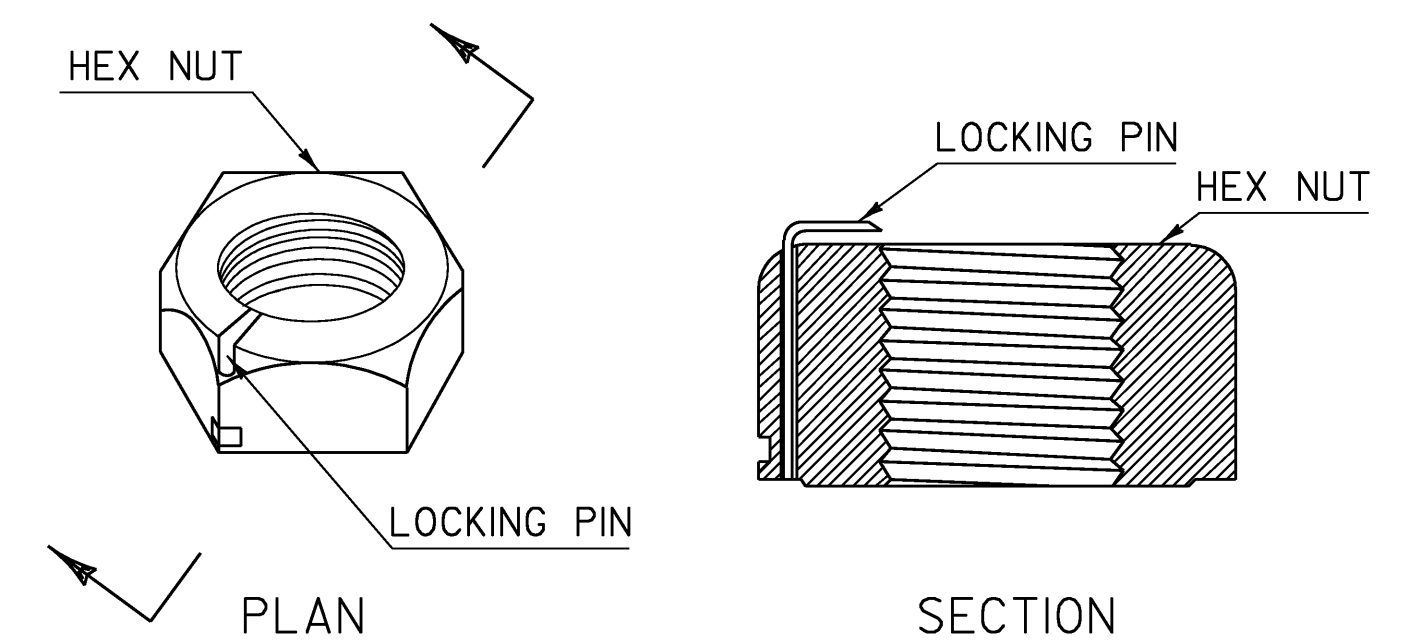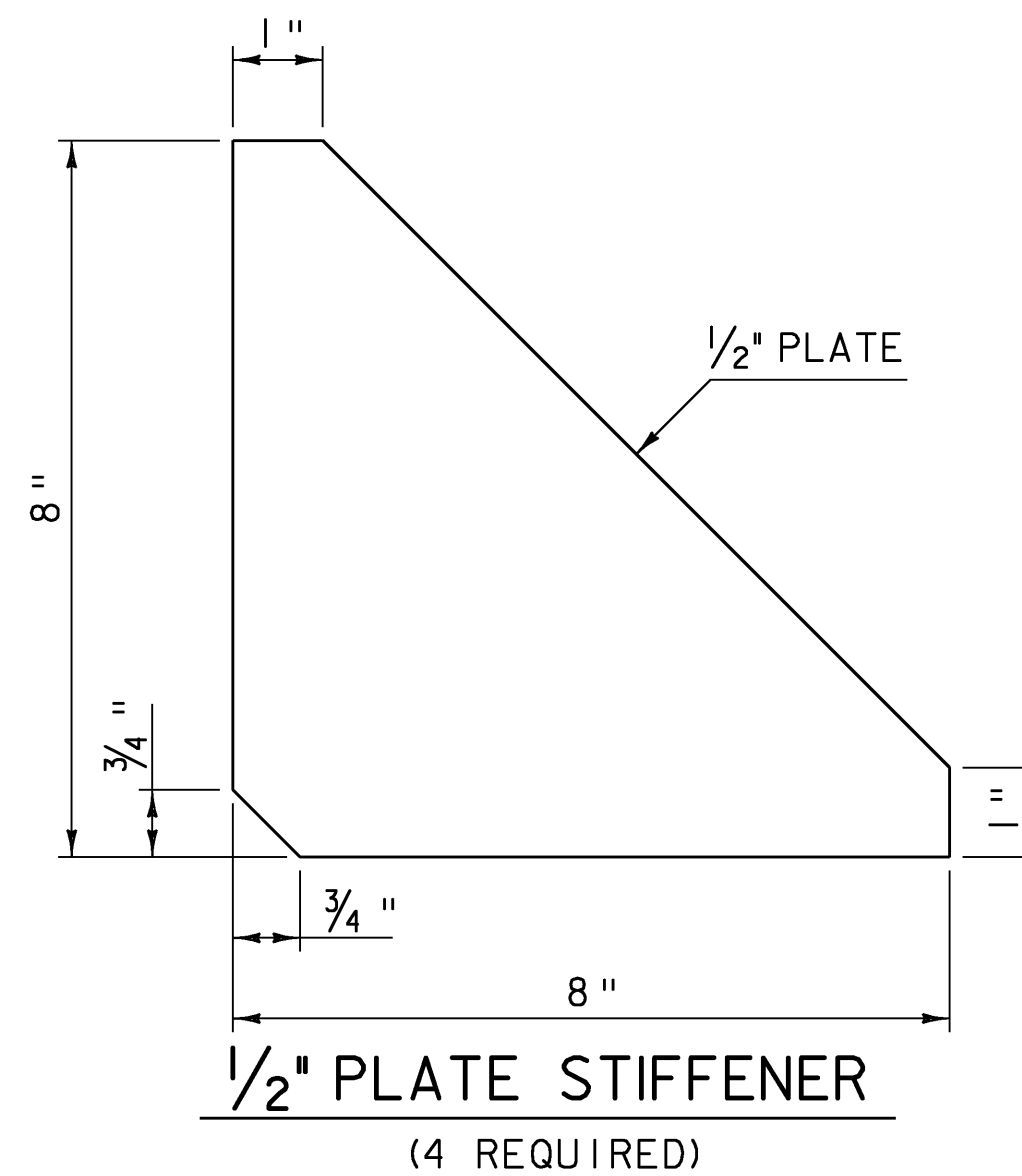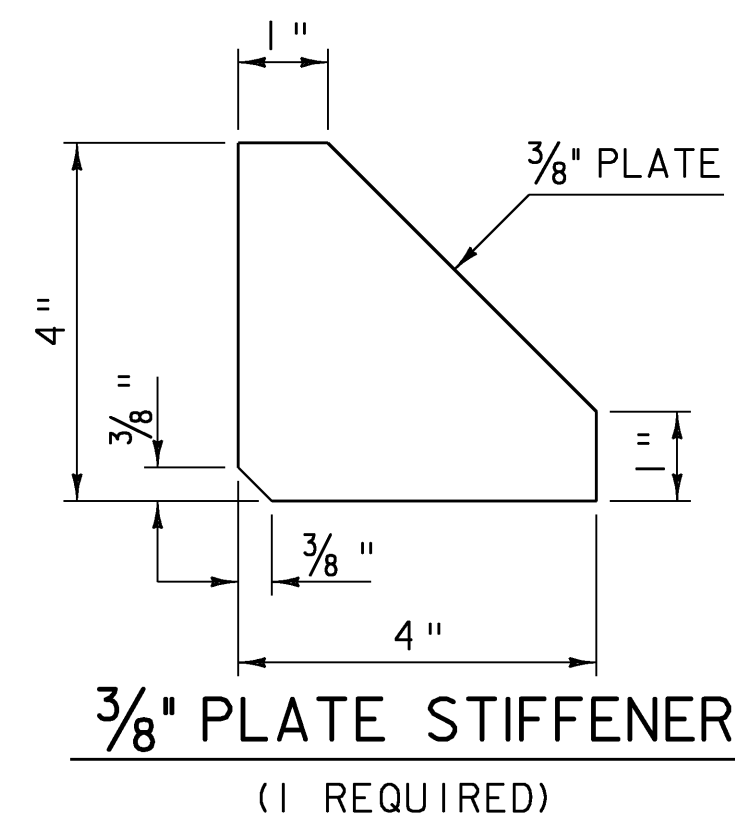


LOCK NUT DETAIL

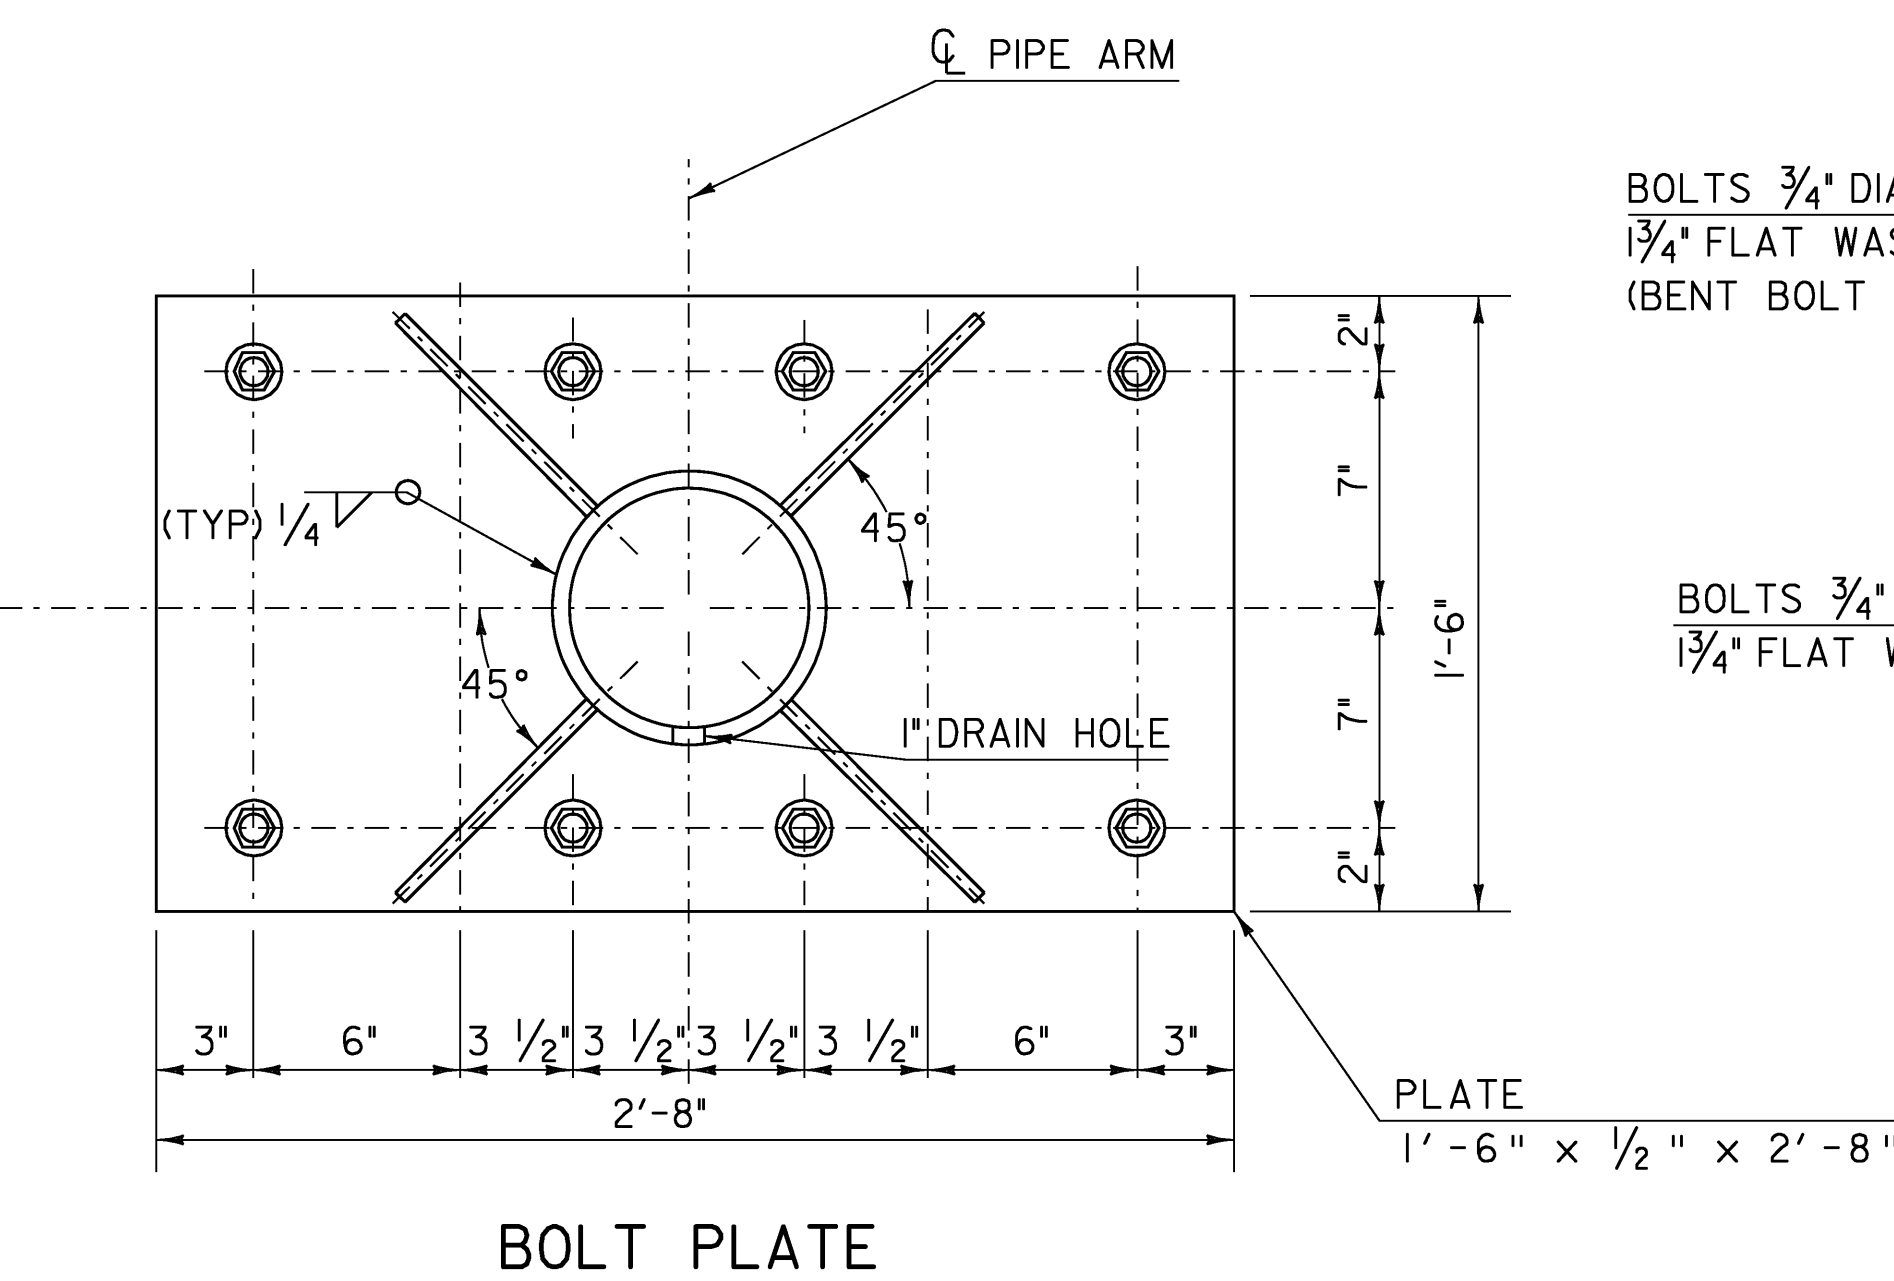


BOLTS 3/4" DIA. x 12" W/SQUARE HEAD, 1 3/4" FLAT WASHERS & LOCK NUT (BENT BOLT AS SHOWN).

BOLTS 3/4" DIA. X 9" W/SQUARE HEAD, 1 3/4" FLAT WASHERS & LOCK NUTS.

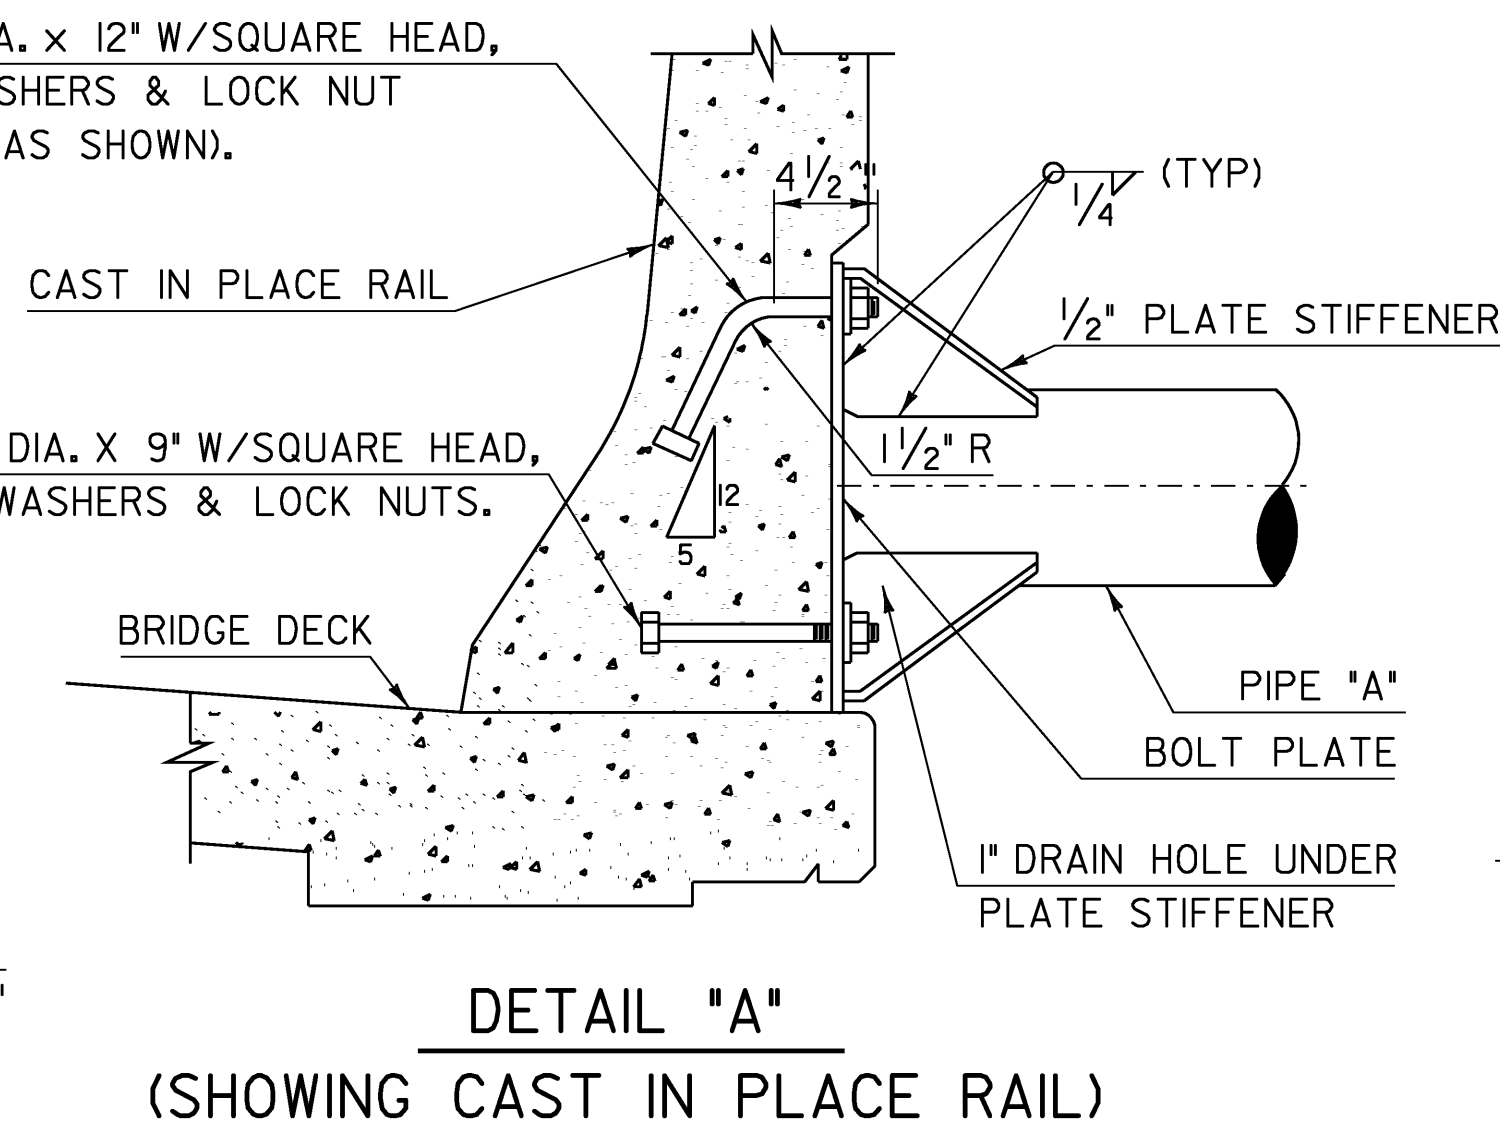

DETAIL "A"  
(SHOWING CAST IN PLACE RAIL)

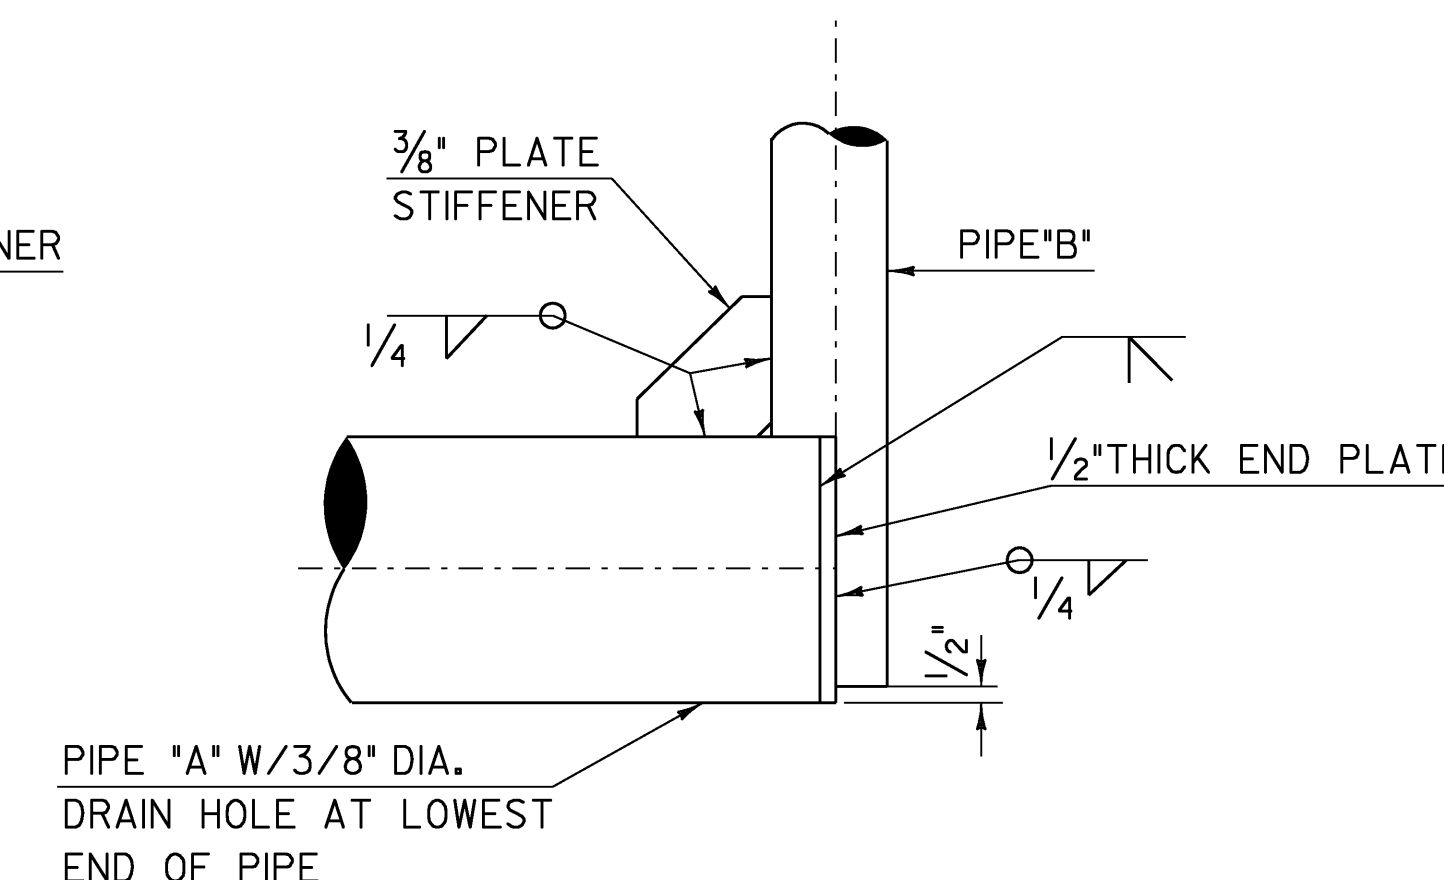

DETAIL "B"



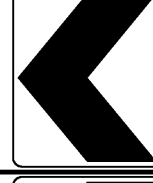
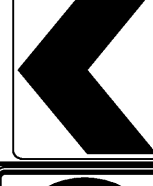



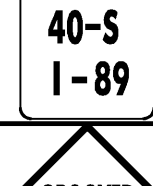


SIGN SUPPORT DETAILS


(FOR W-1-8 CHEVRON SIGNS)  
(2 SIGN SUPPORTS REQUIRED)

NOTE: SEE LAYOUT NORTHBOUND 2 SHEET 15 FOR LOCATIONS  
ALL DIMENSIONS NTS

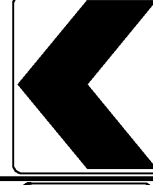PROJECT: BERLIN	PROJECT NO.: IM 089-1 (20)
DESIGN FILE NAME: 99a270\structures\99a270sign post rail.dgn	PLOT DATE: 05-DEC-2007
IPARM FILE NAME: s99a270fsign.i	DRAWN BY: M.FESSEL
DESIGNED BY: R. S. YOUNG	CHECKED BY: R. S. YOUNG
SQUAD LEADER: C.P. WILLIAMS	SHEET: 62 OF 104
BRIDGE MOUNTED SIGN DETAILS	

# TRAFFIC SIGN SUMMARY SHEET

MILEMARKER, STATION, OR SIGN NUMBER	SIGN LEGEND	SIGN DIMENSIONS		NEW & SALVAGED SIGNS				EXIST POST	NO. OF POSTS	NEW SIGN POSTS																REMARKS	SIGN DETAIL	
				"A"	"B"	SALV SIGN	SALV TIS			FLANGED CHANNEL			SQUARE STEEL (In)			TUBULAR ALUMINUM (In)			TUBULAR STEEL (In)				W-SHAPE STEEL				DETAIL ON SHEET NUMBER	STD. SHEET NUMBER
		lb/''								1.75	2.0	2.5	3.0	4.0	4.0 MOD	FOUND-ATION				'G. SIZE		WEIGHT	POST SIZE					
		1.12	2.0							3.0	1.88	2.16	3.35	1.3	1.7	1.7	3.0	3.5	4.0	5.0	24"			30"	7.6			
STA 289+22 RT I-89 NB		1	36	48	12				2																		W I-8 (ASTM TYPE IX SHEETING)	E-150 E-160
STA 290+49 RT I-89 NB		1	6	8	0.33				1	6.50																	VD-70I	E-134 E-160
STA 291+67 RT I-89 NB		1	36	48	12				0																		W I-8 SEE MOUNTING DETAILS SHEET 62 (ASTM TYPE IX SHEETING)	E-150
STA 294+I RT I-89 NB		1	36	48	12				0																		W I-8 SEE MOUNTING DETAILS SHEET 62 (ASTM TYPE IX SHEETING)	E-150
STA 294+I RT I-89 NB		1	36	36					1																		R 3-4	E-143 E-151
STA 294+I RT I-89 NB		1	36	36					1																		R 3-4	E-143 E-151
STA 297+29 RT I-89 NB		1	48	60	20				2																		WI3-2	E-150
STA 395+99 LT I-89 SB		1	6	8	0.33				1	6.50																	VD-70I	E-134 E-160
MM 52.09 I-89 NB		1	48	48	16				2																		VW8-14, SEE GENERAL NOTE 20 (SHEET 10)	SHEET 24
MM 52.81 I-89 SB		1	48	48	16				2																		VW8-14, SEE GENERAL NOTE 20 (SHEET 10)	SHEET 24

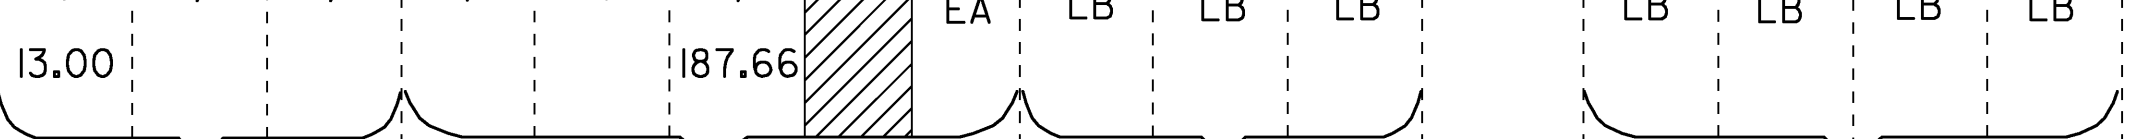

FINAL POST LENGTHS ARE TO BE DETERMINED IN THE FIELD. POST SIZES ARE COMPUTED BASED ON INFORMATION FURNISHED ON THE STANDARD SHEETS AND THE TRAFFIC & SAFETY DIVISION'S "SIGN POST DESIGN GUIDELINE."

<b>TOTALS</b>	SF	SF	EA.	SF		13.00	187.66	EA.	LB	EA.	LB	EA.	EA.	LB
	88.7		2											

PROJECT: BERLIN	PROJECT NO.: IM 089-1(20)
DESIGN FILE NAME: s99a270/structures/s99a270trafnote.dgn	PLOT DATE: 17-DEC-2007
IPARM FILE NAME: s99a270+ss.l	SURVEY DATE: 12/2001
SURVEYED BY: R.GILMAN	SQUAD LEADER: C.P.WILLIAMS
TRAFFIC SIGN SUMMARY SHEET	SHEET: 63 OF 104





## EROSION PREVENTION AND SEDIMENT CONTROL NARRATIVE

### PROJECT DESCRIPTION

The project is located on Interstate 89 over Vermont Route 12 in Berlin Vermont. The project involves the rehabilitation of Bridges 40N and 40S with minor approach work. The horizontal and vertical alignments are the same as what currently exists. Crossovers will be constructed to maintain traffic while each bridge is being rehabilitated.

It is anticipated that this project will last three construction seasons. The anticipated scheduling is as follows:

- Year One** – Develop staging area and field offices, installation of construction signs, construction of northbound crossover, and rehabilitation of Bridge 40N. The rehabilitation Includes removal of the bridge deck and construction of a new concrete deck with concrete railing. Reopen the northbound lane and seed and mulch disturbed areas
- Year Two** – Construction of southbound crossover and Rehabilitation of Bridge 40S. The rehabilitation Includes removal of the bridge deck and construction of a new concrete deck with concrete railing. Construct new U-turn as shown on the plans. Reopen the southbound lanes and seed and mulch disturbed areas.
- Year Three** – Paint girders on both bridges. No crossovers will be necessary during this activity. Traffic will be shifted as required to allow Work to be completed. Remove all construction signs and clean site. Seed and mulch all disturbed areas requiring revegetation.

Note: Area of disturbance shall include limits of earth disturbance within the project area including any waste, staging, and borrow areas within or directly adjacent to the project limits.

The area of disturbance is approximately 4.31 acres.

### SITE INVENTORY AND ANALYSIS

#### **OFF SITE DRAINAGE CHARACTERISTICS**

The area surrounding the project is rural. There are no homes located in the immediate vicinity of this project as it on the interstate. However, there are condominiums along Vermont Route 12 fairly close to the interstate overpass. The vegetation along the interstate is mostly grass with a scattering of native trees. There is a well established grass swale in the median of the interstate that feeds several drop inlets and culvert pipes. These pipes outlet on the exterior boundary of the north and southbound lanes. The proposed staging area for the project is east of the northbound lane and is located at the bottom of the interstate side slope. This area will be accessed from Vermont Route 12 just east of the I-89 overpass. The area is primarily flat and consists of grass and some pine trees. This staging area is within the state right of way and may require some tree removal.

#### **DRAINAGE, WATERWAYS, BODIES OF WATER:**

There are no bodies of water within or near the project area. The Dog river is the closest body of water and is approximately 4000 feet from the project area.

#### **TOPOGRAPHY, EXISTING ROADS, BUILDINGS, UTILITIES:**

The topography of the project site is rolling hills and mostly grasslands. The approach to the bridges is steep at nearly 5 percent and curves significantly to the left. There is a Grange and a Gravel Pit located west the bridge overpass on route 12 towards Berlin. Vermont Route 12 is below the bridge will remain virtually unaffected by this project. However, there are aerial utilities along Vermont Route 12 that will need to be avoided.

#### **VEGETATION:**

The interstate median has ledge outcrop which changes to grass at approximately mile marker 52. The median remains grass throughout the remainder of the project. The exterior edge of both north and southbound lanes are steep slopes ( 1 on 2) vegetated with grass and shrubs. However, there is ledge outcrop located on the right hand side of the northbound lane just beyond the exit 8 interchange. The staging area has grass and scrub pine as vegetation.

#### **SOILS:**

According to a soil survey completed by the United States Department of Agricultural Soil Conservation there are three types of soil at this location. In the area of the approach from the south, including the staging area, the soil is classified as Buxton Silt Loam which has a K value of 0.32. In the vicinity of the bridges the soil is classified as Colton Gravelly Loamy Sand which has a K value of 0.49. The soil north of the bridges is classified as Tunbridge Lyman Complex which has a K value of 0.24.

Generally, K-values indicate the following: 0.00 – 0.23 = low erodibility; 0.24 – 0.36 = moderate erodibility; 0.37 and higher = higher erodibility

#### **SENSITIVE RESOURCE AREAS:**

No 'Threatened & Endangered Species', wetlands, historical sites, or prime agricultural land have been identified within the project limits.

#### **PROXIMITY TO NATURAL OR MAN-MADE FEATURES:**

Disturbance of soils near natural or man-made waterways consists of the work necessary to replace portions of four bridge abutments and applicable roadway approaches as well as the removal of the existing u-turn. Temporary crossovers will also be constructed and removed.

#### **RISK EVALUATION:**

This project has been determined to be low risk under construction general permit 3-9020(2006). And as such the low risk project handbook must be complied with and be on site at all times. The risk evaluation score for this project is 0. See appendix A (attachment to CGP-3-9020). Overall scores of less than 1 qualify the project as low risk. Any modifications to the project shall result in a re-evaluation of the risk and the contractor shall be responsible for re-filing should the risk change.

## EROSION PREVENTION & SEDIMENT CONTROL

Refer to the low risk site handbook and appropriate detail sheets for each practice required on the project to include but not limited to:

**Mark site boundaries** with "Project Demarcation Fencing" denoted -PDF- on the plans, will be used to delineate the limits the contractor can access with construction equipment. This measure limits the area that can be disturbed and exposed to erosion.

**Limit Disturbance Area** by phasing earth disturbing activities through out the duration of the project.

**Vehicle Tracking Pads** to the project site, staging areas, as well as to waste and borrow areas shall be established. The minimum size of a vehicle tracking pad is 12'X50' (3700X15, 000). All surface water flowing to or diverted toward a vehicle tracking pad shall be piped under the stone. Pipes shall be appropriately sized for the contributing area, however, no pipe smaller than 6" (150) diameter shall be used. See EPSC Detail Sheet for materials and construction method to be utilized when constructing a vehicle tracking pad.

**Install silt fence** per the Erosion Control Detail Sheet. Silt fence shall be installed prior to any upslope earthwork.

**Divert upland runoff** using temporary swales as required.

**Reduce flow velocities** in temporary or permanent swales and ditches using stone check dams. Check dams will be installed per Erosion Control Detail Sheet. The check dams may be removed once the stone lining of the ditch is complete and the surrounding area stabilized.

**Permanent Erosion Control measures include:** Seeding and mulching exposed slopes. Use of erosion matting where required.

**Stabilize exposed soils (temporary and final grade)** by Seeding, mulching, and biodegradable erosion control matting or an equivalent product will be utilized on all slopes greater than 1:3 that are not lined with stone fill. Geo-textile fabric is also required under all stone fill. These slopes shall be stabilized within 48 hours of reaching final grade or during intermittent phases of construction activity. Seeding and mulching shall also be applied immediately to all lawns disturbed beyond the work area delineated on these plans. Tracking of all exposed slopes, combined with temporary mulching, will also be utilized on a regular basis. Any slopes to be exposed for 48 hours prior to final grading shall be tracked and mulched. The forecast of rainfall events shall also trigger protection of exposed slopes. If rainfall is predicted the Contractor must stabilize the site accordingly prior to the forecasted event.

**Winter Stabilization** as required per Low Risk Handbook.

**Temporary sediment settling basins** will not be used on this project as there are no cofferdams requiring dewatering

**Site Inspection** shall be based on Permit authorization requirements.

## GENERAL EROSION & SEDIMENT CONTROL GUIDELINES

The Erosion Control Plans are meant as a guideline for preventing erosion and controlling sediment transportation. The work outlined in this narrative consists of applying measures throughout the life of the project to control erosion and minimize the sediment into receiving waters. The measures include stabilization and structural practices, storm water controls and other pollution prevention controls. This document serves as a guide for the Contractor to make an Erosion Prevention and Sediment Control Plan which shall be submitted to the Construction Environmental Engineer for approval.

Coordinate the installation, use, and removal of erosion and sediment control measures with construction activities to ensure economical, effective and continuous erosion and sediment control. Employ temporary stabilization practices in incremental stages as construction proceeds. The contractor will use additional erosion control measures as necessitated by the sequence of construction and as directed be the engineer. See section 105.23 of the Vermont AOT Standard Specifications for Construction, dated 2006.

Install all erosion and sediment control measures as shown in the Erosion Control Plan or as directed by the engineer. Do not modify the type, size or location of any control or practice without approval of the engineer. All changes shall be approved by the Construction Environmental Engineer and also be noted on the plans, in the weekly inspection report, and reported to the appropriate authority in a timely manner.

Inspect all control measures weekly and after each rainfall event. Repair measures shall be taken as needed.


Preventing initial soil erosion is much more effective than treating eroded sediment. Therefore, stabilize all disturbed areas promptly after construction activity has temporarily or permanently ceased. Also, attempt to time all grading to minimize soil exposure. Temporary vegetation shall be established as noted in the plans and approved by the Construction Environmental Engineer. Perimeter control measures shall be installed following clearing, but prior to the start of any grubbing or grading activity, install other temporary controls in incremental stages as construction proceeds. These perimeter controls shall be maintained until the site is permanently stabilized to the satisfaction of the Engineer and on-site coordinator.

Maintaining vegetated buffers along stream banks, wetlands or other sensitive areas is a crucial erosion and sediment control measure that should be established wherever possible.

Control only sediment-laden runoff generated by the project site. Collect and route clean offsite runoff around or through the project site using diversion berms, diversion channels, culverts and/or temporary pipes.

Do not allow construction equipment to operate on the down slope side of perimeter control measures.

PROJECT: BERLIN	PROJECT NO. : IM 089- 1 (20)
DESIGN FILE NAME: 99a270\structures\99a270excel.dgn	
IPARM FILE NAME: s99a270ecnar.i	PLOT DATE: 05-DEC-2007
DESIGNED BY: K. M. HIGGINS	DRAWN BY: M. FESSEL
SQUAD LEADER: C. P. WILLIAMS	CHECKED BY: K. M. HIGGINS
EROSION CONTROL NARRATIVE	SHEET: 66 OF 104

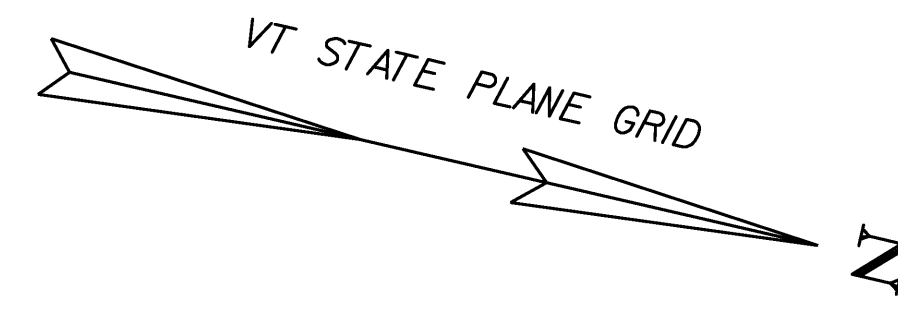

MM 52.10

MM 52.40

ROW LINE

MATCHLINE

MATCHLINE

BERLIN  
MONTPELLIER

ROW LINE

18" CGMP  
DI

18" CGMP  
DI

18" CGMP

1-2

1-2

**LEGEND**

- RUNOFF FLOW DIRECTION
- SOIL BOUNDARY
- SLOPE GRADE
- EXISTING GUARD RAIL

**EPSC EXISTING CONDITIONS  
SITE PLAN SHEET 1**

PROJECT: BERLIN	PROJECT NO.: IM 089-1 (20)
DESIGN FILE NAME: 99a270\structures\s99a270bdr_ero.dgn	PLOT DATE: 05-DEC-2007
IPARM FILE NAME: s99a270excon1.i	DRAWN BY: M.FESSEL
DESIGNED BY: G.SPILAK	CHECKED BY: K.M.HIGGINS
SQUAD LEADER: C.P.WILLIAMS	SHEET: 67 OF 104
EPSC EXISTING CONDITIONS - 1	

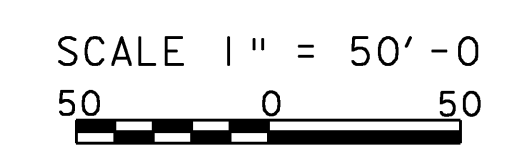

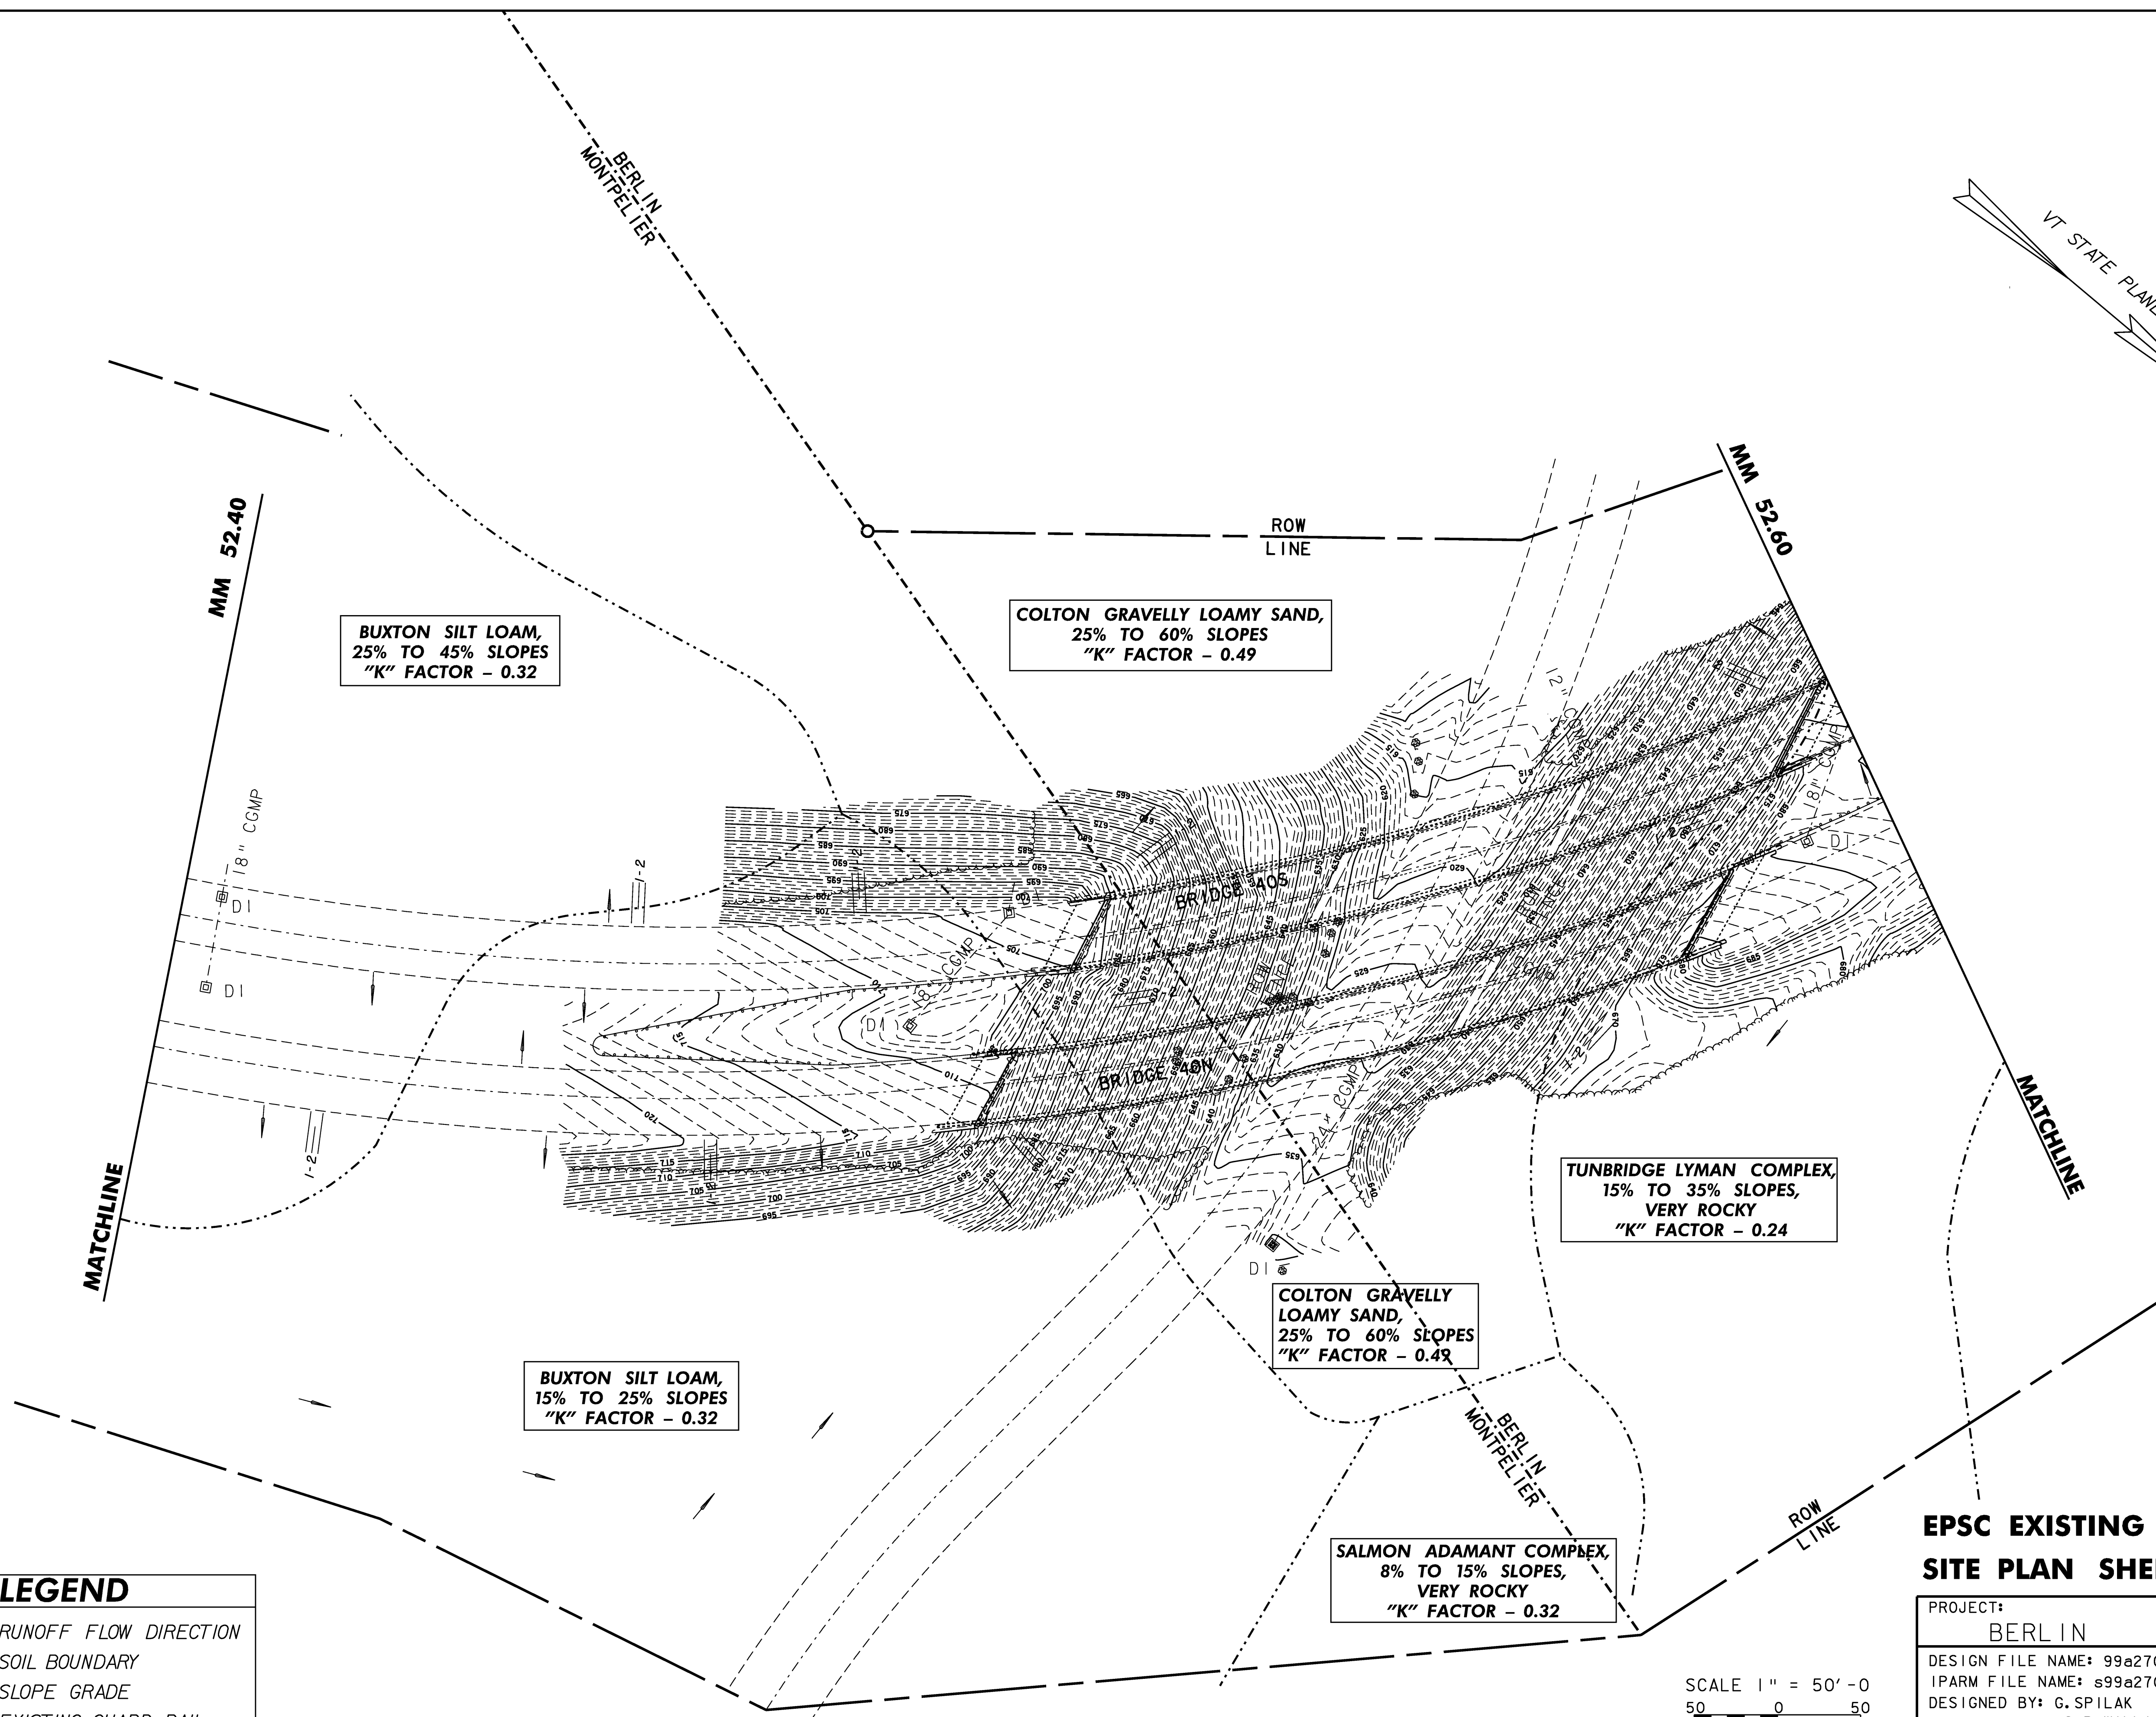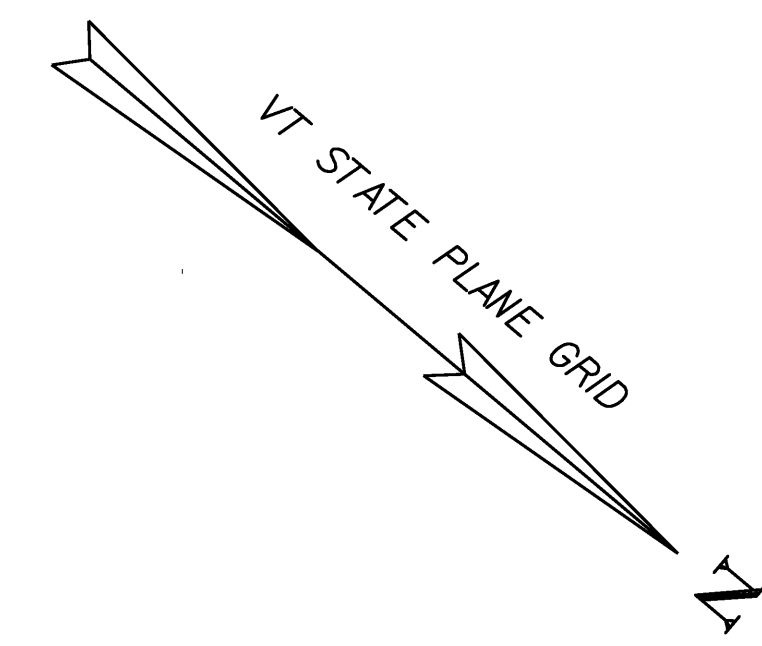

BUXTON SILT LOAM,  
25% TO 45% SLOPES  
"K" FACTOR - 0.32

COLTON GRAVELLY LOAMY SAND,  
25% TO 60% SLOPES  
"K" FACTOR - 0.49

TUNBRIDGE LYMAN COMPLEX,  
15% TO 35% SLOPES,  
VERY ROCKY  
"K" FACTOR - 0.24

BUXTON SILT LOAM,  
15% TO 25% SLOPES  
"K" FACTOR - 0.32

COLTON GRAVELLY  
LOAMY SAND,  
25% TO 60% SLOPES  
"K" FACTOR - 0.49


SALMON ADAMANT COMPLEX,  
8% TO 15% SLOPES,  
VERY ROCKY  
"K" FACTOR - 0.32

LEGEND	
	RUNOFF FLOW DIRECTION
	SOIL BOUNDARY
	SLOPE GRADE
	EXISTING GUARD RAIL

SCALE 1" = 50'-0"  
50 0 50

**EPSC EXISTING CONDITIONS  
SITE PLAN SHEET 2**

PROJECT: BERLIN	PROJECT NO. : IM 089-1 (20)
DESIGN FILE NAME: s99a270\structures\s99a270bdr_ero.dgn	PLOT DATE: 05-DEC-2007
IPARM FILE NAME: s99a270excon2.i	DRAWN BY: M.FESSEL
DESIGNED BY: G.SPILAK	CHECKED BY: K.M.HIGGINS
SQUAD LEADER: C.P.WILLIAMS	SHEET: 68 OF 104
EPSC EXISTING CONDITIONS - 2	

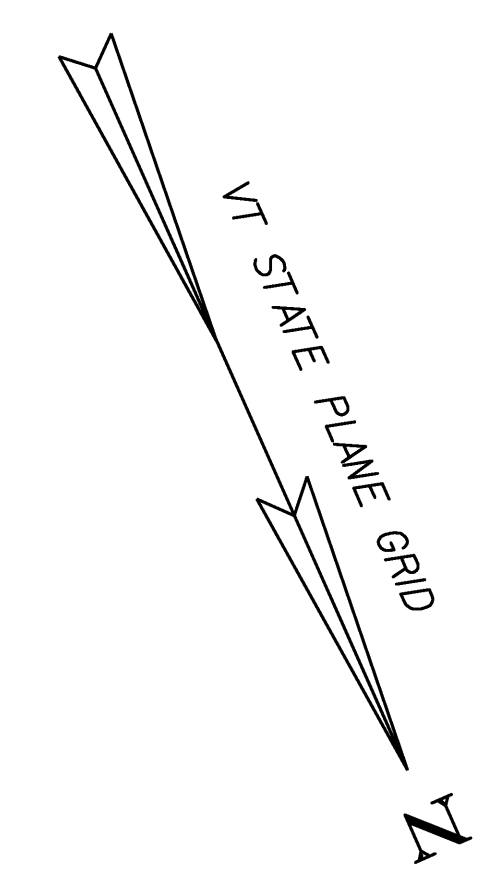

TUNBRIDGE LYMAN COMPLEX,  
15% TO 35% SLOPES,  
VERY ROCKY  
"K" FACTOR - 0.24

TUNBRIDGE LYMAN COMPLEX,  
15% TO 35% SLOPES,  
VERY ROCKY  
"K" FACTOR - 0.24

TUNBRIDGE LYMAN COMPLEX,  
8% TO 15% SLOPES,  
VERY ROCKY  
"K" FACTOR - 0.24

MM 52.60

MM 52.90

MATCHLINE

MATCHLINE

ROW  
LINE

ROW  
LINE

18" CGMP

18" CGMP

18" CGMP


**LEGEND**

- RUNOFF FLOW DIRECTION
- SOIL BOUNDARY
- 1-4 SLOPE GRADE
- EXISTING GUARD RAIL

SCALE 1" = 50'-0"  
50 0 50

**EPSC EXISTING  
CONDITIONS SITE  
PLAN SHEET 3**


PROJECT: BERLIN	PROJECT NO.: IM 089-1 (20)
DESIGN FILE NAME: s99a270\structures\s99a270bdr_ero.dgn	PLOT DATE: 05-DEC-2007
IPARM FILE NAME: s99a270excon3.i	DRAWN BY: M.FESSEL
DESIGNED BY: G.SPILAK	CHECKED BY: K.M.HIGGINS
SQUAD LEADER: C.P.WILLIAMS	SHEET: 69 OF 104
EPSC EXISTING CONDITIONS - 3	

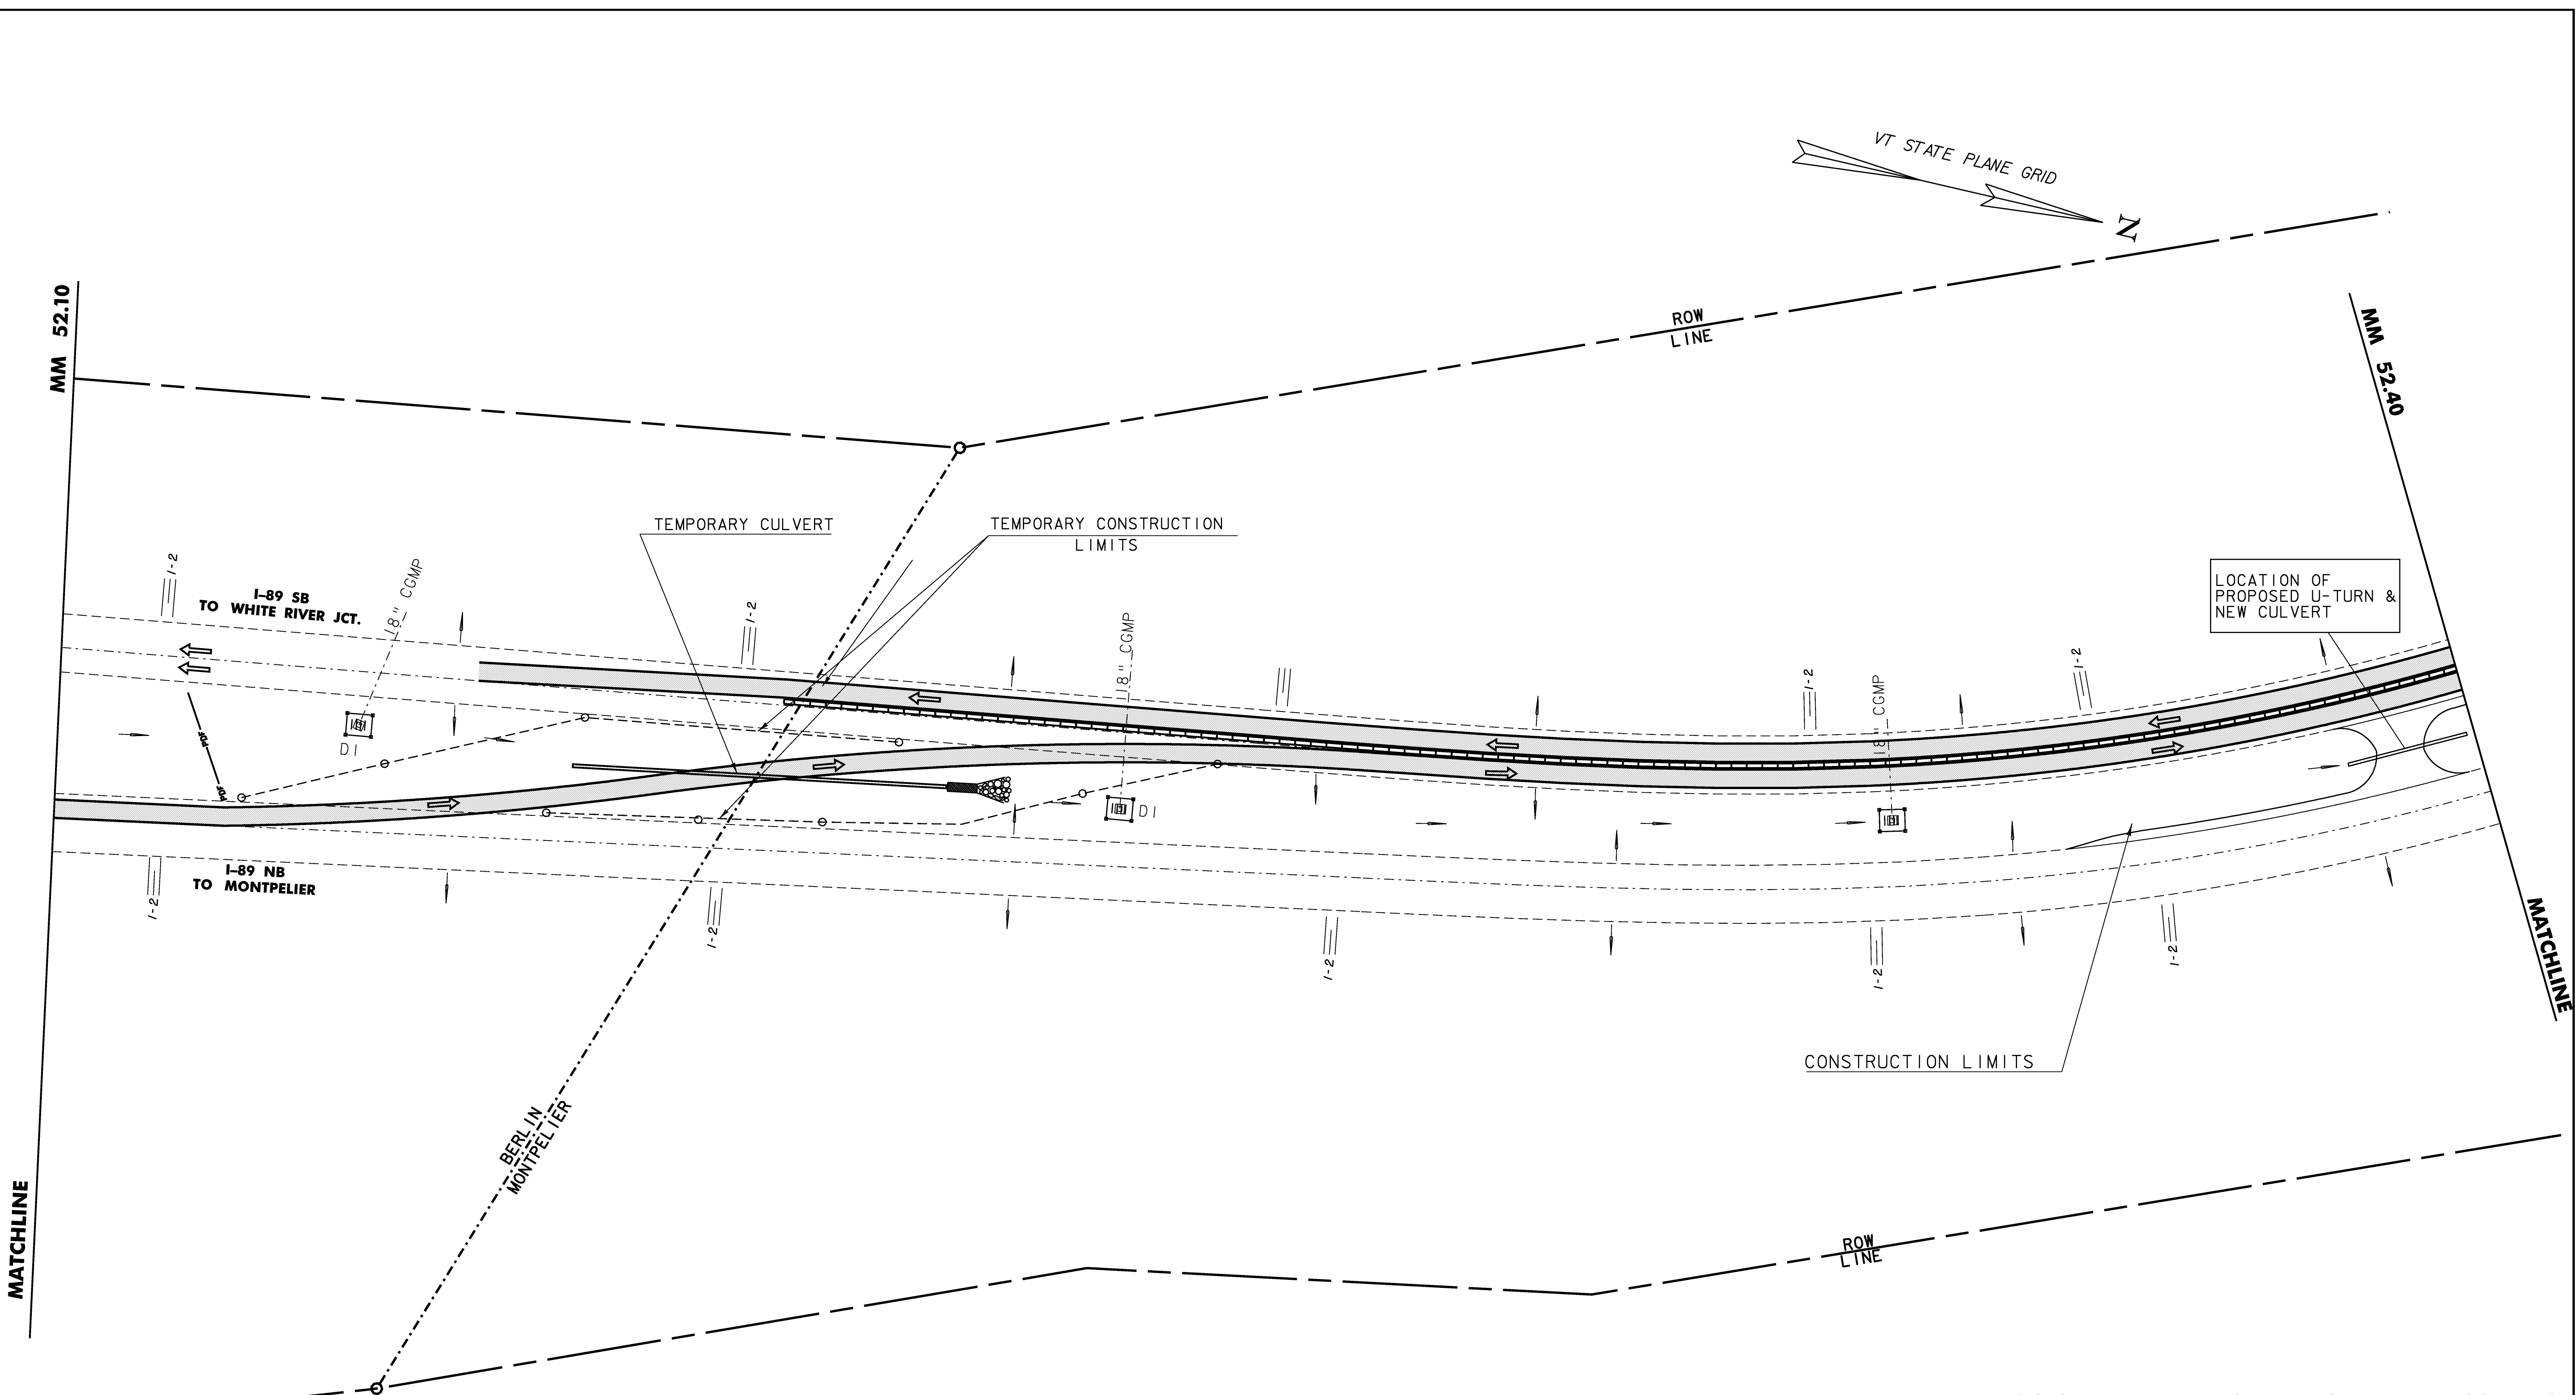


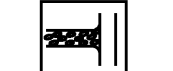





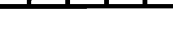
LEGEND			
	DETOUR		RUNOFF FLOW DIRECTION
	EROSION MATTING		TEMPORARY TRAFFIC BARRIER
	INLET PROTECTION DEVICE		RIPRAP OUTLET PROTECTION
	TRAFFIC DIRECTION		
	PROJECT DEMARCATION FENCE		


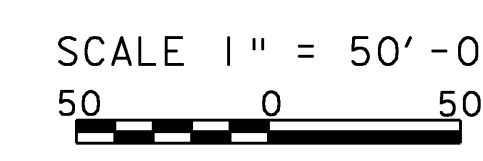
**EROSION PREVENTION & SEDIMENT CONTROL  
BRIDGE 40N CONSTRUCTION - SHEET 1**

PROJECT: BERLIN	PROJECT NO.: IM 089-1 (20)
DESIGN FILE NAME: 99a270\structures\s99a270bdr_ero.dgn	PLOT DATE: 05-DEC-2007
IPARM FILE NAME: s99a270epscri.i	DRAWN BY: M. FESSEL
DESIGNED BY: G. SPILAK	CHECKED BY: K.M. HIGGINS
SQUAD LEADER: C.P. WILLIAMS	SHEET: 70 OF 104
EPSC PLAN NORTHBOUND - 1	



**LEGEND**


	DETOUR
	VEHICLE TRACKING PAD
	INLET PROTECTION DEVICE, TYPE 1
	TRAFFIC DIRECTION
PDF — PDF	PROJECT DEMARCATION FENCE
	RUNOFF FLOW DIRECTION
	RIPRAP OUTLET PROTECTION
	GEOTEXTILE FOR SILT FENCE
	TEMPORARY TRAFFIC BARRIER

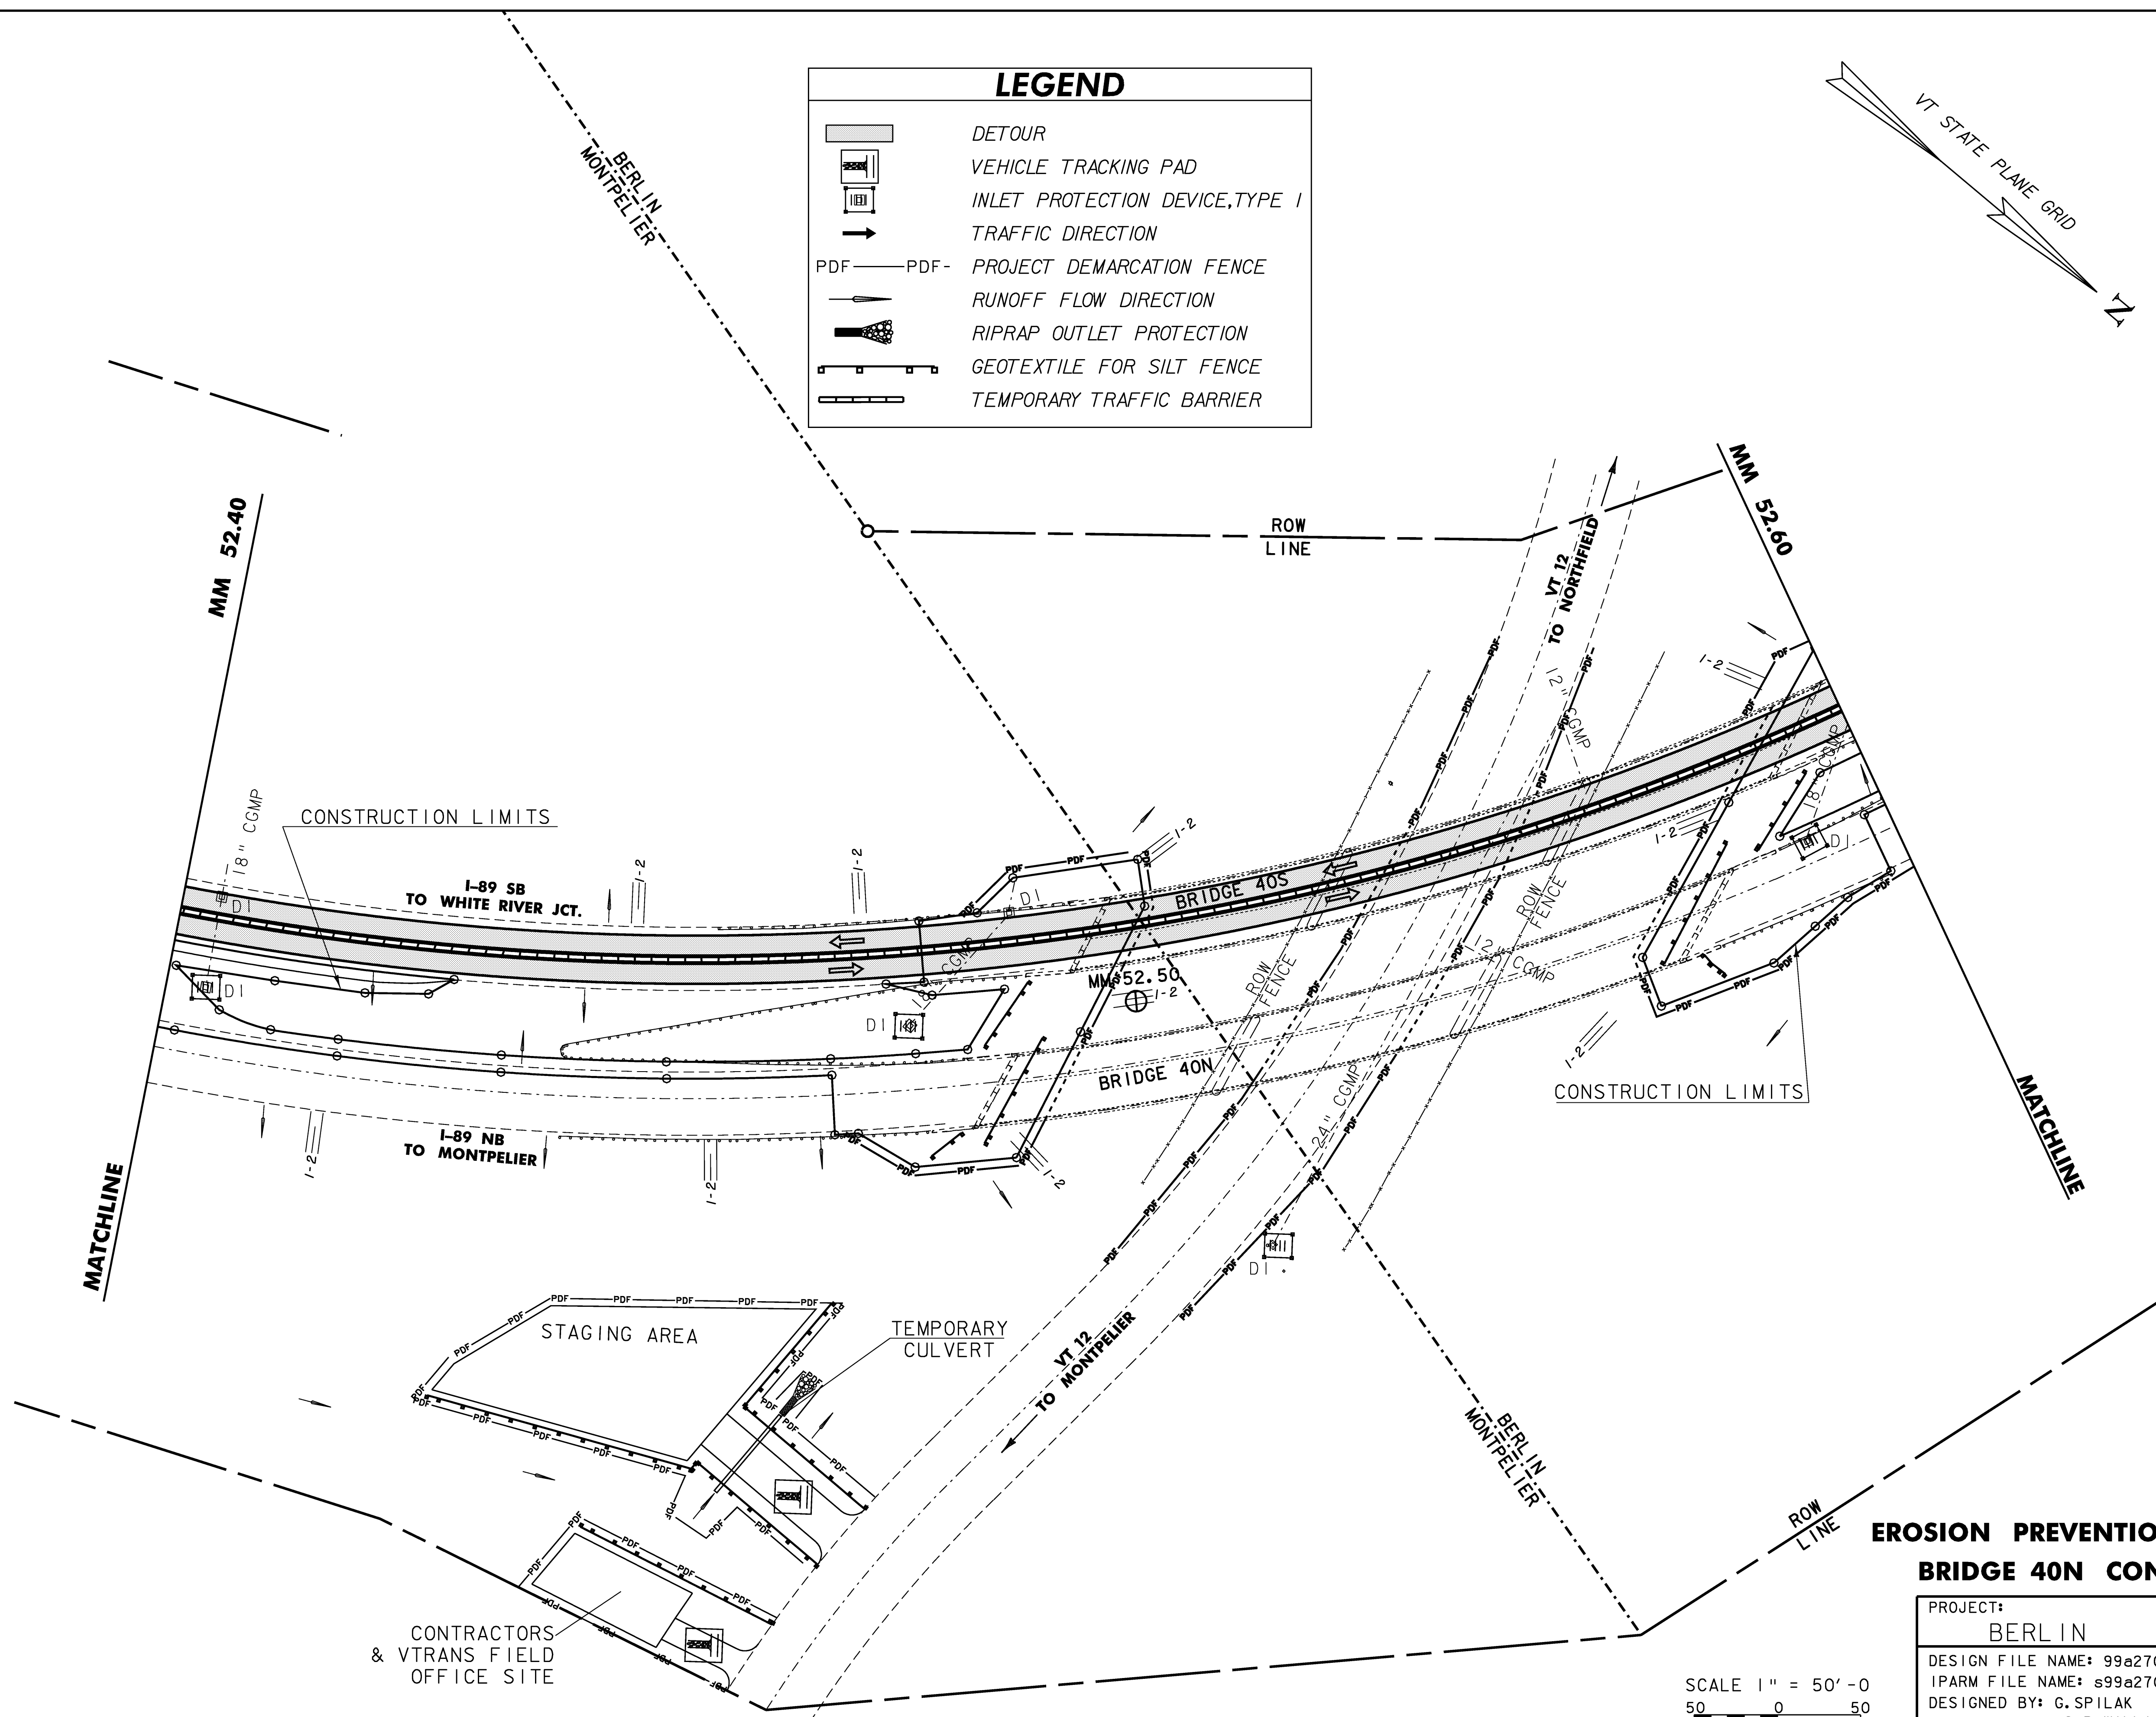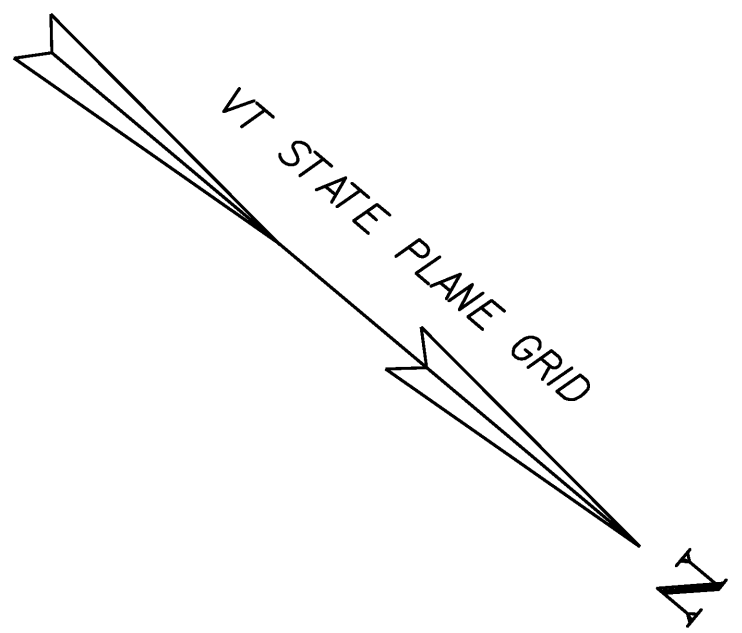

**EROSION PREVENTION & SEDIMENT CONTROL  
BRIDGE 40N CONSTRUCTION - SHEET 2**

PROJECT: BERLIN	PROJECT NO. : IM 089-1 (20)
DESIGN FILE NAME: s99a270\structures\s99a270bdr_ero.dgn	PLOT DATE: 05-DEC-2007
IPARM FILE NAME: s99a270epsrnb2.i	DRAWN BY: M.FESSEL
DESIGNED BY: G.SPILAK	CHECKED BY: K.M.HIGGINS
SQUAD LEADER: C.P.WILLIAMS	SHEET: 71 OF 104
EPSC PLAN NORTHBOUND - 2	

SCALE 1" = 50'-0"  
50 0 50

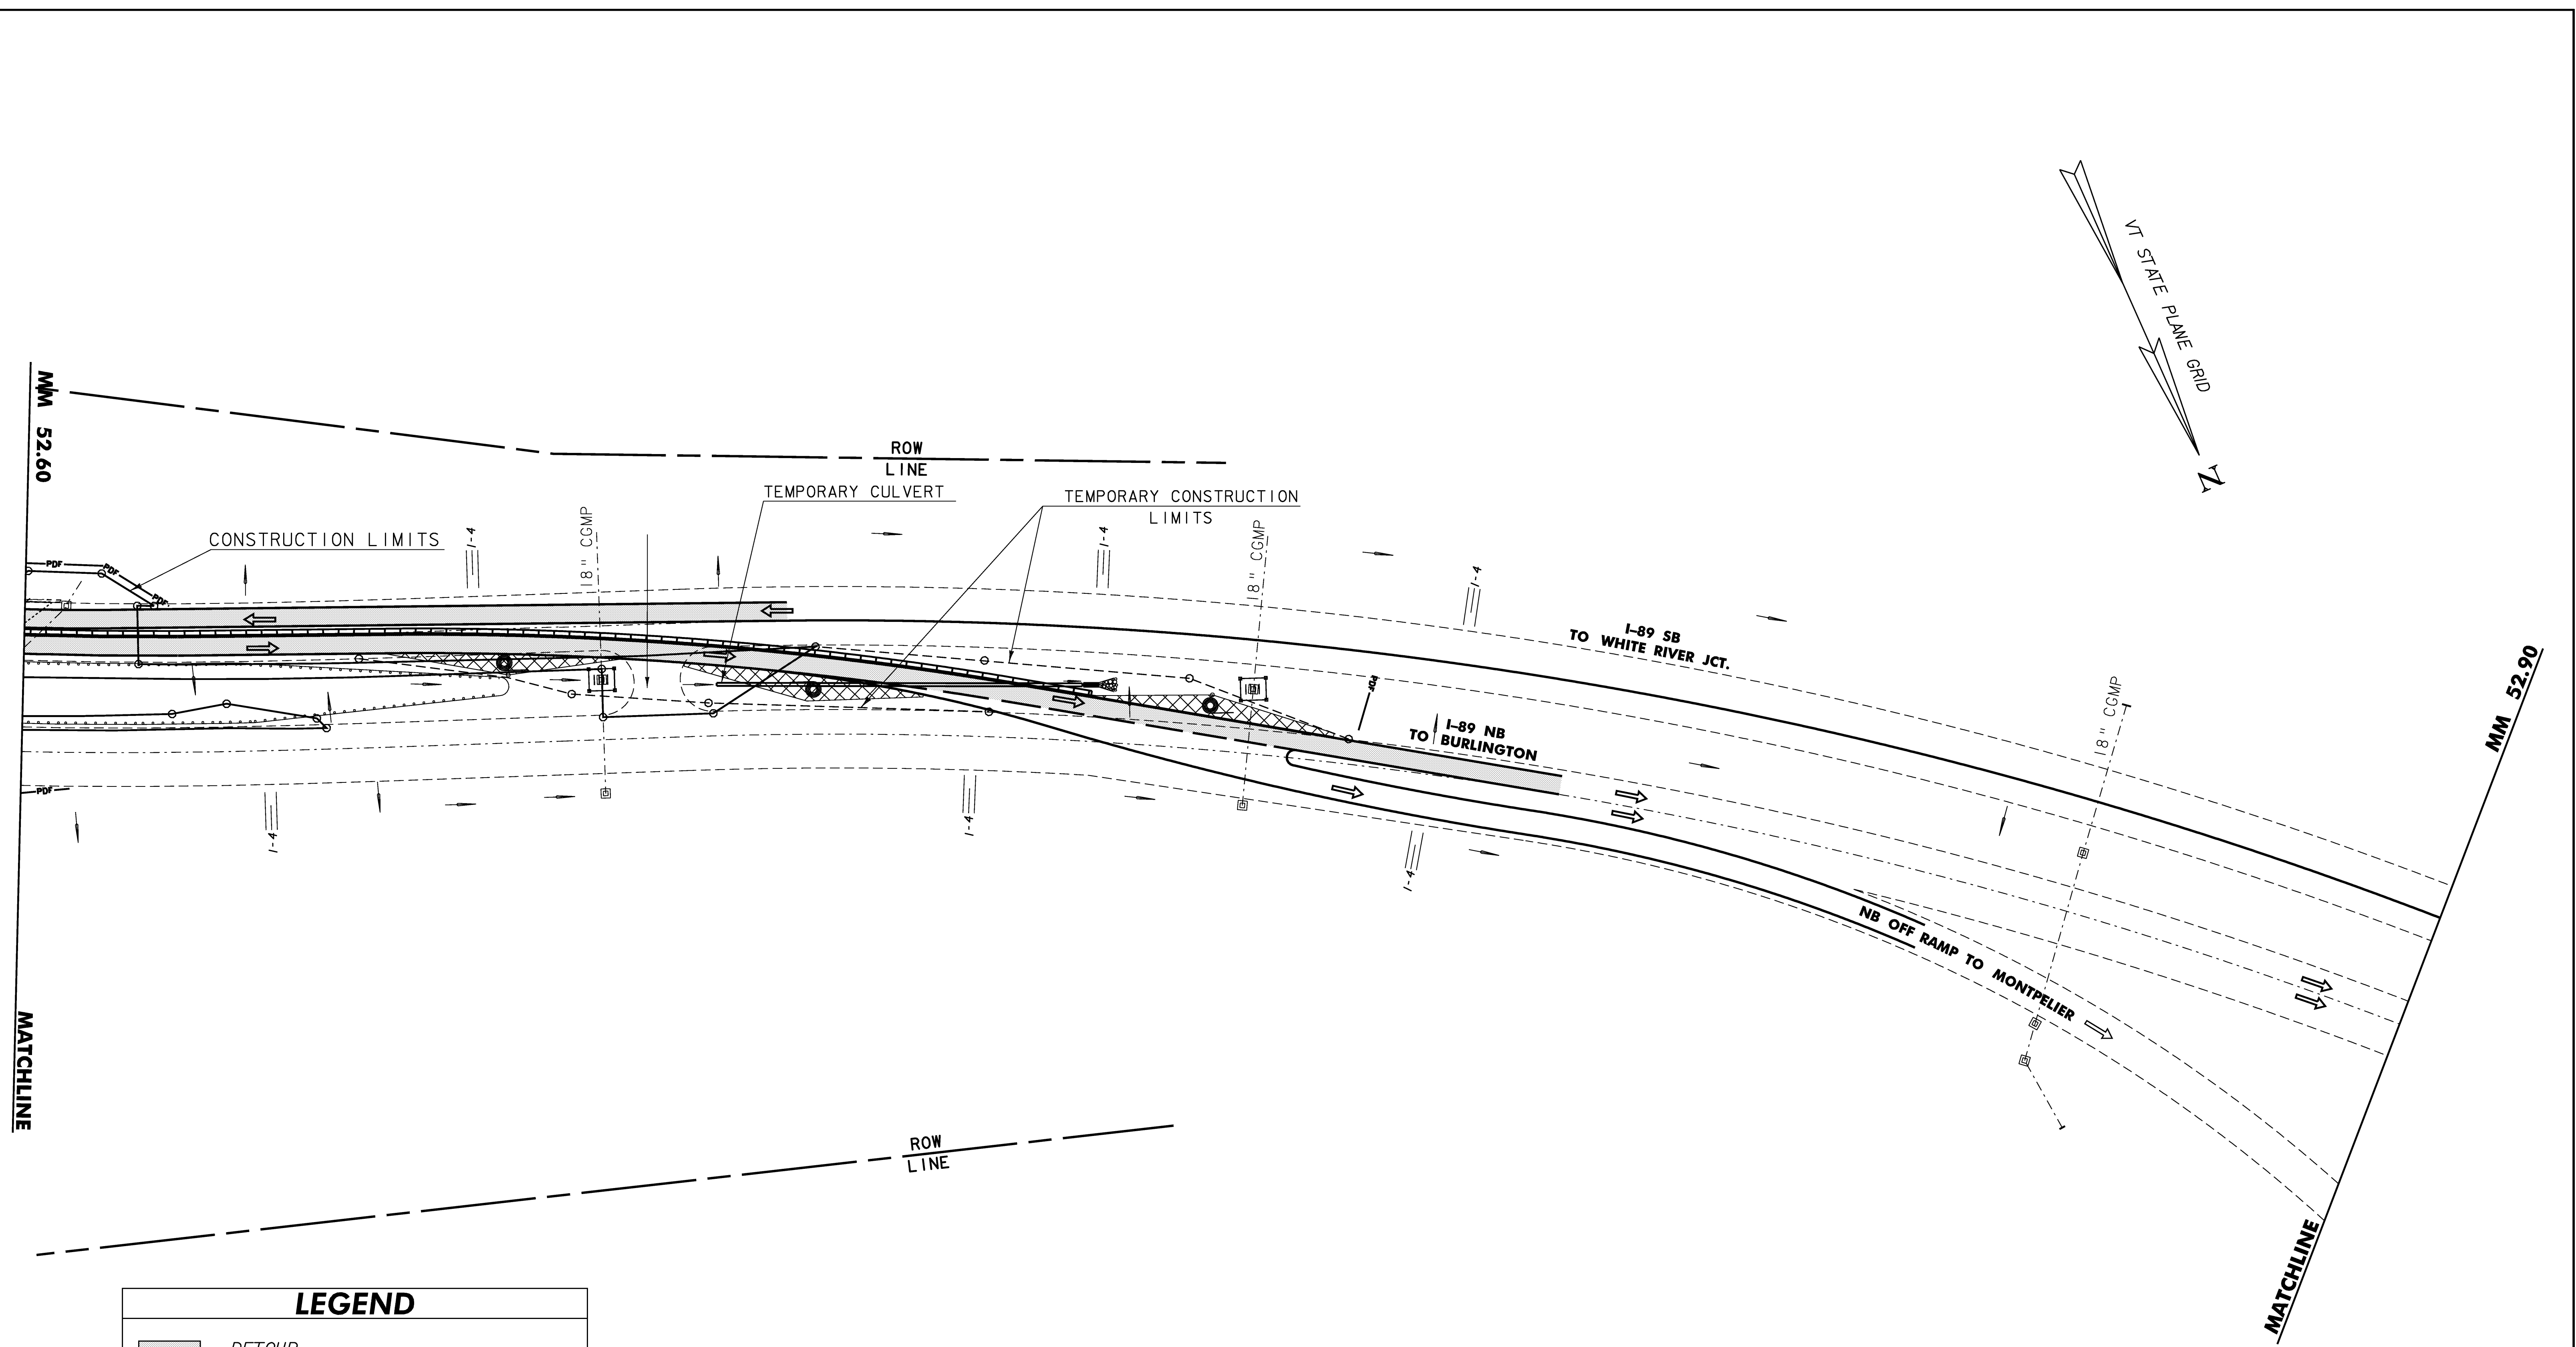


LEGEND	
	DETOUR
	EROSION MATTING
	INLET PROTECTION DEVICE, TYPE I
	TRAFFIC DIRECTION
	PROJECT DEMARCATION FENCE
	RUNOFF FLOW DIRECTION
	RIPRAP OUTLET PROTECTION
	TEMPORARY TRAFFIC BARRIER

SCALE 1" = 50'-0"  
 50 0 50

**EROSION PREVENTION & SEDIMENT CONTROL  
 BRIDGE 40N CONSTRUCTION - SHEET 3**


PROJECT: BERLIN	PROJECT NO.: IM 089-1 (20)
DESIGN FILE NAME: 99a270\structures\s99a270bdr_ero.dgn	PLOT DATE: 05-DEC-2007
IPARM FILE NAME: s99a270epscnb3.i	DRAWN BY: M. FESSEL
DESIGNED BY: G. SPILAK	CHECKED BY: K. M. HIGGINS
SQUAD LEADER: C. P. WILLIAMS	SHEET: 72 OF 104
EPSC PLAN NORTHBOUND - 3	

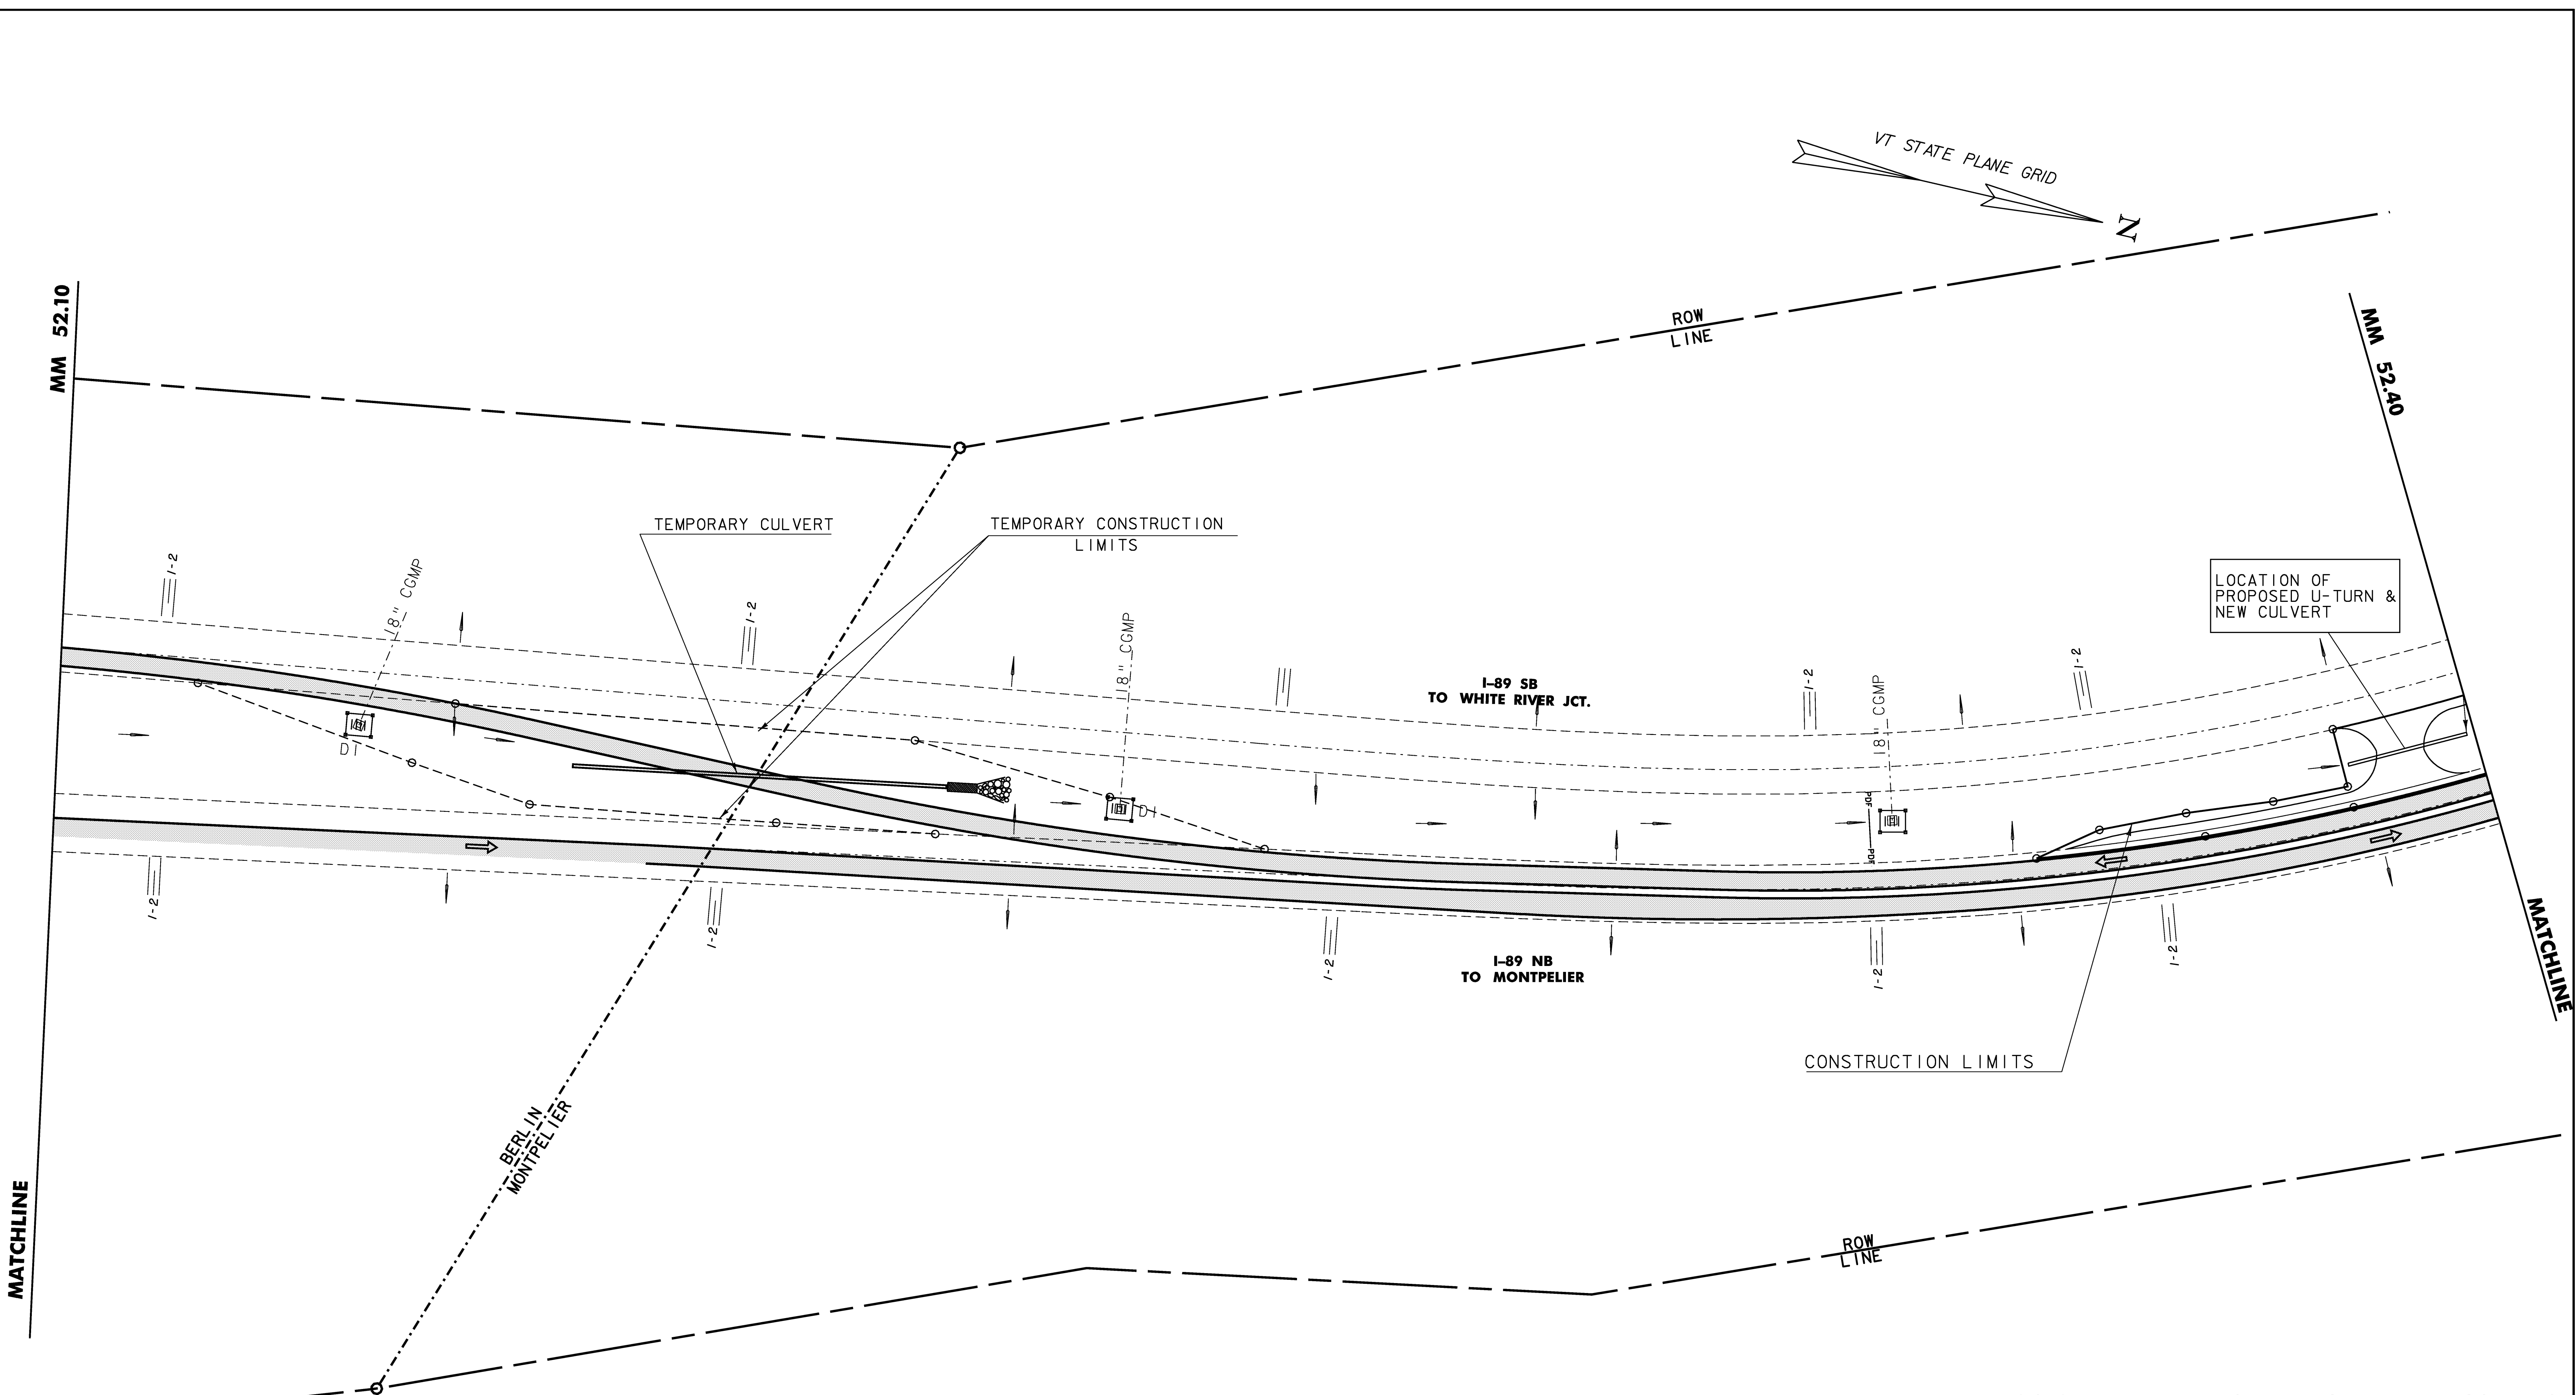


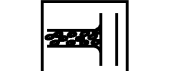





 
LEGEND			
	DETOUR		RUNOFF FLOW DIRECTION
	EROSION MATTING		TEMPORARY TRAFFIC BARRIER
	INLET PROTECTION DEVICE		RIPRAP OUTLET PROTECTION
	TRAFFIC DIRECTION		
	PROJECT DEMARCATION FENCE		


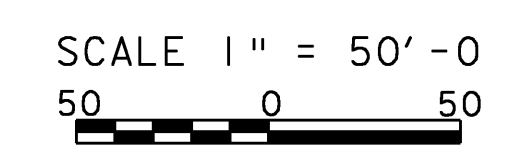
**EROSION PREVENTION & SEDIMENT CONTROL  
BRIDGE 405 CONSTRUCTION - SHEET 1**

PROJECT: BERLIN	PROJECT NO.: IM 089-1 (20)
DESIGN FILE NAME: 99a270\structures\99a270bdr_ero.dgn	PLOT DATE: 05-DEC-2007
IPARM FILE NAME: s99a270epscl.i	DRAWN BY: M. FESSEL
DESIGNED BY: G. SPILAK	CHECKED BY: K. M. HIGGINS
SQUAD LEADER: C. P. WILLIAMS	SHEET: 73 OF 104
EPSC PLAN SOUTHBOUND - 1	



**LEGEND**



	DETOUR
	VEHICLE TRACKING PAD
	INLET PROTECTION DEVICE, TYPE I
	TRAFFIC DIRECTION
PDF — PDF	PROJECT DEMARCATION FENCE
	RUNOFF FLOW DIRECTION
	RIPRAP OUTLET PROTECTION
	GEOTEXTILE FOR SILT FENCE
	TEMPORARY TRAFFIC BARRIER

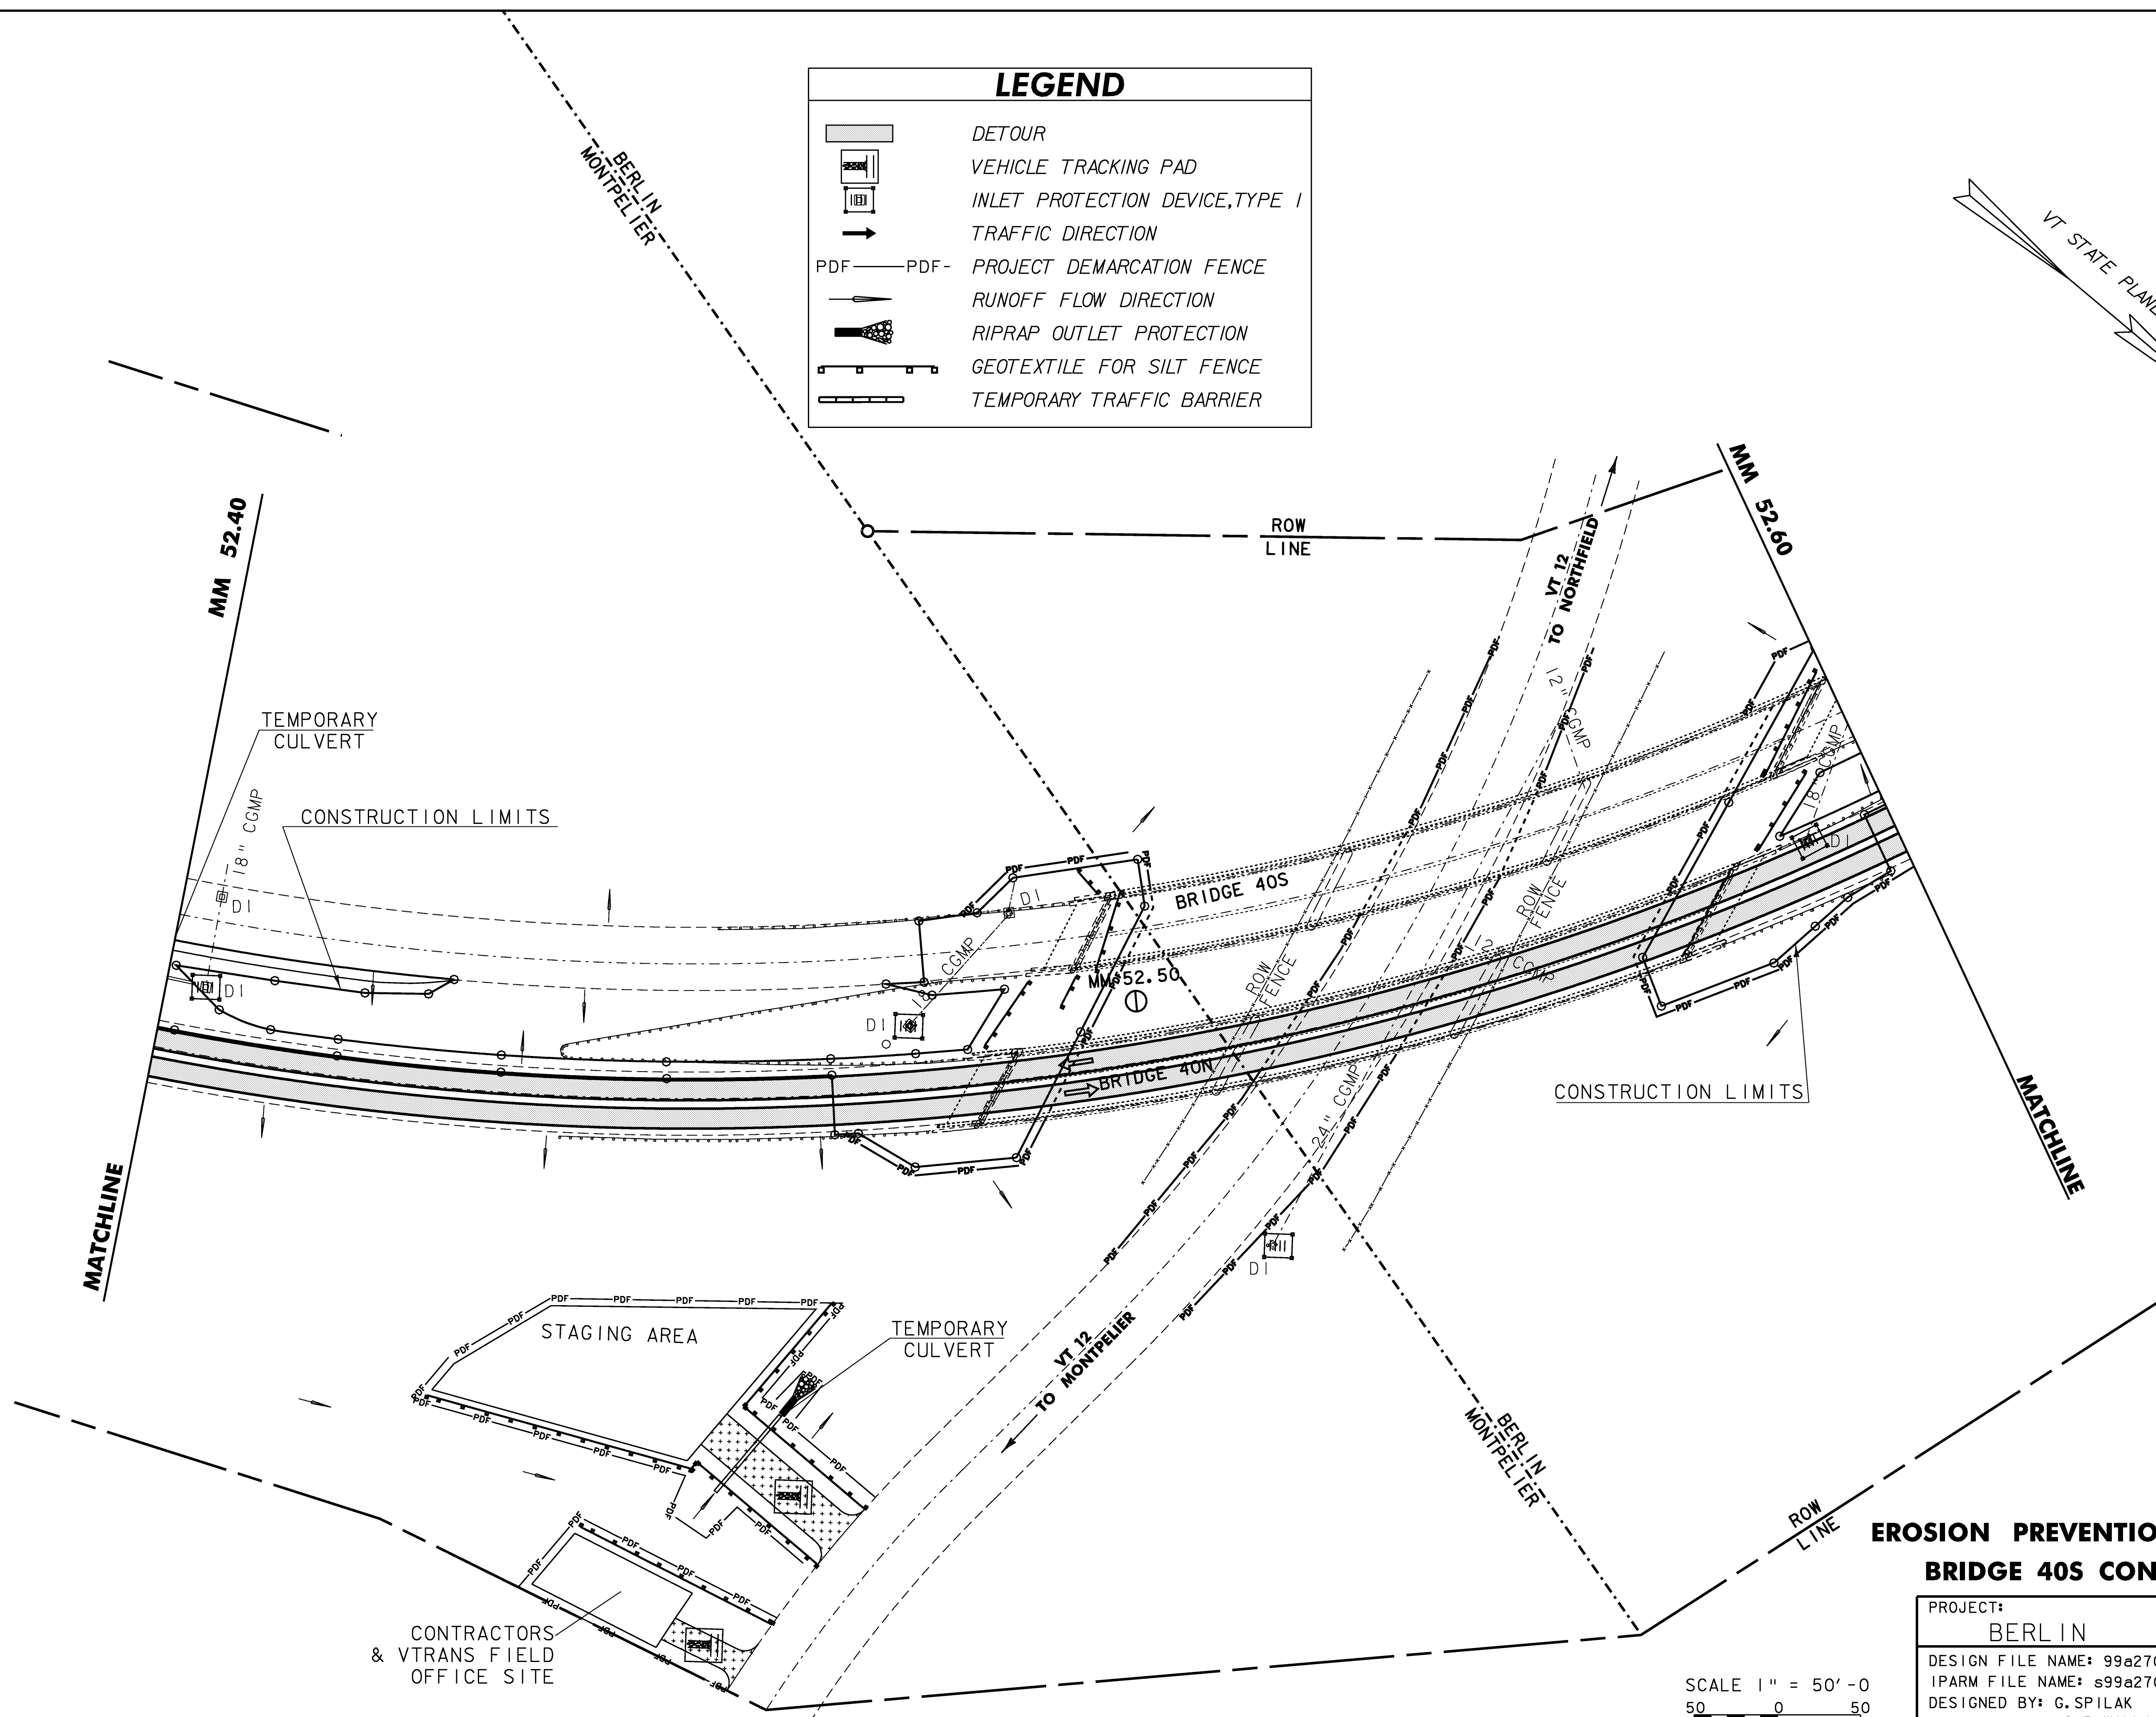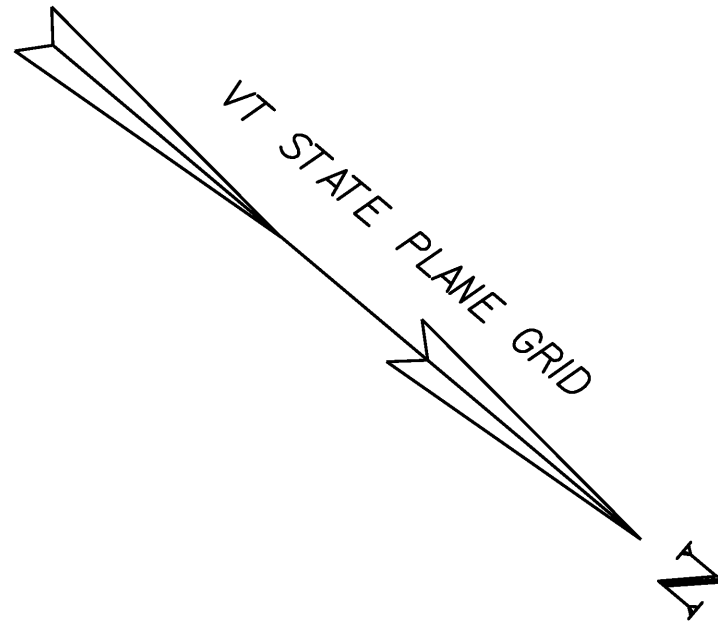

**EROSION PREVENTION & SEDIMENT CONTROL  
BRIDGE 40S CONSTRUCTION - SHEET 2**

PROJECT: BERLIN	PROJECT NO.: IM 089-1 (20)
DESIGN FILE NAME: s99a270\structures\s99a270bdr_ero.dgn	PLOT DATE: 05-DEC-2007
IPARM FILE NAME: s99a270epsusb2.i	DRAWN BY: M. FESSEL
DESIGNED BY: G. SPILAK	CHECKED BY: K. M. HIGGINS
SQUAD LEADER: C. P. WILLIAMS	SHEET: 74 OF 104
EPSC PLAN SOUTHBOUND - 2	

SCALE 1" = 50'-0"  
50 0 50

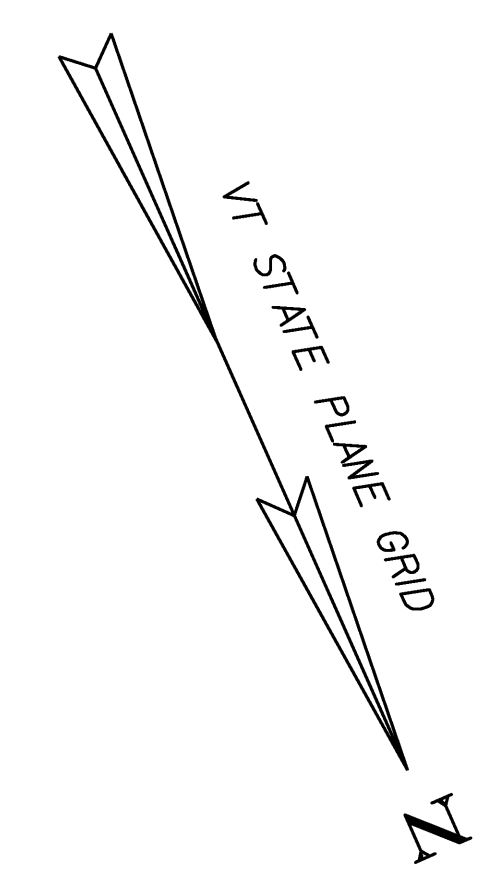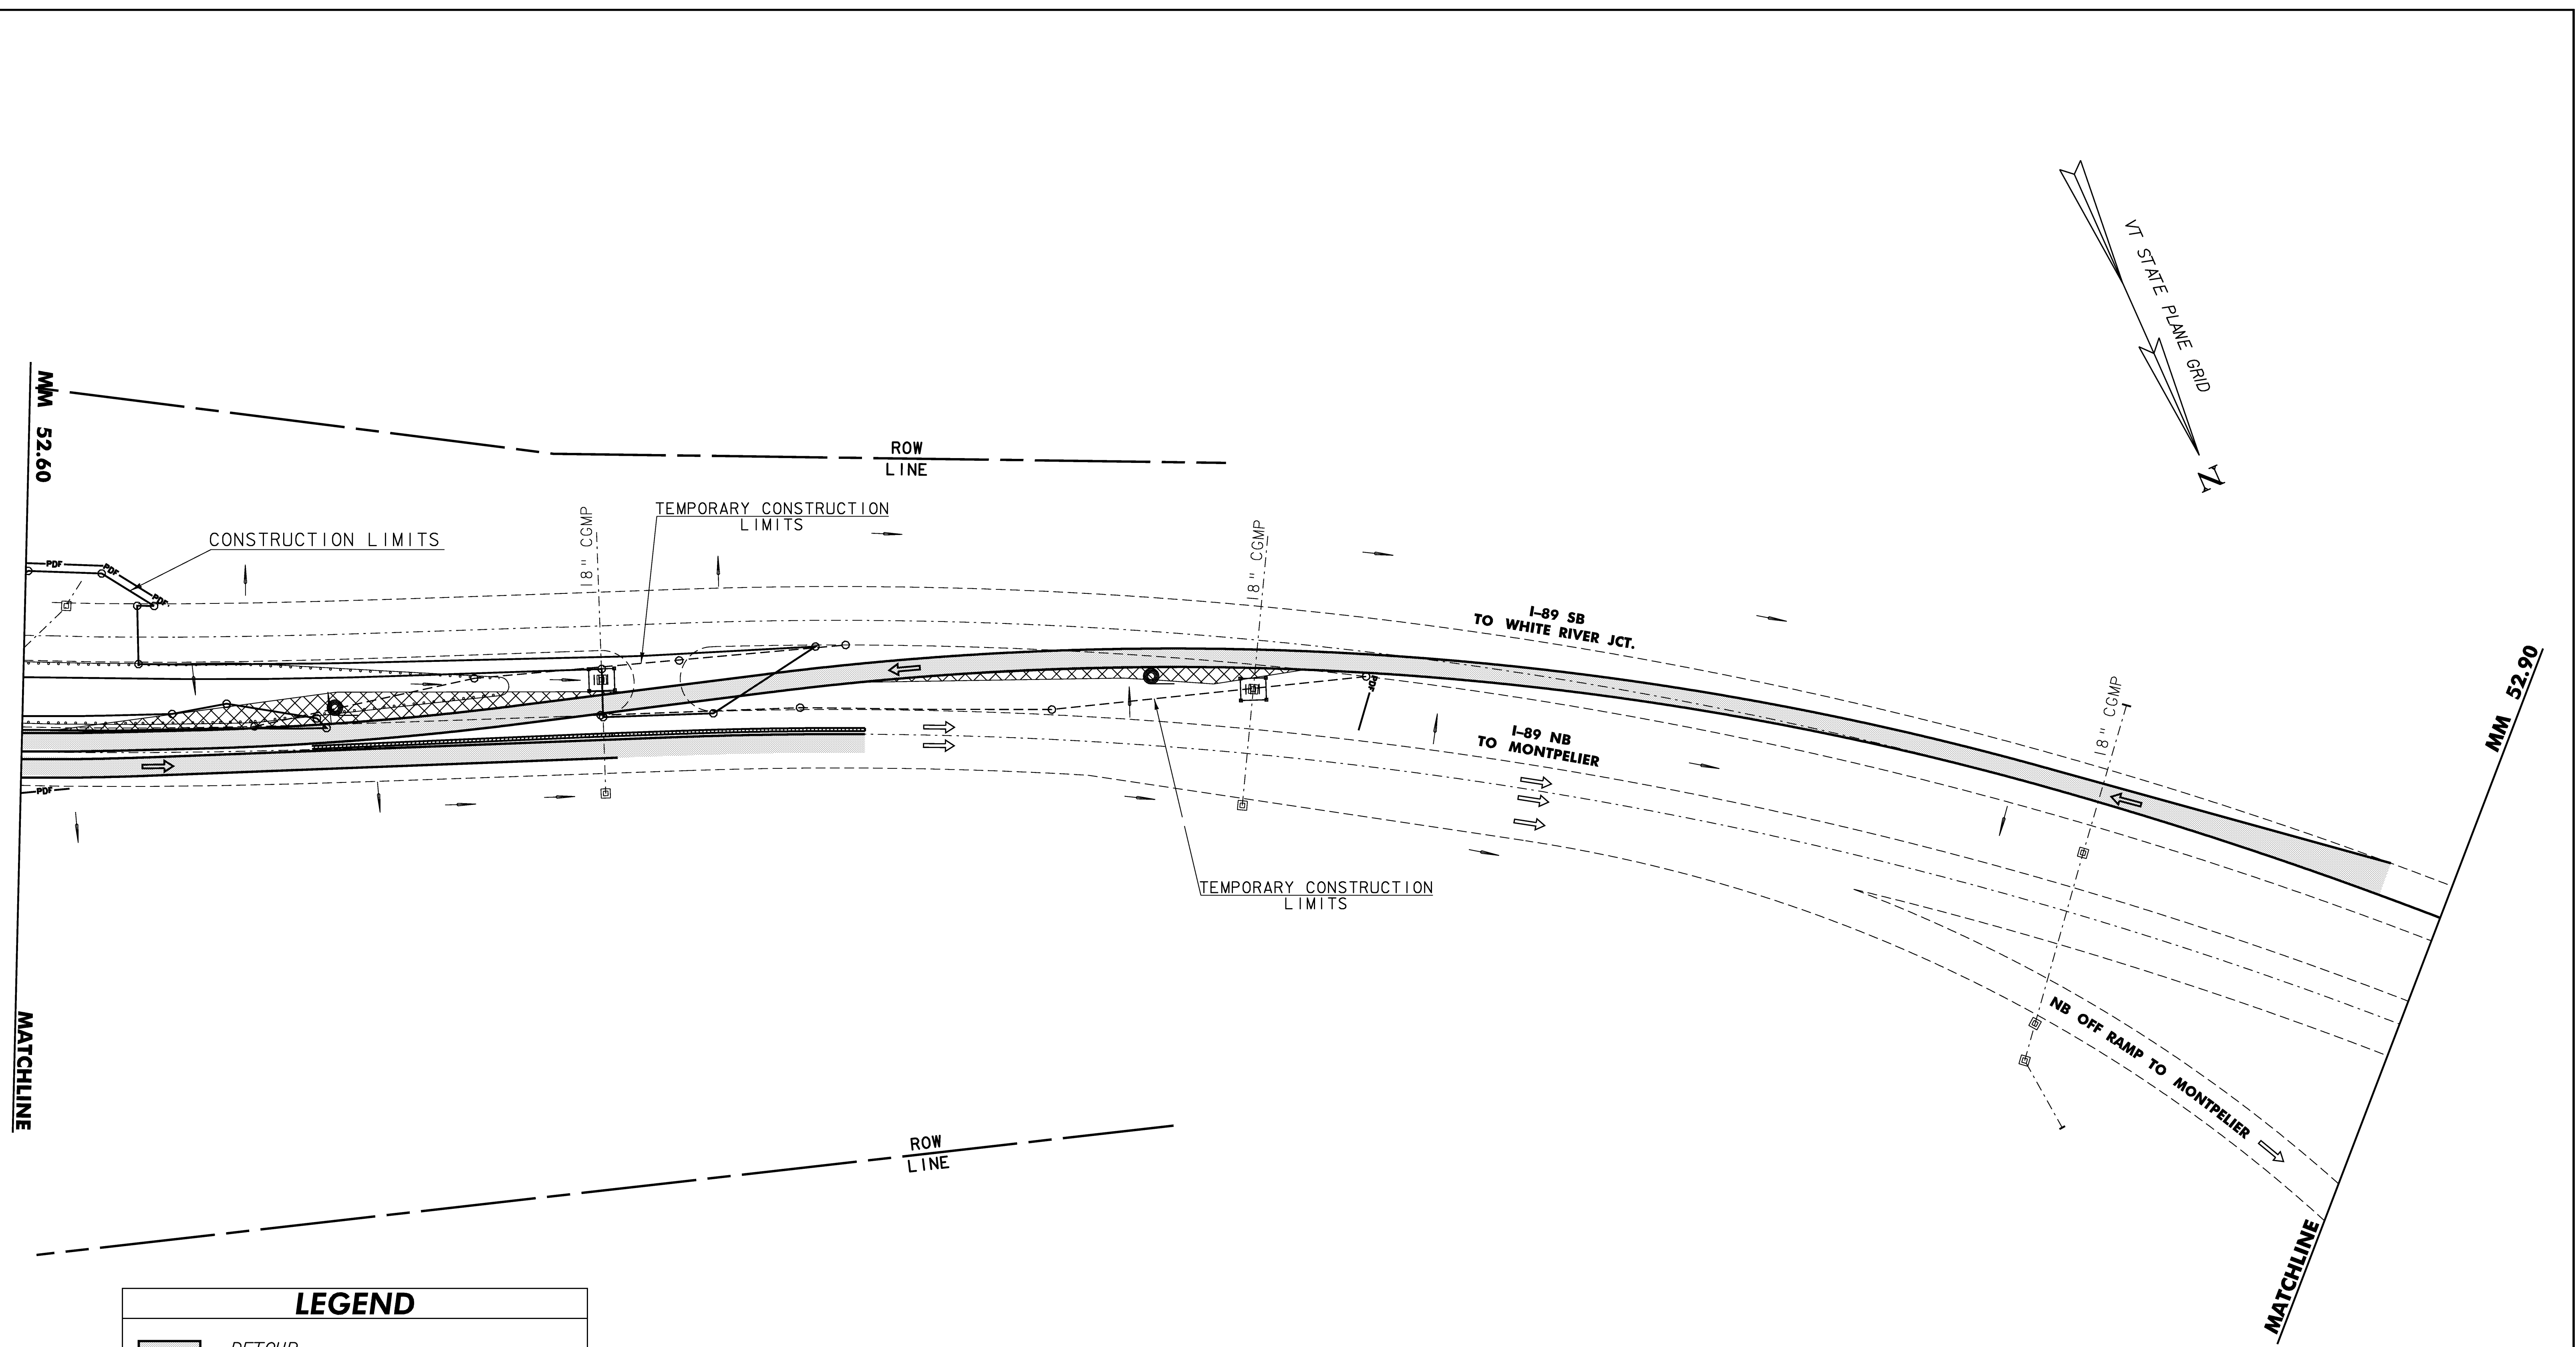

MM 52.60  
MATCHLINE


MM 52.90  
MATCHLINE

LEGEND	
	DETOUR
	EROSION MATTING
	INLET PROTECTION DEVICE, TYPE I
	TRAFFIC DIRECTION
	PROJECT DEMARCATION FENCE
	RUNOFF FLOW DIRECTION
	RIPRAP OUTLET PROTECTION
	TEMPORARY TRAFFIC BARRIER

SCALE 1" = 50'-0"  
50 0 50

**EROSION PREVENTION & SEDIMENT CONTROL  
BRIDGE 405 CONSTRUCTION - SHEET 3**

PROJECT: BERLIN	PROJECT NO.: IM 089-1 (20)
DESIGN FILE NAME: s99a270\structures\s99a270bdr_ero.dgn	PLOT DATE: 05-DEC-2007
IPARM FILE NAME: s99a270epsccb3.i	DRAWN BY: M. FESSEL
DESIGNED BY: G. SPILAK	CHECKED BY: K. M. HIGGINS
SQUAD LEADER: C. P. WILLIAMS	SHEET: 75 OF 104
EPSC PLAN SOUTHBOUND - 3	

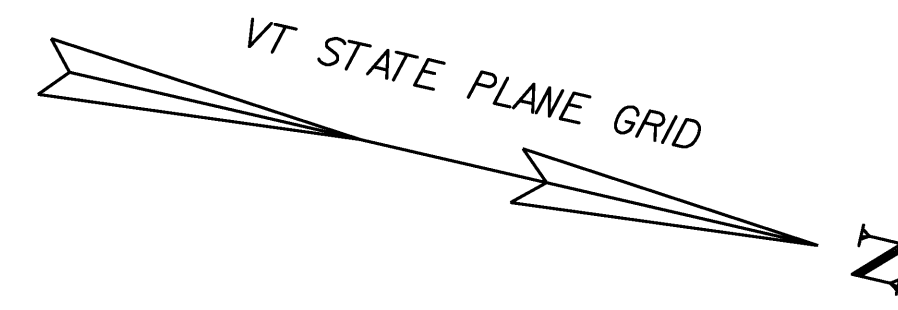

MM 52.10

MM 52.40

ROW LINE

MATCHLINE

MATCHLINE

BERLIN  
MONTPELIER

I-89 SB  
TO WHITE RIVER JCT.

I-89 NB  
TO MONTPELIER

LOCATION OF  
PROPOSED U-TURN &  
NEW CULVERT




18" CGMP  
DI

18" CGMP  
DI

18" CGMP

ROW LINE



**LEGEND**

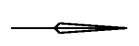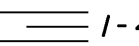-  RUNOFF FLOW DIRECTION
-  SLOPE GRADE
-  SEED AND MULCH

SCALE 1" = 50'-0"  
50 0 50

**EPSC FINAL CONDITIONS  
SITE PLAN SHEET 1**

PROJECT: BERLIN	PROJECT NO.: IM 089-1 (20)
DESIGN FILE NAME: 99a270\structures\s99a270bdr_ero.dgn	PLOT DATE: 05-DEC-2007
IPARM FILE NAME: s99a270finconl.i	DRAWN BY: M.FESSEL
DESIGNED BY: G.SPILAK	CHECKED BY: K.M.HIGGINS
SQUAD LEADER: C.P.WILLIAMS	SHEET: 76 OF 104
EPSC FINAL CONDITIONS - 1	

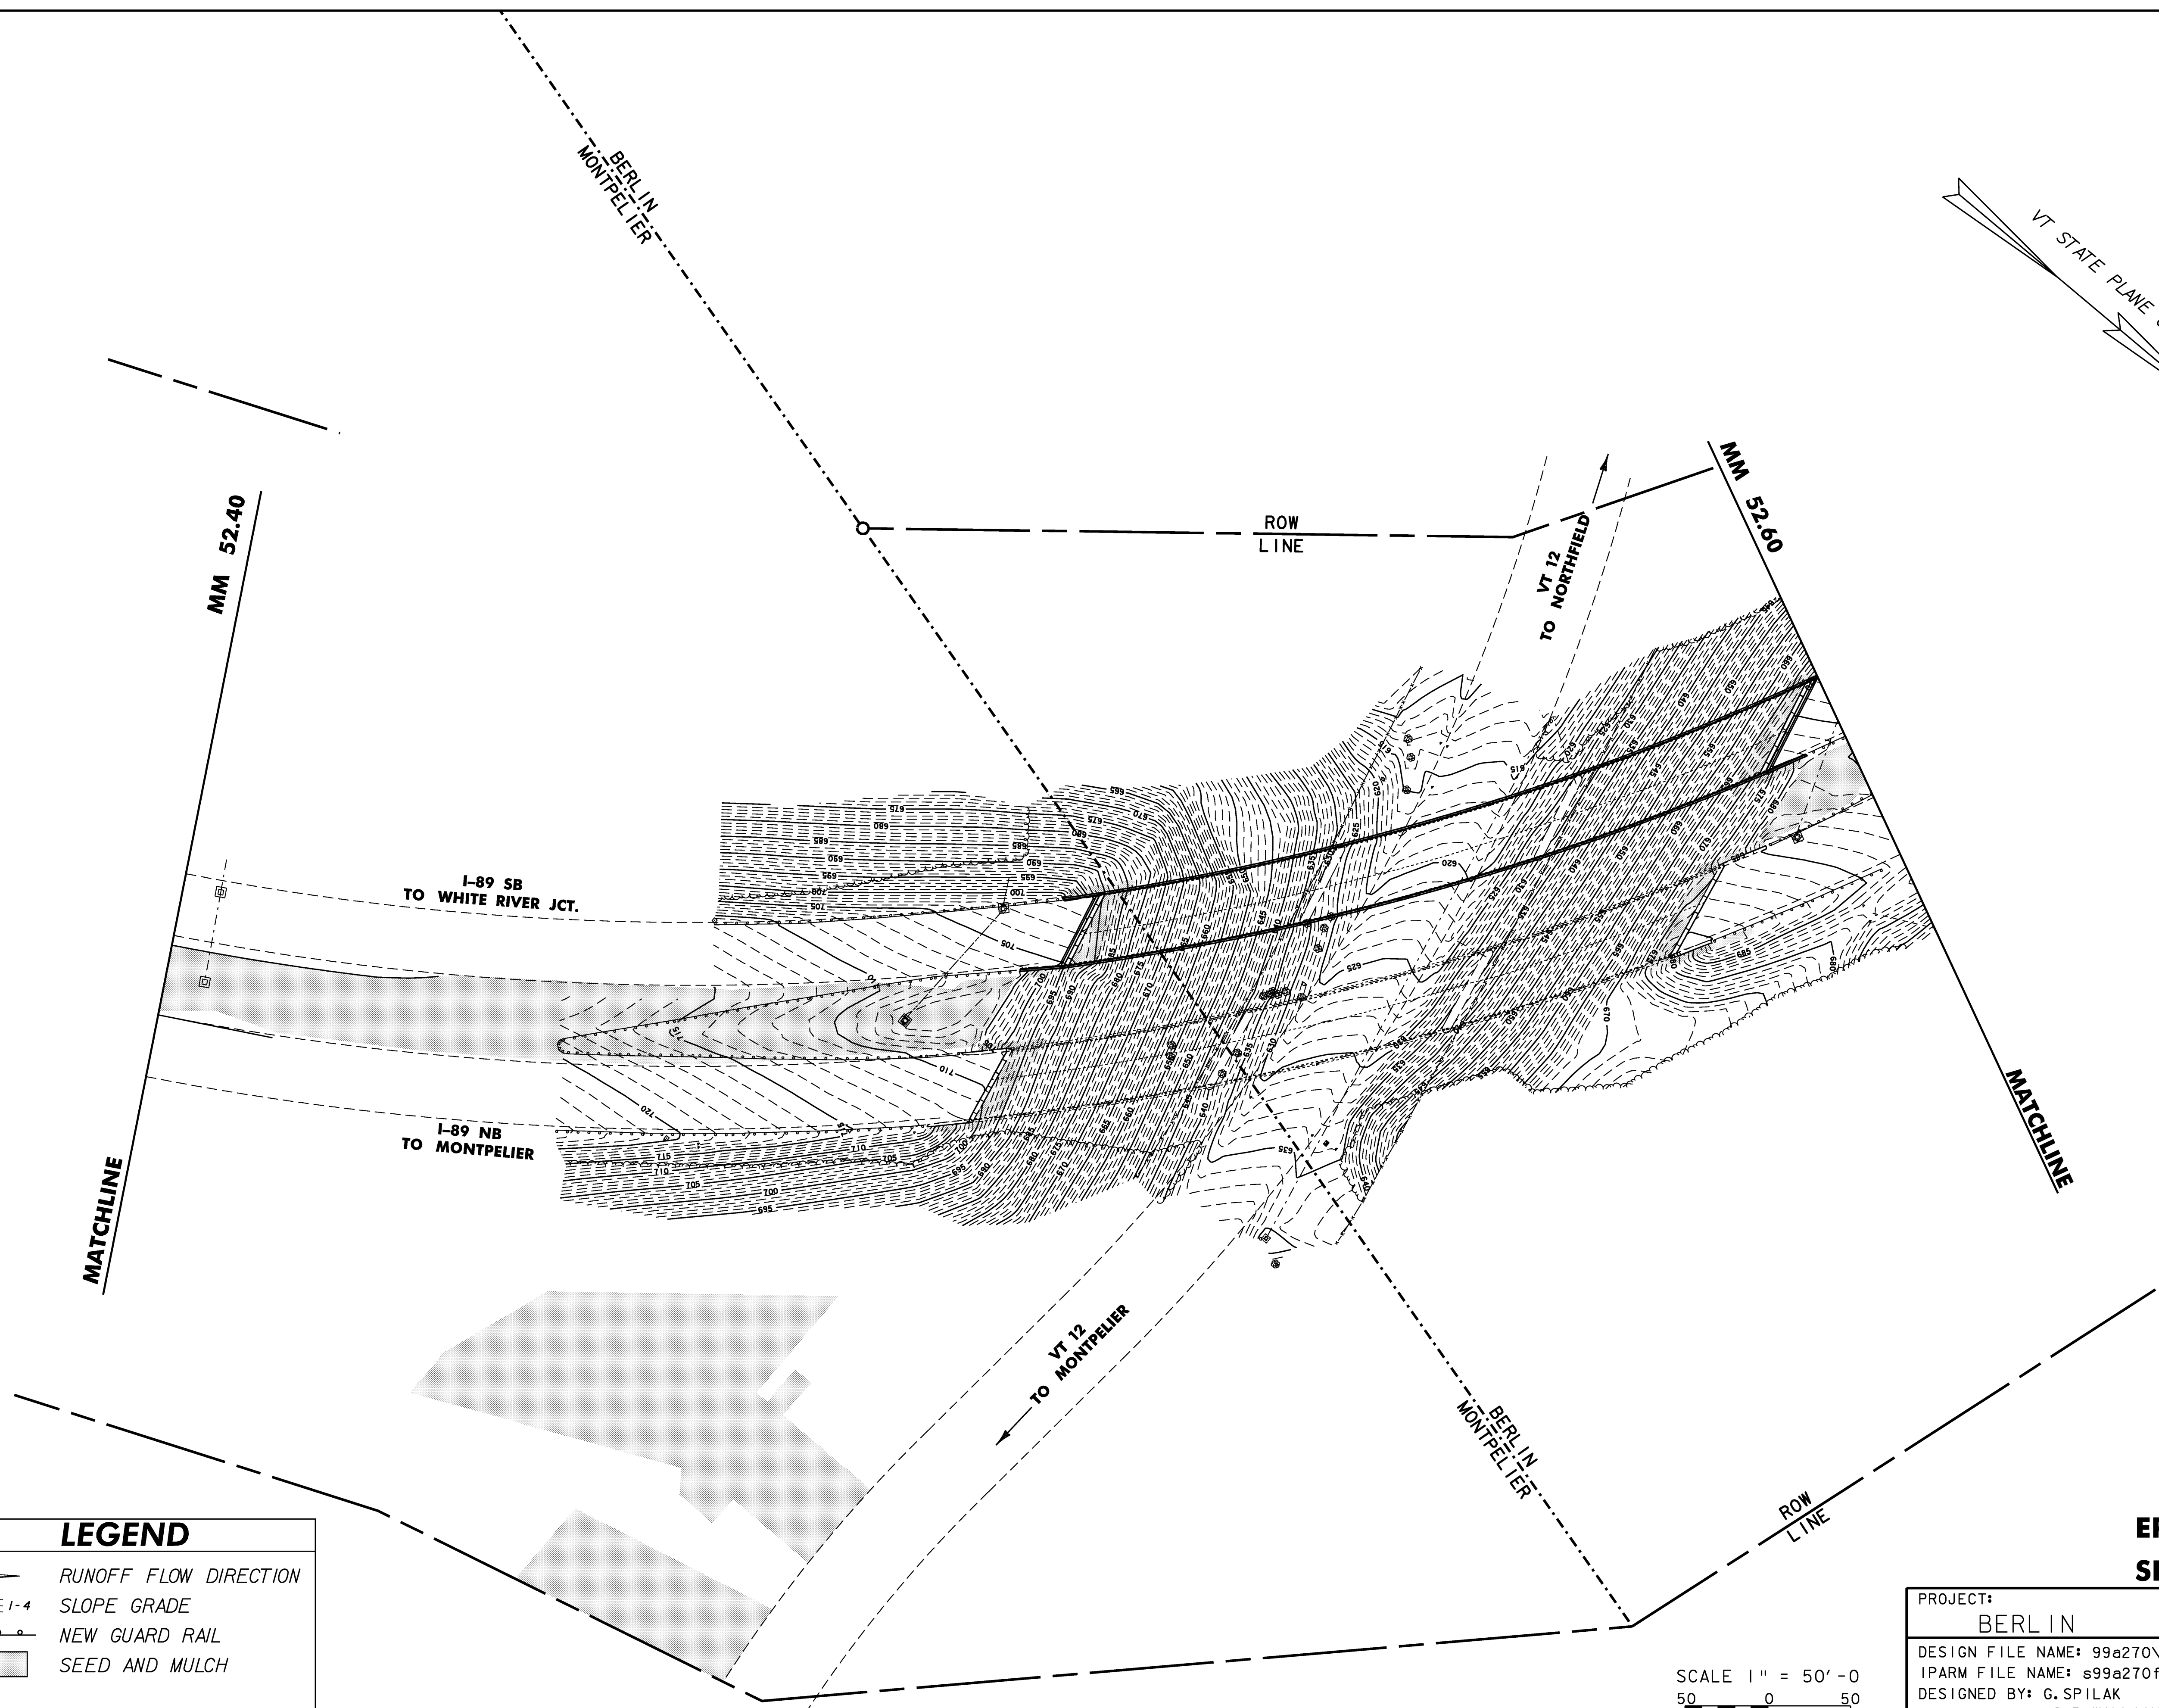
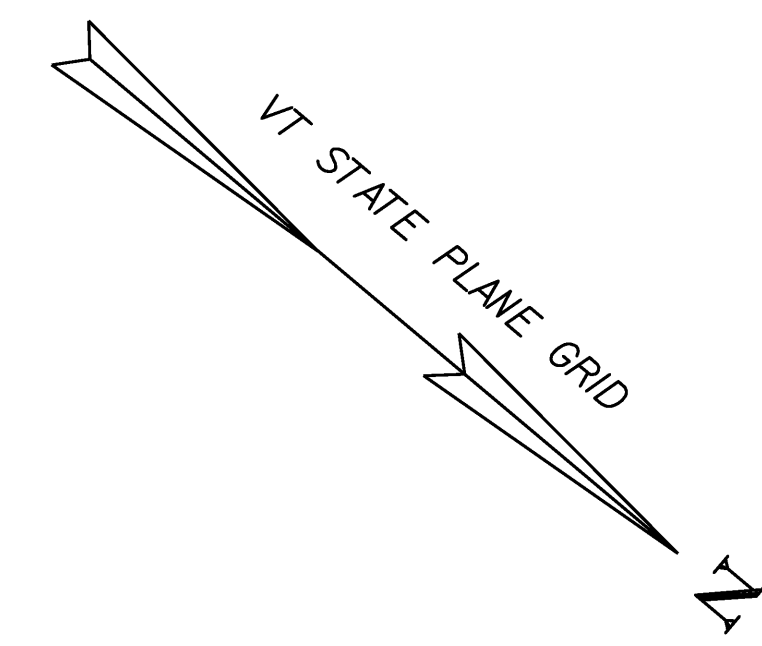


LEGEND	
	RUNOFF FLOW DIRECTION
	1-4 SLOPE GRADE
	NEW GUARD RAIL
	SEED AND MULCH

SCALE 1" = 50'-0"  
 50 0 50

**EPSC FINAL CONDITIONS  
 SITE PLAN SHEET 2**

PROJECT: BERLIN	PROJECT NO.: IM 089-1 (20)
DESIGN FILE NAME: s99a270\structures\s99a270bdr_ero.dgn	PLOT DATE: 05-DEC-2007
IPARM FILE NAME: s99a270\fincon2.i	DRAWN BY: M.FESSEL
DESIGNED BY: G.SPILAK	CHECKED BY: K.M.HIGGINS
SQUAD LEADER: C.P.WILLIAMS	SHEET: 77 OF 104
EPSC FINAL CONDITIONS - 2	

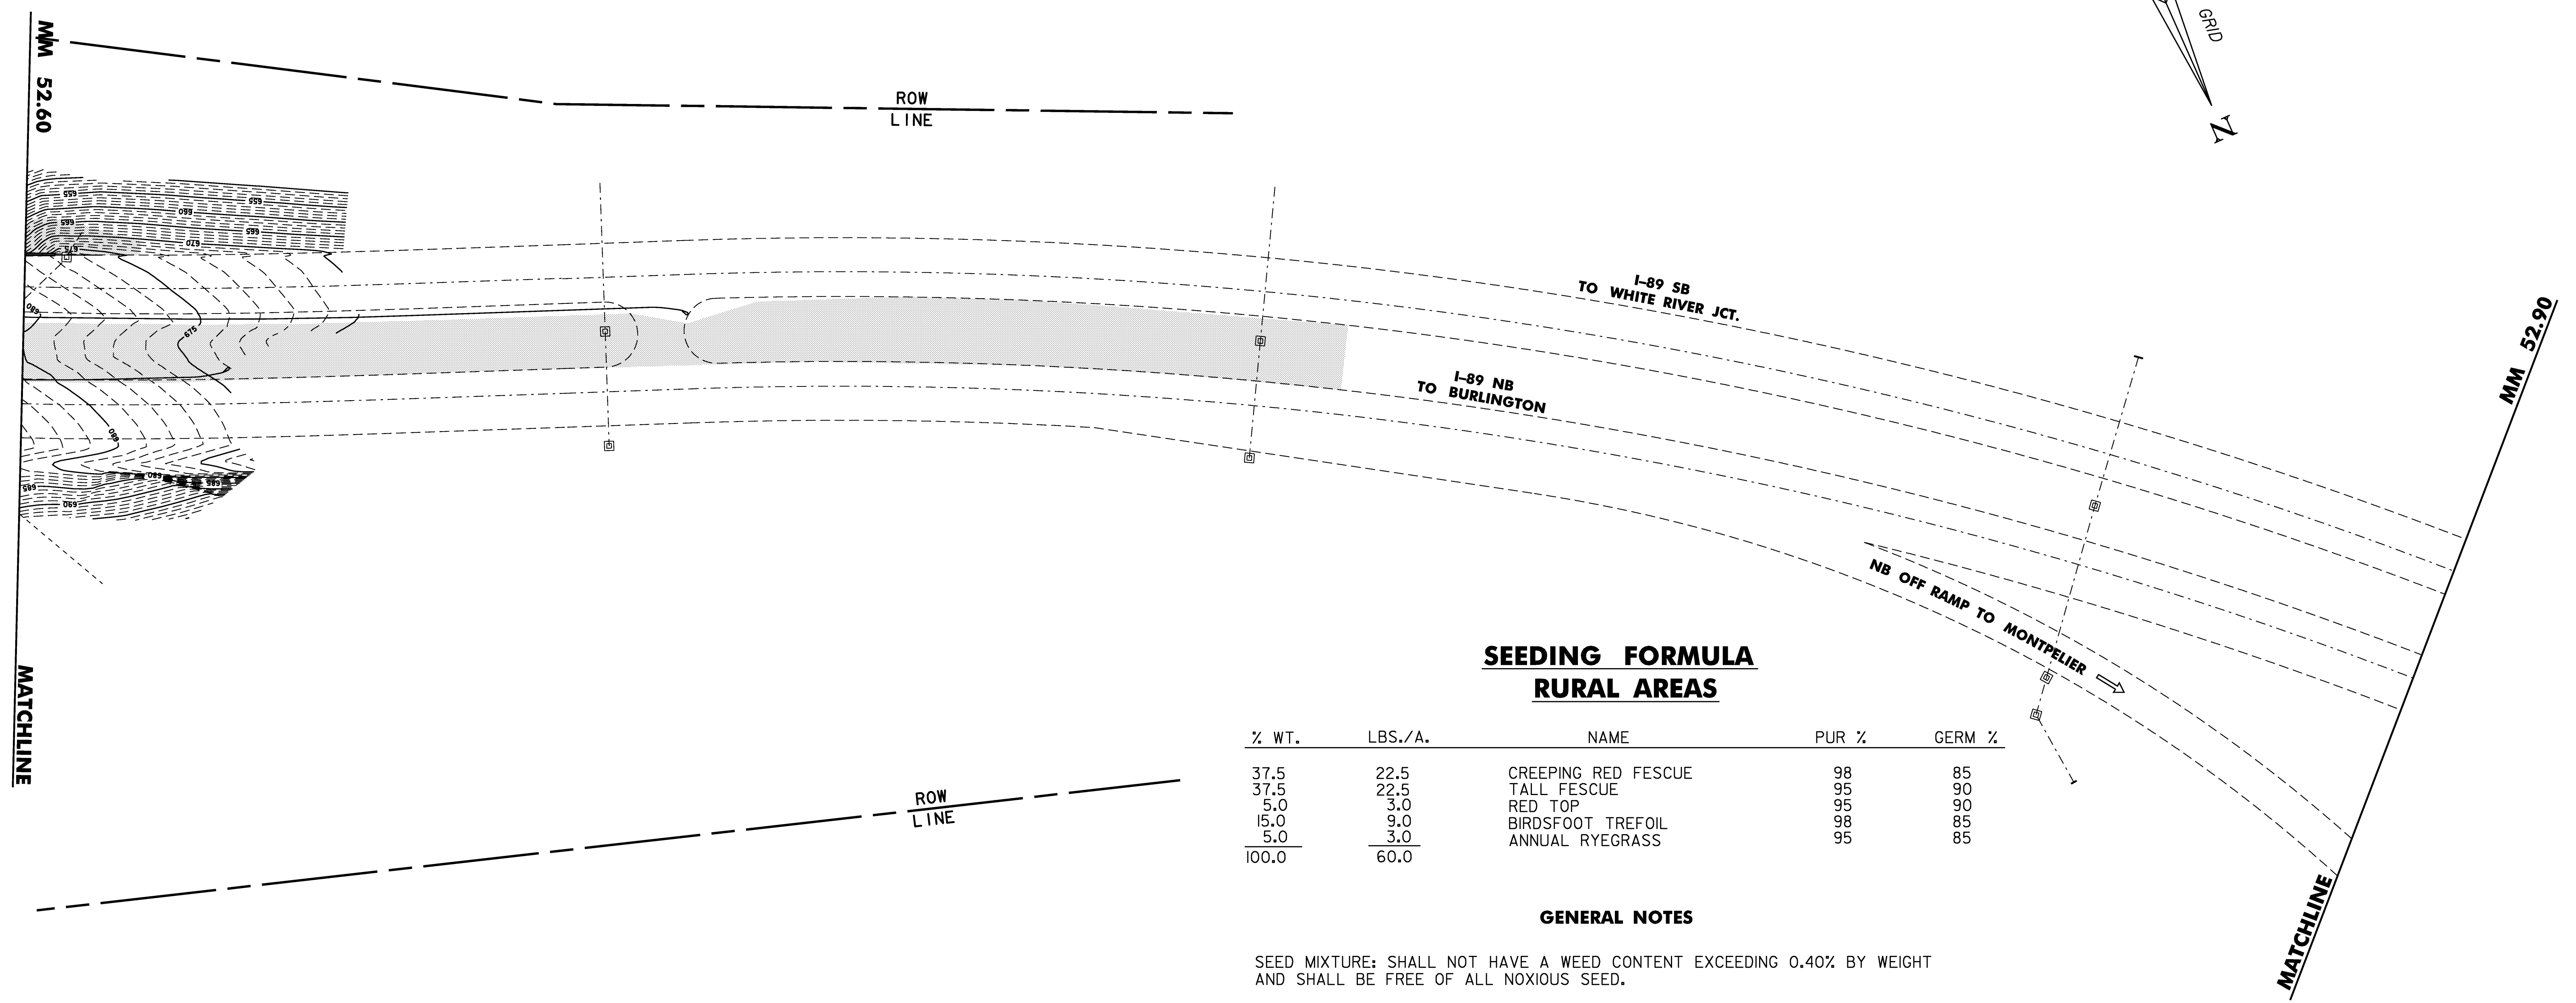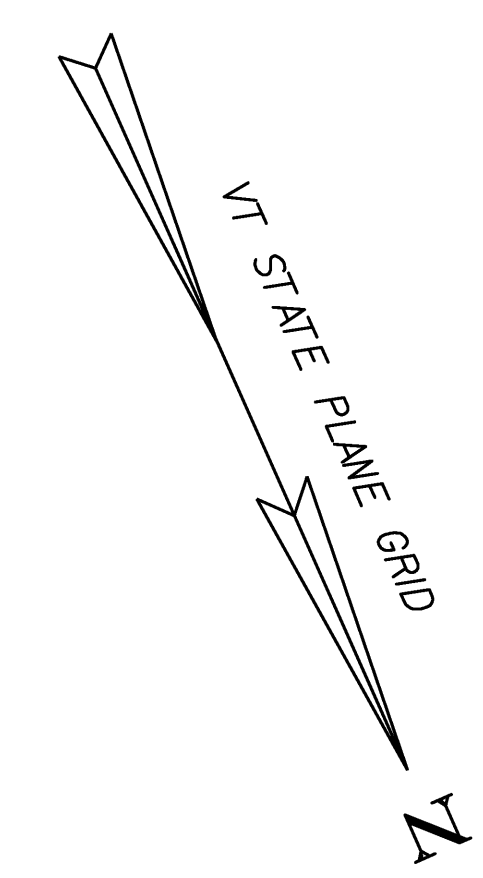

**SEEDING FORMULA  
RURAL AREAS**

% WT.	LBS./A.	NAME	PUR %	GERM %
37.5	22.5	CREeping RED FESCUE	98	85
37.5	22.5	TALL FESCUE	95	90
5.0	3.0	RED TOP	95	90
15.0	9.0	BIRDSFOOT TREFOIL	98	85
5.0	3.0	ANNUAL RYEGRASS	95	85
100.0	60.0			

**GENERAL NOTES**


- SEED MIXTURE: SHALL NOT HAVE A WEED CONTENT EXCEEDING 0.40% BY WEIGHT AND SHALL BE FREE OF ALL NOXIOUS SEED.
- SEED: TO BE APPLIED PER SEEDING FORMULAS OR AS DIRECTED BY THE ENGINEER.
- FERTILIZER: FORMULA 10-20-10, TO BE USED WITH SEED, APPLIED AT THE RATE OF 500 LBS./ACRE. (HYDRO SEEDERS MAY USE 19-19-19 FORMULA).
- AGRICULTURAL LIMESTONE: TO BE APPLIED AT THE RATE OF 2 TONS/ACRE, OR AS DIRECTED BY THE ENGINEER.
- HAY MULCH: TO BE PLACED ON EARTH SLOPES AT THE RATE OF 2 TONS/ACRE, OR AS DIRECTED BY THE ENGINEER.
- TOPSOIL: TO BE USED WITH SEED AS INDICATED ON THE PLANS, OR AS DIRECTED BY THE ENGINEER.

SCALE 1" = 50'-0"  
50 0 50

LEGEND	
	RUNOFF FLOW DIRECTION
	1-4 SLOPE GRADE
	NEW GUARD RAIL
	SEED AND MULCH

**EPSC FINAL  
CONDITIONS SITE  
PLAN SHEET 3**


PROJECT: <b>BERLIN</b>	PROJECT NO.: <b>IM 089-1 (20)</b>
DESIGN FILE NAME: 99a270\structures\s99a270bdr_ero.dgn	PLOT DATE: 05-DEC-2007
IPARM FILE NAME: s99a270fincon3.i	DRAWN BY: M.FESSEL
DESIGNED BY: G.SPILAK	CHECKED BY: K.M.HIGGINS
SQUAD LEADER: C.P.WILLIAMS	SHEET: 78 OF 104
EPSC FINAL CONDITIONS - 3	

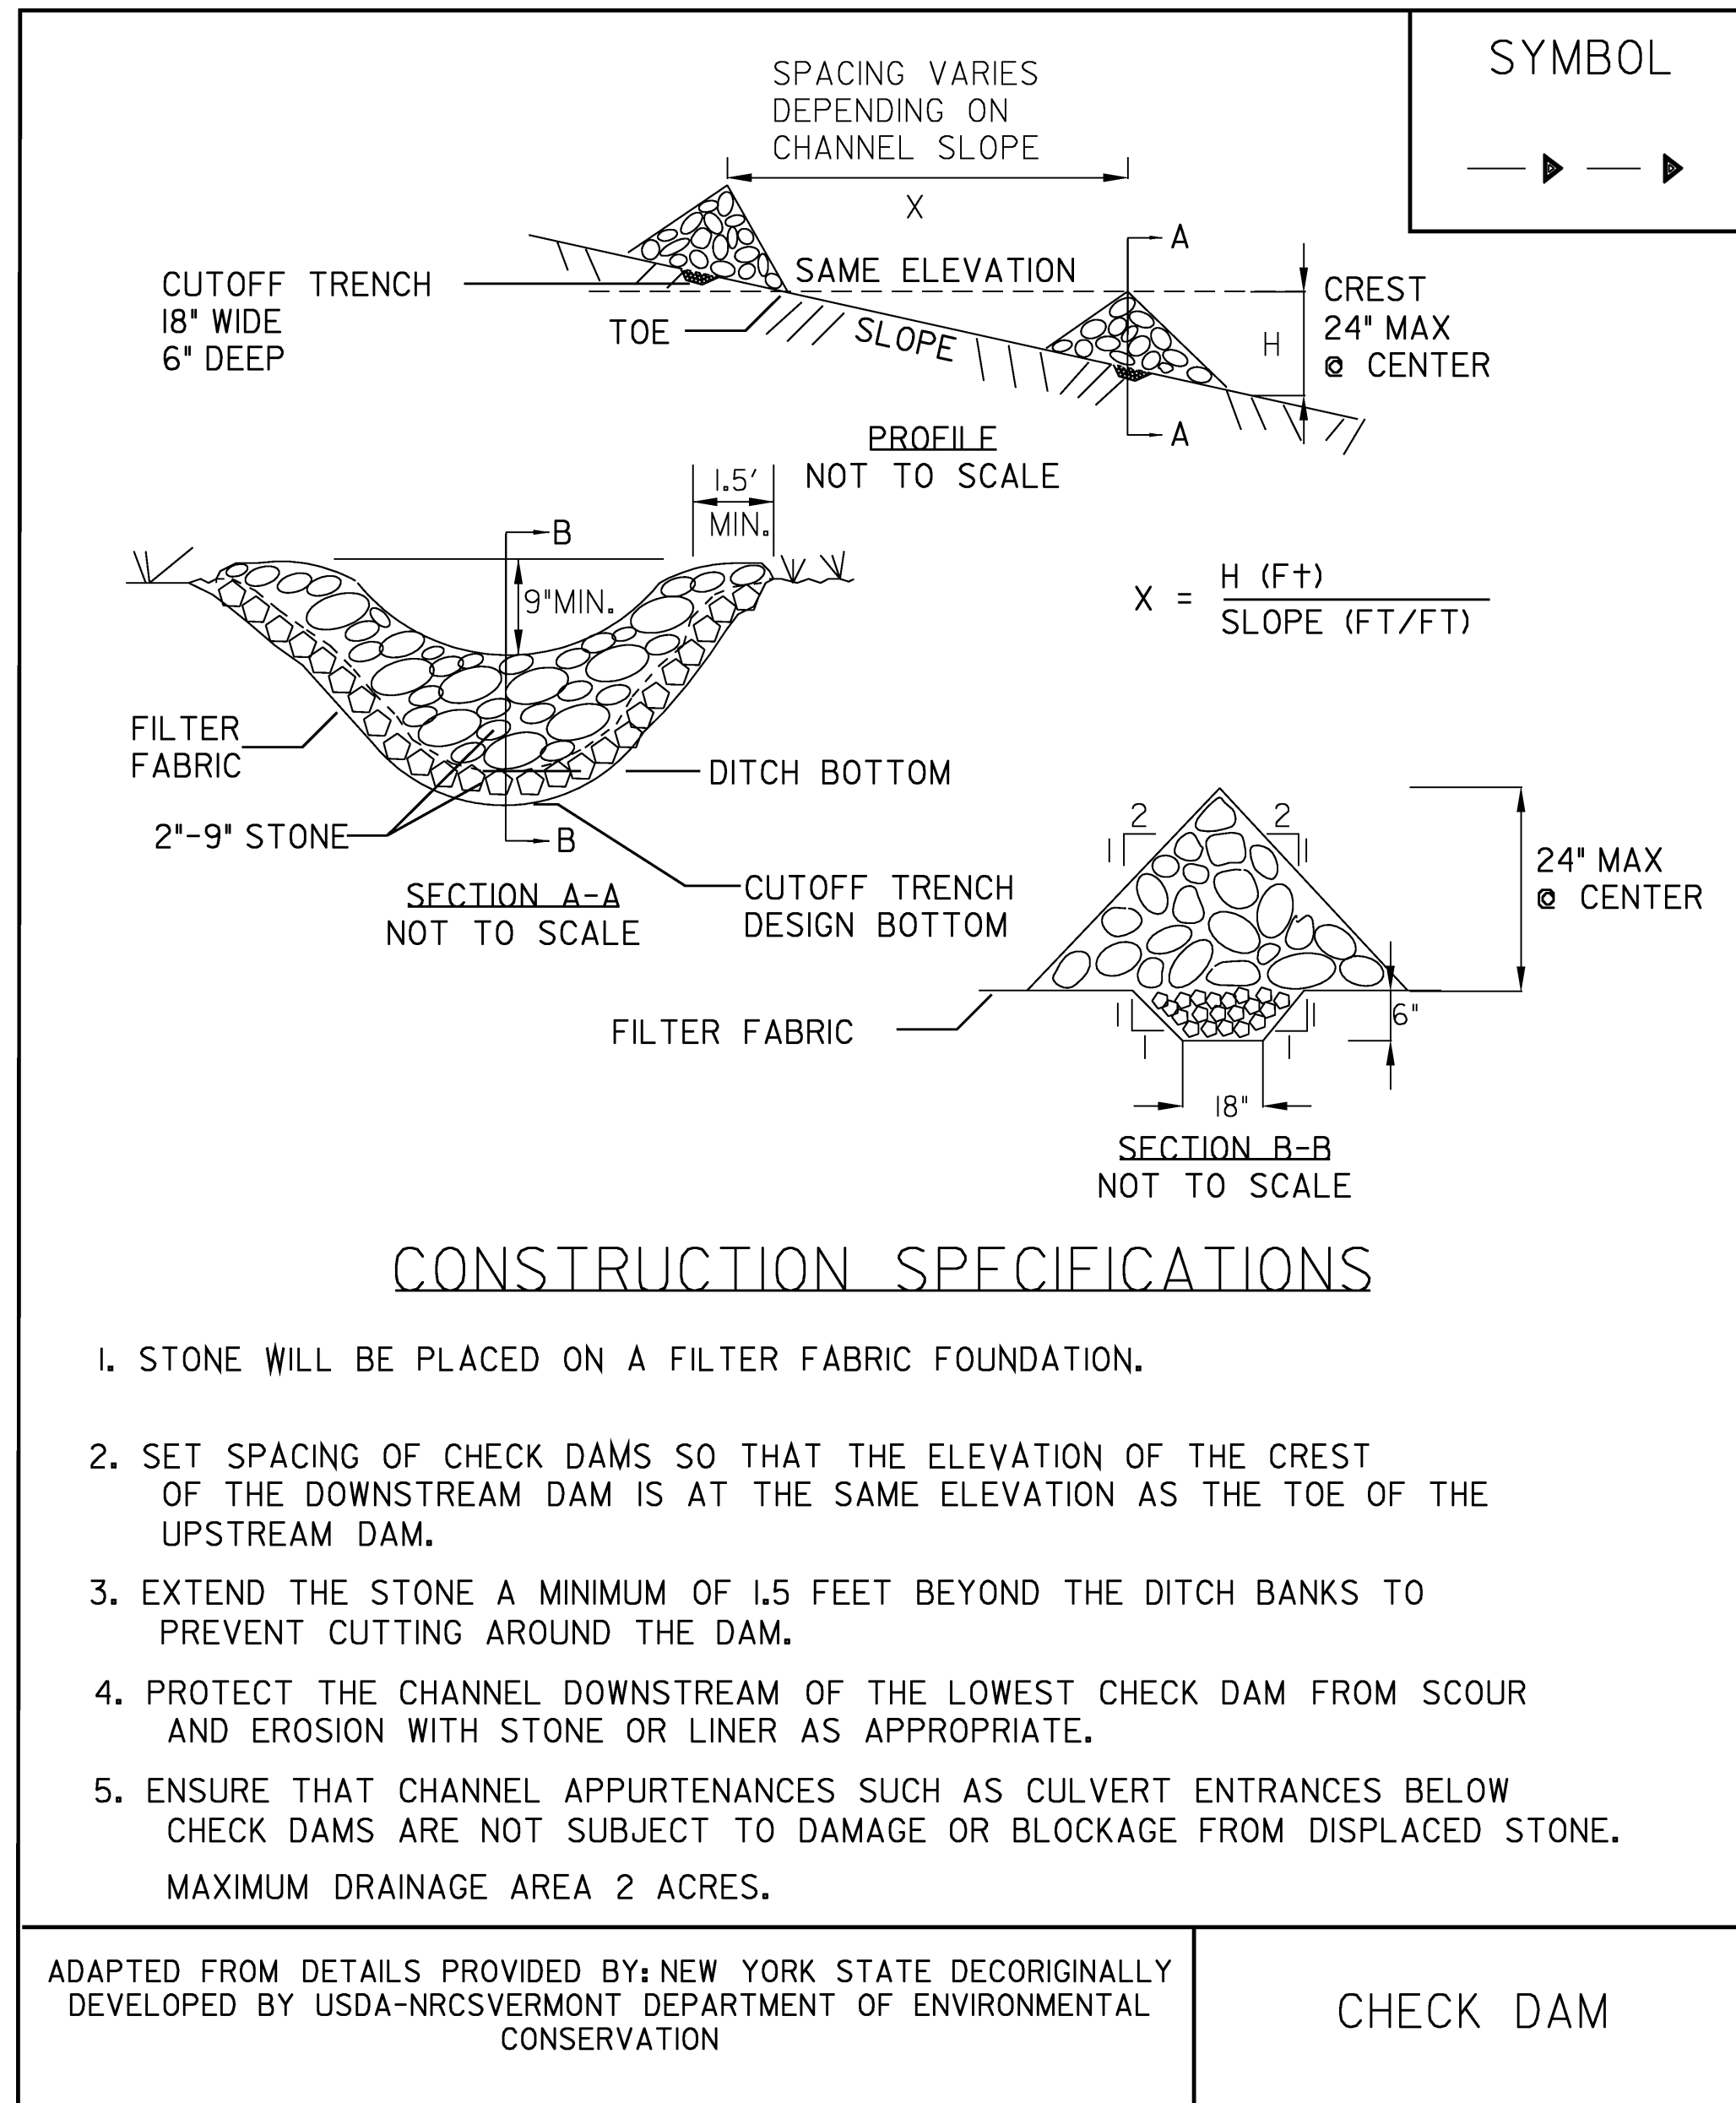

NOTES:  
REFER TO "THE VERMONT STANDARDS & SPECIFICATIONS FOR EROSION PREVENTION & SEDIMENT CONTROL -2006-" FROM THE VT AGENCY OF NATURAL RESOURCES FOR ADDITIONAL GUIDANCE.

THIS ITEM SHALL BE PAID FOR UNDER ITEM 653.25 TEMPORARY STONE CHECK DAM, TYPE I


REVISIONS	
MARCH 8, 2007	JMF

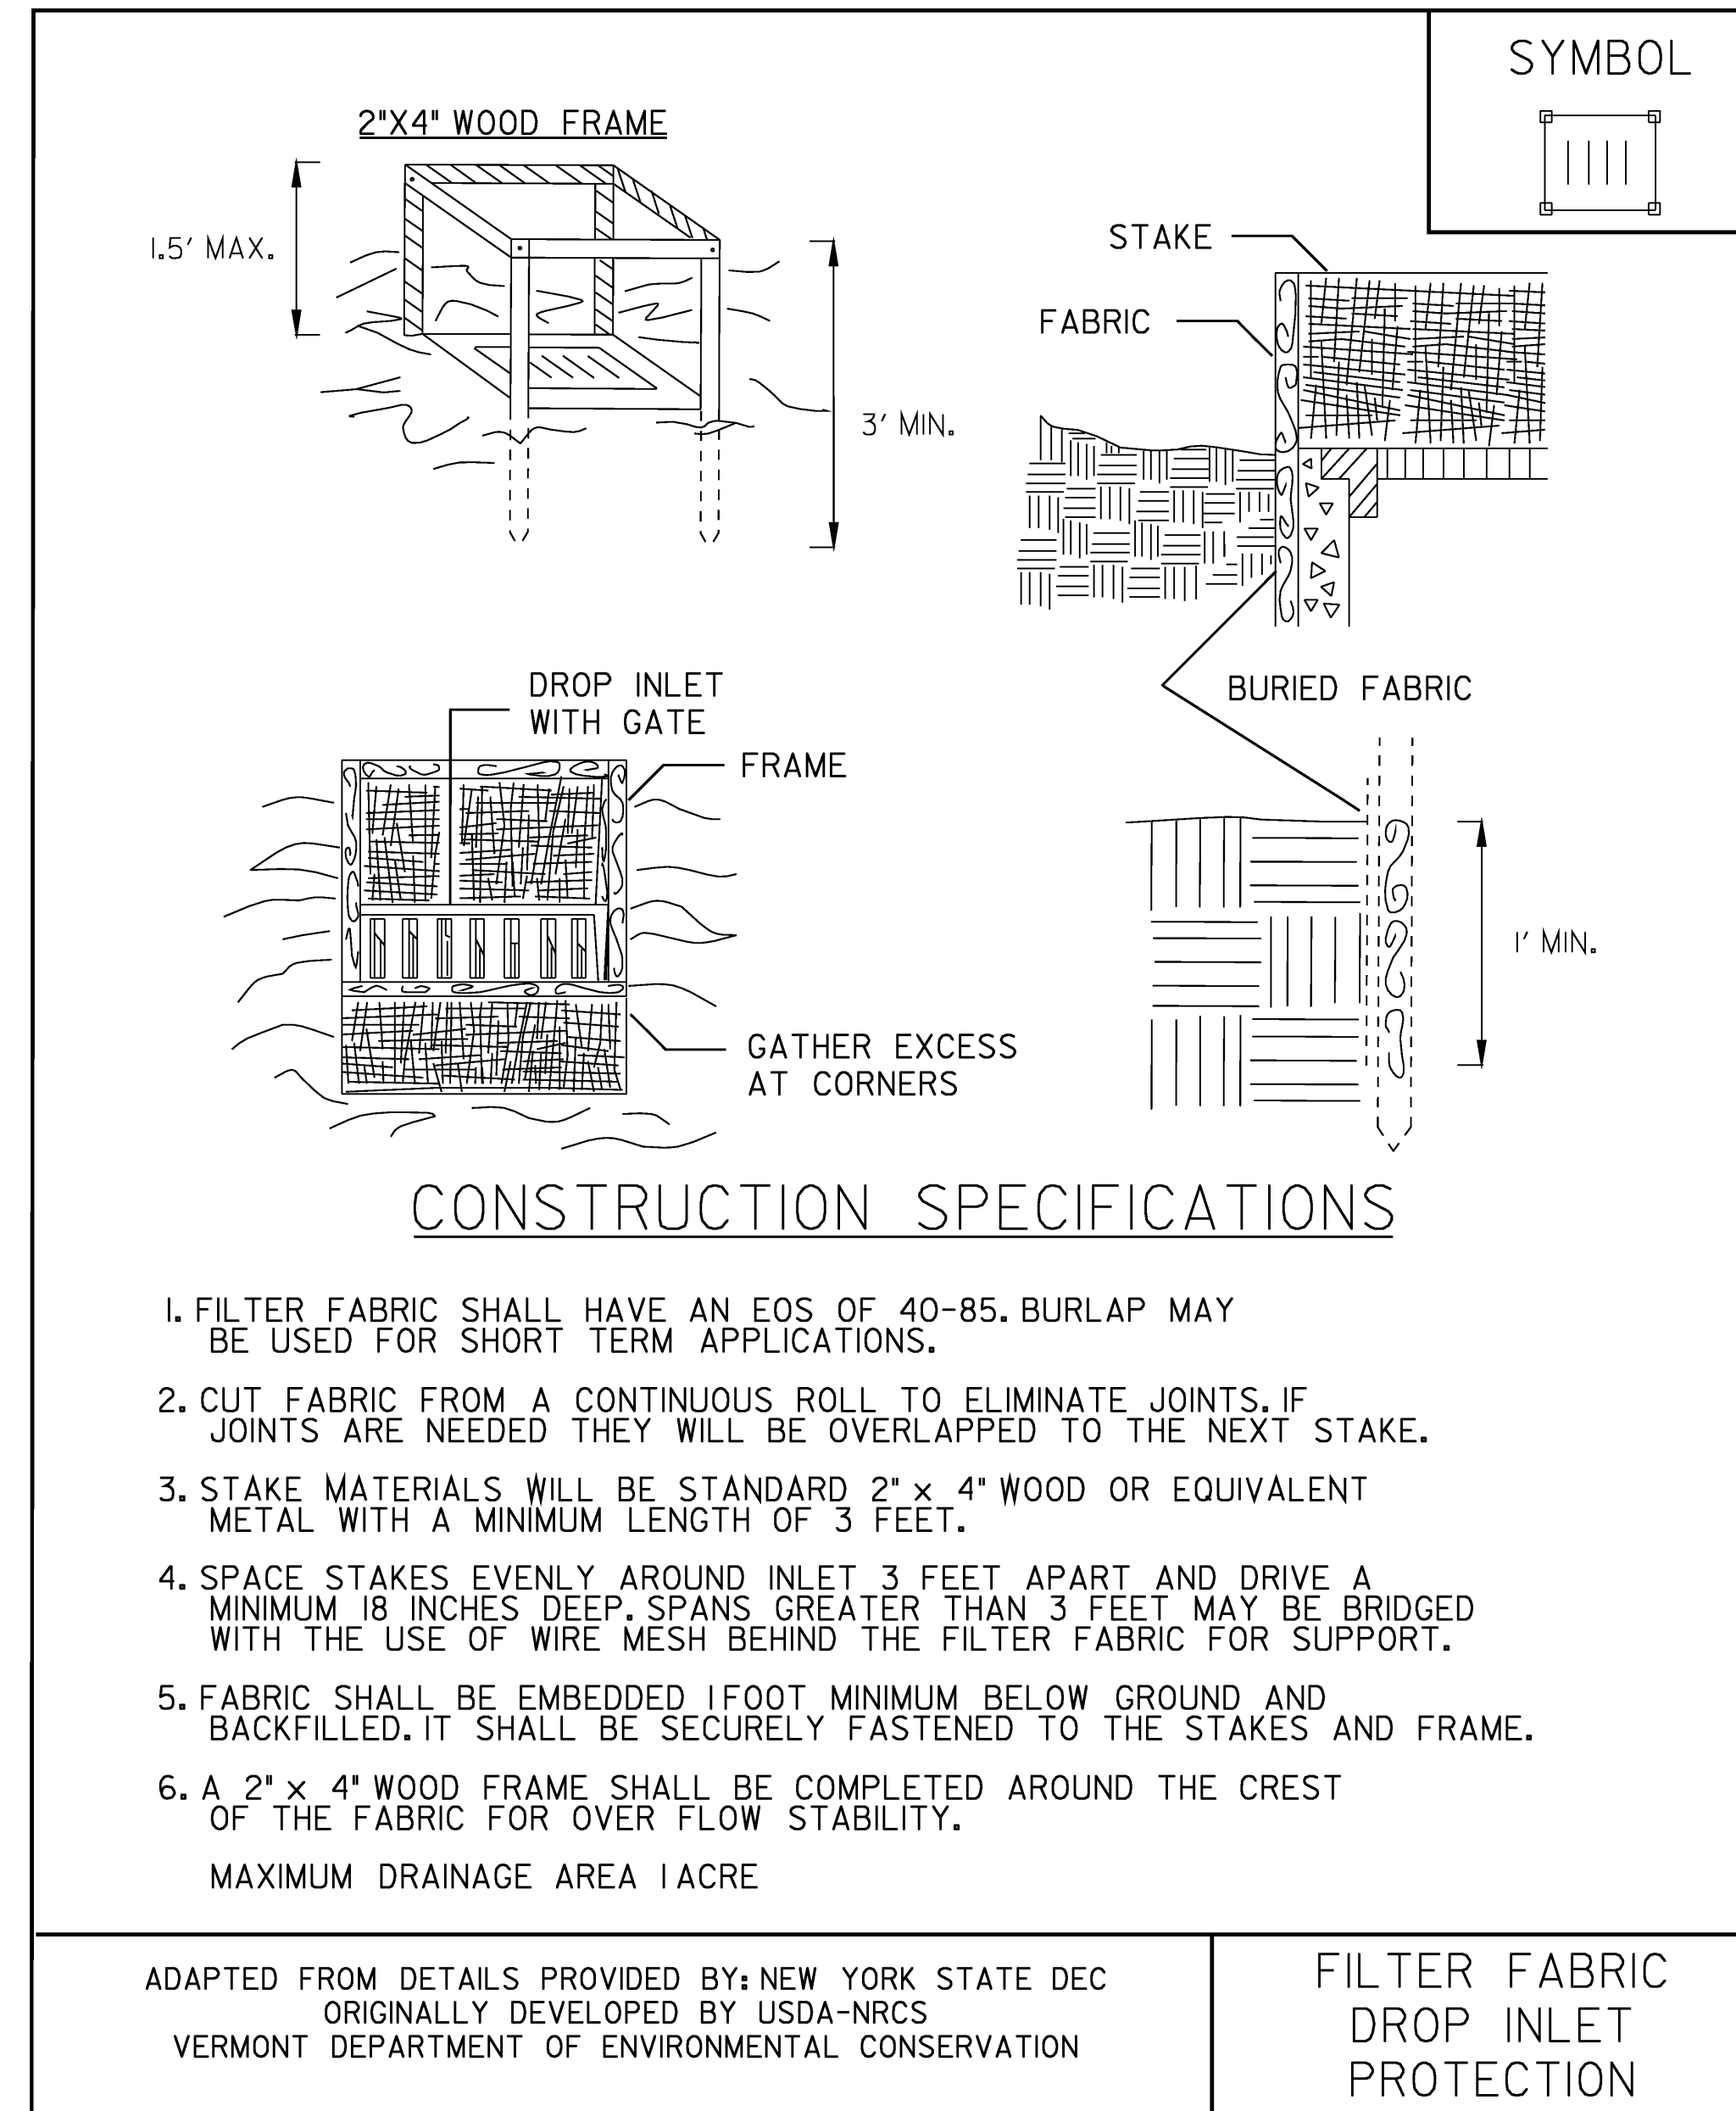

NOTES:  
REFER TO "THE VERMONT STANDARDS & SPECIFICATIONS FOR EROSION PREVENTION & SEDIMENT CONTROL -2006-" FROM THE VT AGENCY OF NATURAL RESOURCES FOR ADDITIONAL GUIDANCE.

THIS ITEM SHALL BE PAID FOR UNDER ITEM 653.40 INLET PROTECTION DEVICE, TYPE I

REVISIONS	
MARCH 8, 2007	JMF

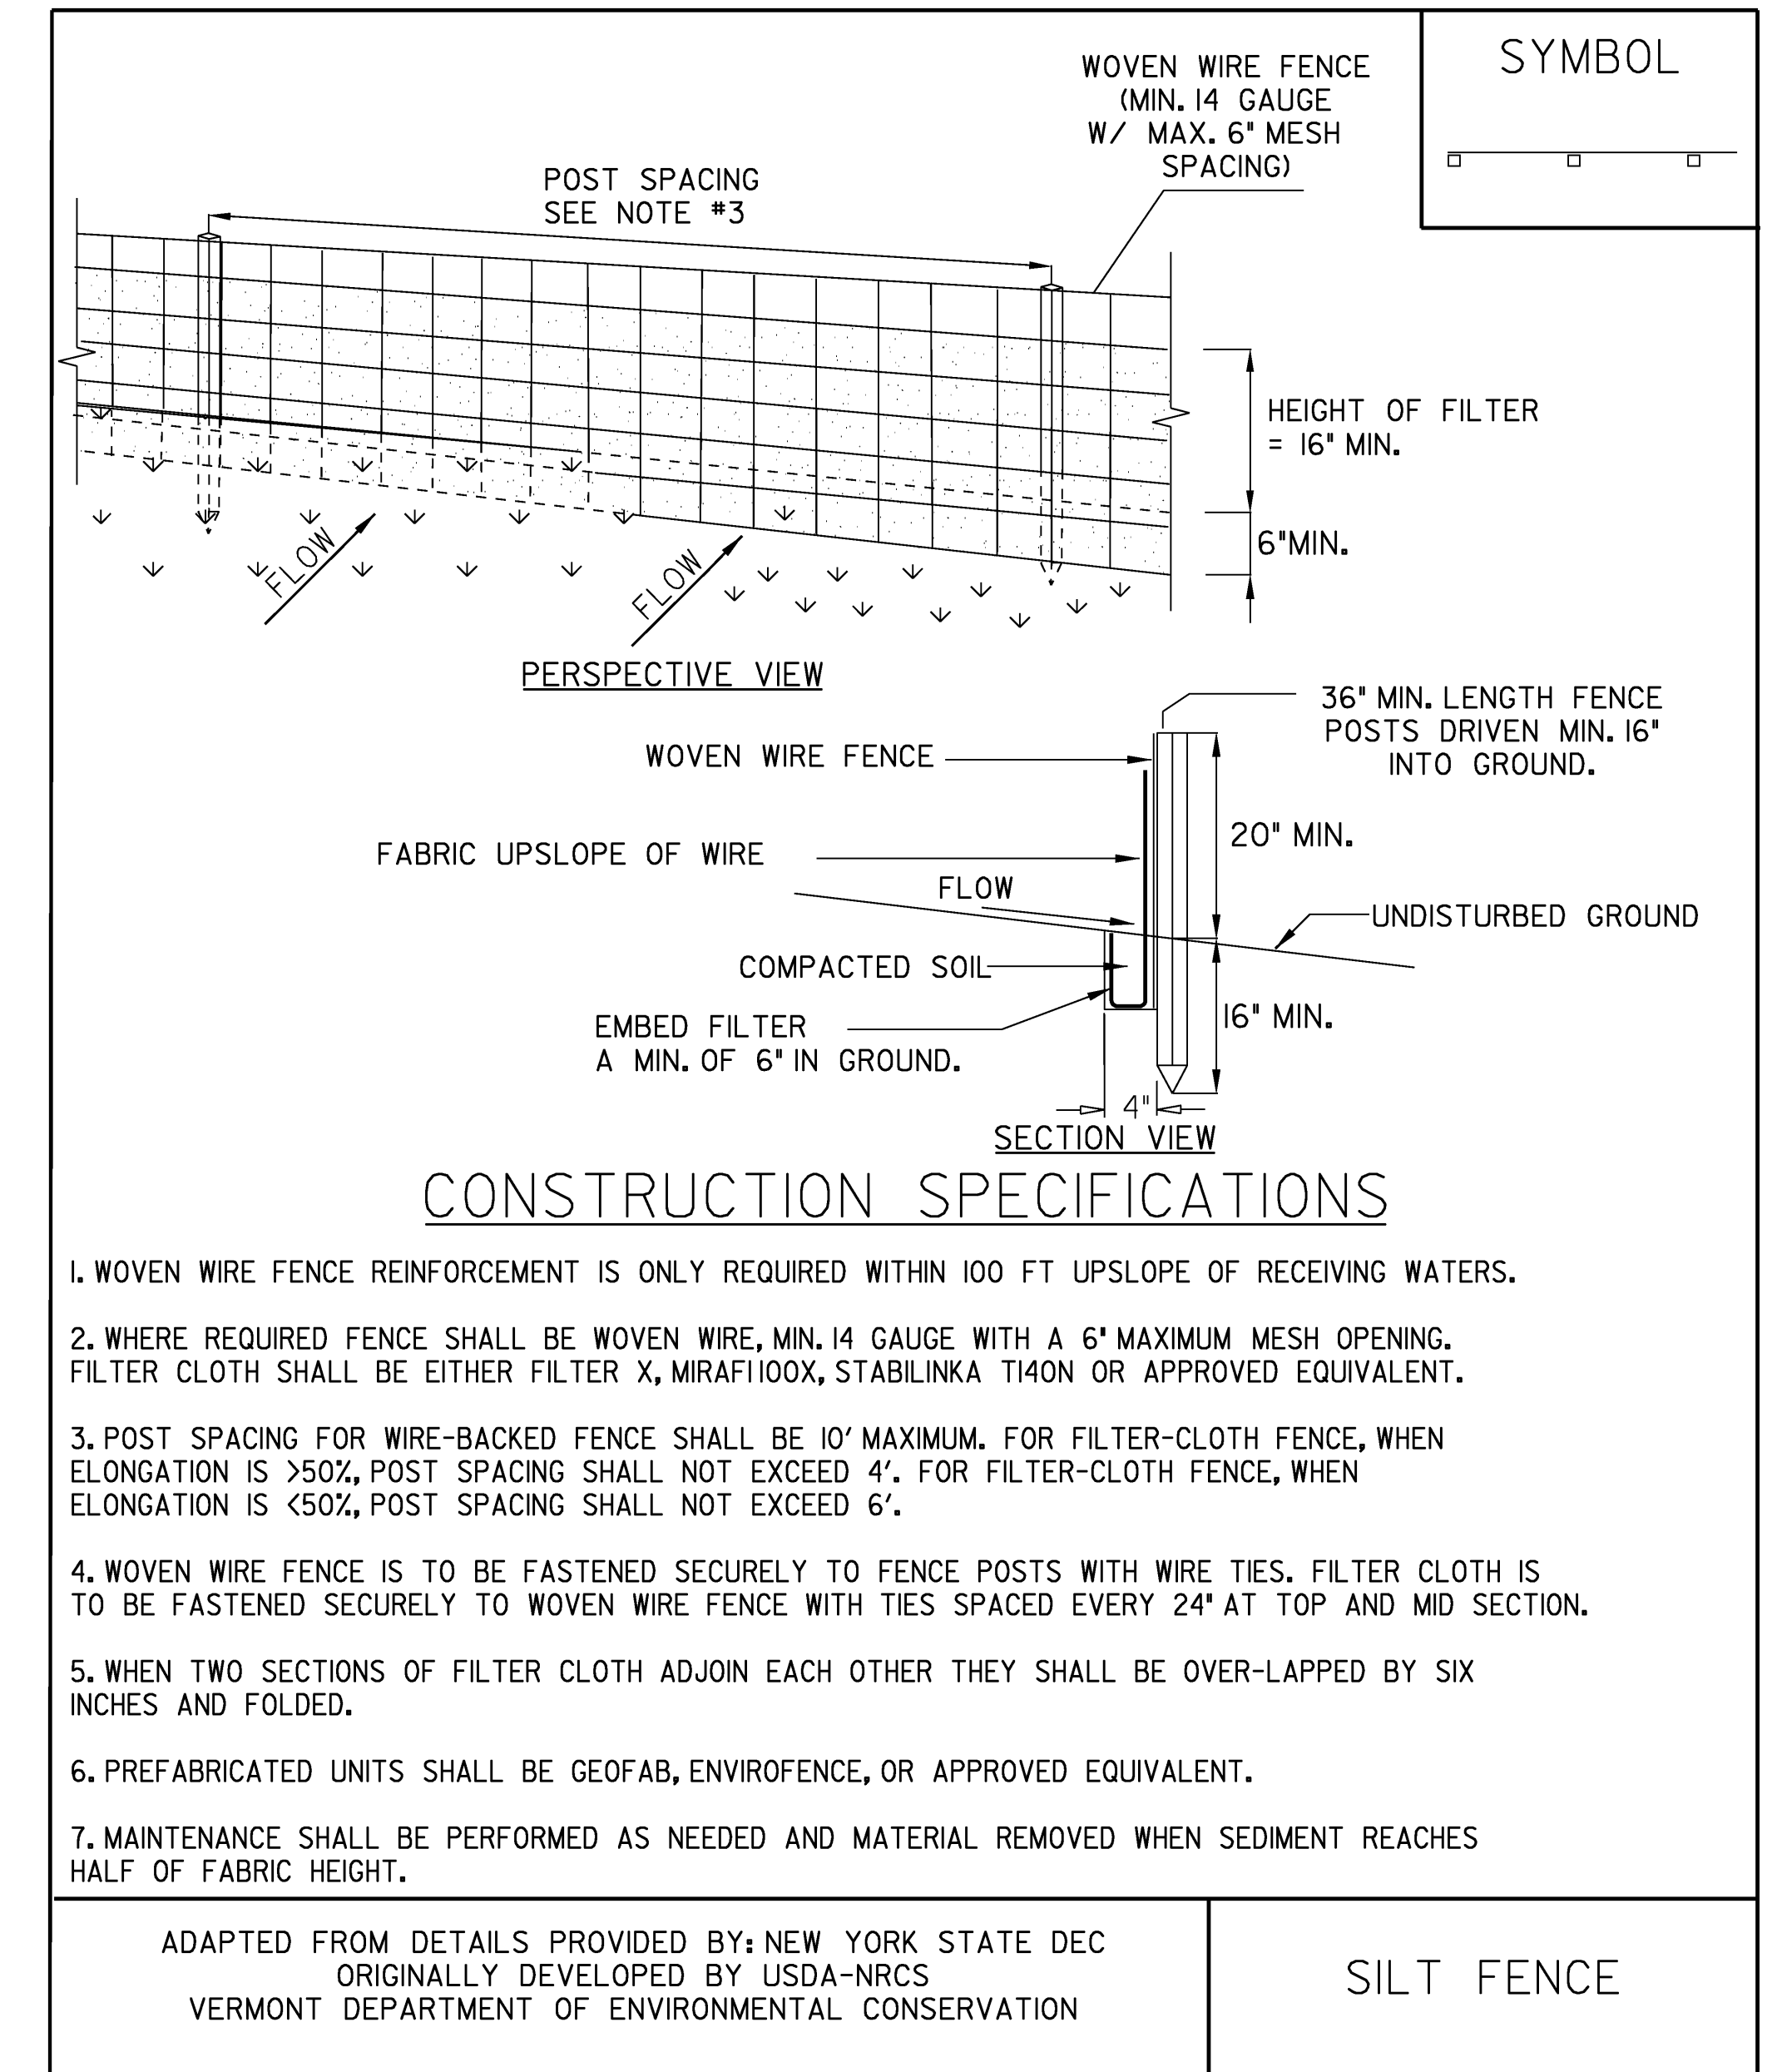


NOTES:  
REFER TO "THE VERMONT STANDARDS & SPECIFICATIONS FOR EROSION PREVENTION & SEDIMENT CONTROL -2006-" FROM THE VT AGENCY OF NATURAL RESOURCES FOR ADDITIONAL GUIDANCE.

THIS ITEM SHALL BE PAID FOR UNDER ITEM STANDARD SPECIFICATION 649.51 GEOTEXTILE FOR SILT FENCE OR SPECIAL PROVISION 900.675 (GEOTEXTILE FOR SILT FENCE, WOVEN WIRE REINFORCED)

**EPSC DETAIL SHEETS**

PROJECT: BERLIN	PROJECT NO.: IM 089-1 (20)
DESIGN FILE NAME: 99a270\Structures\99a270EPSCdetails.dgn	
IPARM FILE NAME: 99a270epscode+1.i	
DESIGNED BY: CONST. ENV. SECTION	DRAWN BY: CONST. ENV. SECT.
SQUAD LEADER: C.P. WILLIAMS	CHECKED BY: A. CABRAL
EPSC DETAIL SHEET - 1	SHEET: 79 OF 104

**NTS**

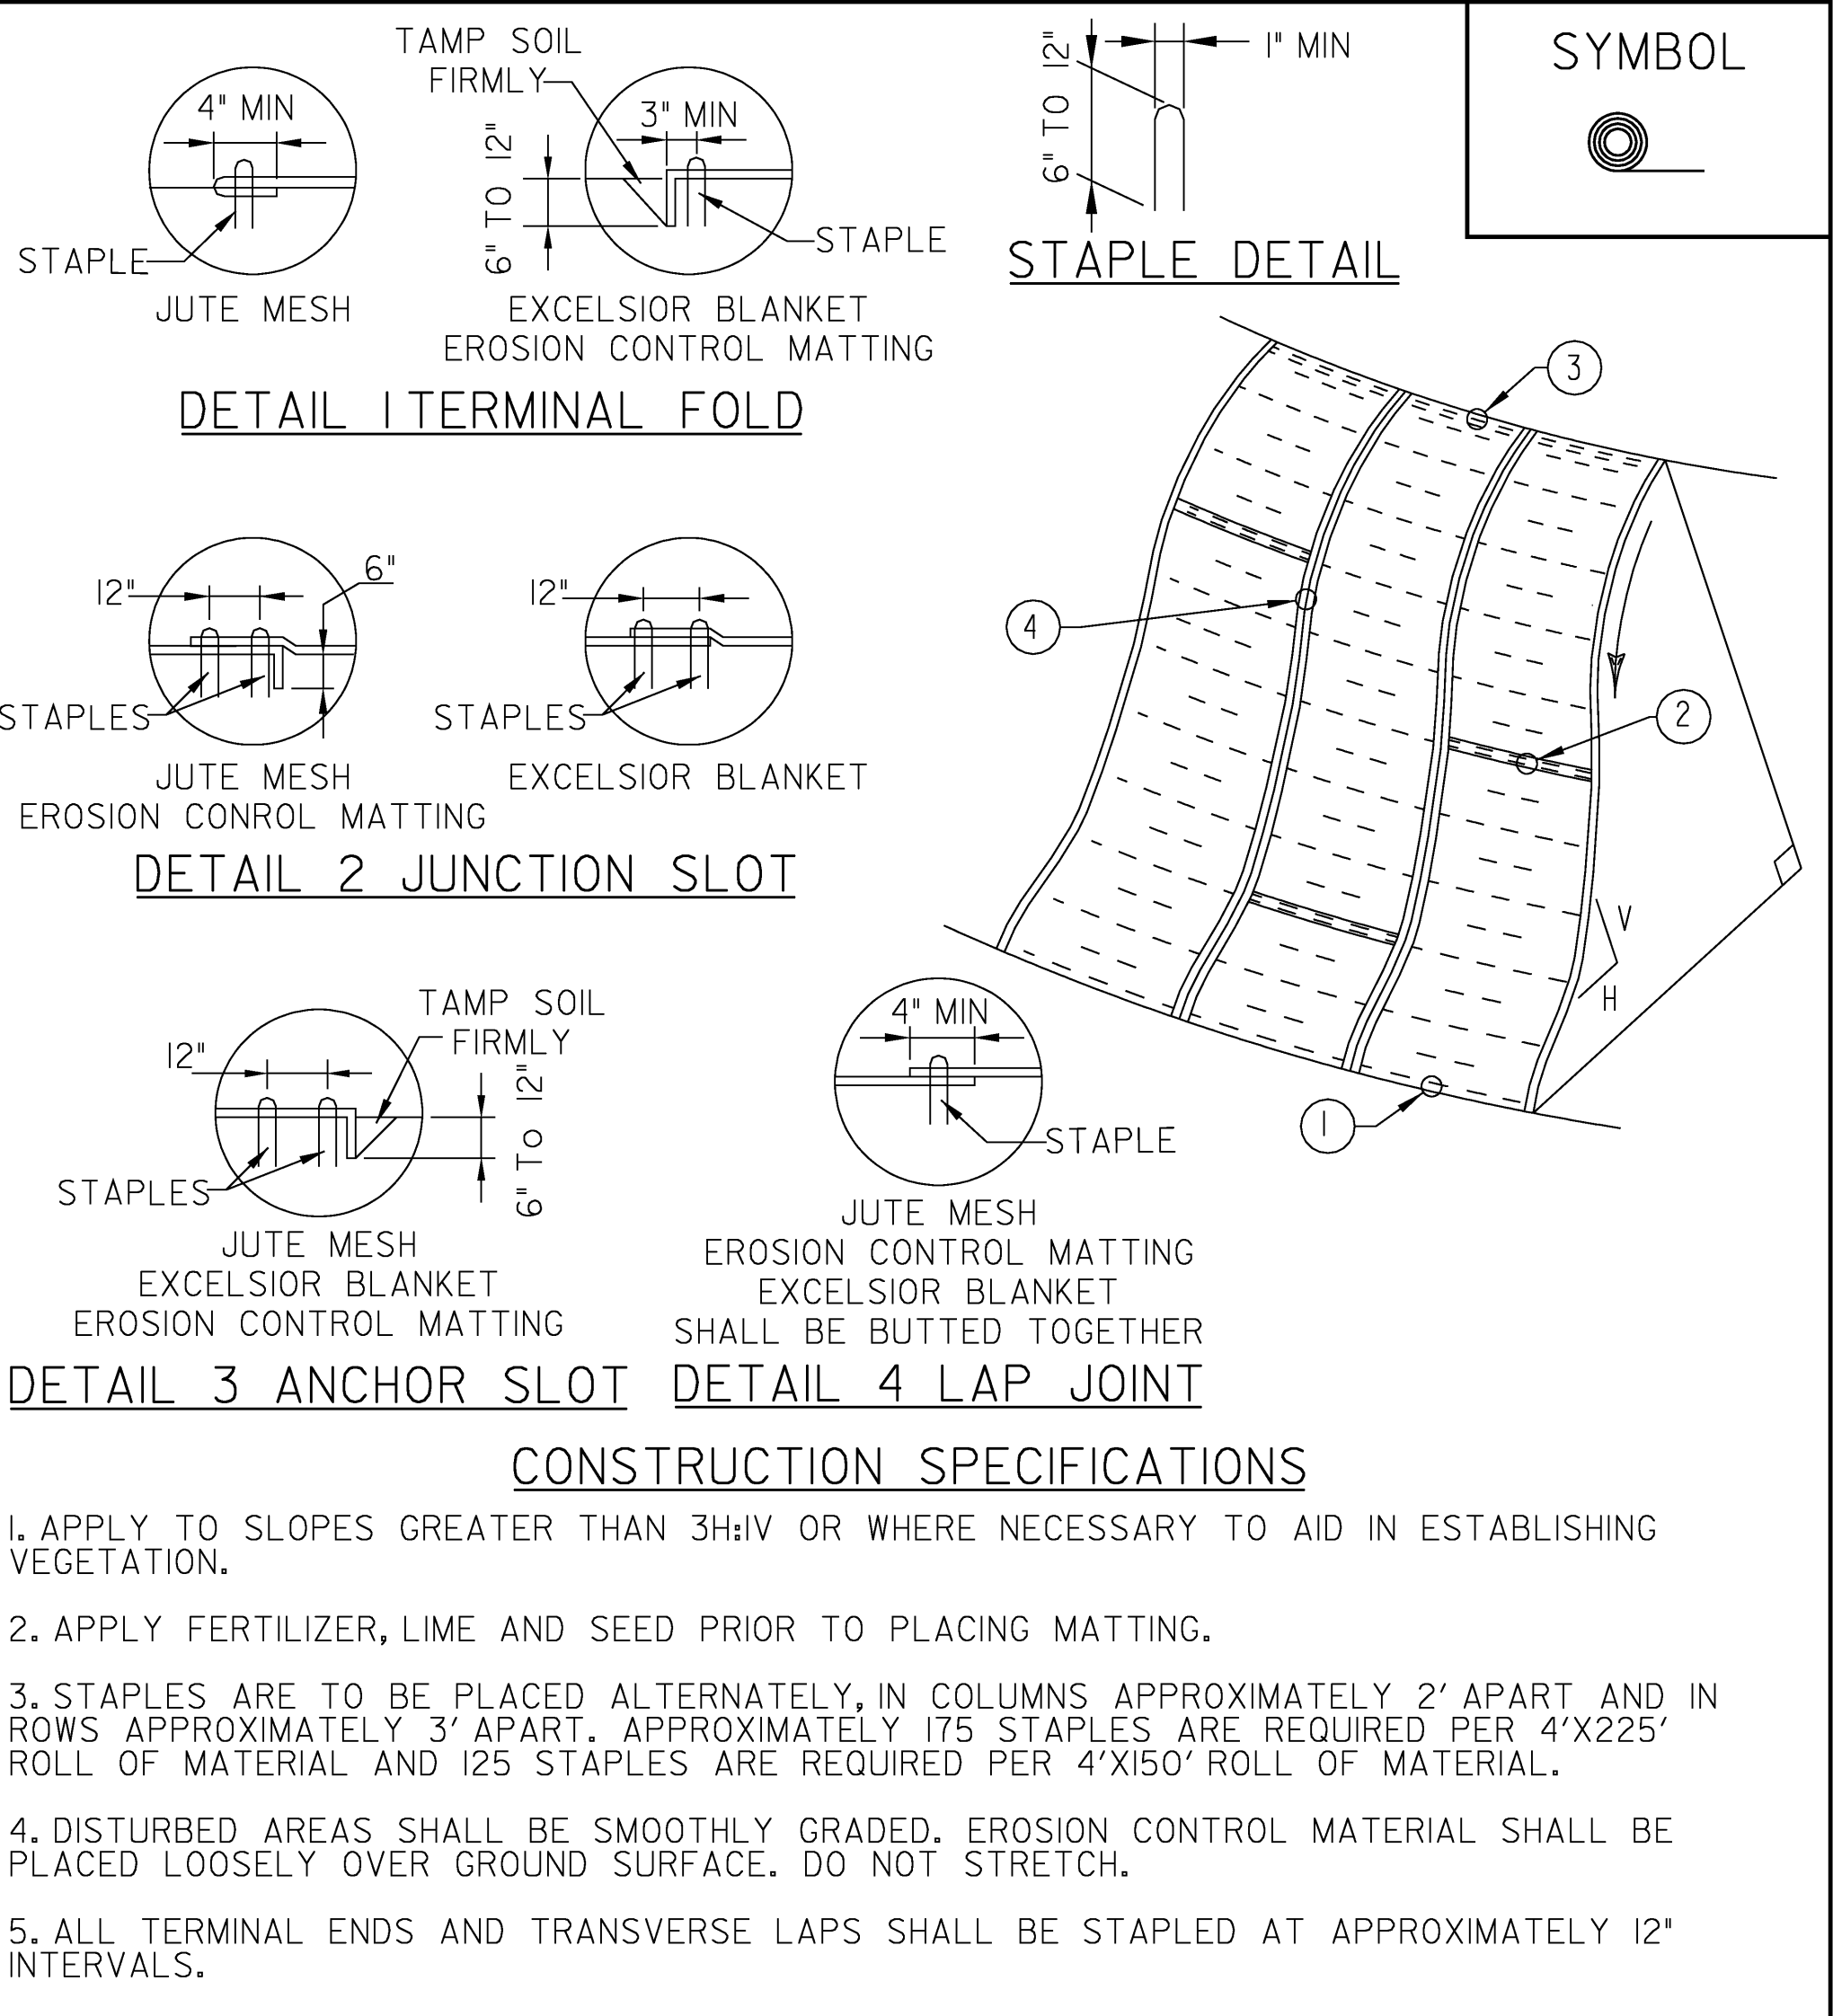


ADAPTED FROM DETAILS PROVIDED BY: ILLINOIS USDA-NRCS  
ORIGINALLY DEVELOPED BY USDA-NRCS  
VERMONT DEPARTMENT OF ENVIRONMENTAL CONSERVATION

**ROLLED EROSION CONTROL PRODUCT (RECP) SIDE SLOPE**

NOTES:  
REFER TO \*THE VERMONT STANDARDS & SPECIFICATIONS FOR EROSION PREVENTION & SEDIMENT CONTROL -2006- \*FROM THE VT AGENCY OF NATURAL RESOURCES FOR ADDITIONAL GUIDANCE.

THIS ITEM SHALL BE PAID FOR UNDER ITEM  
653.20 TEMPORARY EROSION MATTING OR  
653.21 PERMANENT EROSION MATTING

NEW	
APRIL 16, 2007	WHF
REVISIONS	

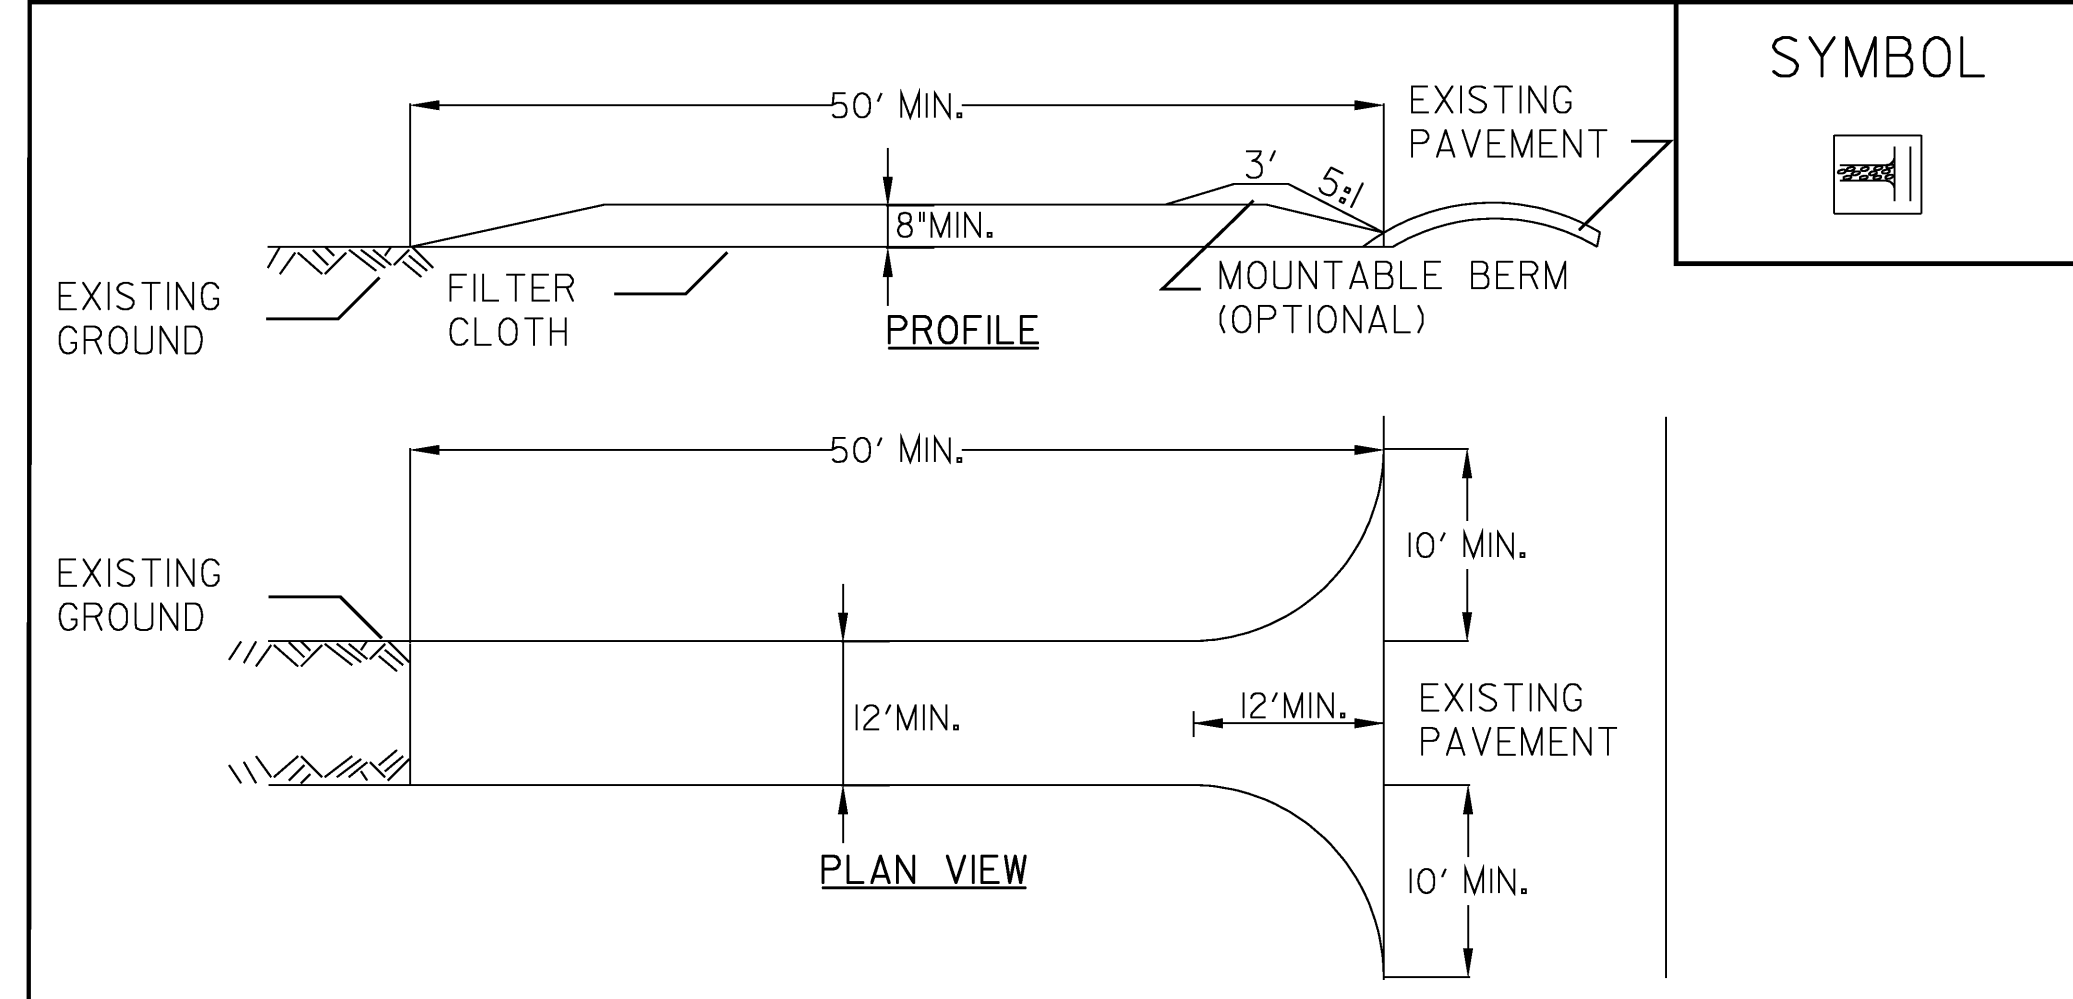

**CONSTRUCTION SPECIFICATIONS**

1. STONE SIZE - USE 1-4" STONE, OR RECLAIMED OR RECYCLED CONCRETE EQUIVALENT.
2. LENGTH - NOT LESS THAN 50 FEET (EXCEPT ON A SINGLE RESIDENCE LOT WHERE A 30 FOOT MINIMUM LENGTH APPLIES).
3. THICKNESS - NOT LESS THAN EIGHT (8) INCHES.
4. WIDTH - TWELVE (12) FOOT MINIMUM, BUT NOT LESS THAN THE FULL WIDTH AT POINTS WHERE INGRESS OR EGRESS OCCURS. TWENTY-FOUR (24) FOOT IF SINGLE ENTRANCE TO SITE.
5. GEOTEXTILE MUST BE PLACED OVER THE ENTIRE AREA PRIOR TO PLACING STONE.
6. SURFACE WATER - ALL SURFACE WATER FLOWING OR DIVERTED TOWARD CONSTRUCTION ENTRANCES SHALL BE PIPED BENEATH THE ENTRANCE. IF PIPING IS IMPRACTICAL, A MOUNTABLE BERM WITH 5:1 SLOPES WILL BE PERMITTED.
7. MAINTENANCE - THE ENTRANCE SHALL BE MAINTAINED IN A CONDITION WHICH WILL PREVENT TRACKING OR FLOWING OF SEDIMENT ONTO PUBLIC RIGHTS-OF-WAY, ALL SEDIMENT SPILLED, DROPPED, WASHED OR TRACKED ONTO PUBLIC RIGHTS-OF-WAY MUST BE REMOVED IMMEDIATELY.
8. WHEN WASHING IS REQUIRED, IT SHALL BE DONE ON AN AREA STABILIZED WITH STONE AND WHICH DRAINS INTO AN APPROVED SEDIMENT TRAPPING DEVICE.
9. PERIODIC INSPECTION AND NEEDED MAINTENANCE SHALL BE PROVIDED ACCORDING TO PERMIT REQUIREMENTS.


ADAPTED FROM DETAILS PROVIDED BY: NEW YORK STATE DEC  
ORIGINALLY DEVELOPED BY USDA-NRCS  
VERMONT DEPARTMENT OF ENVIRONMENTAL CONSERVATION

**STABILIZED CONSTRUCTION ENTRANCE**

NOTES:  
REFER TO \*THE VERMONT STANDARDS & SPECIFICATIONS FOR EROSION PREVENTION & SEDIMENT CONTROL -2006- \*FROM THE VT AGENCY OF NATURAL RESOURCES FOR ADDITIONAL GUIDANCE.

THIS ITEM SHALL BE PAID FOR UNDER ITEM  
653.35 VEHICLE TRACKING PAD

REVISIONS	
FEBRUARY 9, 2007	WHF
MARCH 8, 2007	JMF

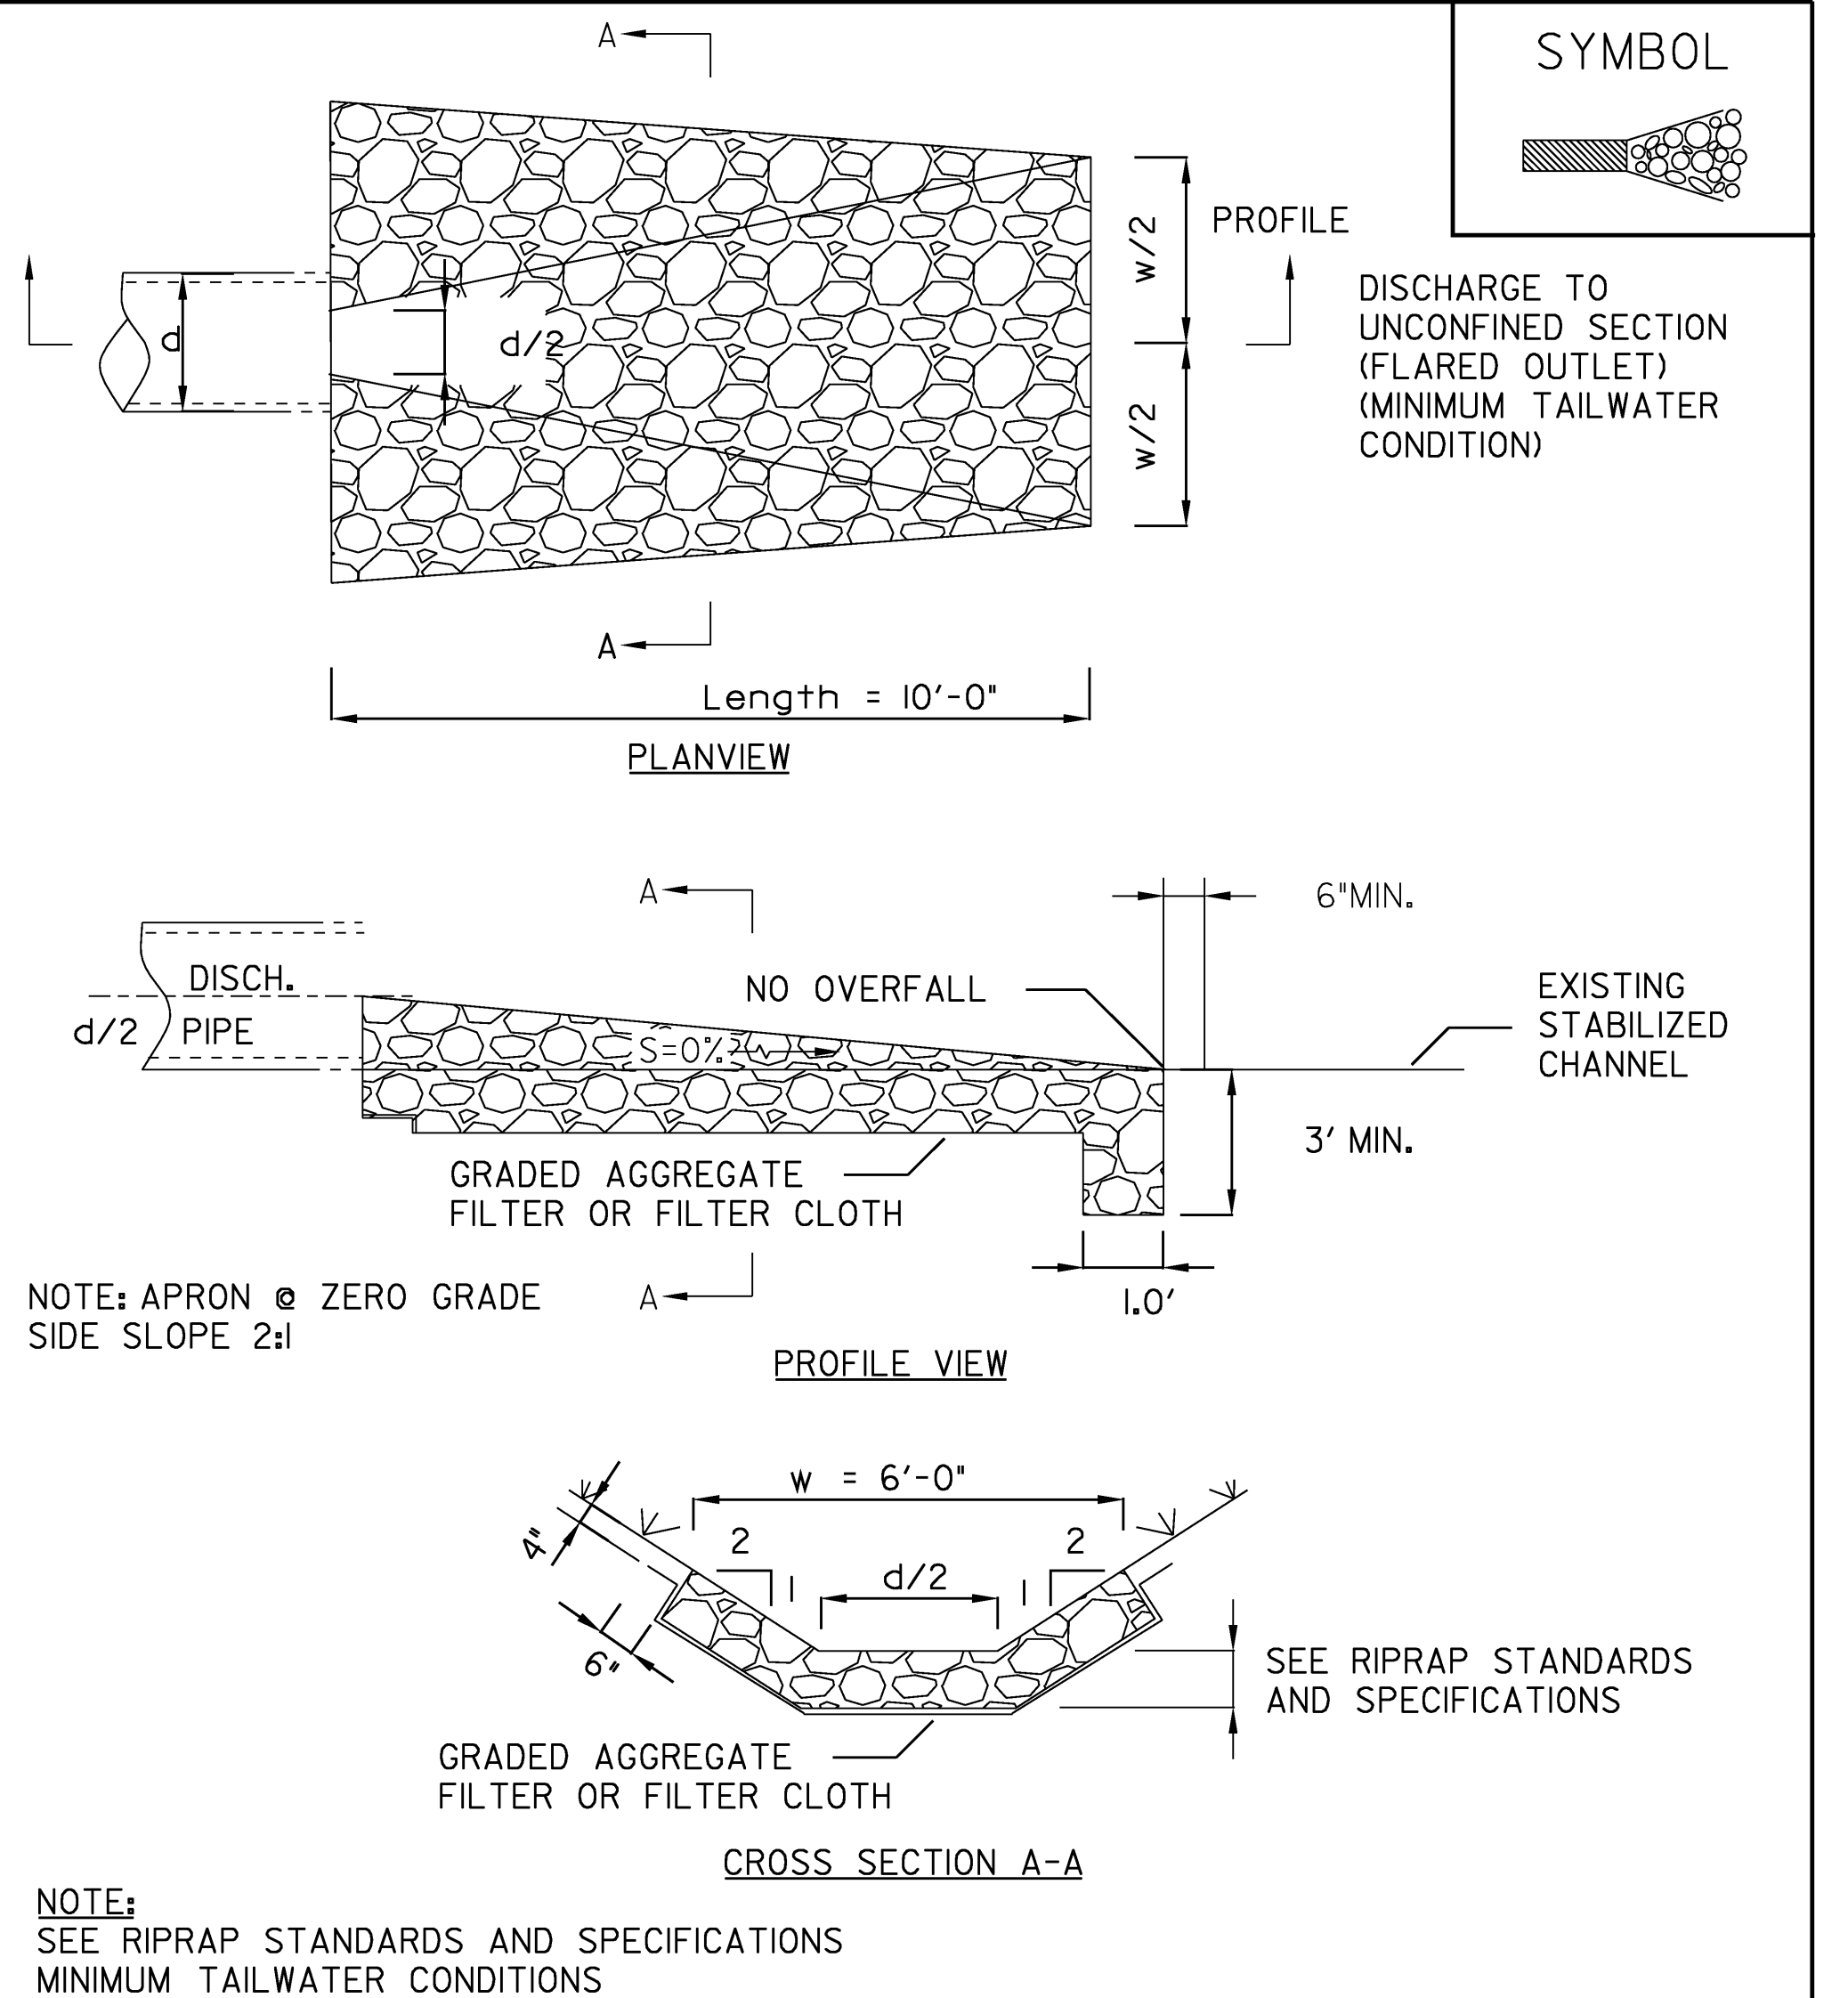

ADAPTED FROM DETAILS PROVIDED BY: NEW YORK STATE DEC  
ORIGINALLY DEVELOPED BY USDA-NRCS  
VERMONT DEPARTMENT OF ENVIRONMENTAL CONSERVATION

**RIPRAP OUTLET PROTECTION EXAMPLE**


NOTES:  
REFER TO \*THE VERMONT STANDARDS & SPECIFICATIONS FOR EROSION PREVENTION & SEDIMENT CONTROL -2006- \*FROM THE VT AGENCY OF NATURAL RESOURCES FOR ADDITIONAL GUIDANCE.

THIS ITEM SHALL BE PAID FOR UNDER ITEM  
653.25 TEMPORARY STONE CHECK DAM, TYPE I

**EPSC DETAIL SHEETS**

PROJECT: BERLIN	PROJECT NO.: IM 089-1 (20)
DESIGN FILE NAME: 99a270\Structures\99a270EPSCdetails.dgn	PLOT DATE: 05-DEC-2007
IPARM FILE NAME: 99a270epsdet2.i	DRAWN BY: CONST. ENV. SECT.
DESIGNED BY: CONST. ENV. SECTION	CHECKED BY: A. CABRAL
SQUAD LEADER: C. P. WILLIAMS	SHEET: 80 OF 104
EPSC DETAIL SHEET - 2	

**NTS**

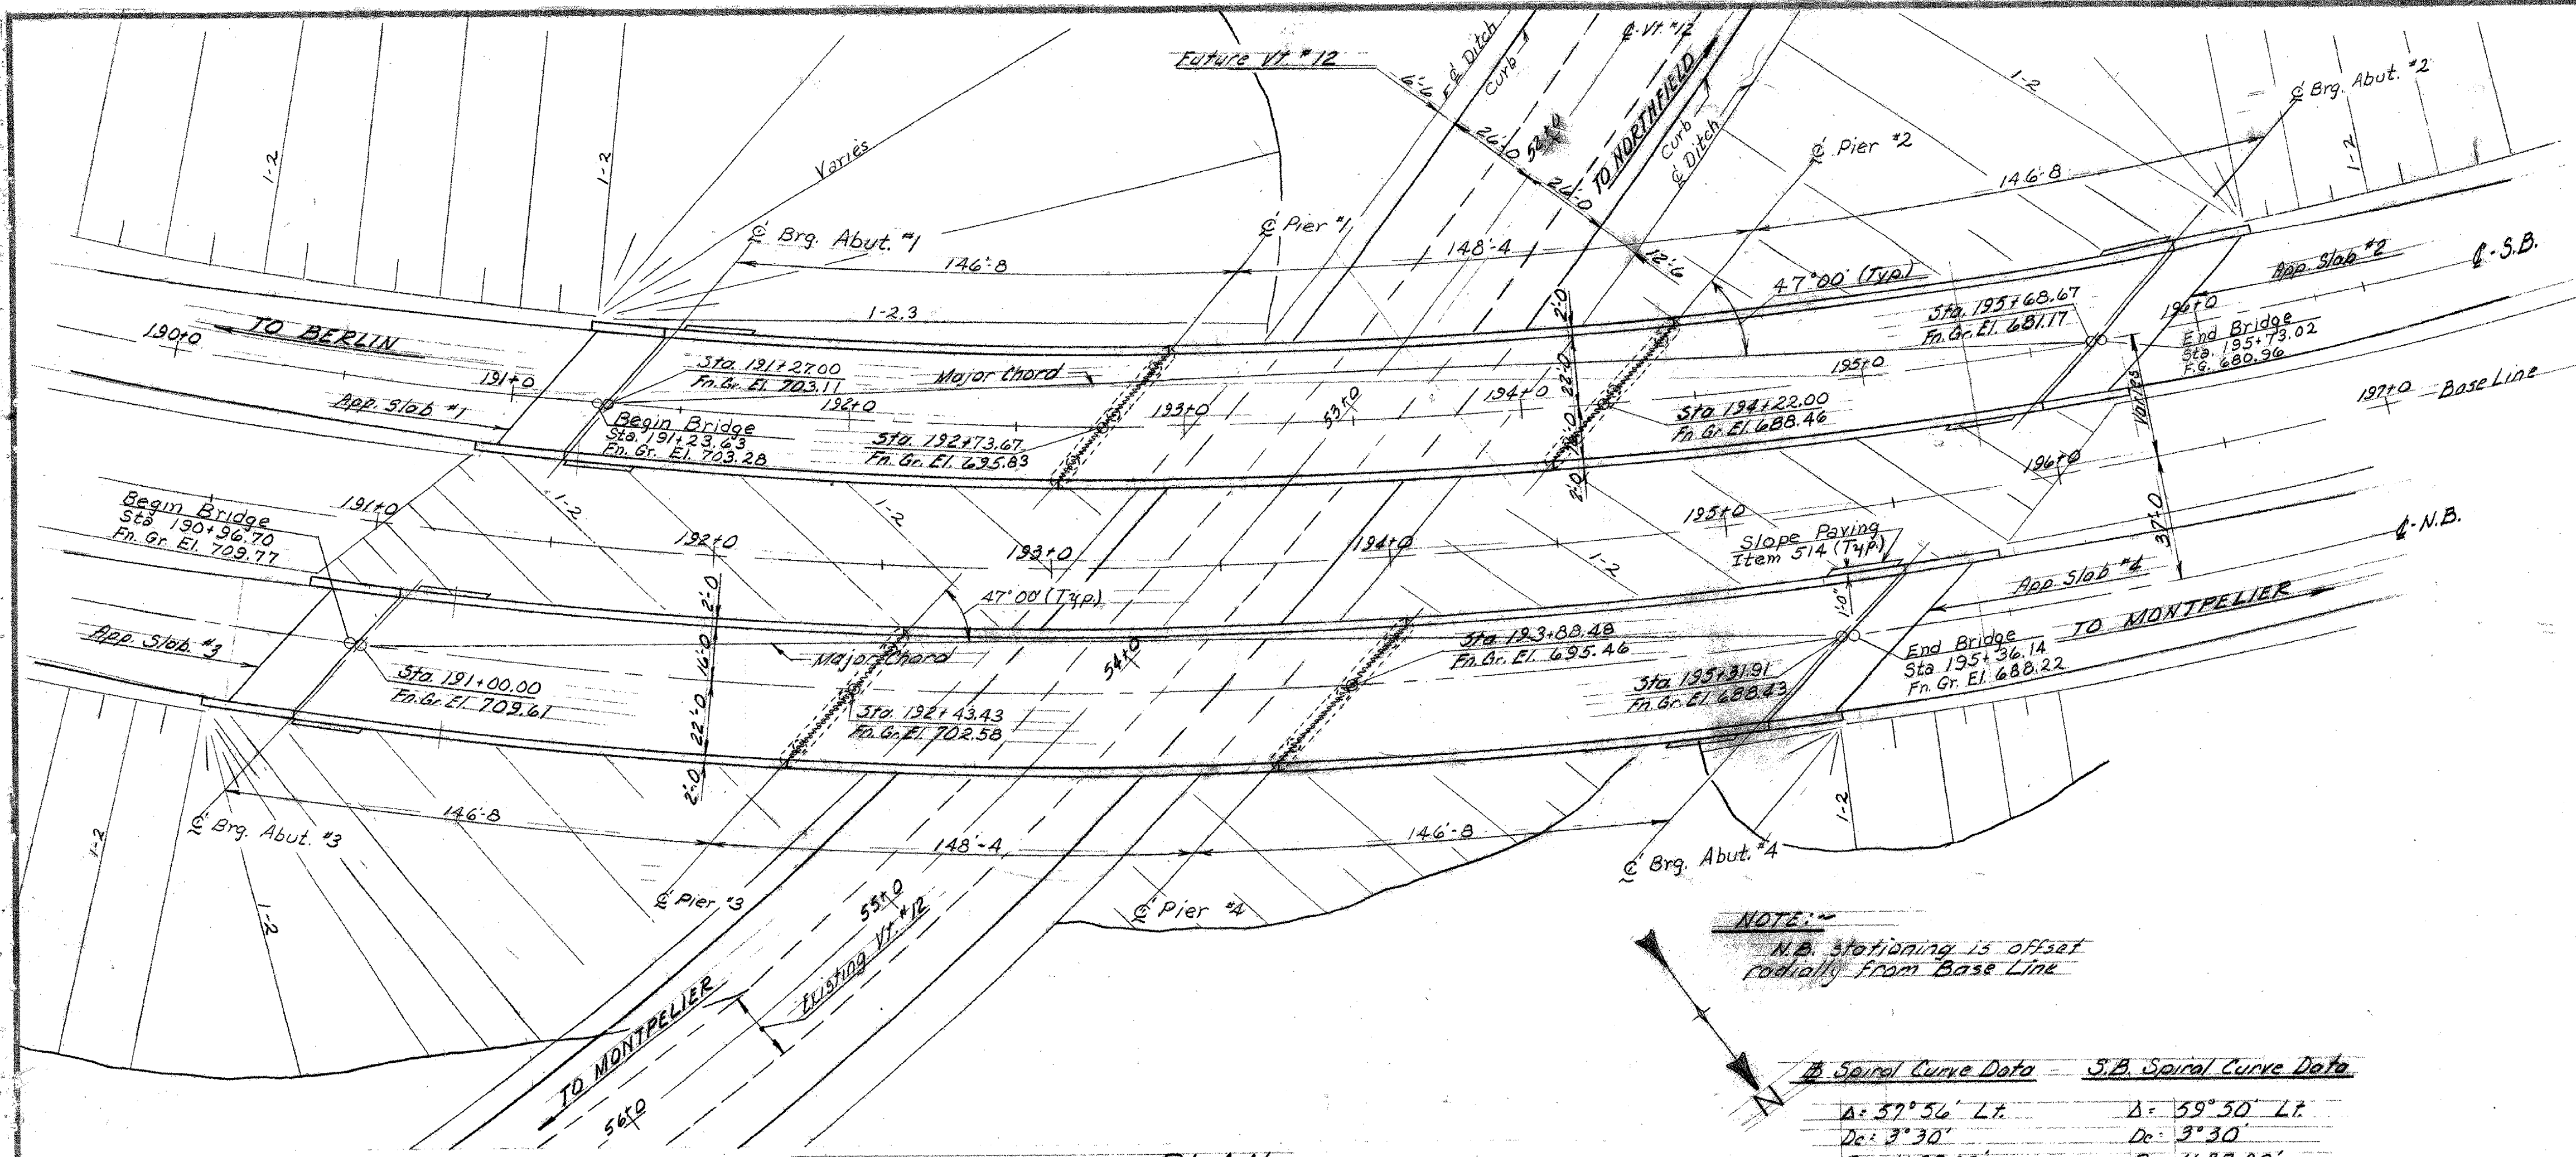

**PLAN**  
SCALE 1/4" = 30 FT.

**NOTE:**  
N.B. Stationing is offset radially from Base Line

S.A. Spiral Curve Data		S.B. Spiral Curve Data	
$\Delta = 57^{\circ}56'$	L.P.	$\Delta = 59^{\circ}50'$	L.P.
$D_c = 3^{\circ}30'$		$D_c = 3^{\circ}30'$	
$R_c = 1637.02'$		$R_c = 1637.02'$	
$B_s = 7^{\circ}00'$		$B_s = 7^{\circ}00'$	
$\Delta_c = 43^{\circ}56'$		$\Delta_c = 45^{\circ}50'$	
$E_s = 238.72'$		$E_s = 256.36'$	
Bank = 15%/ft.		Bank = 15%/ft.	

**GENERAL NOTES**

- For additional General Notes see Std. Sh. SCB-D1-67.
- Elevation Datum is sea level based on nearest U.S. Government vertical control.
- All Piling shall be steel 12BP53. Piling for Abut. #2 shall be driven to point bearing on ledge. Piling for all other substructure units shall be driven to such depth as is determined by Pile Loading Tests to be required to develop bearing of 45 tons per pile, except that all Piles shall penetrate 10 Ft. minimum into existing ground regardless of bearing capacity.
- Where bottom of Footing elevation is above old ground, Fill is to be placed 0.5 feet above bottom of Footing elevation before Piles are driven. Excavation of this material to bottom of Footing elevation after piles are driven shall be paid for as Structure Excavation, Item 109.
- Superstructure and Pier Column and Cap concrete shall be Class AA, Mod. All other concrete shall be Class B, Mod.
- Bridge railing is to be as detailed on Std. Sheet SB-R1-64, Sh. 1 of 2 of 2, or SB-R2-65. Post spacing shall not exceed maximum shown on Standards.
- Wing Wall sections are not to be placed above adjacent bridge seat elevation until beams have been profiled and final grade determined by the Engineer.
- Water Repellent, Item 440, shall be used as follows:  
Abutments & Wings - All exposed surfaces not otherwise treated.  
Piers - Columns above grade; sides, ends, and bottoms of Pier Caps  
Superstructure - Top of concrete curb, fascia, and bottom of deck from fascia to exterior beam.
- For details of construction joints see Std. SCB-D6-67, Det. B.
- Scuppers are to be placed as detailed on BR. 413.
- All bridge geometry at Abutments #2 and #4 bridge ends is based on an extension of the S.B. and Base Line curves beyond the C.S. rather than on the true spiral Q.

**LIST OF BRIDGE SHEETS**

- BR. 400 Plan and Elevation
- 401 Quantity Sheet
- 402 Preliminary Information
- 403-405 Borings
- 406 Typical Section of Curb and Railing Plan.
- 407, 408 S.B. Framing Plans
- 409, 410 N.B. Framing Plans
- 411 Girder and Bracing Details
- 412, 413 Expansion Dam and Drainage Details
- 414 Bearing Devices and Girder Gumpers
- 415-418 Abutments #1 thru #4
- 419-422 Piers #1 thru #4
- 423 Approach Slabs
- BR. 424-427 Reinforcing Schedules


**ROADWAY REFERENCE SHEETS**

- I 89 Profile Sheet Sta. 185+0 - 201+0
- I 89 Plan Sheet Sta. 185+0 - 201+0
- I 89 Base Line Sections Sta. 190+50 - 196+0
- I 89 Southbound Sections Sta. 190+50 - 196+0
- Rte. #12 Sections Sta. 49+50 - 56+50

**STANDARD SHEETS**

- SCB-D1-67 1-24-68
- SCB-D6-67, Det. A, B, F 1-24-68
- SB-R1-64 Sh. 1 of 2 11-31-68R
- SB-R1-64 Sh. 2 of 2 11-31-68R
- SB-R2-65 11-31-68R

Note: All 12BP53 Steel Piles are to be driven to a 45 ton bearing capacity. (See Note #3)

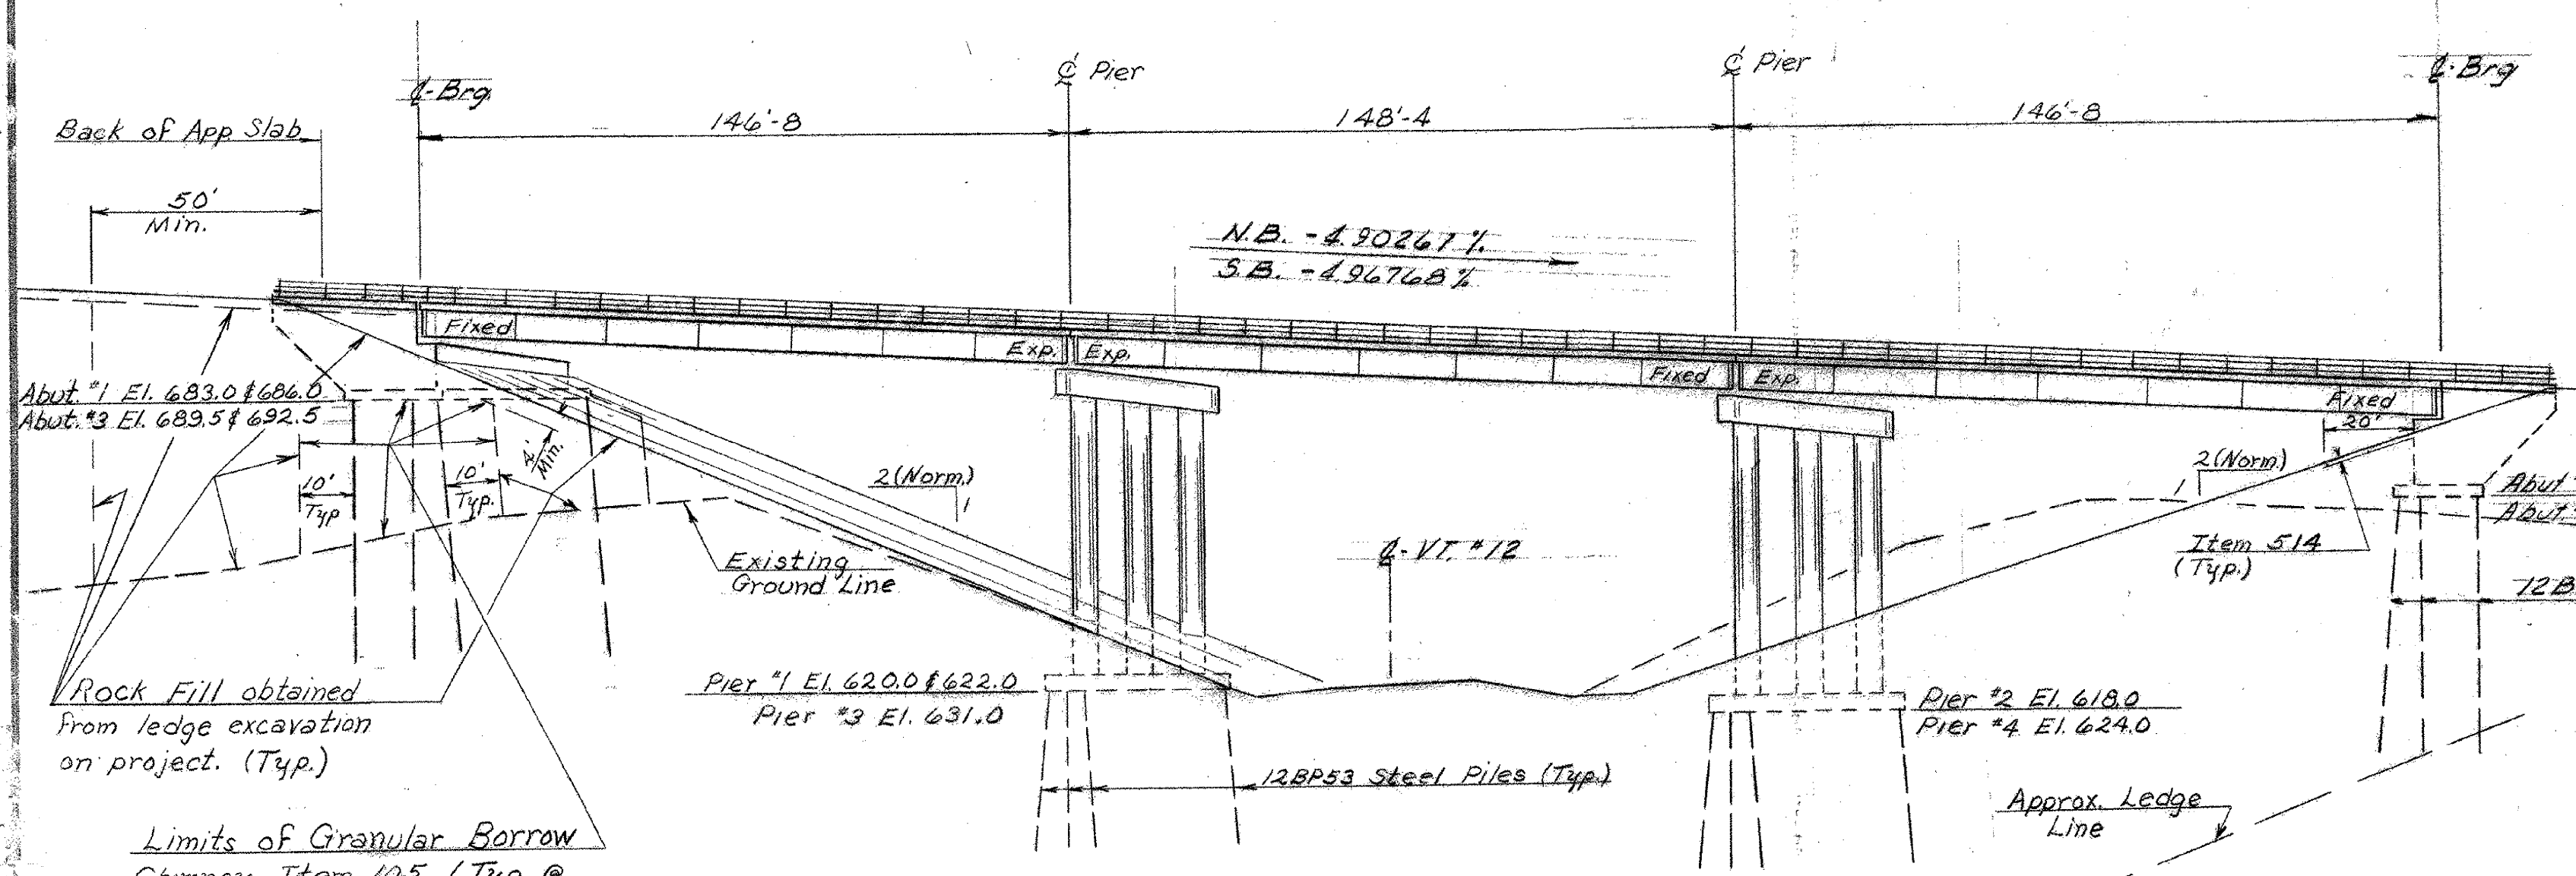

**ELEVATION - N.B. FASCIA**  
SCALE 1/4" = 30 FT.

Limits of Granular Borrow Chimney, Item 105 (Typ. @ All Abutments.) See I 89 Sections For Additional Details.

THIS SHEET FOR REFERENCE ONLY  
BERLIN 1M 089-1(20)  
BRIDGES 40 N&S  
SHEET 81 OF 104

**STATE OF VERMONT**  
DEPARTMENT OF HIGHWAYS

**PROJECT: - BERLIN-MONTPELIER**  
**TOWNS OF BERLIN & MONTPELIER**

**ROUTE No. I-89**      **STA. 195+50**

**I-89 OVER VI. RTE. 12**

**PLAN AND ELEVATION**



SCALE  $\frac{1}{4}'' = 30'$

**IN CHARGE** W. Smith

**DRAWN BY** P. Doherty **CHECKED BY** F. Gilman  
E.W. Tripp      W. Smith


**PROJECT No. I-89-1(12)**

**SHEET 131 OF 197**      **BR. 400**

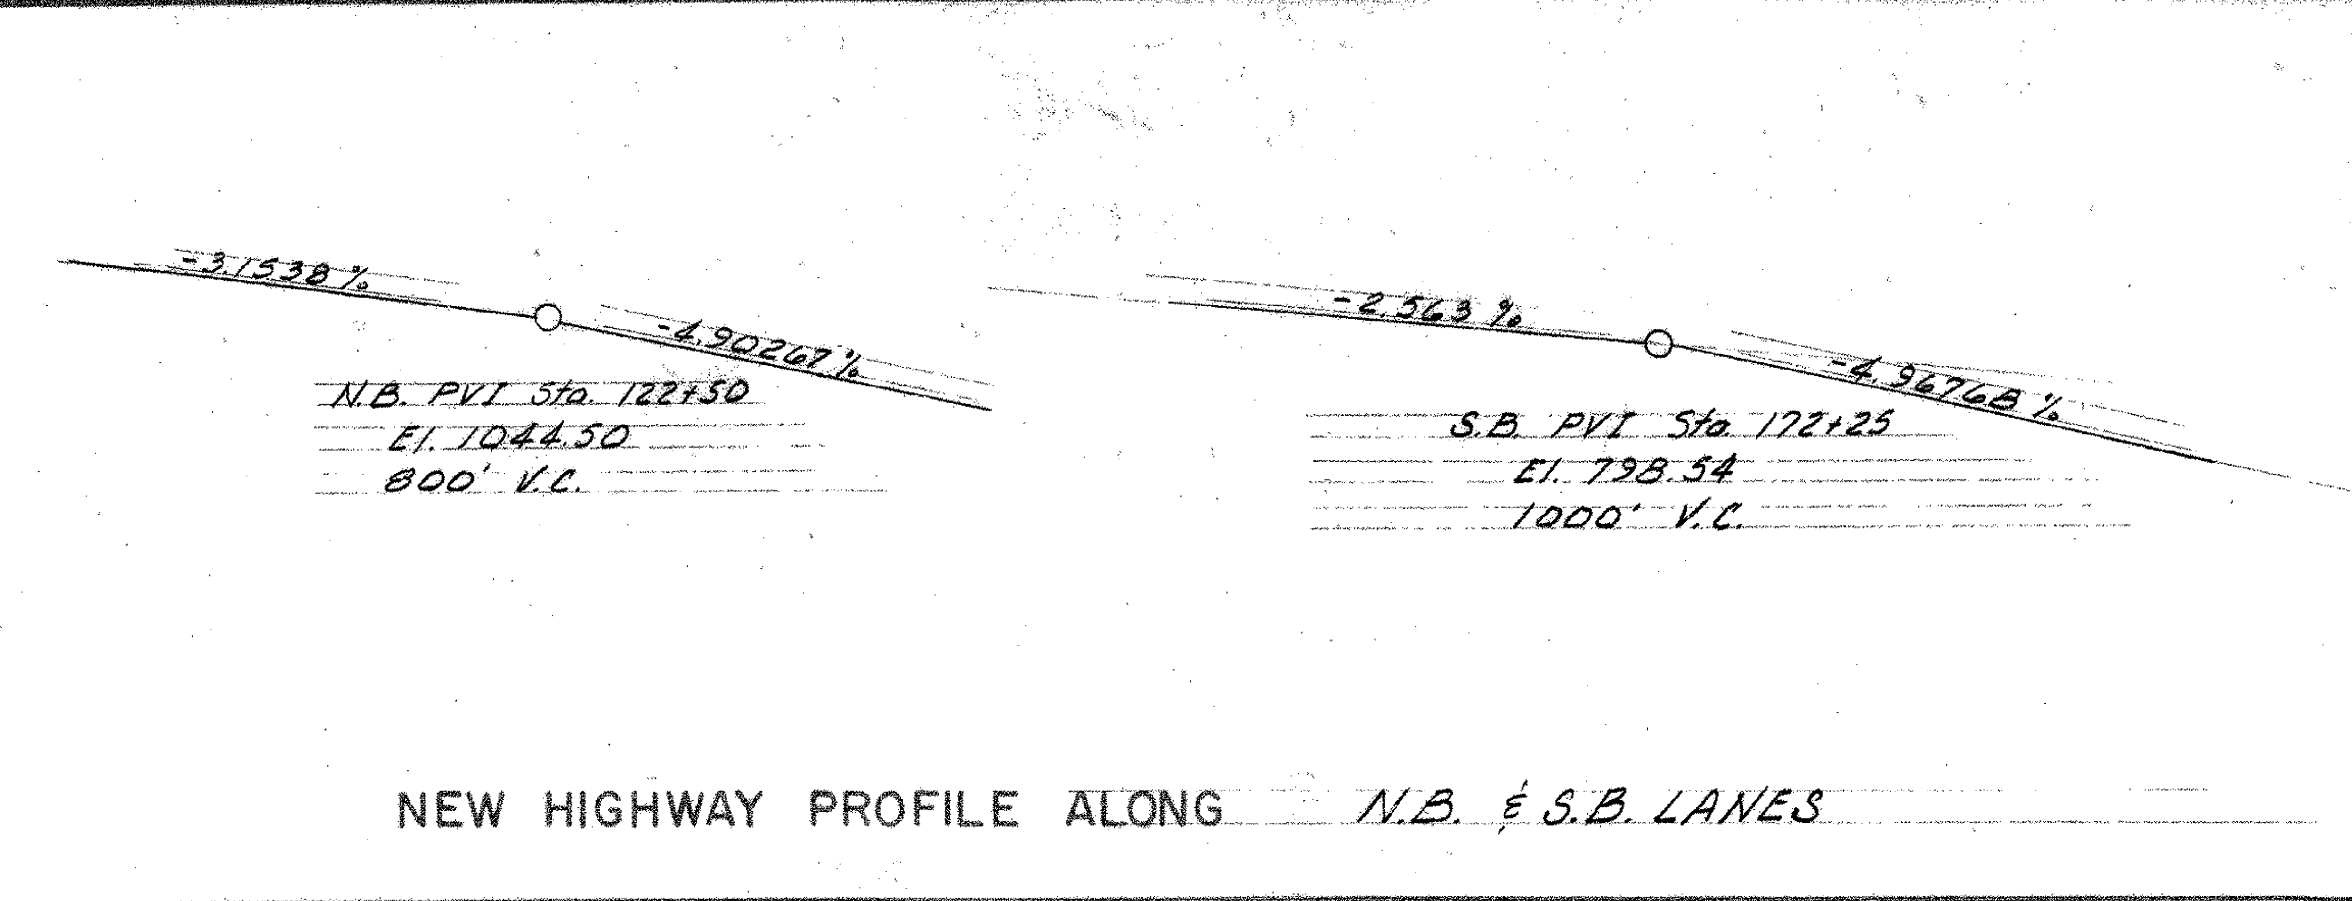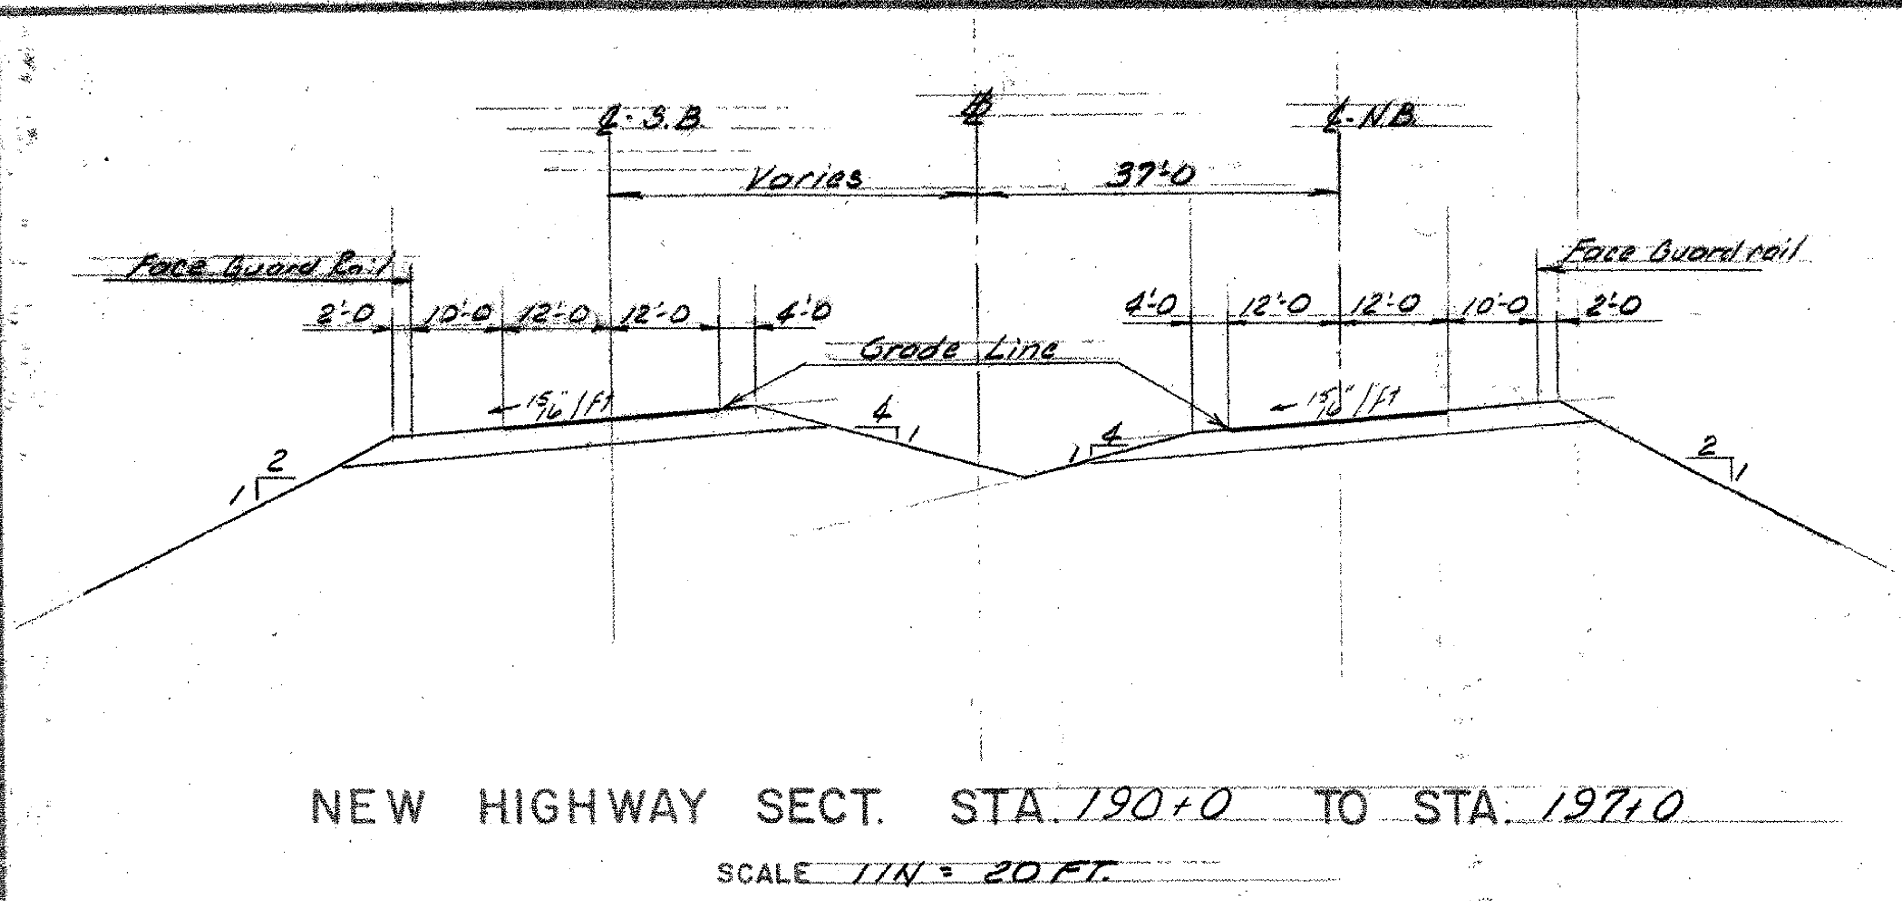


HIGHWAY NO. I-89 NAME OF HIGHWAY Interstate  
 STRUCTURE NO. \_\_\_\_\_ COUNTY Washington TOWNS Berlin & Montpelier  
 PROJECT NO. I-89-1(12) LOCATION I-89 over VT. RTE. 12

- ### EXISTING STRUCTURE
1. RATED LOADING OF EXISTING STRUCTURE \_\_\_\_\_
  2. TYPE OF EXISTING STRUCTURE \_\_\_\_\_
  3. UNDERCLEARANCE ELEVATION OF EXISTING STRUCTURE \_\_\_\_\_
  4. WHAT DISPOSITION SHOULD BE MADE OF EXISTING STRUCTURE? \_\_\_\_\_ COST OF REMOVAL \_\_\_\_\_
  5. SHOULD EXISTING STRUCTURE BE USED TO MAINTAIN TRAFFIC DURING CONSTRUCTION OF NEW STRUCTURE? \_\_\_\_\_
  6. SHOULD NEW TEMPORARY STRUCTURE BE BUILT? \_\_\_\_\_
  7. ORDINARY HIGH WATER SURFACE ELEV. AT EXISTING STRUCTURE \_\_\_\_\_ WATERWAY TO ORDINARY H.W. \_\_\_\_\_
  8. EXTREME HIGH WATER AT EXISTING STRUCTURE \_\_\_\_\_
  9. SPAN OF EXISTING BRIDGE UPSTREAM \_\_\_\_\_ WATERWAY TO EXTREME H.W. \_\_\_\_\_  
 SPAN OF EXISTING BRIDGE DOWNSTREAM \_\_\_\_\_ WATERWAY TO EXTREME H.W. \_\_\_\_\_
  10. TYPE OF FOUNDATION UNDER EXISTING ABUTMENTS \_\_\_\_\_
  11. DOES ALL WATER AT FLOOD ELEVATION PASS THROUGH EXISTING STRUCTURE? \_\_\_\_\_
  12. IF NOT AT WHAT ELEVATION IS RELIEF AFFORDED? \_\_\_\_\_
  13. ADDITIONAL WATERWAY AREA PROVIDED \_\_\_\_\_

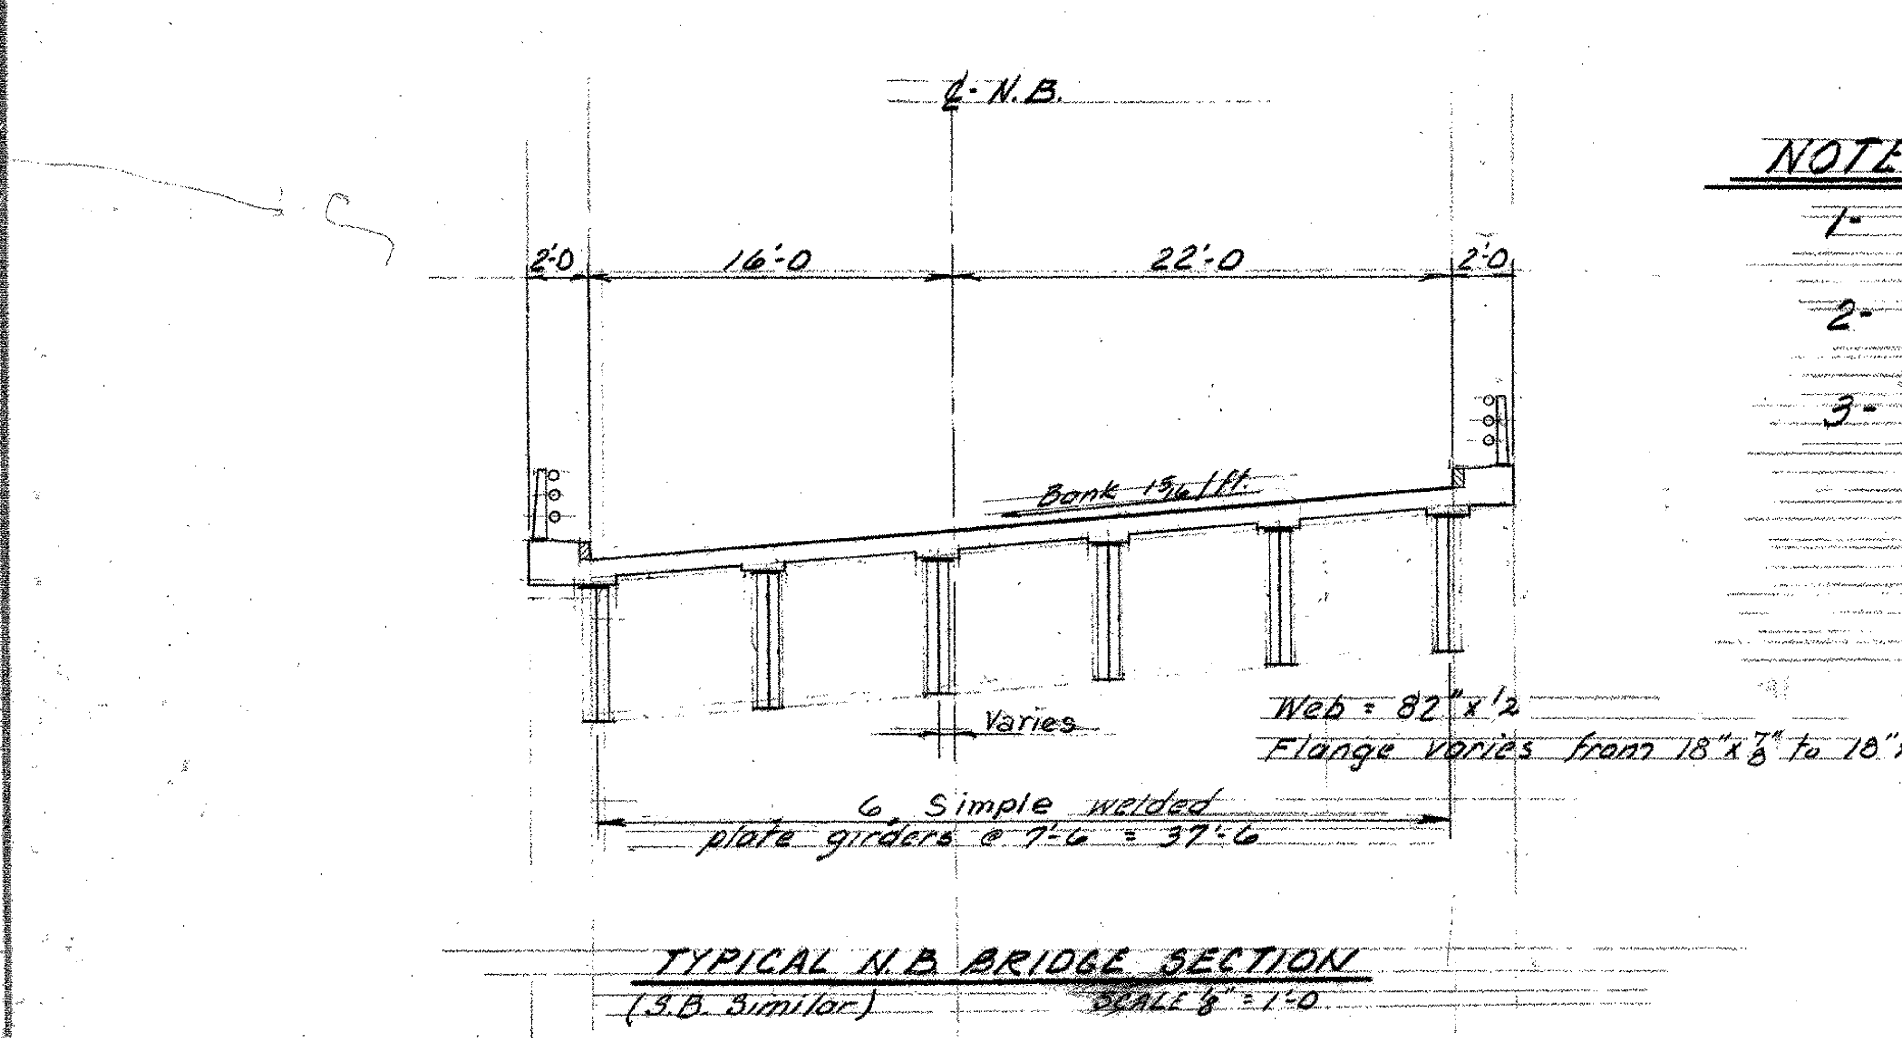


**NOTES:**

- 1- For general notes and allowable design stresses see SCB-DI-67.
- 2- For additional details of superstructure see BR. 406.
- 3- For details of railing see SB-R1-64 & SB-R2-65.

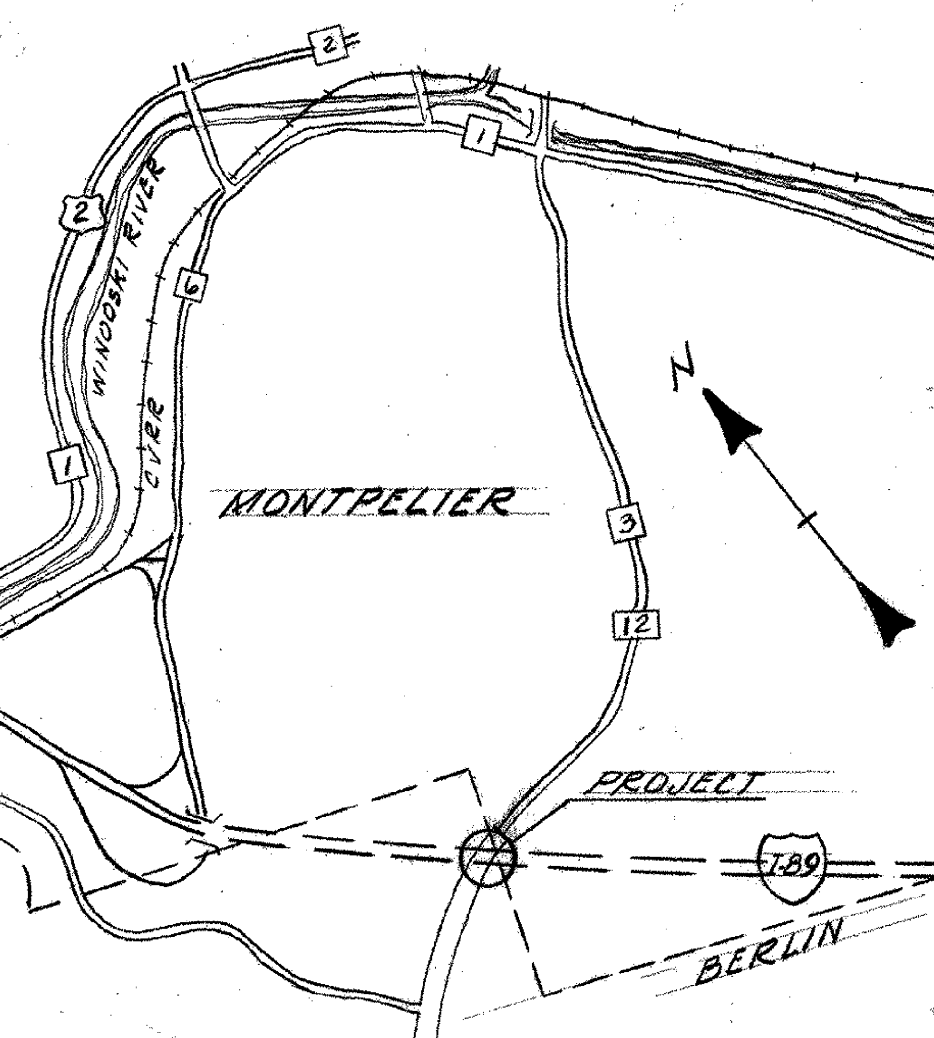

- ### NEW STRUCTURE
1. RECOMMENDED TYPE OF STRUCTURE Simple Composite A. Girders
  2. RECOMMENDED CLEAR SPAN OR SPANS 145' - 145' - 145' c.c. Bearings
  3. MEASURED PARALLEL TO & NEW HIGHWAY \_\_\_\_\_
  4. MEASURED AT RIGHT ANGLES TO & STREAM \_\_\_\_\_
  5. ARE THERE OBJECTIONS TO A PIER IN THE STREAM? ANSWER YES OR NO \_\_\_\_\_
  6. ORDINARY HIGH WATER ELEVATION AT NEW STRUCTURE \_\_\_\_\_
  7. EXTREME HIGH WATER ELEVATION AT NEW STRUCTURE \_\_\_\_\_ SOURCE OF INFORMATION \_\_\_\_\_
  8. IS ALL WATER INTENDED TO PASS THROUGH NEW STRUCTURE? \_\_\_\_\_
  9. DOES STREAM REACH ITS MAXIMUM HIGH WATER ELEVATION RAPIDLY? \_\_\_\_\_ IS ORDINARY RISE RAPID? \_\_\_\_\_
  10. LOW WATER ELEVATION AT NEW STRUCTURE \_\_\_\_\_
  11. DRAINAGE AREA IN ACRES ABOVE STRUCTURE \_\_\_\_\_ CHARACTER OF TERRAIN \_\_\_\_\_
  12. IS STREAM EVER DRY \_\_\_\_\_
  13. VELOCITY OF STREAM AT HIGH WATER STAGE \_\_\_\_\_ ESTIMATED DISCHARGE \_\_\_\_\_
  14. AREA FULL OPENING \_\_\_\_\_ AREA BELOW ORDINARY H.W. \_\_\_\_\_
  15. CHARACTER OF SCOUR \_\_\_\_\_ DRIFT \_\_\_\_\_ ICE \_\_\_\_\_
  16. ESTIMATED DRAINAGE AREA ABOVE NATURAL OR ARTIFICIAL STORAGE \_\_\_\_\_
  17. VERTICAL CLEARANCE ABOVE FLOOD ELEVATION \_\_\_\_\_
  18. ARE SIDEWALKS REQUIRED? IF SO ON WHAT SIDE? No BOTH SIDES \_\_\_\_\_
  19. RECOMMENDED TYPE OF PAVEMENT Reinforced concrete with 2" bituminous surface
  20. TRAFFIC TO BE MAINTAINED UNDER ITEM NO. III ONE OR TWO WAYS 2 PROBABLE COST \_\_\_\_\_
  21. PROBABLE COST OF CLEARING AND GRUBBING STREAM CHANNEL AT STRUCTURE SITE \_\_\_\_\_
  22. SHOULD PROVISIONS BE MADE FOR PUBLIC UTILITIES? No
  23. ESTIMATED ALLOWABLE LOAD ON FOUNDATIONS 45 Tons/1/2 File SHOULD PILES BE USED? Yes EST. LGTH. See Table

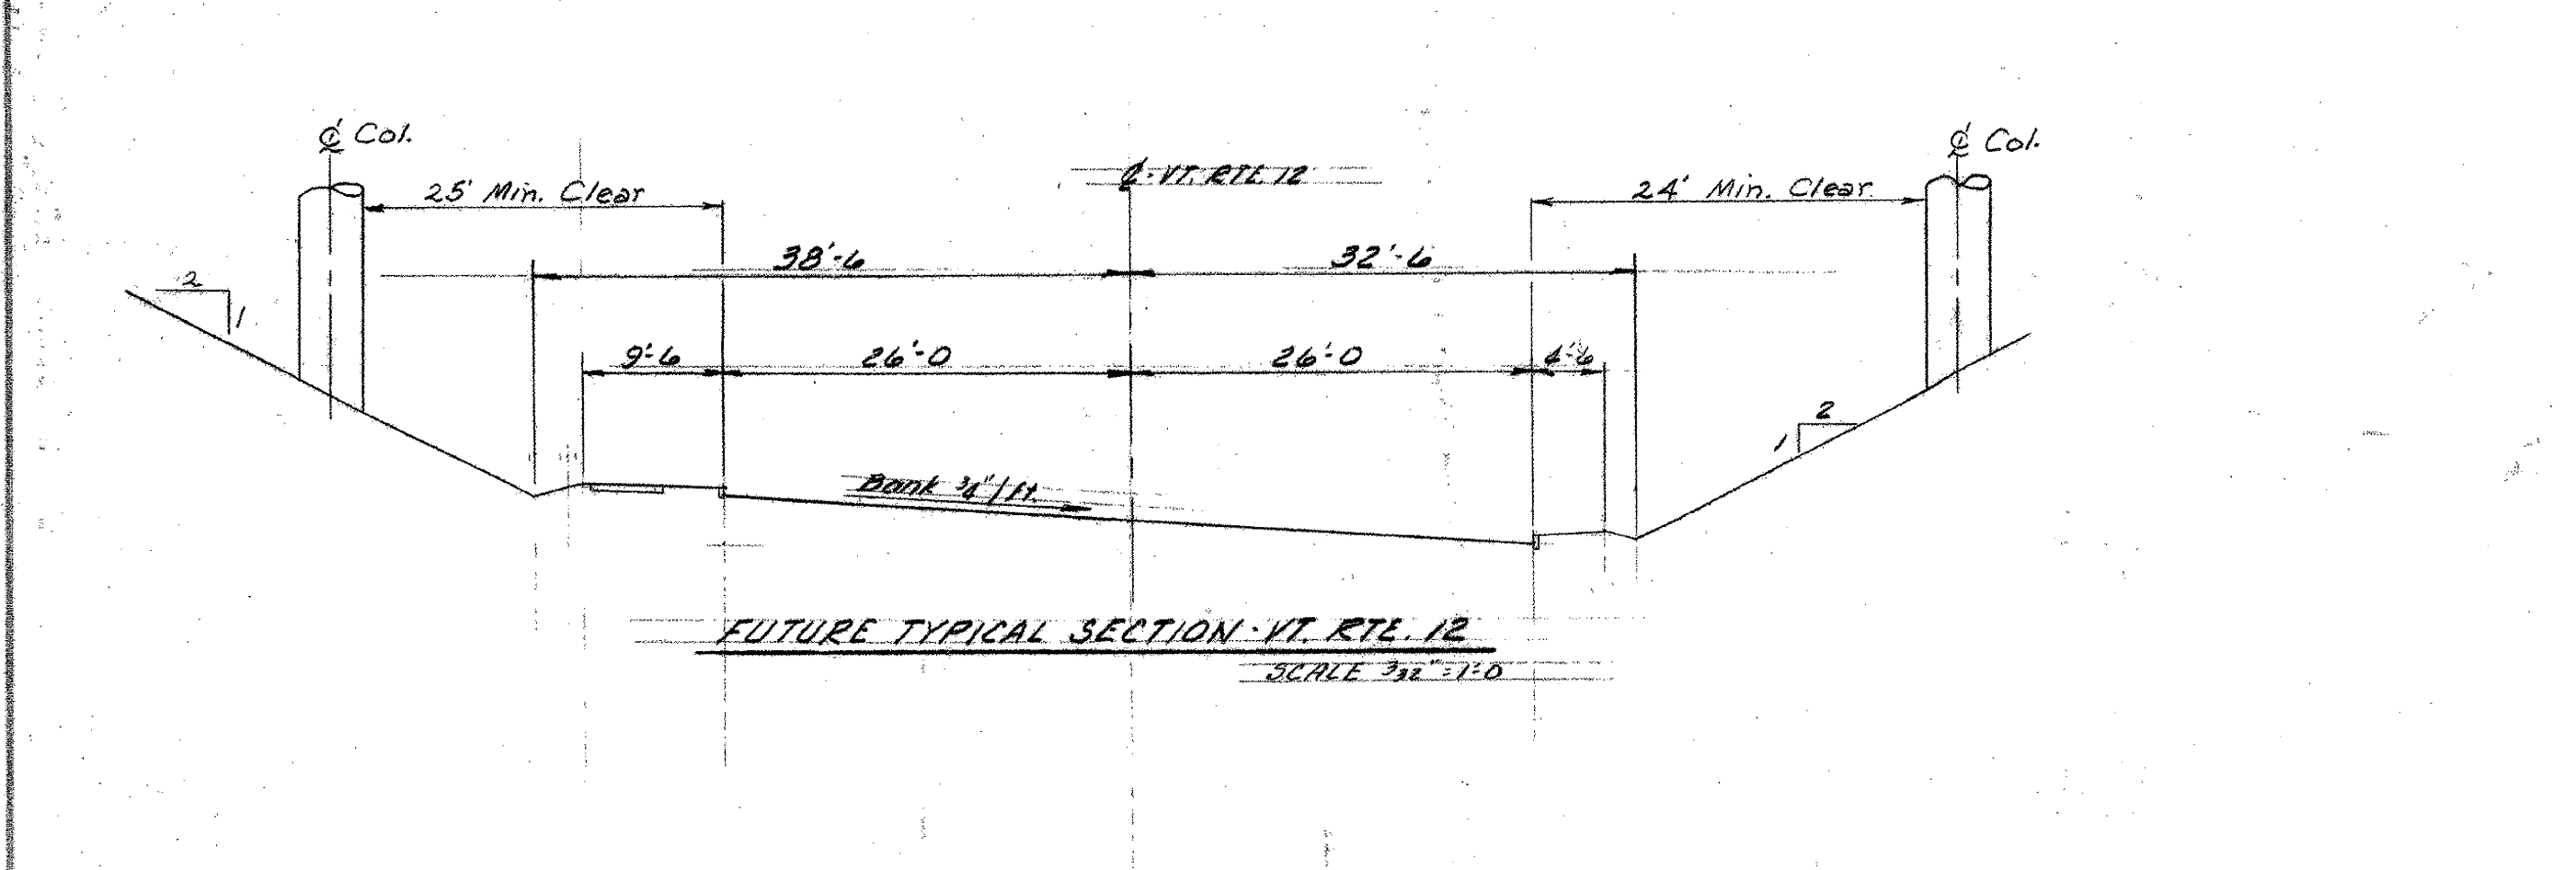


**ESTIMATED PILE LENGTHS (12 B.P. 53)**

Abut. No. 1	50'
Abut. No. 2	25'
Abut. No. 3	55'
Abut. No. 4	40'
Pier No. 1	35'
Pier No. 2	25'
Pier No. 3	30'
Pier No. 4	30'

### FOUNDATION INFORMATION

OBTAINED FOR DESIGN PURPOSES ONLY, AND THE STATE ASSUMES NO RESPONSIBILITY WHATSOEVER FOR THE SUFFICIENCY OR ACCURACY OF THE INFORMATION SHOWN. BOULDERS MAY BE ENCOUNTERED AT ANY PIER OR ABUTMENT LOCATION.

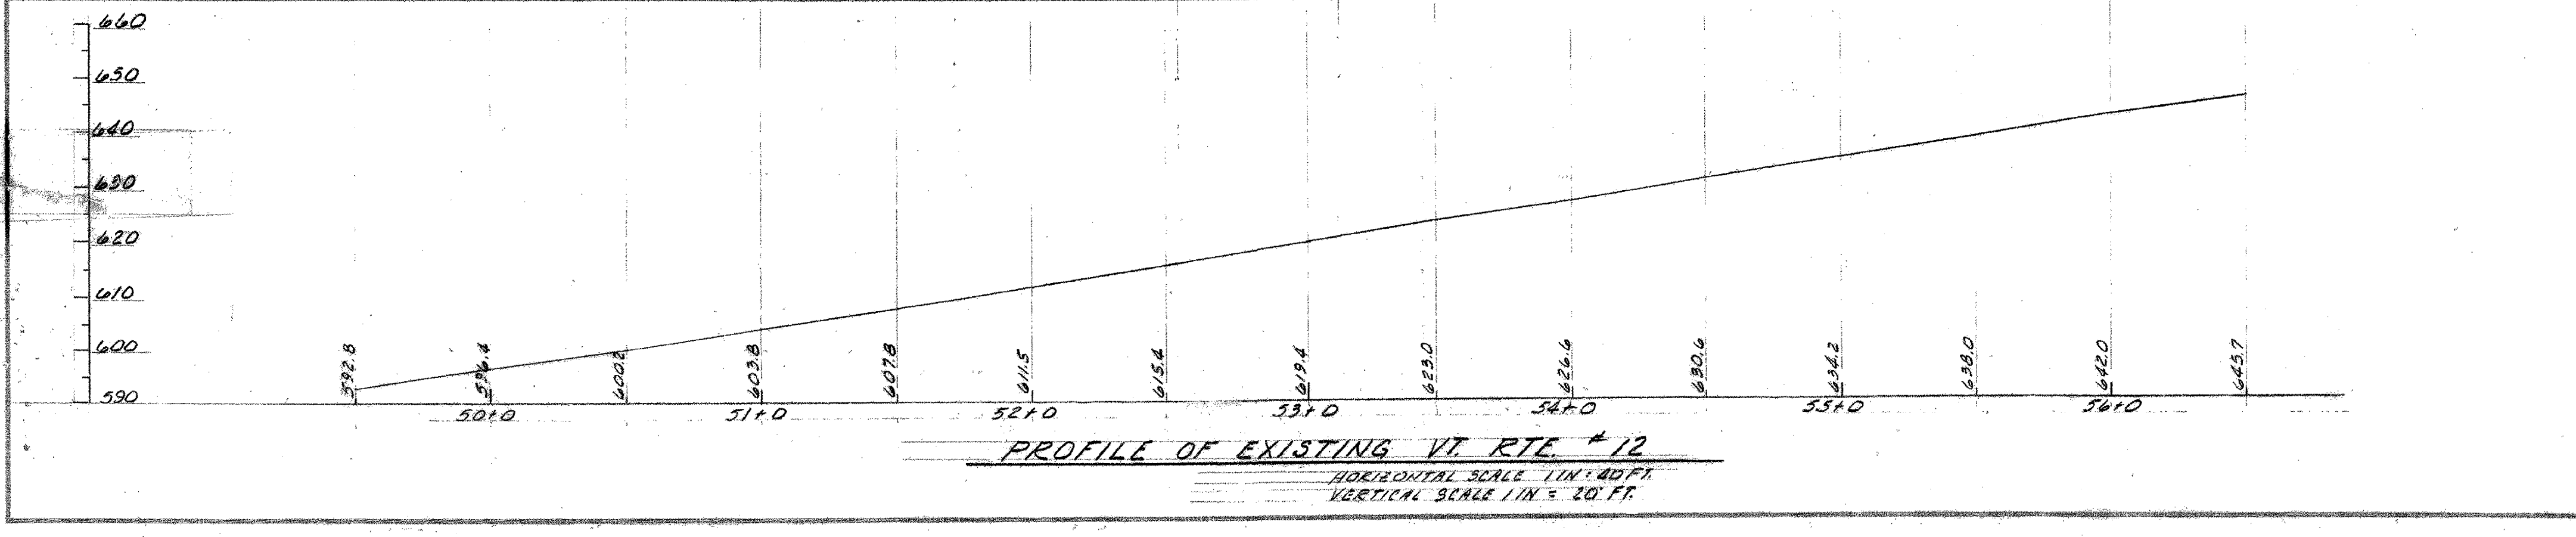

THIS SHEET FOR REFERENCE ONLY  
 BERLIN 1M 089-1(20)  
 BRIDGES 40 N&S  
 SHEET 82 OF 104

STATE OF VERMONT  
 DEPARTMENT OF HIGHWAYS

RECOMMENDED FOR APPROVAL: R. H. Frank 6/6/67  
 CHIEF ENGINEER DATE

RECOMMENDED FOR APPROVAL: Paul Brown 6/5/67  
 BRIDGE ENGINEER DATE

RECOMMENDED FOR APPROVAL: E. W. O'Leary 6/5/67  
 ASST. CHIEF ENGINEER DATE

APPROVED BY: R. W. Arnold 6/6/67  
 CHIEF ENGINEER DATE



INTERSTATE IN THE TOWNS OF  
BERLIN & MONTPELIER

ROUTE NO. I-89 STA. 793+50  
I-89 OVER VT. RTE. 12

PRELIMINARY INFORMATION

SURVEYED BY E. W. O'Leary CHECKED BY E. W. O'Leary SCALE AS SHOWN  
 DRAWN BY E. W. O'Leary IN CHARGE E. W. O'Leary DATE 6/6/67

PROJECT NO. I-89-1(12) SHEET 153 OF 197  
 BR. 402

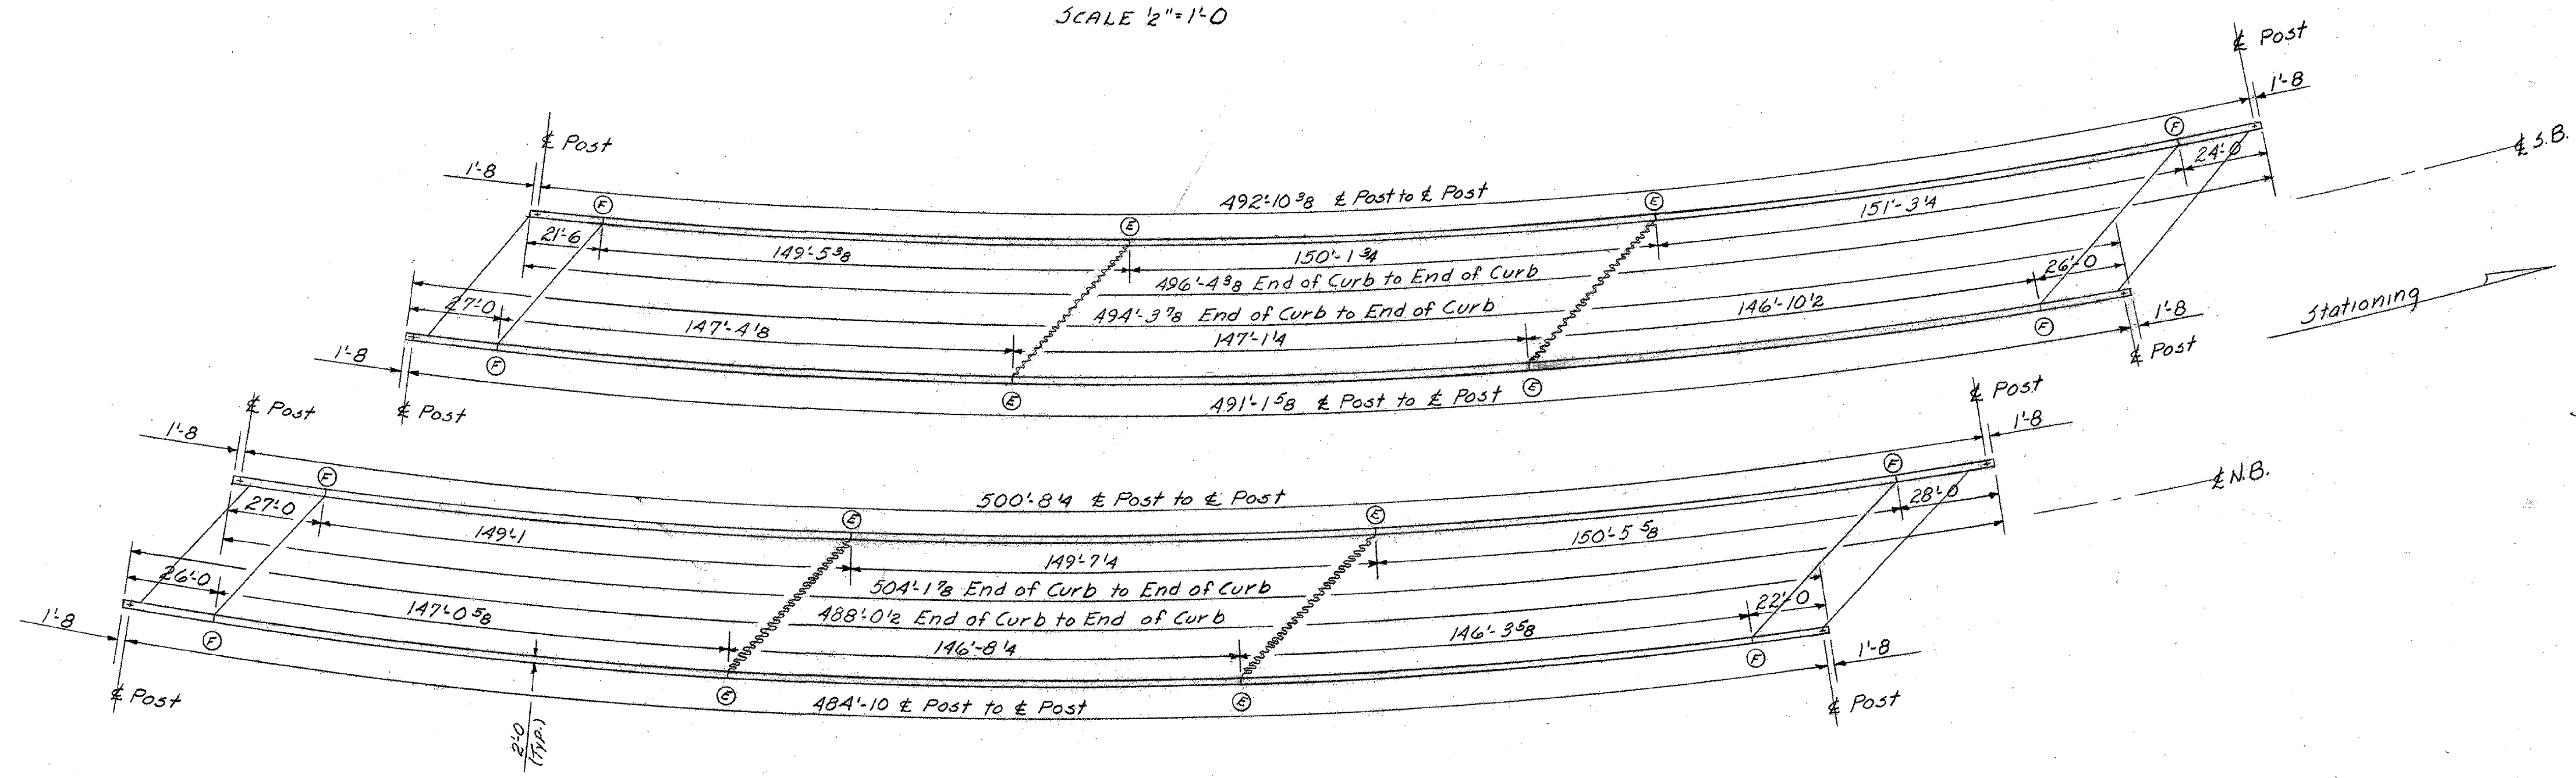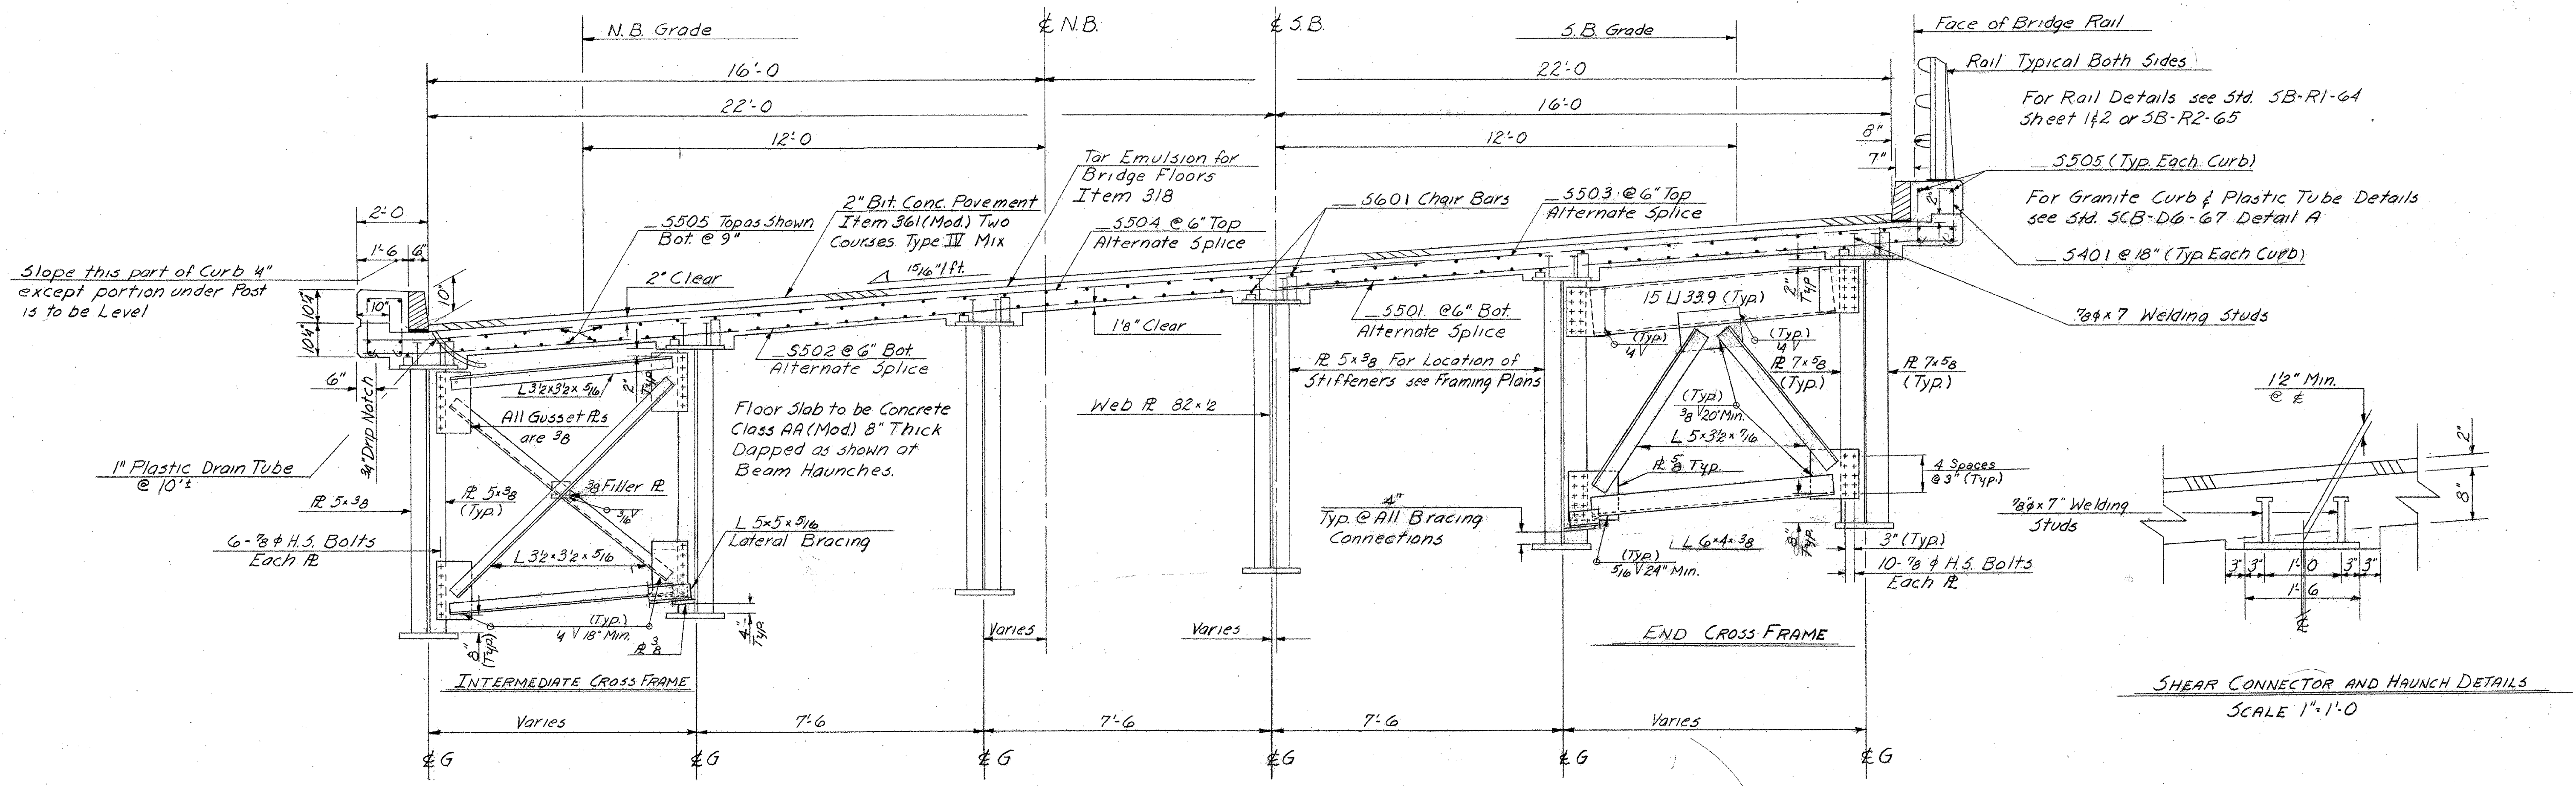

All Dimensions are Arc Dimensions  
 ⊙ Provide 3' expansion in railing across this joint  
 ⊙ Provide 3' expansion in railing across this joint


See BR 400 for General Notes

THIS SHEET FOR REFERENCE ONLY  
 BERLIN (M 089-120)  
 BRIDGES 40 N&S  
 SHEET 83 OF 104


**STATE OF VERMONT**  
 DEPARTMENT OF HIGHWAYS

PROJECT BERLIN-MONTPELIER  
 TOWNS OF BERLIN & MONTPELIER  
 ROUTE No. I-89 STA. 193+50'  
 I-89 OVER VT. RTE. #12

TYPICAL SECTION AND CURB & RAILING PLAN  
 SCALE AS SHOWN  
 IN CHARGE W. SMITH  
 DRAWN BY E. GILMAN CHECKED BY W. TRIPP  
 PROJECT No. I-89-1(12) 11-67  
 SHEET 157 OF 197 BR. 406

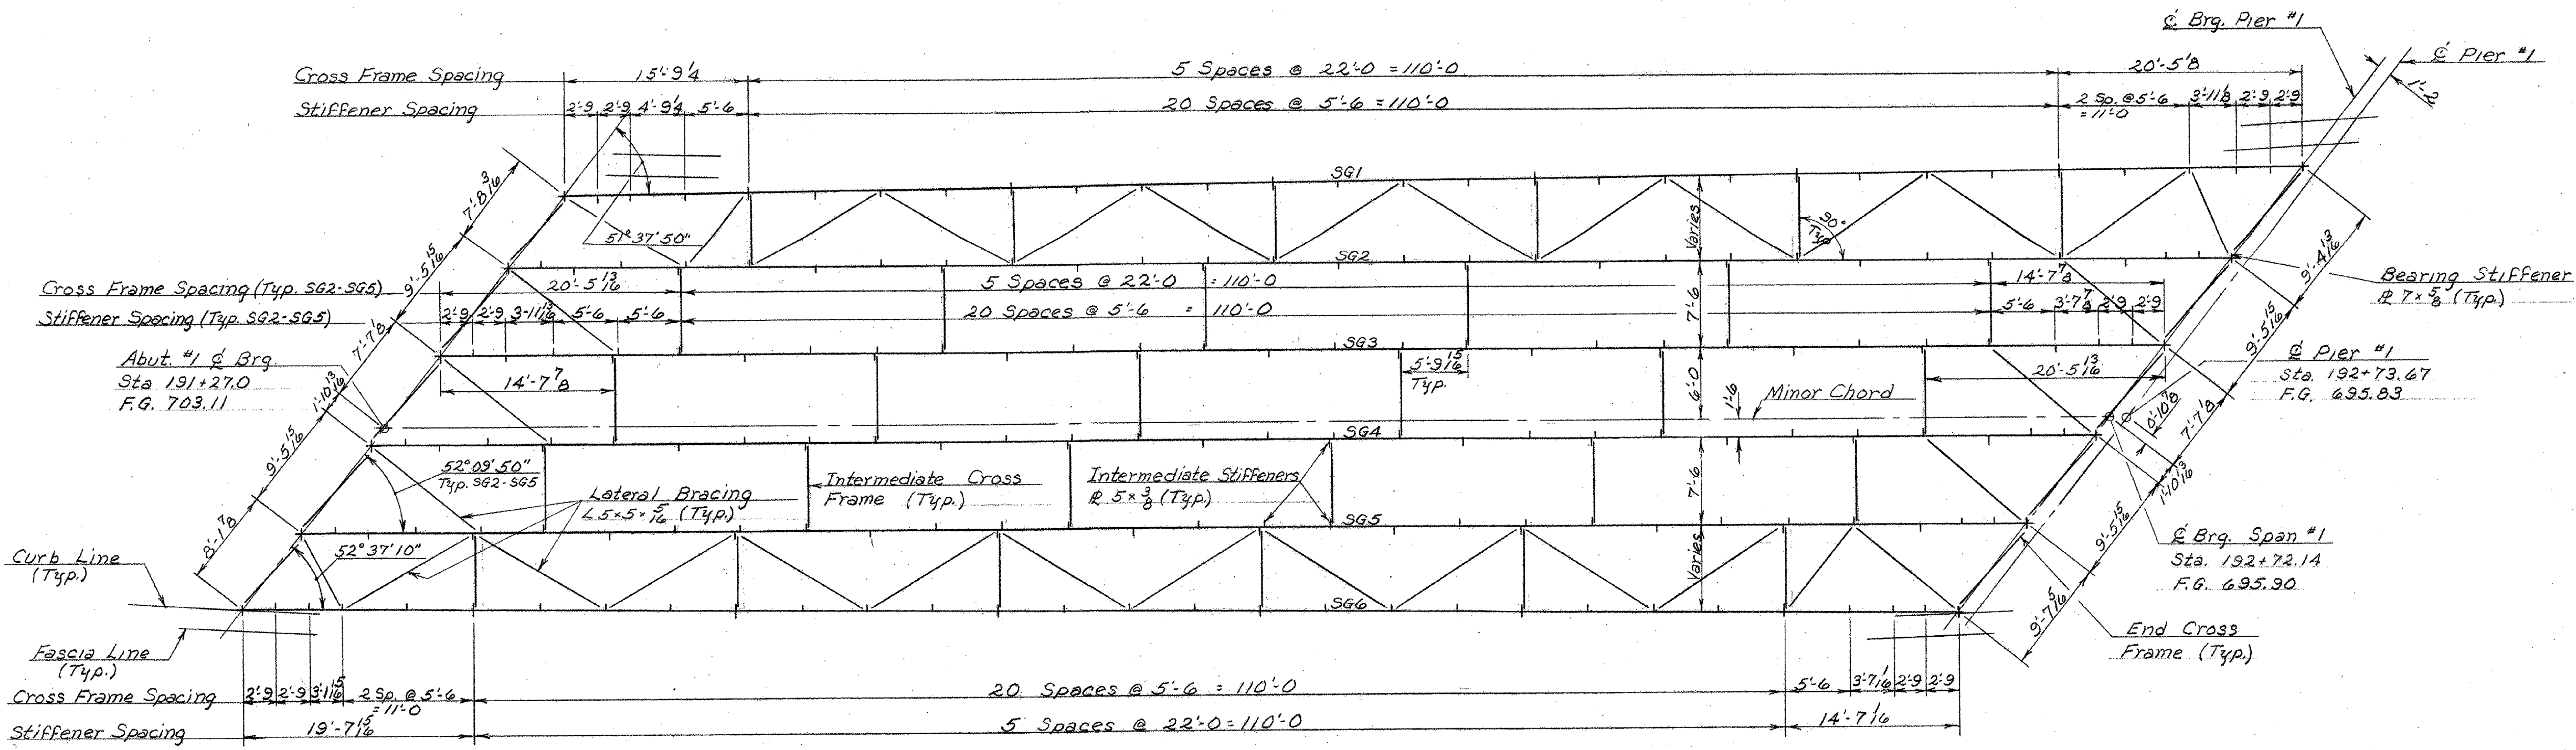

**S.B. SPAN #1 FRAMING PLAN**  
SCALE: 1/8" = 1'-0"

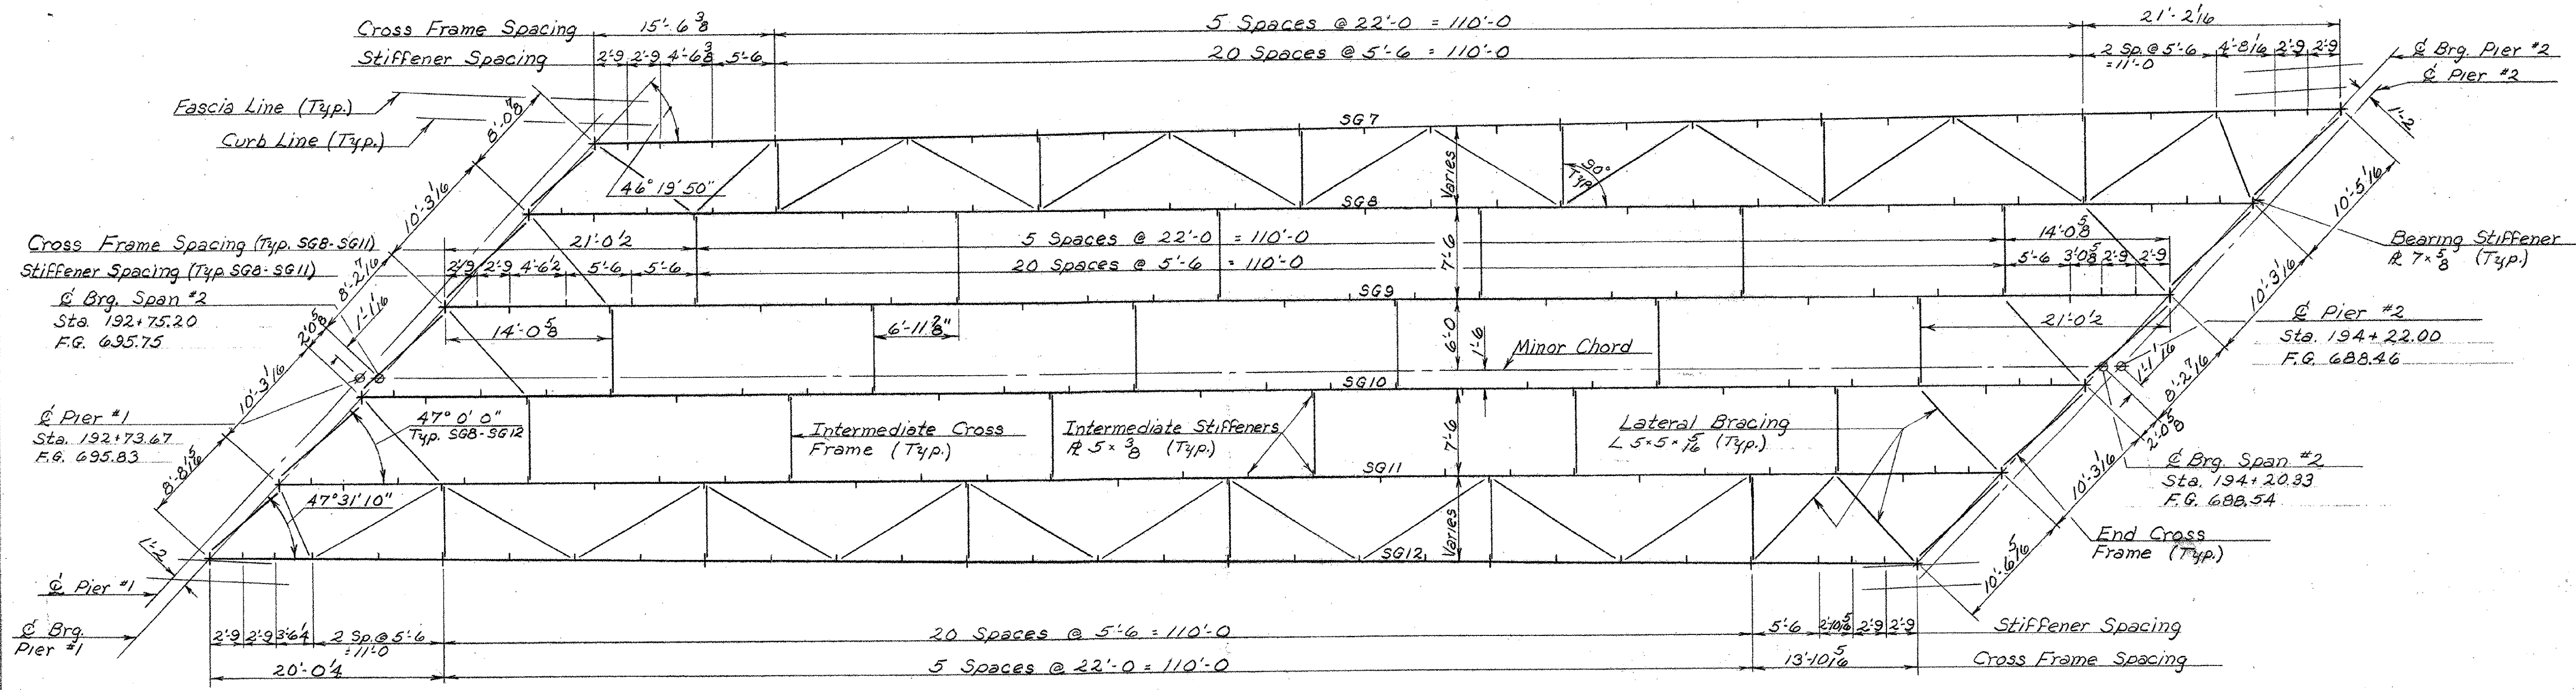


**S.B. SPAN #2 FRAMING PLAN**  
SCALE: 1/8" = 1'-0"

- NOTES**
1. See BR. 400 For General Notes.
  2. See BR. 408 For S.B. Girder Elevation.
  3. See BR. 411 For Framing Details.
  4. See BR. 406 For Intermediate and End Cross Frame details.


THIS SHEET FOR REFERENCE ONLY  
BERLIN 1089-1(CO)  
BRIDGES 40 N&S  
SHEET 84 OF 104

**STATE OF VERMONT**  
DEPARTMENT OF HIGHWAYS


PROJECT BERLIN-MONTPELIER  
TOWNS OF BERLIN & MONTPELIER  
ROUTE NO. I 89 STA. 193+50.2  
I 89 OVER VT. 12  
S.B. SPAN #1 & #2 FRAMING PLAN  
SCALE AS NOTED  
IN CHARGE W. SMITH  
DRAWN BY W. TRIPP CHECKED BY R. LADD  
PROJECT NO. I 89-1(12)  
SHEET 158 OF 197 BR. 407

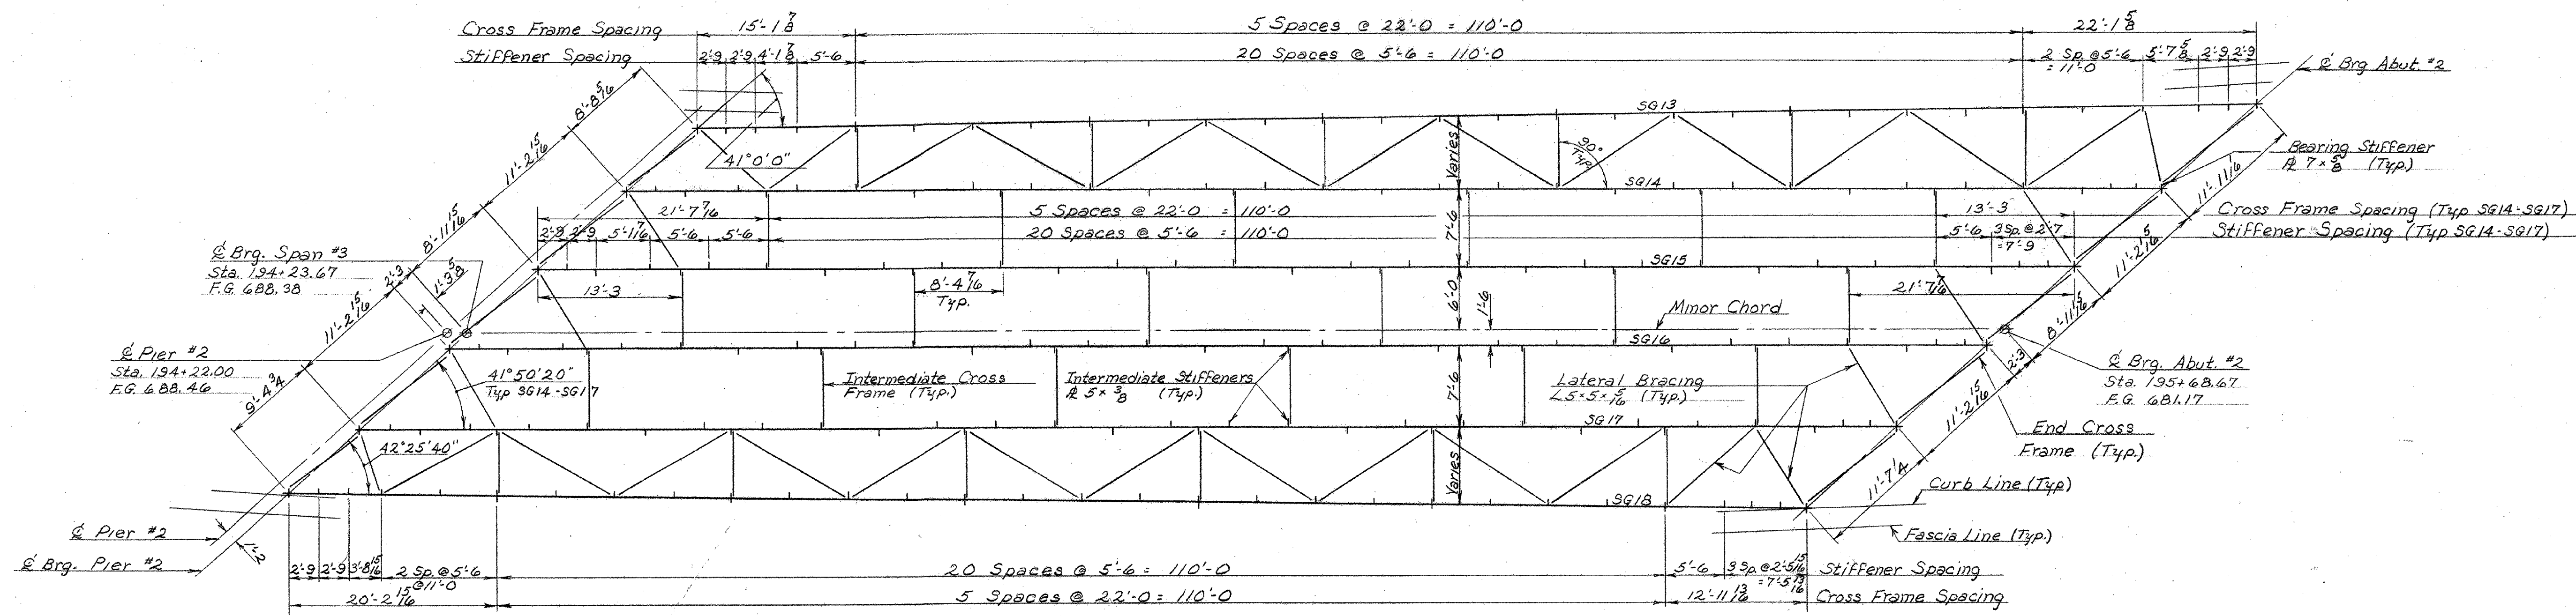

**S.B. SPAN #3 FRAMING PLAN**  
SCALE: 1/8" = 1'-0"

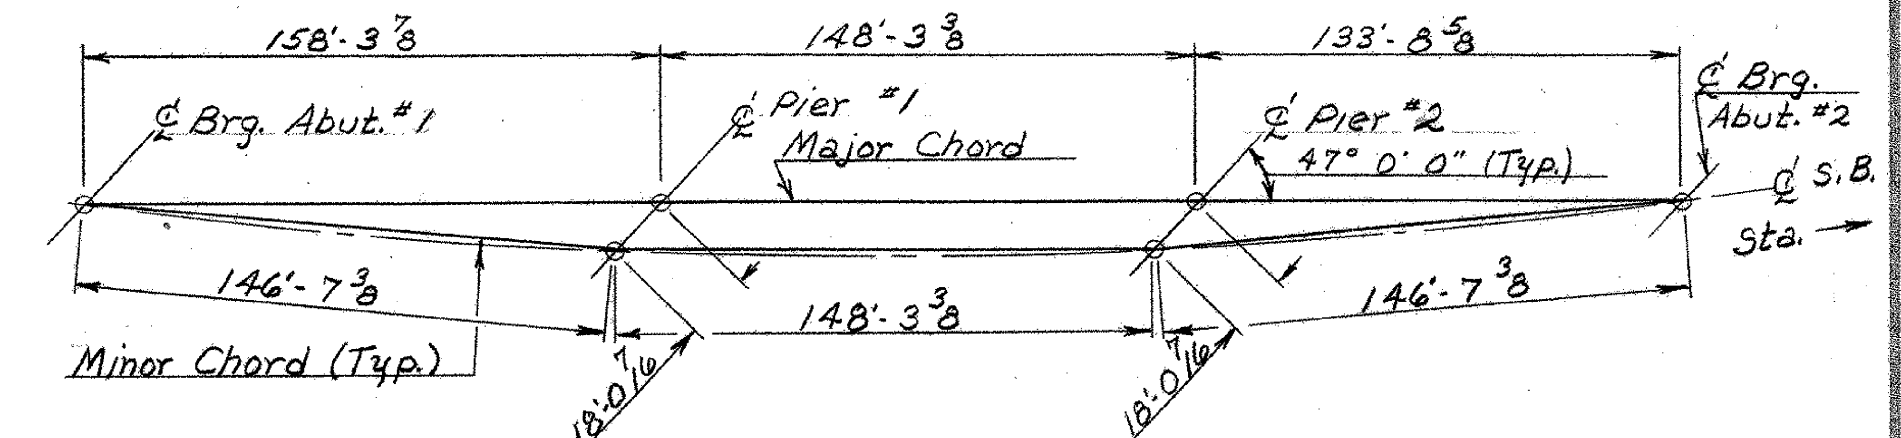

**S.B. CHORD LAYOUT**  
N.T.S.

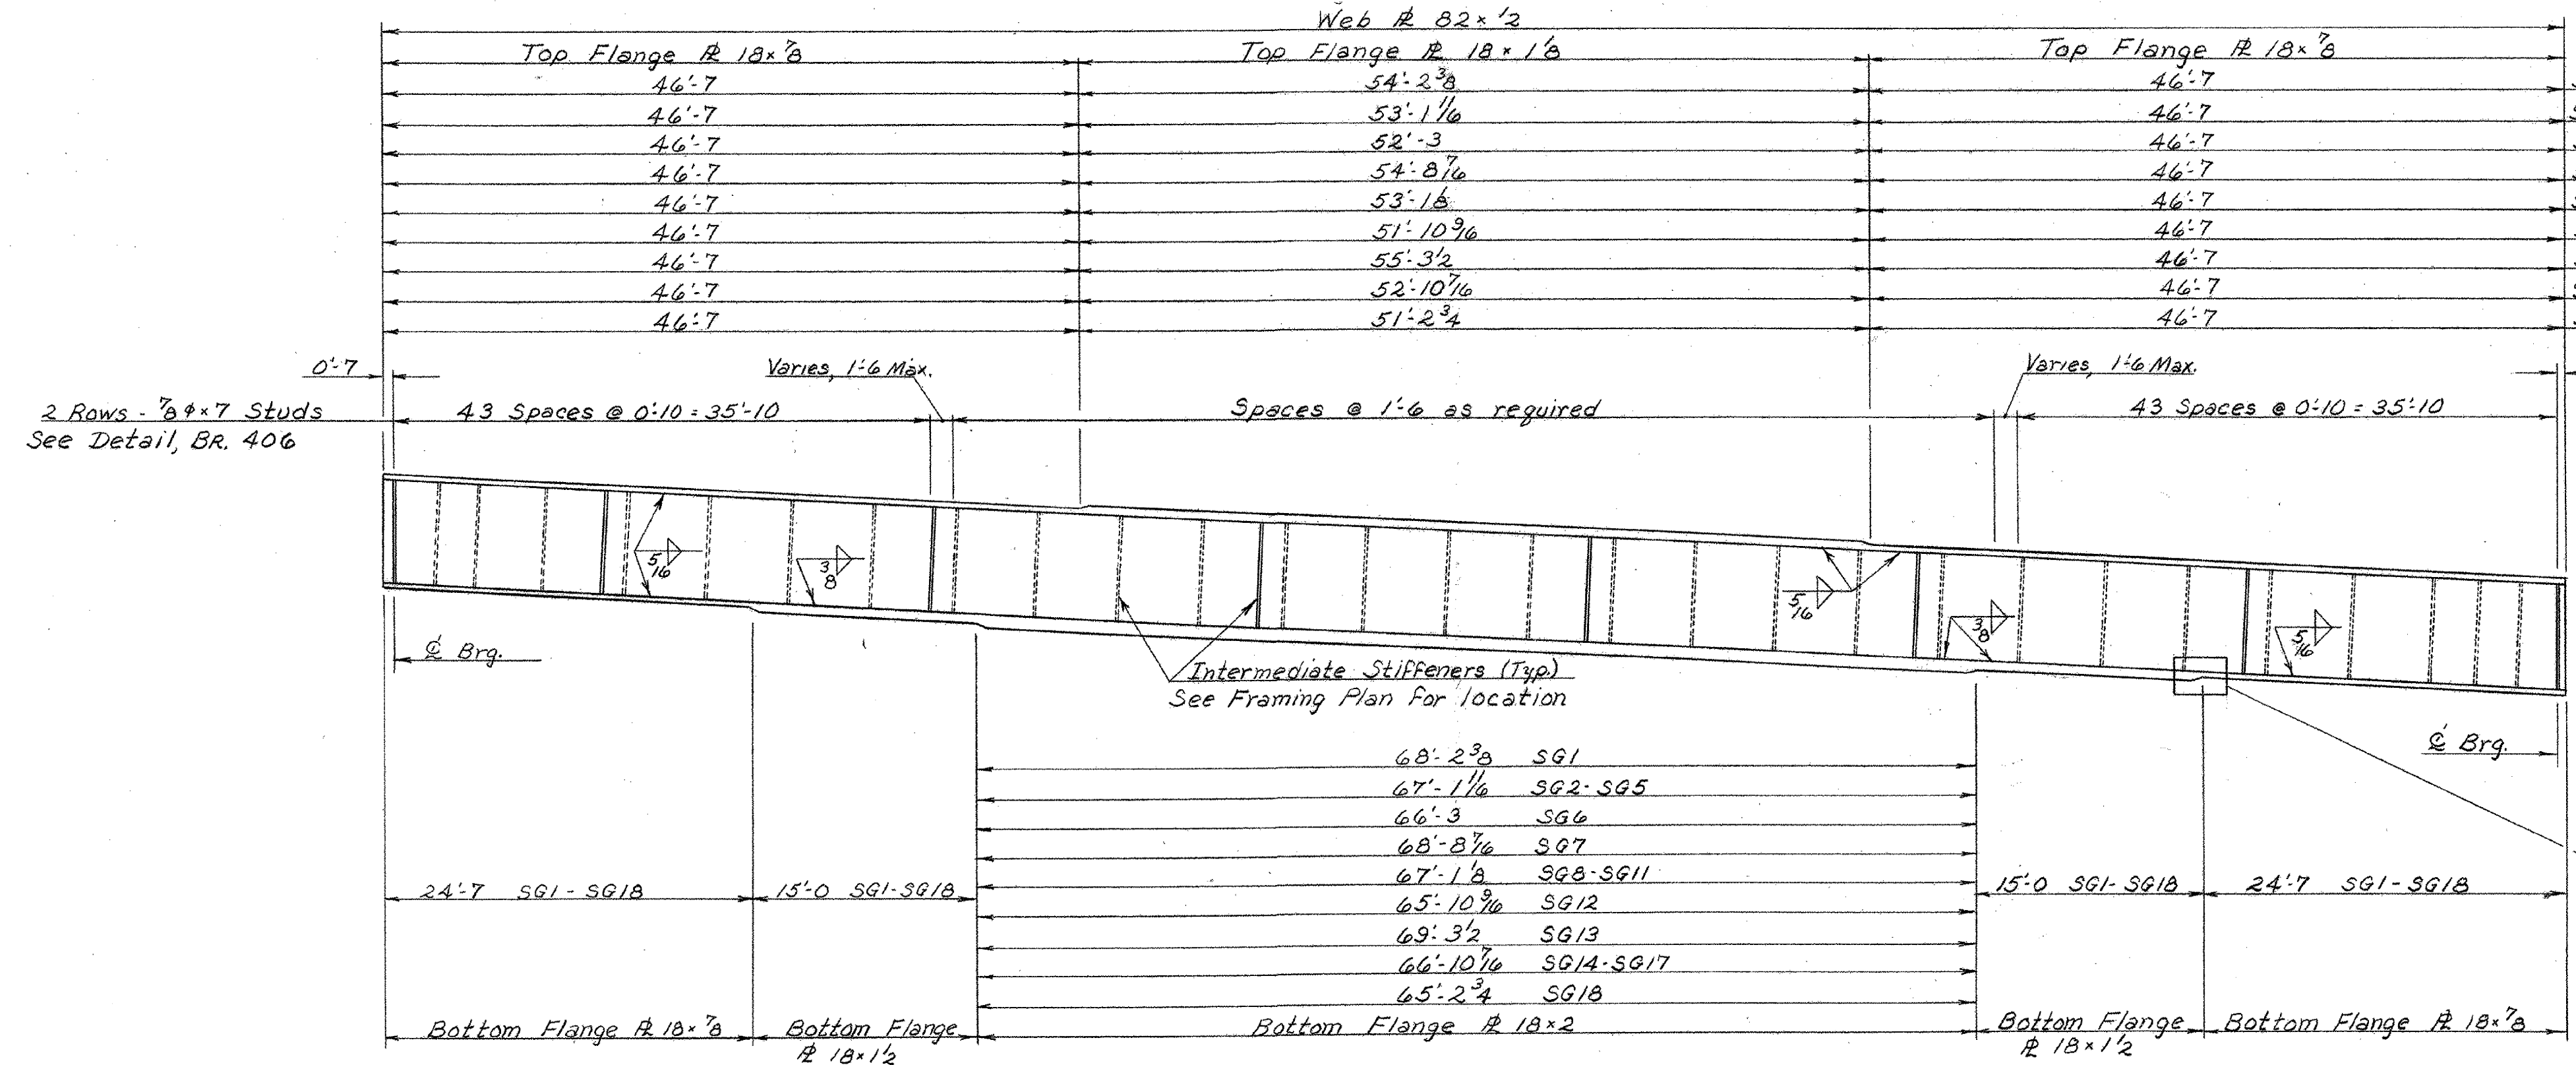


**TYPICAL SOUTHBOUND GIRDER ELEVATION**  
SCALE: 1/8" = 1'-0"

SG1 Total Length	147'-4 3/8"
SG2-SG5	146'-3 3/8"
SG6	145'-5"
SG7	147'-10 7/8"
SG8-SG11	146'-3'0"
SG12	145'-0 3/8"
SG13	148'-5 1/2"
SG14-SG17	146'-0 1/8"
SG18 Total Length	144'-4 3/4"

- NOTES**
1. See BR. 400 For General Notes.
  2. See BR. 411 For Framing Details
  3. See BR. 406 For Intermediate and End Cross Frame Details.

THIS SHEET FOR REFERENCE ONLY  
BERLIN IM 089-1(20)  
BRIDGES 40 N&S  
SHEET 85 OF 104

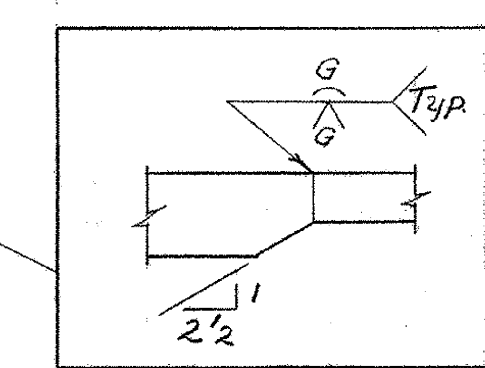


**TYPICAL FLANGE BUTT WELD**  
N.T.S.


**STATE OF VERMONT**  
DEPARTMENT OF HIGHWAYS

PROJECT BERLIN-MONTPELIER  
TOWNS OF BERLIN & MONTPELIER  
ROUTE NO. I 89 STA. 193+50'  
I 89 OVER VT. 12

S.B. SPAN #3 FRAMING PLAN & GIRDER ELEV.  
SCALE AS NOTED  
IN CHARGE W. SMITH  
DRAWN BY W. TRIPP CHECKED BY R. LADD  
11-67  
PROJECT NO. I 89-1(12)  
SHEET 189 OF 192 BR. 408

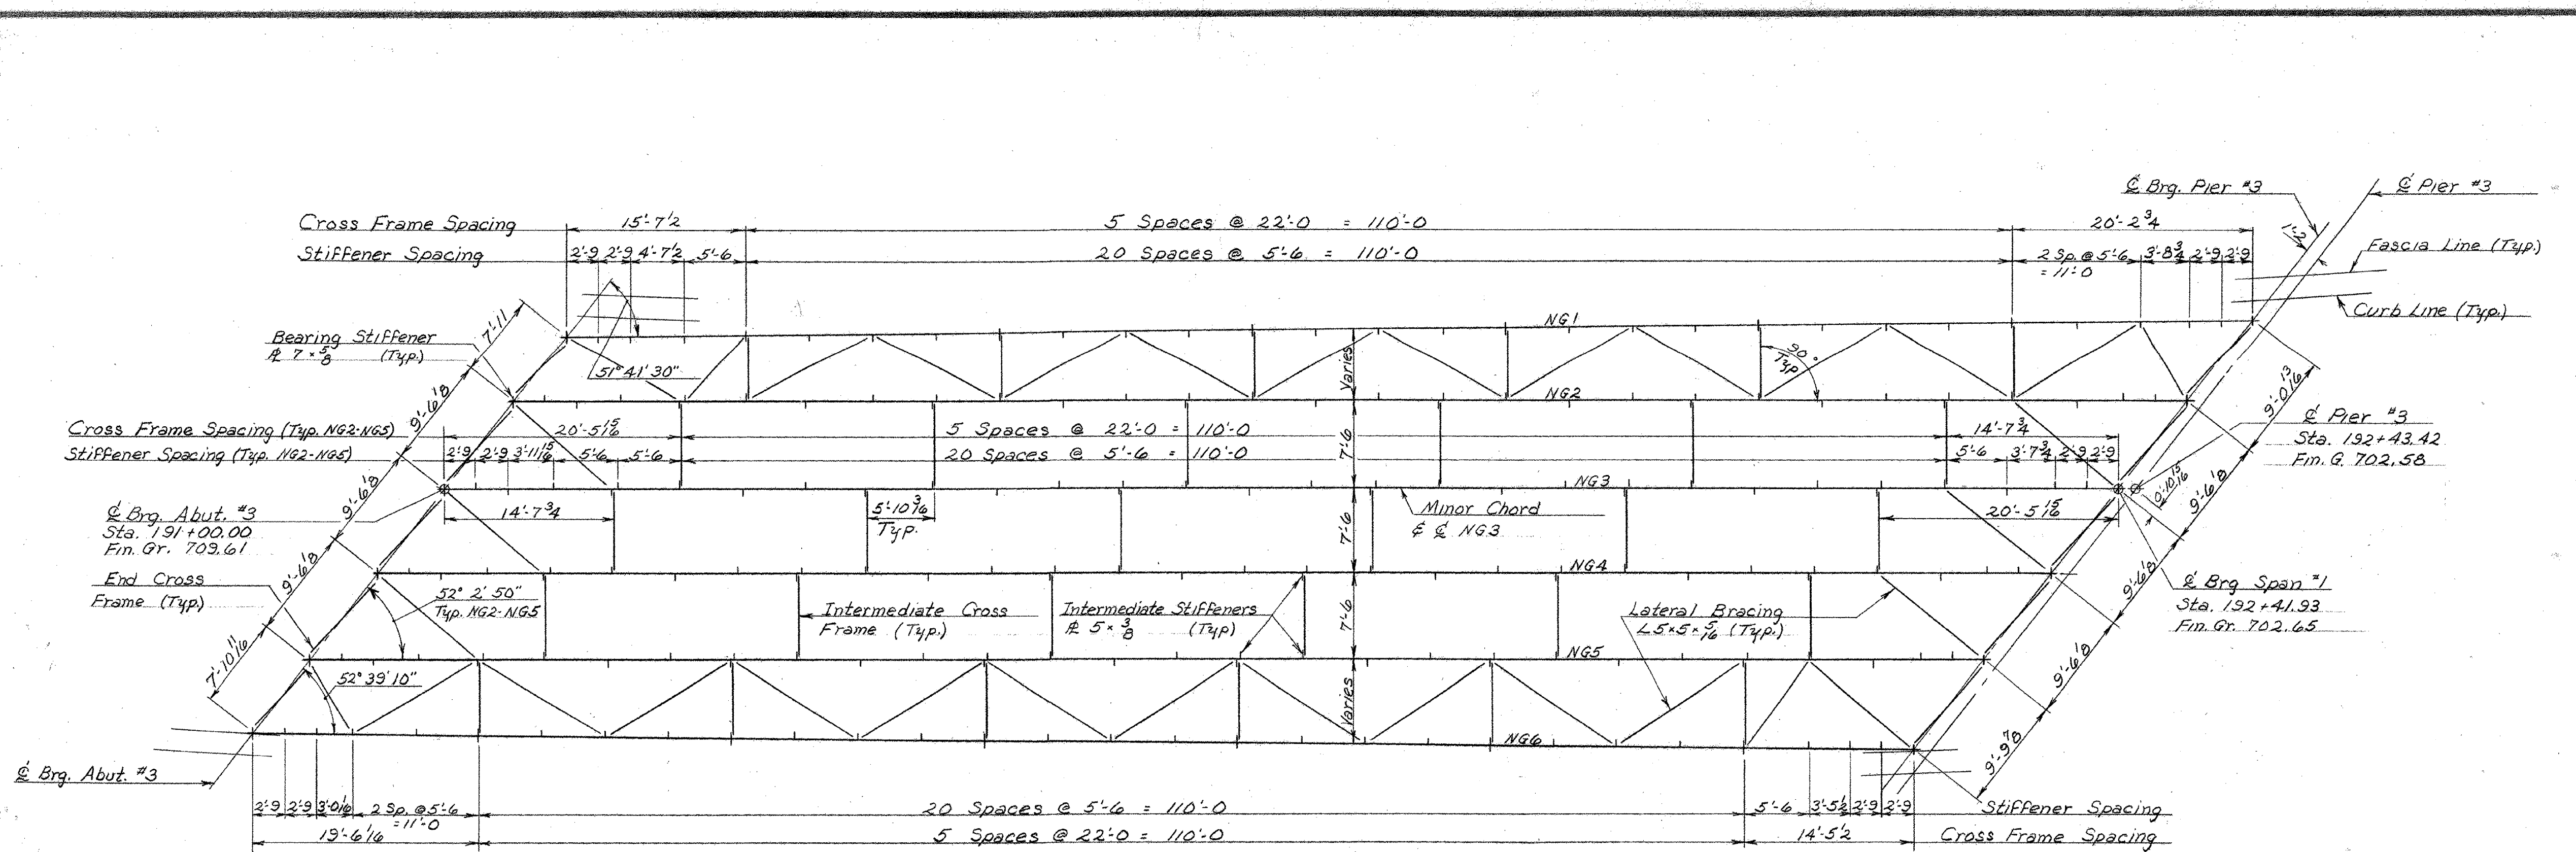

**N.B. SPAN #1 FRAMING PLAN**  
SCALE: 1/8" = 1'-0"

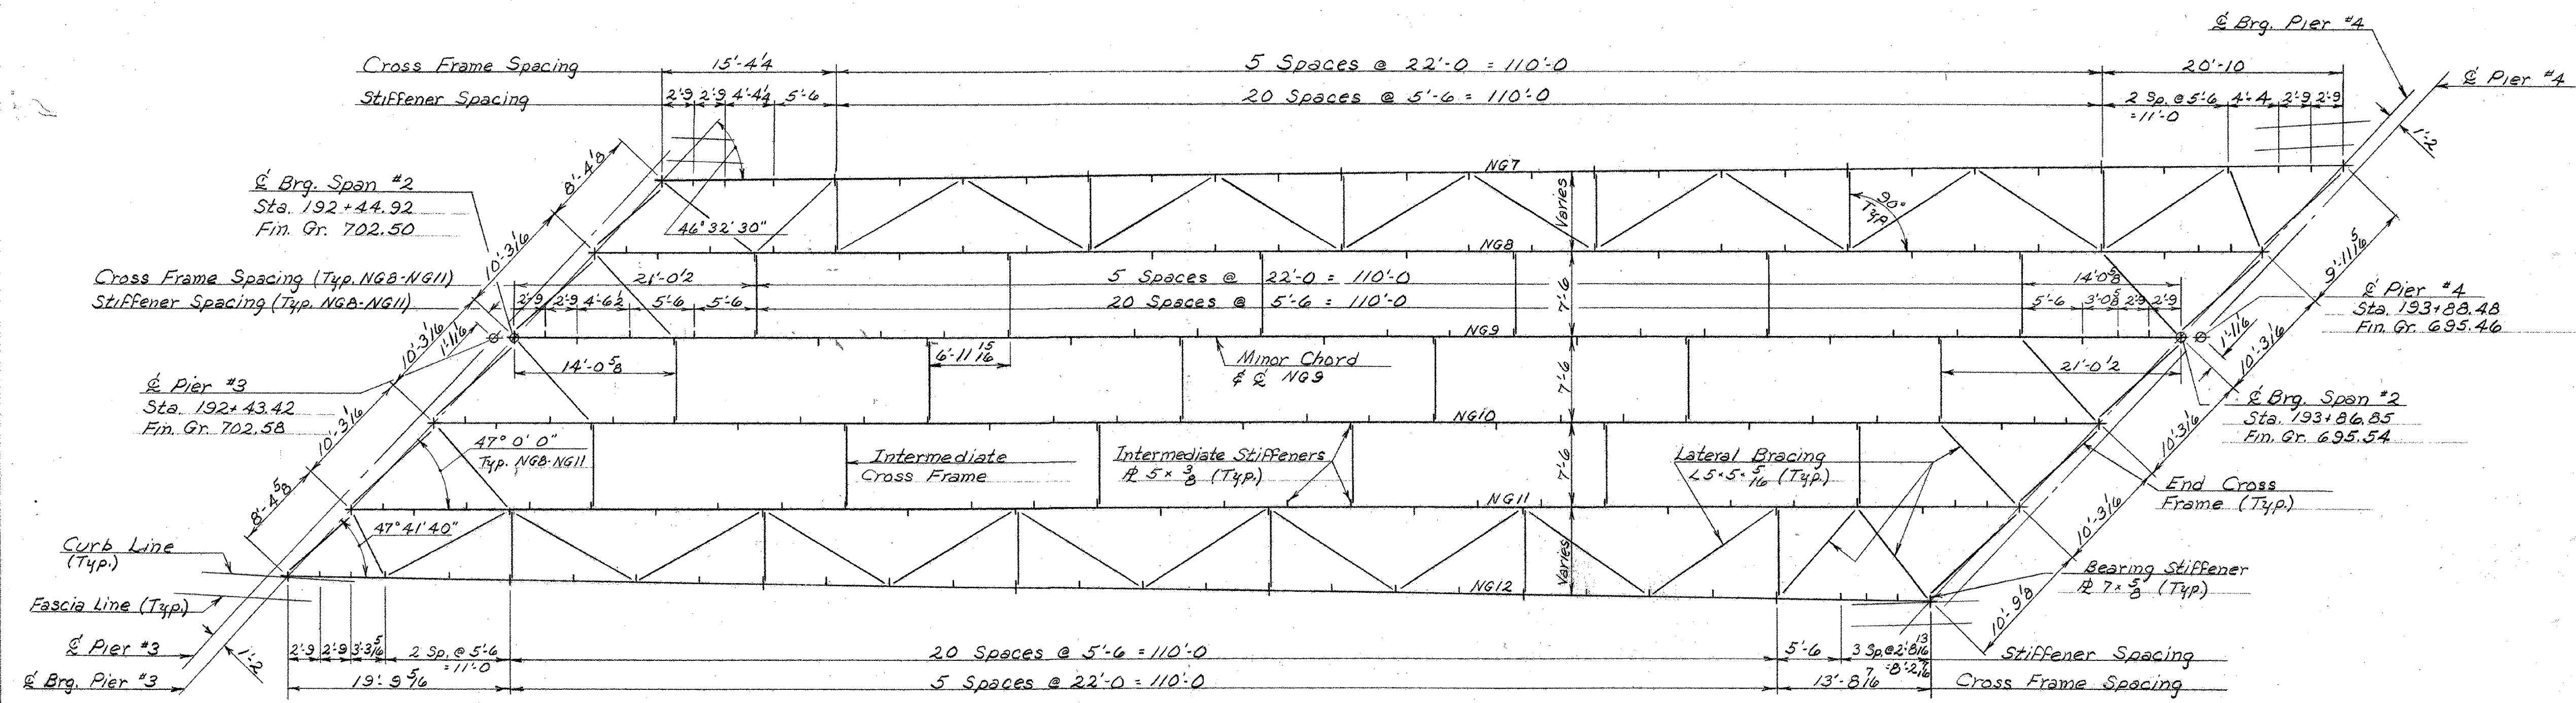

**N.B. SPAN #2 FRAMING PLAN**  
SCALE: 1/8" = 1'-0"

- NOTES**
1. See BR. 400 For General Notes.
  2. See BR. 410 For N.B. Girder Elevation.
  3. See BR. 411. For Framing Details.
  4. See BR. 406 For Intermediate and End Cross Frame Details.

THIS SHEET FOR REFERENCE ONLY  
BERLIN 1M 089-1(20)  
BRIDGES 40 N&S  
SHEET 86 OF 104

**STATE OF VERMONT**  
DEPARTMENT OF HIGHWAYS


PROJECT BERLIN-MONTPELIER  
TOWNS OF BERLIN & MONTPELIER

ROUTE NO. I 89 STA. 193+50.7  
I 89 OVER VT. 12


N.B. SPANS #1 & #2 FRAMING PLAN  
SCALE AS NOTED

IN CHARGE W. SMITH  
DRAWN BY W. TRIPP CHECKED BY R. LADD  
11-67


PROJECT NO. I 89-1(12)  
SHEET 160 OF 497 BR. 409

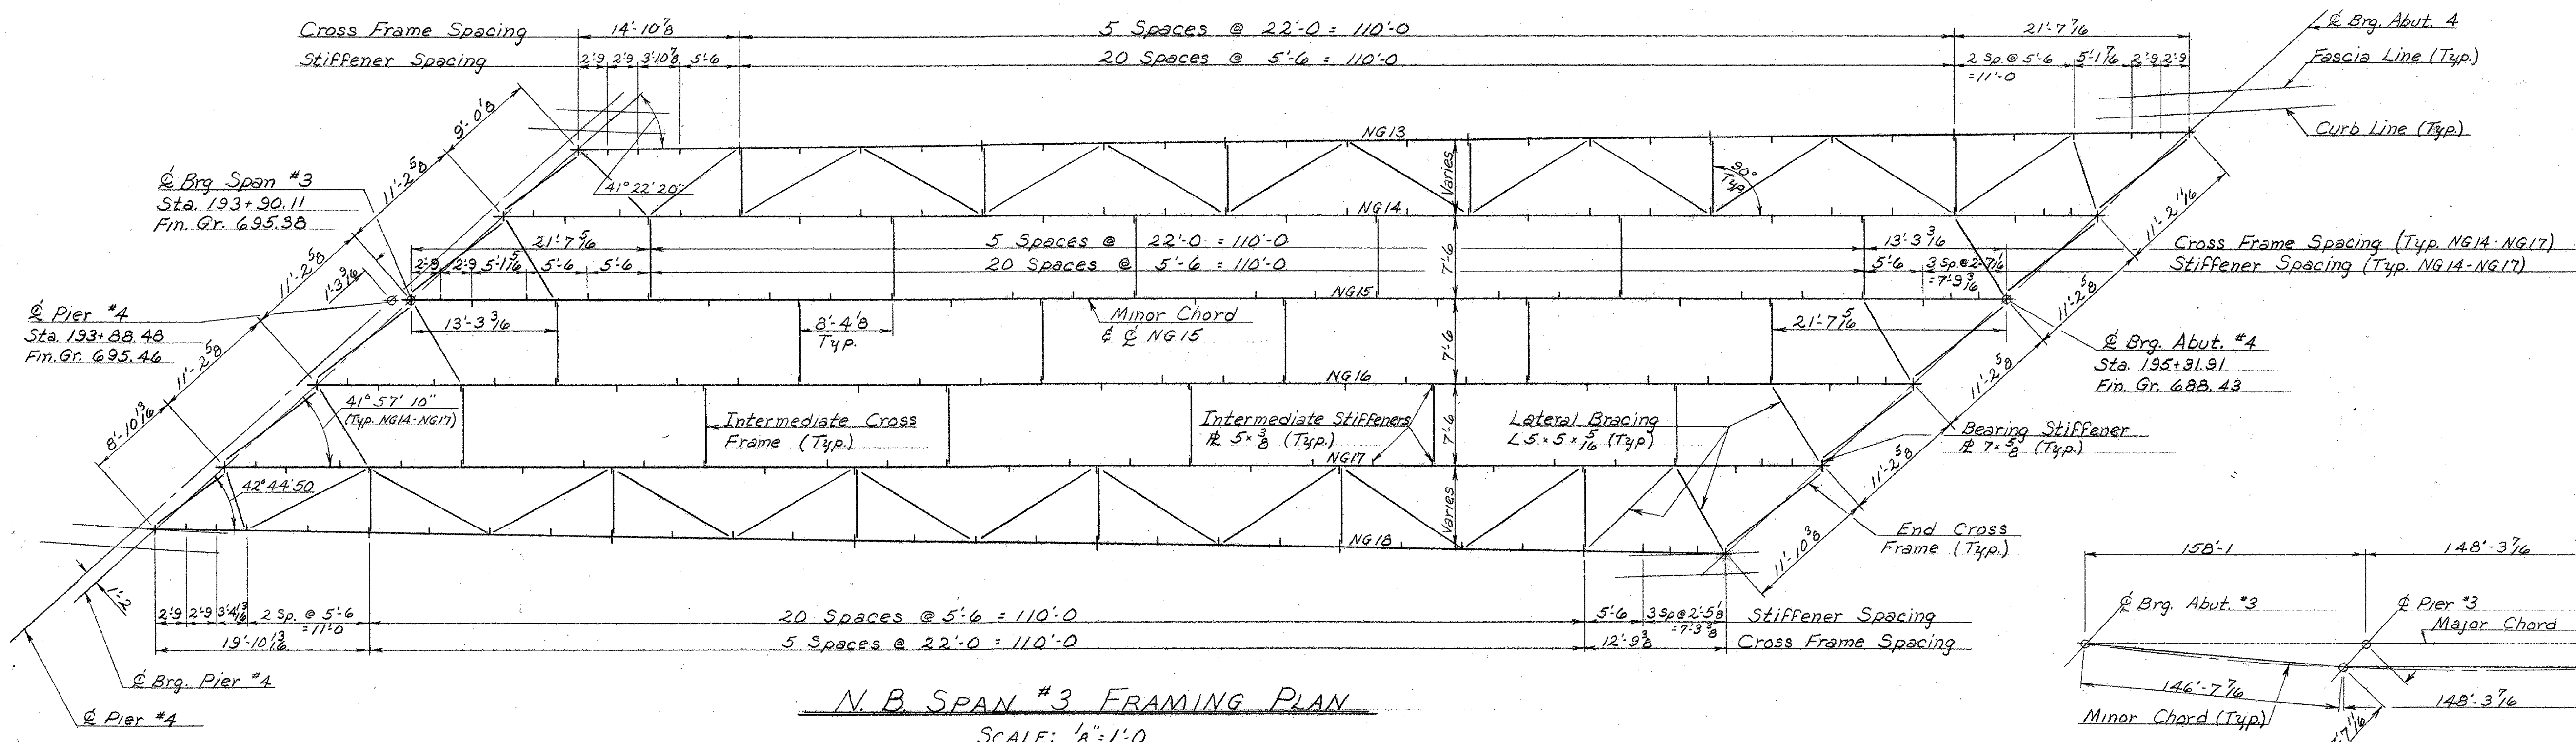

N.B. SPAN #3 FRAMING PLAN  
SCALE: 1/8" = 1'-0"

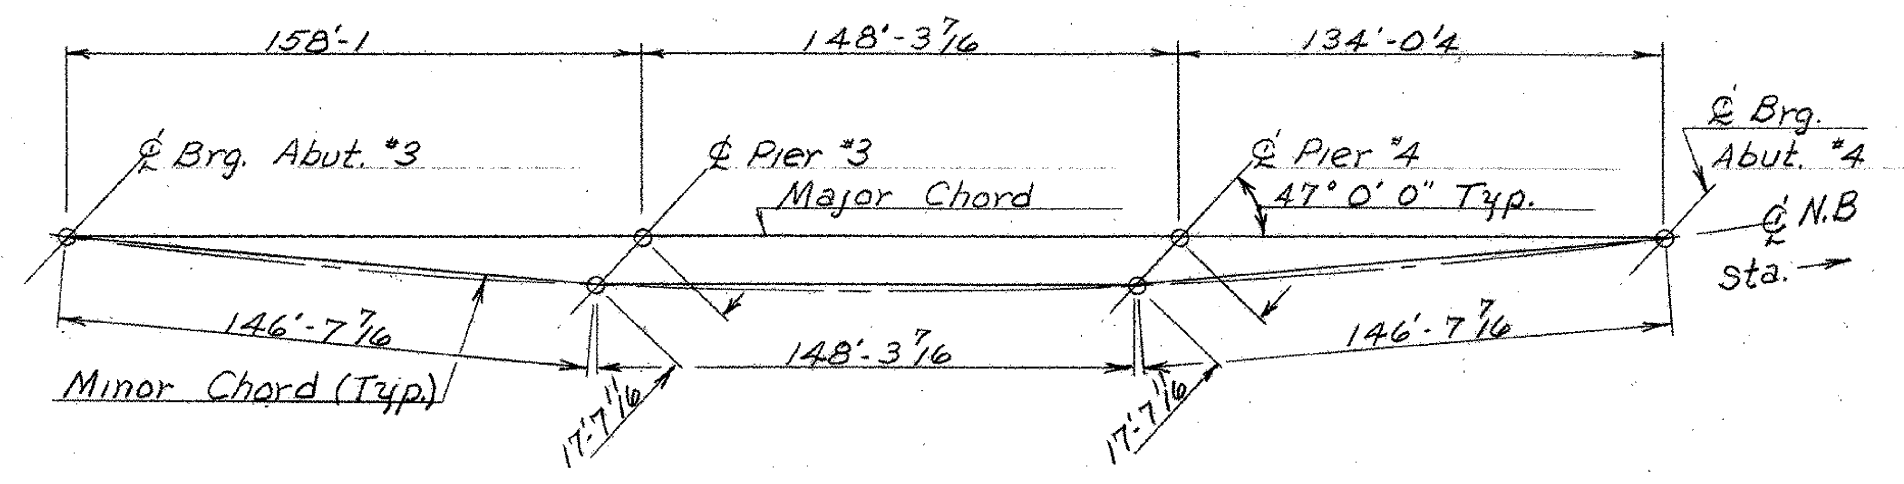

N.B. CHORD LAYOUT  
N.T.S.

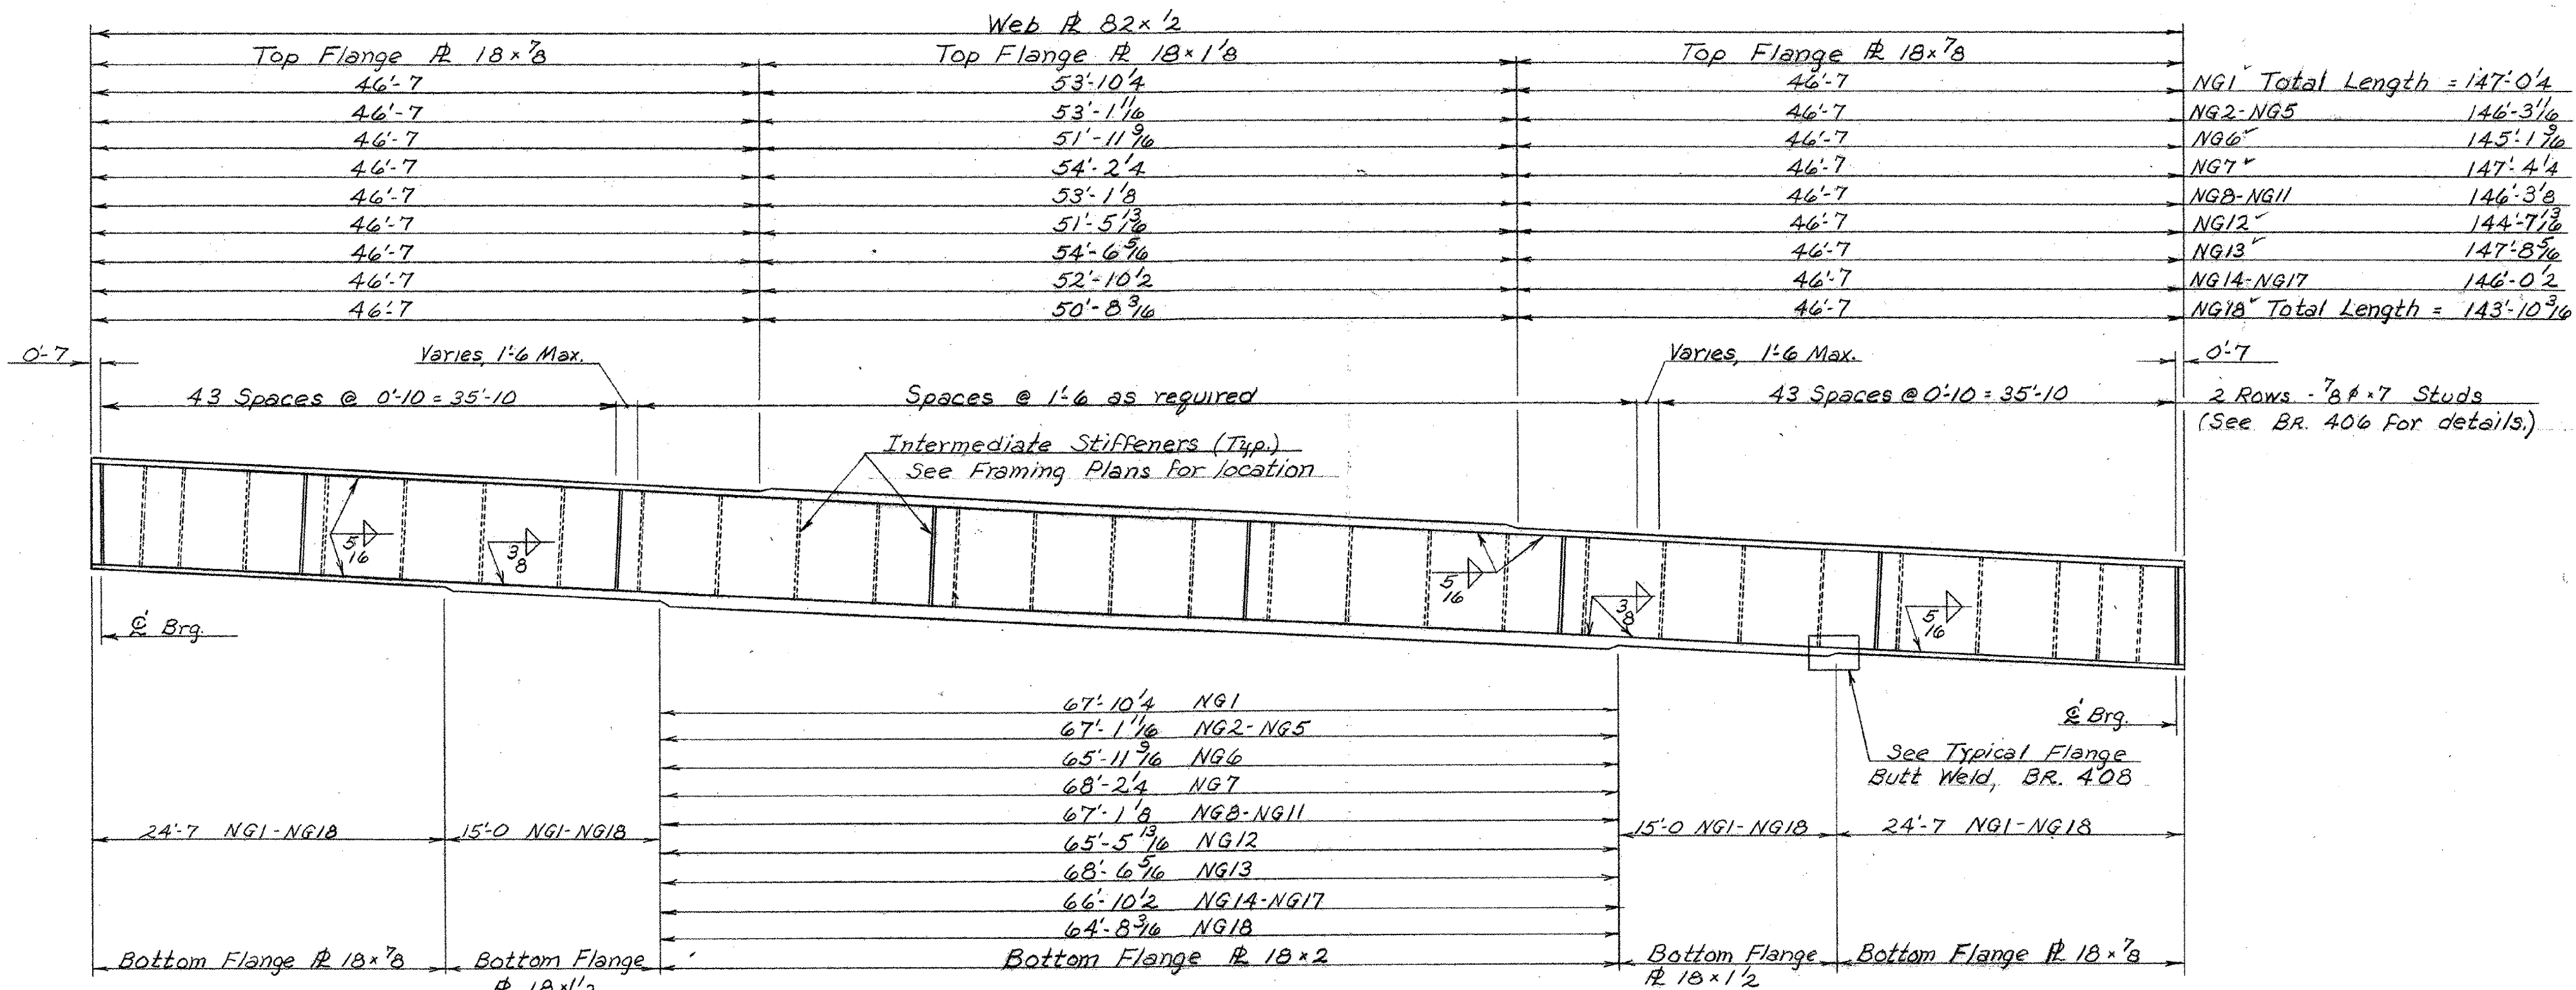

TYPICAL NORTHBOUND GIRDER ELEVATION  
SCALE: 1/8" = 1'-0"

NOTES

1. See BR. 400 For General Notes.
2. See BR. 411 For Framing Details.
3. See BR. 406 For Intermediate and End Cross Frame Details.

THIS SHEET FOR REFERENCE ONLY  
BERLIN IM 089-1(20)  
BRIDGES 40 N&S  
SHEET 87 OF 104

**STATE OF VERMONT**  
DEPARTMENT OF HIGHWAYS

PROJECT BERLIN-MONTPELIER  
TOWNS OF BERLIN & MONTPELIER


ROUTE NO. I 89 STA. 193+50±  
I 89 OVER VT. 12

N.B. SPAN #3 FRAMING PLAN & GIRDER ELEV.  
SCALE AS NOTED


IN CHARGE W. SMITH

DRAWN BY W. TRIPP CHECKED BY R. LADD  
11-67


PROJECT NO. I 89-1(12)  
SHEET 141 OF 197 BR. 410

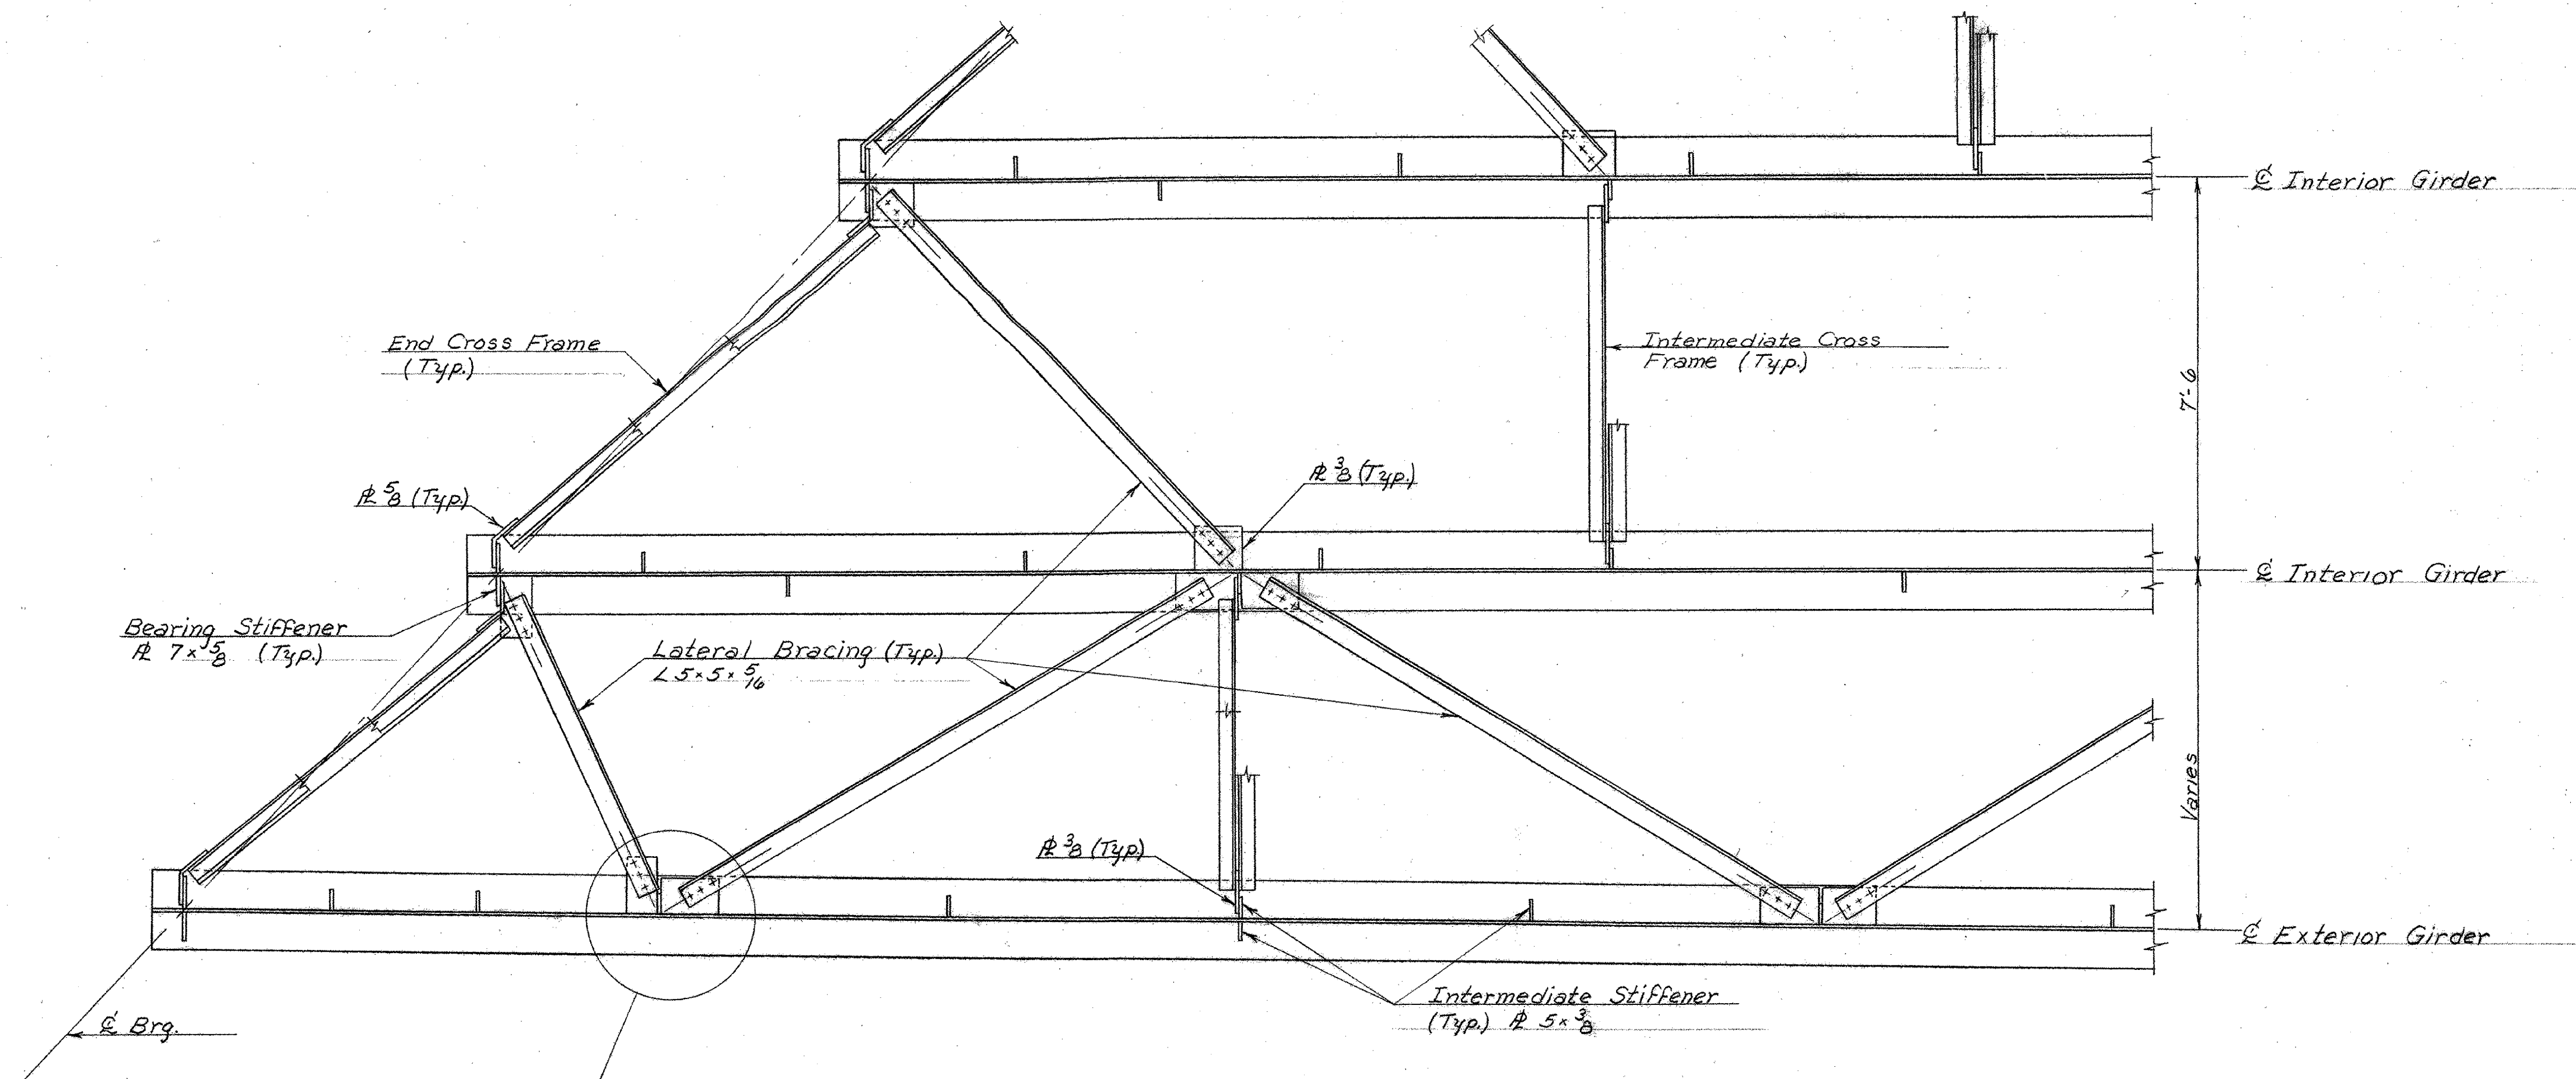


**FRAMING PLAN DETAILS**  
SCALE:  $\frac{1}{2}'' = 1'-0''$

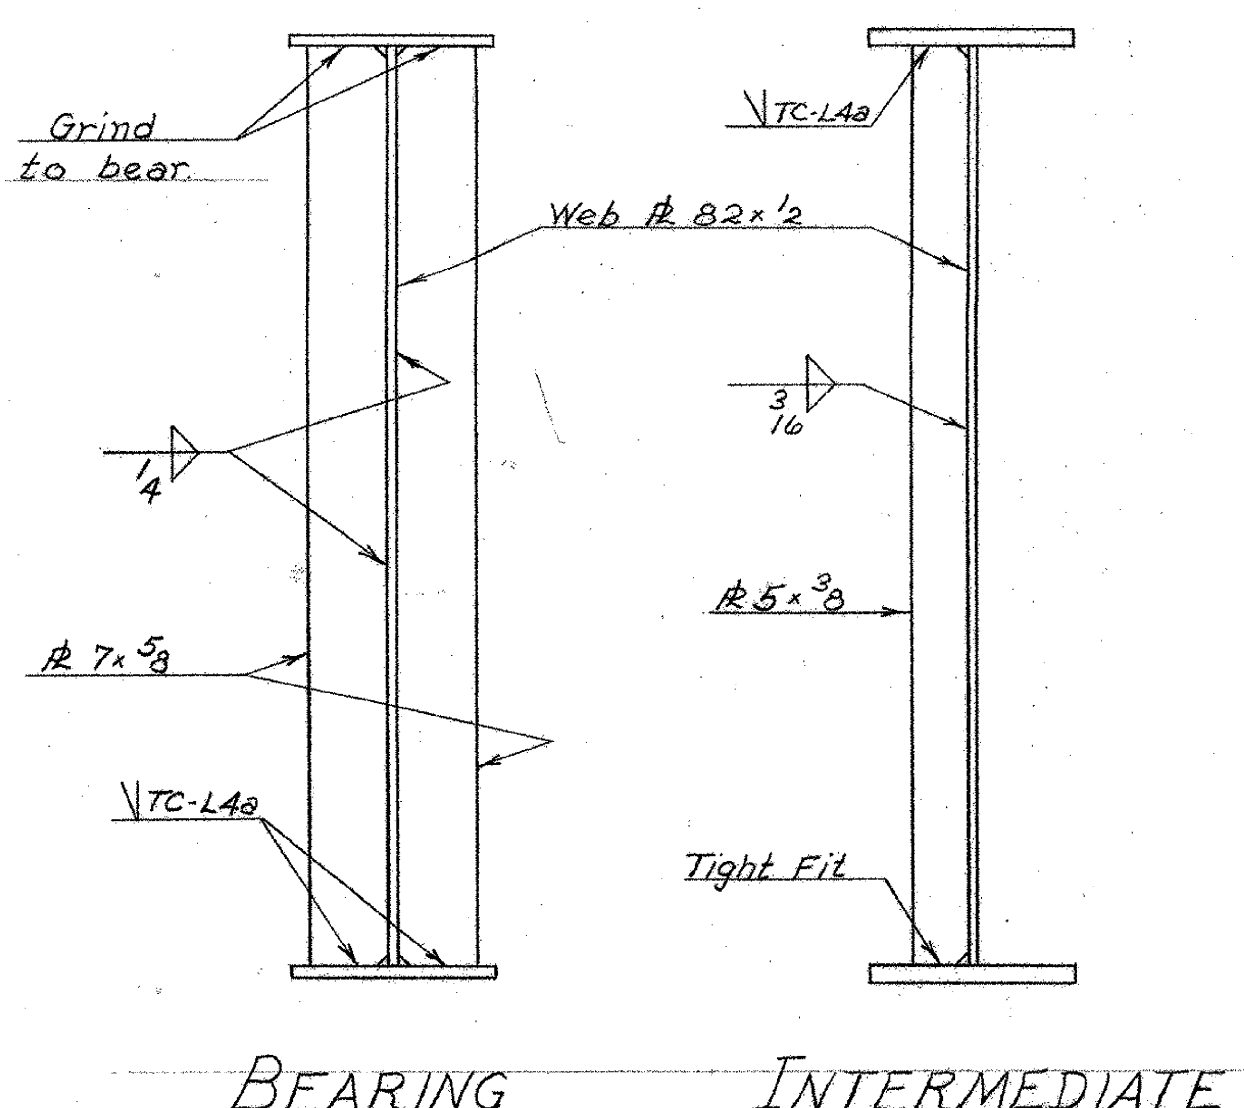


**STIFFENER DETAILS**  
SCALE:  $\frac{3}{4}'' = 1'-0''$

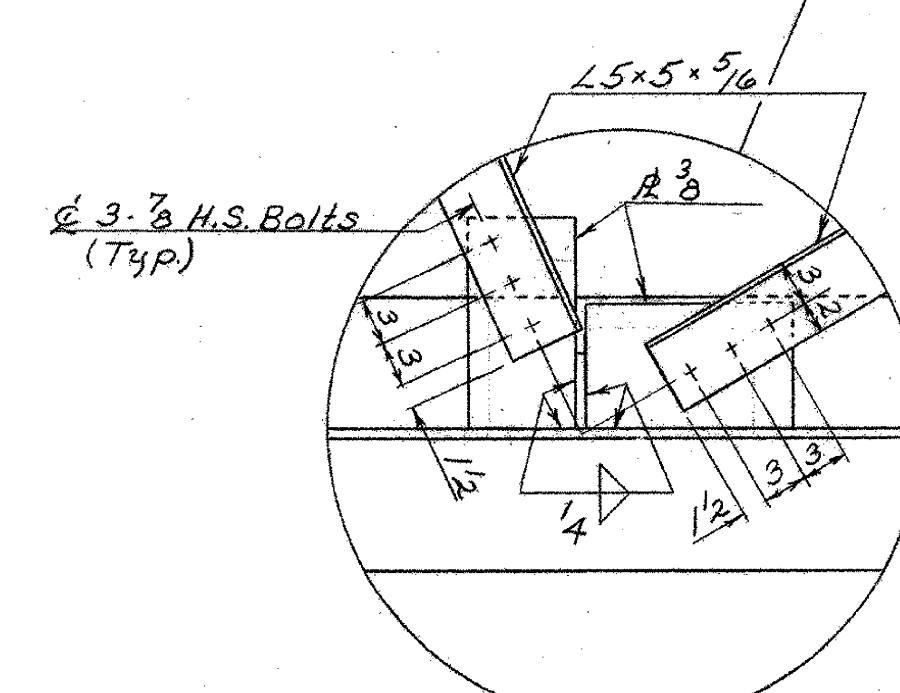

**LATERAL BRACING CONNECTION DETAIL**  
SCALE:  $1'' = 1'-0''$

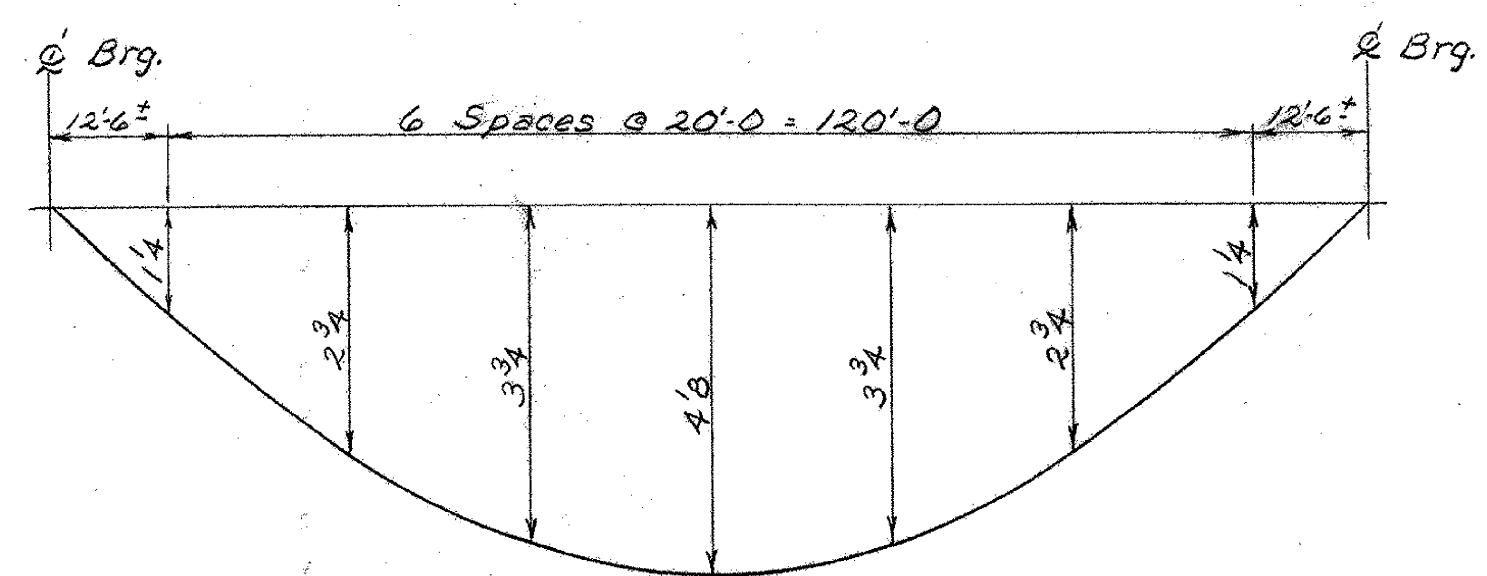

**DEAD LOAD DEFLECTION DIAGRAM**  
(DUE TO WEIGHT OF GIRDER, BRACING, SLAB, CURBS, RAILING, & PAVEMENT)  
NOT TO SCALE

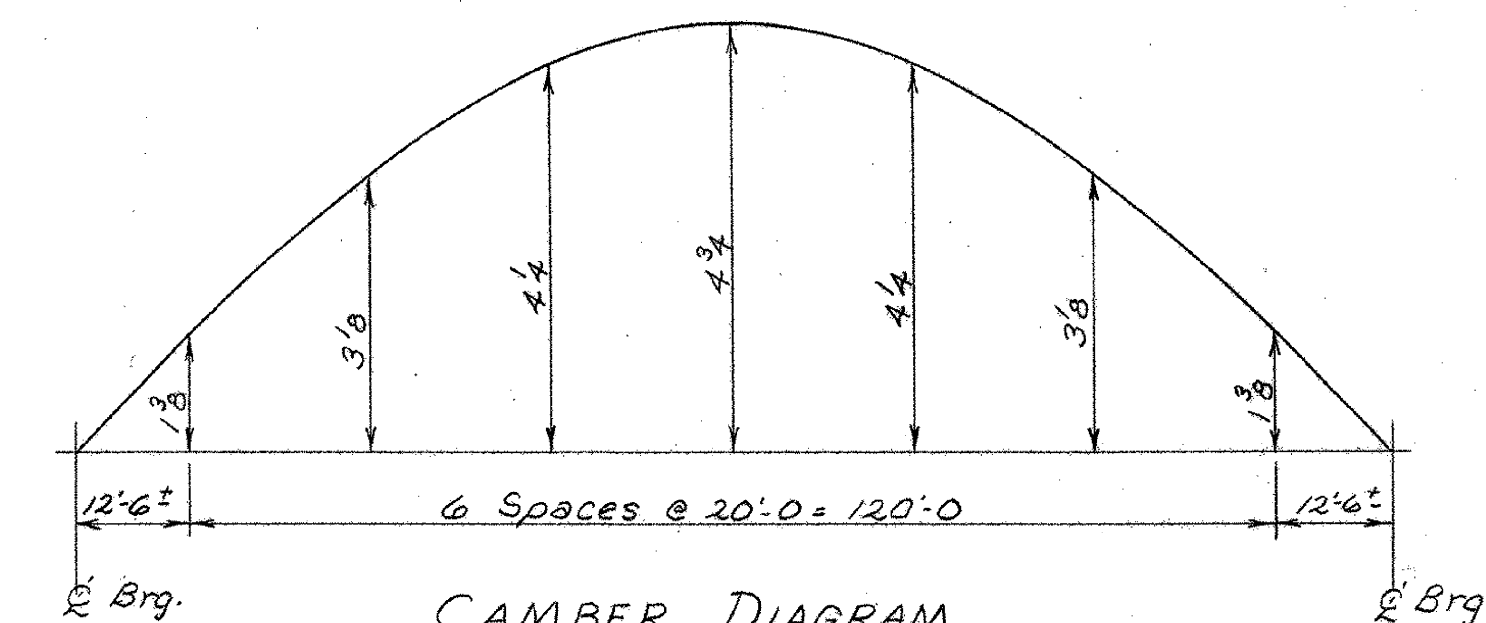

**CAMBER DIAGRAM**  
(SIMILAR ALL GIRDERS)  
NOT TO SCALE

- NOTES**
1. See BR 400 For General Notes.
  2. See BR 406 For additional details of Bracing and Cross Frames.

THIS SHEET FOR REFERENCE ONLY  
BERLIN IM 089-1(20)  
BRIDGES 40 N&S  
SHEET 88 OF 104

**STATE OF VERMONT**  
DEPARTMENT OF HIGHWAYS

PROJECT BERLIN-MONTPELIER  
TOWNS OF BERLIN & MONTPELIER  
ROUTE No I 89 STA. 193+50  
I 89 OVER VT. 12  
GIRDER & BRACING DETAILS  
SCALE As Noted  
IN CHARGE W. SMITH  
DRAWN BY W. TRIPP CHECKED BY R. LADD  
PROJECT No. I 89-1(12)  
SHEET 102 OF 127 BR. 411




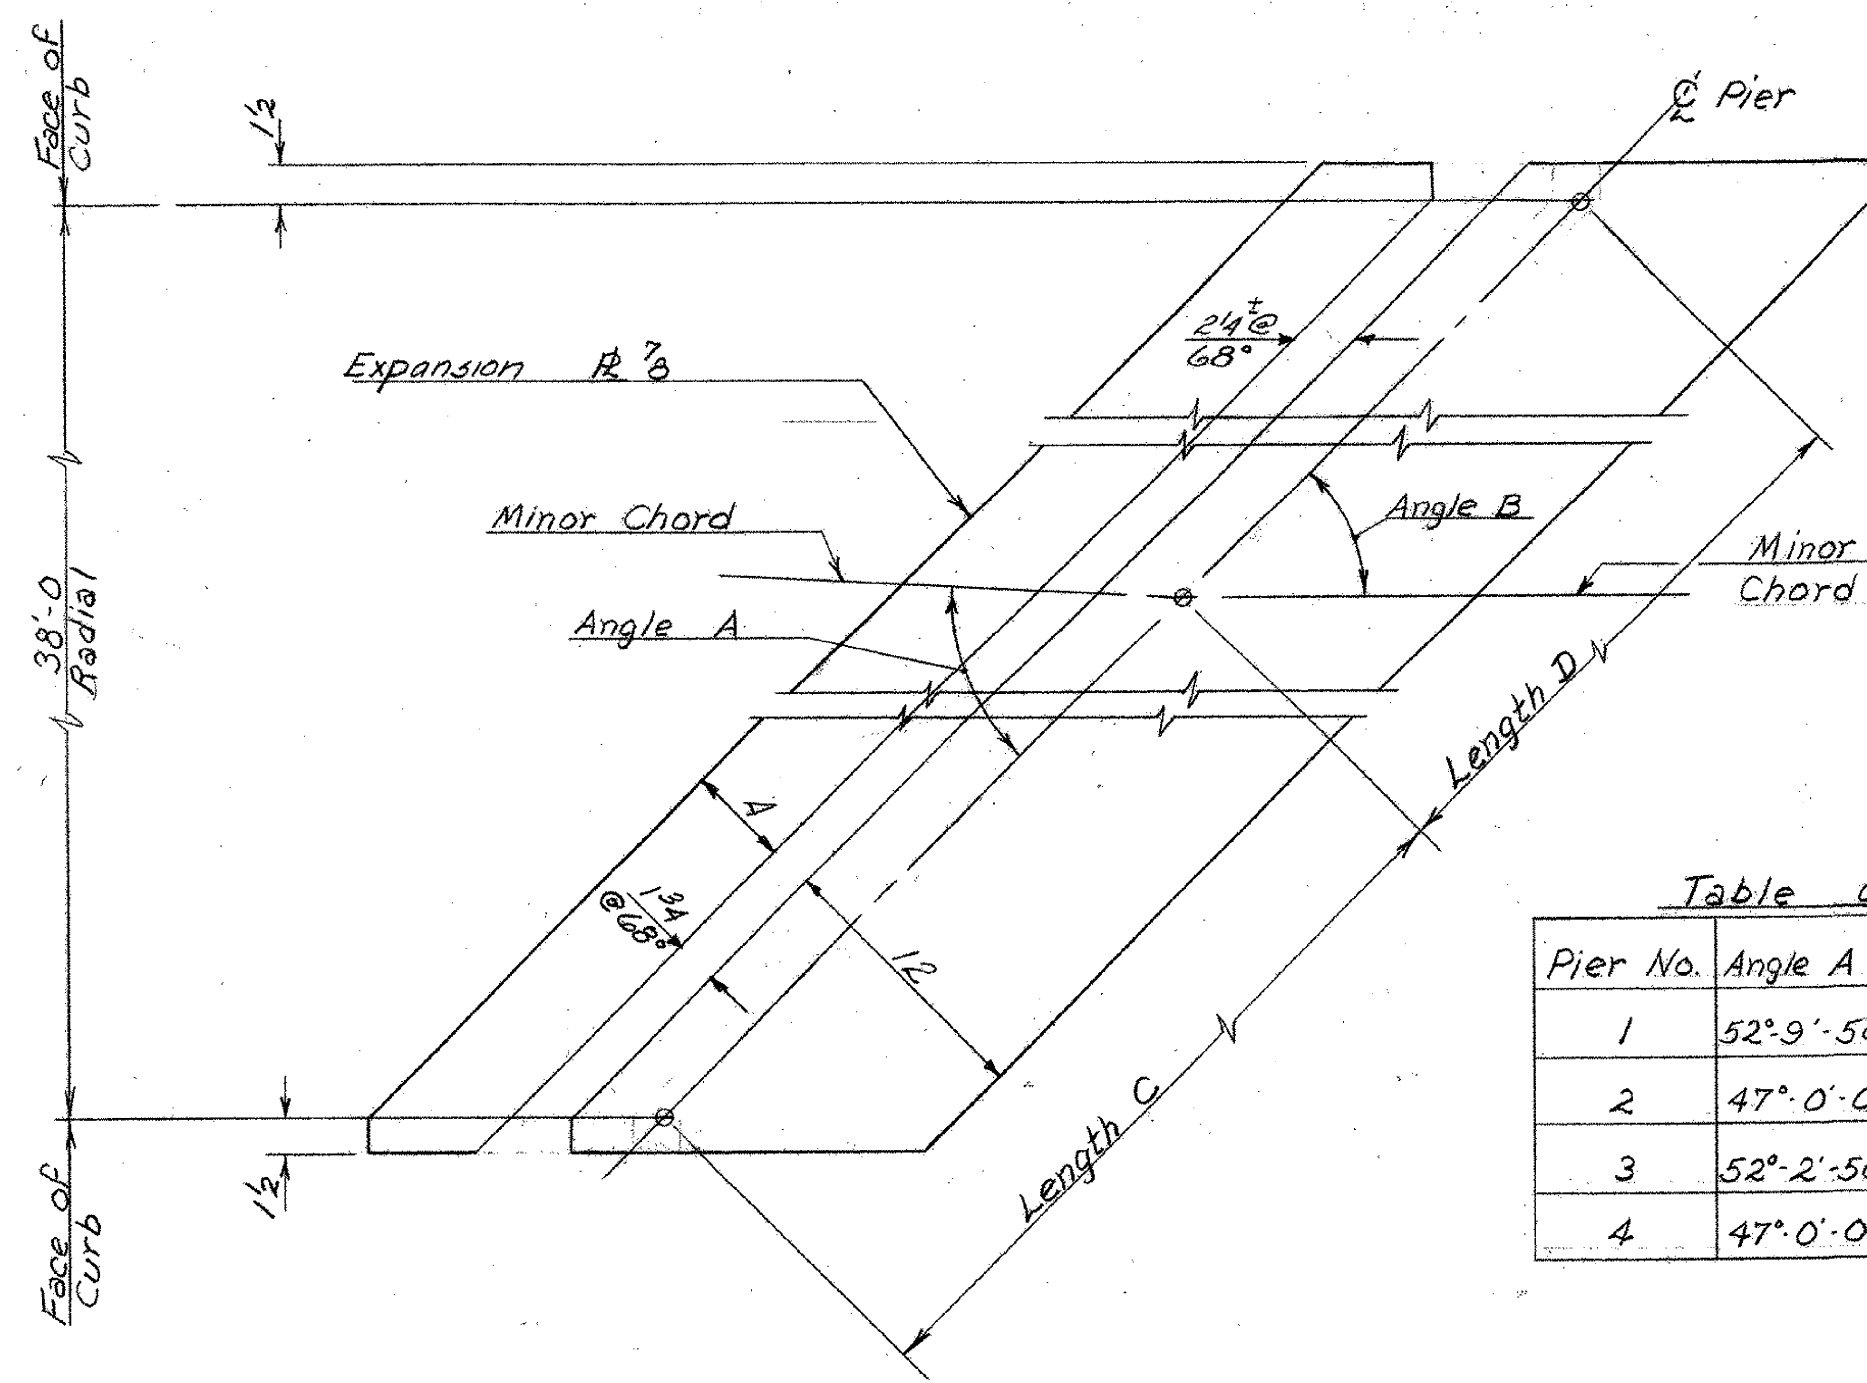



Table of Dimensions

Pier No.	Angle A	Angle B	Length C	Length D
1	52°-9'-50"	47°-0'-0"	20'-11 1/4"	29'-0 7/16"
2	47°-0'-0"	41°-50'-20"	22'-9"	31'-8"
3	52°-2'-50"	47°-0'-0"	28'-9 3/8"	21'-1 1/4"
4	47°-0'-0"	41°-57'-10"	31'-2 1/16"	22'-11 1/2"


TYPICAL EXPANSION PLATE DETAIL  
SCALE: 1 1/2" = 1'-0"

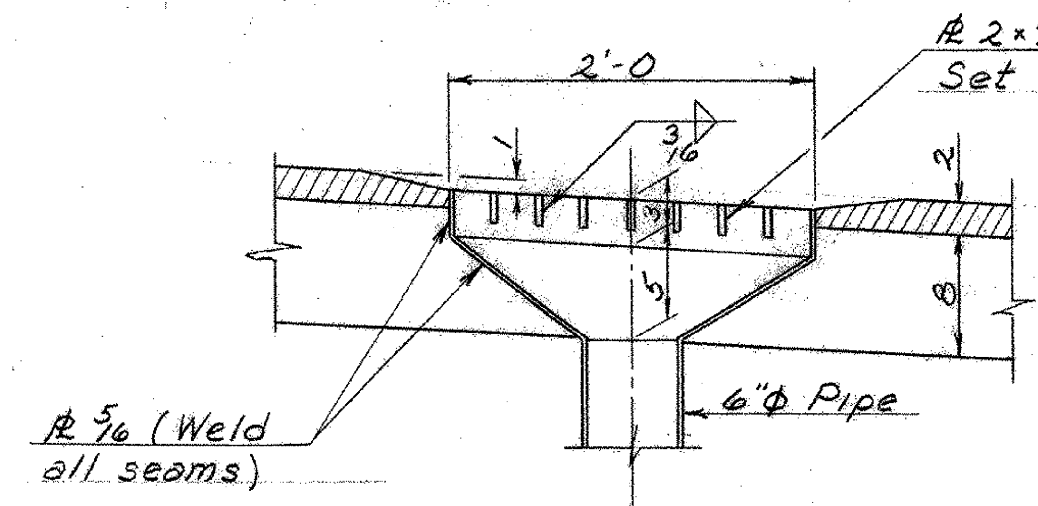


SECTION A-A  
SCALE: 1" = 1'-0"

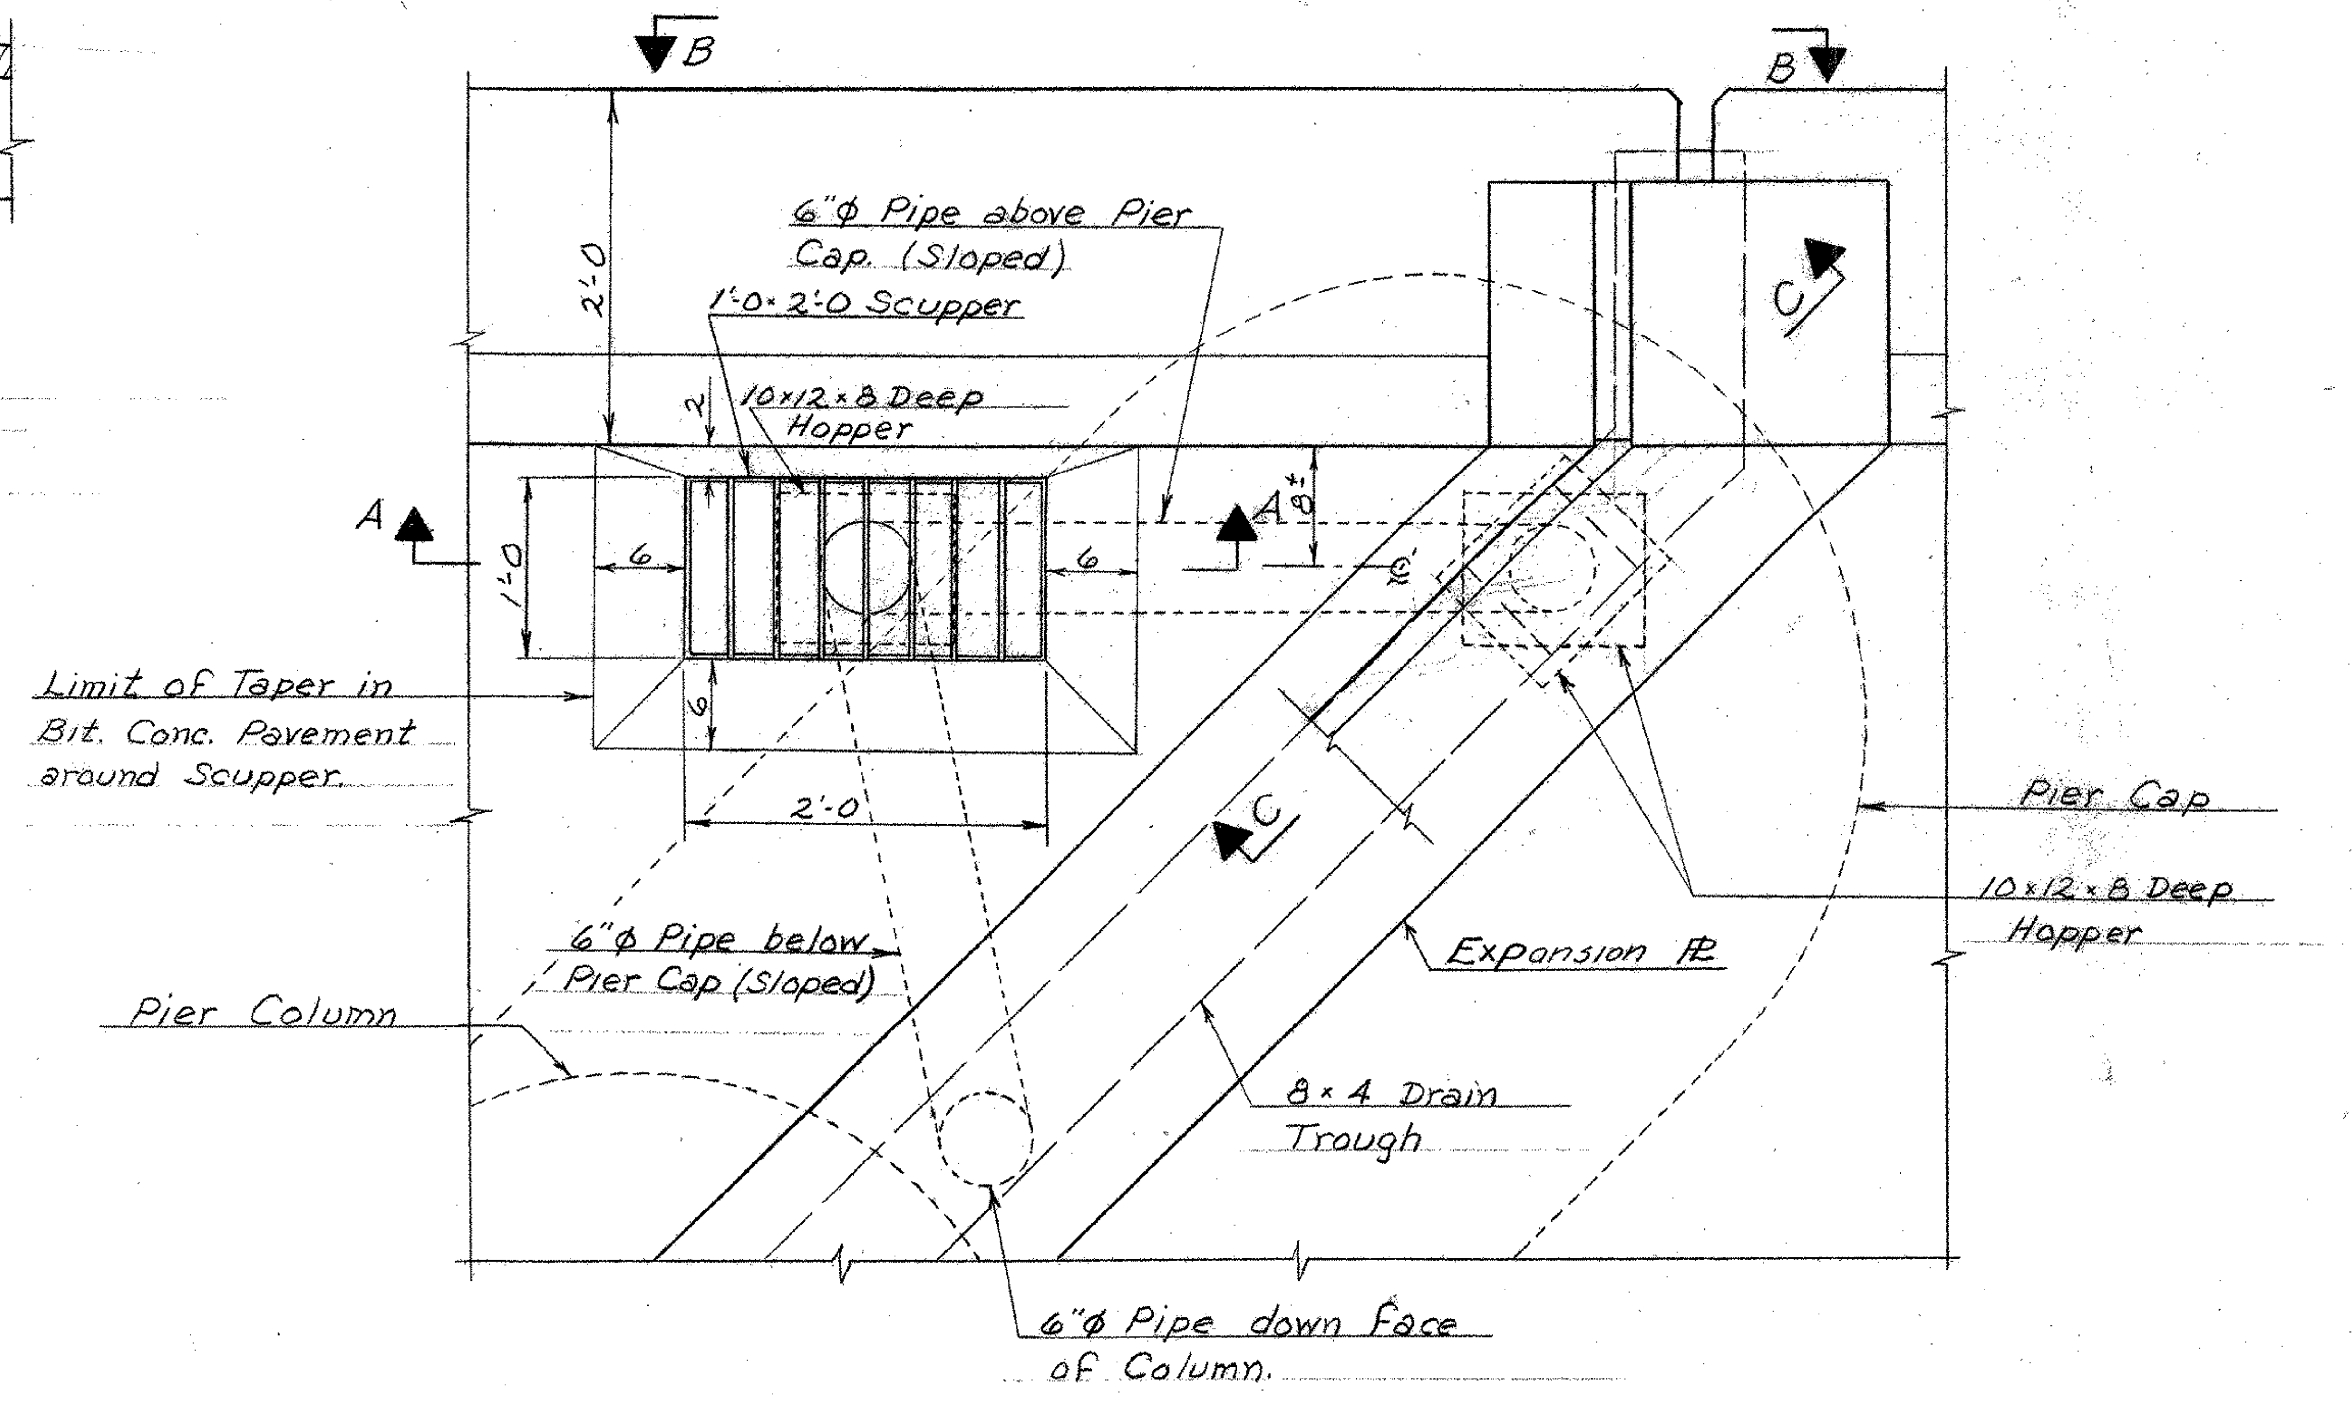


TYPICAL PLAN OF EXP. PLATE & SCUPPER  
AT LOW END OF PIER JOINT  
SCALE: 1" = 1'-0"

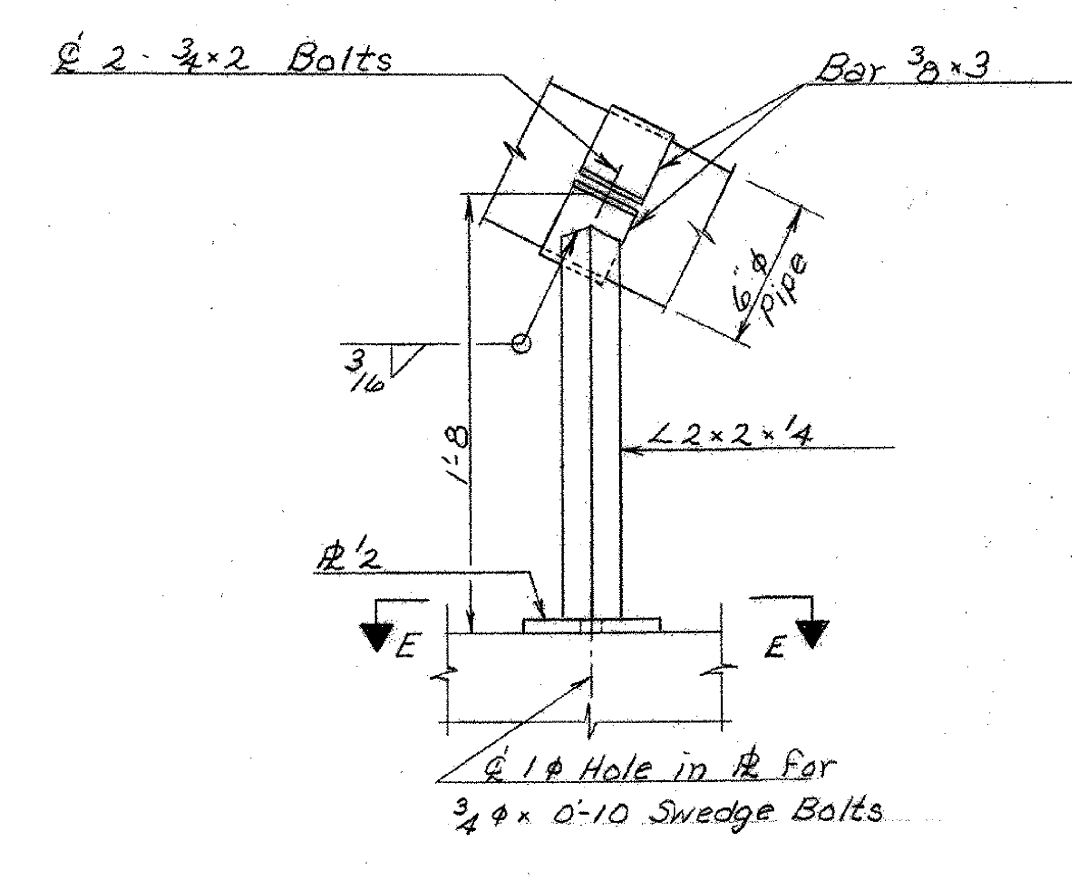


PIPE SUPPORT DETAIL  
SCALE: 1 1/2" = 1'-0"

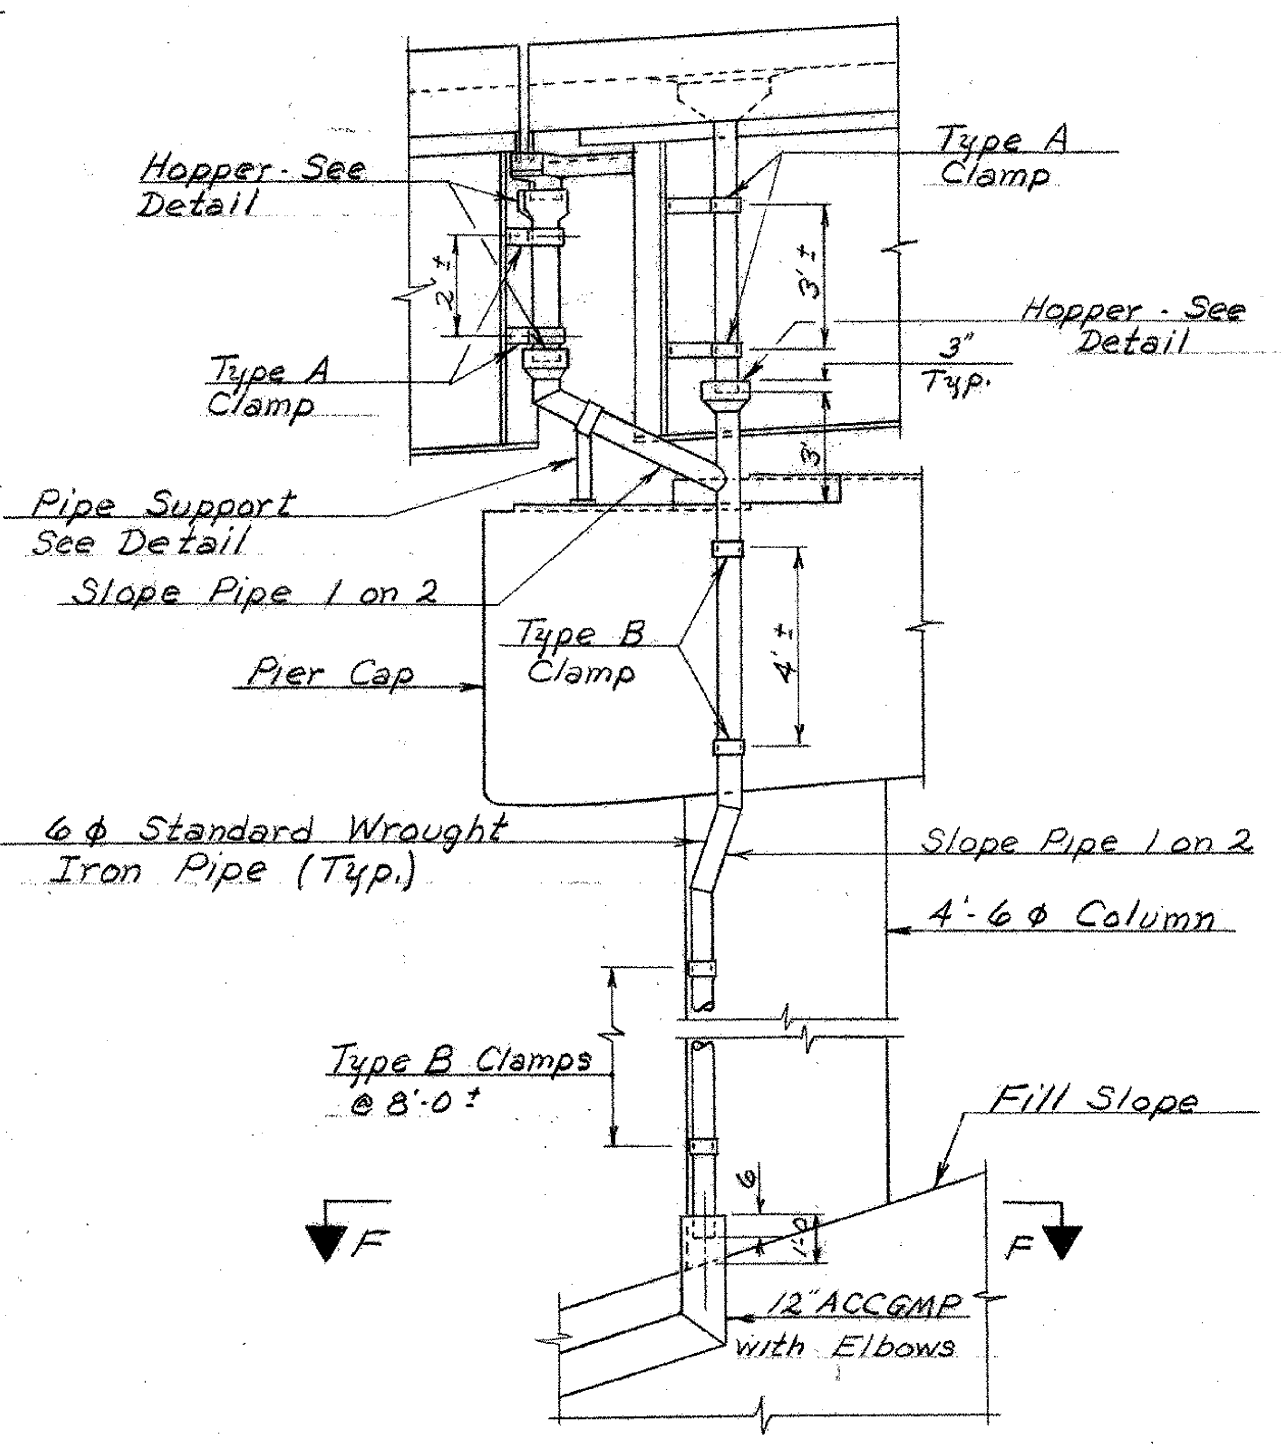

ELEVATION B-B  
SCALE: 1/4" = 1'-0"

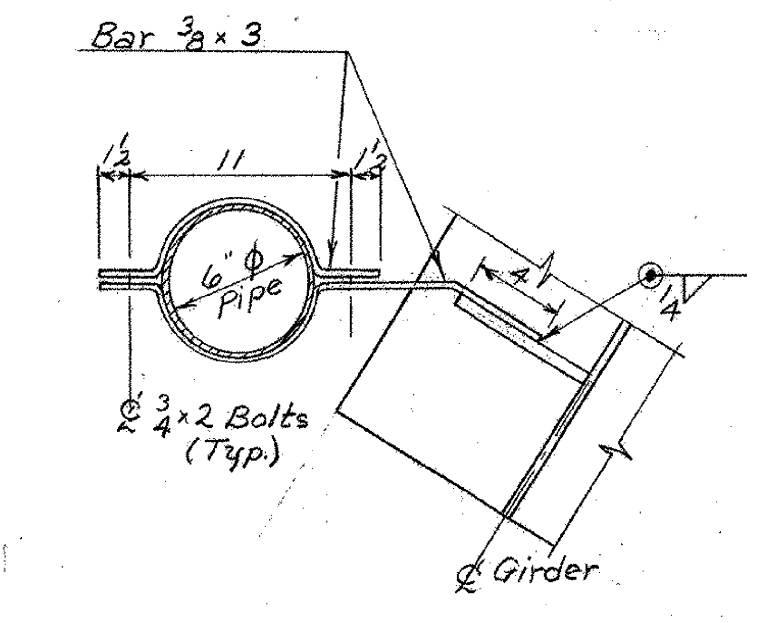


CLAMP DETAIL - TYPE A  
SCALE: 1 1/2" = 1'-0"

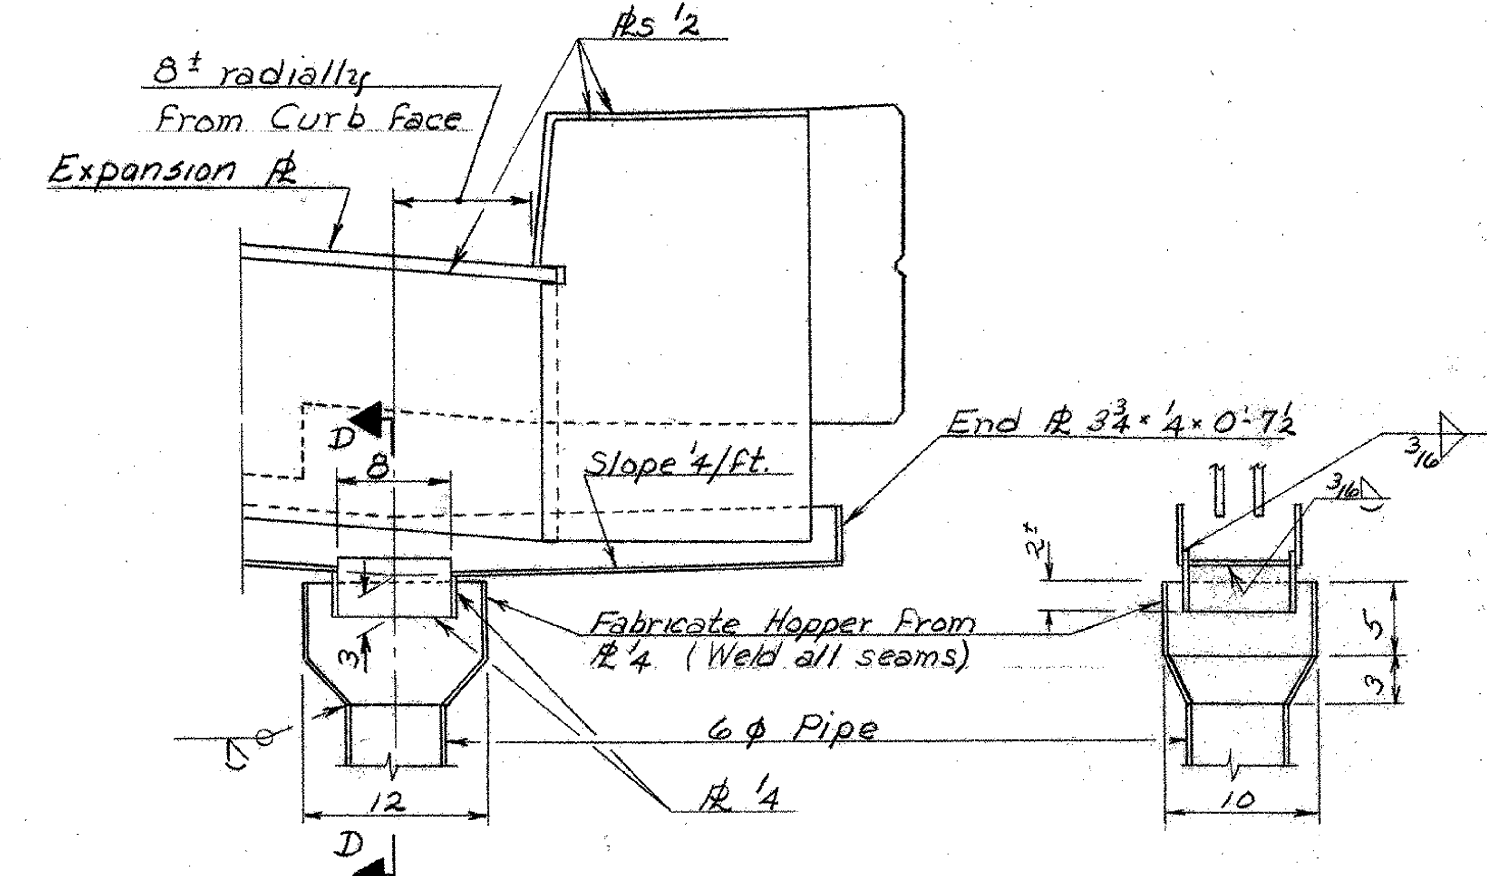

SECTION C-C  
SCALE: 1" = 1'-0"


SECTION D-D  
SCALE: 1" = 1'-0"

NOTE: HOPPER DETAILS SHOWN ABOVE ARE TYPICAL FOR ALL HOPPERS

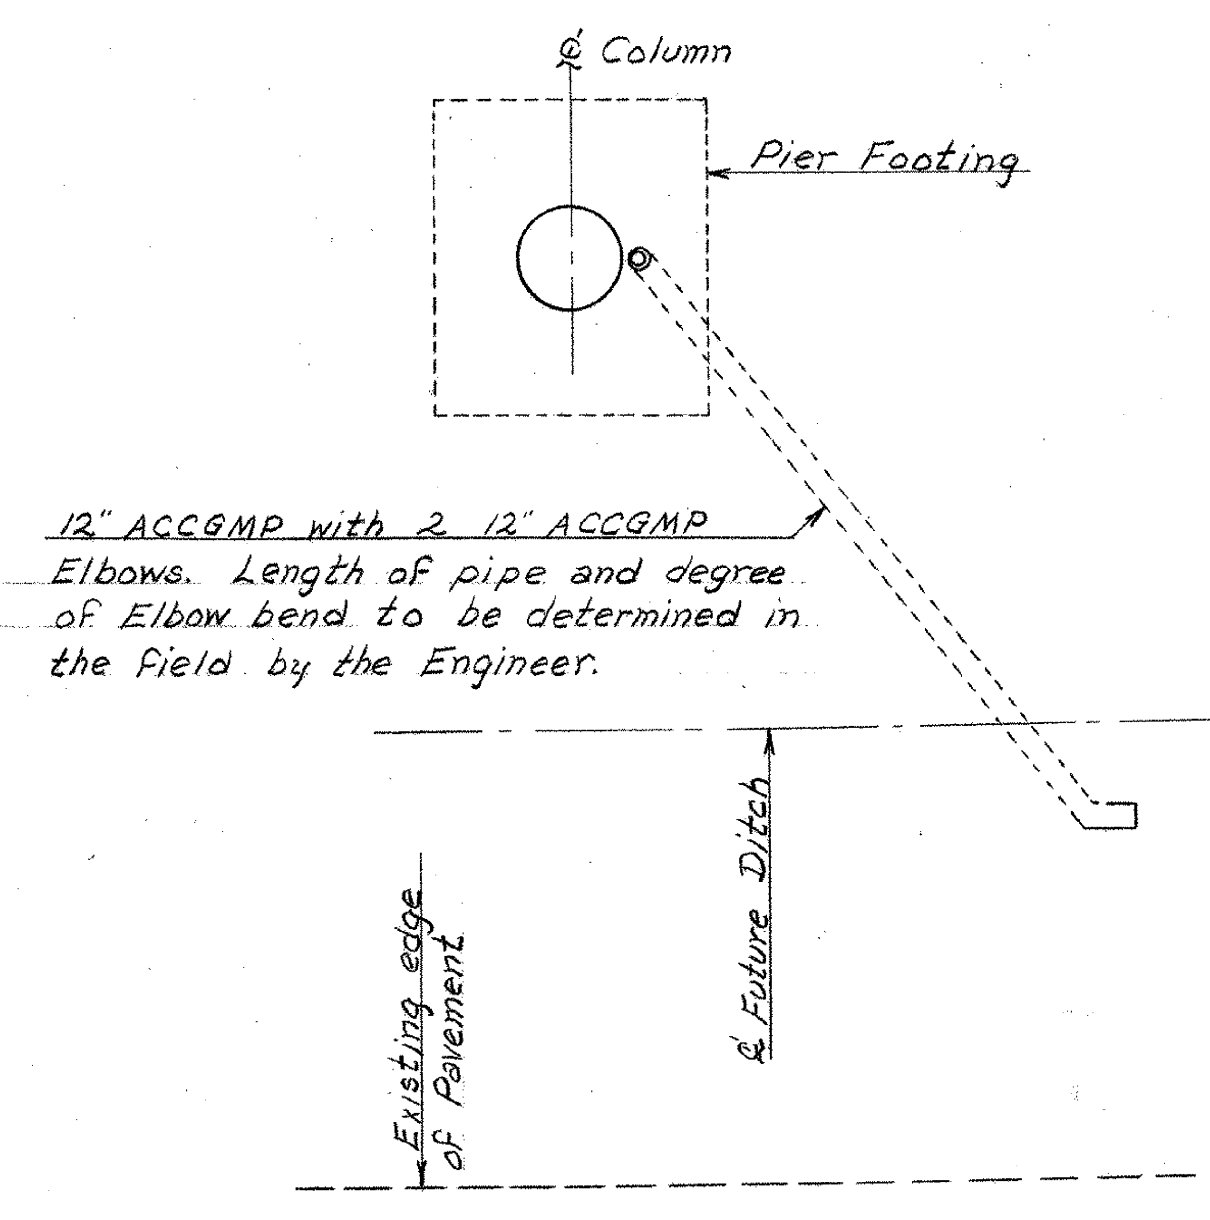

SECTION F-F  
SCALE: 1/8" = 1'-0"

(SECTION IS SHOWN FOR PIERS #1 & #3; DETAILS ARE SIMILAR FOR PIERS #2 & #4.)

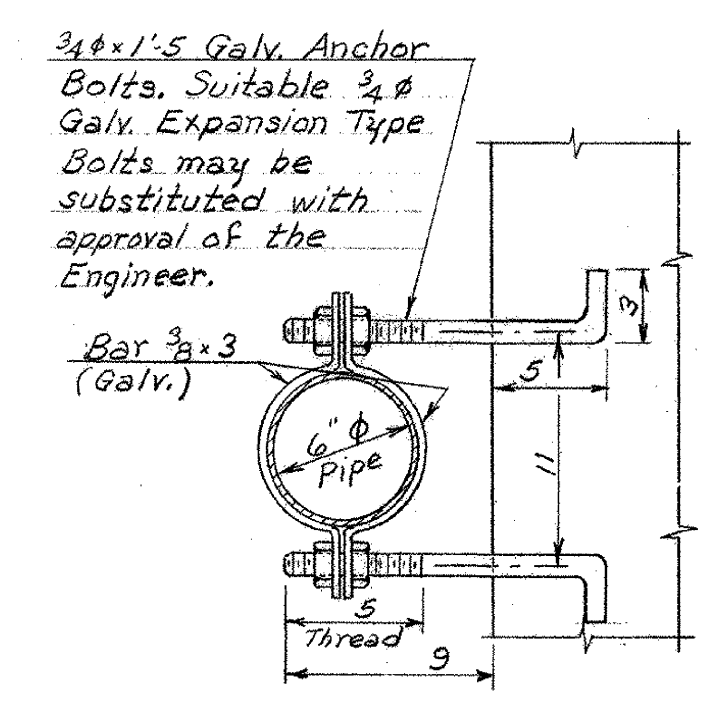


CLAMP DETAIL - TYPE B  
SCALE: 1 1/2" = 1'-0"

THIS SHEET FOR REFERENCE ONLY  
BERLIN IM 089-1(20)  
BRIDGES 40 N&S  
SHEET 90 OF 104


NOTE: SEE BR. 412 FOR NOTES

STATE OF VERMONT  
DEPARTMENT OF HIGHWAYS


PROJECT BERLIN - MONTPELIER  
TOWNS OF BERLIN & MONTPELIER  
ROUTE NO. I 89 STA. 193+50±  
I 89 OVER VT. 12  
FINGER PL. AND DRAINAGE DETAILS  
SCALE AS NOTED  
IN CHARGE W. SMITH  
DRAWN BY W. TRIPP CHECKED BY R. LADD  
PROJECT NO. I 89 (30)  
SHEET 90 OF 104 BR. 413

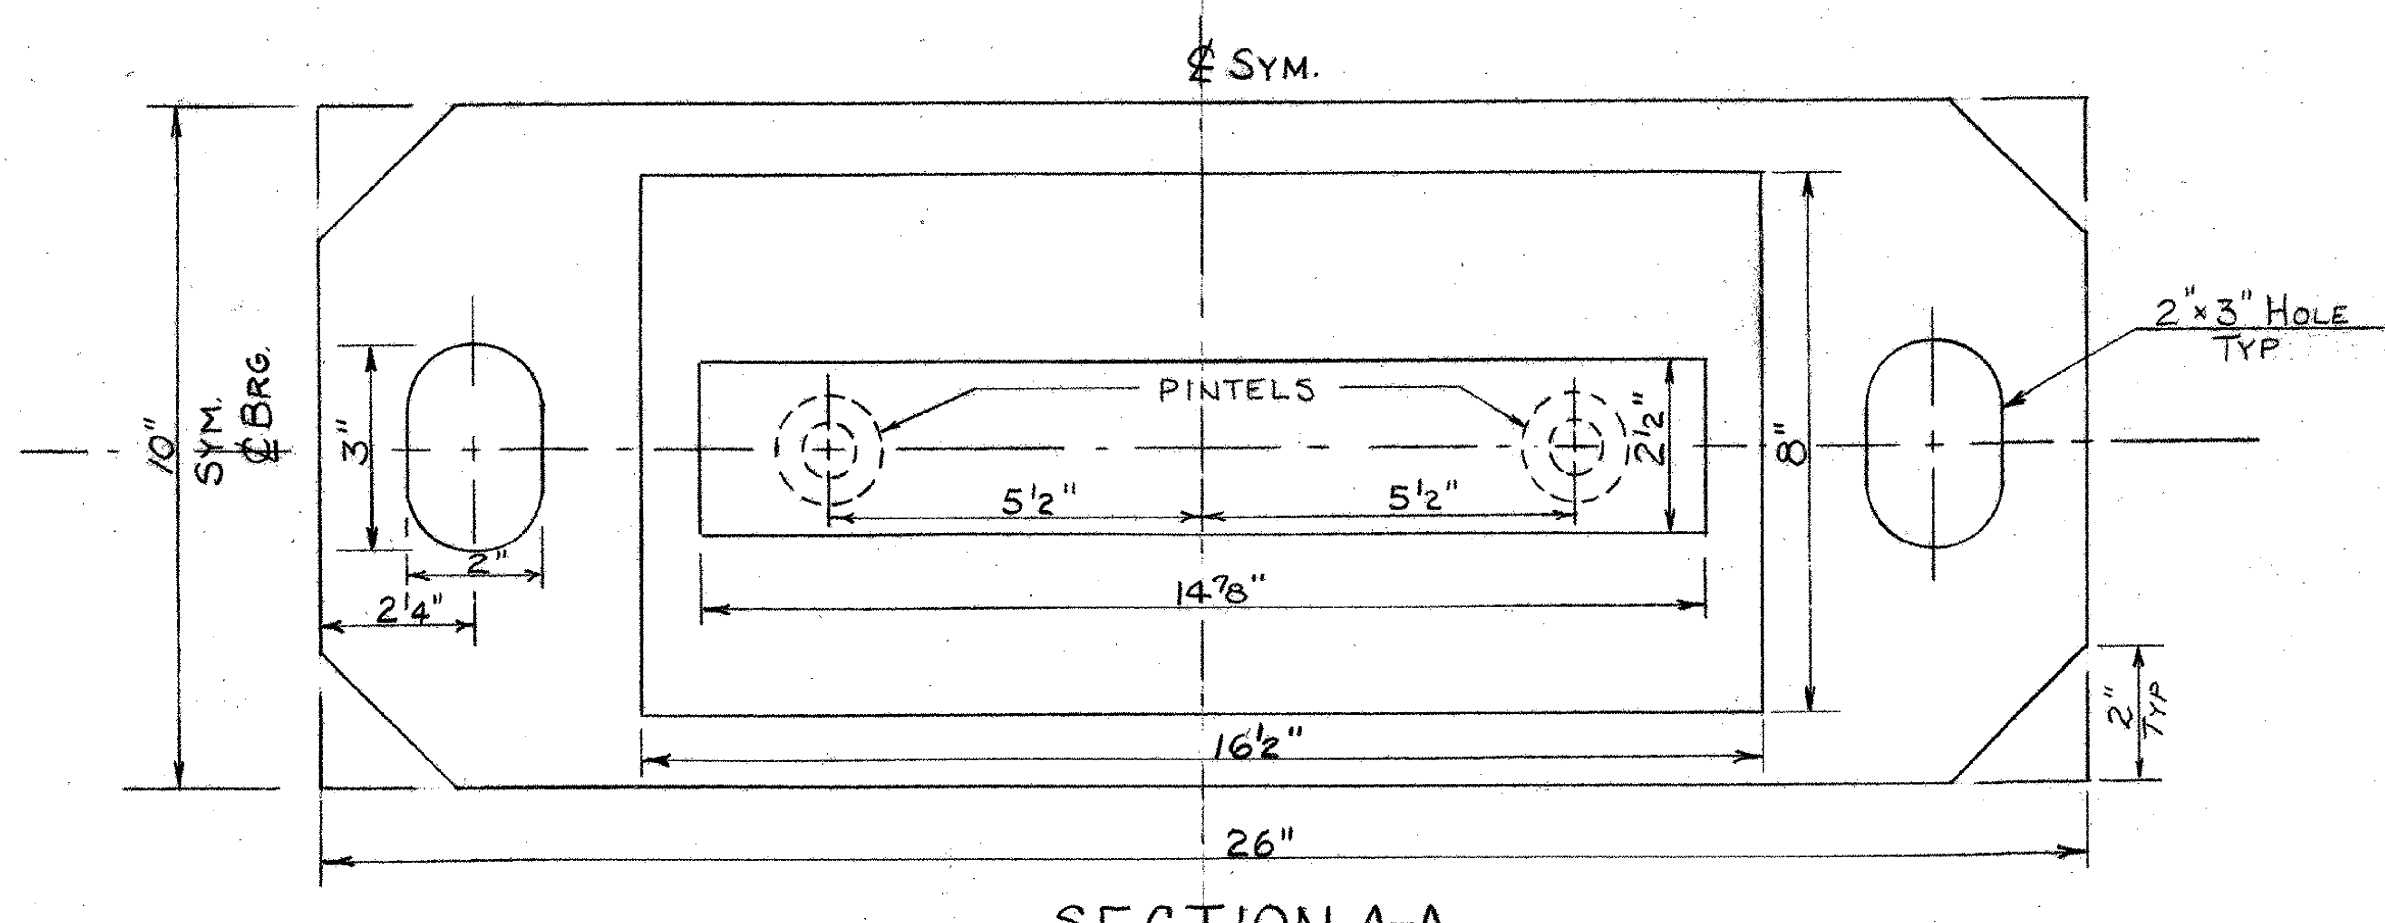

SECTION A-A

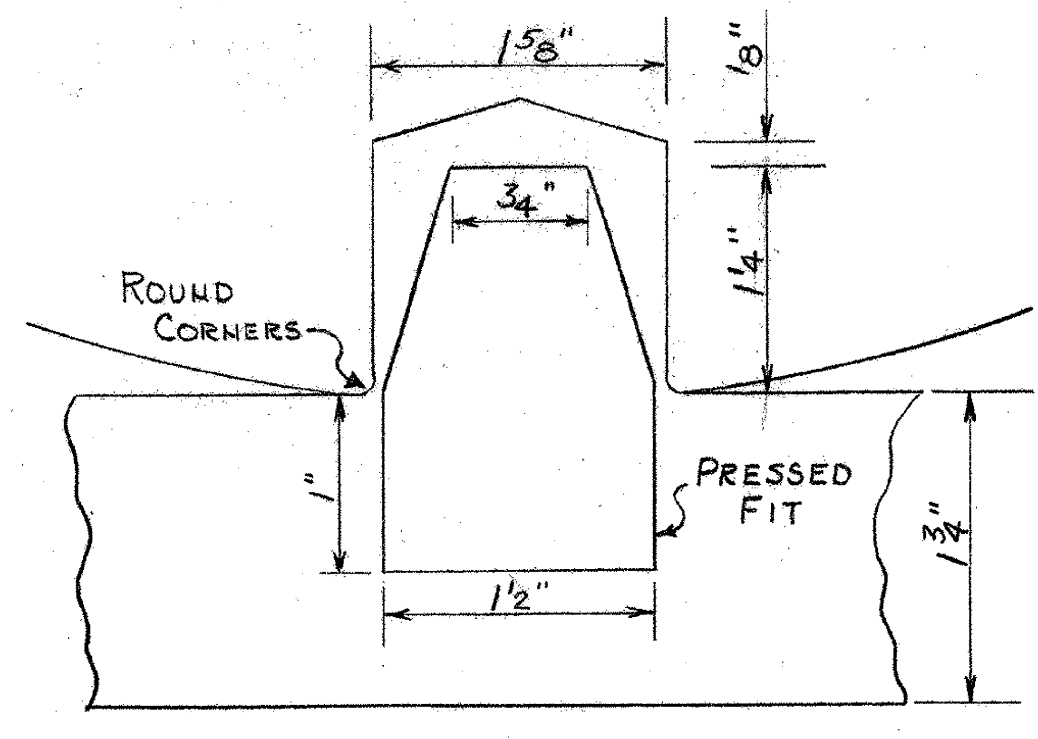


PINTEL DETAIL  
N.T.S.

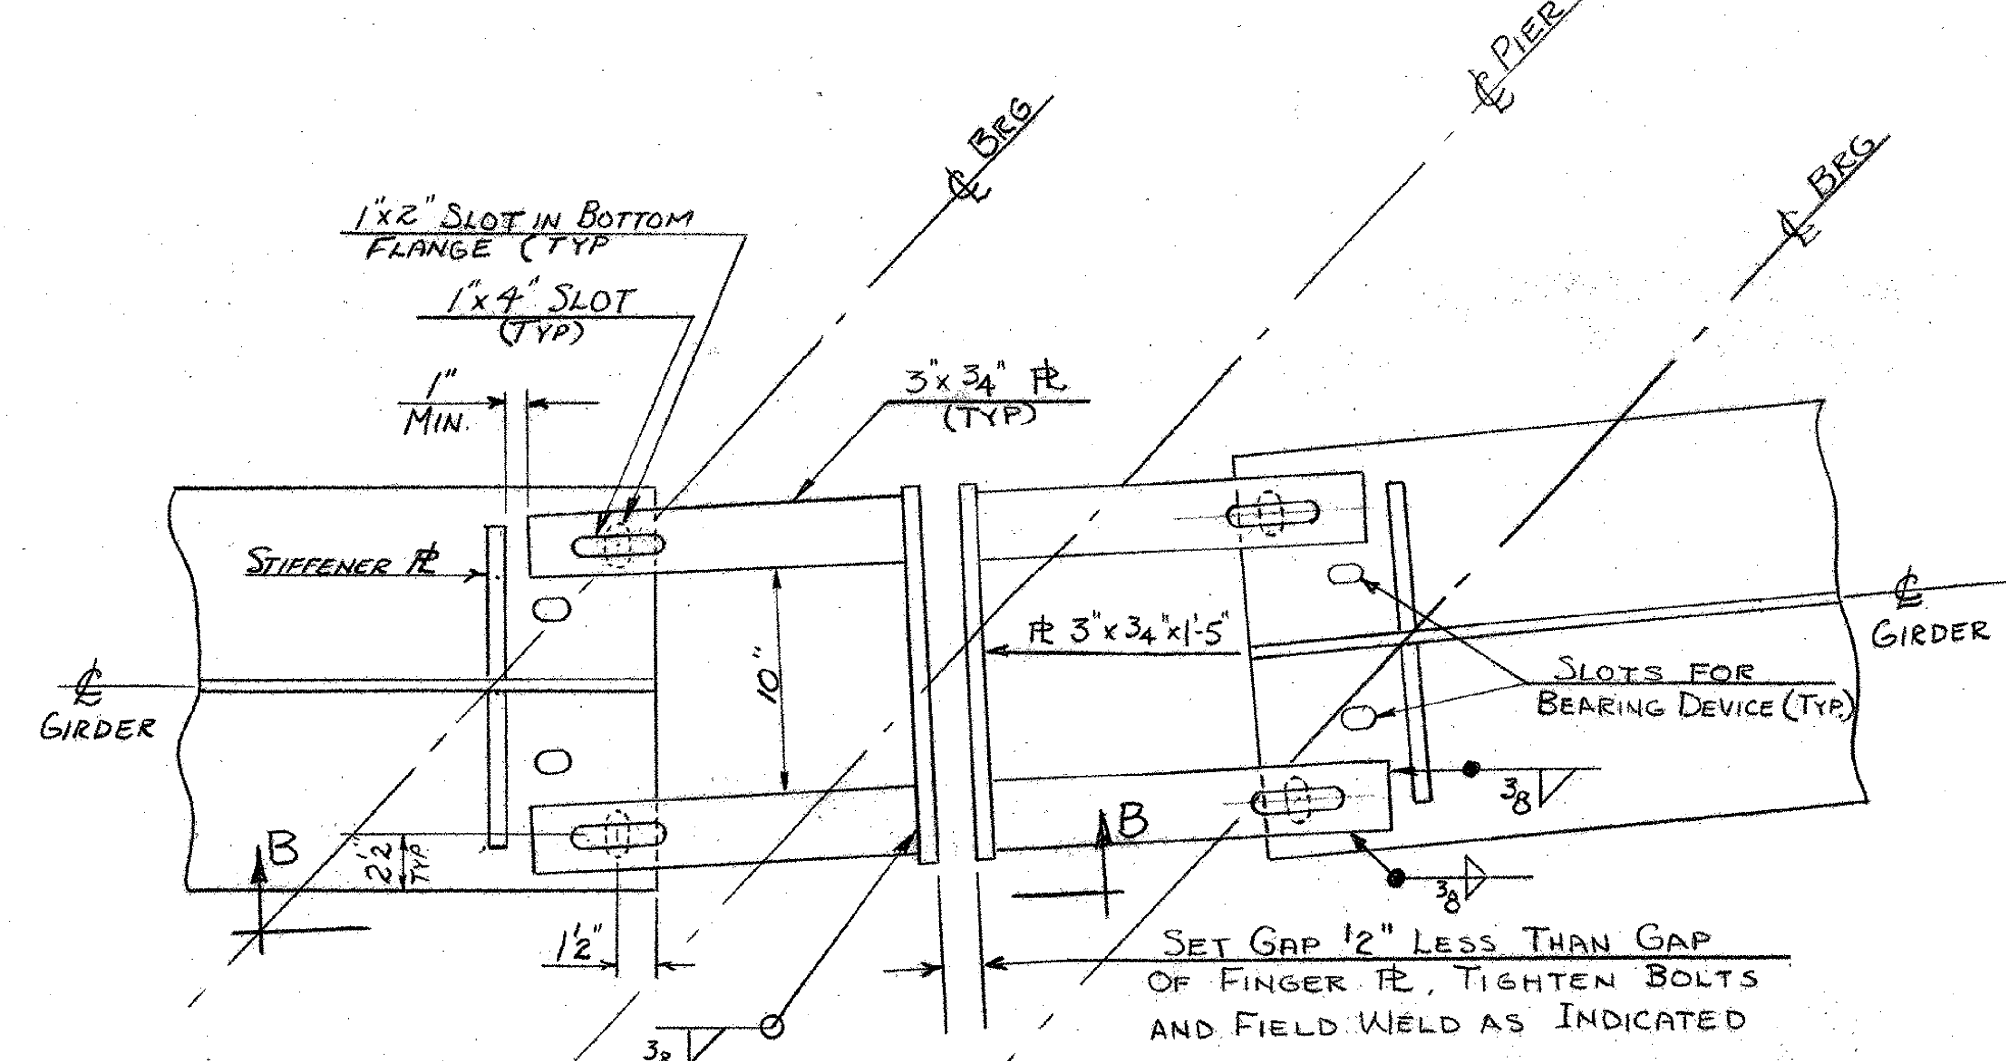

GIRDER BUMPER DETAIL

SCALE: 1/2" = 1'-0"


NOTE: USE GIRDER BUMPER AT:  
 3G-2+3G-8 } PIER #1  
 3G-5+3G-11 }  
 3G-8+3G-14 } PIER #2  
 3G-11+3G-17 }  
 NG-2+NG-8 } PIER #3  
 NG-5+NG-11 }  
 NG-8+NG-14 } PIER #4  
 NG-11+NG-17 }

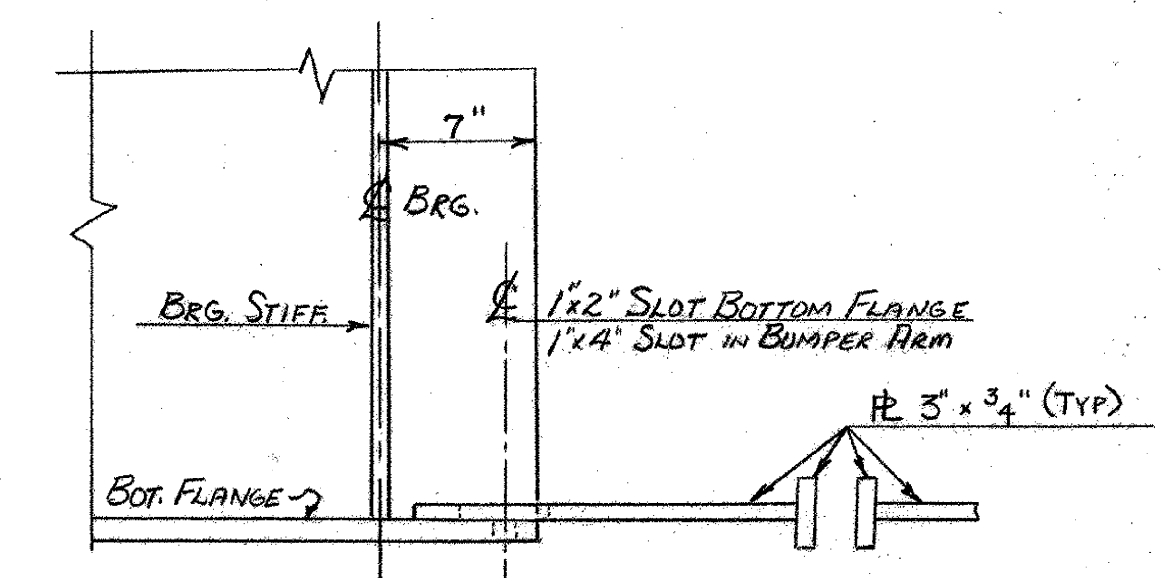

SECTION B-B  
N.T.S.


- NOTES: 1. PREFORMED FABRIC PADS, 1/8" THICK, EQUAL IN SIZE TO THE BEARING PLATES, AND CONFORMING TO SPECIFICATION 404.02 (23) SHALL BE USED UNDER EACH BEARING
2. ALIGN DEVICES SO THAT ALL ROCKER ARM SHAFTS WILL BE VERTICAL @ 45° F.
3. CONTACT SURFACES OF ROCKERS ARE TO BE GIVEN ONE SHOP COAT OF WHITE LEAD AND TALLOW. PINTEL HOLES ARE TO BE FILLED WITH GRAPHITE AND GREASE AT TIME OF PLACEMENT. REMAINDER OF BEARING DEVICE IS TO BE GIVEN (3) THREE COATS OF PAINT IN ACCORDANCE WITH SPECIFICATION 404.03
4. FOR GENERAL NOTES SEE BR-400

THIS SHEET FOR REFERENCE ONLY  
 BERLIN 1M 089-(120)  
 BRIDGES 40 N&S  
 SHEET 91 OF 104

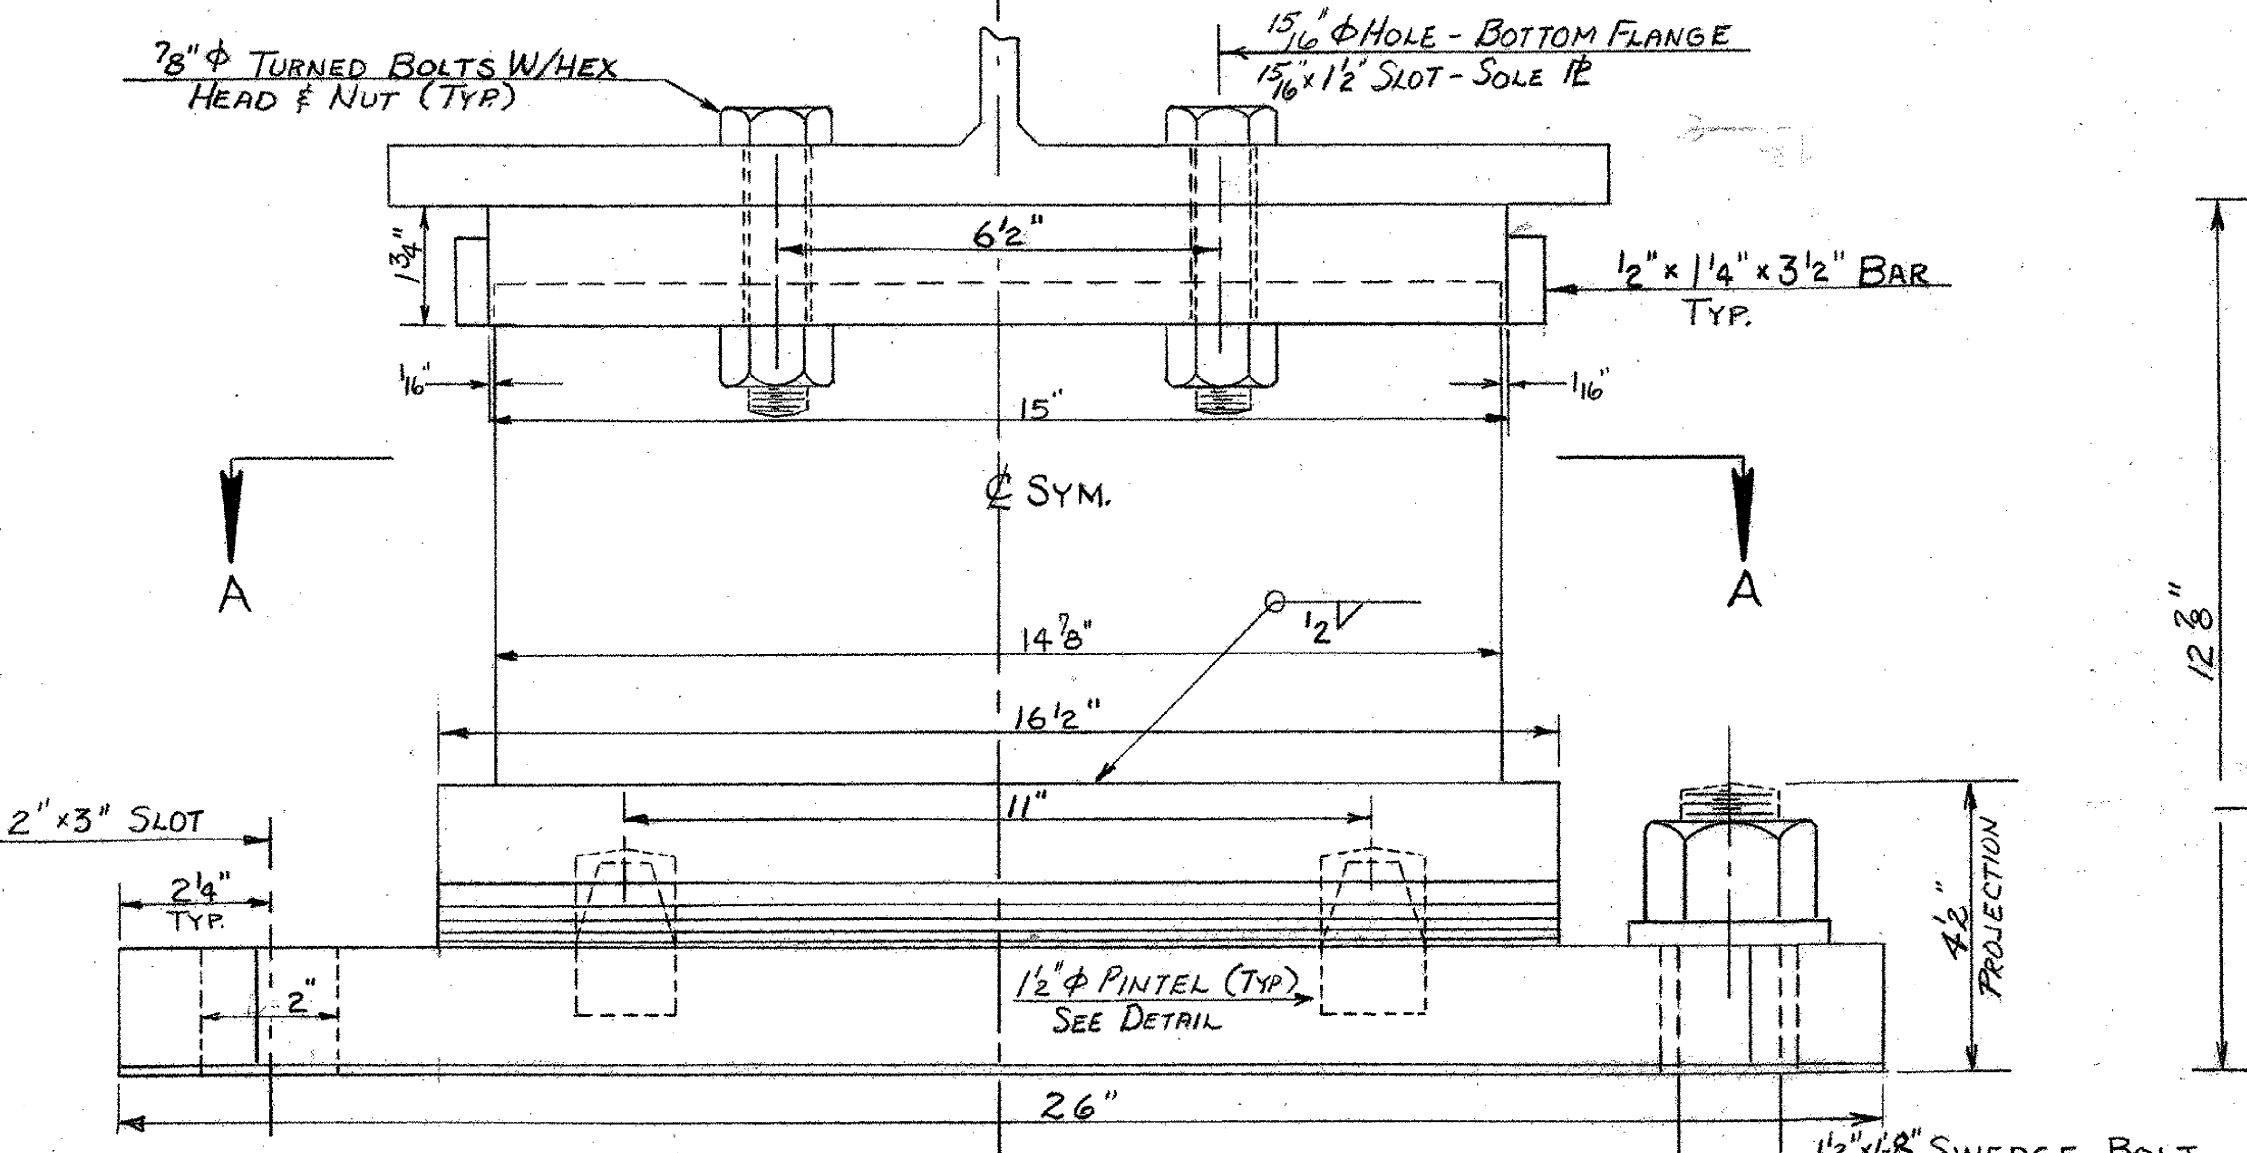


ELEVATION

EXPANSION DEVICE

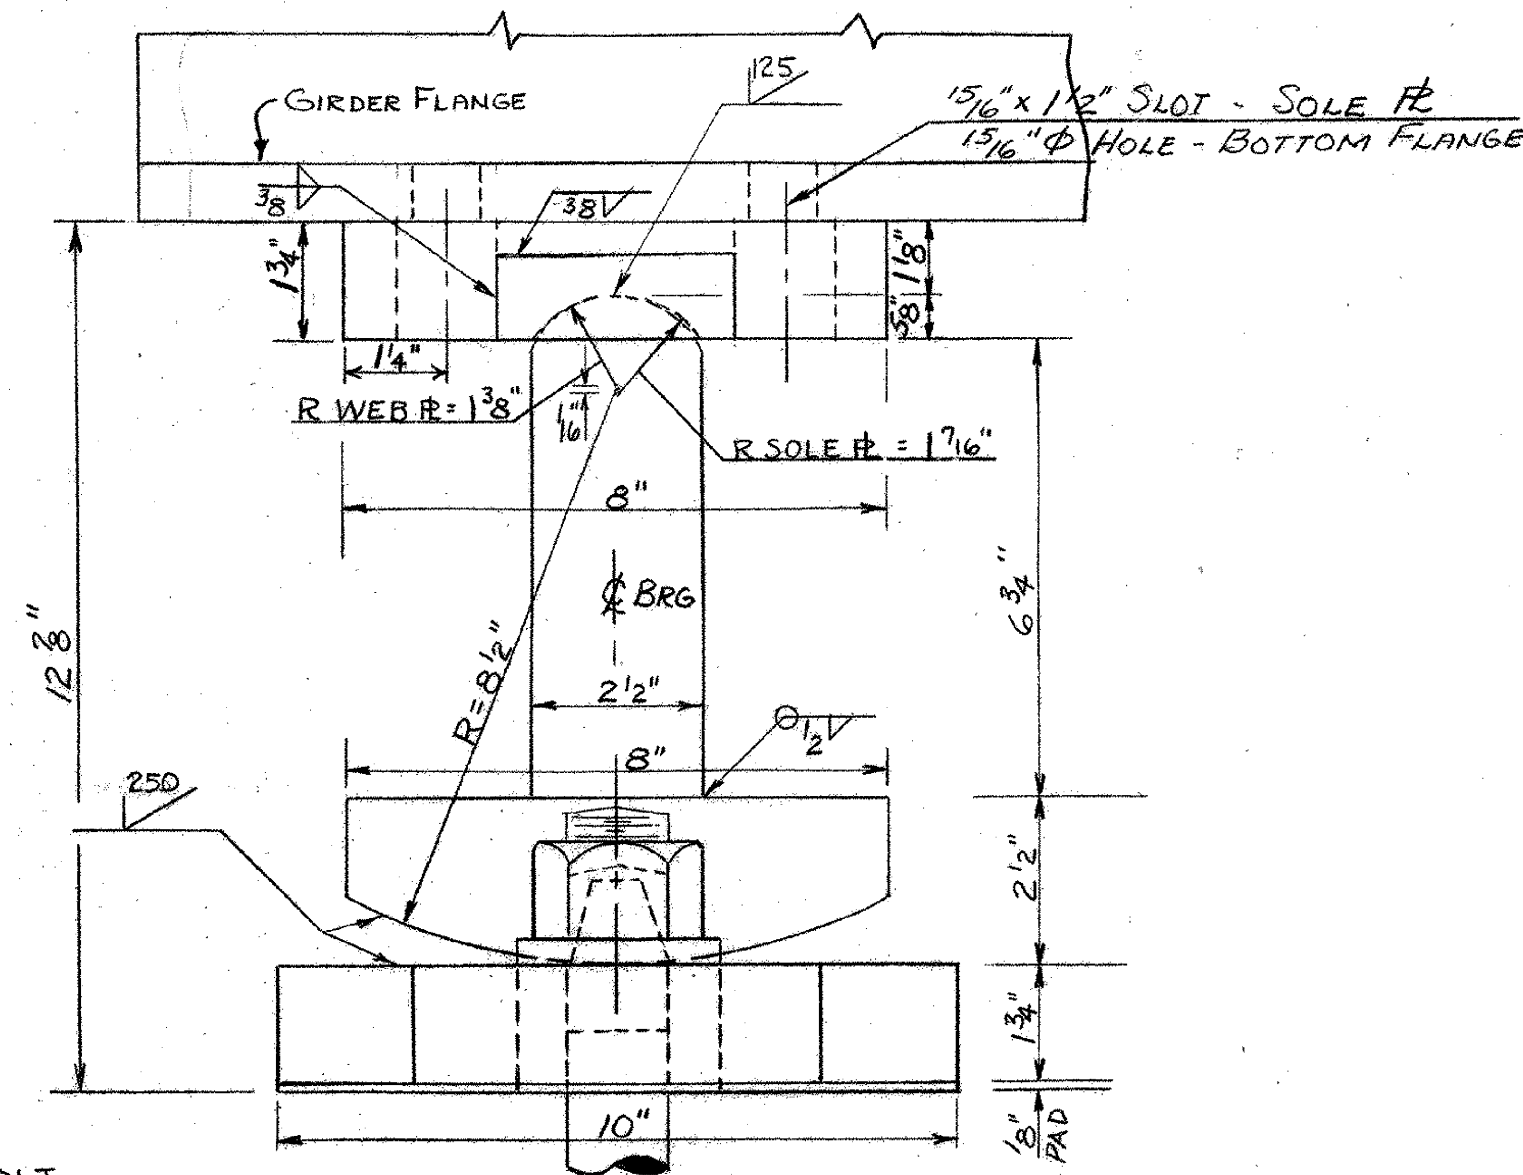


SIDE-VIEW

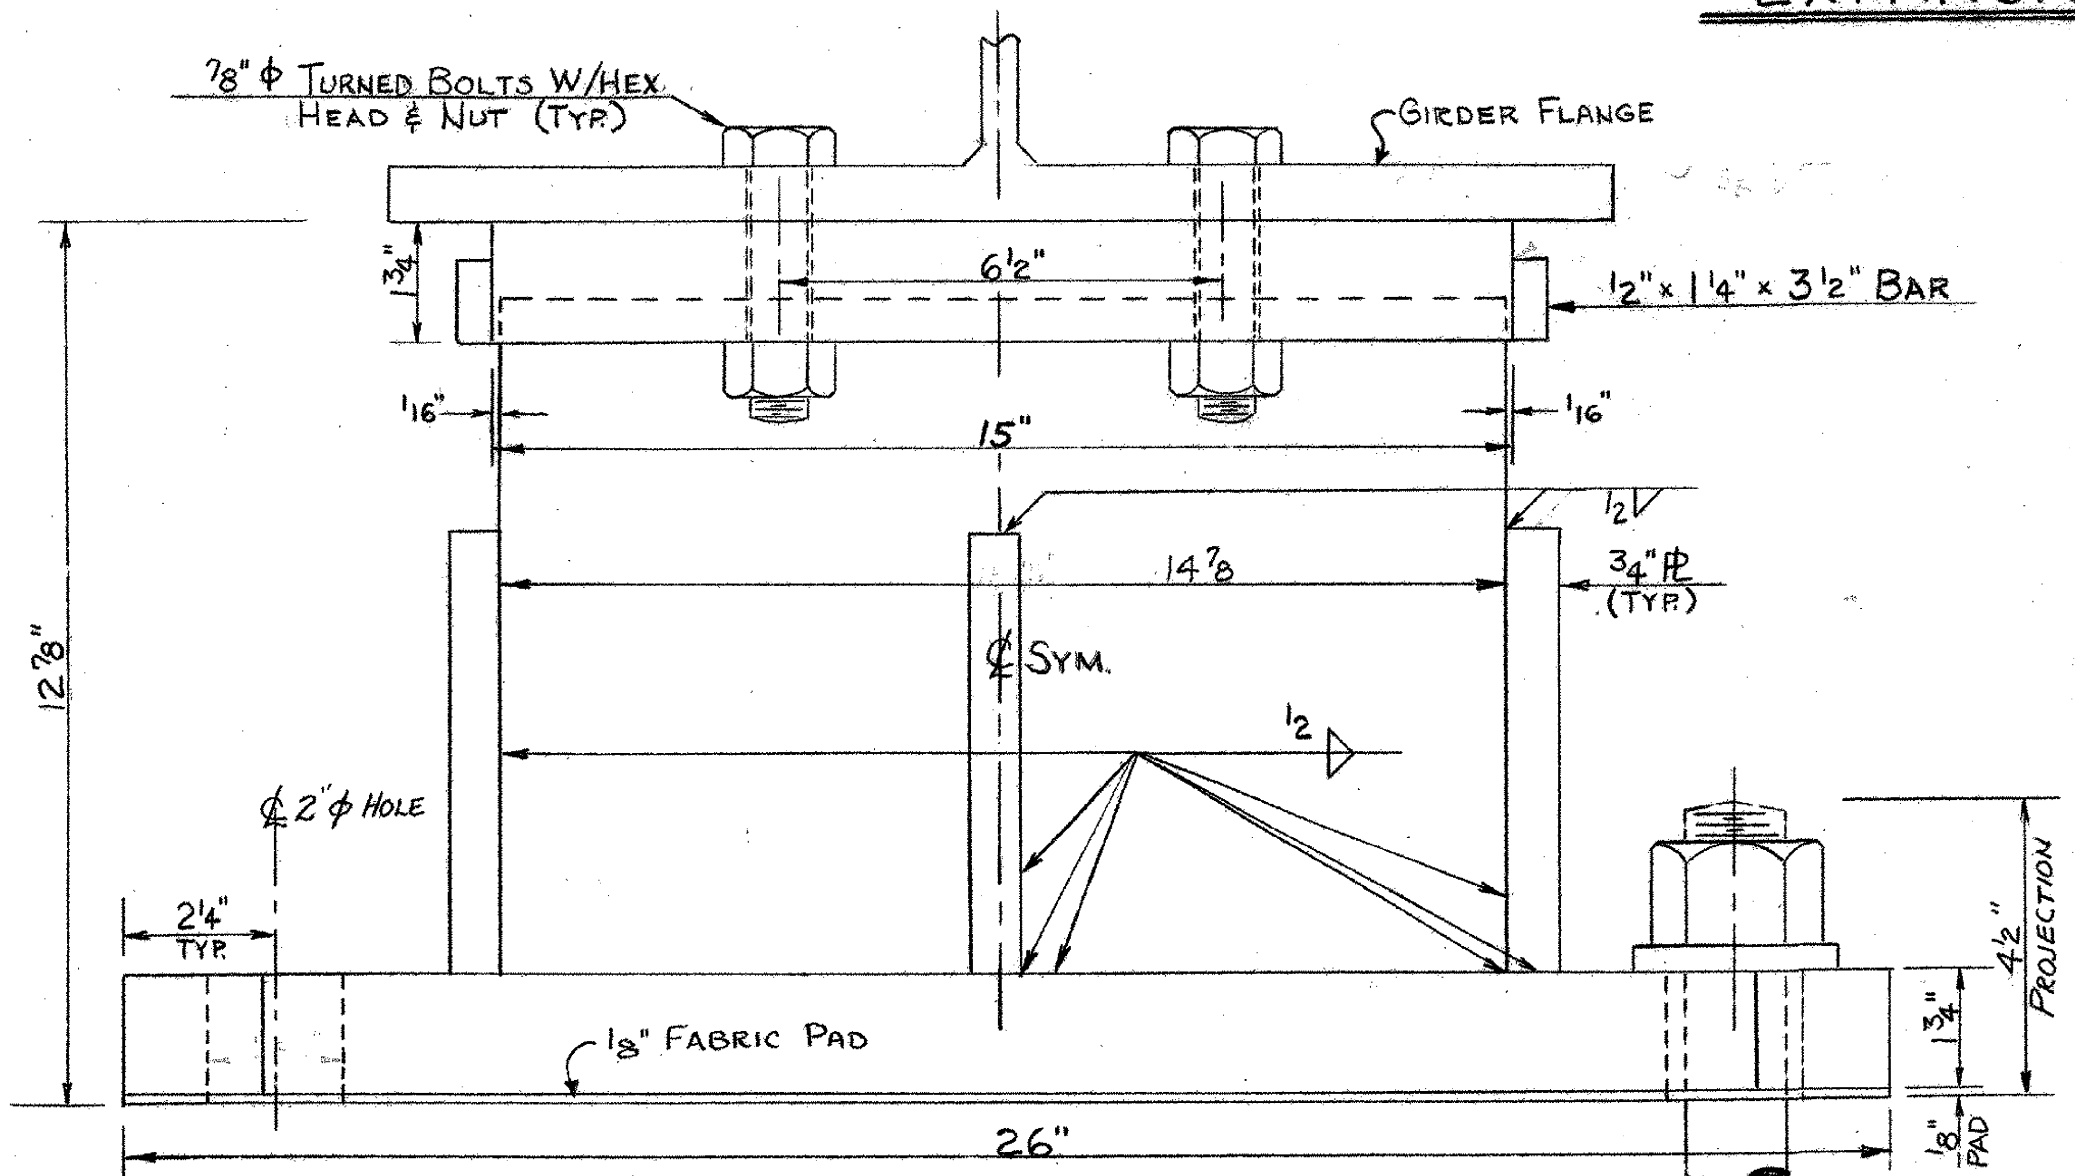

ELEVATION

FIXED DEVICE

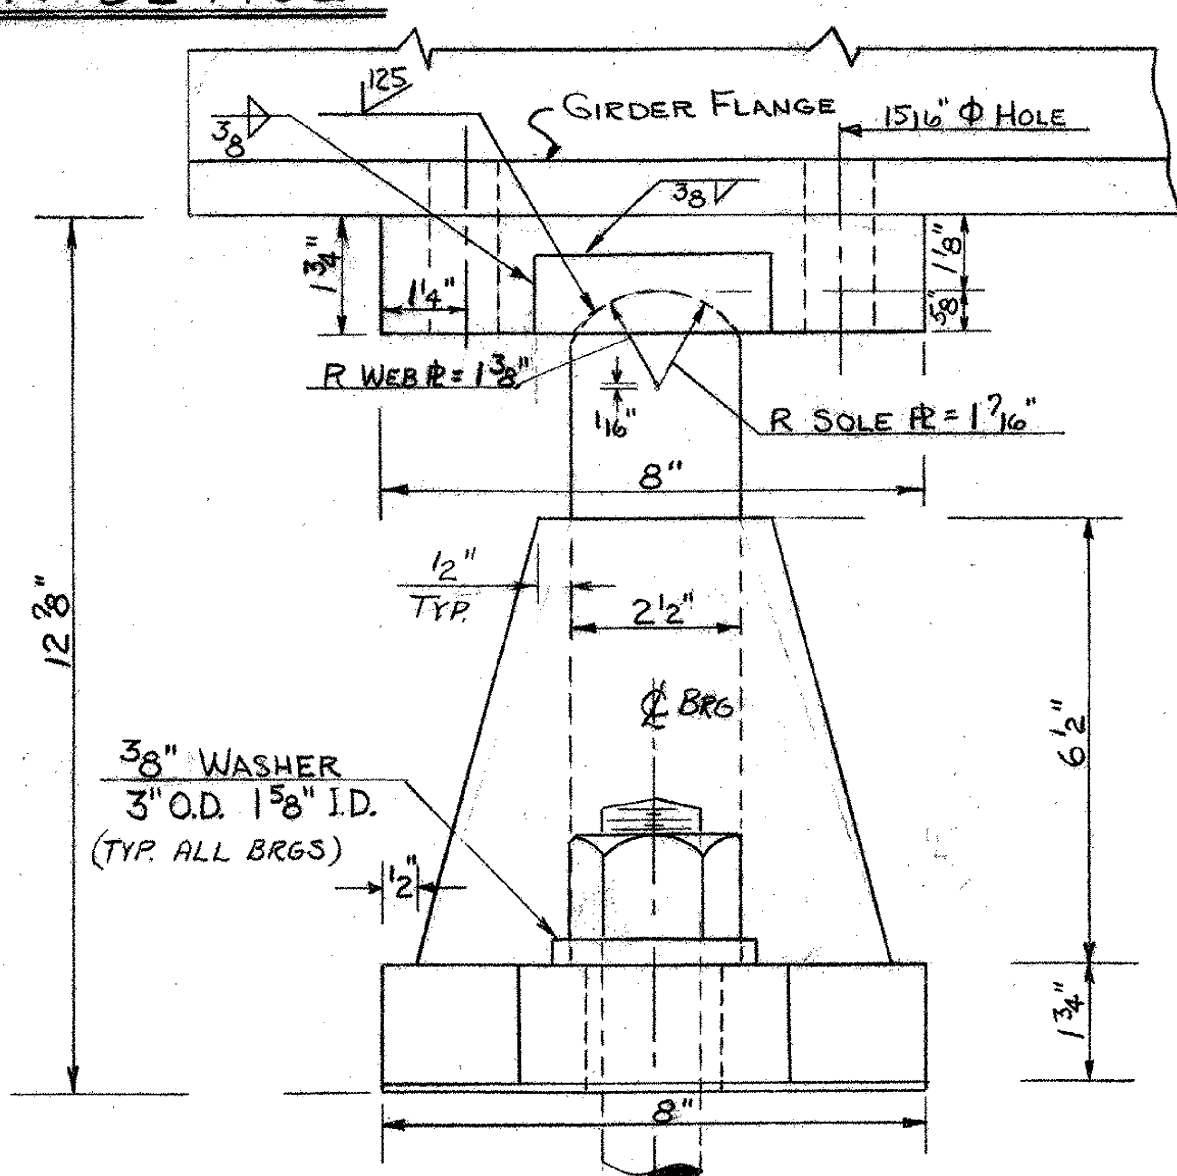

SIDE-VIEW









1/2x1/8 SWEDGE BOLT - 2 REQUIRED EACH BEARING DEVICE

STATE OF VERMONT  
 DEPARTMENT OF HIGHWAYS

PROJECT BERLIN-MONTPELIER  
 TOWNS OF BERLIN & MONTPELIER  
 ROUTE No. 189 STA. \_\_\_\_\_  
189 OVER VT. RTE 12  
 BEARING DEVICE & BUMPER DETAILS  
 SCALE 3/8" = 1" OR AS NOTED  
 IN CHARGE W. SMITH  
 DRAWN BY R. LADD CHECKED BY W. TRIPP  
 PROJECT No. 189-1(12)  
 SHEET 165 OF 197 BR-414





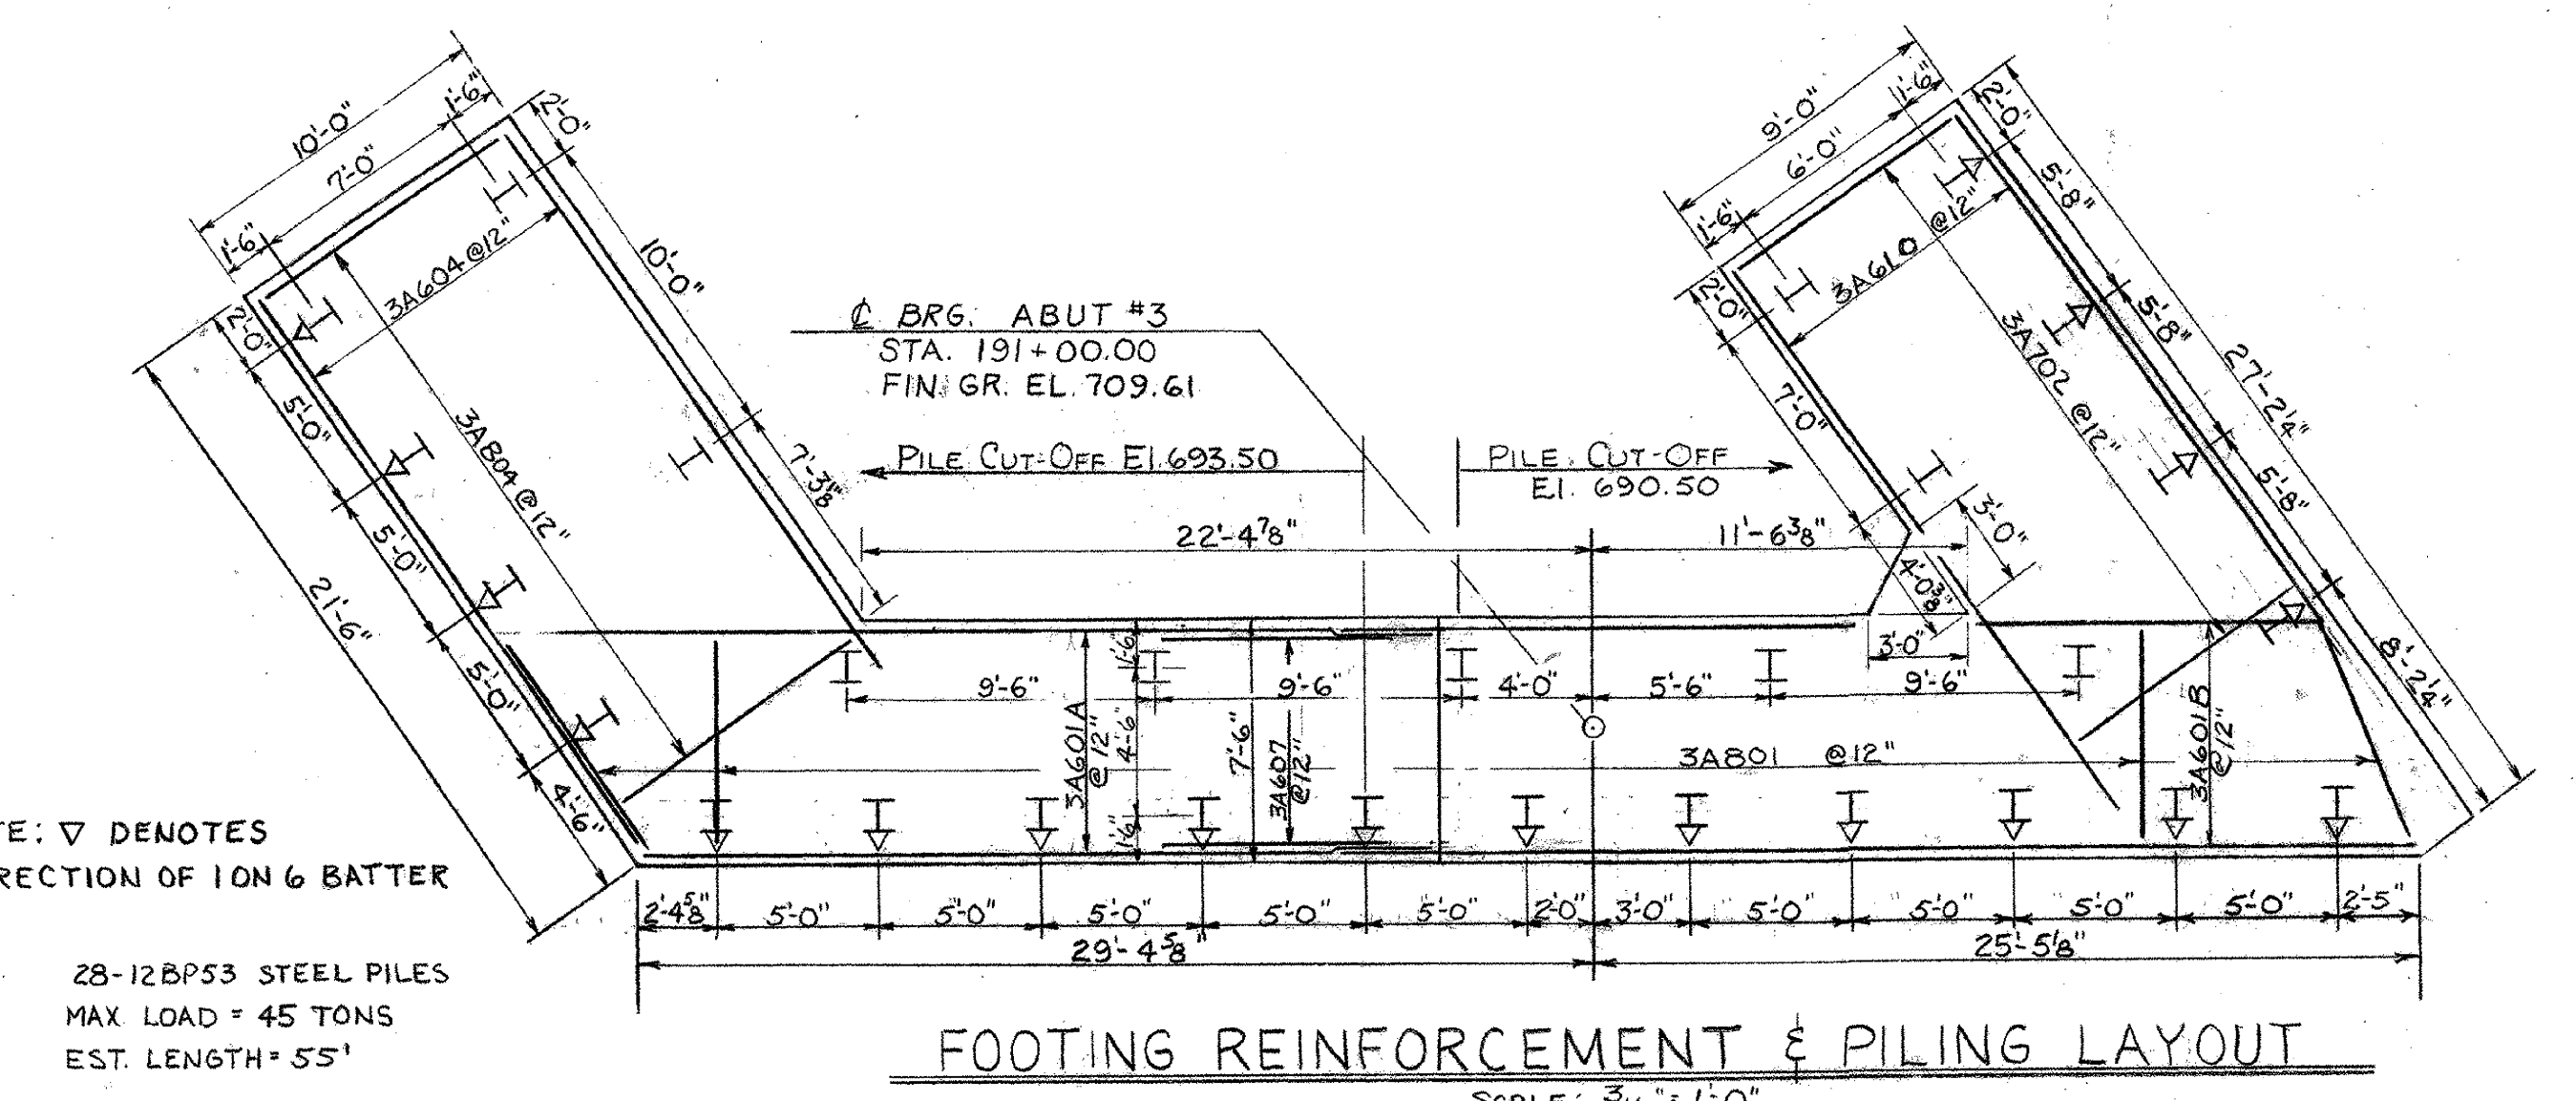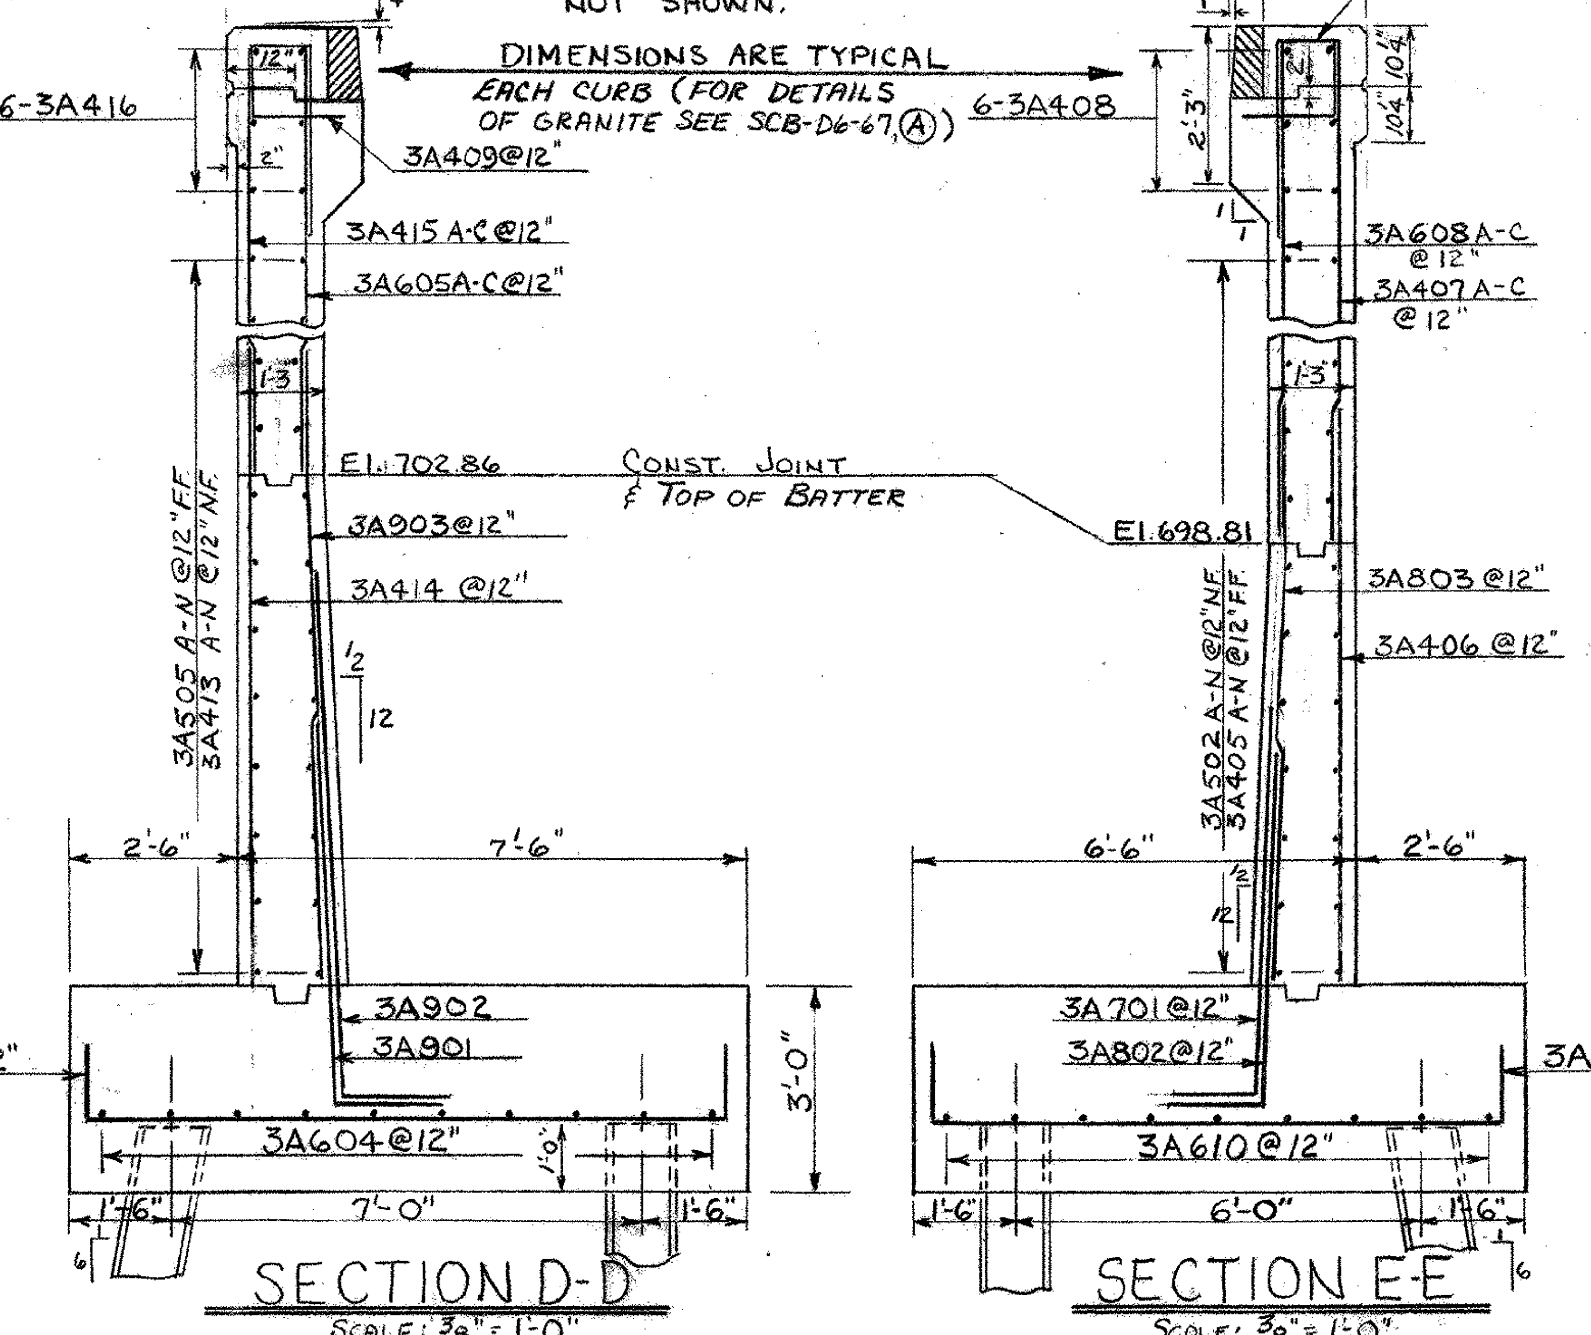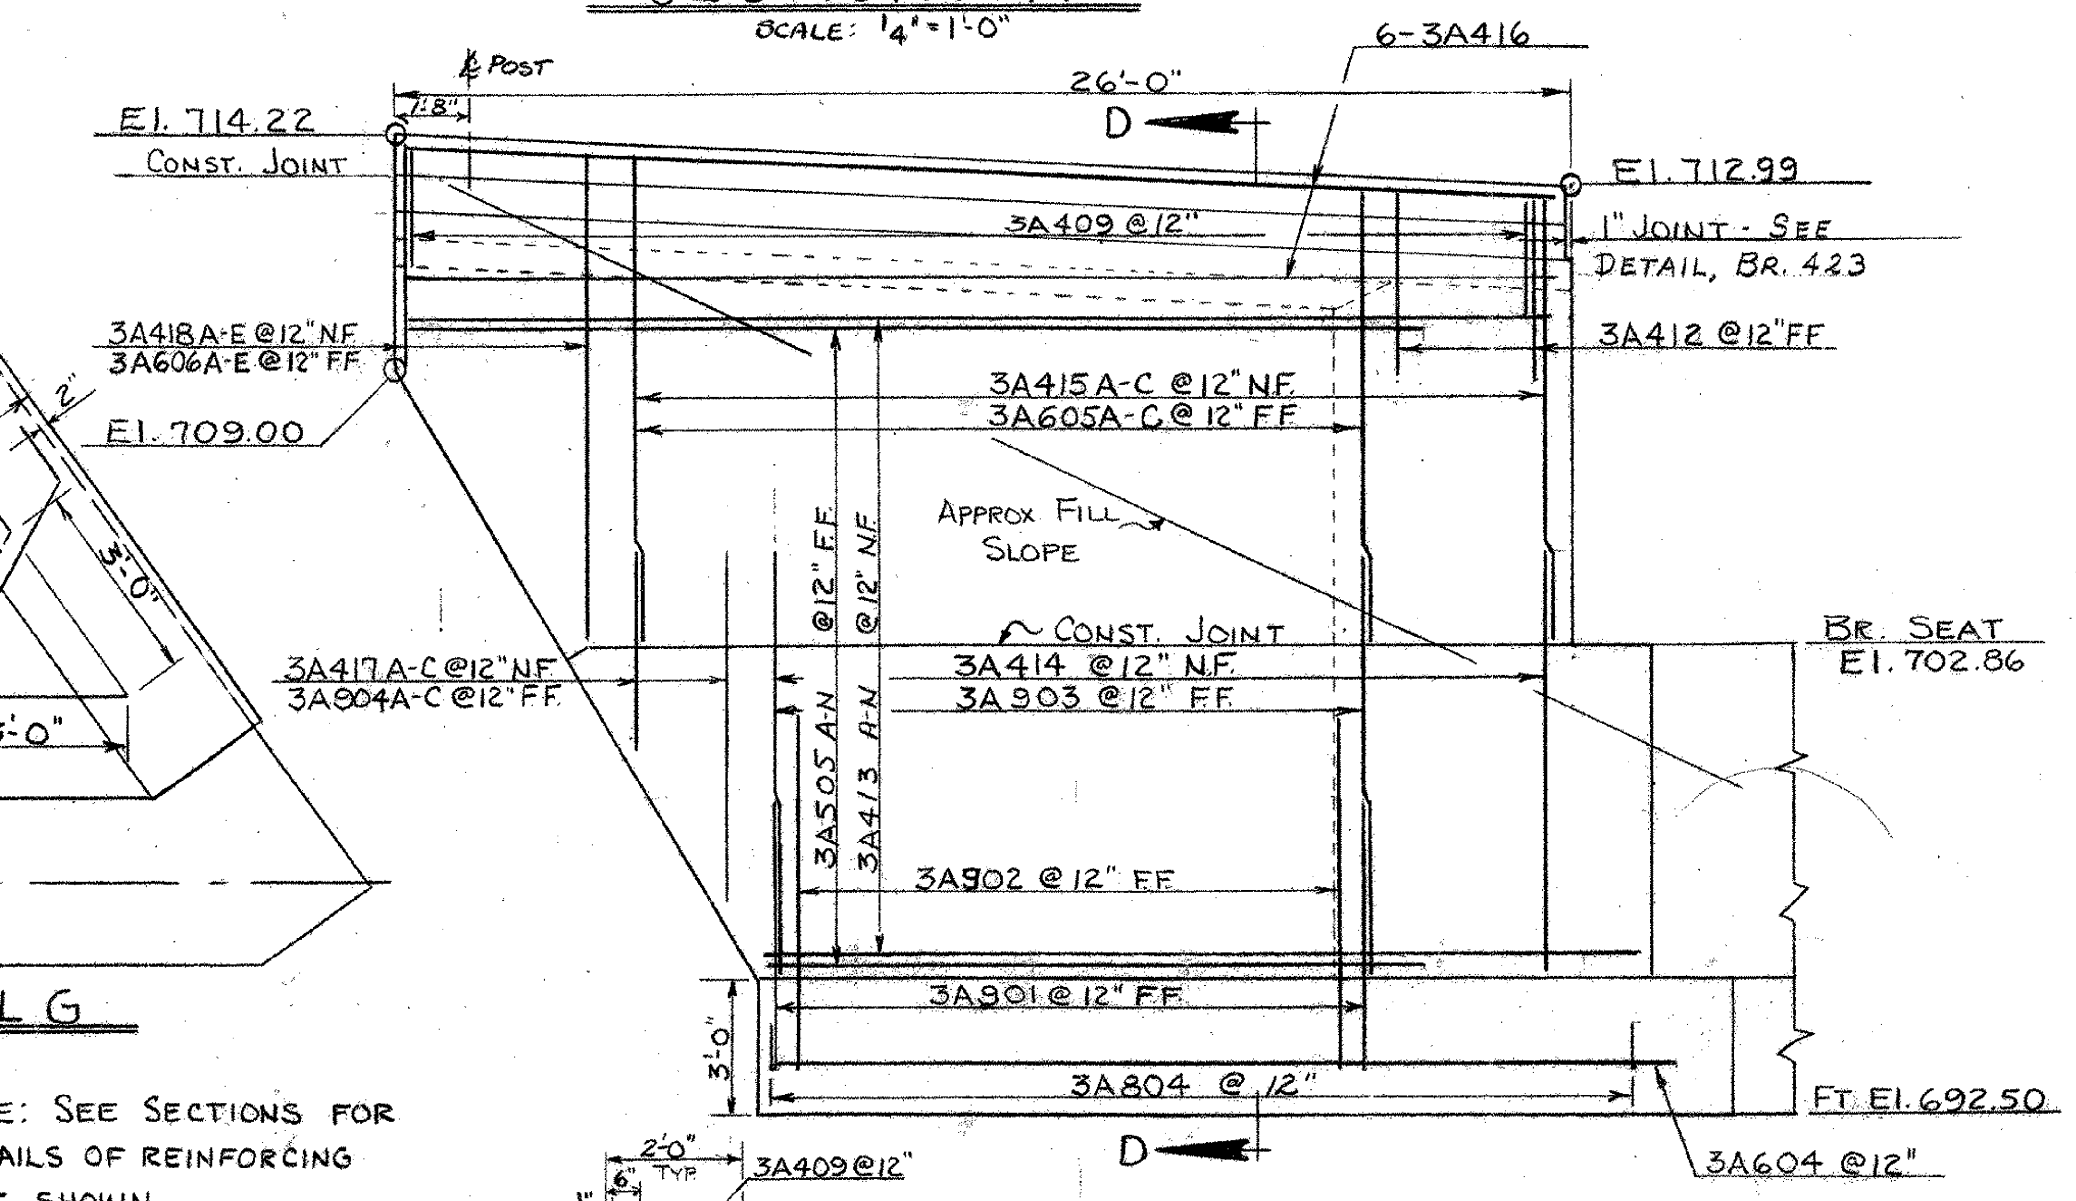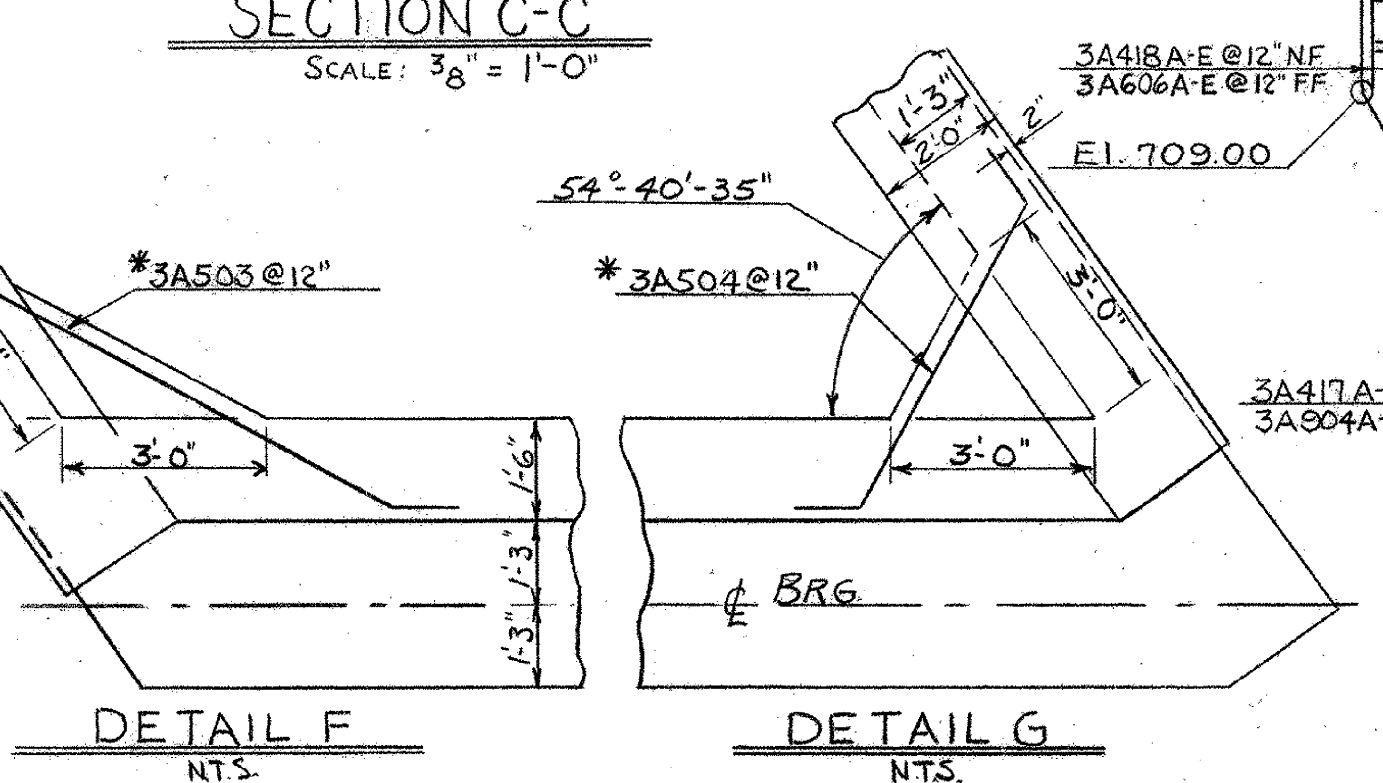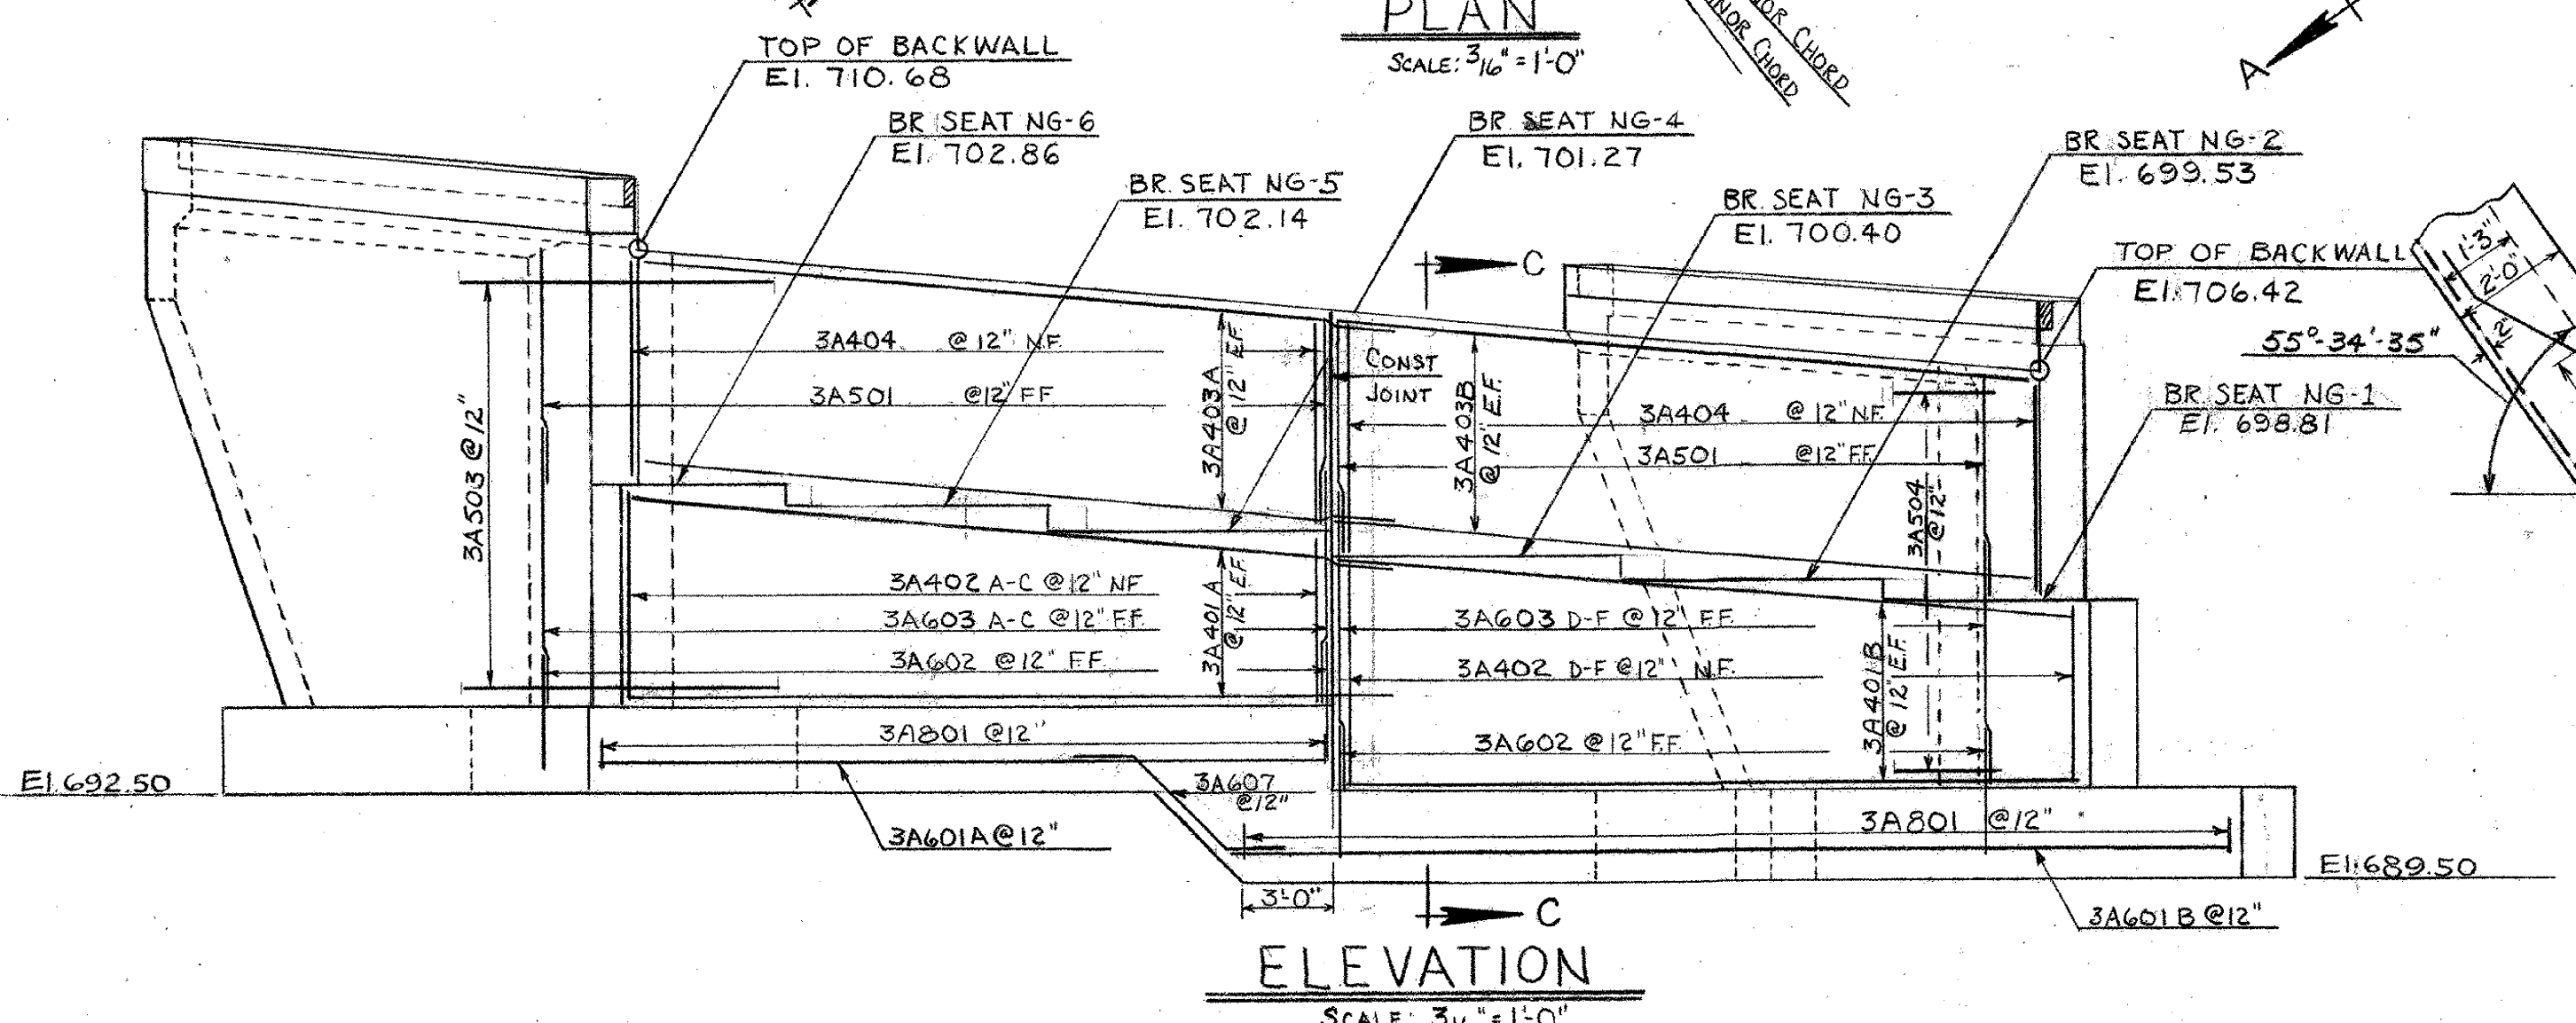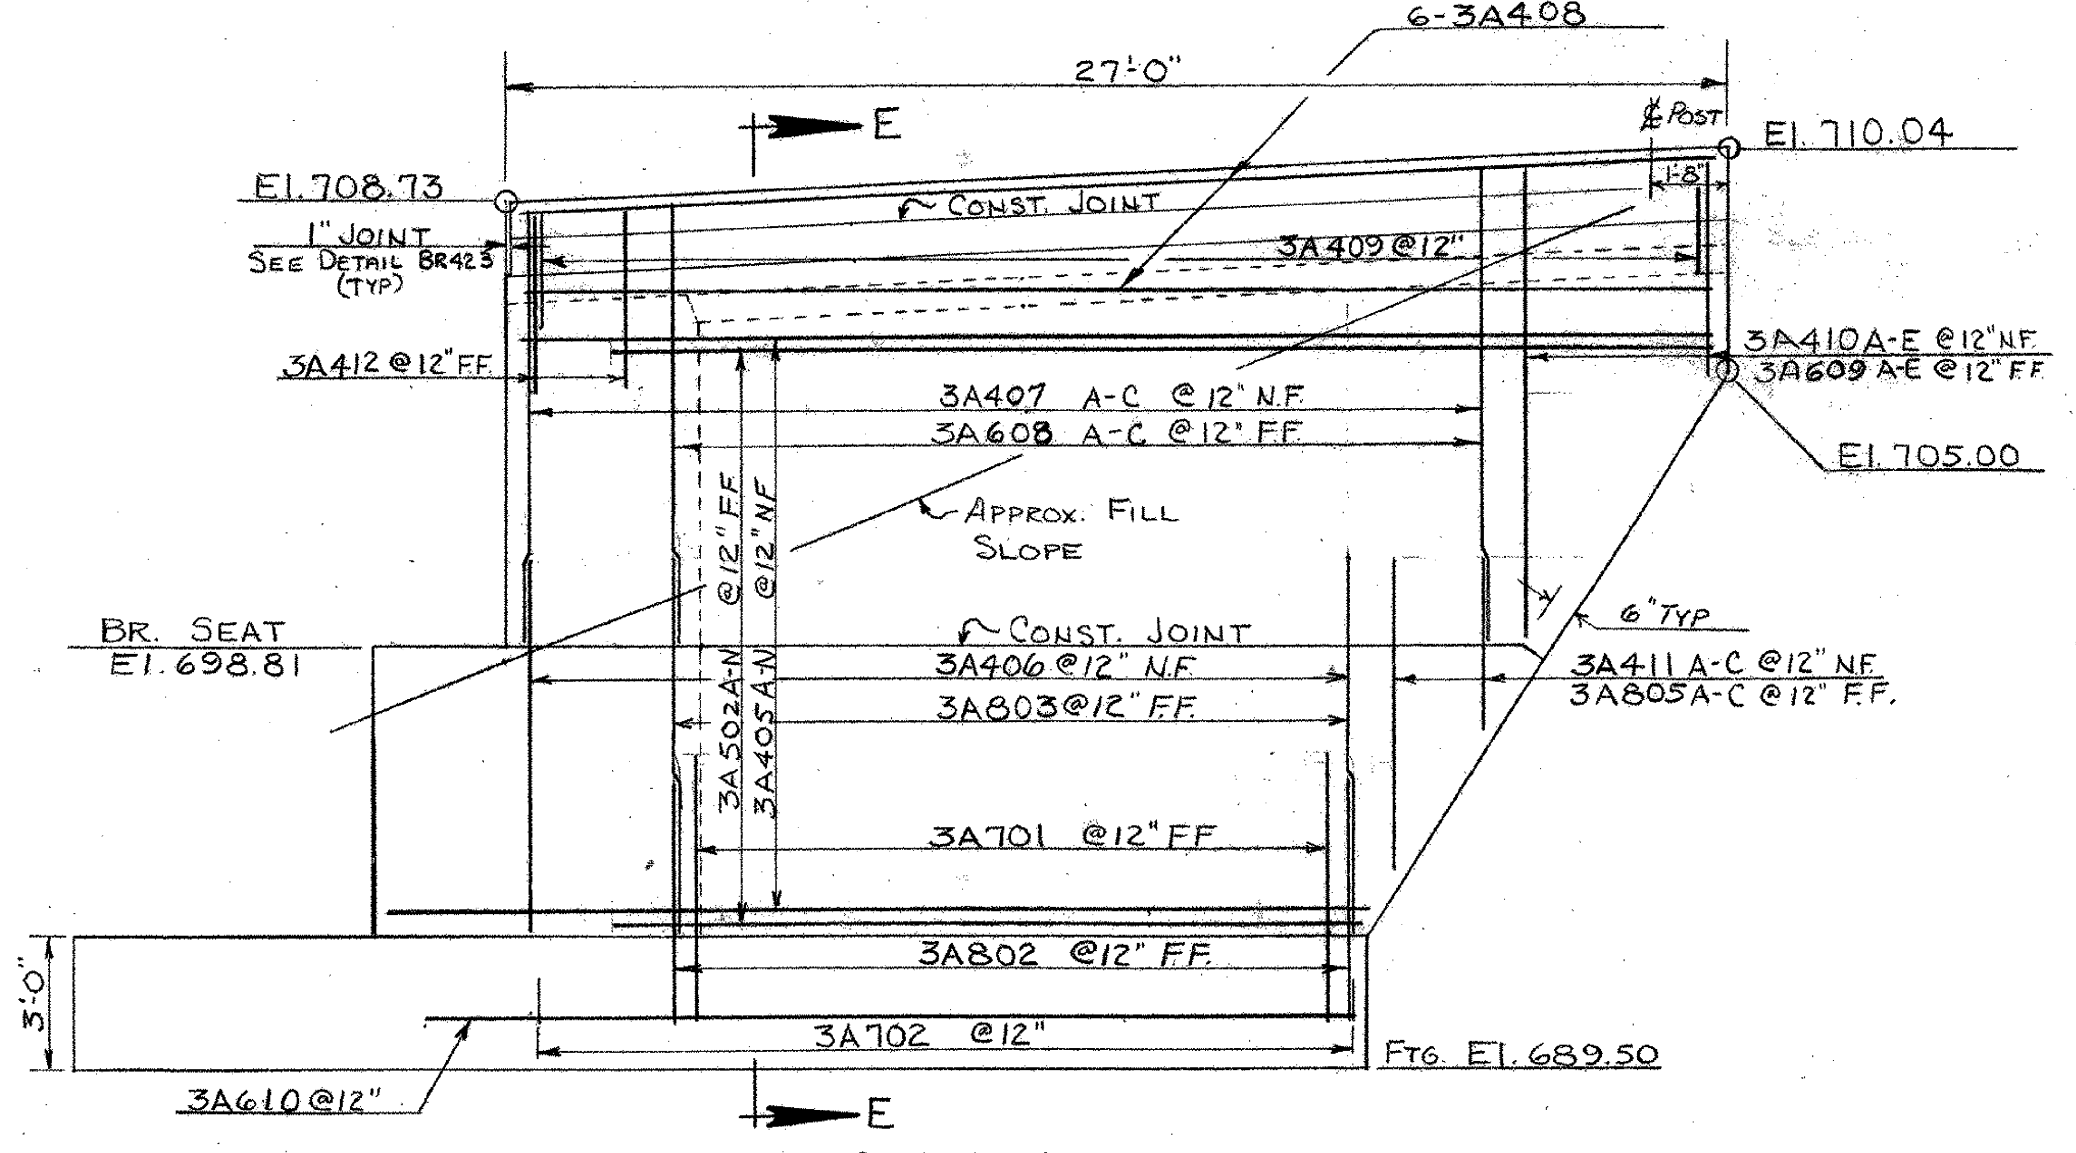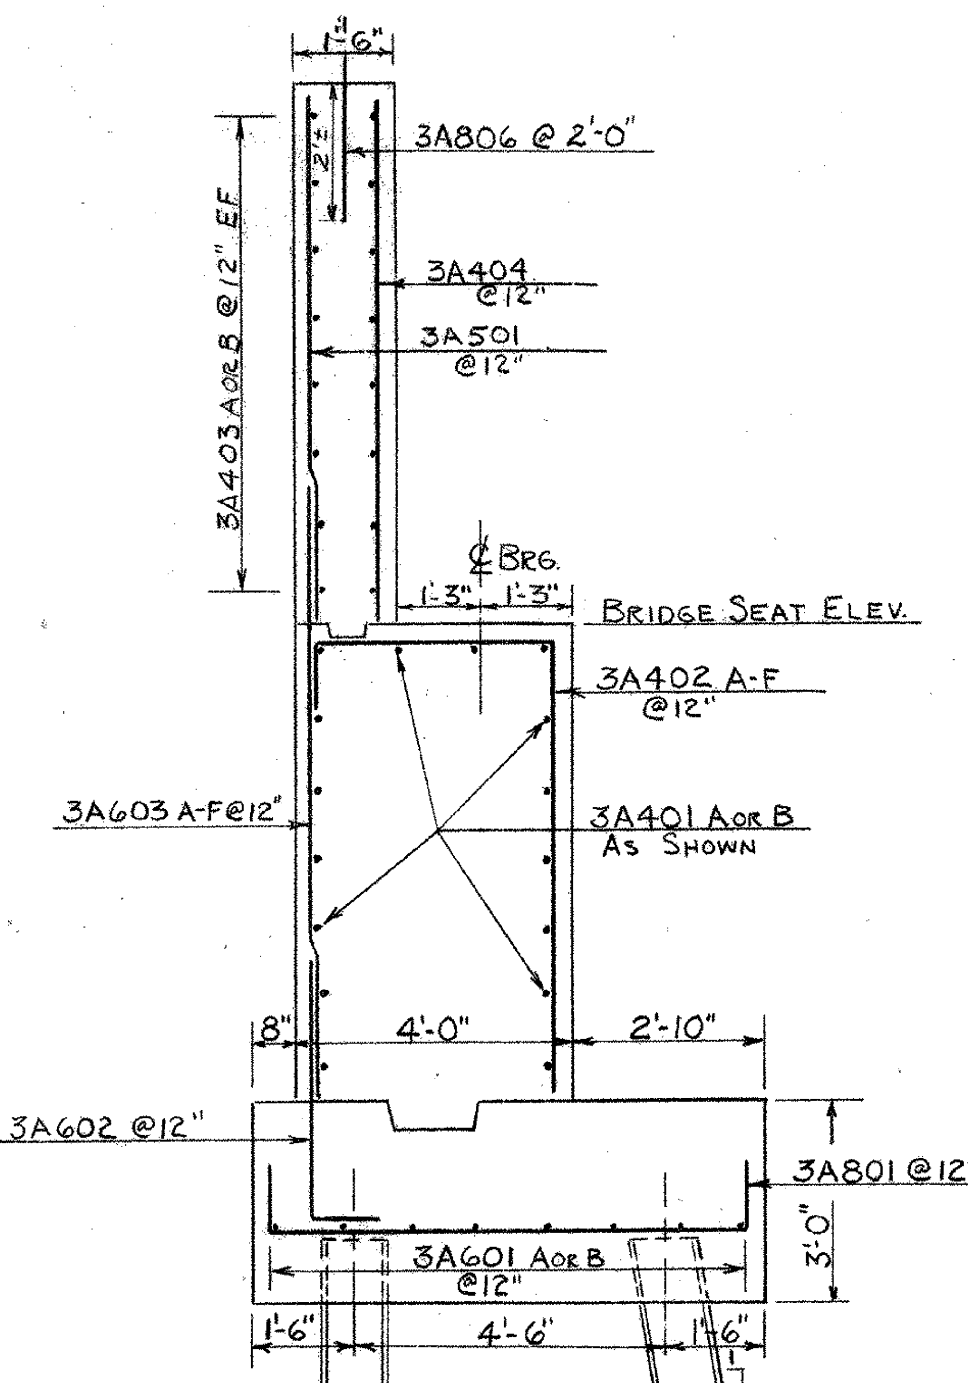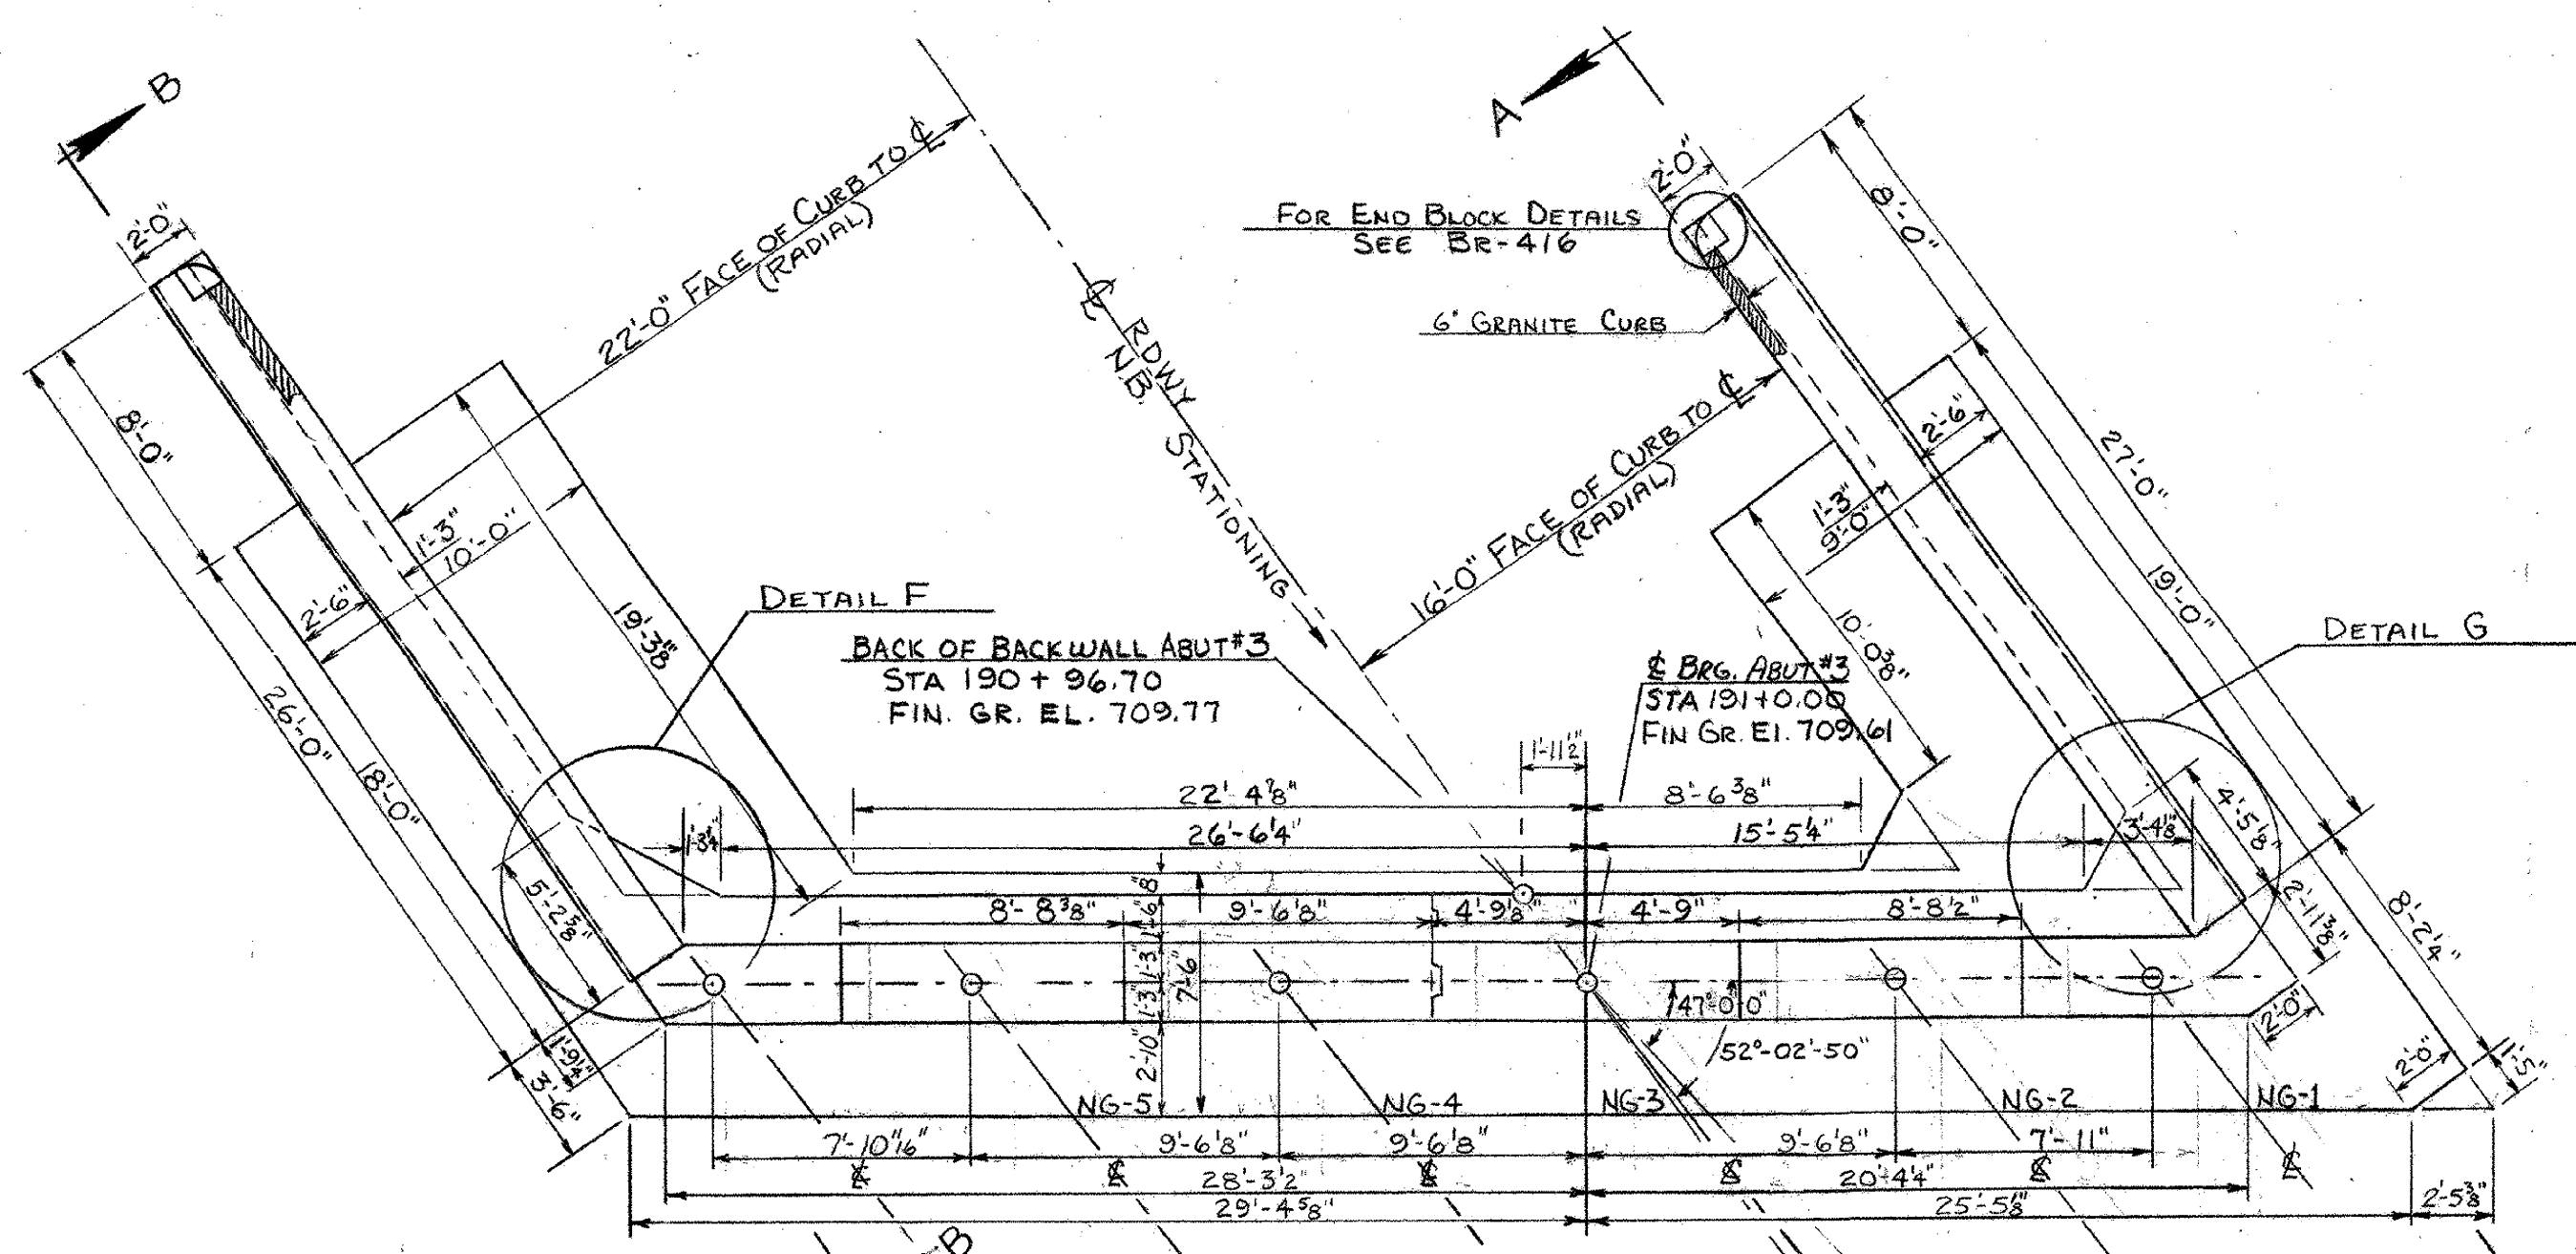

\* NOTE: SEE SECTIONS FOR DETAILS OF REINFORCING NOT SHOWN.

DIMENSIONS ARE TYPICAL EACH CURB (FOR DETAILS OF GRANITE SEE SCB-DE-67(2))

THIS SHEET FOR REFERENCE ONLY  
BERLIN IM 089-(20)  
BRIDGES 40 N&S  
SHEET 94 OF 104

FOR ABUT. NOTES SEE BR-416

**STATE OF VERMONT**  
DEPARTMENT OF HIGHWAYS

PROJECT BERLIN-MONTPELIER  
TOWNS OF BERLIN & MONTPELIER

ROUTE No. 189 STA. 193+50  
189 OVER VT RTE 12


ABUTMENT #3

SCALE AS NOTED  
IN CHARGE W. SMITH


DRAWN BY R. LADD CHECKED BY W. TRIPP  
PROJECT No. 189-1(12) 11/67  
SHEET 102 OF 122 BR-417

NOTE: ▽ DENOTES  
DIRECTION OF 10N & BATTER


28-12BPS3 STEEL PILES  
MAX. LOAD = 45 TONS  
EST. LENGTH = 55'

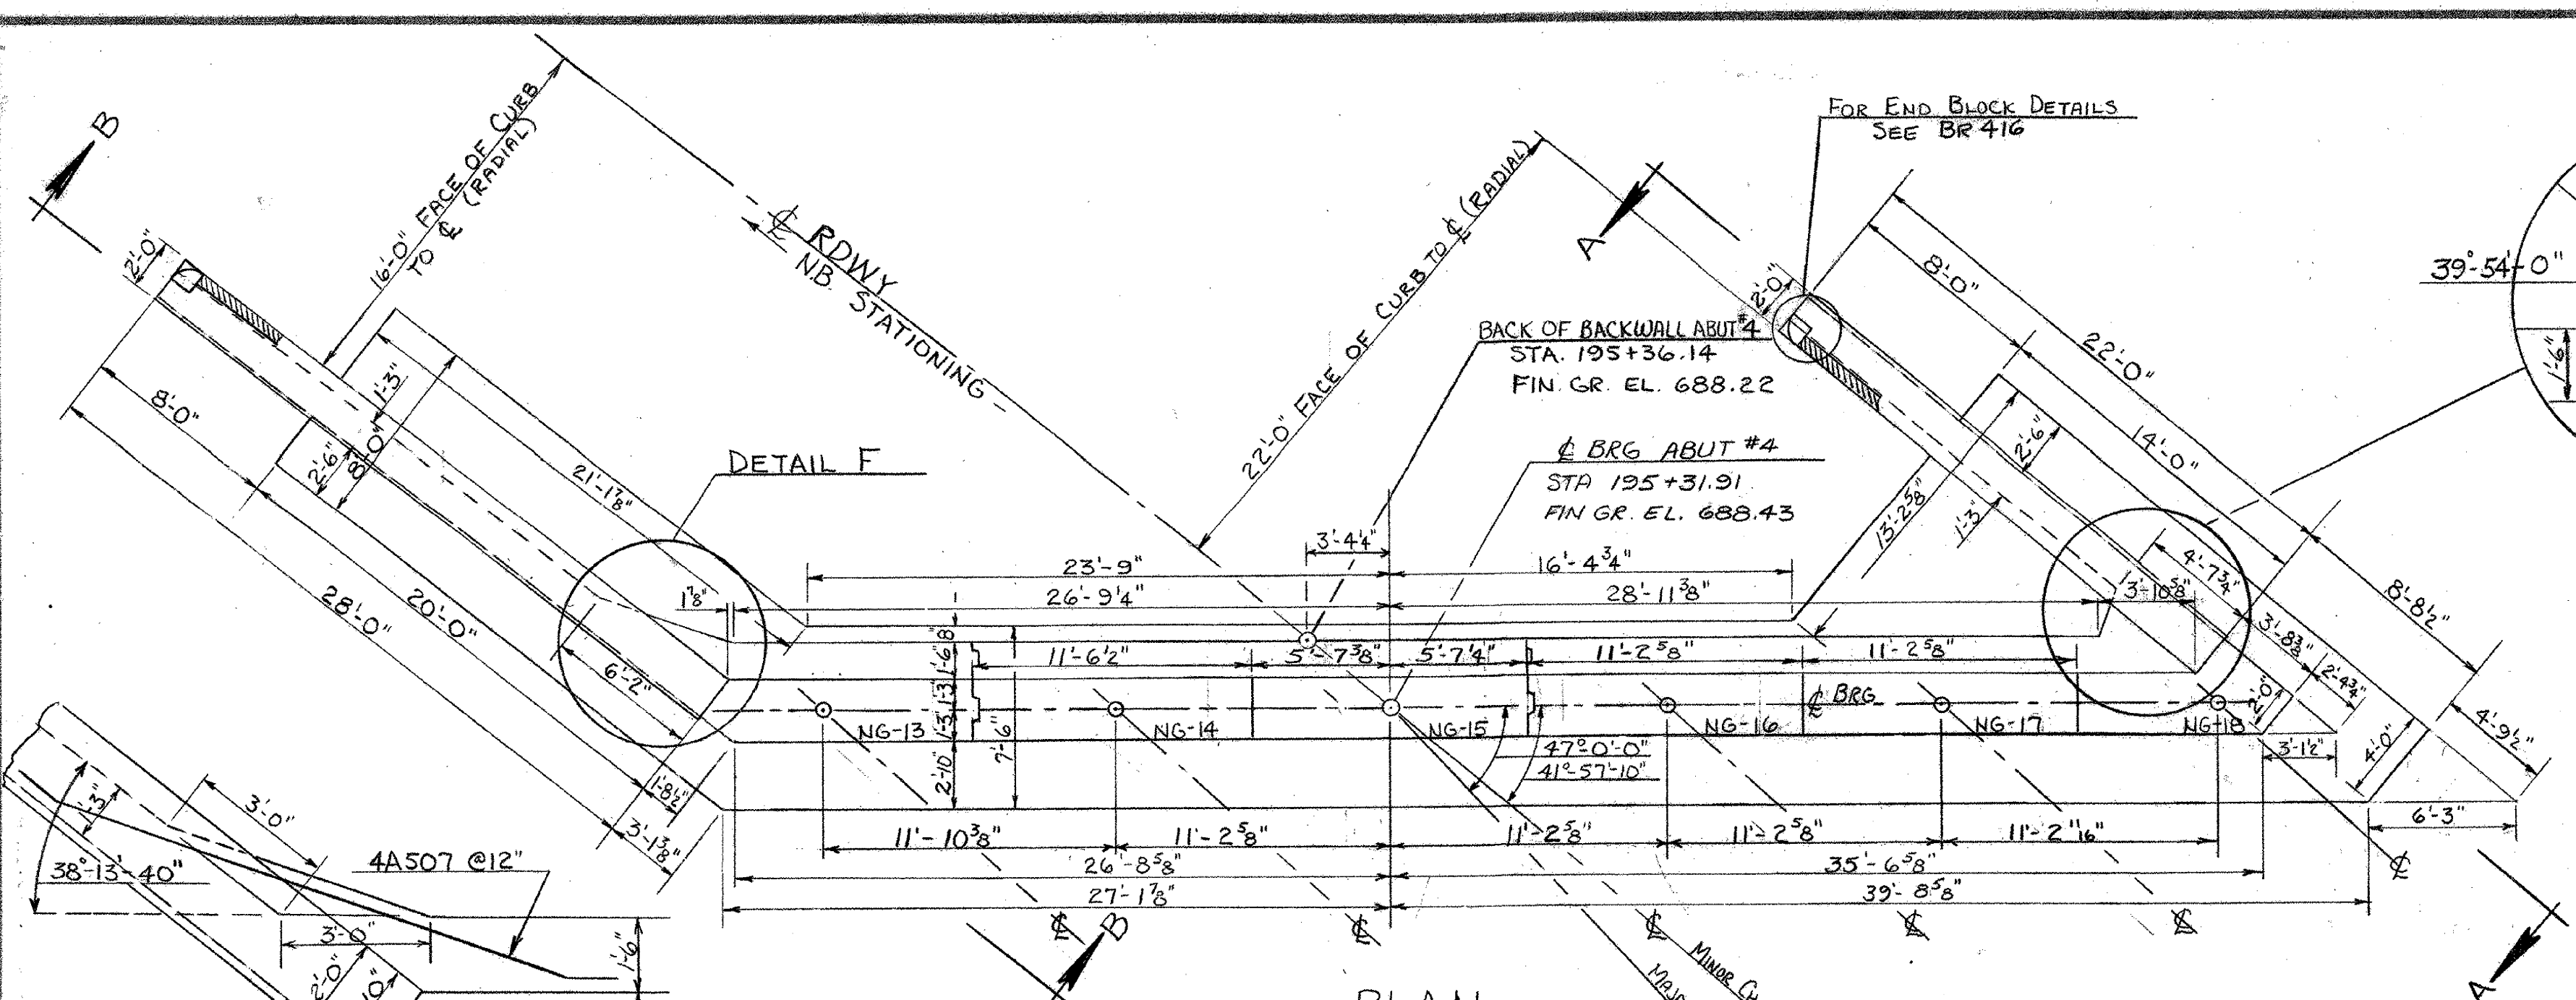

PLAN  
SCALE: 3/16" = 1'-0"

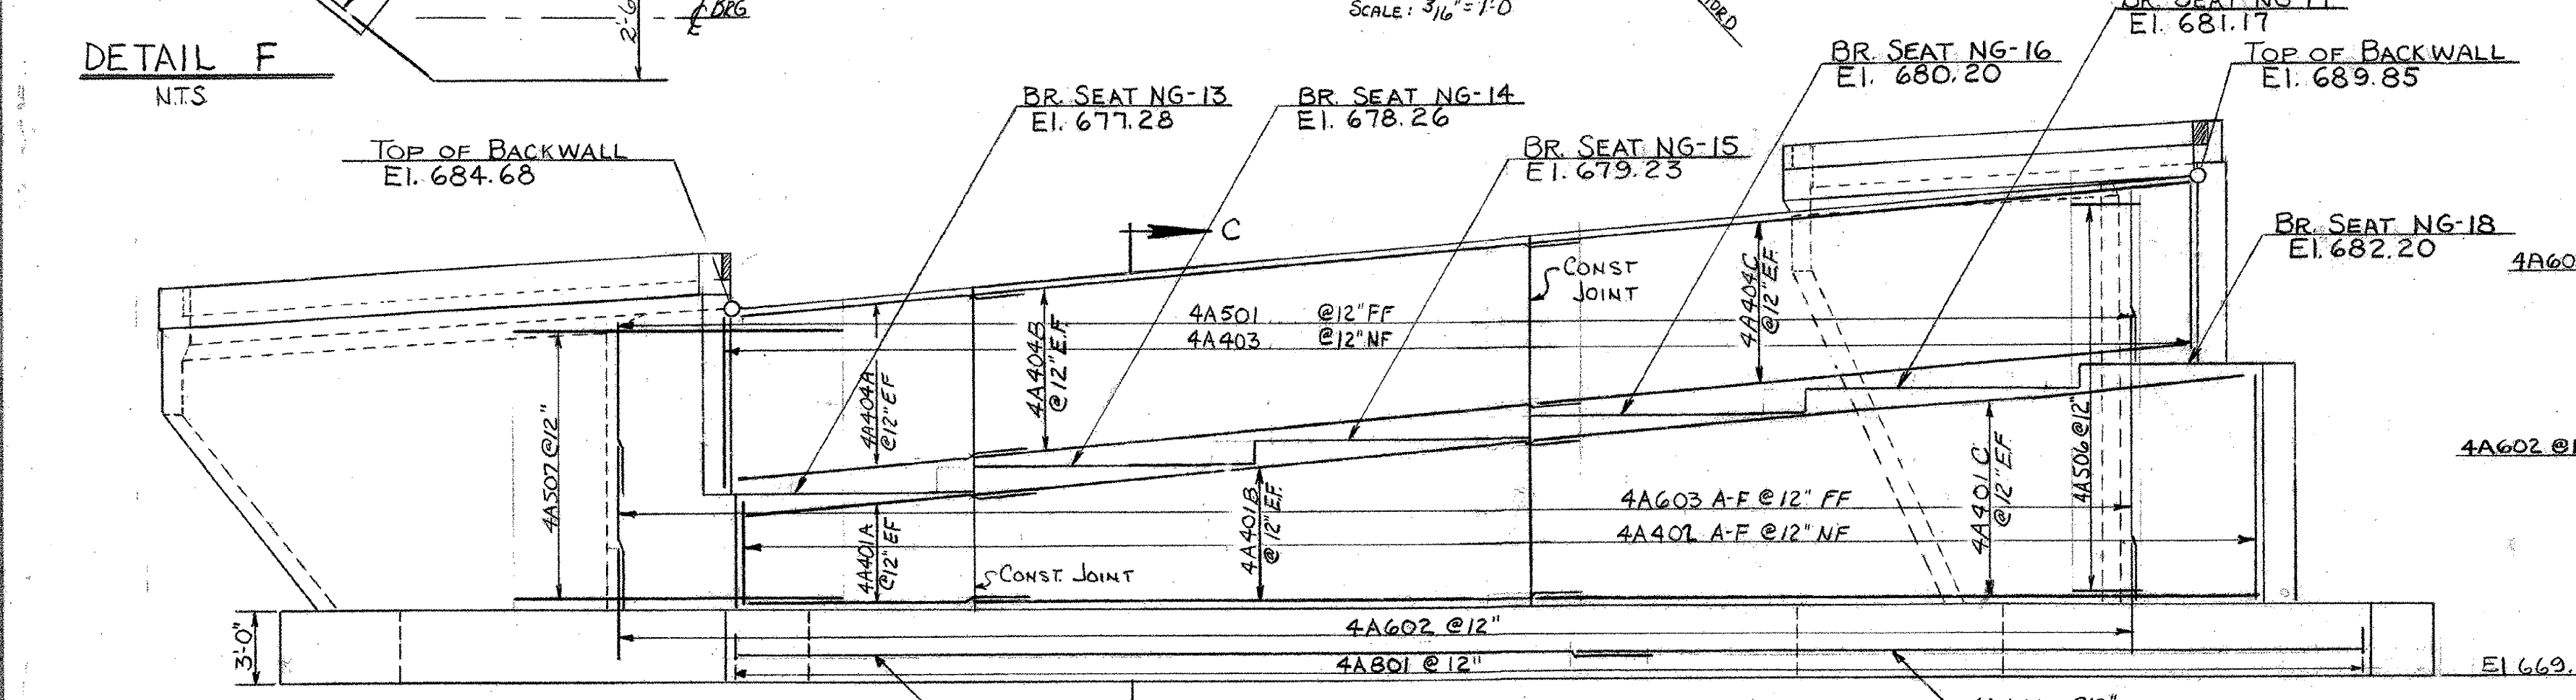


ELEVATION  
SCALE: 3/16" = 1'-0"

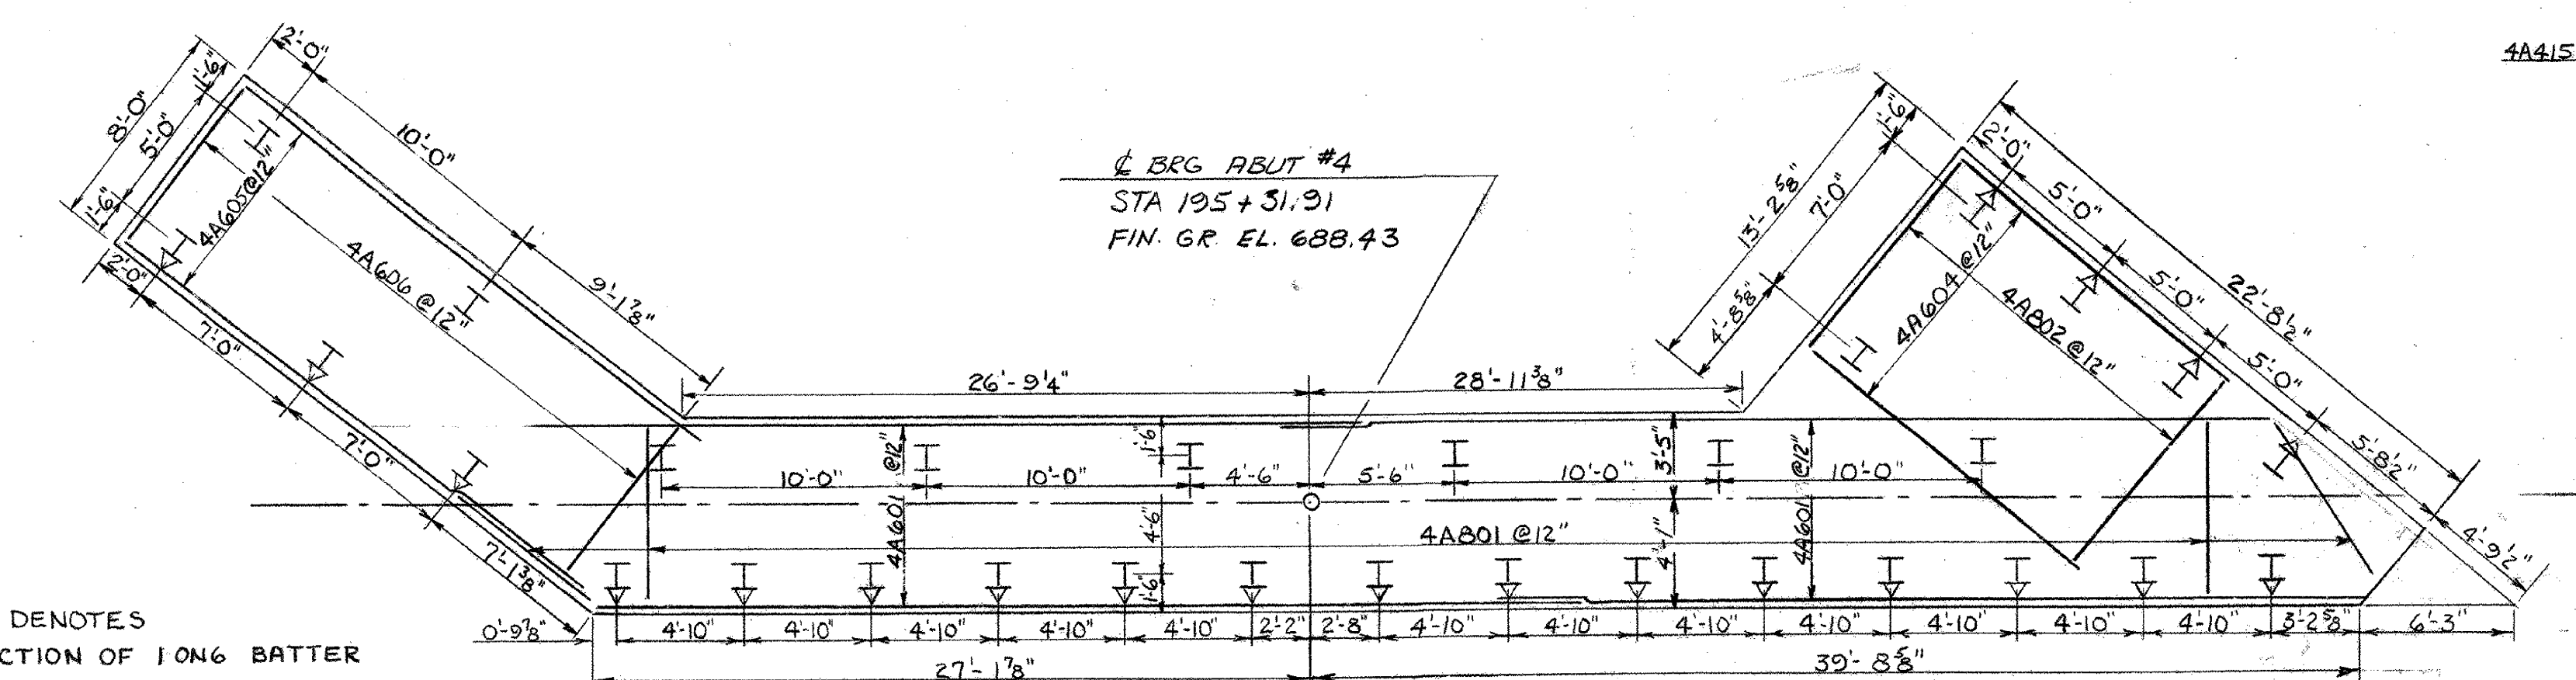


FOOTING REINFORCEMENT & PILING LAYOUT  
SCALE: 3/16" = 1'-0"

NOTE: ▽ DENOTES DIRECTION OF 10#6 BATTER


30-12BP53 STEEL PILES  
MAX. LOAD = 45 TONS  
EST. LENGTH = 40'

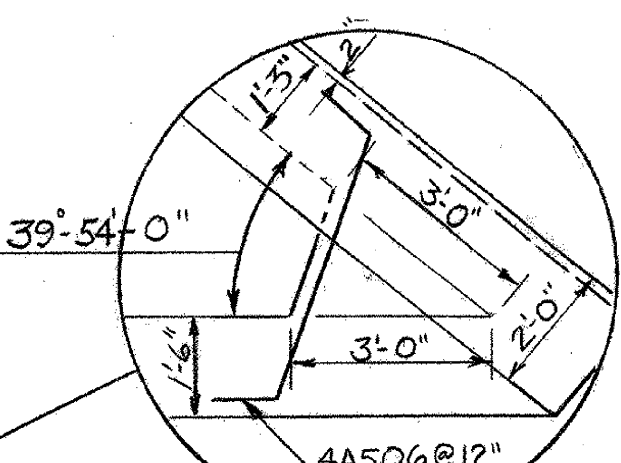


FOR END BLOCK DETAILS SEE BR 416

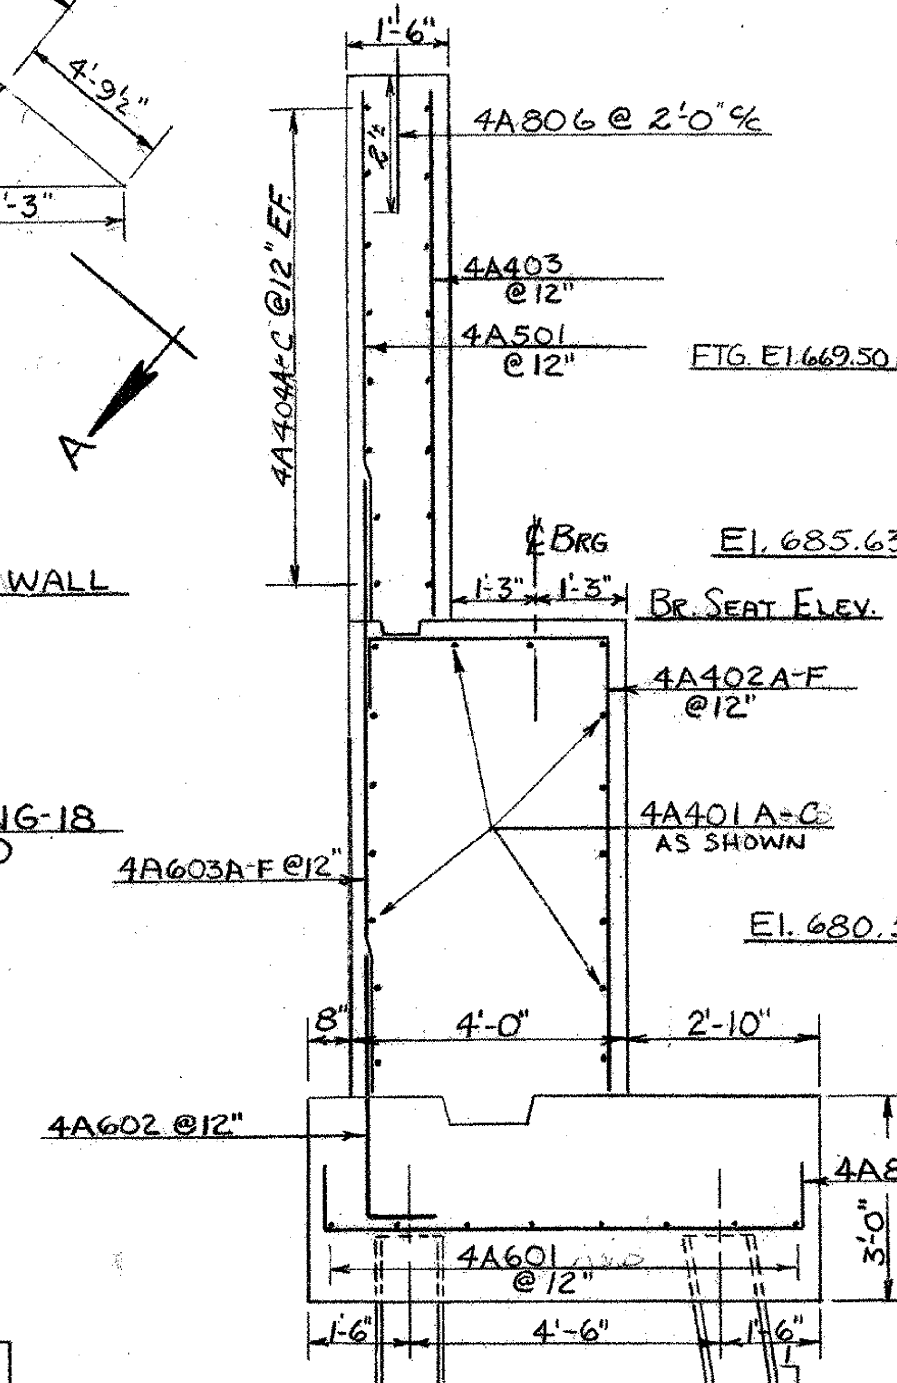


SECTION C-C  
SCALE: 3/8" = 1'-0"

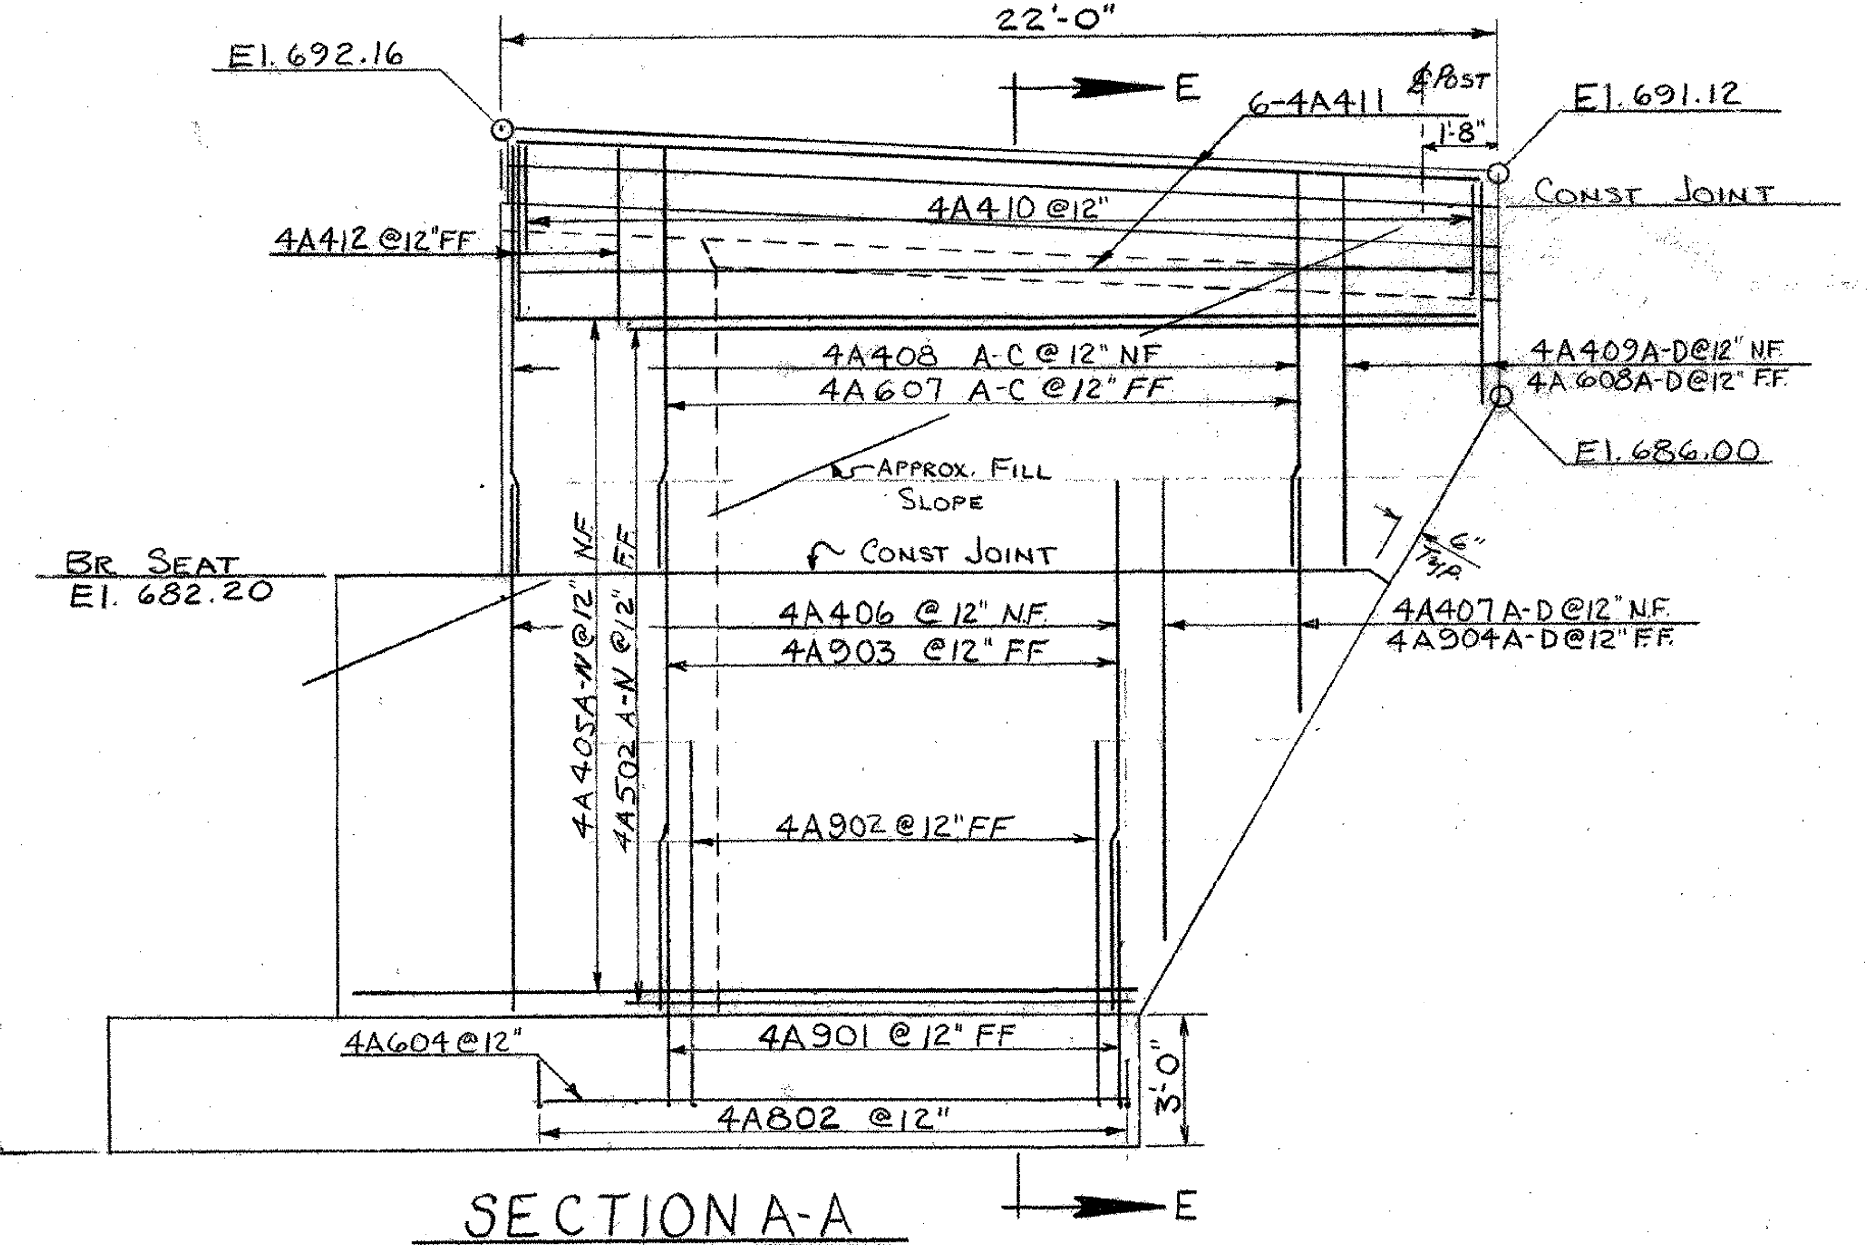

SECTION A-A  
SCALE: 1/4" = 1'-0"

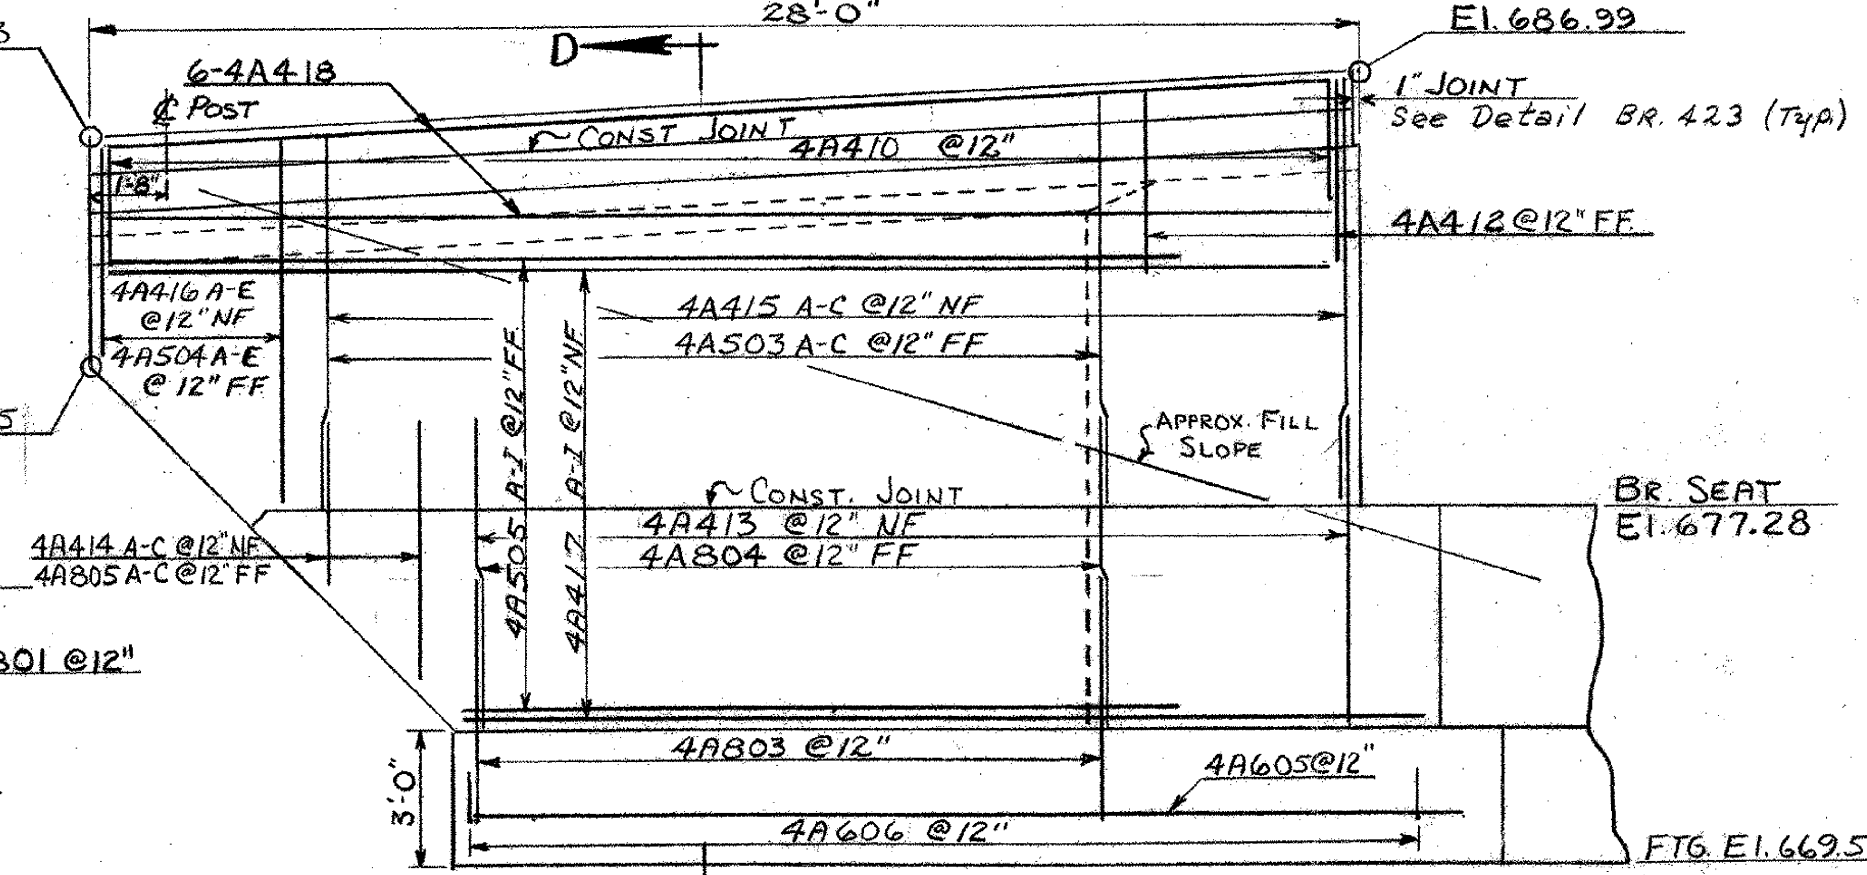

SECTION B-B  
SCALE: 1/4" = 1'-0"

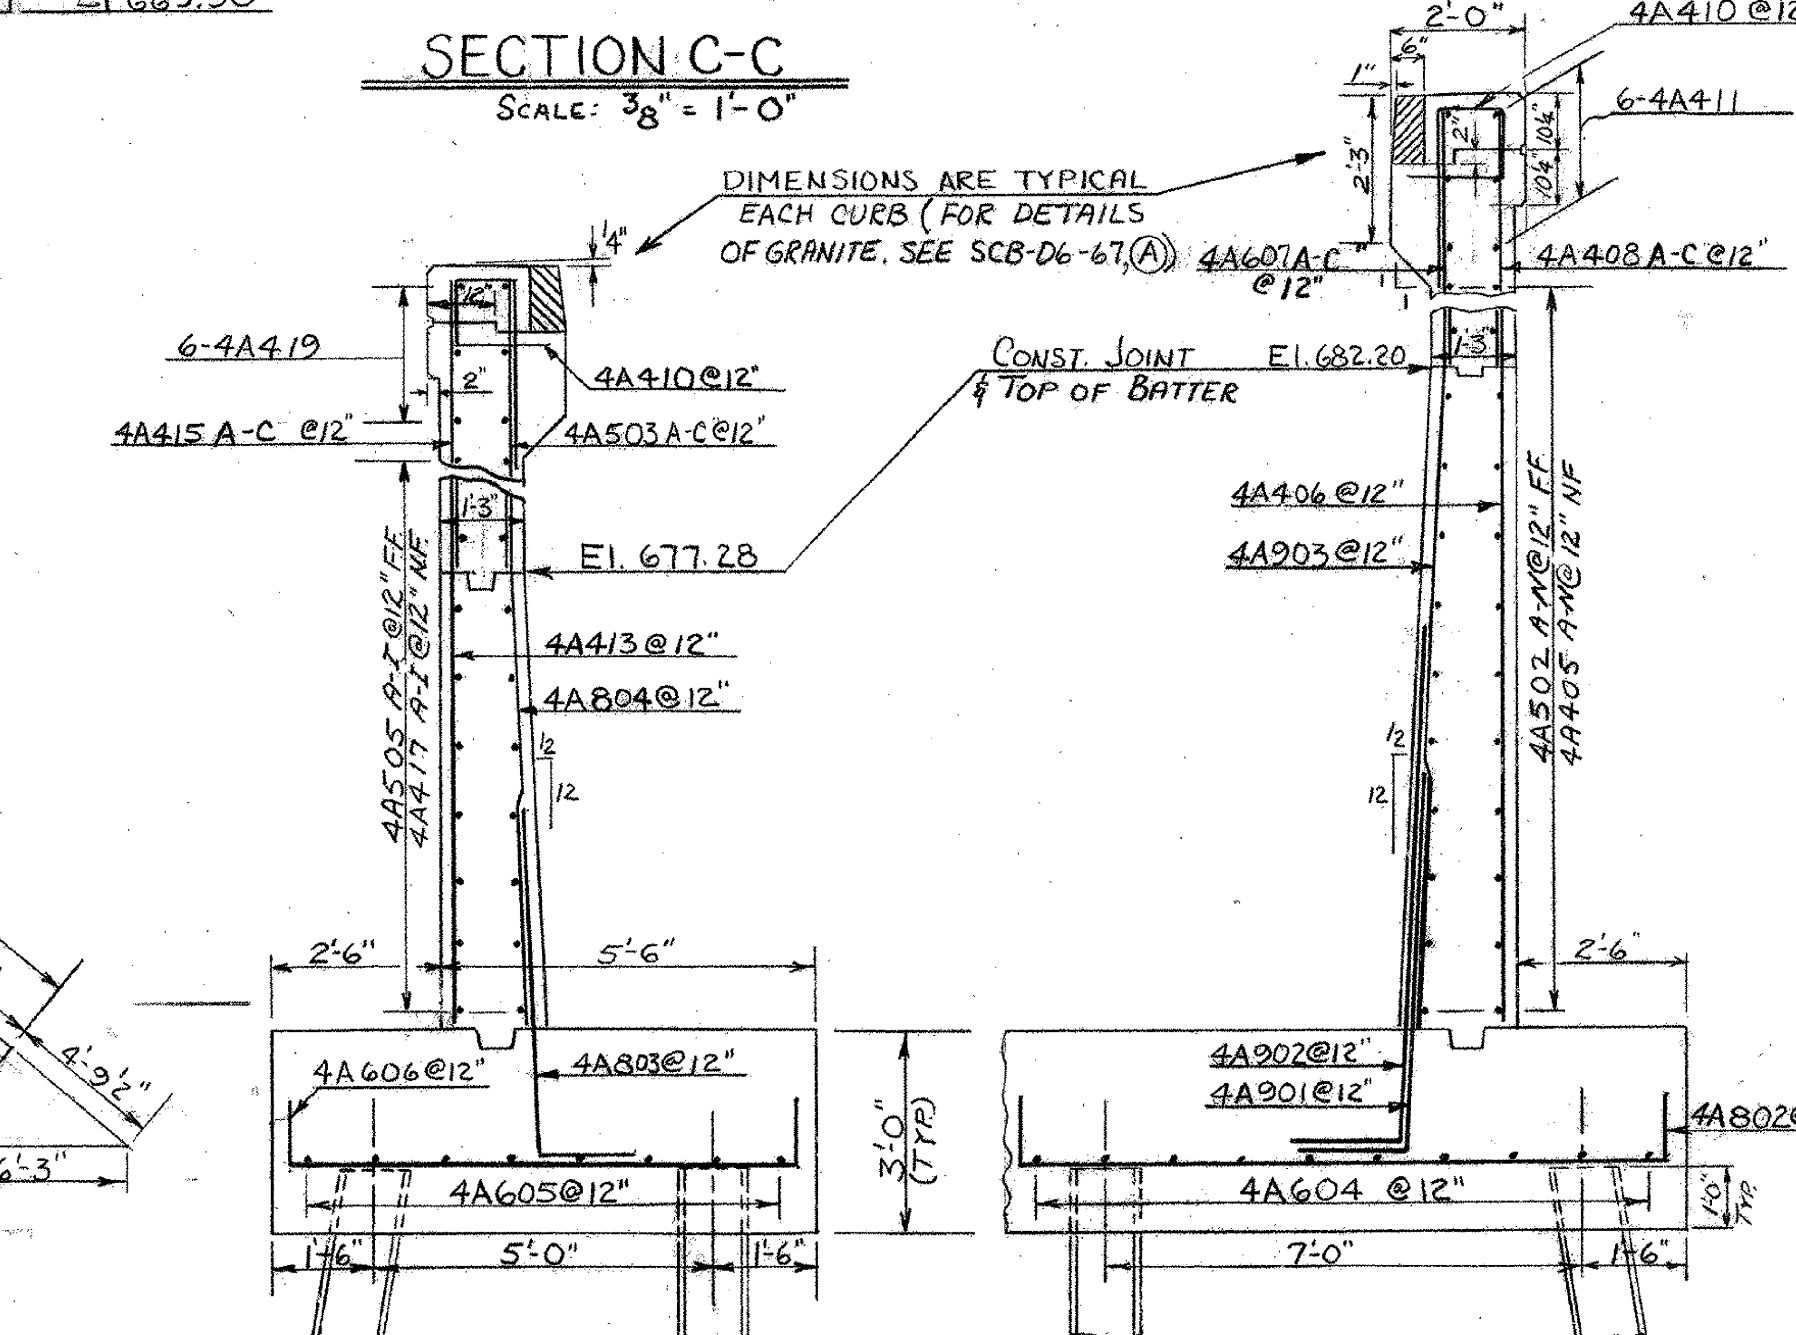

SECTION D-D  
SCALE: 3/8" = 1'-0"

SECTION E-E  
SCALE: 3/8" = 1'-0"

DIMENSIONS ARE TYPICAL EACH CURB (FOR DETAILS OF GRANITE, SEE SCB-D6-67(A) 4A601A-C @ 12"






THIS SHEET FOR REFERENCE ONLY  
BERLIN 1089-1(20)  
BRIDGES 40 N&S  
SHEET 95 OF 104

FOR ABUT. NOTES SEE BR-416

**STATE OF VERMONT**  
DEPARTMENT OF HIGHWAYS

PROJECT BERLIN-MONTPELIER  
TOWNS OF BERLIN & MONTPELIER  
ROUTE No. 189 STA. 193+50.0  
189 OVER VT. RTE 12  
ABUTMENT #4

SCALE AS NOTED  
IN CHARGE W. SMITH  
DRAWN BY R. LADD CHECKED BY W. TRIPP  
PROJECT No. 189-1(12)  
SHEET 102 OF 127 BR-416

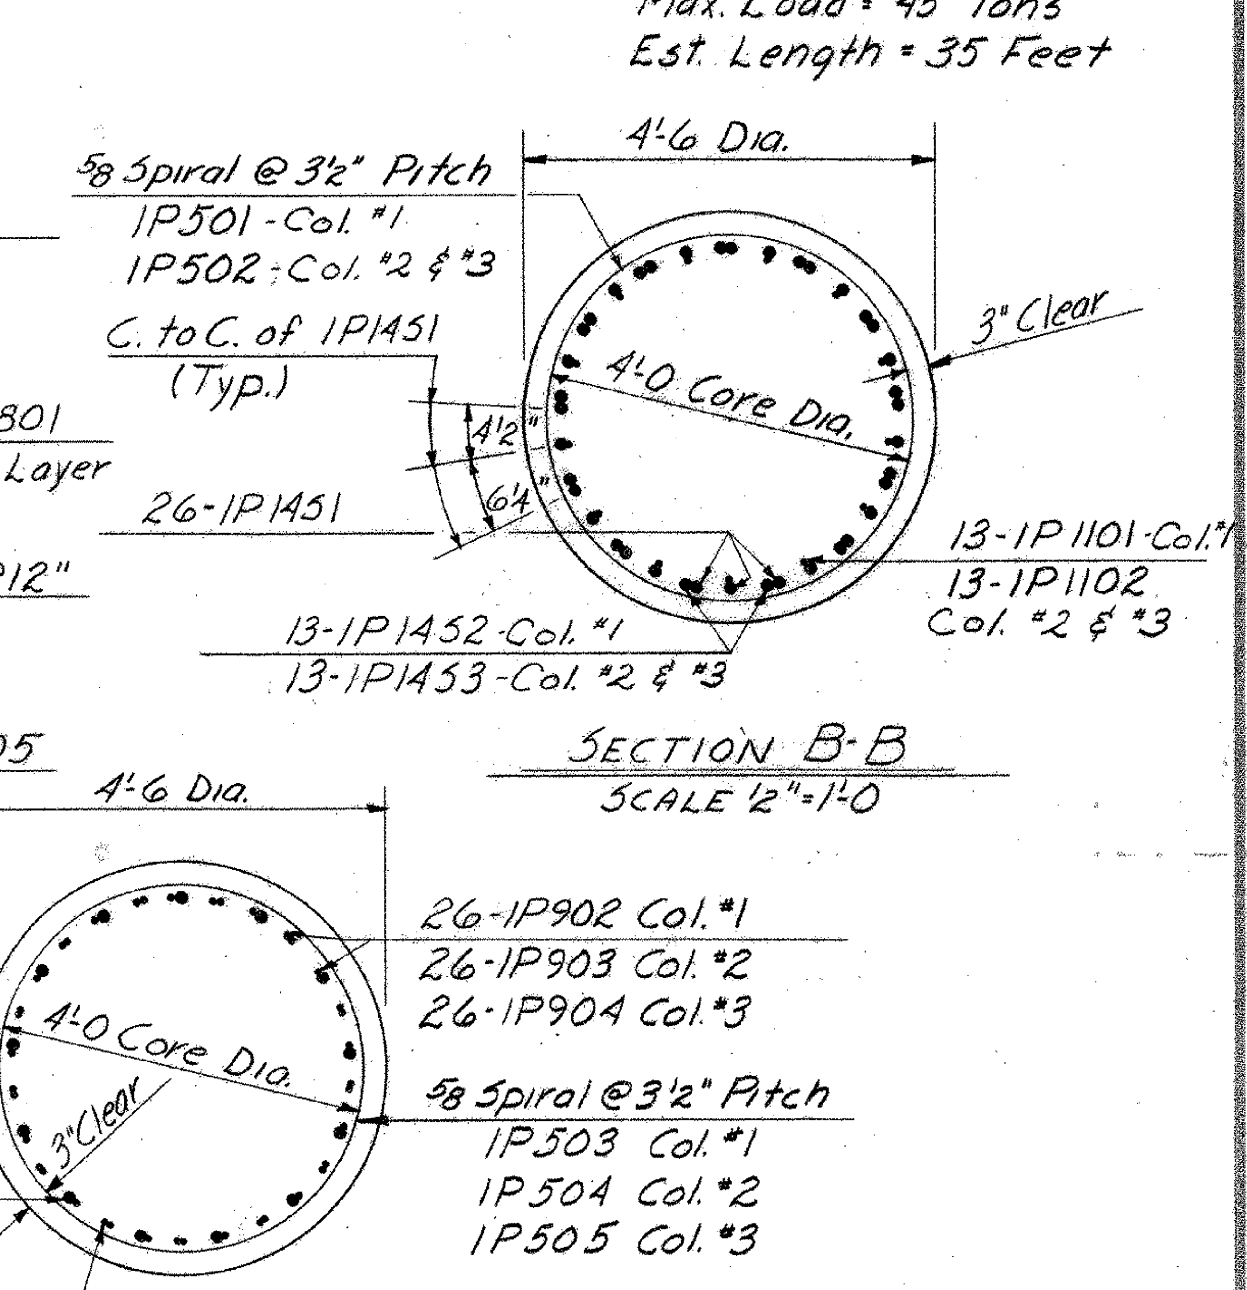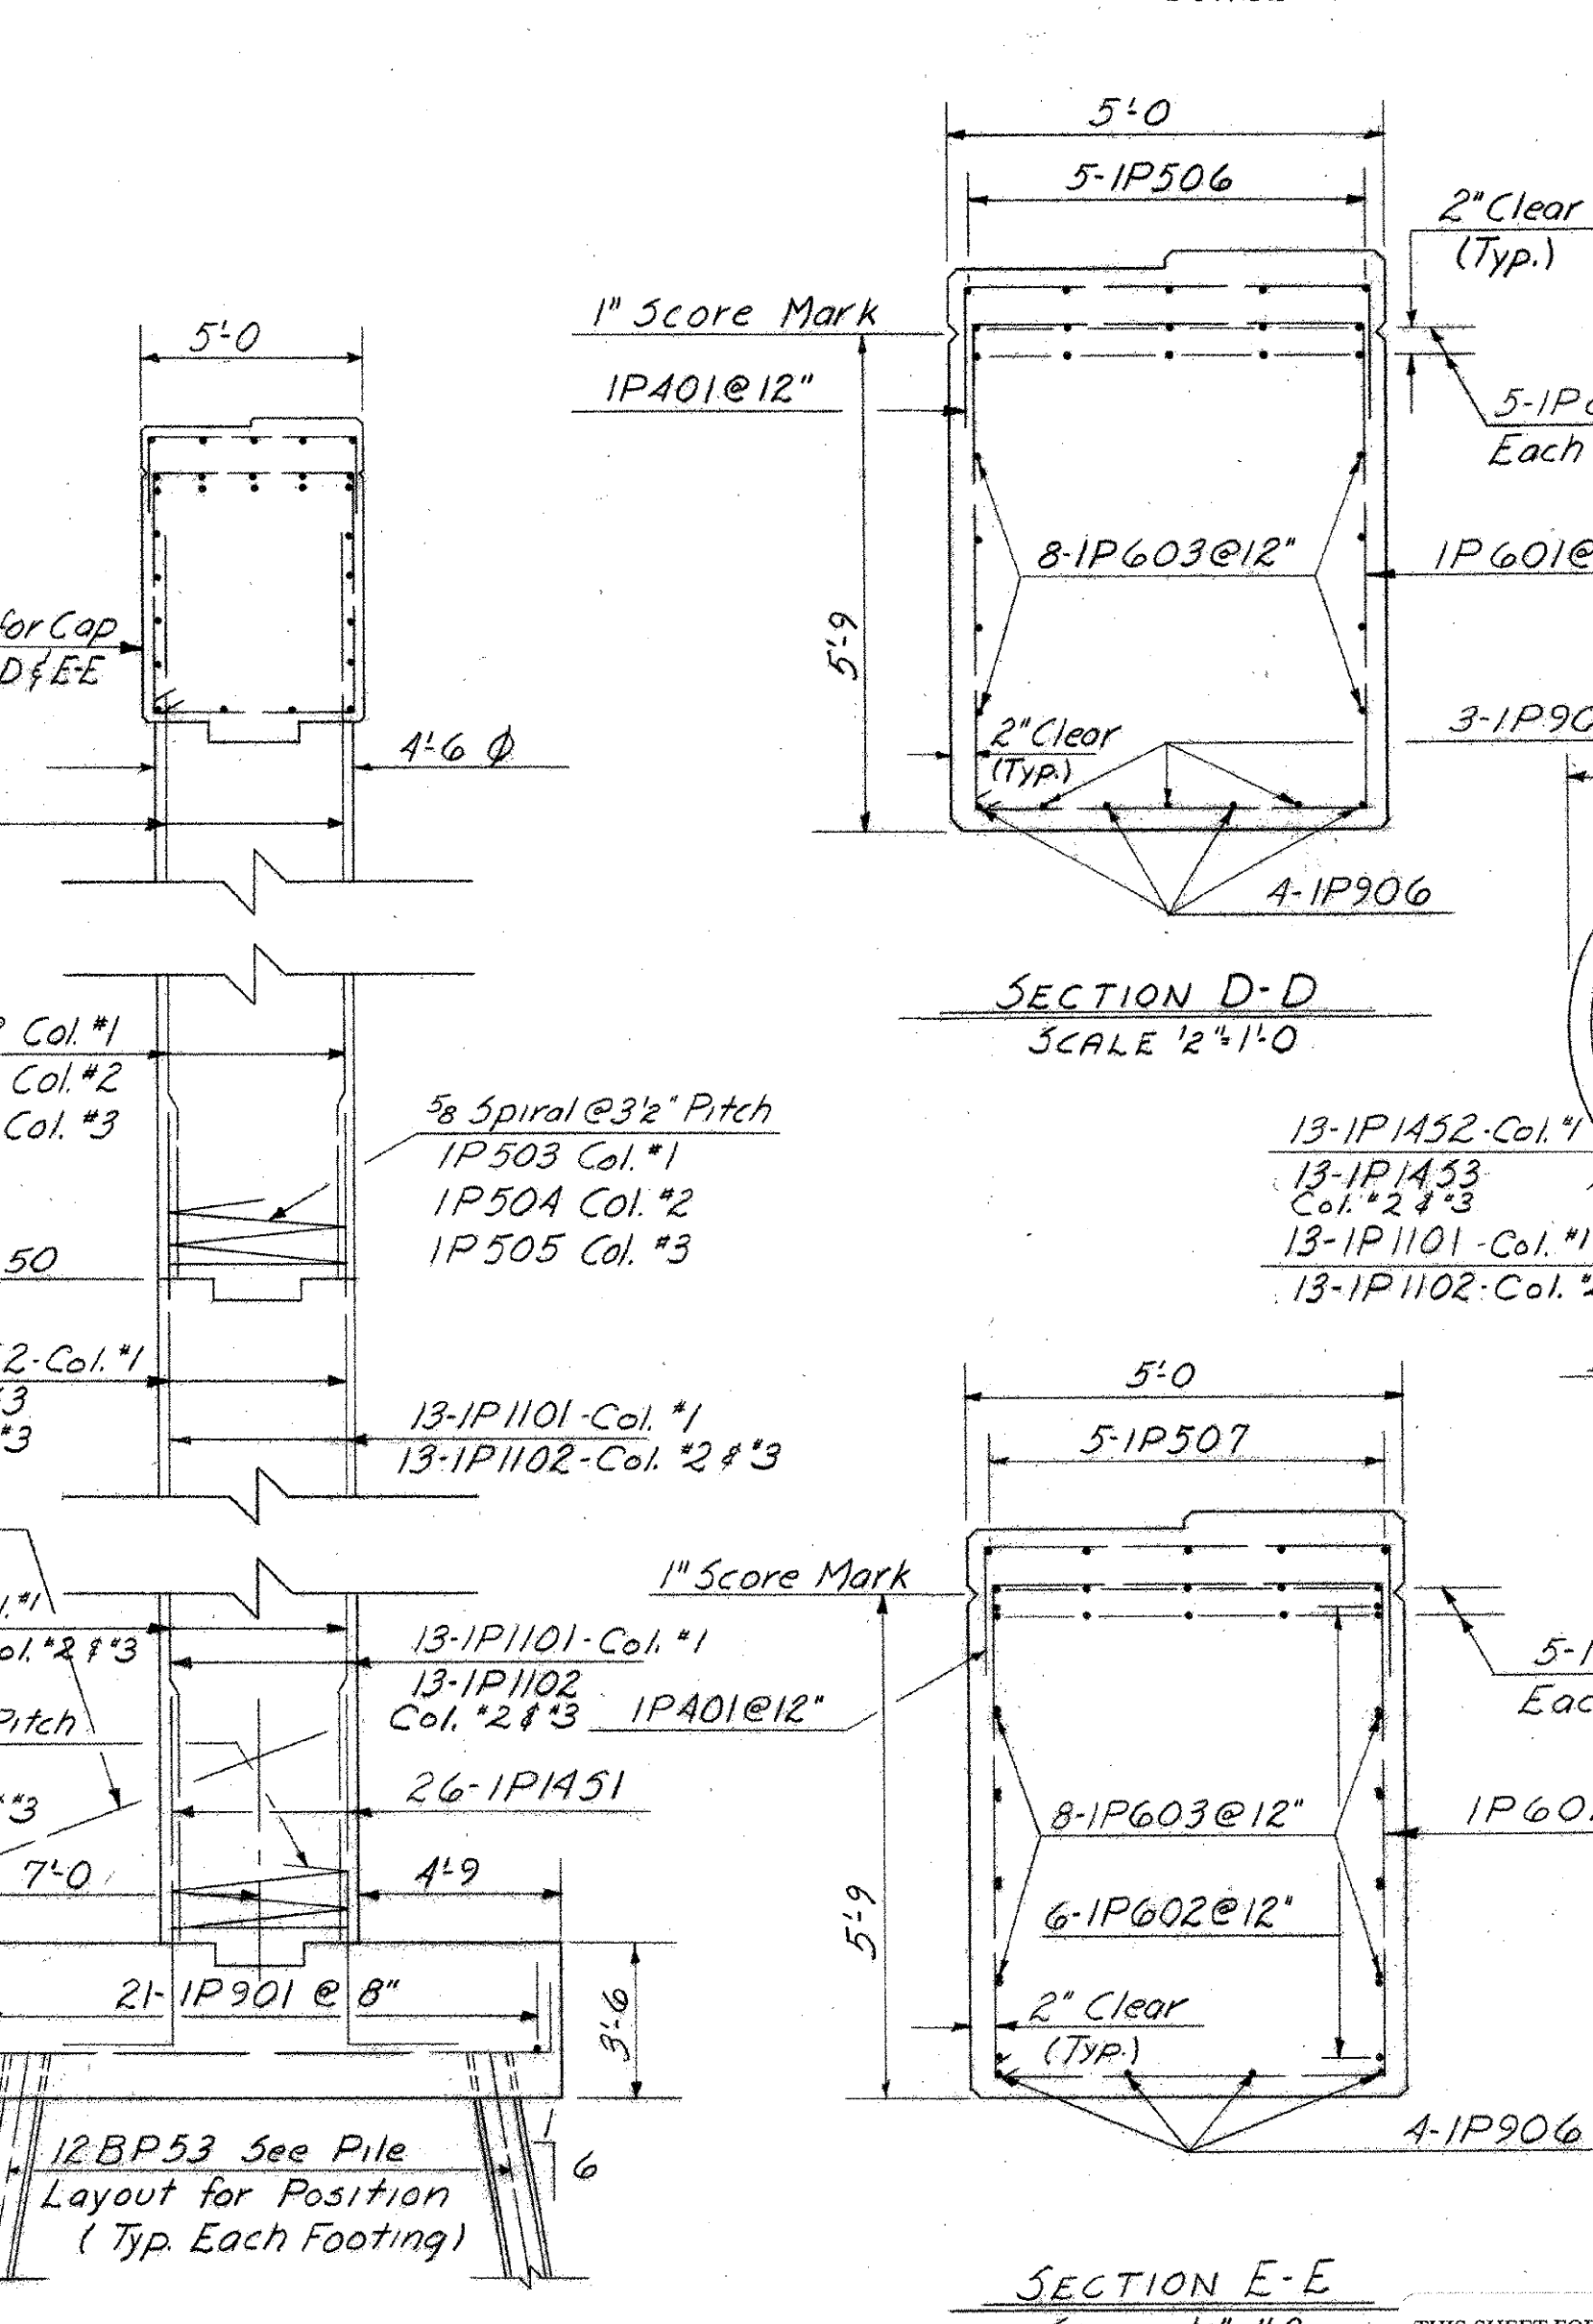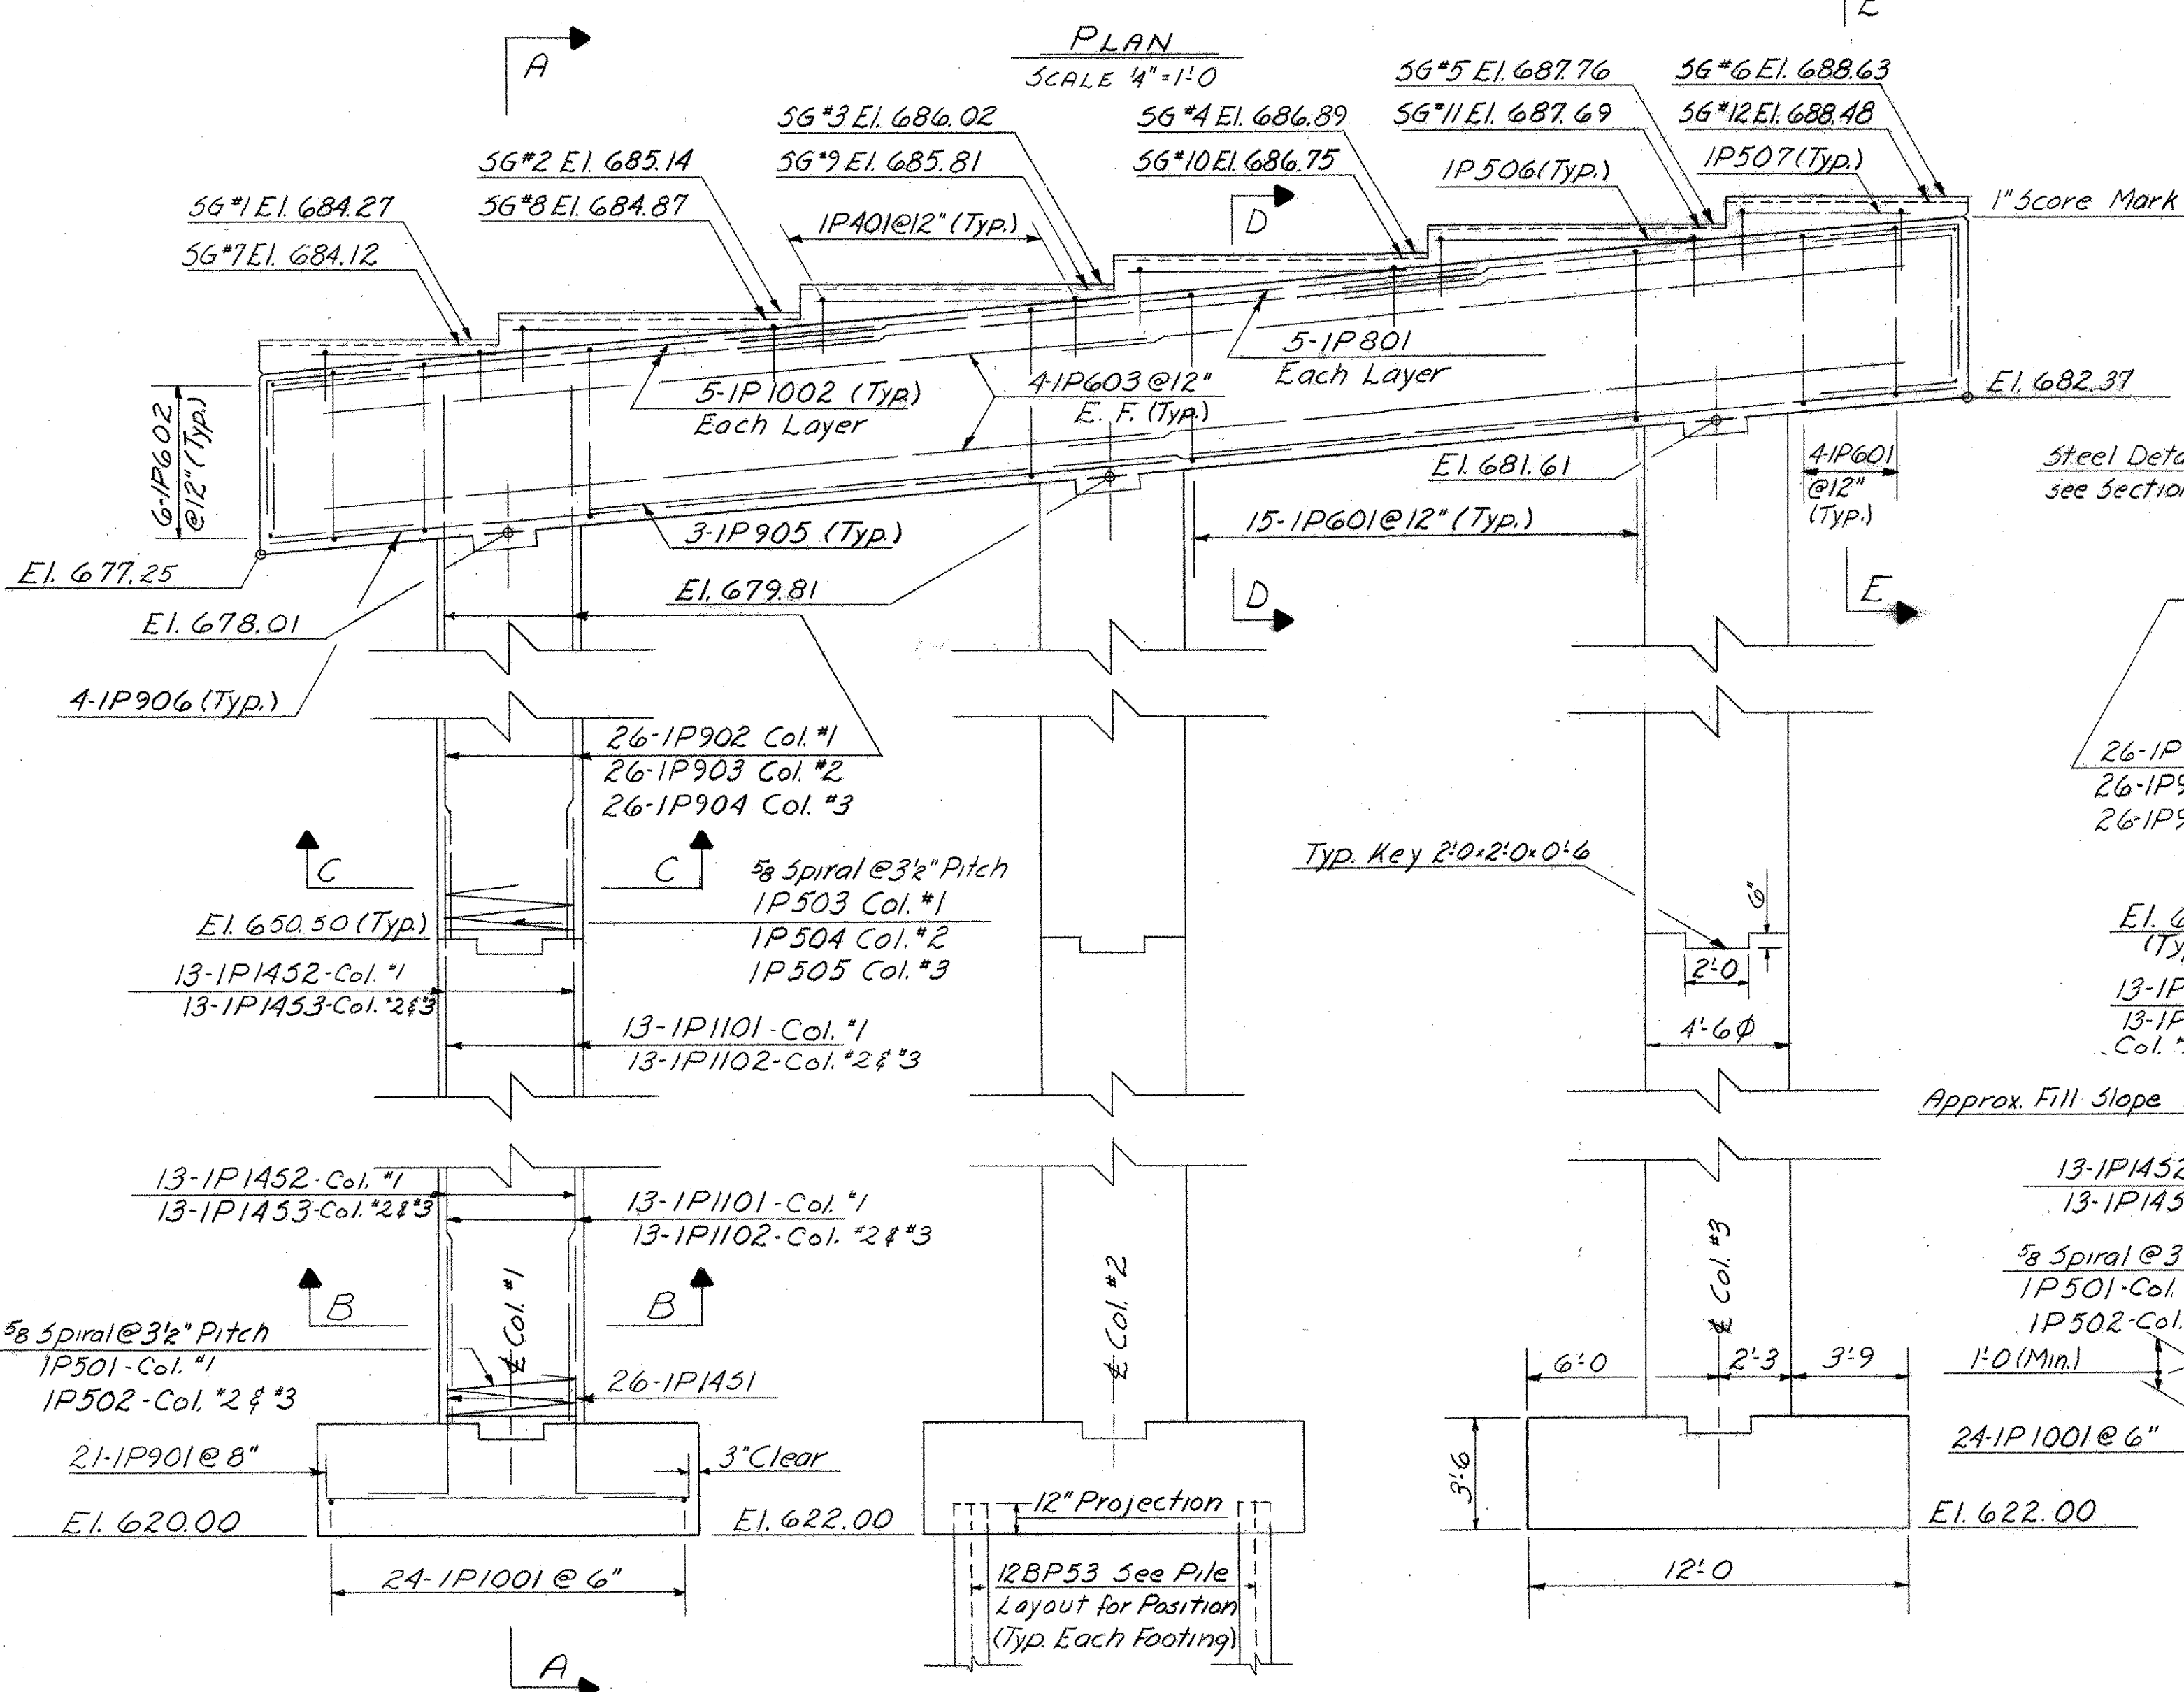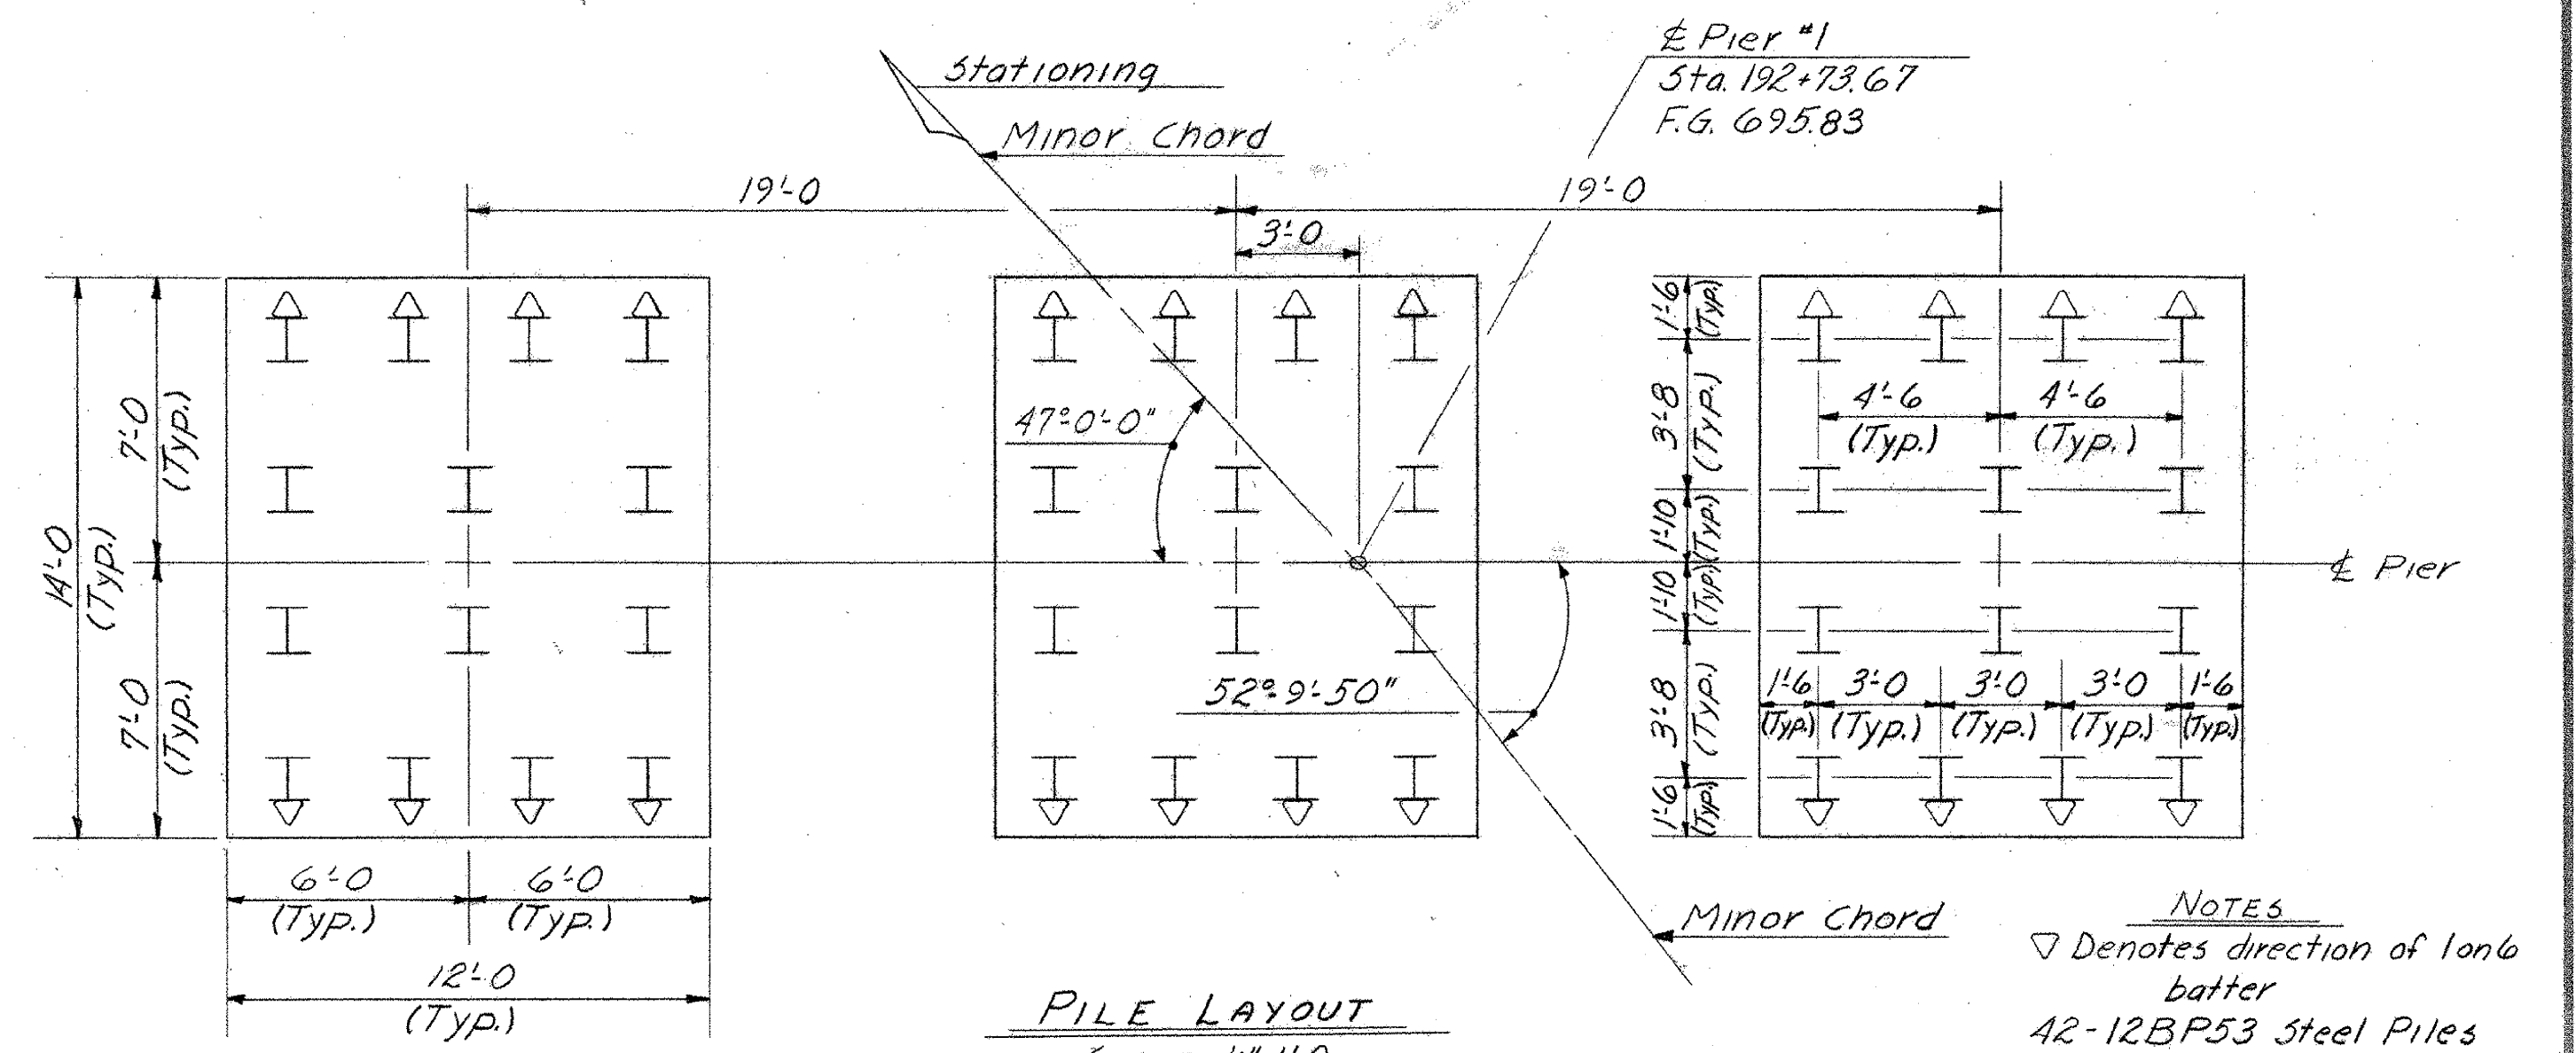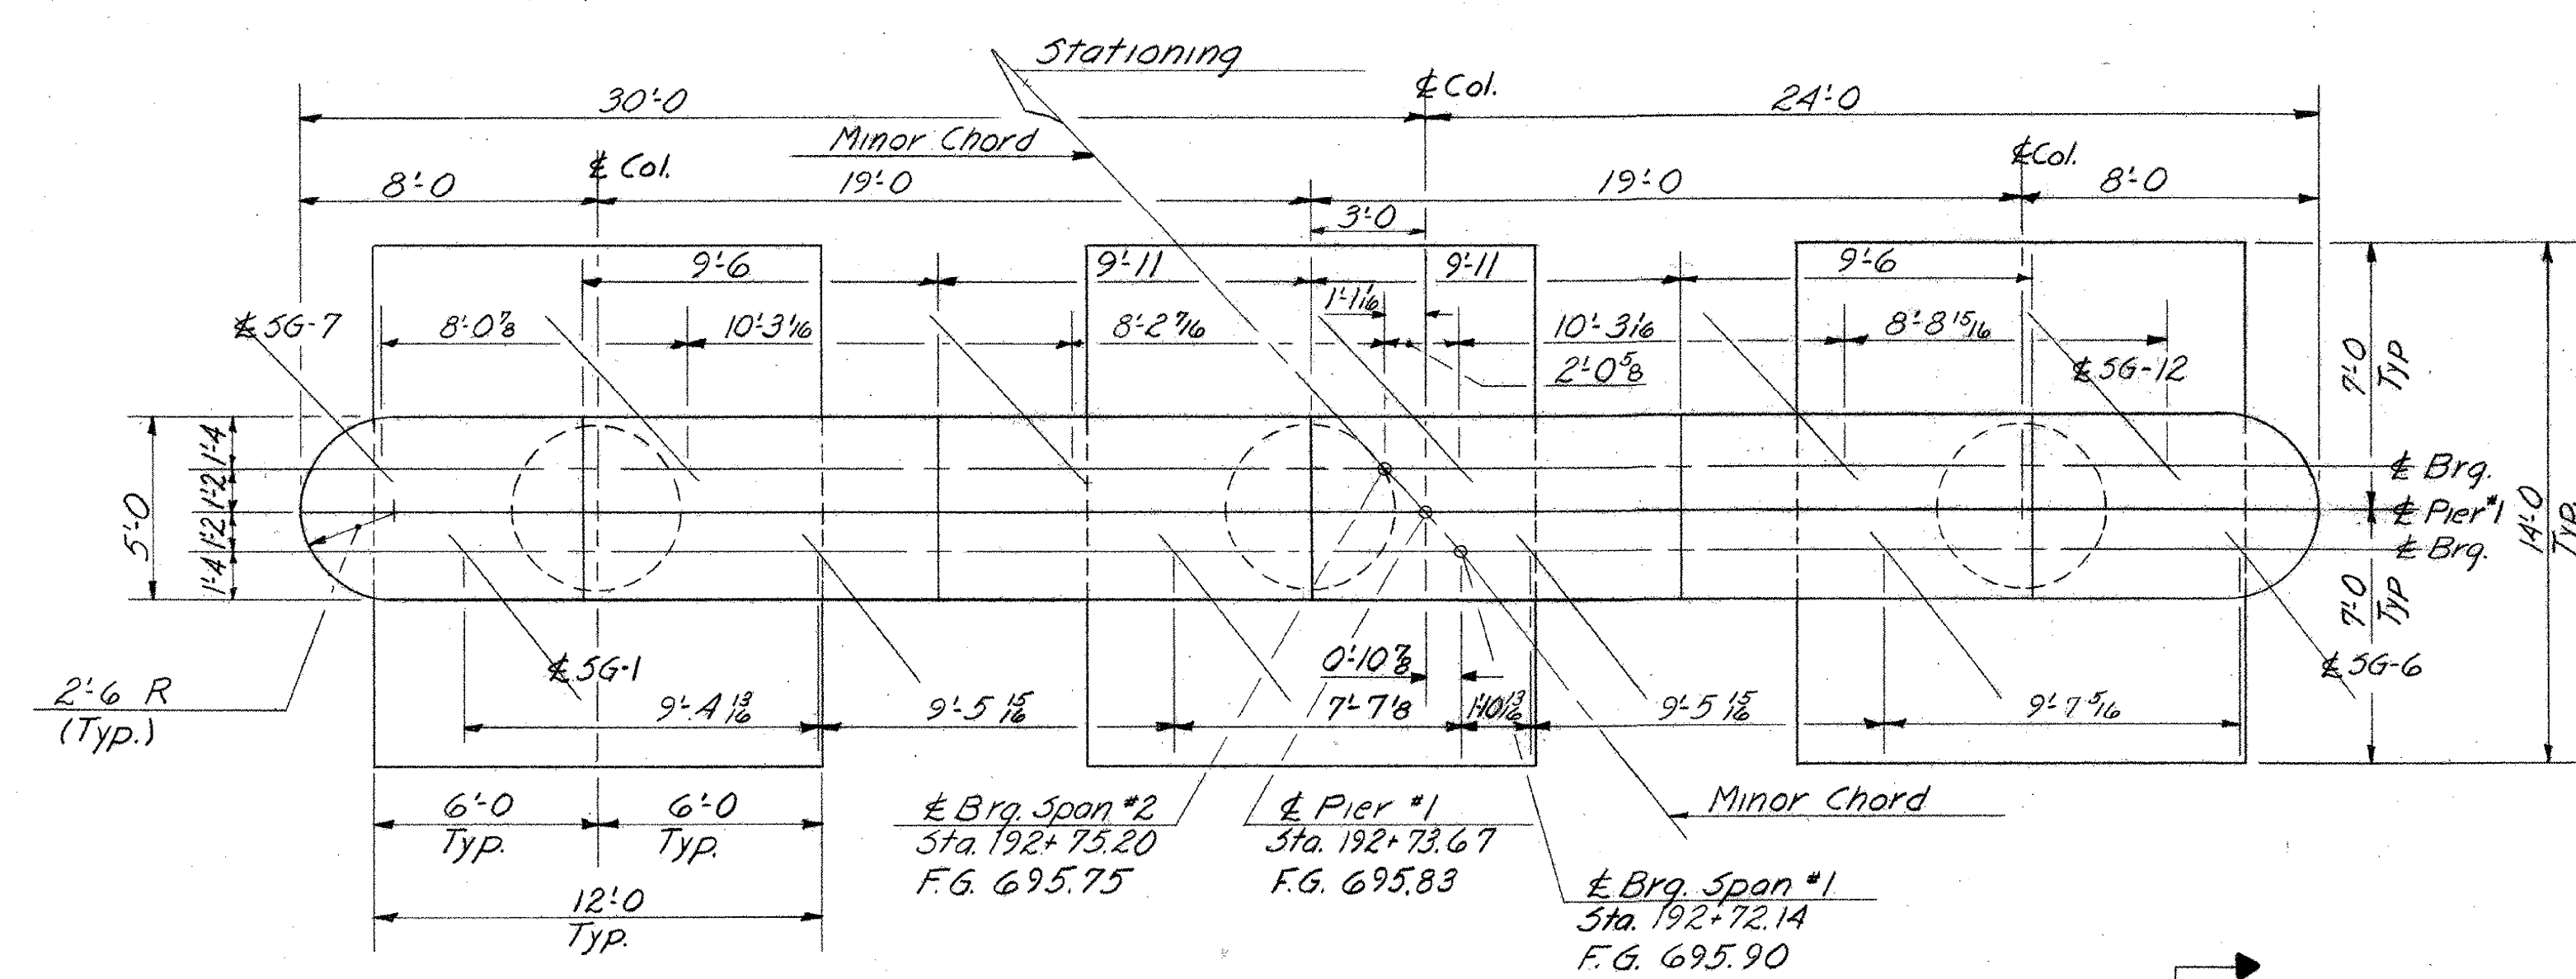

**NOTES**

1. For Piling Table see BR. 421
2. For General Notes see BR. 400
3. Pier Footings are to be Concrete Class B(mod); Columns and Caps are to be Concrete Class AA(mod)

**STATE OF VERMONT**  
DEPARTMENT OF HIGHWAYS

PROJECT BERLIN-MONTPELIER  
TOWNS OF BERLIN & MONTPELIER



ROUTE No. I-89 STA. 193+50±  
I-89 OVER VT. #12

PIER #1

SCALE AS SHOWN

IN CHARGE W. SMITH

DRAWN BY E. GULMAN CHECKED BY W. TRIPP  
BERLIN IM 089-1C0)  
BRIDGES 40 N&S  
PROJECT No. I-89-1112  
SHEET 170 OF 427 BR 419

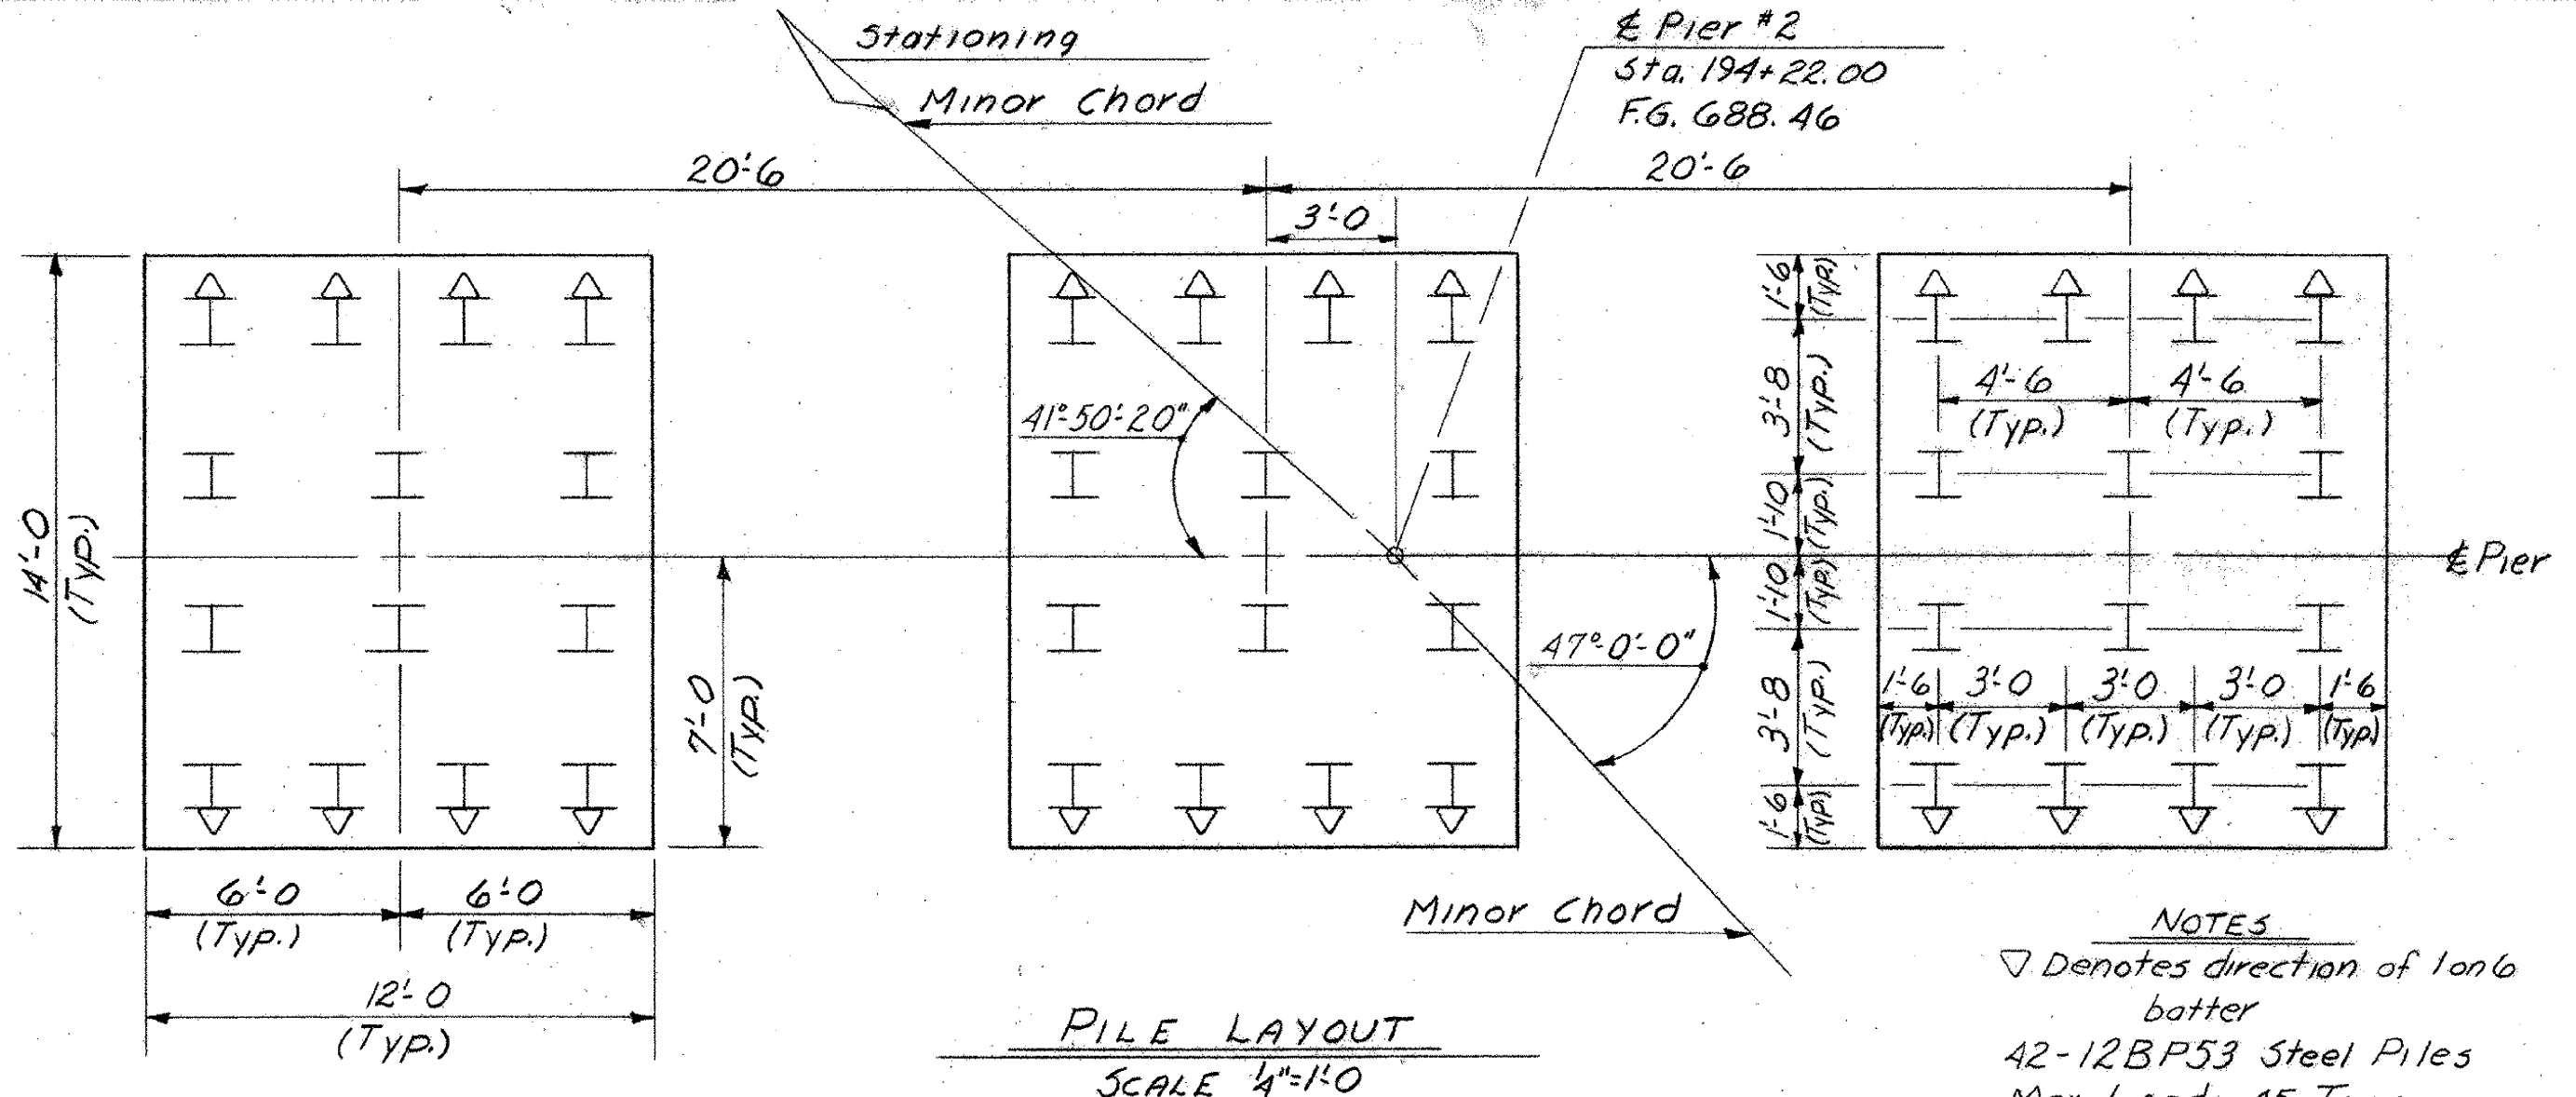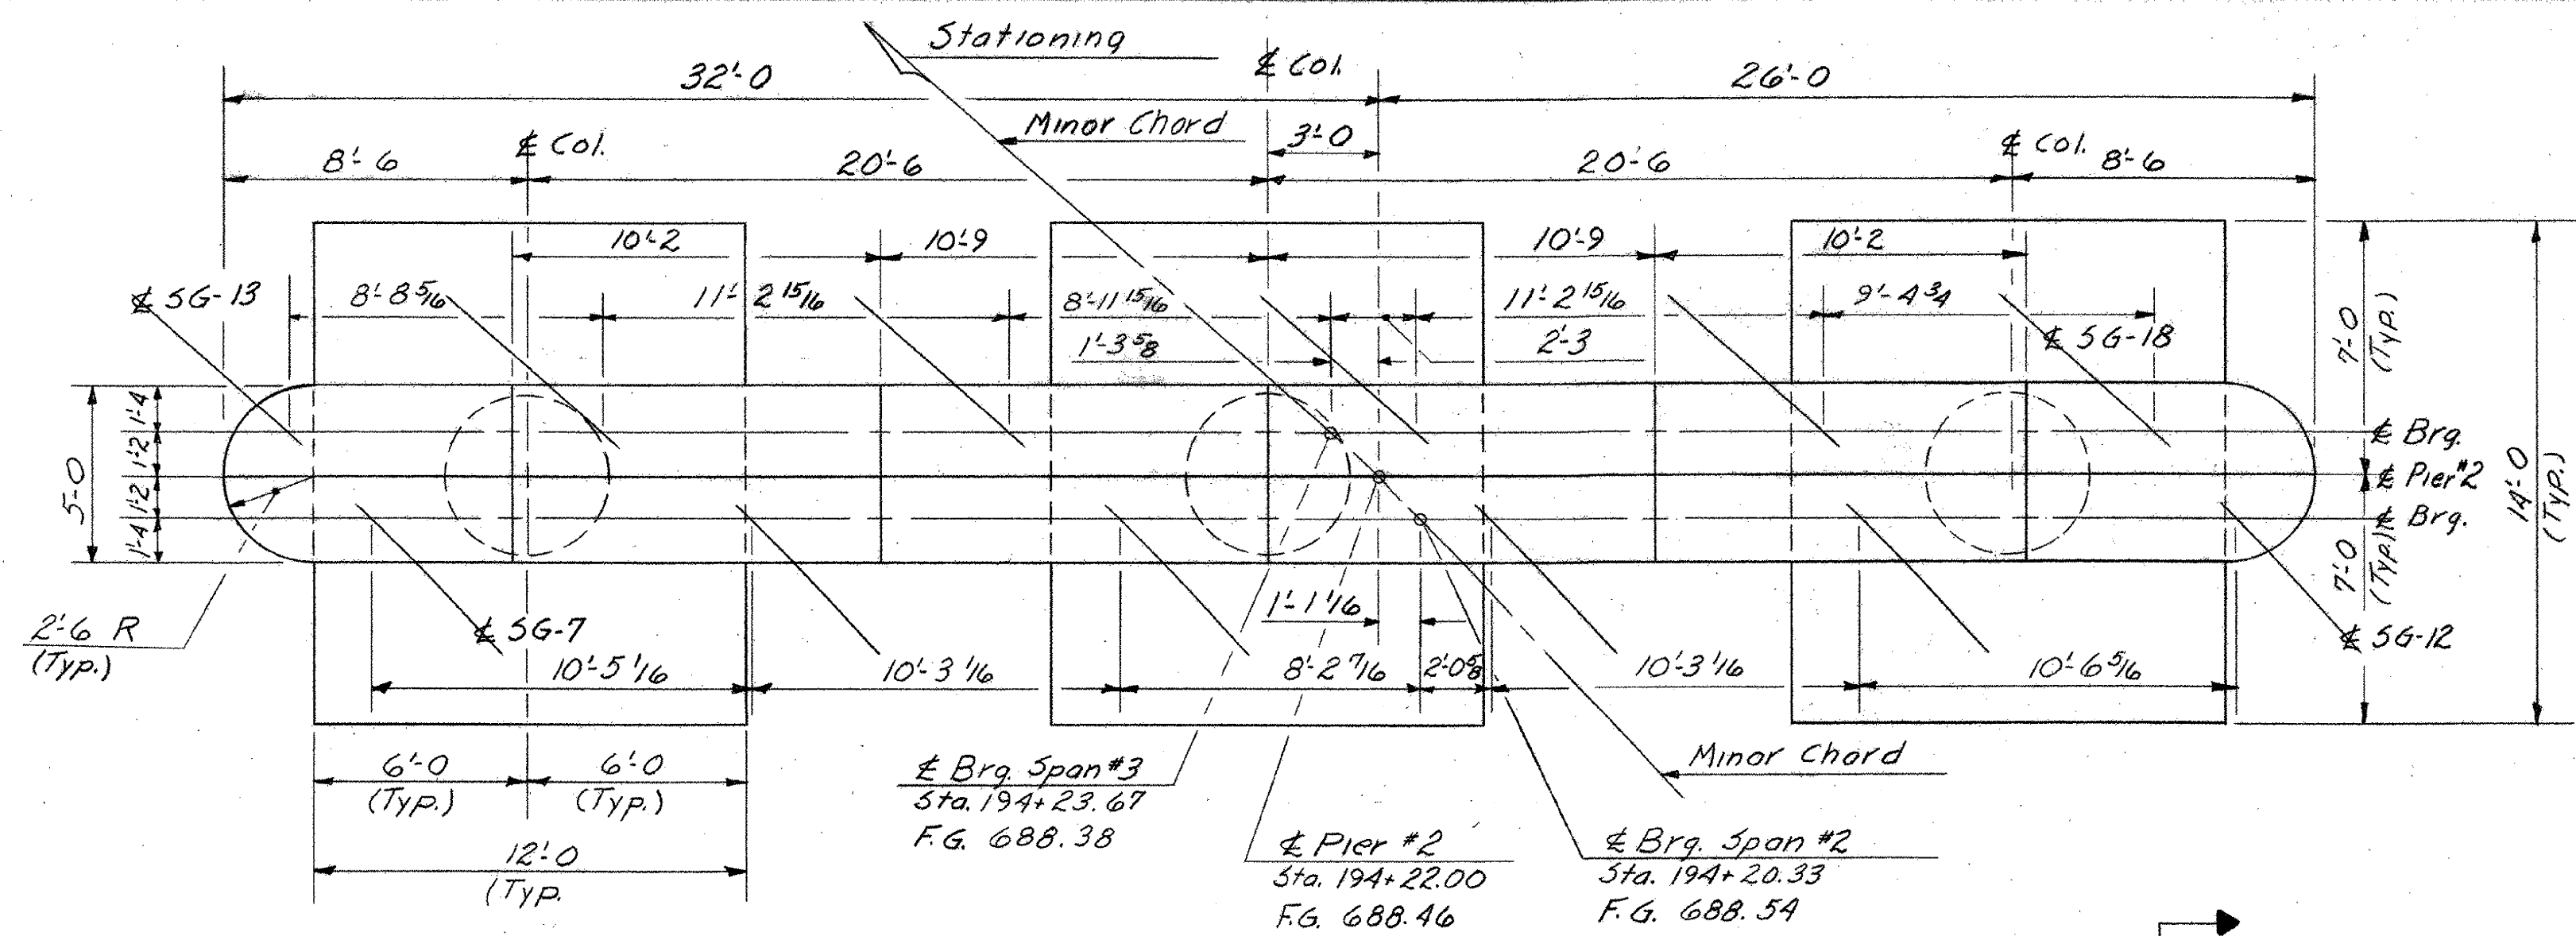





**NOTES**

▽ Denotes direction of long batter

42-12BP53 Steel Piles

Max. Load = 45 Tons

Est. Length = 25 Feet

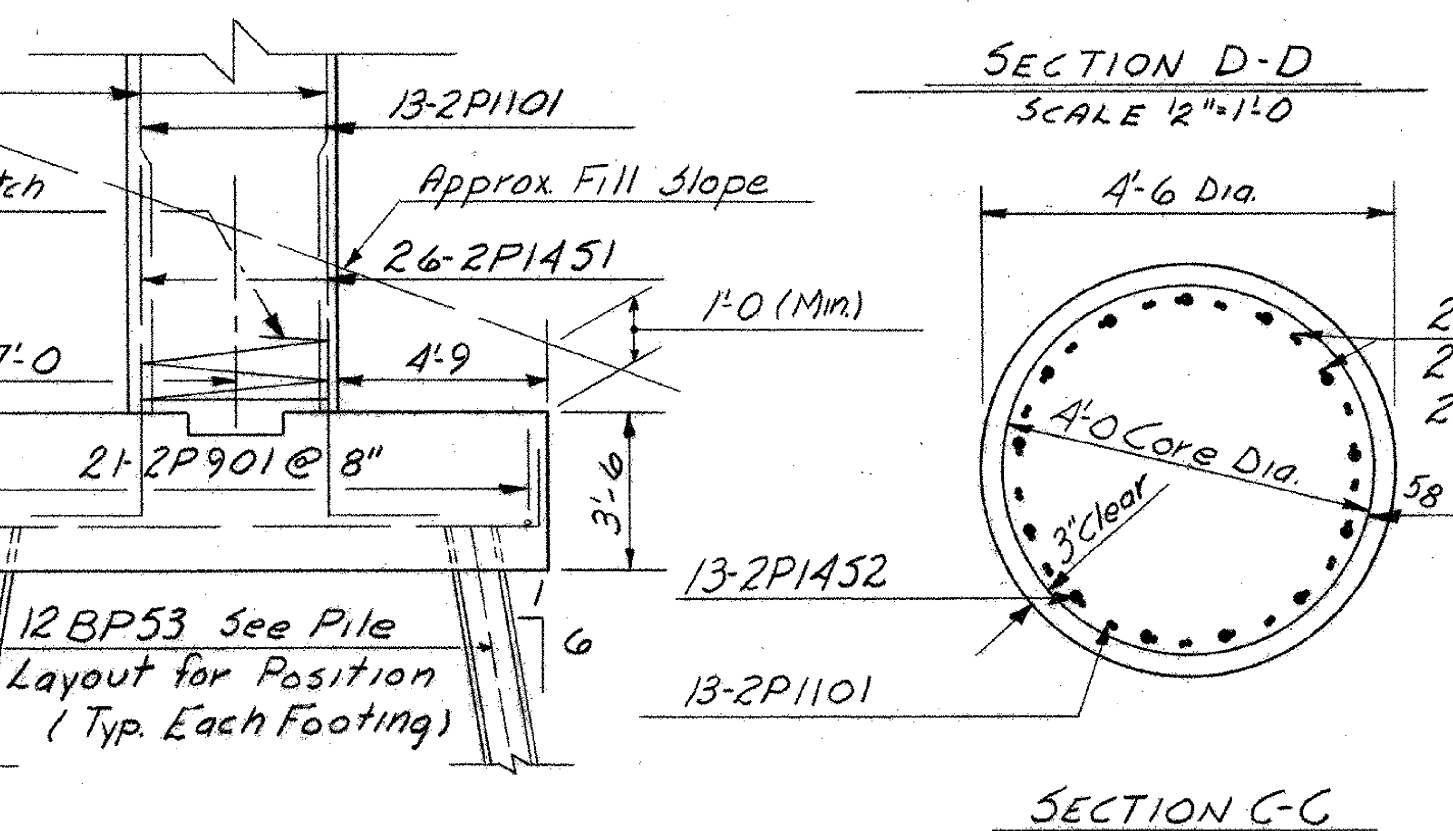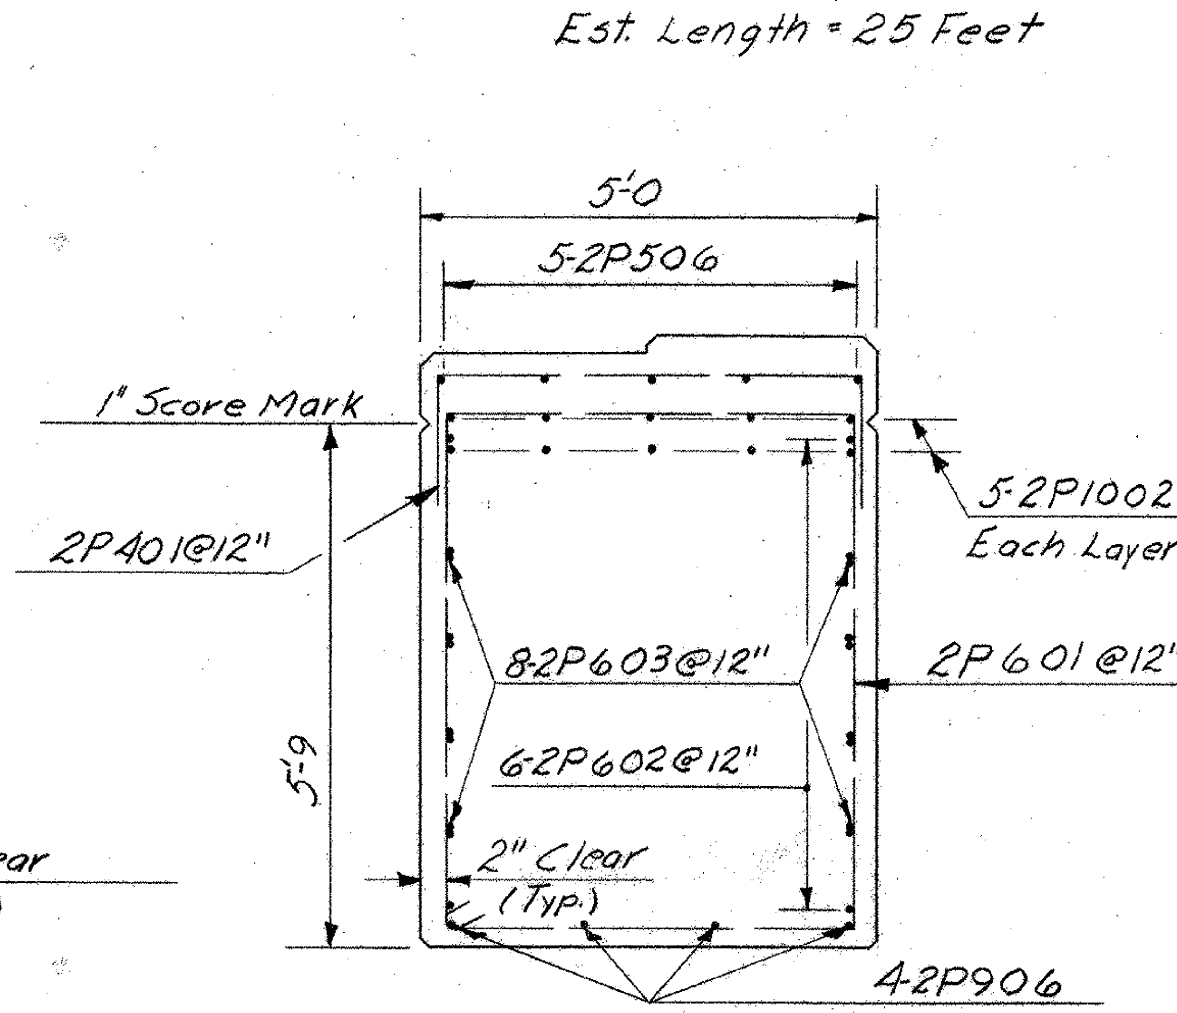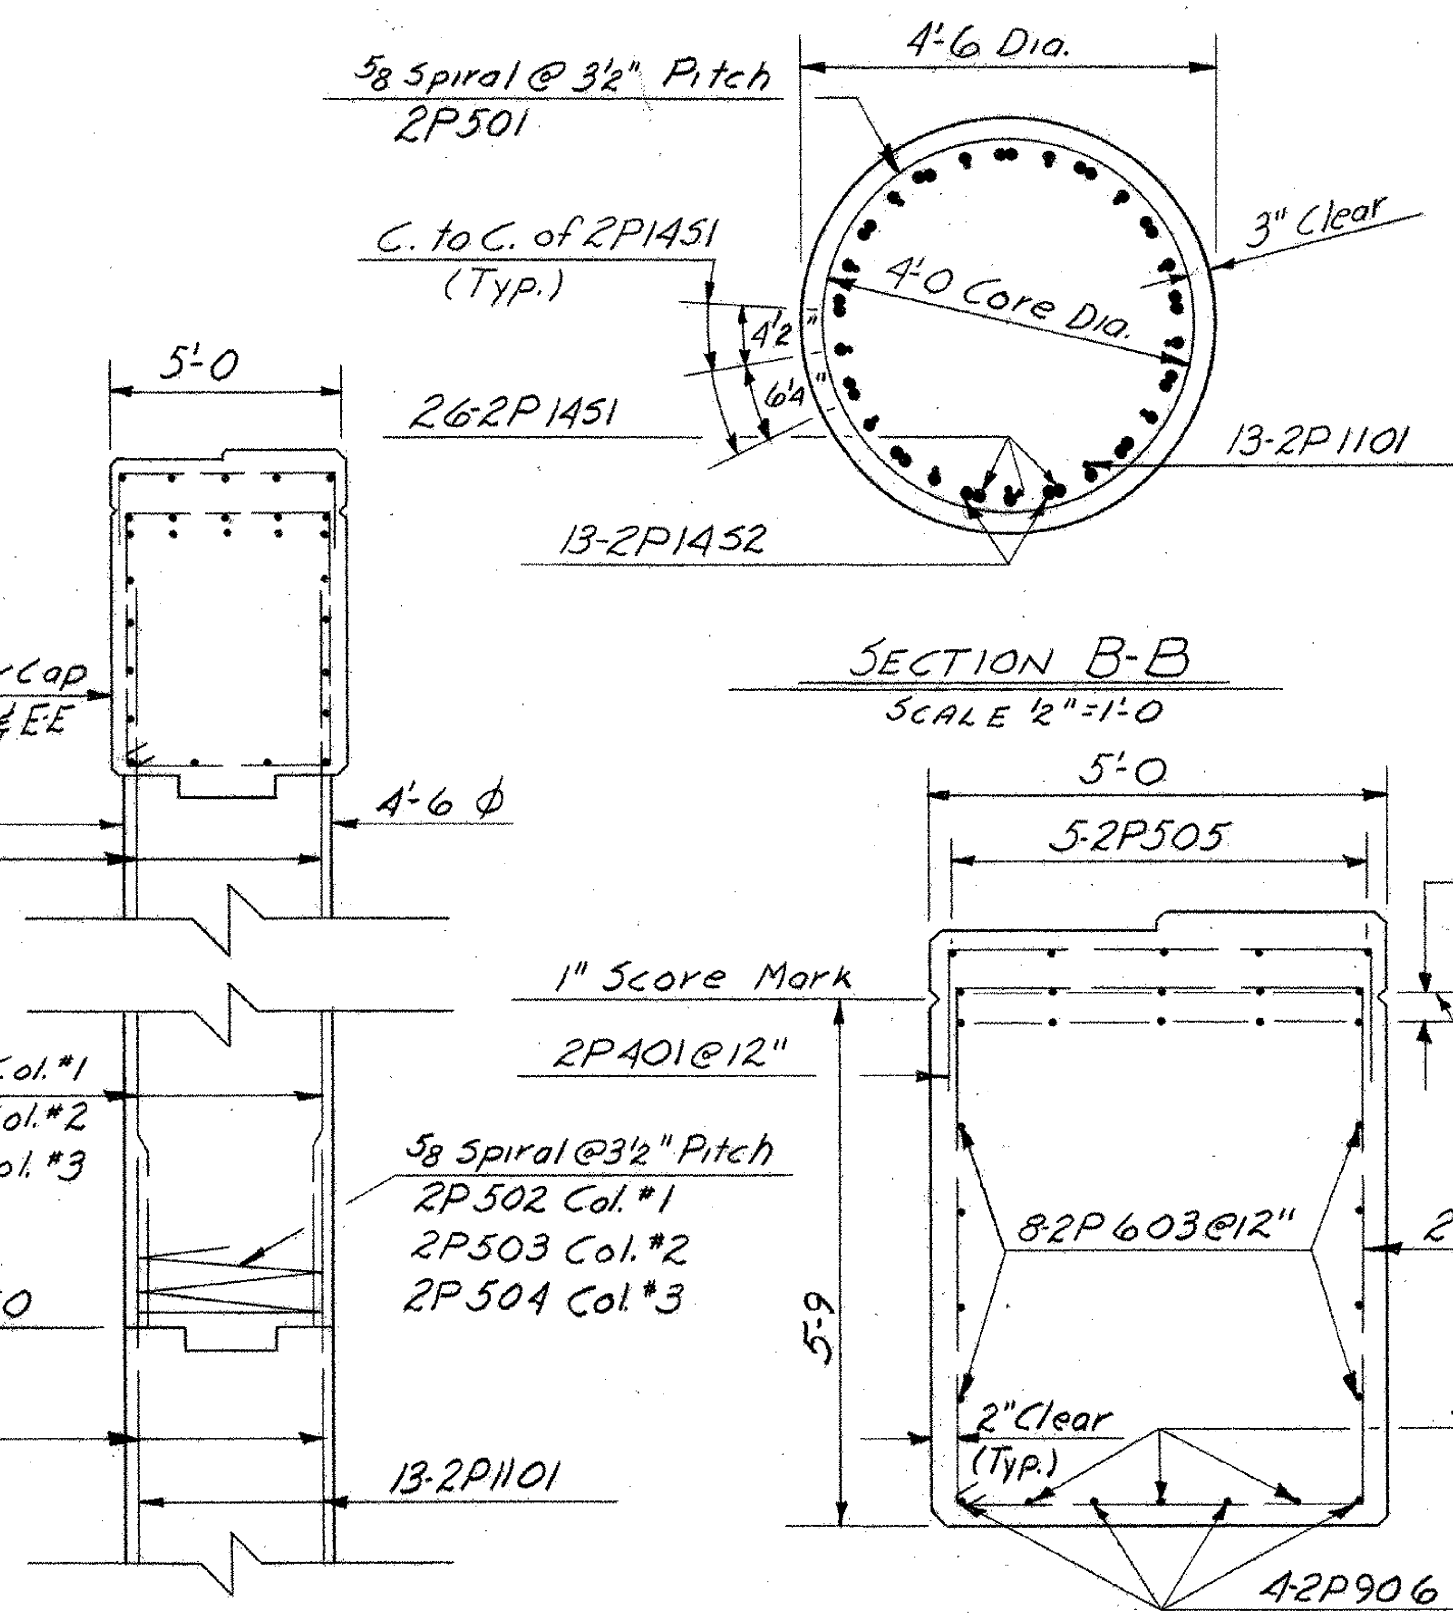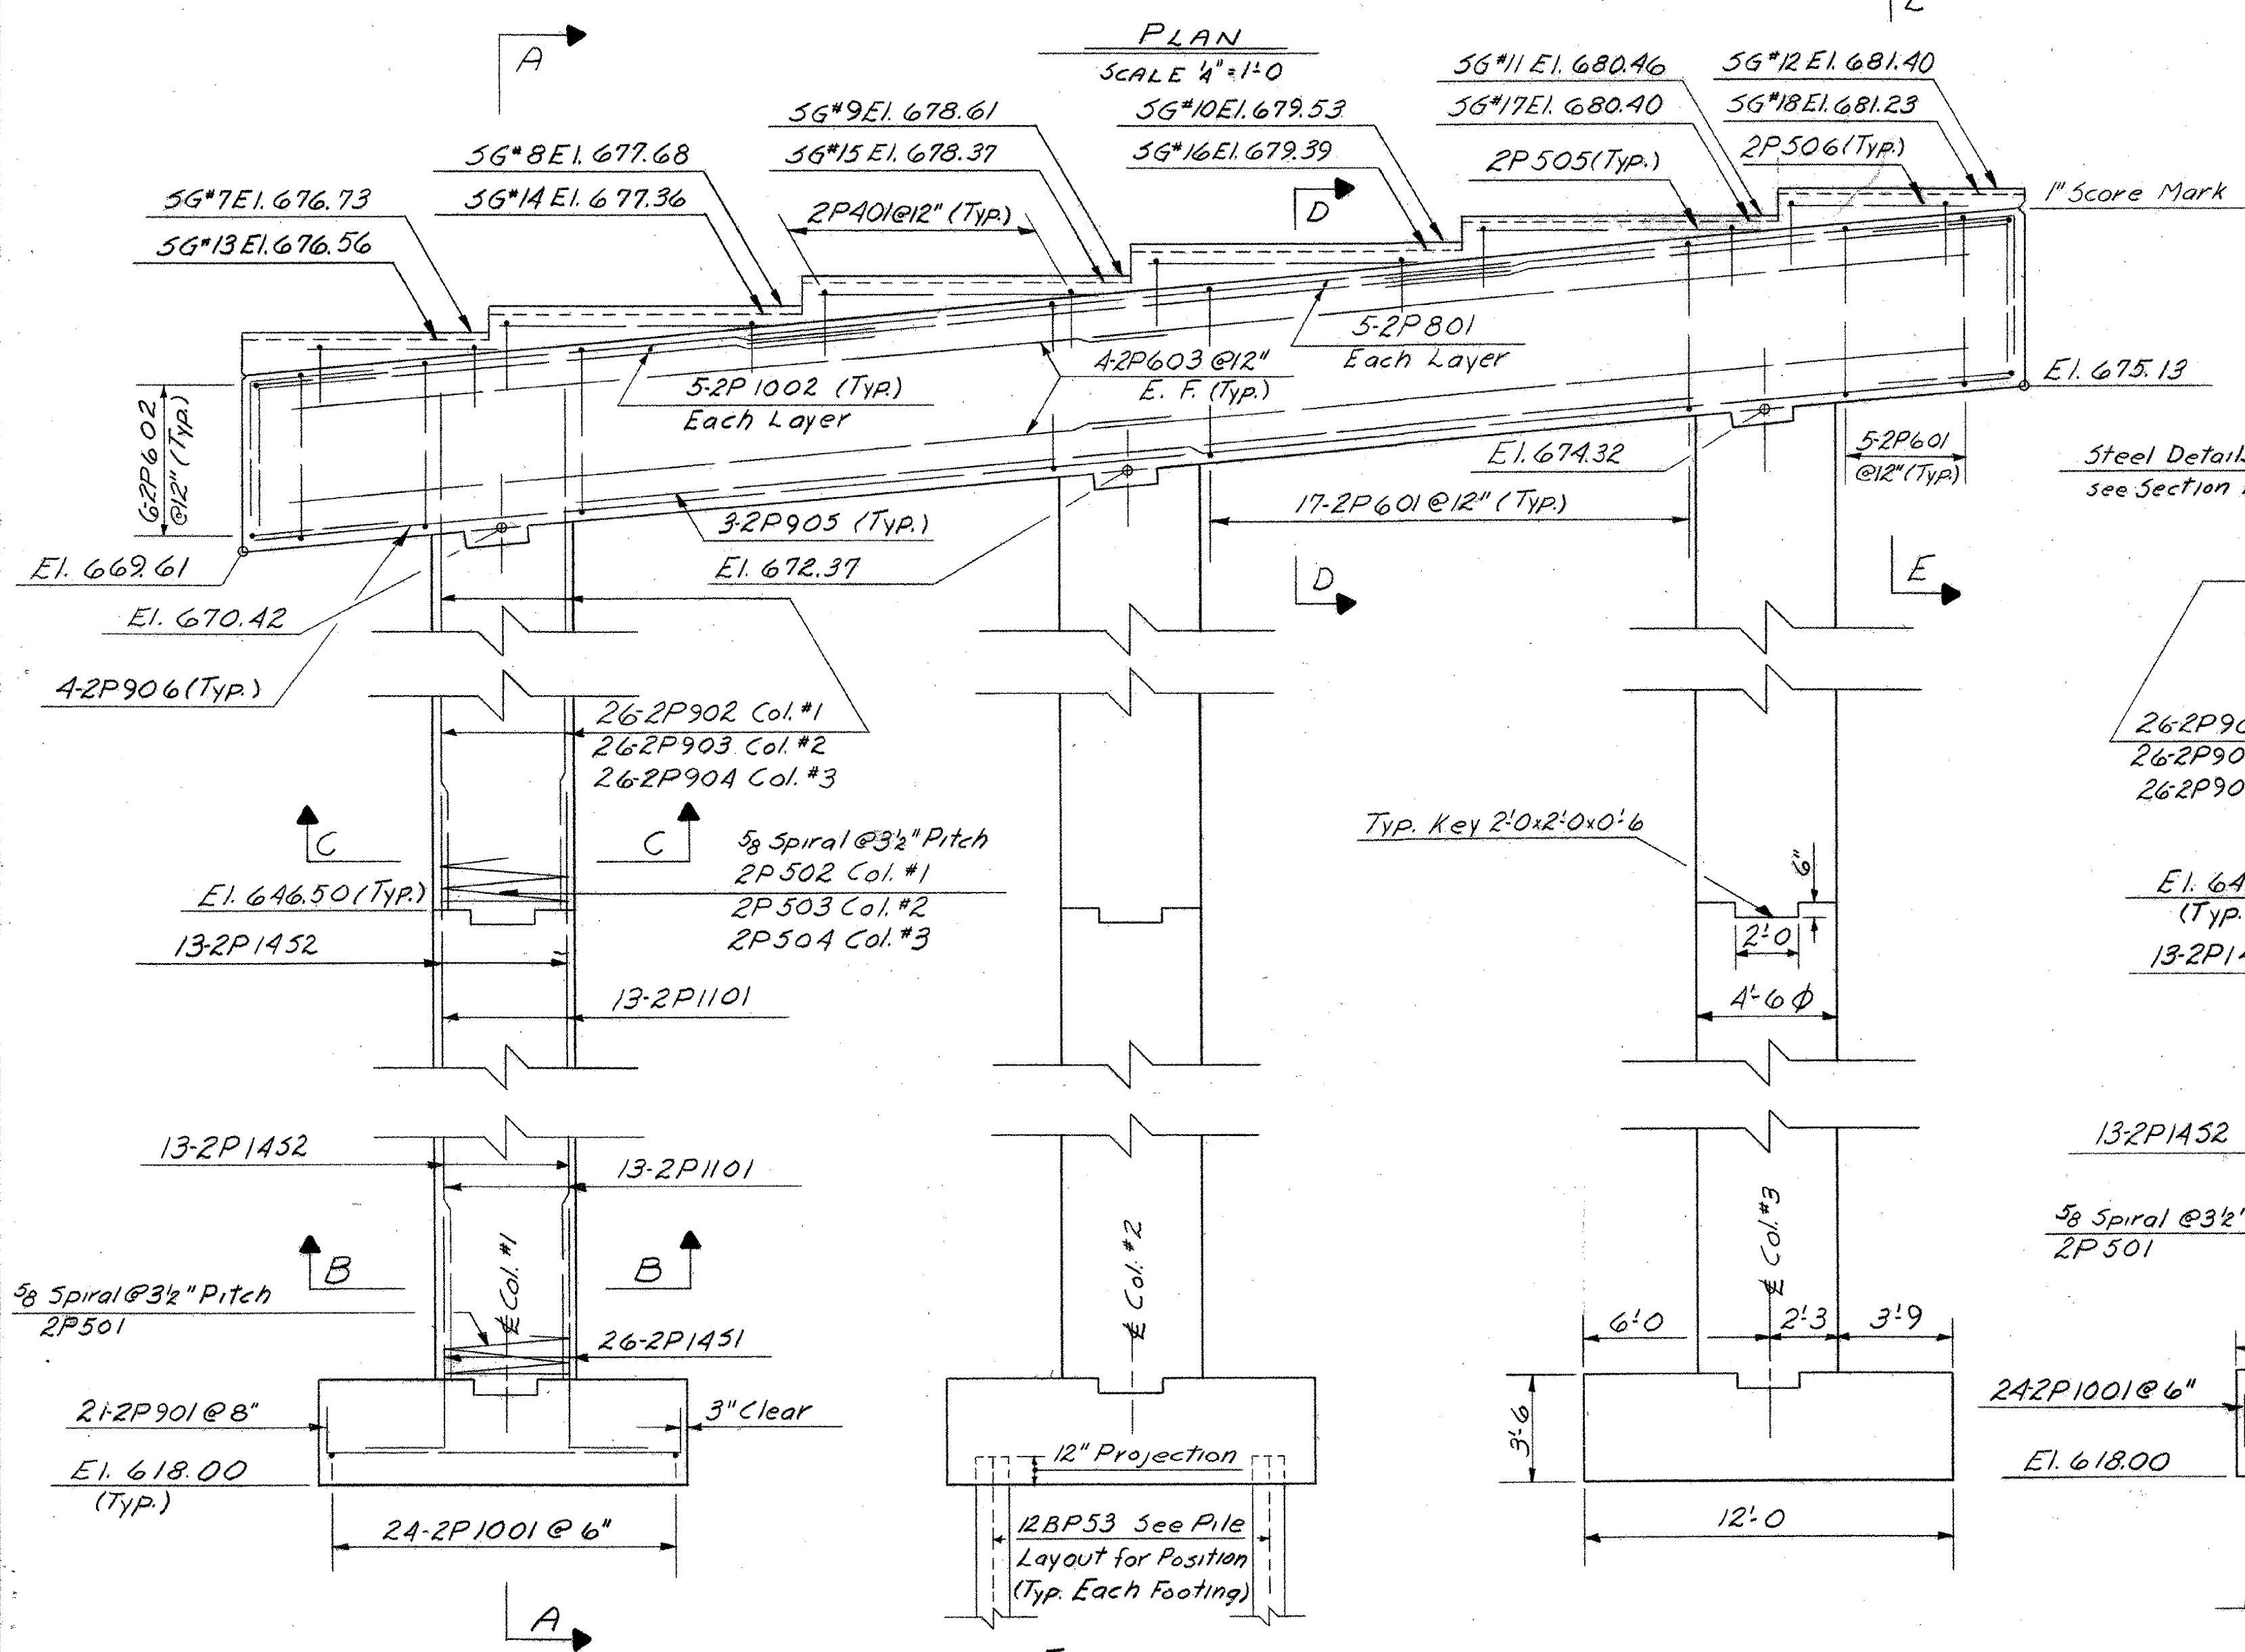

THIS SHEET FOR REFERENCE ONLY  
 BERLIN IM 089-1(20)  
 BRIDGES 40 N&S  
 SHEET 97 OF 104



**STATE OF VERMONT**  
 DEPARTMENT OF HIGHWAYS

PROJECT BERLIN-MONTPELIER  
 TOWNS OF BERLIN, MONTPELIER

ROUTE No. I-89 STA. 193+50±  
 I-89 OVER VT. #12



PIER #2

SCALE AS SHOWN



IN CHARGE W. SMITH

DRAWN BY E.B. MAN CHECKED BY W.T. TRIPP  
 11-67

PROJECT No. I-89-1(12)  
 SHEET 171 OF 427 BR 420

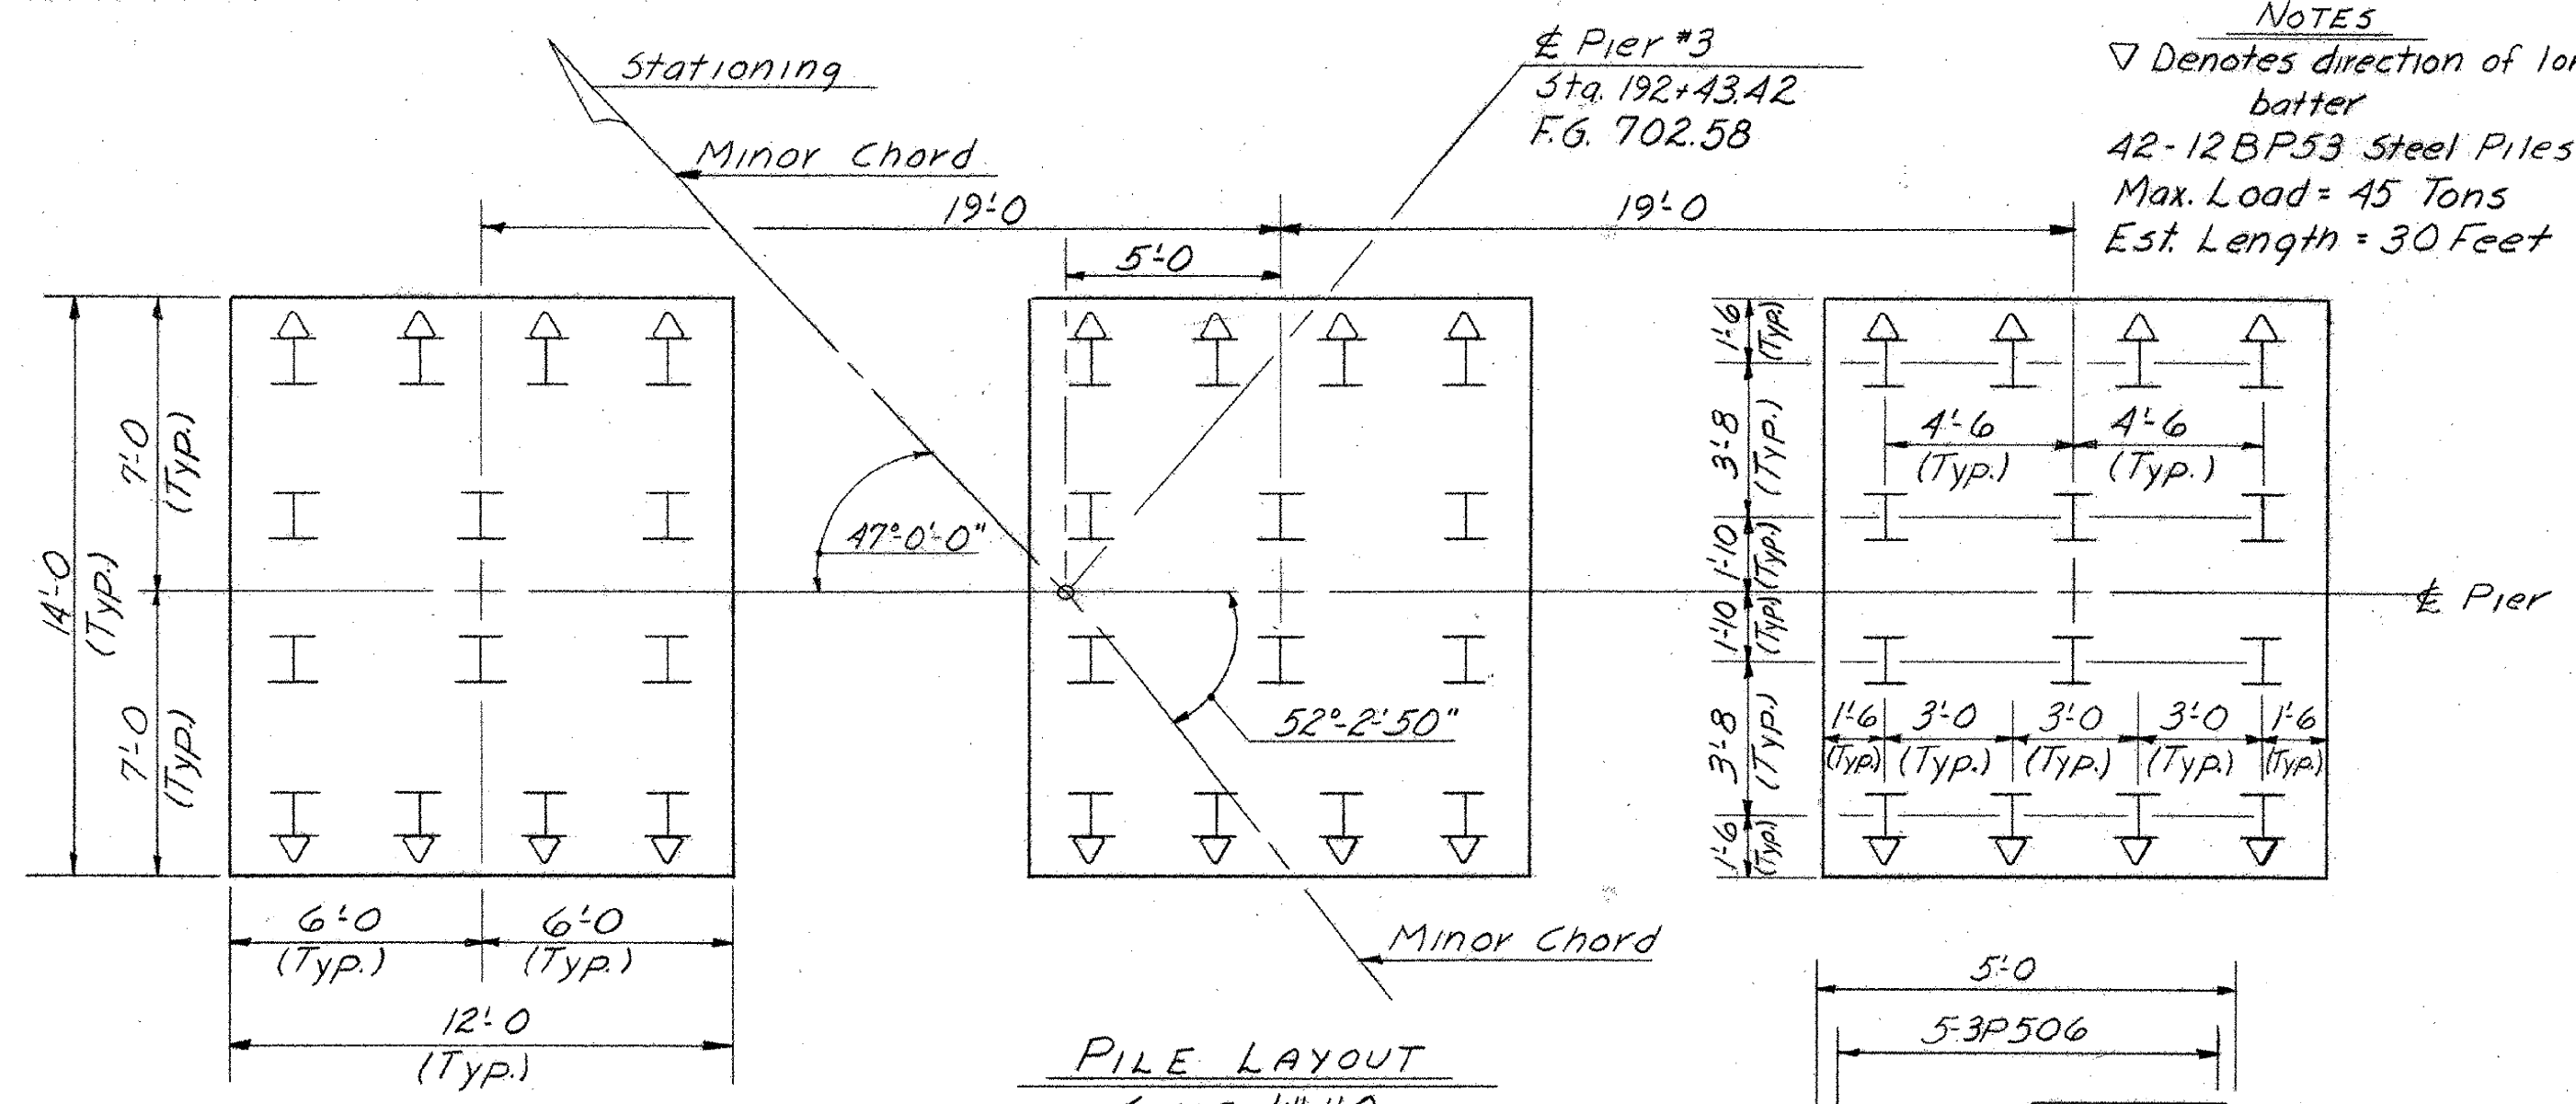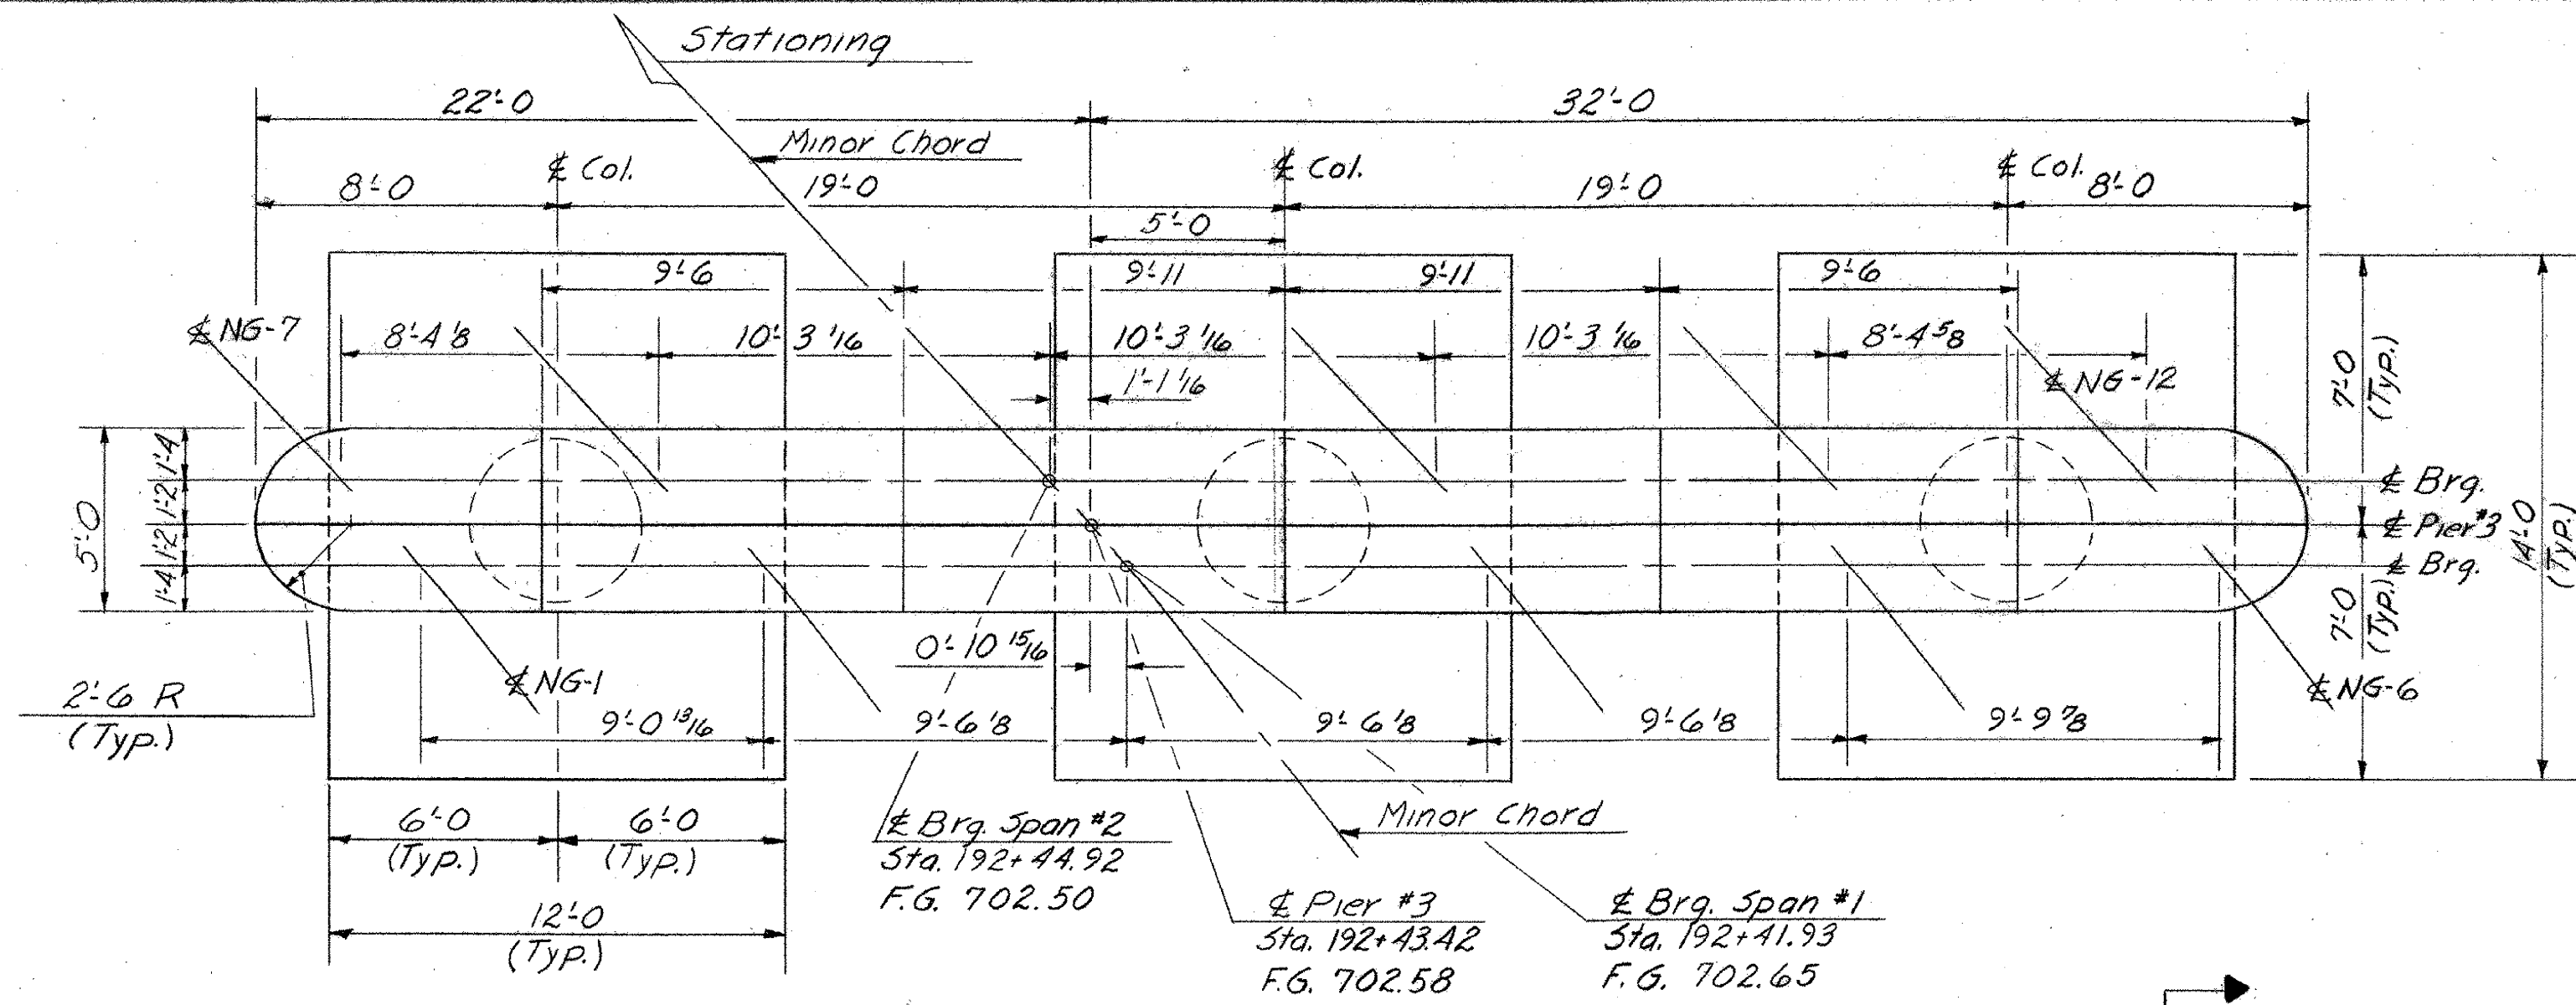

NOTES  
 ▽ Denotes direction of long batter  
 42-12BP53 Steel Piles  
 Max. Load = 45 Tons  
 Est. Length = 30 Feet

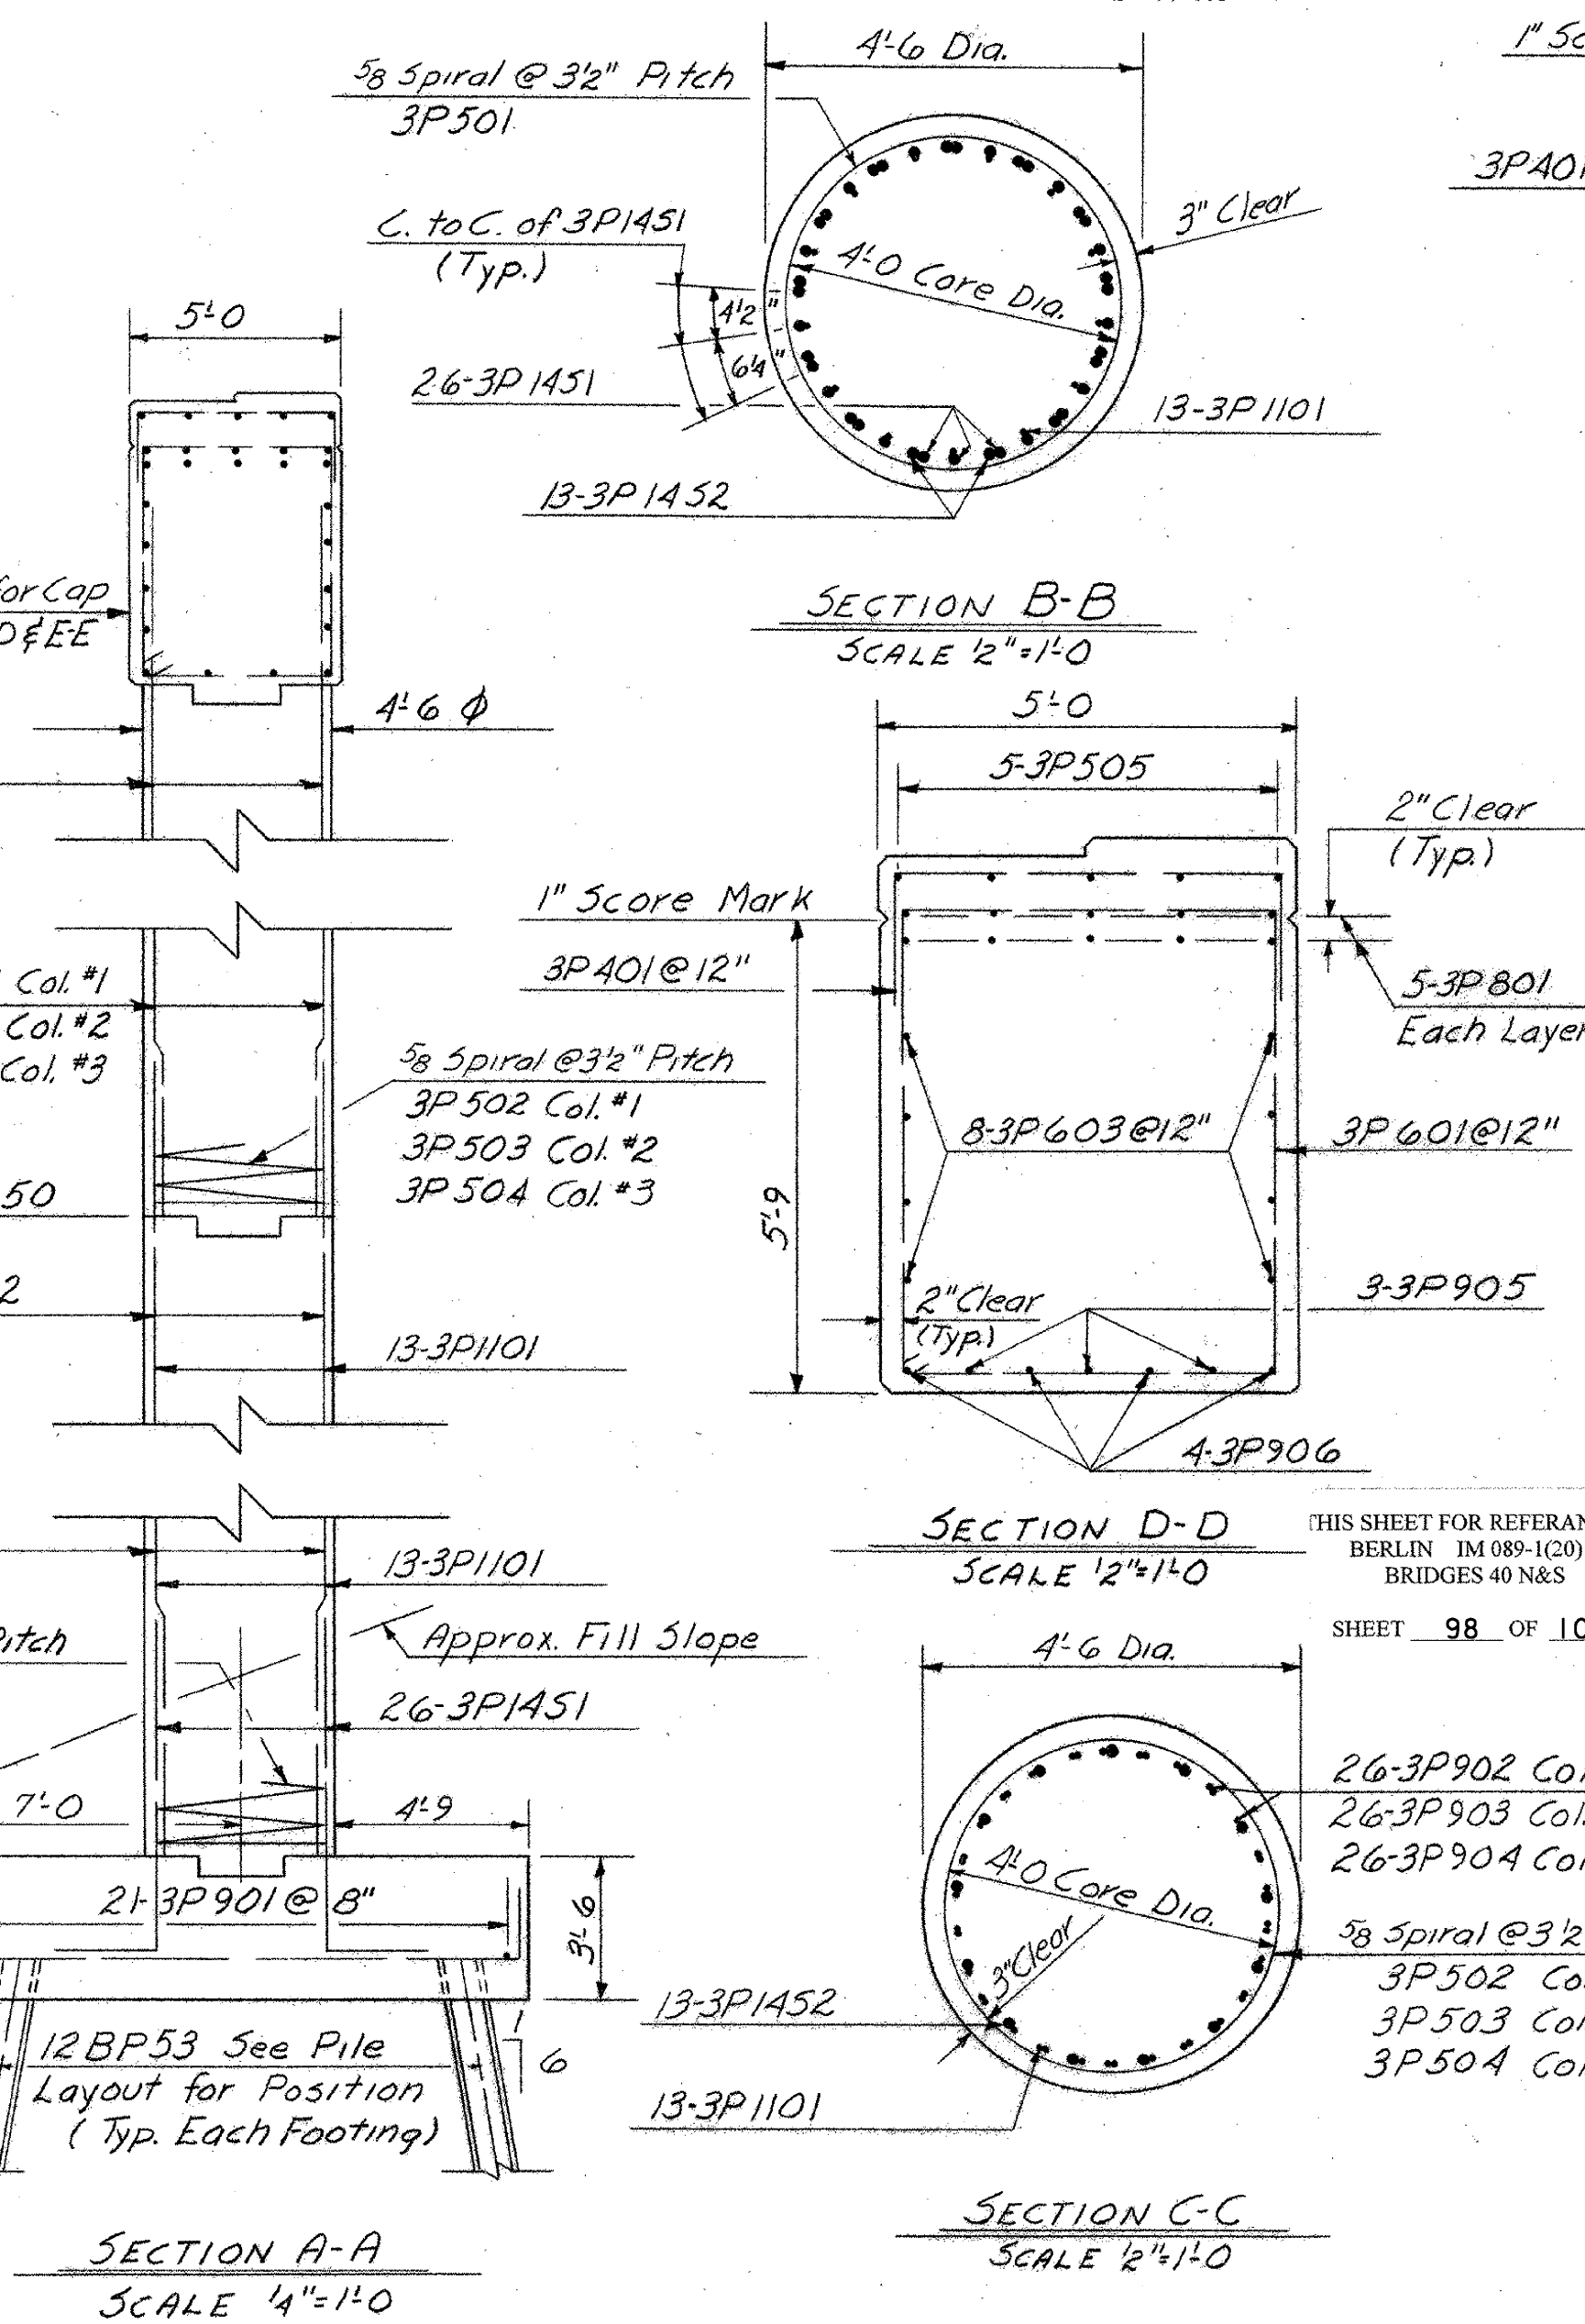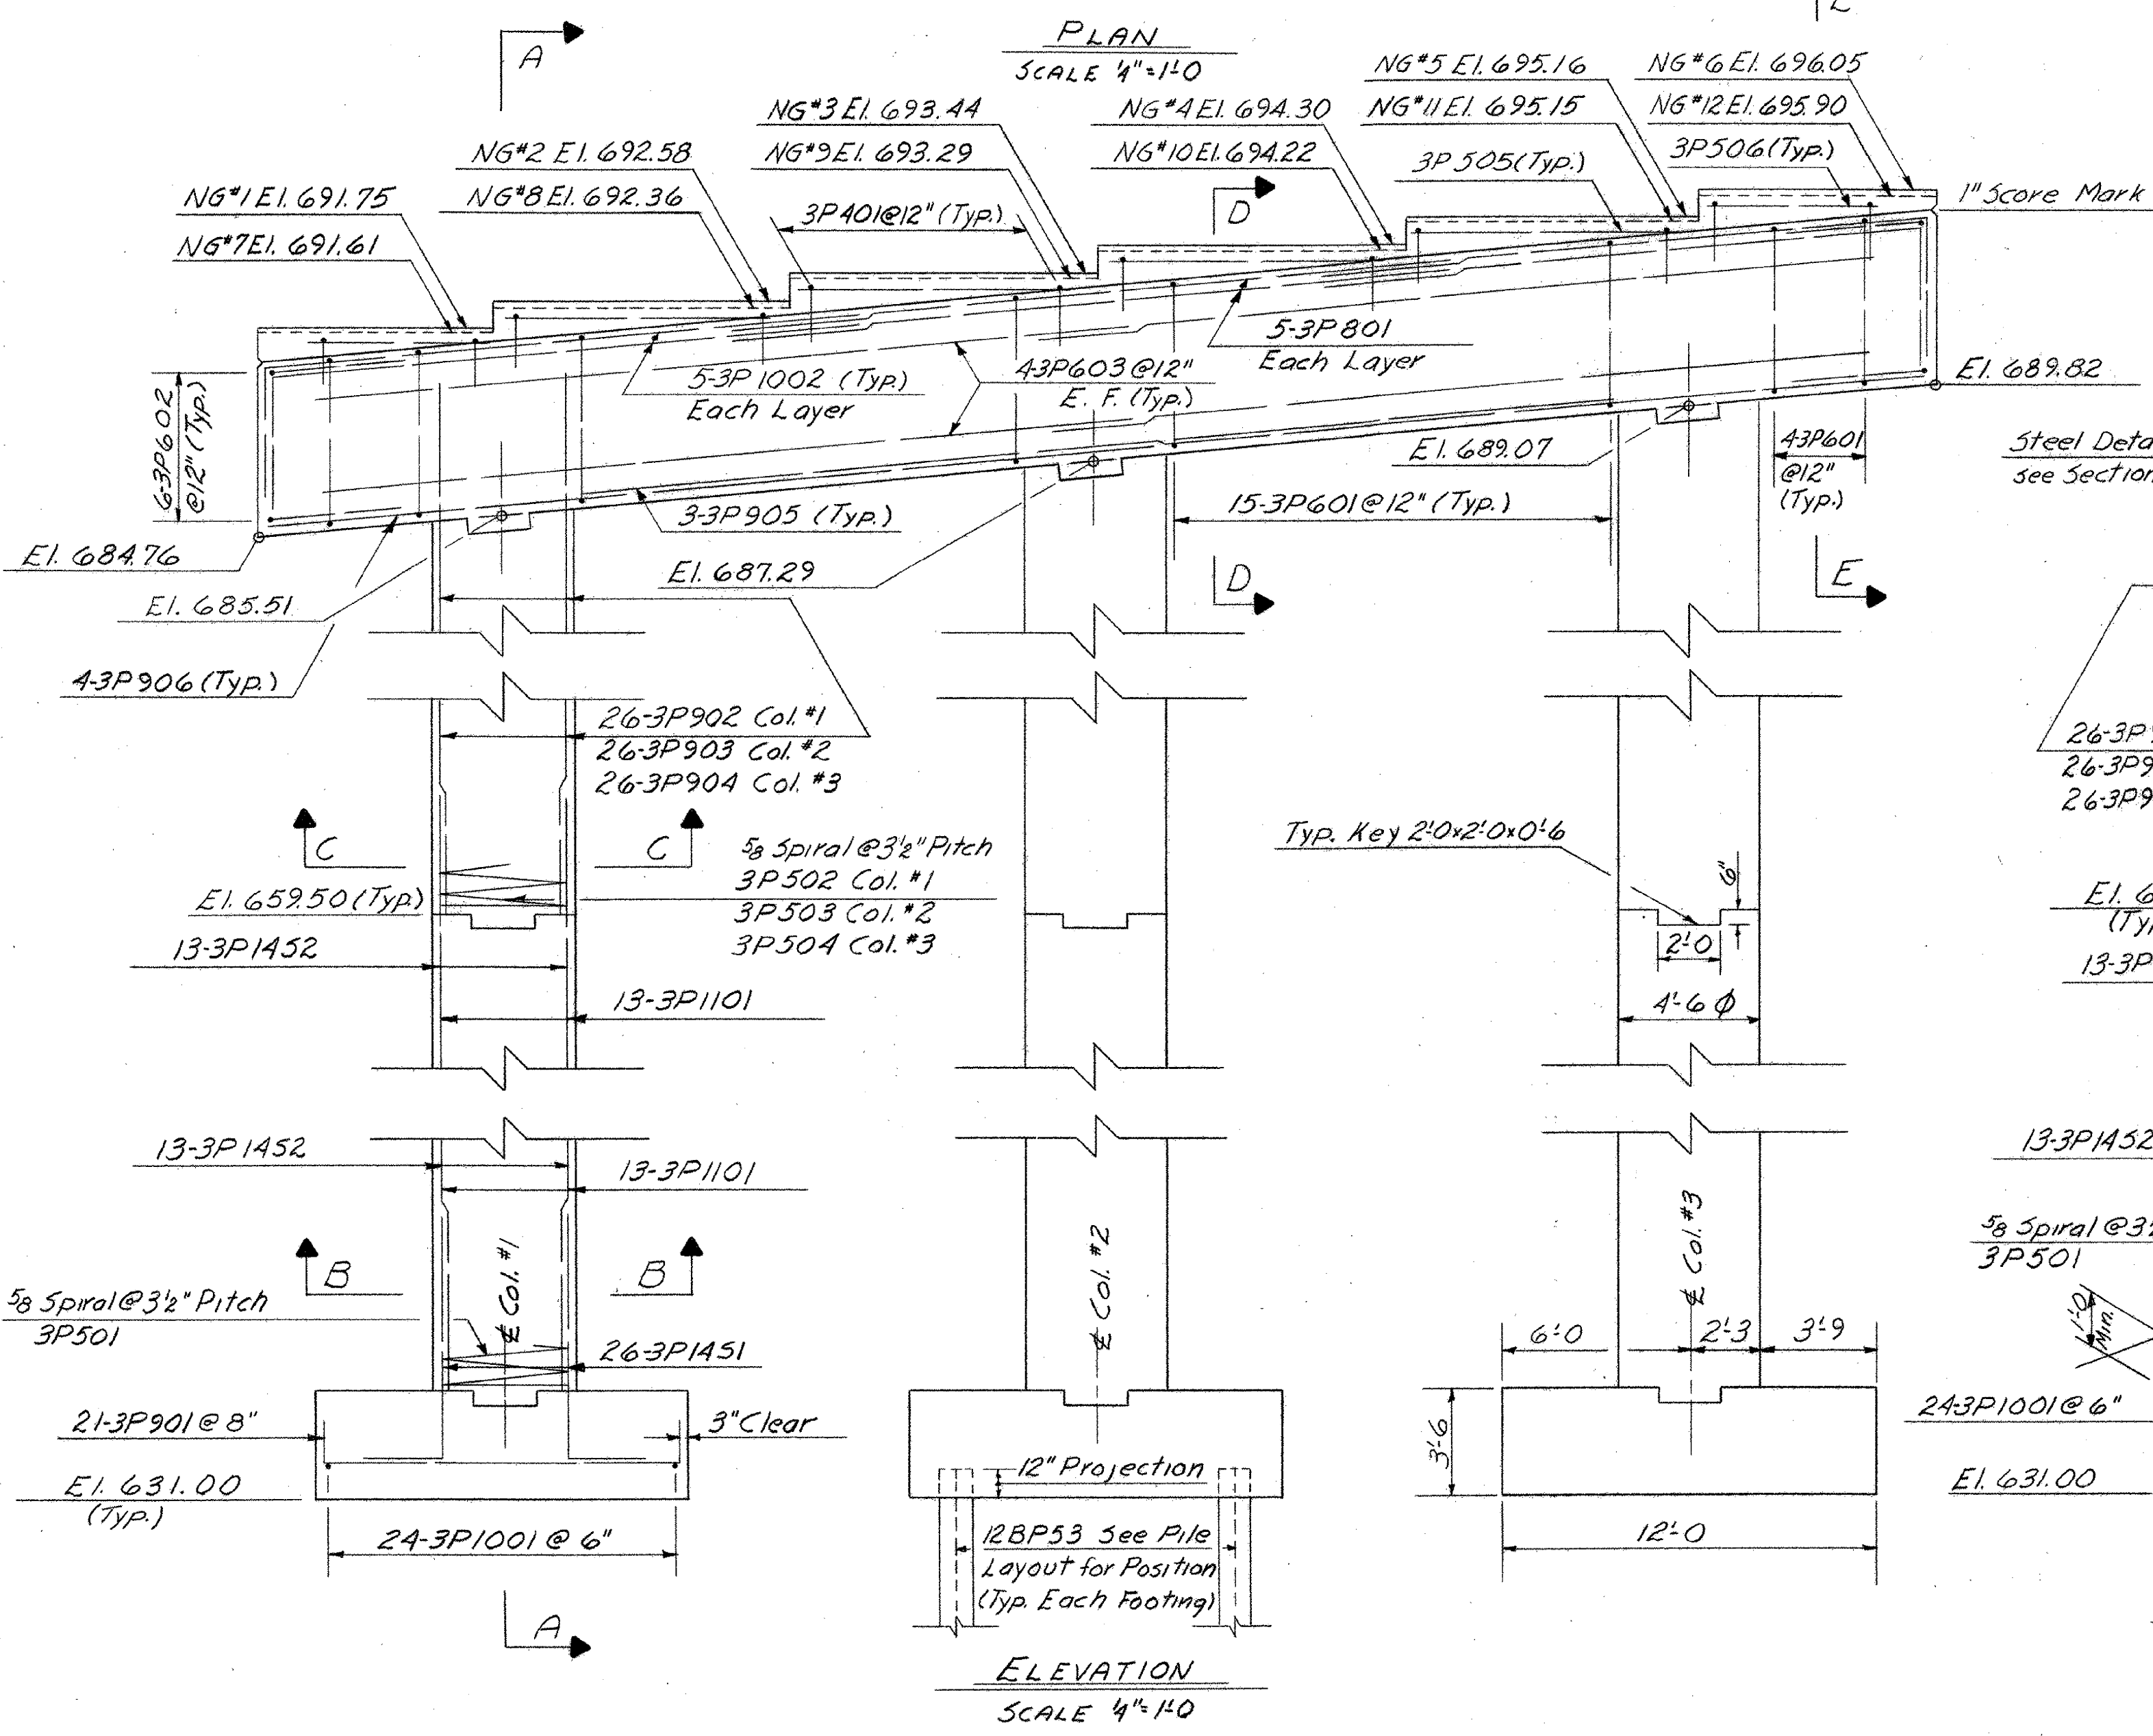

PILING TABLE				
Location	No. of Piles	Est. Lgh. of Piles	Splice Allowed for Piles Not Exceeding Plan Length (to be paid for only if used)	Splices Estimated for Piles Exceeding Plan Length (to be paid for only if used)
Abut. #1	26	50'	0	5
* Abut. #2	28	45'	0	6
Abut. #3	28	55'	0	6
Abut. #4	30	40'	0	6
Pier #1	42	35'	0	9
Pier #2	42	25'	0	9
Pier #3	42	30'	0	9
Pier #4	42	30'	0	9

\* Abut. #2 Estimated Ledge Elevation 626.0±  
 For Pier Notes see BR. 419.

THIS SHEET FOR REFERENCE ONLY  
 BERLIN JM 089-1C0  
 BRIDGES 40 N&S  
 SHEET 98 OF 104

**STATE OF VERMONT**  
 DEPARTMENT OF HIGHWAYS



PROJECT BERLIN-MONTPELIER  
 TOWNS OF BERLIN-MONTPELIER

ROUTE NO. I-89 STA. 193+50±  
 I-89 OVER VT #12



PIER #3

SCALE AS SHOWN  
 IN CHARGE W. SMITH

DRAWN BY E. GILMAN CHECKED BY W. TRIPP 11-67  
 PROJECT NO. I-89-(112)  
 SHEET 172 OF 192 BR 421

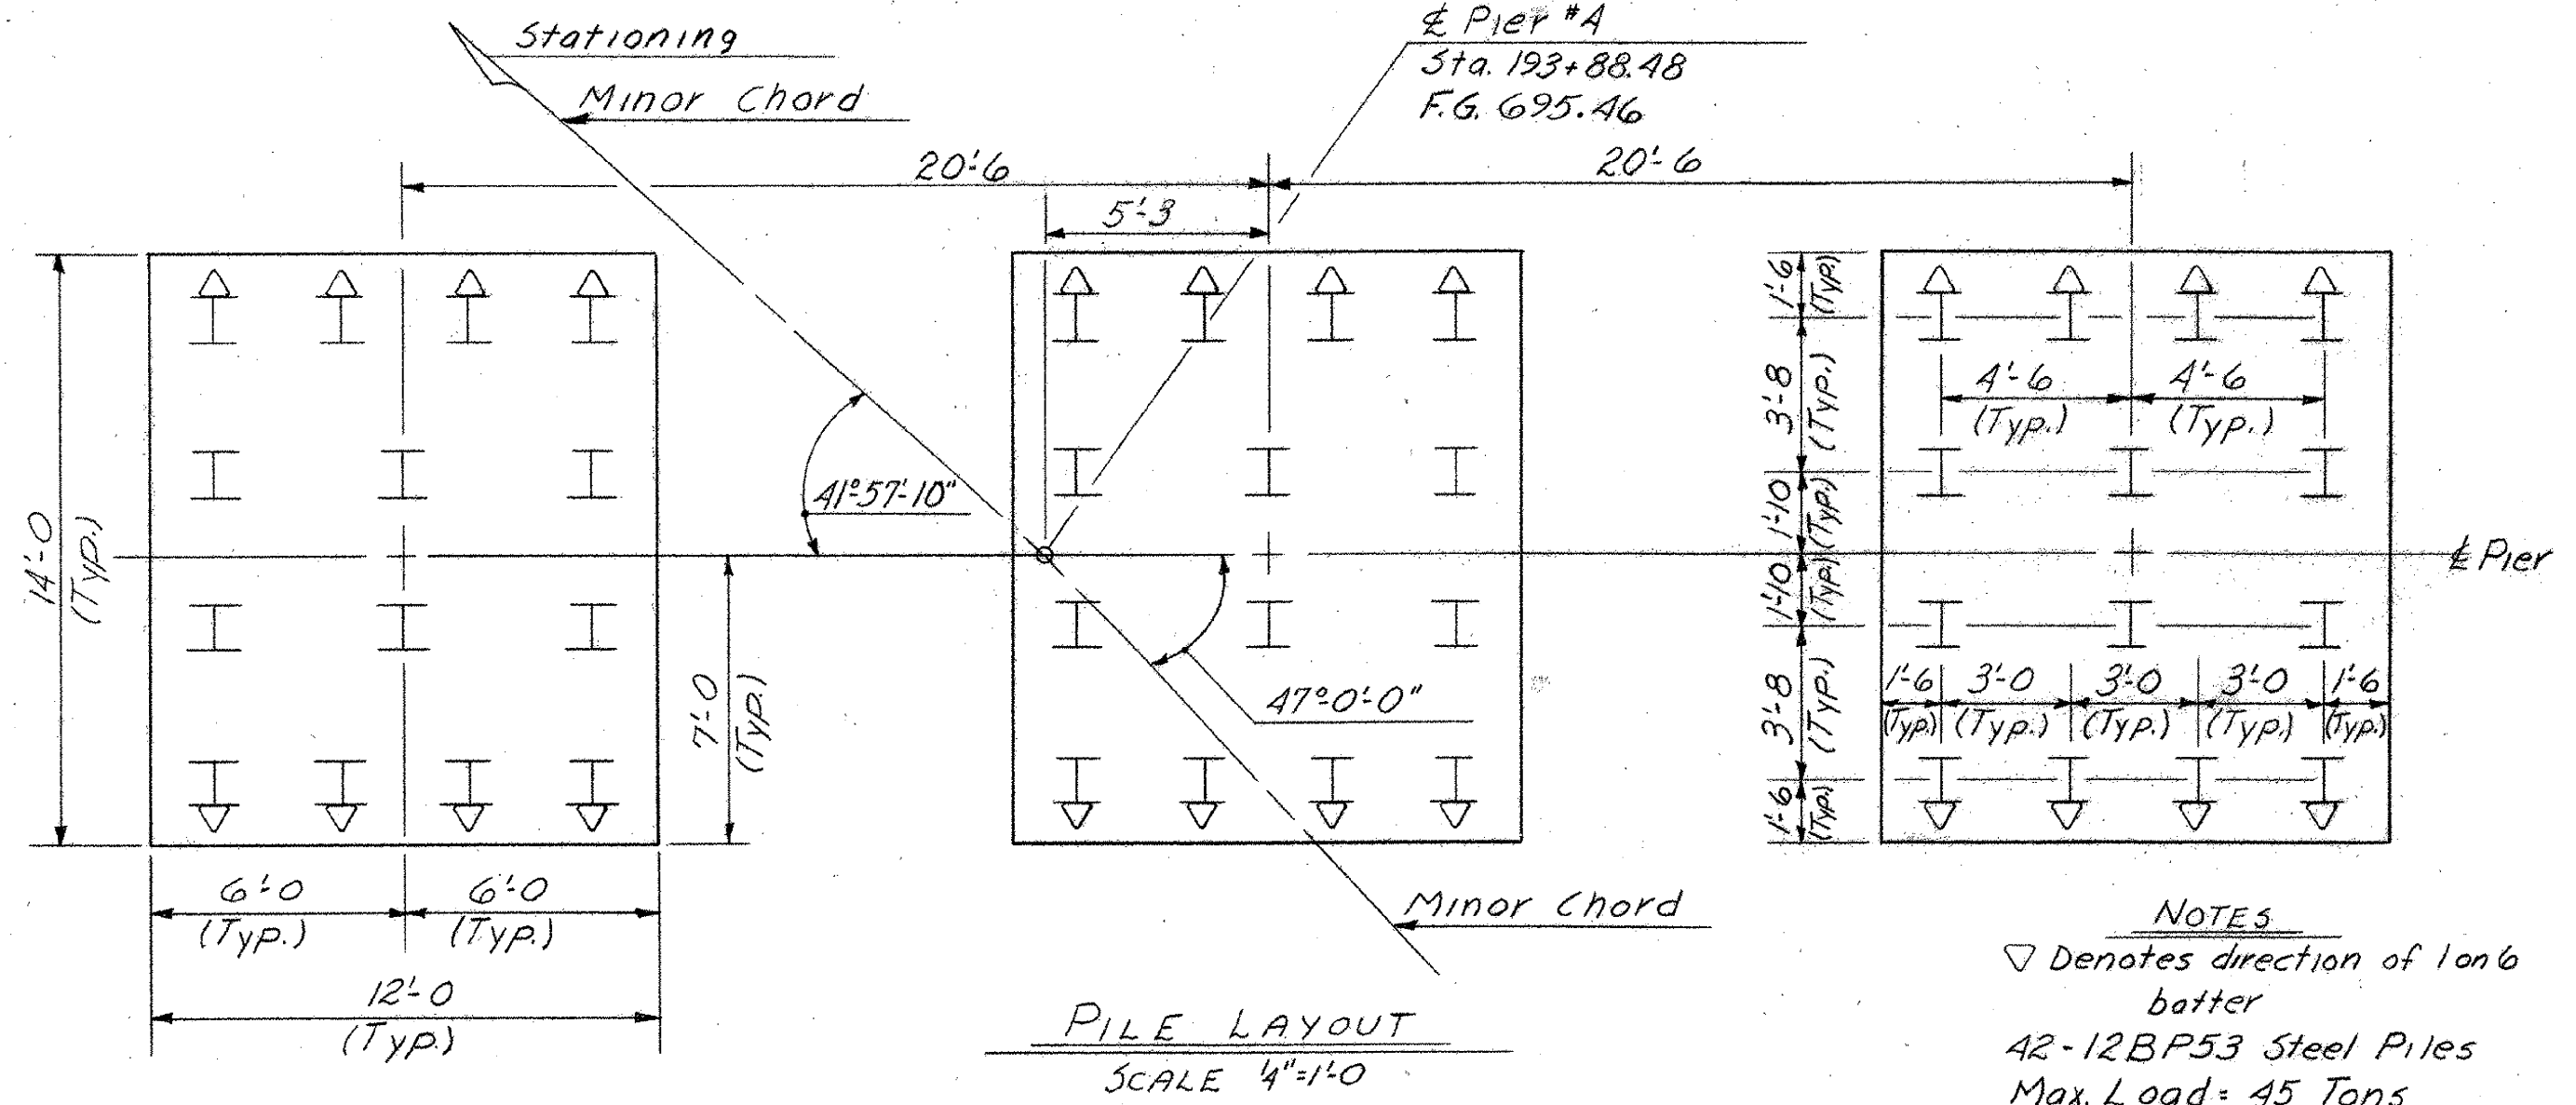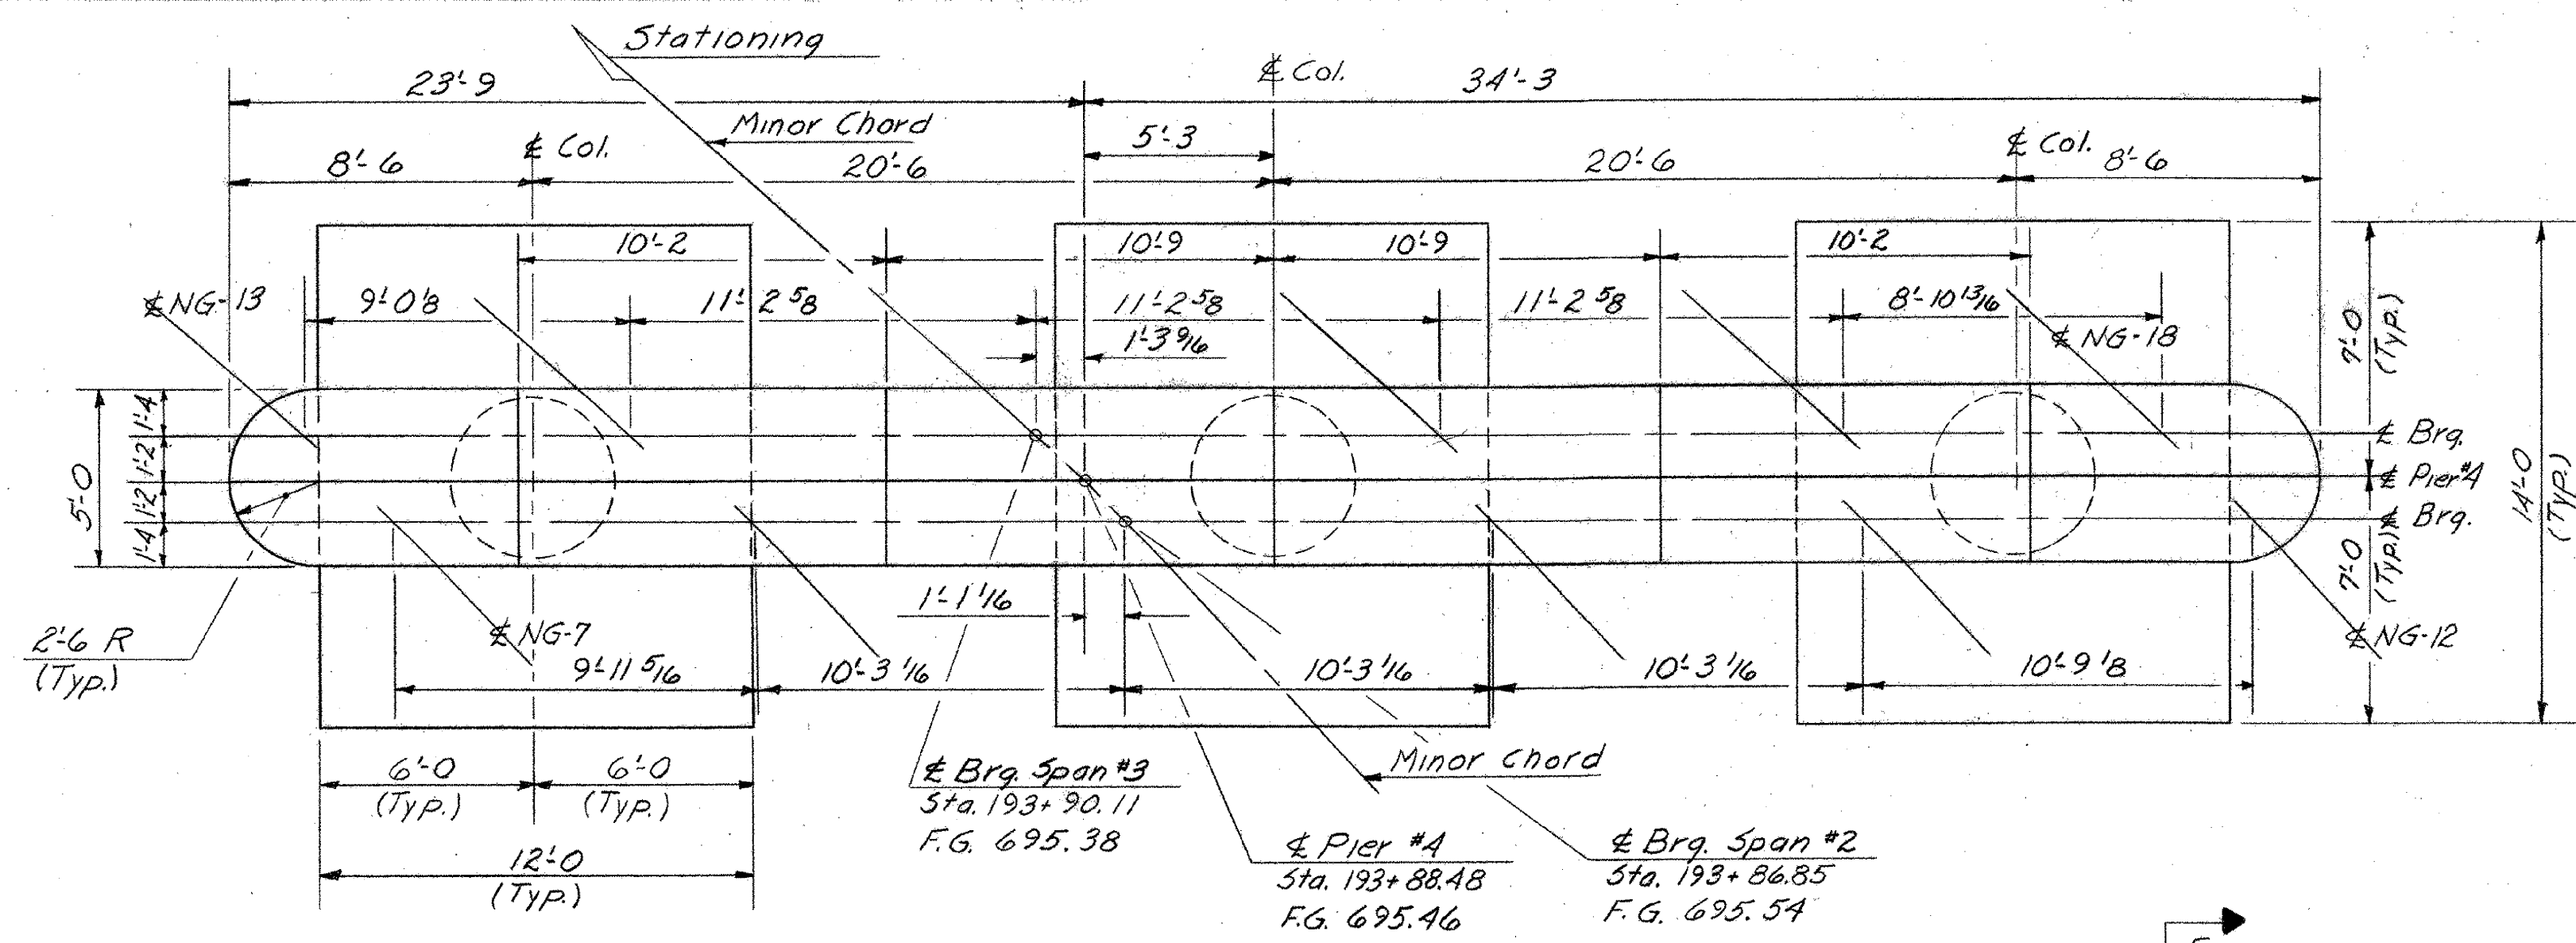

**NOTES**  
 ▽ Denotes direction of long batter  
 42-12BP53 Steel Piles  
 Max. Load = 45 Tons  
 Est. Length = 30 Feet

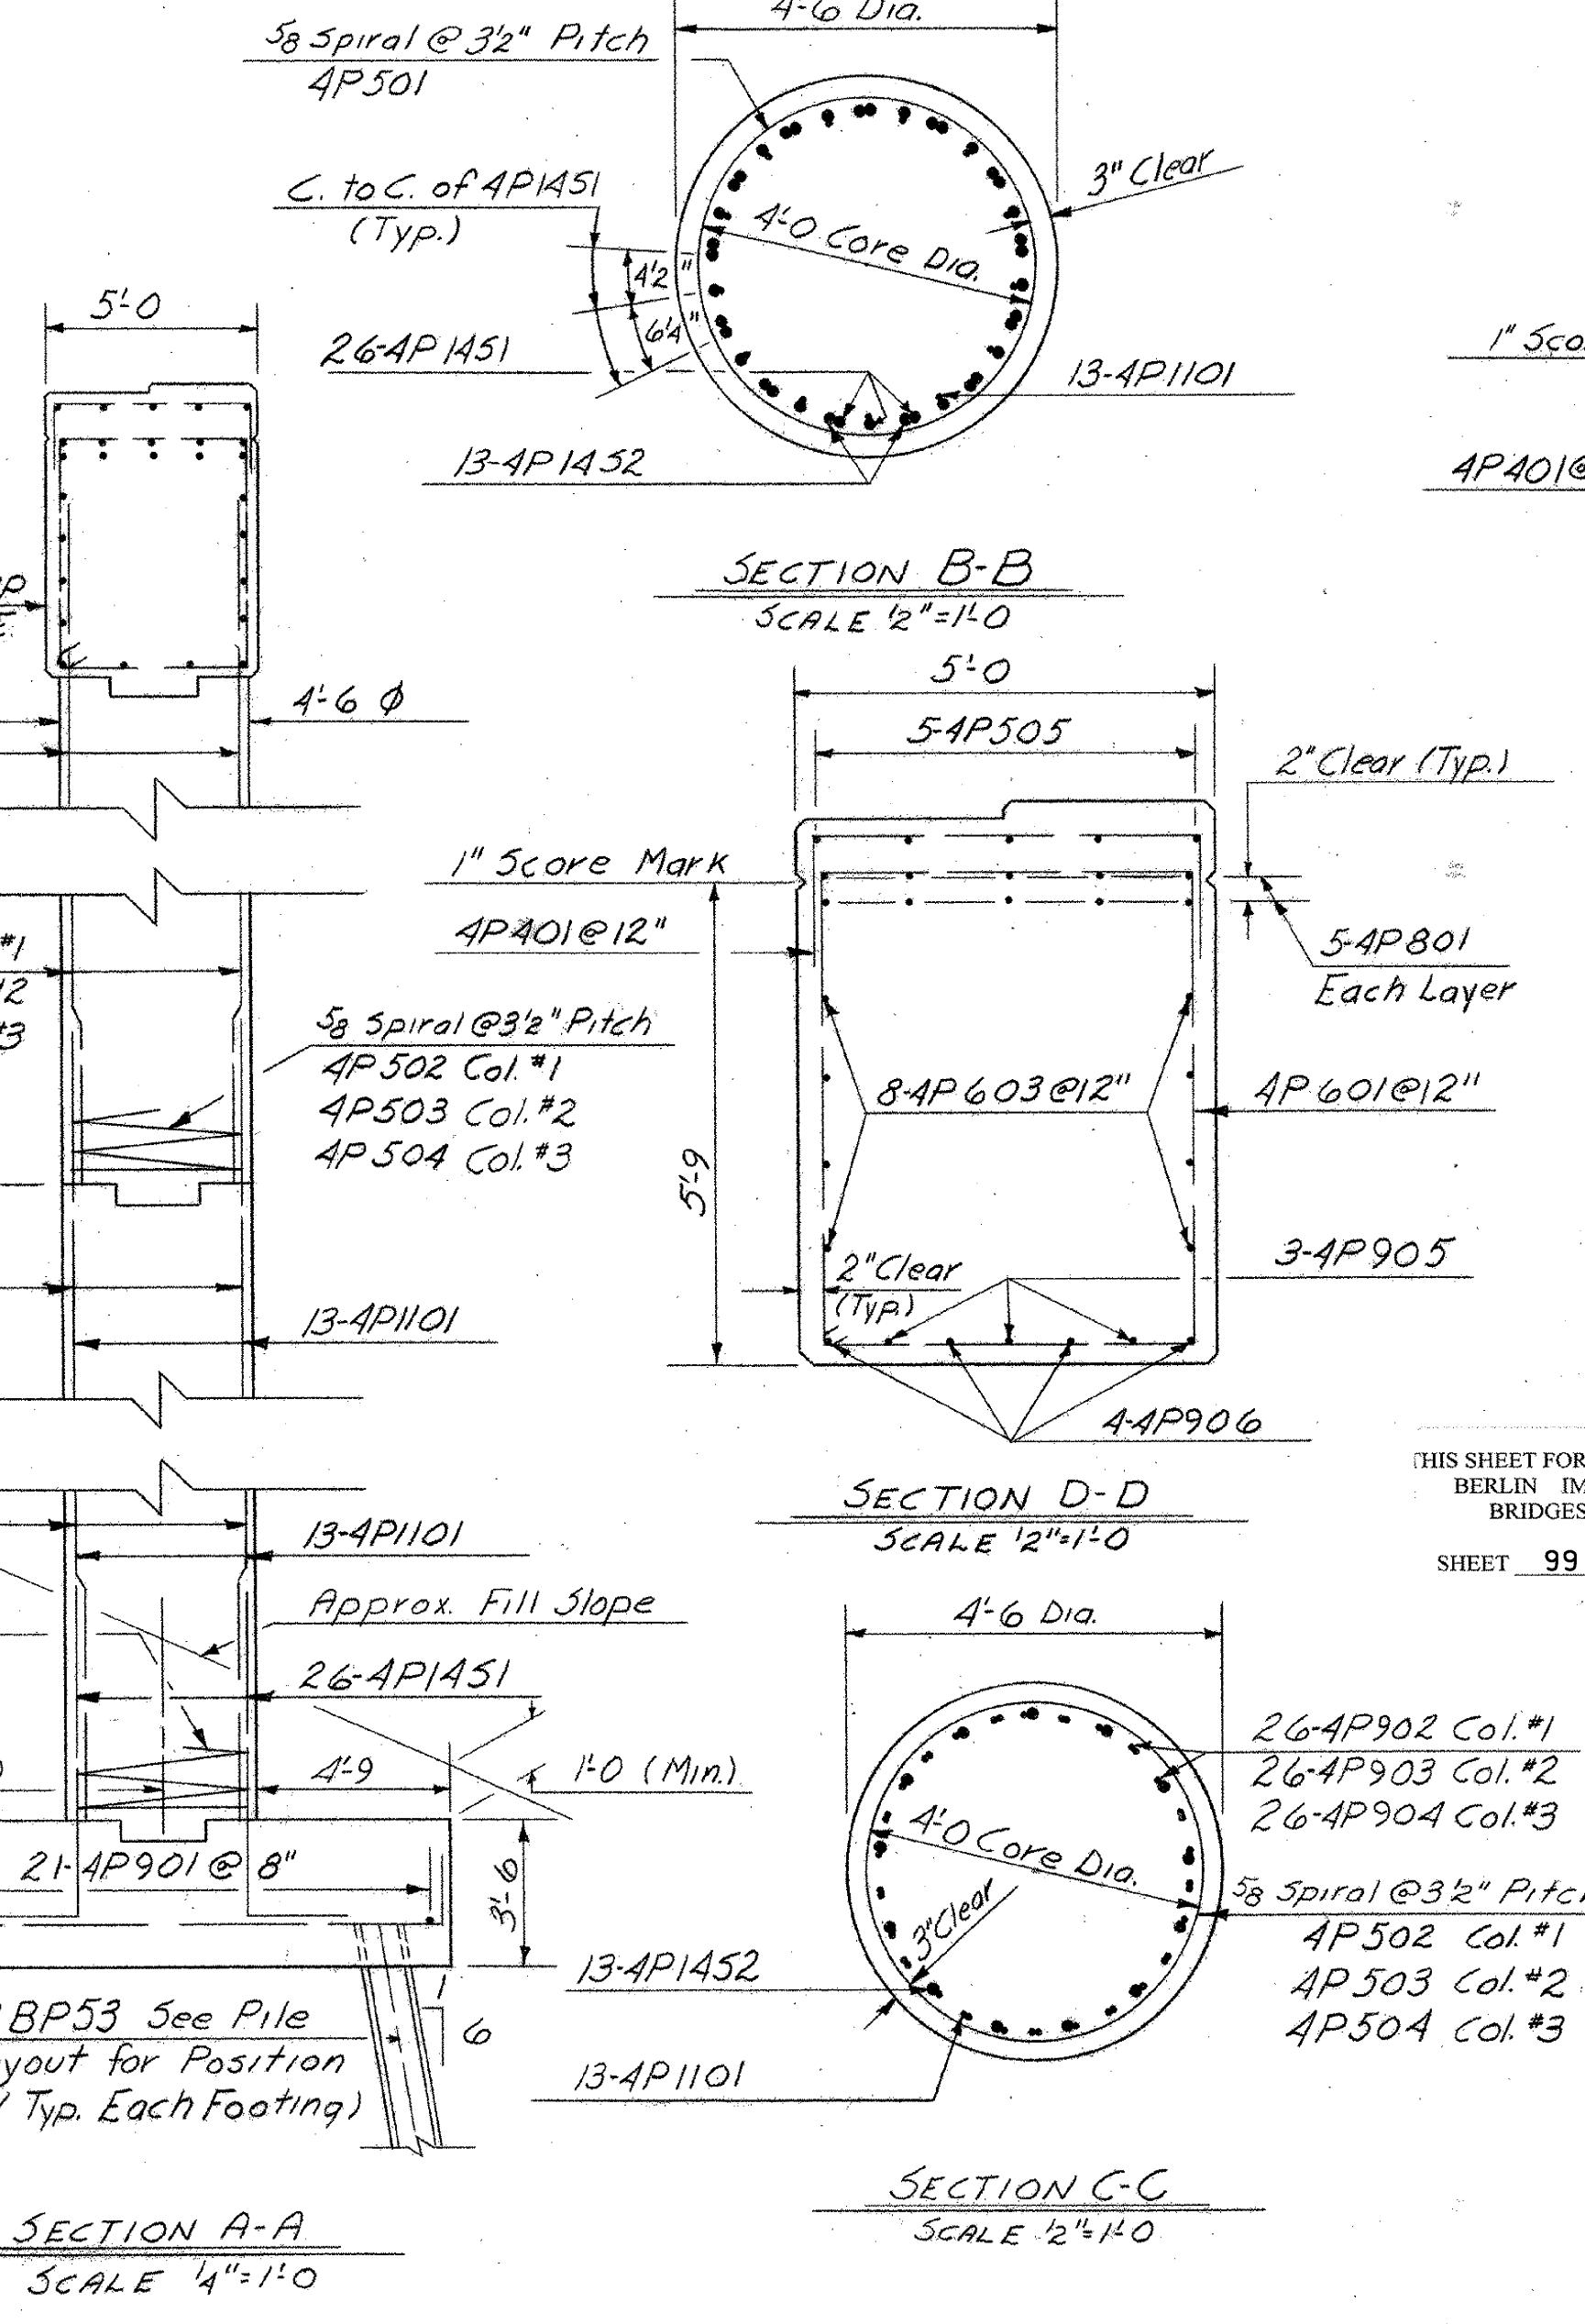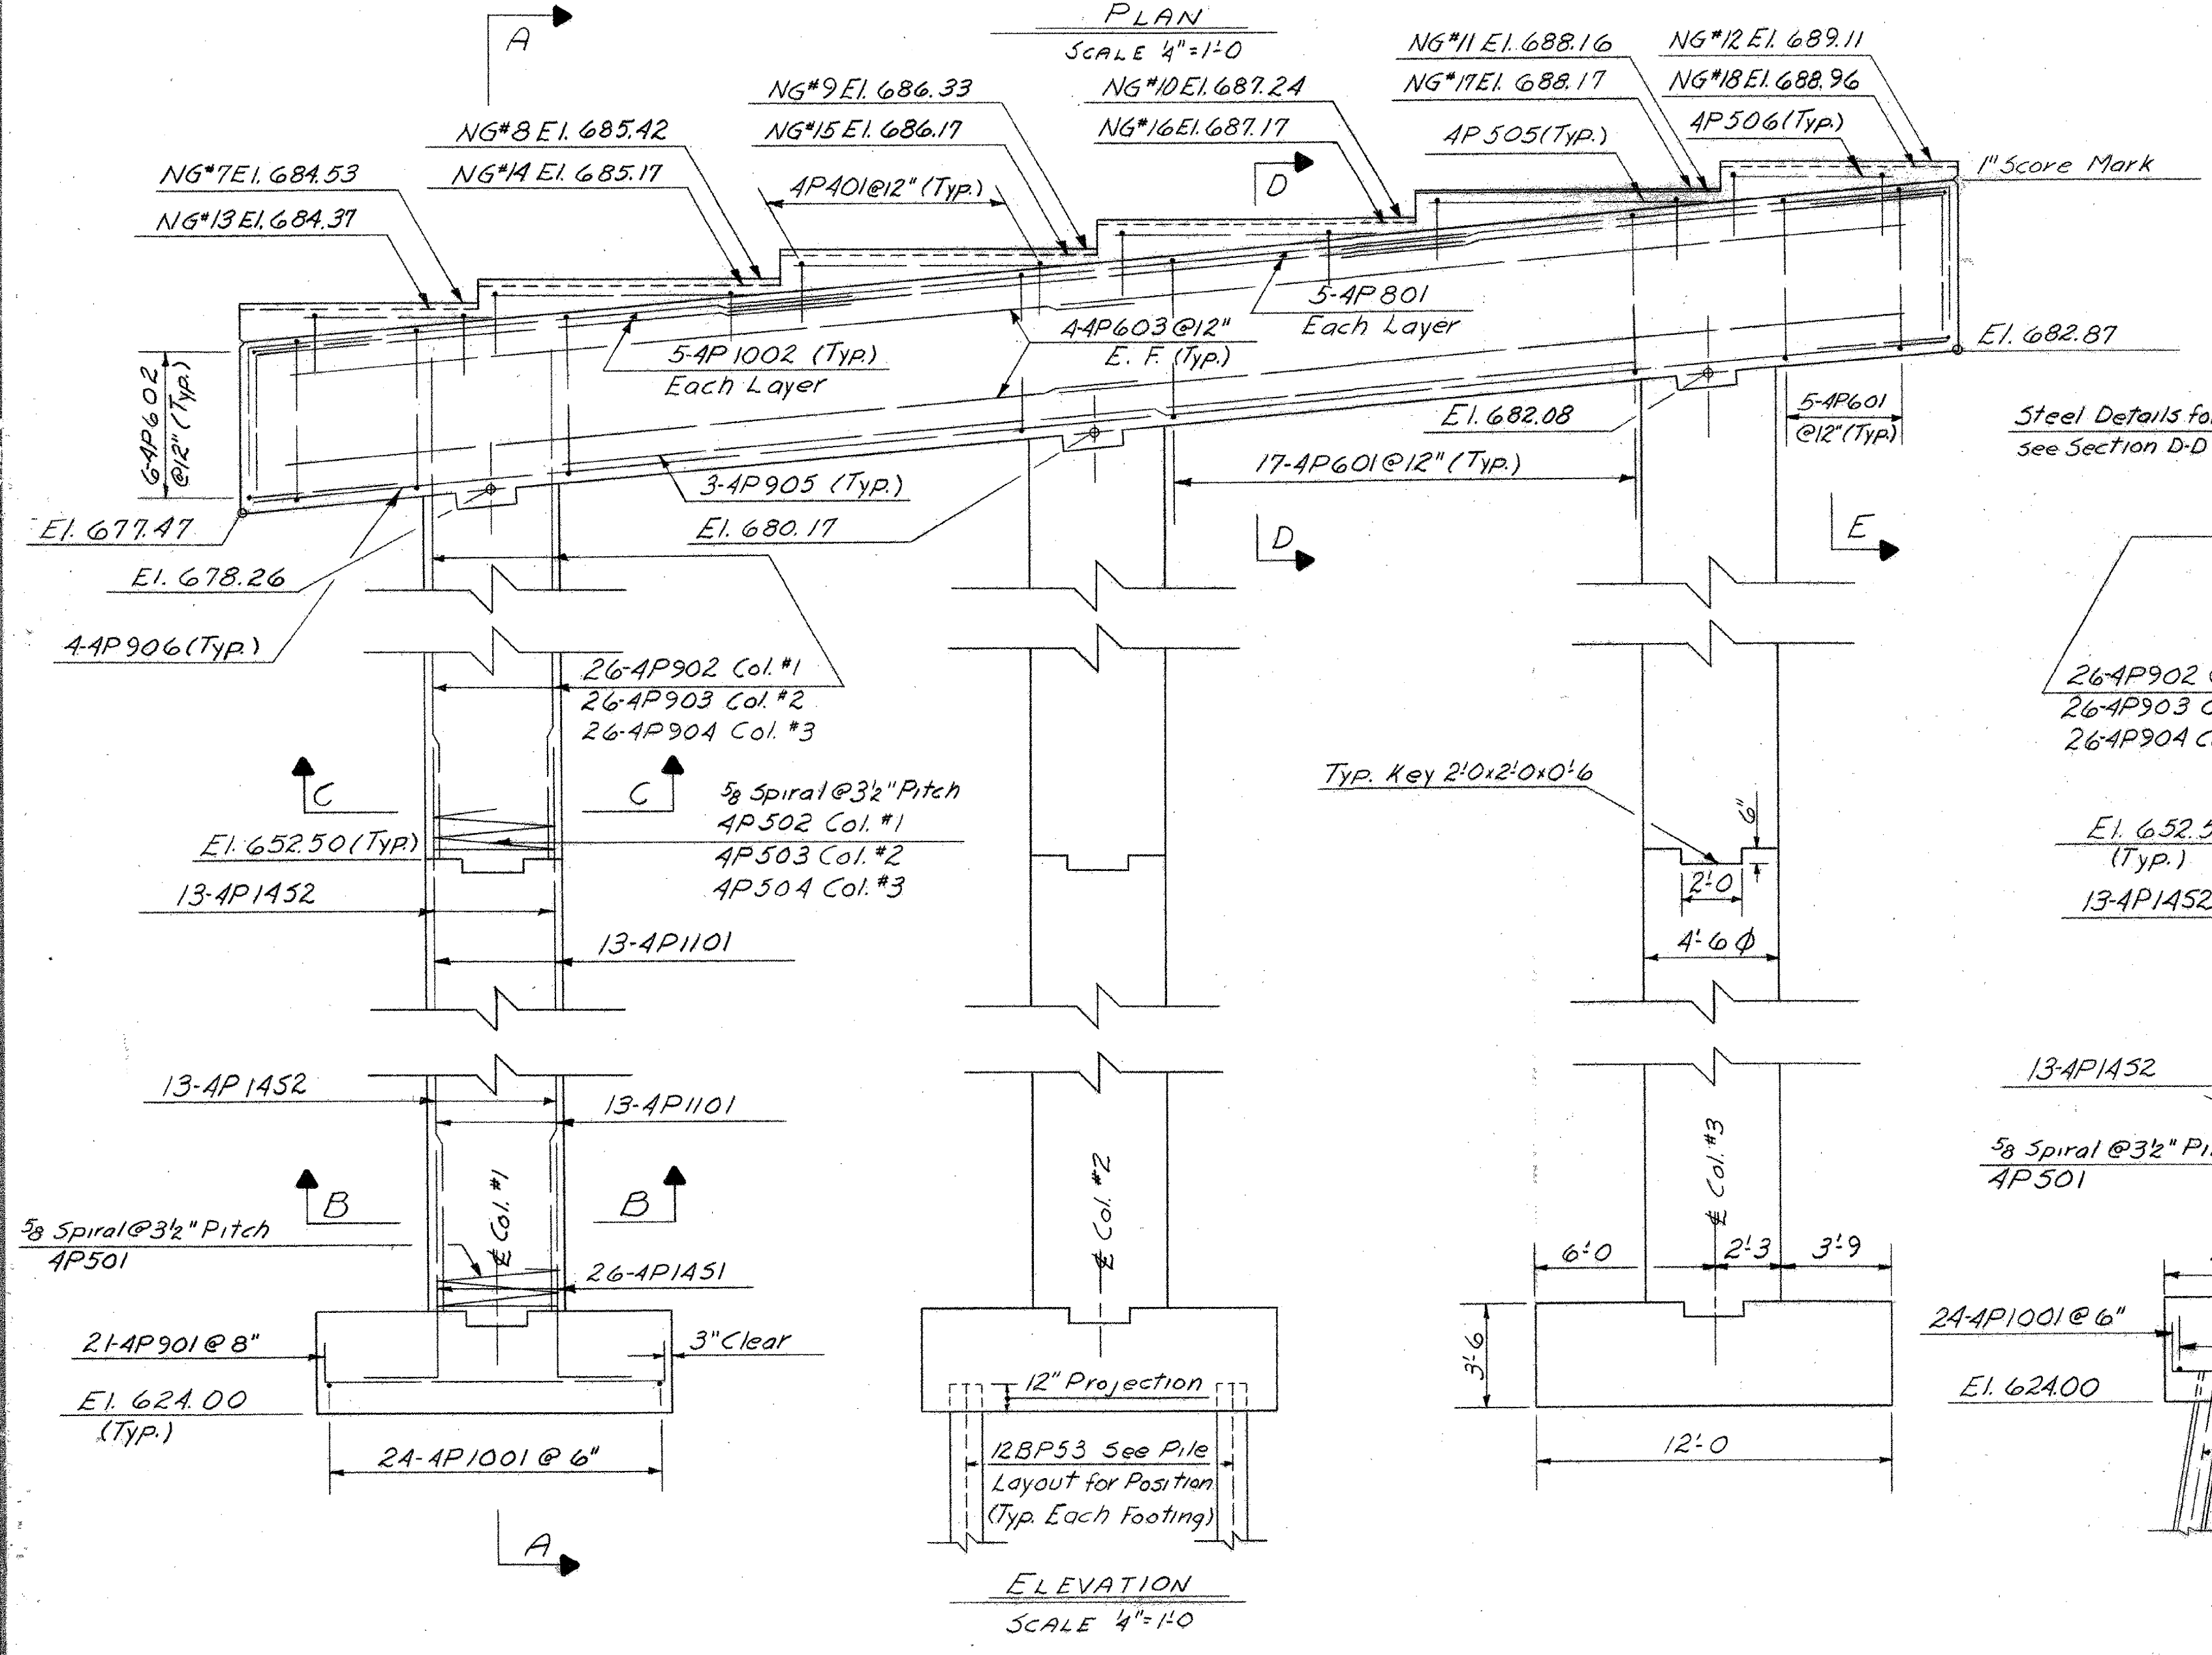

For Pier Notes see BR. 419  
 For Piling Table see BR. 421

THIS SHEET FOR REFERENCE ONLY  
 BERLIN IM 089-1(20)  
 BRIDGES 40 N&S  
 SHEET 99 OF 104

**STATE OF VERMONT**  
 DEPARTMENT OF HIGHWAYS


PROJECT BERLIN-MONTPELIER  
 TOWNS OF BERLIN & MONTPELIER

ROUTE NO. I-89 STA. 193+50.2  
 I-89 OVER VT #12

PIER #4


SCALE AS SHOWN  
 IN CHARGE W. SMITH

DRAWN BY G. G. MAN CHECKED BY W. TRIPP 11-67  
 PROJECT NO. I-89-1(12)  
 SHEET 123 OF 497 BR 422

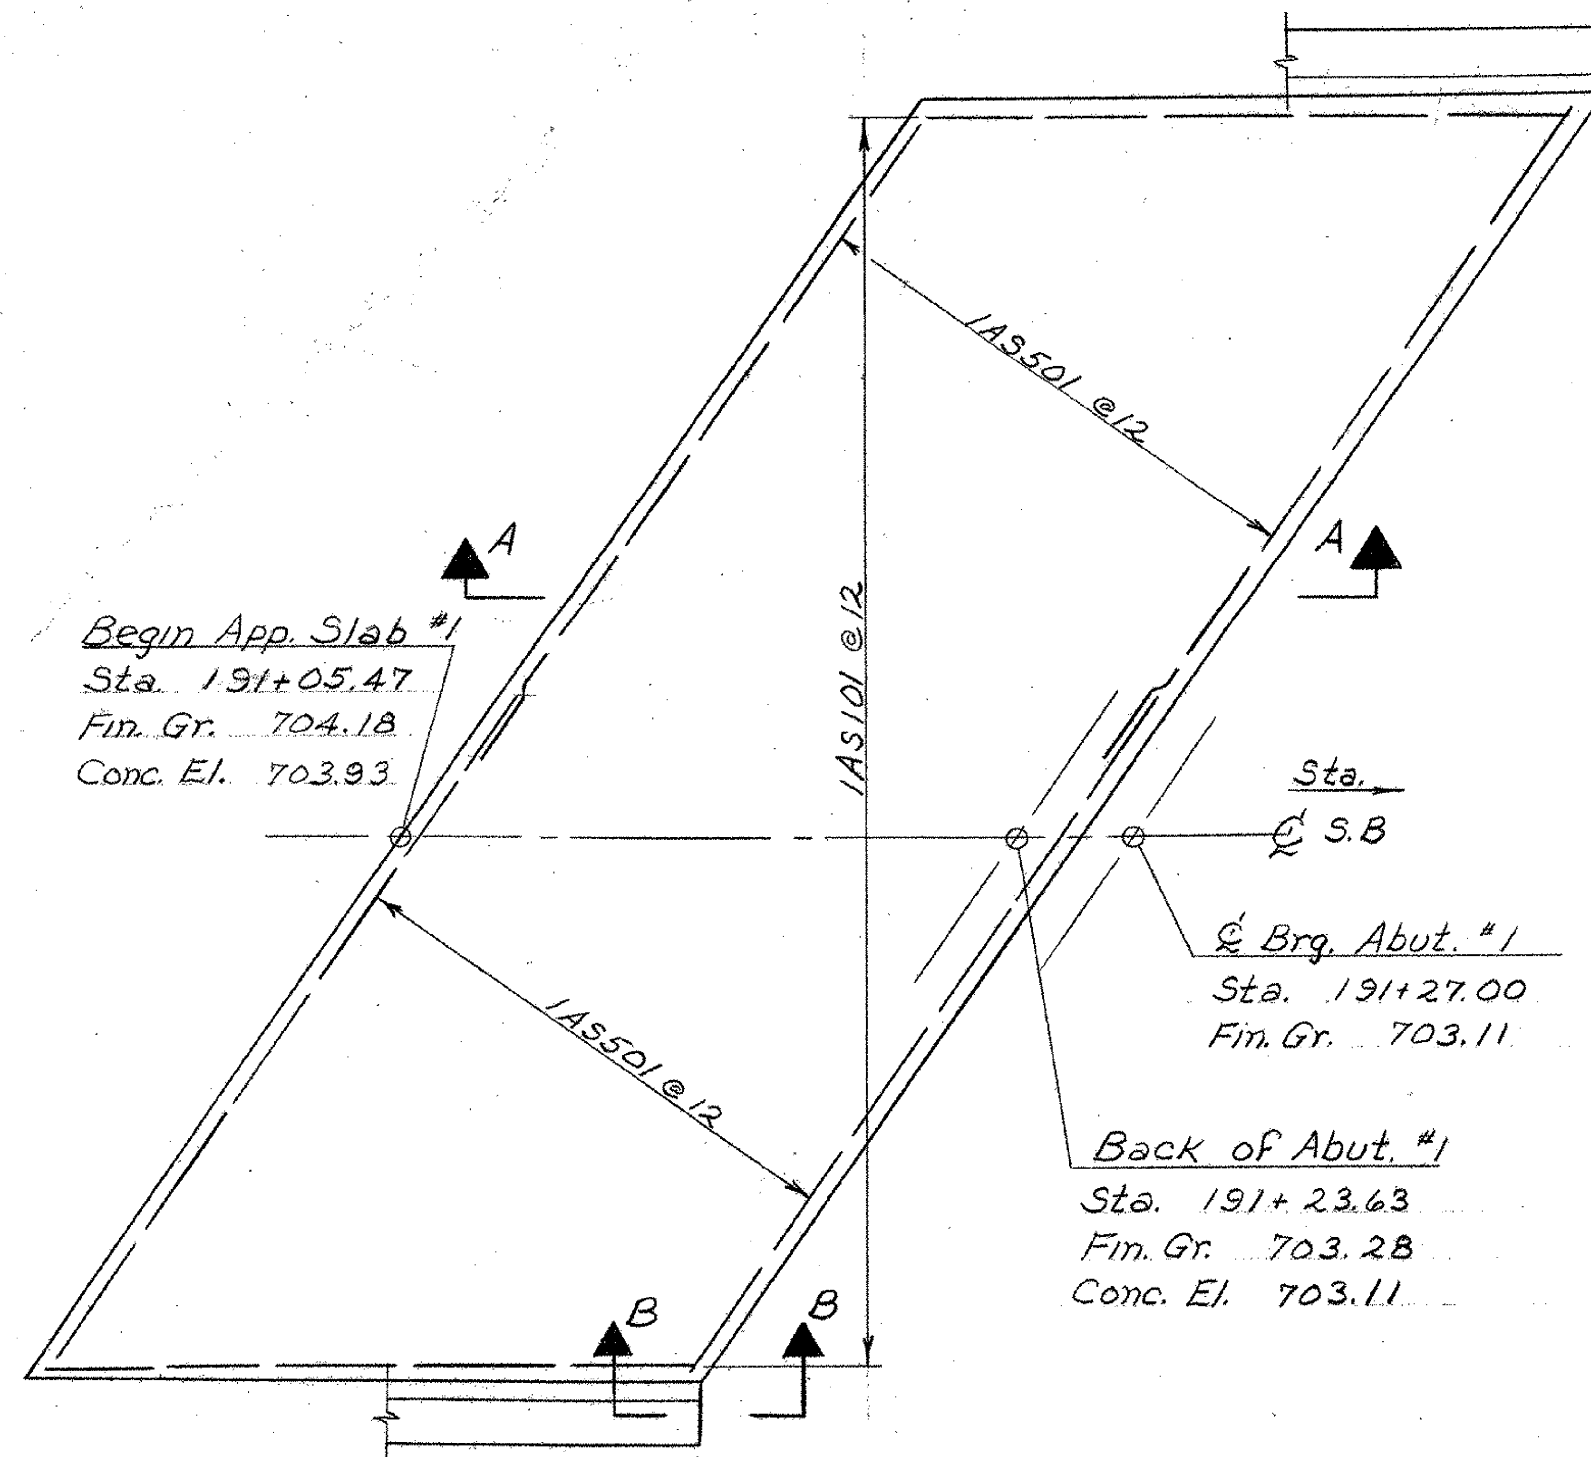


PLAN - APPROACH SLAB #1  
SCALE: 3/16" = 1'-0"


Abut. Wing (Typ.)  
See BR. 416-419 For details

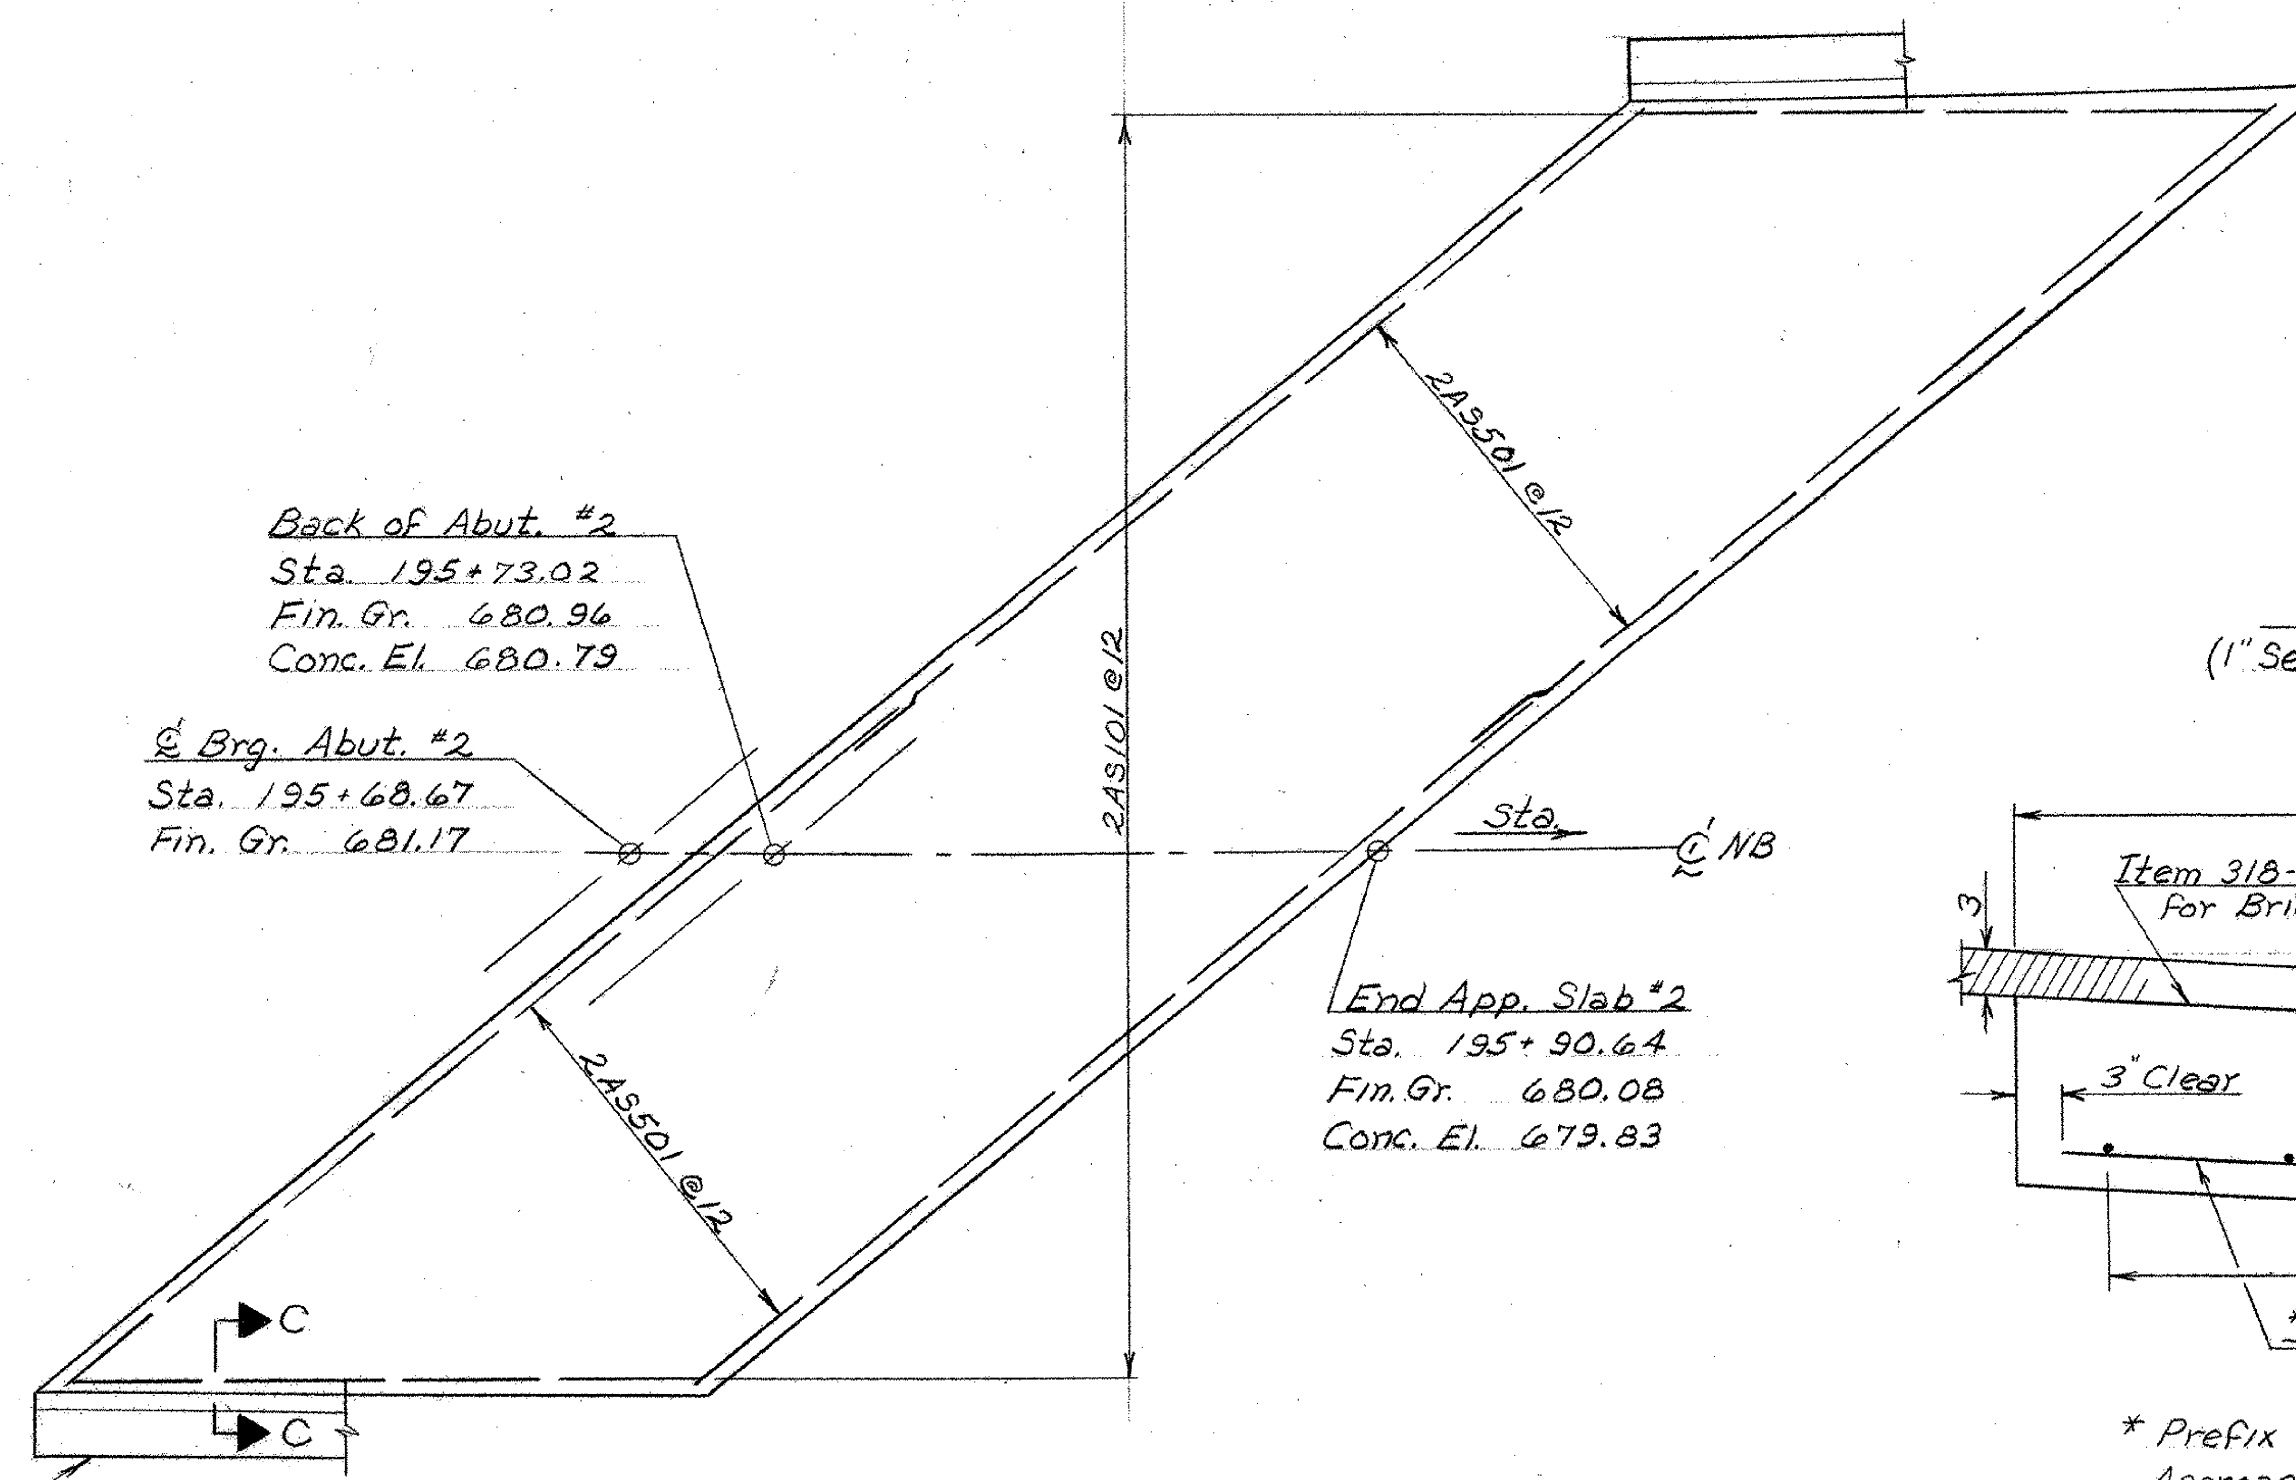


PLAN - APPROACH SLAB #2  
SCALE: 3/16" = 1'-0"

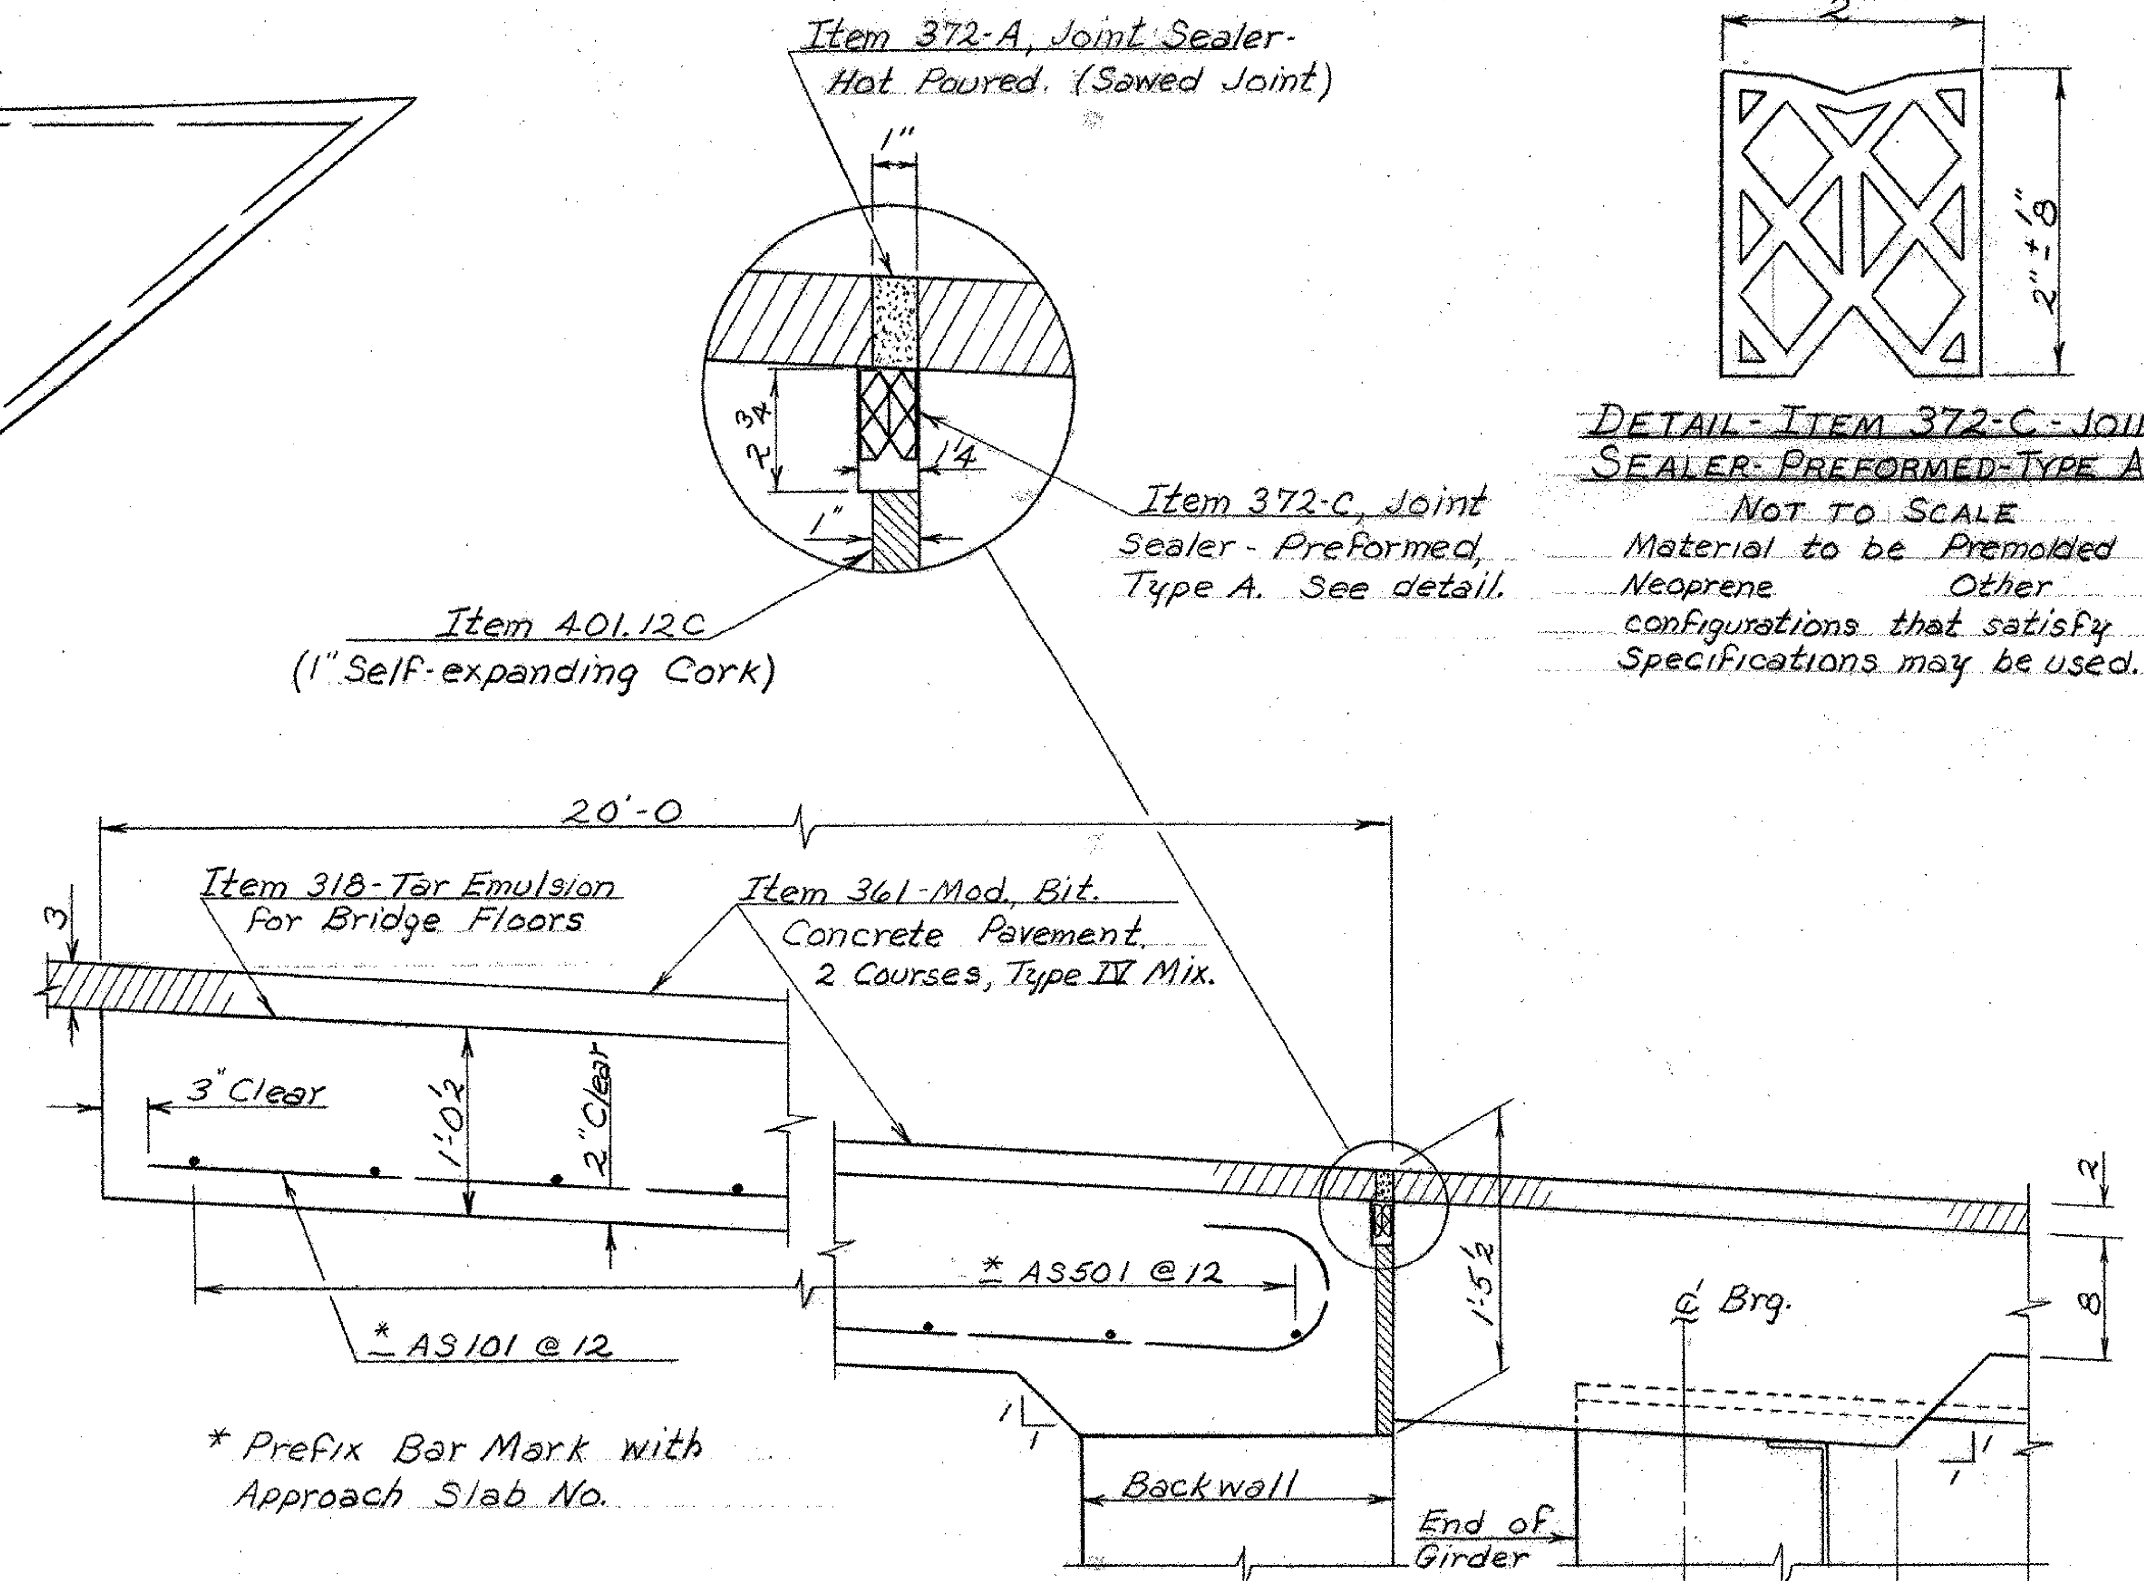


SECTION A-A  
SCALE: 1" = 1'-0"

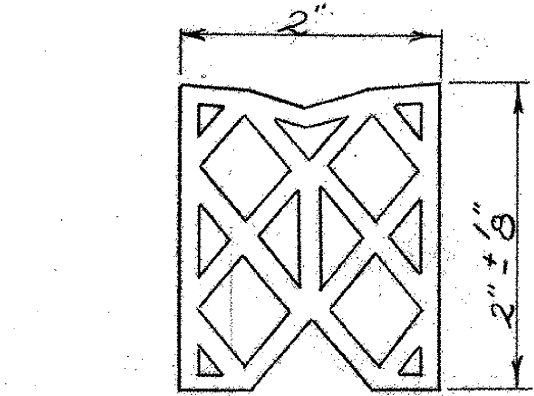


DETAIL - ITEM 372-C - JOINT SEALER - PREFORMED - TYPE A  
NOT TO SCALE  
Material to be Premolded Neoprene Other configurations that satisfy Specifications may be used.

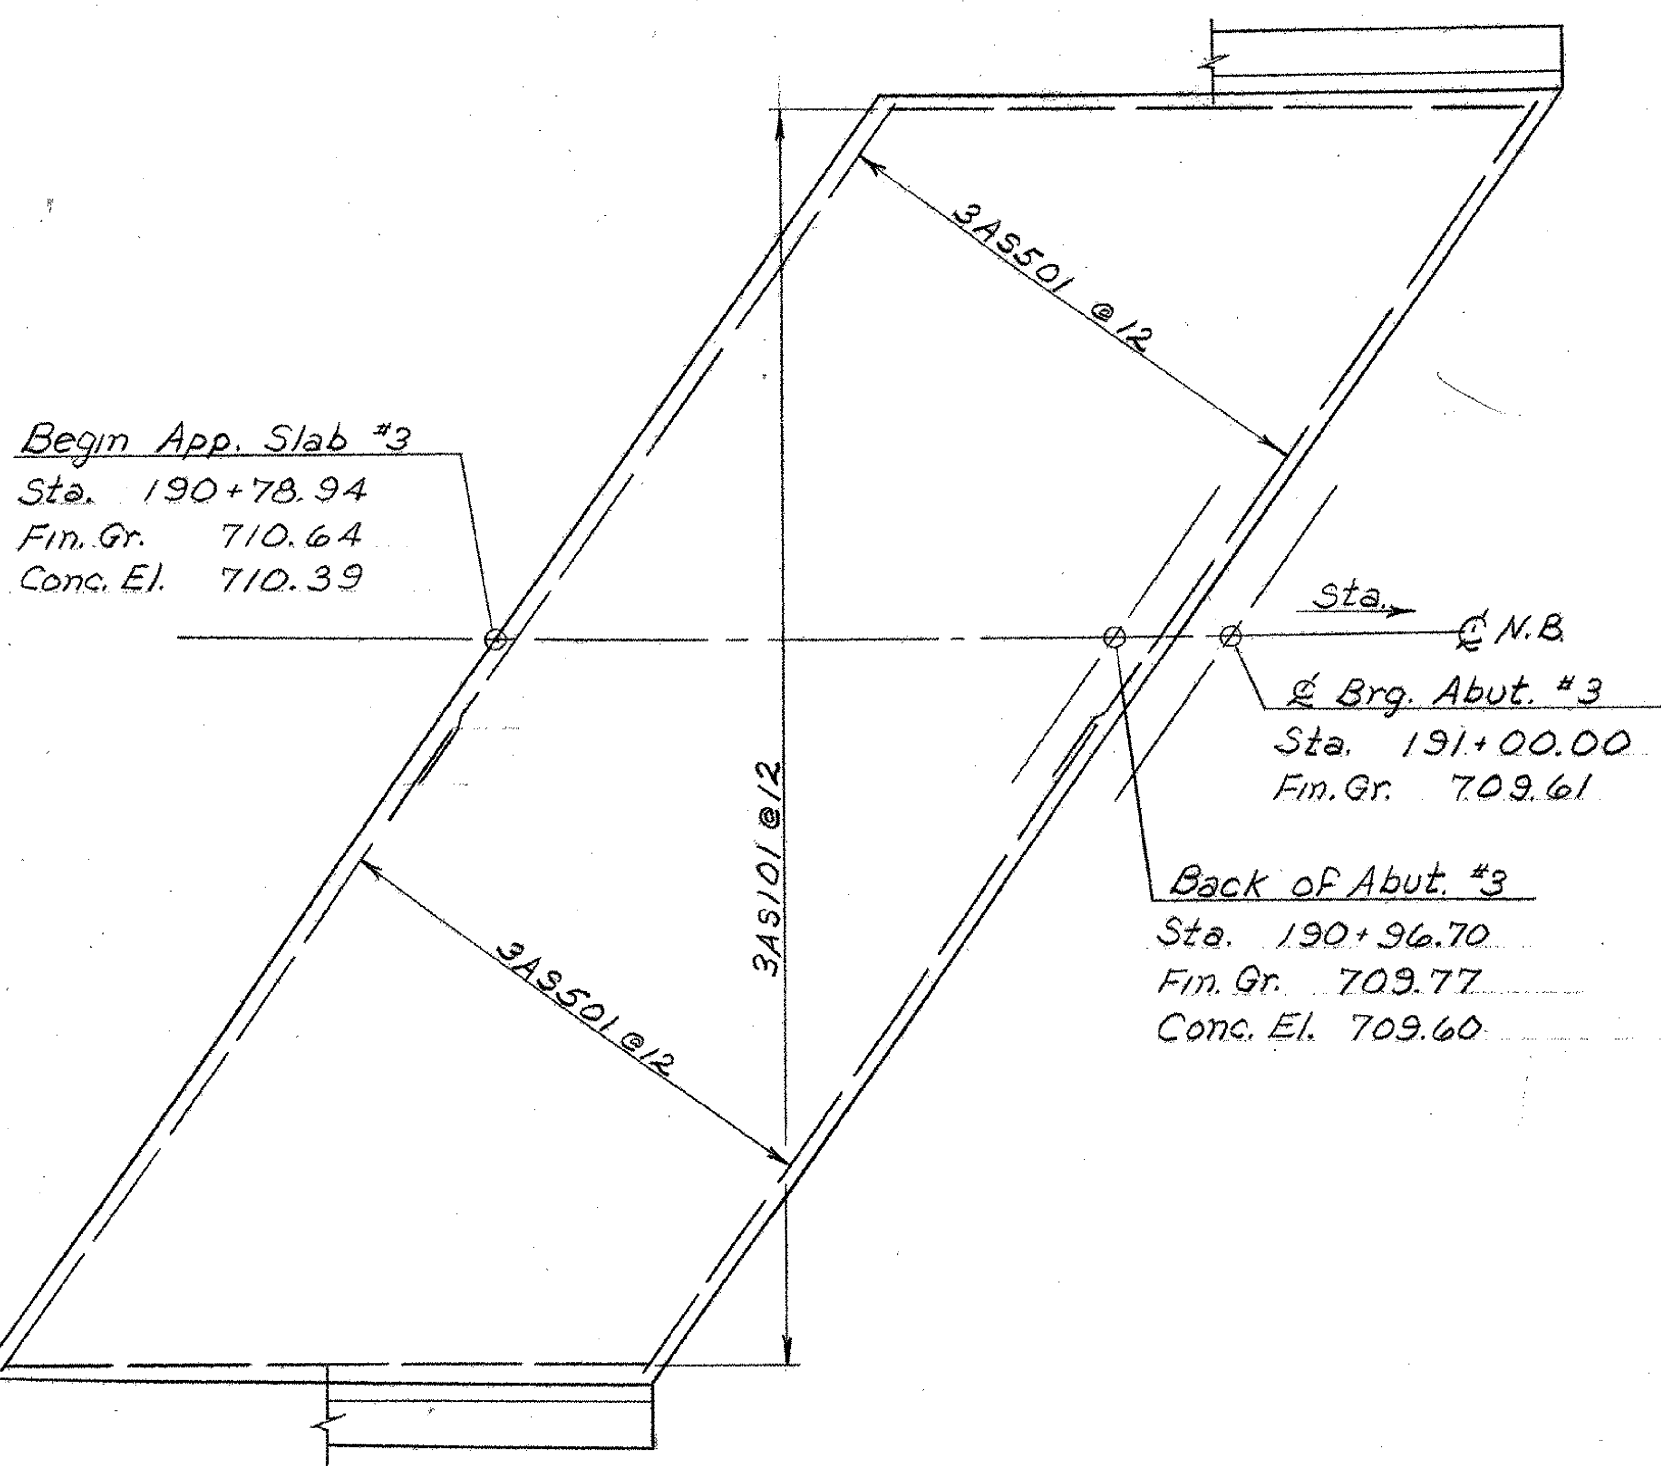


PLAN - APPROACH SLAB #3  
SCALE: 3/16" = 1'-0"

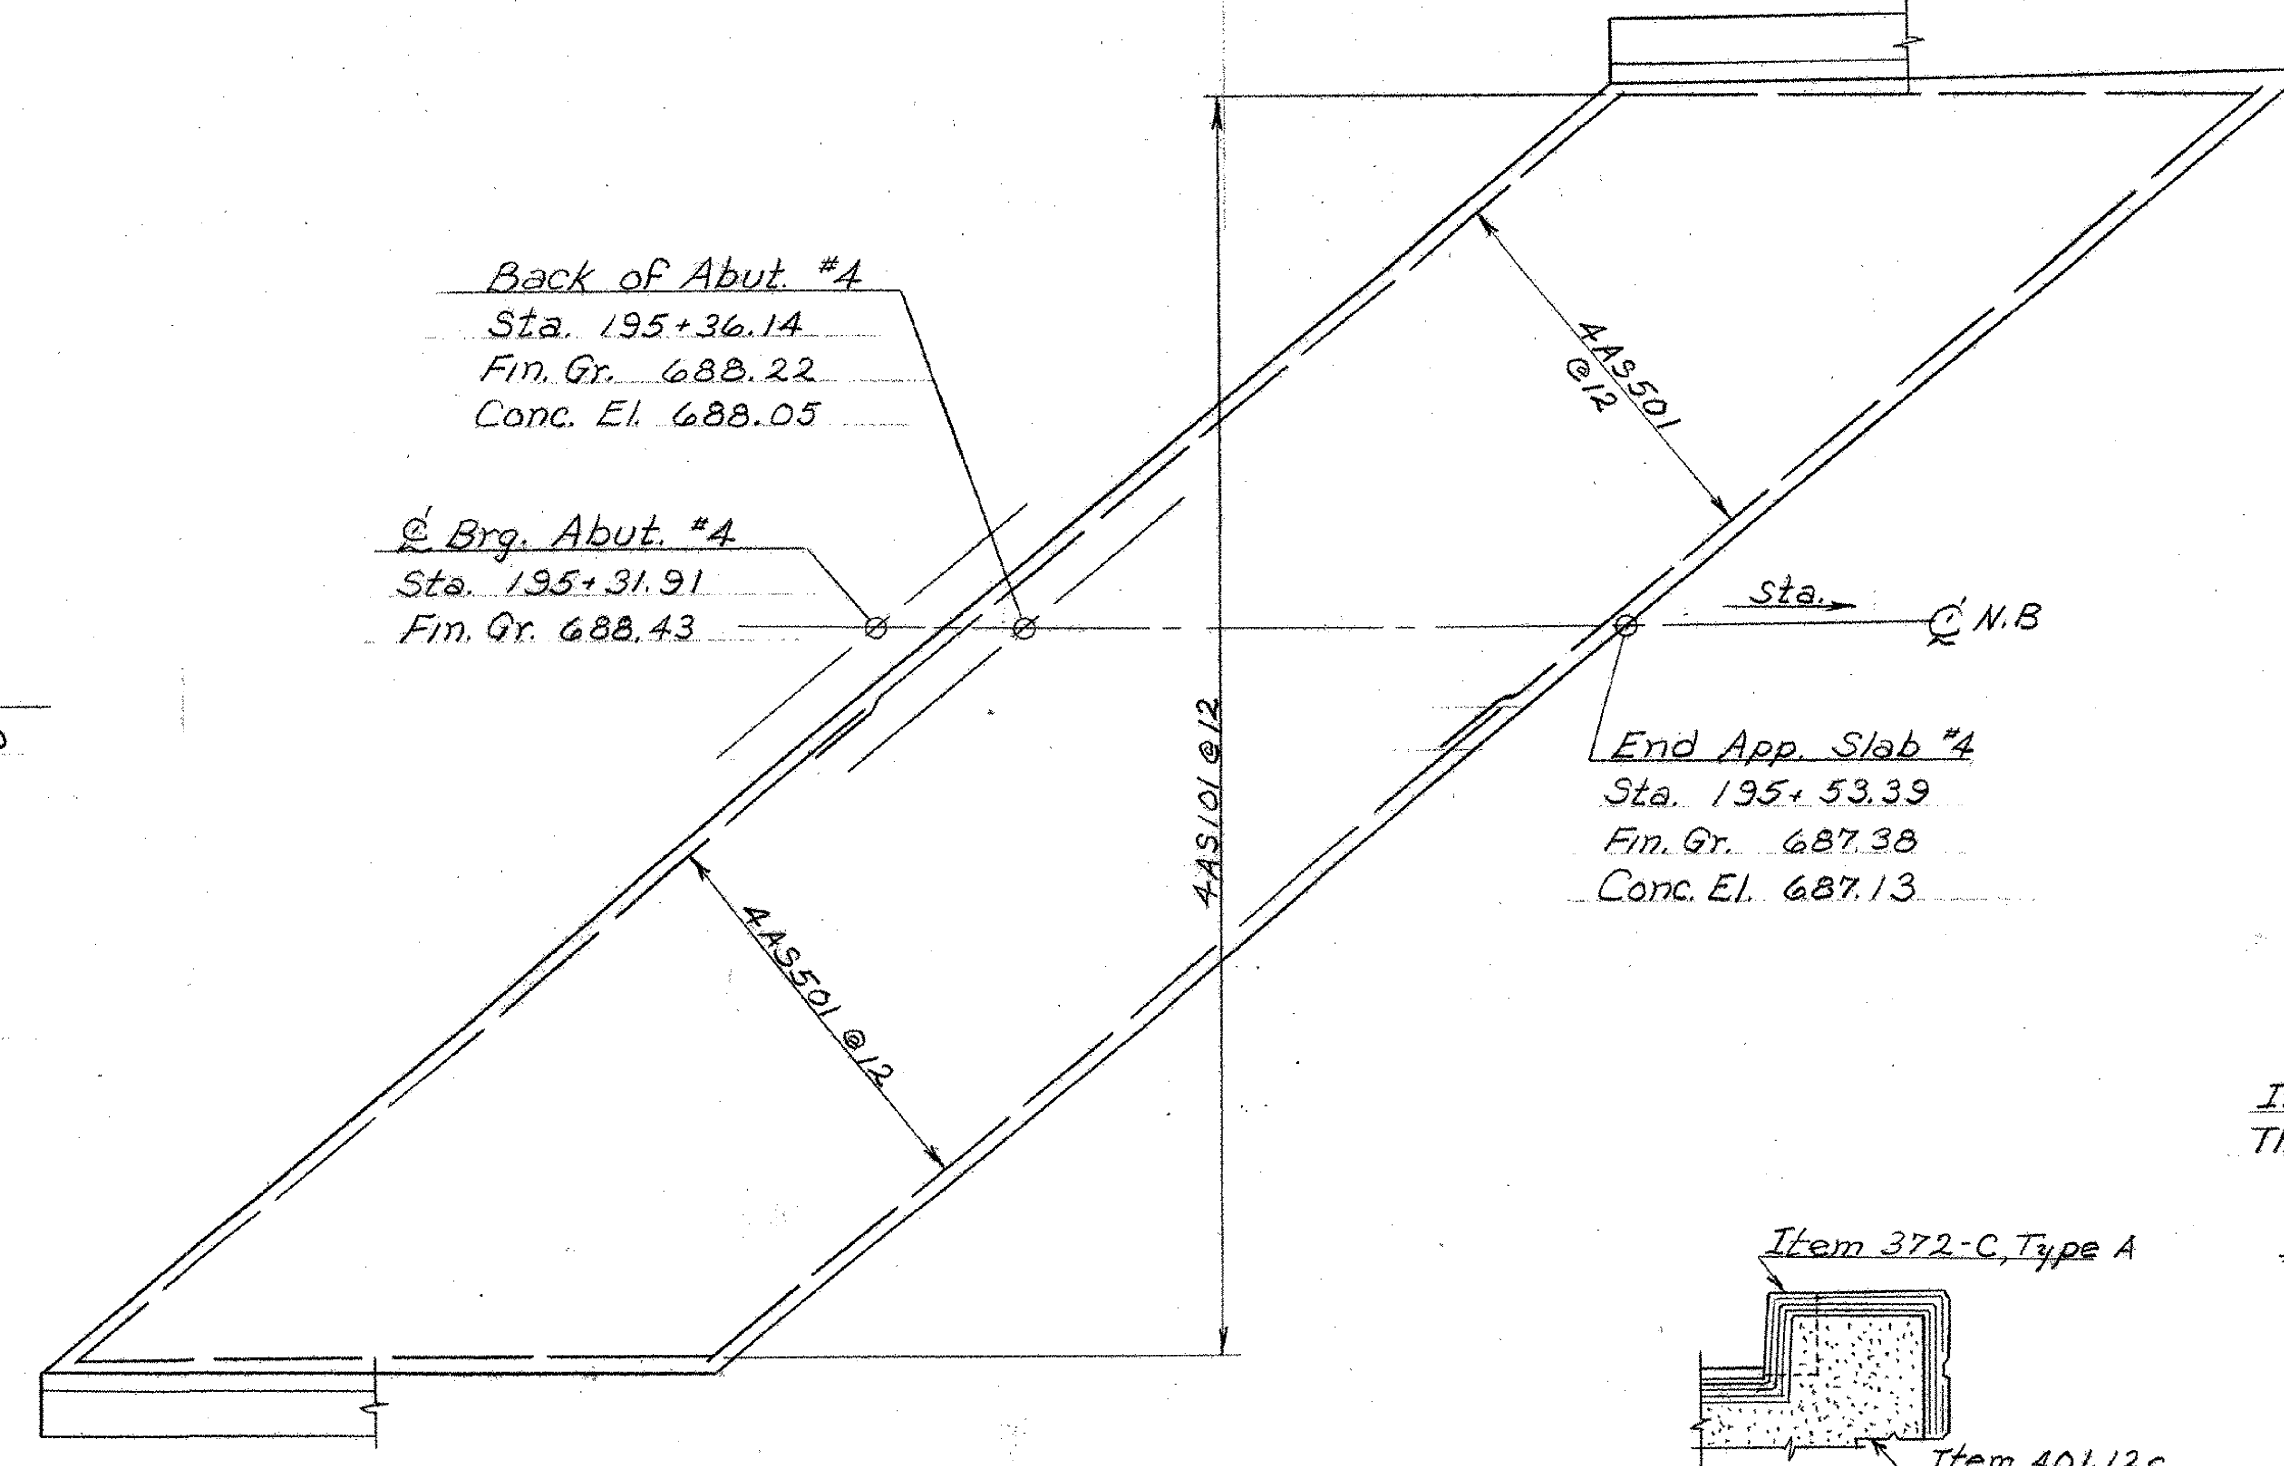

PLAN - APPROACH SLAB #4  
SCALE: 3/16" = 1'-0"

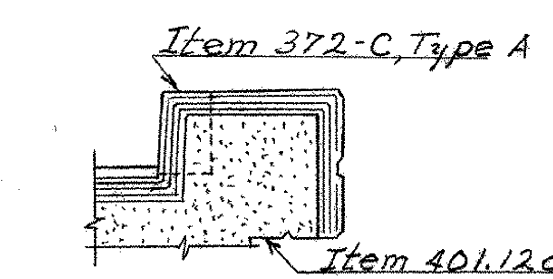


SECTION D-D  
N.T.S.

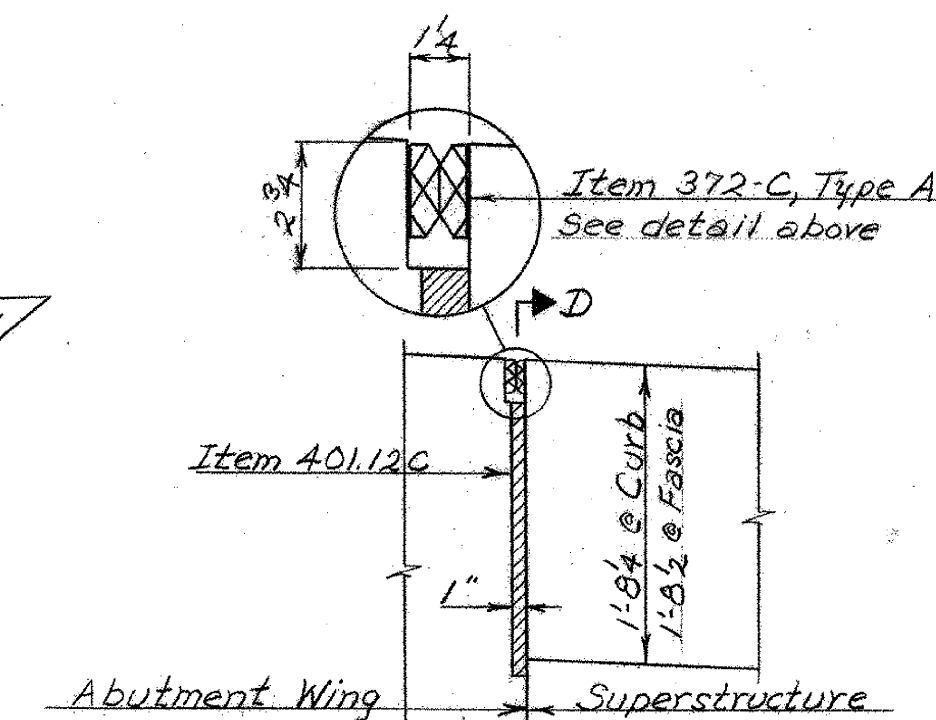

SECTION B-B  
SCALE: 1" = 1'-0"

THIS SHEET FOR REFERENCE ONLY  
BERLIN IM 089-1120  
BRIDGES 40 N&S  
SHEET 100 OF 104

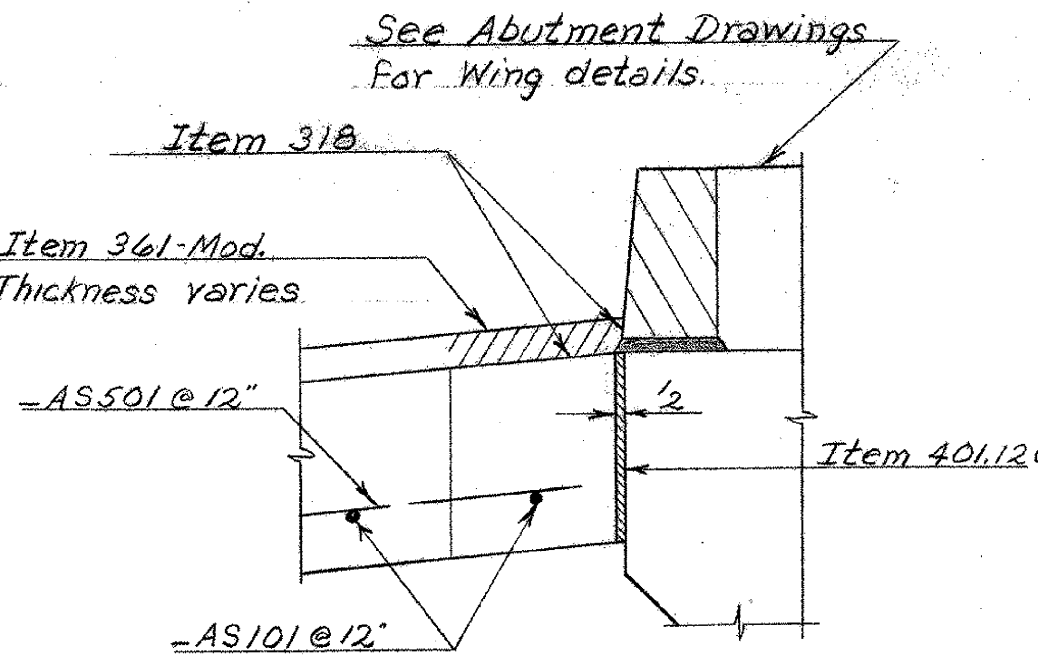

SECTION C-C  
SCALE: 1" = 1'-0"

- NOTES
- See BR. 400 for General Notes.
  - Slope Approach Slabs to provide for 3" of Bit. Conc. at Roadway end and 2" at Bridge end.
  - Premolded Joint Sealer is to be continuous across roadway and curb from fascia to fascia.
  - Cross slopes of Approach Slabs to be same as for Bridge.

STATE OF VERMONT  
DEPARTMENT OF HIGHWAYS

PROJECT BERLIN - MONTPELIER  
TOWNS OF BERLIN & MONTPELIER

ROUTE No. I 89 STA. 193+50±  
I 89 OVER VT. 12

APPROACH SLAB PLANS AND DETAILS  
SCALE AS NOTED

IN CHARGE W. SMITH

DRAWN BY W. TRIPP CHECKED BY R. LADD  
11-67

PROJECT No. I 89-1120 (50)

SHEET 100 OF 104 BR. 423







Item	No. Pieces	Size	Length	Mark	Type	A	B	C	D	E	F	G	H	J	K	R	B
<b>PIER No. 3</b>																	
<b>FOOTING</b>																	
1																	
2	63	9	14-4	3P901	2	1-5	11-6					1-5					
3	72	10	16-8	3P1001	2	1-7	13-6					1-7					
4	*79	145	10-3	3P1451	2	2-1	8-2										
<b>COLUMN</b>																	
7	26	9	29-10	3P902	Str												
8	26	9	31-7	3P903	Str												
9	26	9	33-5	3P904	Str												
10	39	145	30-8	3P1452	Str												
11	*40	11	28-10	3P1101	3	5-8	2-0	21-2					0-2				28-10
<b>Spiral Core Pitch Turns Spacers</b>																	
15	3	5	24-9 1/2	3P501	4-0	3 1/2	88	4									
16	1	5	25-11 1/2	3P502	4-0	3 1/2	92	4									
17	1	5	27-8 1/2	3P503	4-0	3 1/2	98	4									
18	1	5	29-9	3P504	4-0	3 1/2	105	4									
<b>CAP</b>																	
21	20	5	8-6	3P505	Str												
22	10	5	5-6	3P506	Str												
23	16	6	25-9	3P603	Str												
24	10	8	22-4	3P801	Str												
25	6	9	15-0	3P905	Str												
26	8	9	28-5	3P906	Str												
<b>SPAN No. 1</b>																	
82																	
83	415	5	31-6	3SS505	Str												
84	8	5	26-1	3SS506	Str												
85	60	6	31-10	3SS601	Str												
86																	
87	199	4	4-6	3SS401	S3	0-5	1-4	1-0	1-4				0-5				
88	300	5	18-11	3SS501	19	1-10	17-1						0-2	1-10	18-11		
89	300	5	24-11	3SS502	19	1-10	23-1						0-2	1-10	24-11		
90	*301	5	15-2	3SS503	19	1-10	13-4						0-2	1-10	15-2		
91	300	5	28-8	3SS504	19	1-10	26-10						0-2	1-10	28-8		
92																	
<b>SPAN No. 2</b>																	
96	415	5	31-6	3SS505	Str												
97	8	5	28-3	3SS506	Str												
98	60	6	31-10	3SS601	Str												
99																	
100	199	4	4-6	3SS401	S3	0-5	1-4	1-0	1-4				0-5				
101	300	5	18-11	3SS501	19	1-10	17-1						0-2	1-10	18-11		
102	300	5	24-11	3SS502	19	1-10	23-1						0-2	1-10	24-11		
103	300	5	15-2	3SS503	19	1-10	13-4						0-2	1-10	15-2		
104	300	5	28-8	3SS504	19	1-10	26-10						0-2	1-10	28-8		
105																	
<b>SPAN No. 3</b>																	
107	415	5	31-6	3SS505	Str												
108	8	5	31-2	3SS506	Str												
109	60	6	31-10	3SS601	Str												
110																	
111	199	4	4-6	3SS401	S3	0-5	1-4	1-0	1-4				0-5				
112	300	5	18-11	3SS501	19	1-10	17-1						0-2	1-10	18-11		
113	300	5	24-11	3SS502	19	1-10	23-1						0-2	1-10	24-11		
114	300	5	15-2	3SS503	19	1-10	13-4						0-2	1-10	15-2		
115	300	5	28-8	3SS504	19	1-10	26-10						0-2	1-10	28-8		
116																	
<b>SPAN No. 4</b>																	
119	415	5	31-6	3SS505	Str												
120	8	5	26-1	3SS506	Str												
121	60	6	31-10	3SS601	Str												
122																	
123	199	4	4-6	3SS401	S3	0-5	1-4	1-0	1-4				0-5				
124	300	5	18-11	3SS501	19	1-10	17-1						0-2	1-10	18-11		
125	300	5	24-11	3SS502	19	1-10	23-1						0-2	1-10	24-11		
126	*301	5	15-2	3SS503	19	1-10	13-4						0-2	1-10	15-2		
127	300	5	28-8	3SS504	19	1-10	26-10						0-2	1-10	28-8		
128																	
<b>SPAN No. 1</b>																	
129	415	5	31-6	3SS505	Str												
130	8	5	26-1	3SS506	Str												
131	60	6	31-10	3SS601	Str												
132																	
133	199	4	4-6	3SS401	S3	0-5	1-4	1-0	1-4				0-5				
134	300	5	18-11	3SS501	19	1-10	17-1						0-2	1-10	18-11		
135	300	5	24-11	3SS502	19	1-10	23-1						0-2	1-10	24-11		
136	*301	5	15-2	3SS503	19	1-10	13-4						0-2	1-10	15-2		
137	300	5	28-8	3SS504	19	1-10	26-10						0-2	1-10	28-8		
138																	
<b>SPAN No. 2</b>																	
139	415	5	31-6	3SS505	Str												
140	8	5	26-1	3SS506	Str												
141	60	6	31-10	3SS601	Str												
142																	
143	199	4	4-6	3SS401	S3	0-5	1-4	1-0	1-4				0-5				
144	300	5	18-11	3SS501	19	1-10	17-1						0-2	1-10	18-11		
145	300	5	24-11	3SS502	19	1-10	23-1						0-2	1-10	24-11		
146	*301	5	15-2	3SS503	19	1-10	13-4						0-2	1-10	15-2		
147	300	5	28-8	3SS504	19	1-10	26-10						0-2	1-10	28-8		
148																	
<b>SPAN No. 3</b>																	
149	415	5	31-6	3SS505	Str												
150	8	5	26-1	3SS506	Str												
151	60	6	31-10	3SS601	Str												
152																	
153	199	4	4-6	3SS401	S3	0-5	1-4	1-0	1-4				0-5				
154	300	5	18-11	3SS501	19	1-10	17-1						0-2	1-10	18-11		
155	300	5	24-11	3SS502	19	1-10	23-1						0-2	1-10	24-11		
156	*301	5	15-2	3SS503	19	1-10	13-4						0-2	1-10	15-2		
157	300	5	28-8	3SS504	19	1-10	26-10						0-2	1-10	28-8		
158																	
<b>SPAN No. 4</b>																	
159	415	5	31-6	3SS505	Str												
160	8	5	26-1	3SS506	Str												
161	60	6	31-10	3SS601	Str												
162																	
163	199	4	4-6	3SS401	S3	0-5	1-4	1-0	1-4				0-5				
164	300	5	18-11	3SS501	19	1-10	17-1						0-2	1-10	18-11		
165	300	5	24-11	3SS502	19	1-10	23-1						0-2	1-10	24-11		
166	*301	5	15-2	3SS503	19	1-10	13-4						0-2	1-10	15-2		
167	300	5	28-8	3SS504	19	1-10	26-10						0-2	1-10	28-8		
168																	

### SOUTHBOUND SUPERSTRUCTURE

### TYPICAL BAR BENDS

**NOTES**

- All dimensions are out to out of bar.
- 'J' dimensions on 180° hooks to be shown only where necessary to restrict hook size otherwise standard hooks are to be used.
- Where 'J' is not shown, 'J' will be kept equal to or less than  $\frac{C}{10}$  or 'H'. Where 'J' can exceed 'H', it should be shown.
- 'H' dimension on stirrups to be shown where necessary to restrict hooks.
- Where bars are to be bent more accurately than standard bending tolerances bending dimensions which require closer working should have limits indicated.
- Figures in circles show types.
- No allowance for bend curvature is to be made except for standard hook & radii in excess of same.

### NORTHBOUND SUPERSTRUCTURE

Item	No. Pieces	Size	Length	Mark	Type	A	B	C	D	E	F	G	H	J	K	R	B	
<b>APPROACH SLAB No. 1</b>																		
163																		
164	34	5	24-4	3AS501	Str													
165	*39	10	20-7	3AS101	1	1-1	19-6							0-9				
166																		
167																		
168																		
<b>APPROACH SLAB No. 2</b>																		
169																		
170	26	5	31-6	3AS501	Str													



**WELDING PROCEDURE SPECIFICATION**  
Per WPQR # GMAW-01

MATERIAL SPECIFICATION: A36, A572, A709 Grade 36 & 50  
 WELDING PROCESS: GMAW  
 MANUAL OR MACHINE: Semi-Automatic  
 POSITION OF WELDING: Flat & Horizontal  
 FILLER METAL SPECIFICATION: A5.18  
 FILLER METAL CLASSIFICATION: ER70S-6  
 FILLER METAL MANUFACTURER: Hobart  
 SHIELDING GAS: AR 92% CO2 8% DEW POINT: -40°F FLOW RATE: 32-43 CFH  
 SINGLE OR MULTIPLE PASS: Single or Multiple  
 SINGLE OR MULTIPLE ARC: Single ELECTRODE STICKOUT: 3/4 + 1/4"  
 WELDING CURRENT: DC+  
 POLARITY: Reverse  
 WELDING PROGRESSION: Forward (Stringer Bead)  
 ROOT TREATMENT: Free of dirt, rust and oil  
 PREHEAT AND INTERPASS TEMP. ≤ 3/8" = 50°F ≤ 1/2" = 70°F ≤ 2/2" = 150°F (Minimum)  
 POSTHEAT TREATMENT: N/A

**WELDING PROCEDURE**

Weld Size	Electrode Size	Welding Current		Travel Speed "/Min	Joint Detail TC-P4-GF
		Amps	Volts		
All	.045	247 - 302	27 - 31	9 - 11	<p>Dimensions per approved drawings</p>
All	1/16	247 - 302	27 - 31	9 - 11	

THIS PROCEDURE MAY VARY DUE TO THE FABRICATION SEQUENCE, FIT-UP, PASS SIZE, ETC., WITHIN THE LIMITATIONS OF VARIABLES GIVEN IN TABLE 4.3 OF AWS D1.5-2002 BRIDGE WELDING CODE.

PROCEDURE NO: GM - TC-P4-GF MANUFACTURER: Niagara Bridge and Rail

REVISION NO: 0 AUTHORIZED BY: Thomas F. Wright

VT RANS  
 RECEIVED  
 JWC  
 5/12/08




MAR 27 2008

Parts and Service to meet your specific project needs

**WELD PROCEDURE SPECIFICATION**  
Per WPQR # GMAW-01

MATERIAL SPECIFICATION: A709, A36, A572 Grade 36 & 50  
 WELDING PROCESS: GMAW  
 MANUAL OR MACHINE: Semi-Automatic  
 POSITION OF WELDING: Horizontal  
 FILLER METAL SPECIFICATION: A5.18  
 FILLER METAL CLASSIFICATION: ER70S-6  
 FILLER METAL MANUFACTURER: Hobart  
 SHIELDING GAS: AR 92% CO2 8% DEW POINT: -60°F FLOW RATE: 35 CFH  
 SINGLE OR MULTIPLE PASS: Single  
 SINGLE OR MULTIPLE ARC: Single ELECTRODE STICKOUT: 3/4 max  
 WELDING CURRENT: DC+  
 POLARITY: Reverse  
 WELDING PROGRESSION: Forward (Stringer Bend)  
 ROOT TREATMENT: Free of dirt, rust and oil  
 PREHEAT AND INTERPASS TEMP. ≤ 3/4" = 50°F ≤ 1 1/2" = 70°F ≤ 2 1/2" = 150°F (Minimums)  
 POSTHEAT TREATMENT: N/A

**WELDING PROCEDURE**

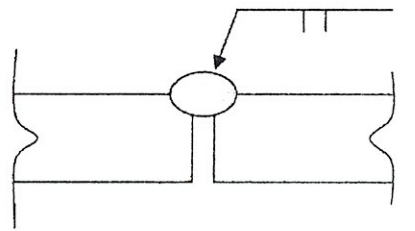Weld Size	Electrode Size	Welding Current		Travel Speed "/>Min	Joint Detail Square groove seal weld
		Amps	Volts		
All	1/16	247 - 302	27 - 31	9 - 11	 <p>Material thickness and shape per approved drawings Seal weld on one side only</p>

THIS PROCEDURE MAY VARY DUE TO THE FABRICATION SEQUENCE, FIT-UP, PASS SIZE, ETC., WITHIN THE LIMITATIONS OF VARIABLES GIVEN IN TABLE 5.3 OF AWS D1.5-2002 BRIDGE WELDING CODE.

PROCEDURE NO: Seal Weld MANUFACTURER: Niagara Bridge and Rail

REVISION NO: 0 AUTHORIZED BY: *Thomas F. Wright*

RECEIVED BY: *JWC*

DATE: MAR 27 2008

BY: *JWC*


DATE: 5/12/08



**WELD PROCEDURE SPECIFICATION**  
Per WPQR # GMAW-01

MATERIAL SPECIFICATION: A709, A36, A572 Grade 36 & 50  
 WELDING PROCESS: GMAW  
 MANUAL OR MACHINE: Semi-Automatic  
 POSITION OF WELDING: Horizontal  
 FILLER METAL SPECIFICATION: A5.18  
 FILLER METAL CLASSIFICATION: ER70S-6  
 FILLER METAL MANUFACTURER: Hobart  
 SHIELDING GAS: AR 92% CO2 8% DEW POINT: -60°F FLOW RATE: 35 CFH  
 SINGLE OR MULTIPLE PASS: Single  
 SINGLE OR MULTIPLE ARC: Single ELECTRODE STICKOUT: 3/4  
 WELDING CURRENT: DC+  
 POLARITY: Reverse  
 WELDING PROGRESSION: Forward (Stringer Bead)  
 ROOT TREATMENT: N/A  
 PREHEAT AND INTERPASS TEMP. ≤ 3/4" = 50°F ≤ 1 1/2" = 70°F ≤ 2 1/2" = 150°F (Minimums)  
 POSTHEAT TREATMENT: N/A

**WELDING PROCEDURE**

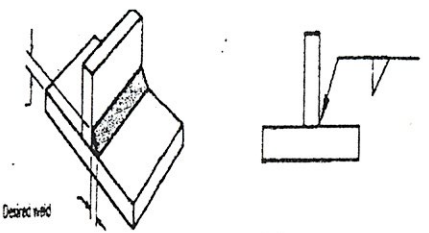Weld Size	Electrode Size	Welding Current		Travel Speed "/Min	Joint Detail Fillet
		Amps	Volts		
All	1/16	247-302	27-31	9-11	

THIS PROCEDURE MAY VARY DUE TO THE FABRICATION SEQUENCE, FIT-UP, PASS SIZE, ETC., WITHIN THE LIMITATIONS OF VARIABLES GIVEN IN TABLE 5.3 OF AWS D1.5-2002 BRIDGE WELDING CODE.

PROCEDURE NO: GMAW 01 Fillet MANUFACTURER: Niagara Bridge and Rail

REVISION NO: 0 AUTHORIZED BY: Thomas F. Wright


VTTRANS  
RECEIVED  
JWC  
BY: JWC  
DATE: 5/12/08



**WELD PROCEDURE SPECIFICATION**


MATERIAL SPECIFICATION: ASTM A108 anchor stud to a horizontal (planar) Carbon Steel surface  
 WELDING PROCESS: Automatic timed stud weld  
 MANUAL OR MACHINE: Machine (hand held stud gun)  
 POSITION OF WELDING: Down hand (Flat)  
 STUD METAL SPECIFICATION: ASTM A-108  
 STUD METAL CLASSIFICATION: Type A or B  
 STUD MANUFACTURE: Tri-Weld  
 SHIELDING GAS: N/A DEW POINT: \_\_\_\_\_ FLOW RATE: \_\_\_\_\_  
 FERRULE OR FLUX DESCRIPTION: Ceramic part #F 009-694  
 SINGLE OR MULTIPLE ARC: Single ELECTRODE STICKOUT: N/A  
 WELDING CURRENT: DC  
 POLARITY: Straight  
 ROOT TREATMENT: Clean of oil, dirt, rust, rust pits, moisture and scale  
 PREHEAT AND INTERPASS TEMP. 40F min  
 POSTHEAT TREATMENT: None  
 WELDING MACHINE: Pro-Weld model ARC 1800  
 STUD WELDING GUN: Nelson model # 751-347-000 1800amp

**WELDING PROCEDURE**

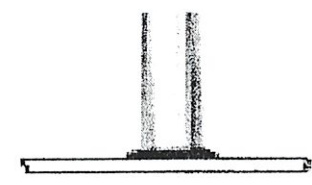Stud Diameter	Weld Current (Amps)	Lift & Plunge		Weld Time (sec.)	Joint Detail (Stud weld)
		Lift	Plunge		
1/2"	1600 ± 5%	.093"	.187"	.700 ± 5%	


THIS PROCEDURE MAY VARY DUE TO THE FABRICATION SEQUENCE, FIT-UP, ETC., WITHIN THE LIMITATIONS OF VARIABLES GIVEN IN SECTION 7 OF AWS D1.5 BRIDGE WELDING CODE.  
 THIS PROCEDURE IS CONSIDERED PREQUALIFIED IN ACCORDANCE WITH AWS D1.5 SECTION 7.6.1 AND IS PERFORMED WITHIN THE STUD MANUFACTURES RECOMMENDATIONS.

PROCEDURE NO: Carbon Stud weld MANUFACTURER: Niagara Bridge and Rail  
 REVISION NO: 0 AUTHORIZED BY: [Signature]  
 BY: [Signature] DATE: 5/17/08

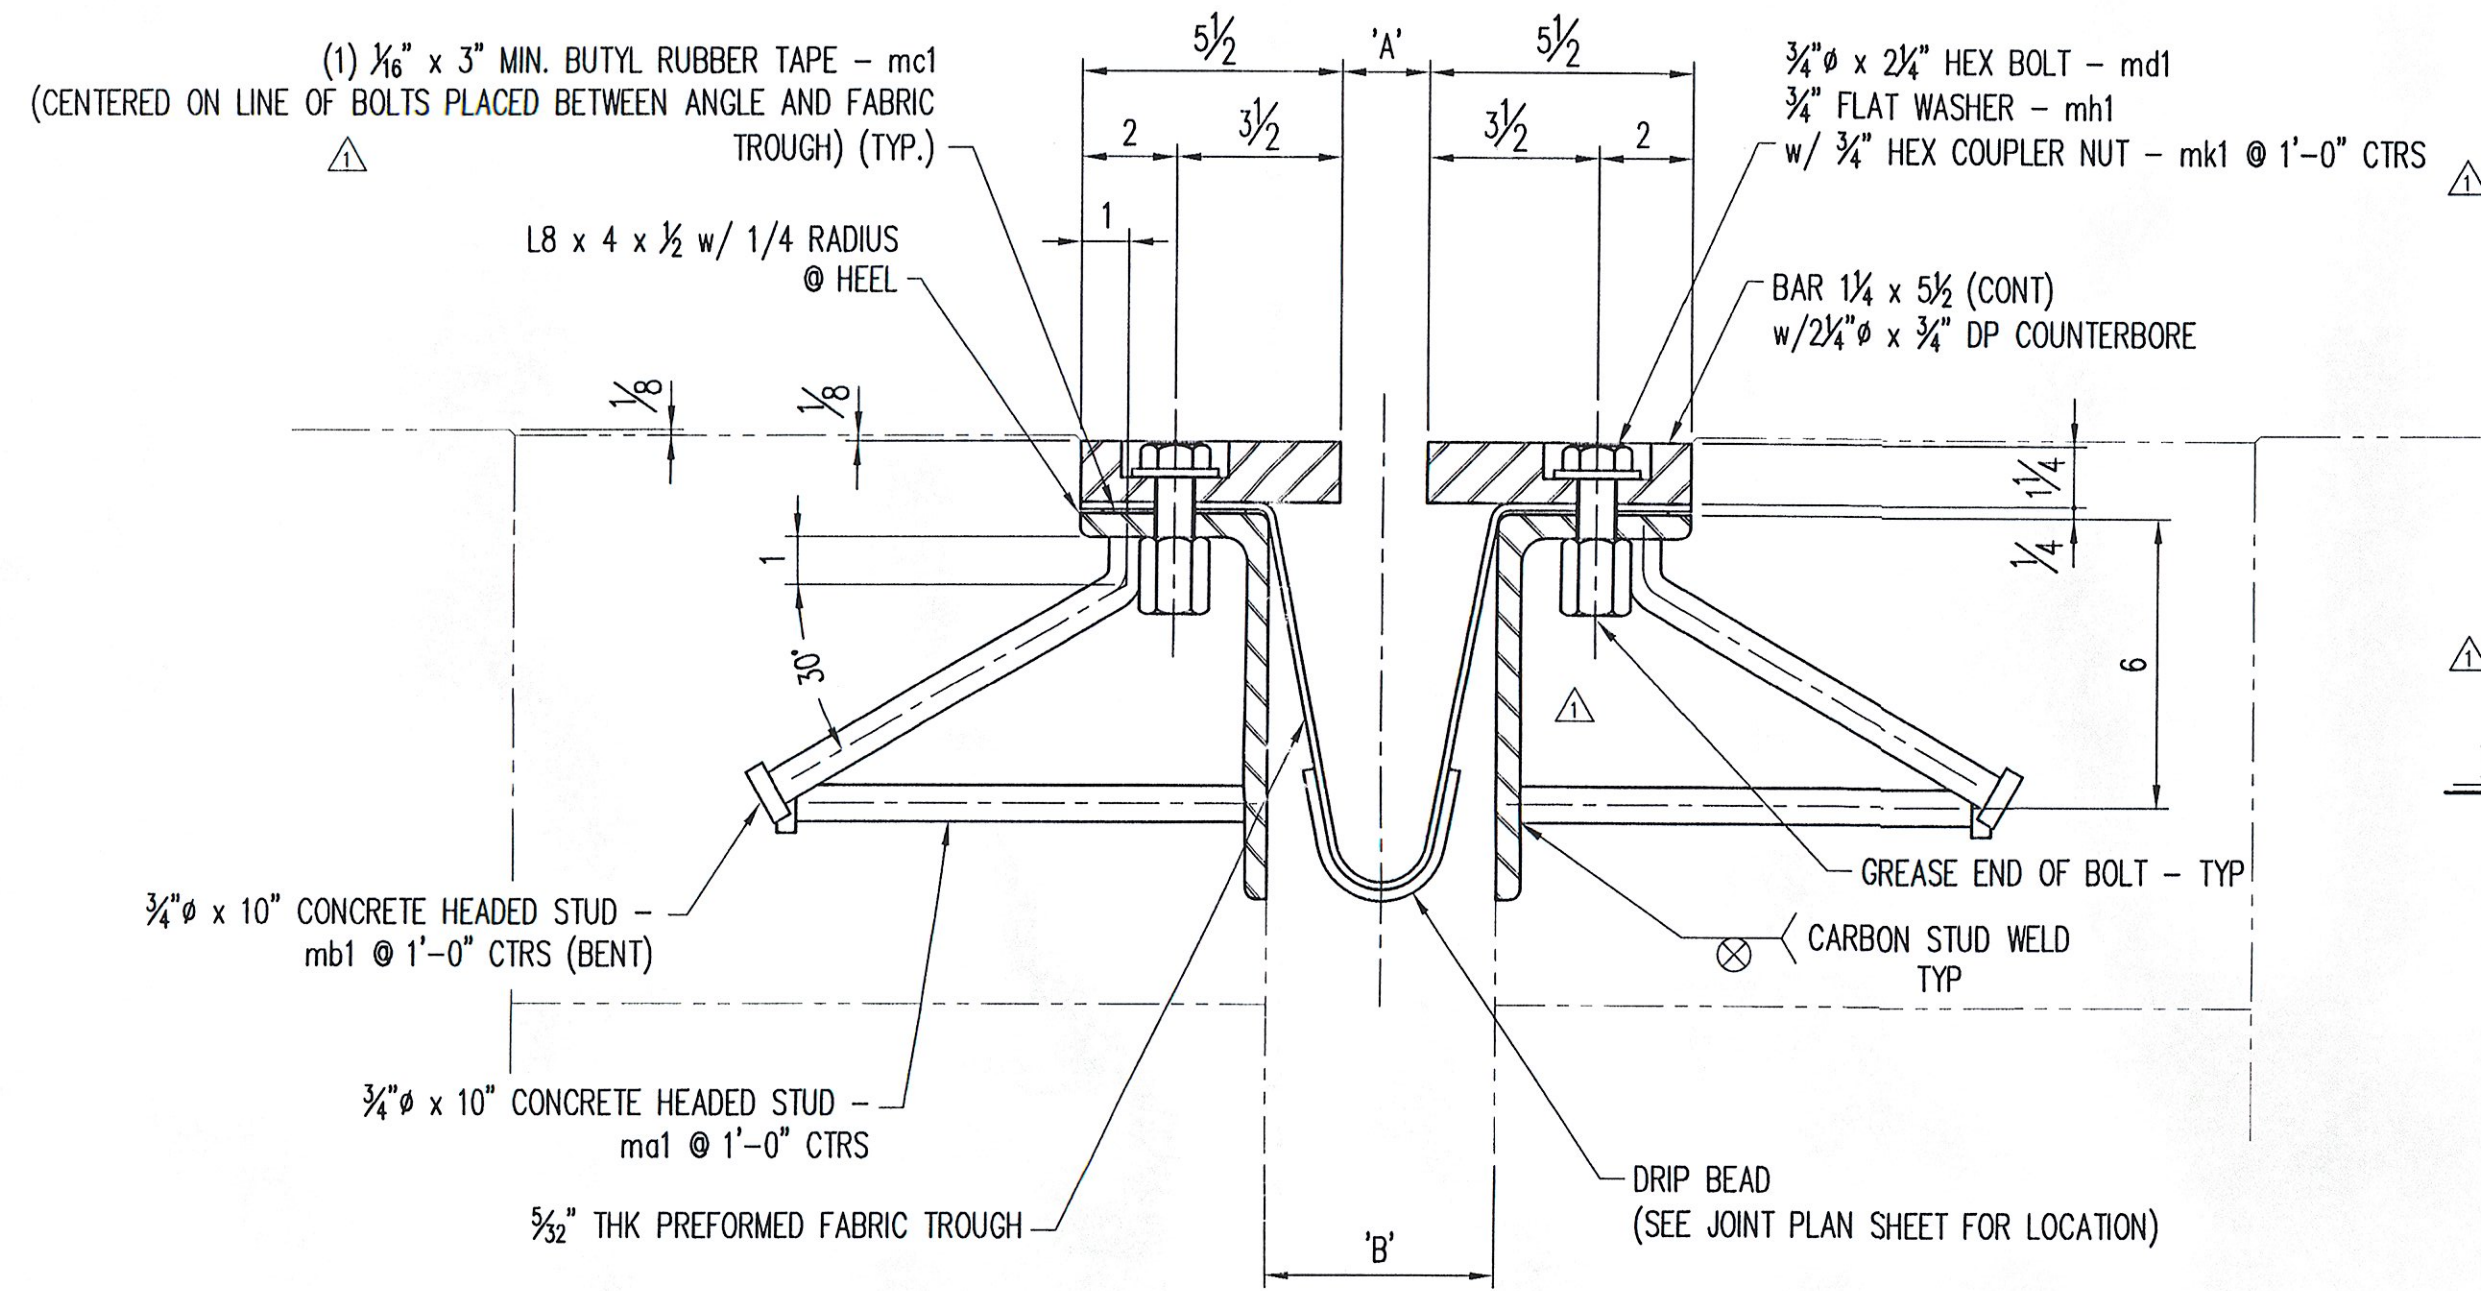


**STANDARD SECTION VIEW: A-A**


REFER TO JOINT PLAN SHEET FOR DIMENSIONS 'A' and/or 'B'

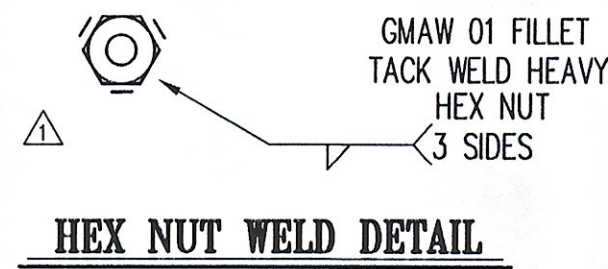


**HEX NUT WELD DETAIL**

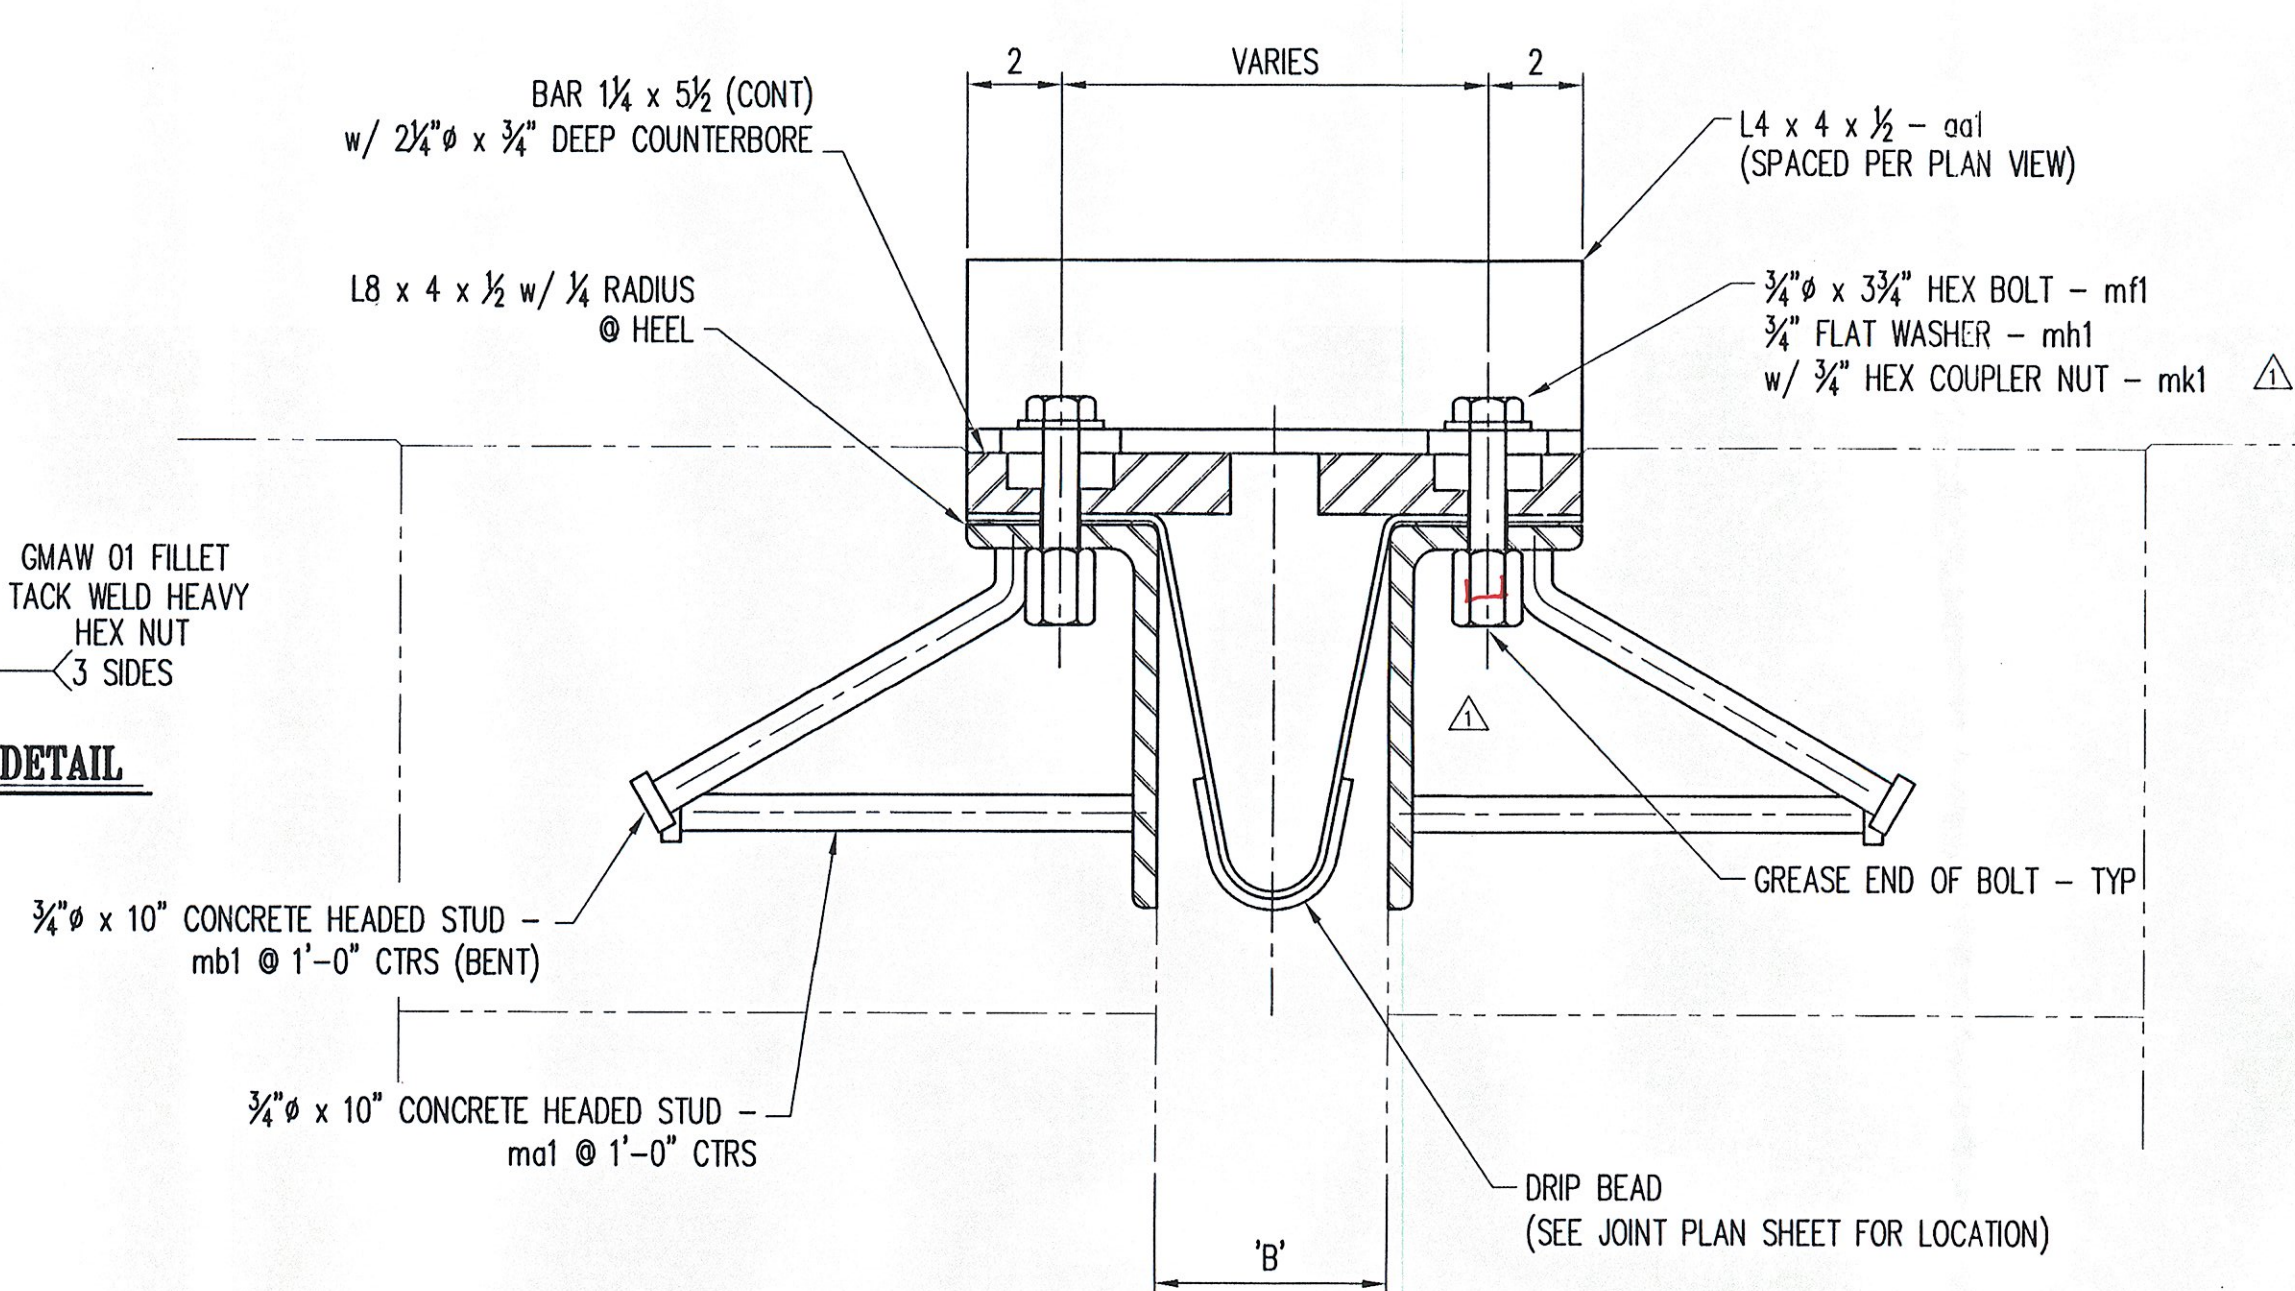


**SHIPPING ANGLE SECTION: C-C**

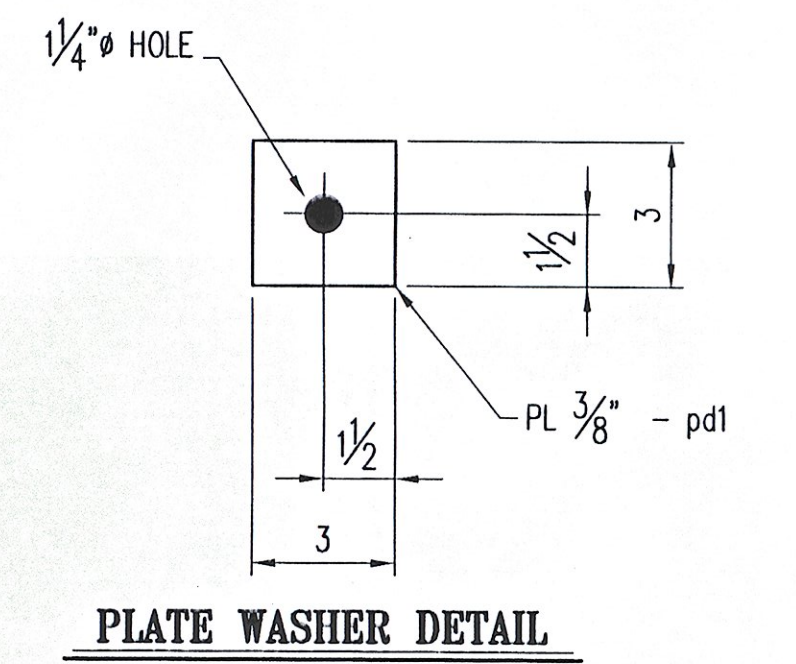


**PLATE WASHER DETAIL**

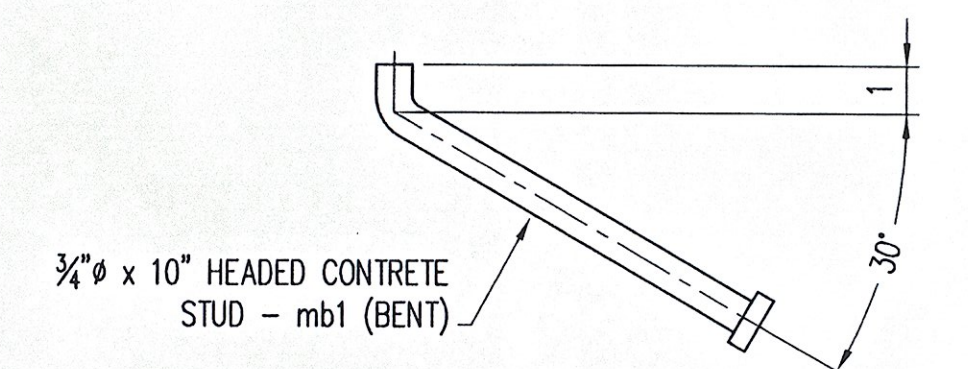


**BENT STUD DETAIL**

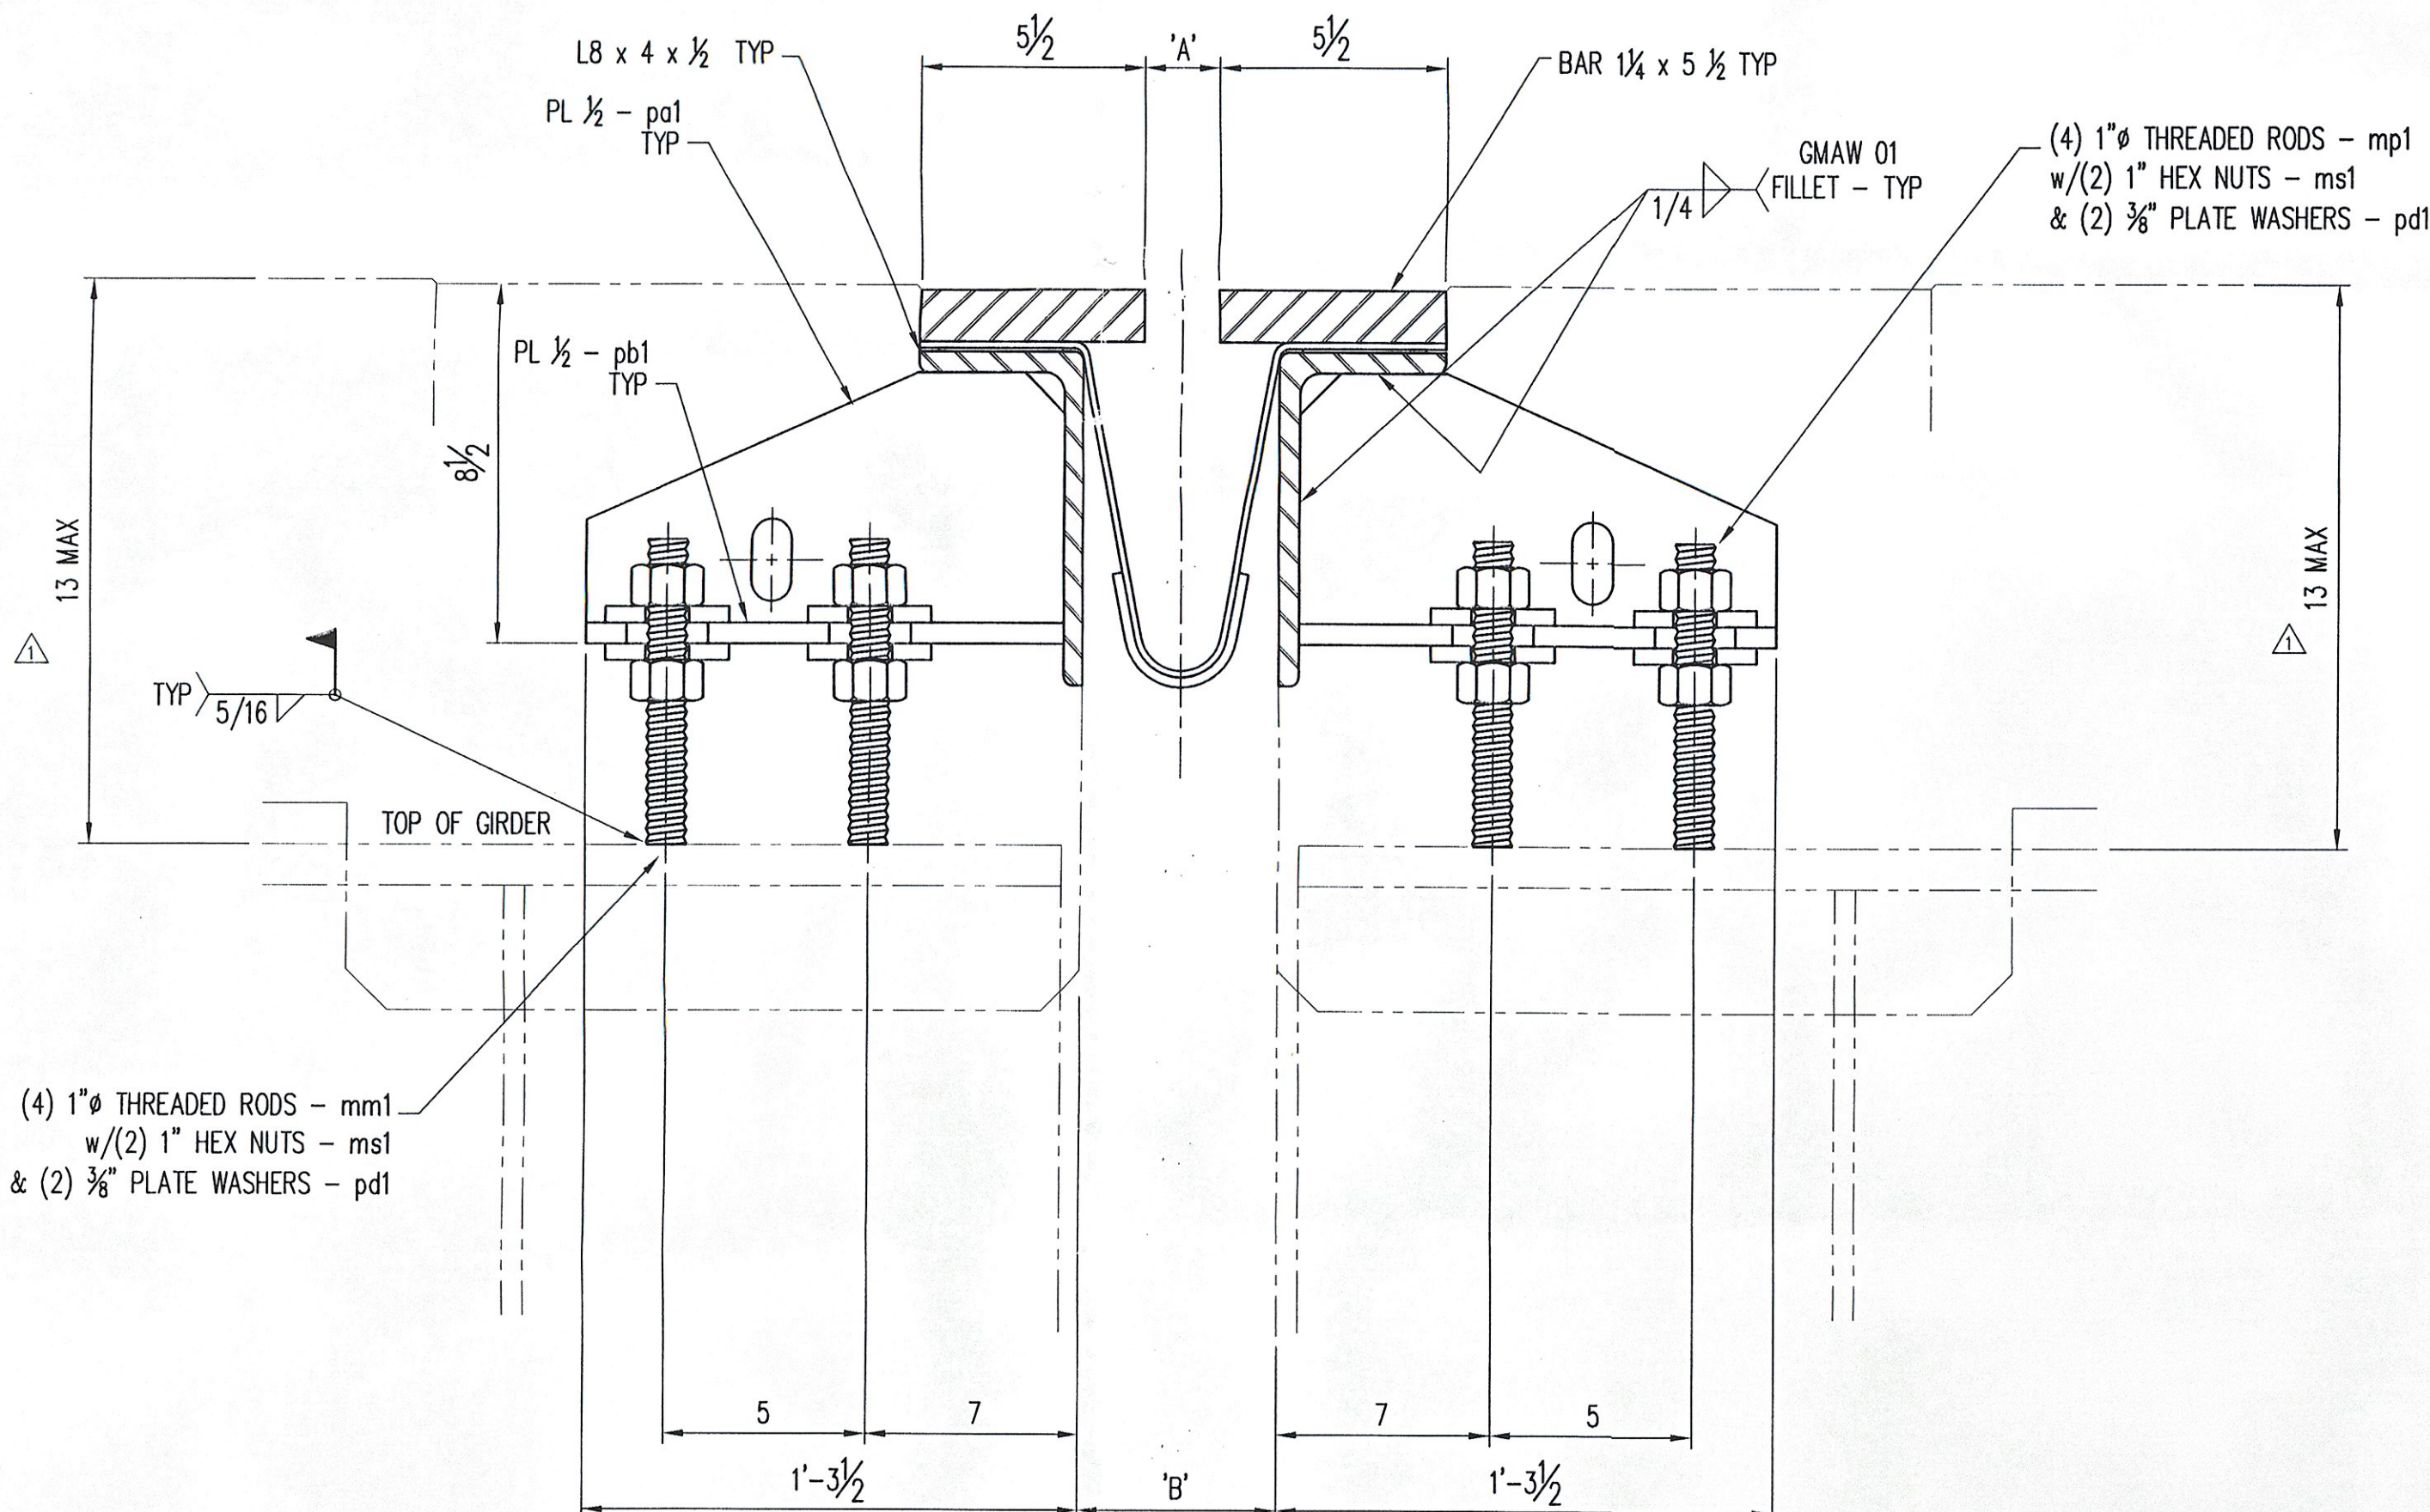

**GIRDER SECTION VIEW: B-B**

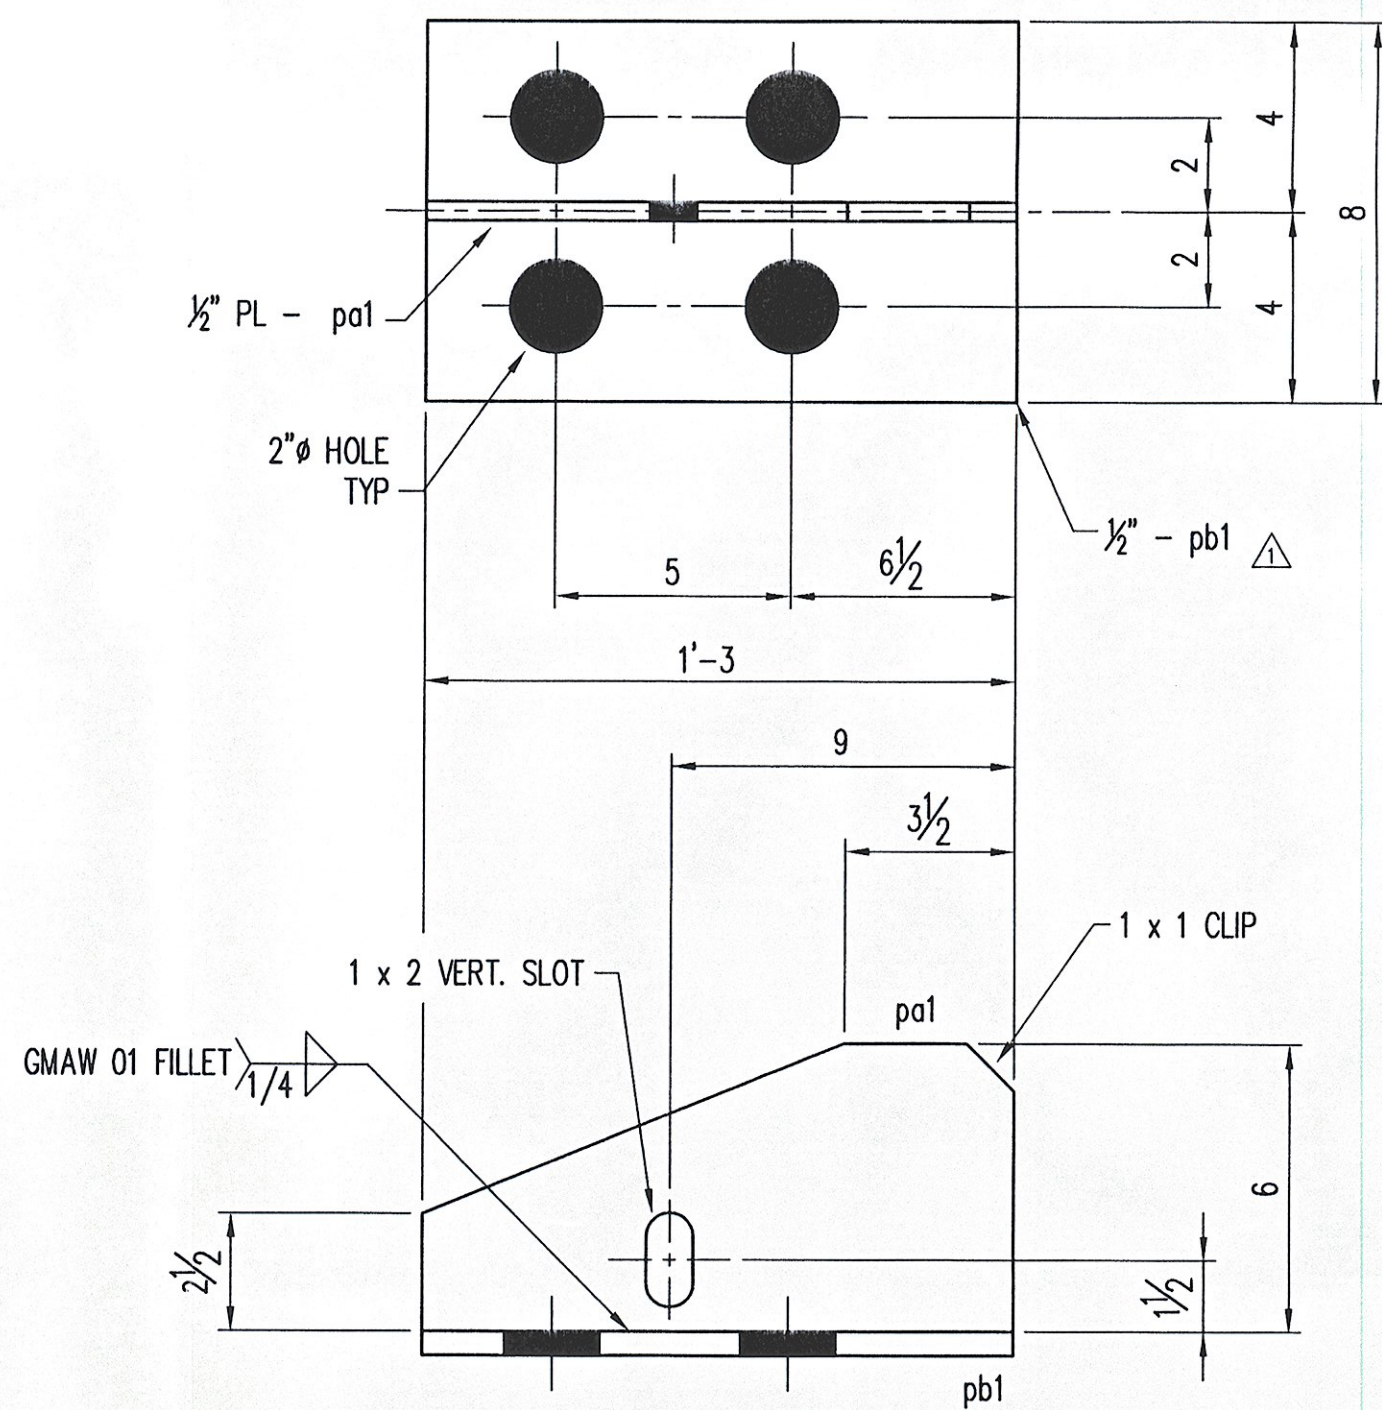

**BRACKET DETAIL**

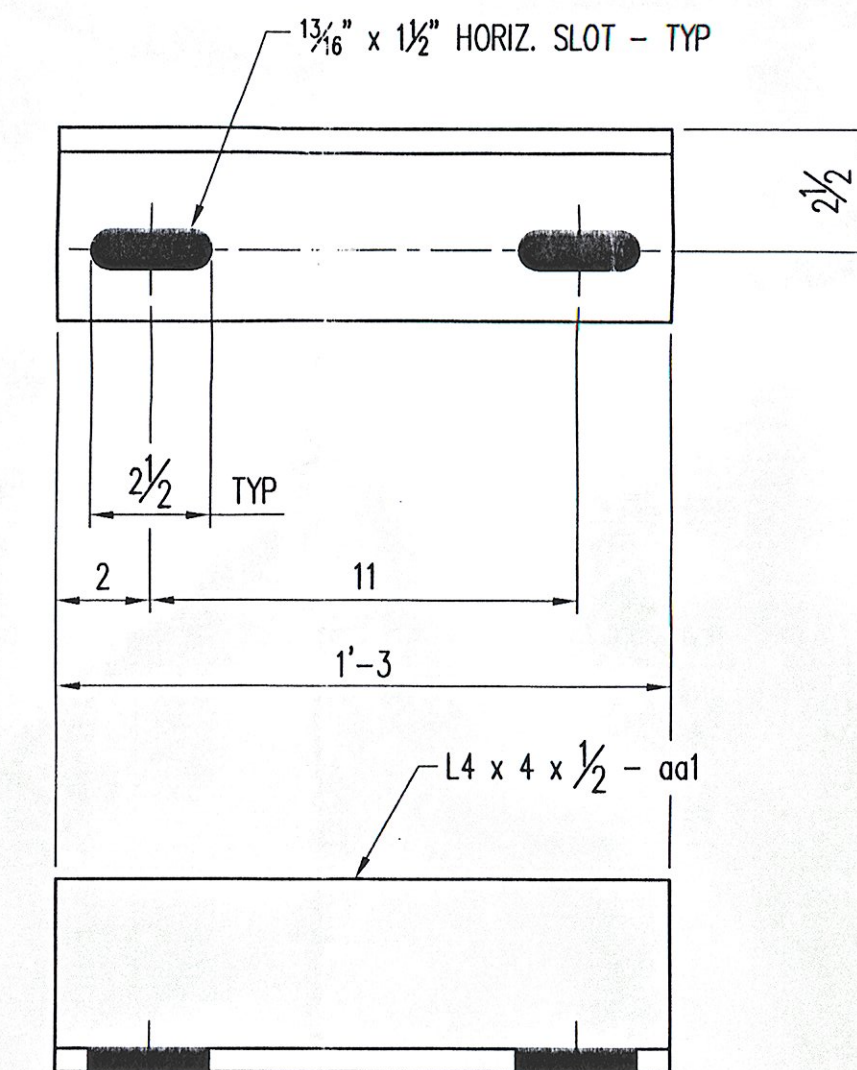

**SHIPPING ANGLE DETAIL**

**GENERAL NOTES:**

- ALL MATERIALS, CONSTRUCTION AND DESIGN SHALL CONFORM TO THE STATE OF VERMONT, AGENCY OF TRANSPORTATION STANDARD SPECIFICATION FOR CONSTRUCTION, DATED 2006, AND ITS LATEST REVISIONS, AND THE AASHTO STANDARD SPECIFICATIONS FOR HIGHWAY BRIDGES, 17th EDITION DATED 2002, AND ITS REVISIONS.
- WELDING SHALL MEET THE REQUIREMENTS OF THE ANSI/AASHTO/AWS D1.5 BRIDGE WELDING CODE AS MODIFIED BY THE STANDARD SPECIFICATIONS.
- HEADED CONCRETE STUDS SHALL BE ASTM A108 AND AUTOMATIC END WELDED WITH COMPLETE FUSION.
- ANY TIGHTLY ADHERENT WELD SPLATTER NEED NOT BE REMOVED IN COATING AREAS TO BE CAST IN CONCRETE.
- ALL STEEL COMPONENTS SHALL BE AASHTO M270 (GRADE 36) AND GALVANIZED OR METALIZED AS PER SUBSECTION 516.16 (UON). PRIOR TO GALVANIZING OR METALIZING, ALL CORNERS AND EDGES OF STEEL PLATES, SHAPES, ETC., SHALL BE GROUND TO A 1/16" +/- RADIUS.
- PREFORMED FABRIC MATERIAL SHALL BE CONTINUOUS AND SHALL CONFORM TO SUBSECTION 707.07.
- BUTYL RUBBER TAPE SHALL CONFORM TO AASHTO SPECIFICATION M-198, TYPE II.
- FABRIC TROUGH SHALL BE THOROUGHLY CLEANED AND FLUSHED AFTER PAVING OPERATION.
- THE EXPANSION JOINT SHALL BE SHOP ASSEMBLED AND SHIPPED AS 2 UNITS.
- THE 8 x 4 x 1/2 ANGLES SHALL BE FURNISHED AS 2 PIECES. THE 1 1/4 x 5 1/2 BARS ON EACH SIDE OF THE JOINT SHALL BE PROVIDED IN 2 EQUAL LENGTHS.

STRUCTURES COPY

RECEIVED  
 CK'D BY 135 OK'D BY RSY  
 MAY - 7 2008  
 RESUBMIT APPROVED AS NOTED  
 BY CPW DATE 5/8/08

No.	Description	Date	By	Approved
REVISIONS PER APPROVAL DRAWINGS	4/28/08	SB		



**Niagara Bridge and Rail**  
 4817 Henry Avenue, Niagara Falls, N.Y. 14304  
 Phone: (716) 283-4710 Fax: (716) 283-5137

Project Information:  
 STATE: VERMONT  
 COUNTY:  
 CITY / TOWNSHIP: BERLIN  
 LOCATION: I-89 (NB & SB) OVER VT ROUTE 12  
 PROJECT NO.: 1M 089-1 (20)  
 OWNER: VT-AOT  
 CONTRACTOR:

Drawn By: JJB Date: 3/23/08 Checked By: TFW Date: 3/30/08  
 Description: VERMONT - EXPANSION JOINT DETAIL STANDARD DETAILS Sheet No.: 1 of 5 Scale: NONE  
 Drawing No.: 10064-01 Rev No.: 1




JOINT OPENING		
TEMP	'A'	'B'
105° F.	1/2"	3/2"
90° F.	3/4"	3 3/4"
75° F.	1"	4"
60° F.	1 1/8"	4 9/16"
45° F.	1 3/8"	4 3/8"
30° F.	1 1/2"	4 1/2"
15° F.	2 1/8"	5 1/8"
0° F.	2 3/8"	5 3/8"
-15° F.	2 5/8"	5 5/8"

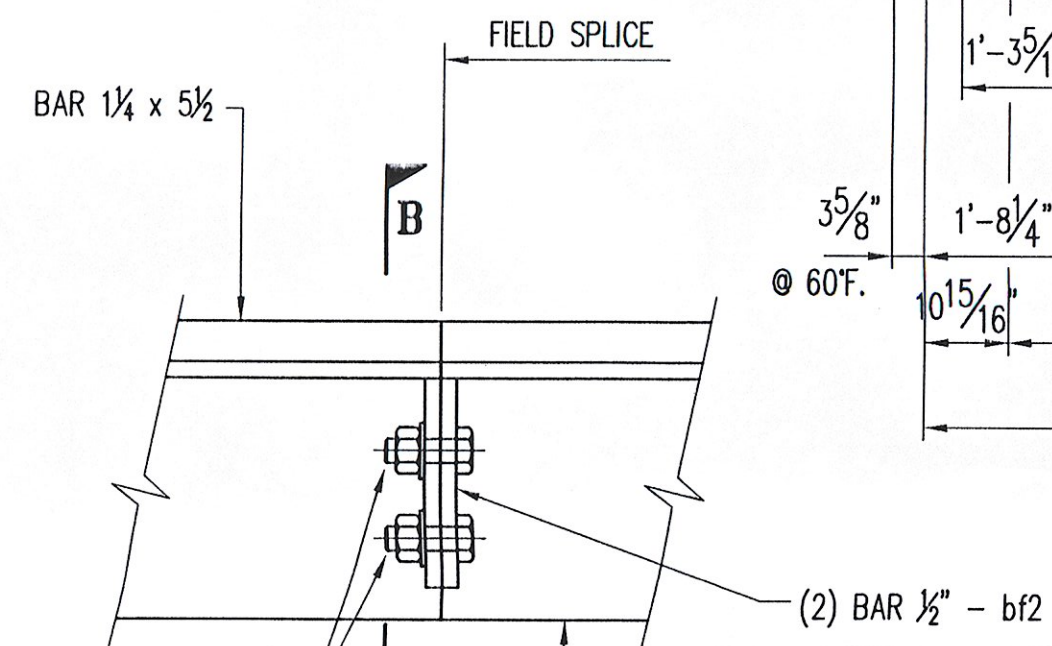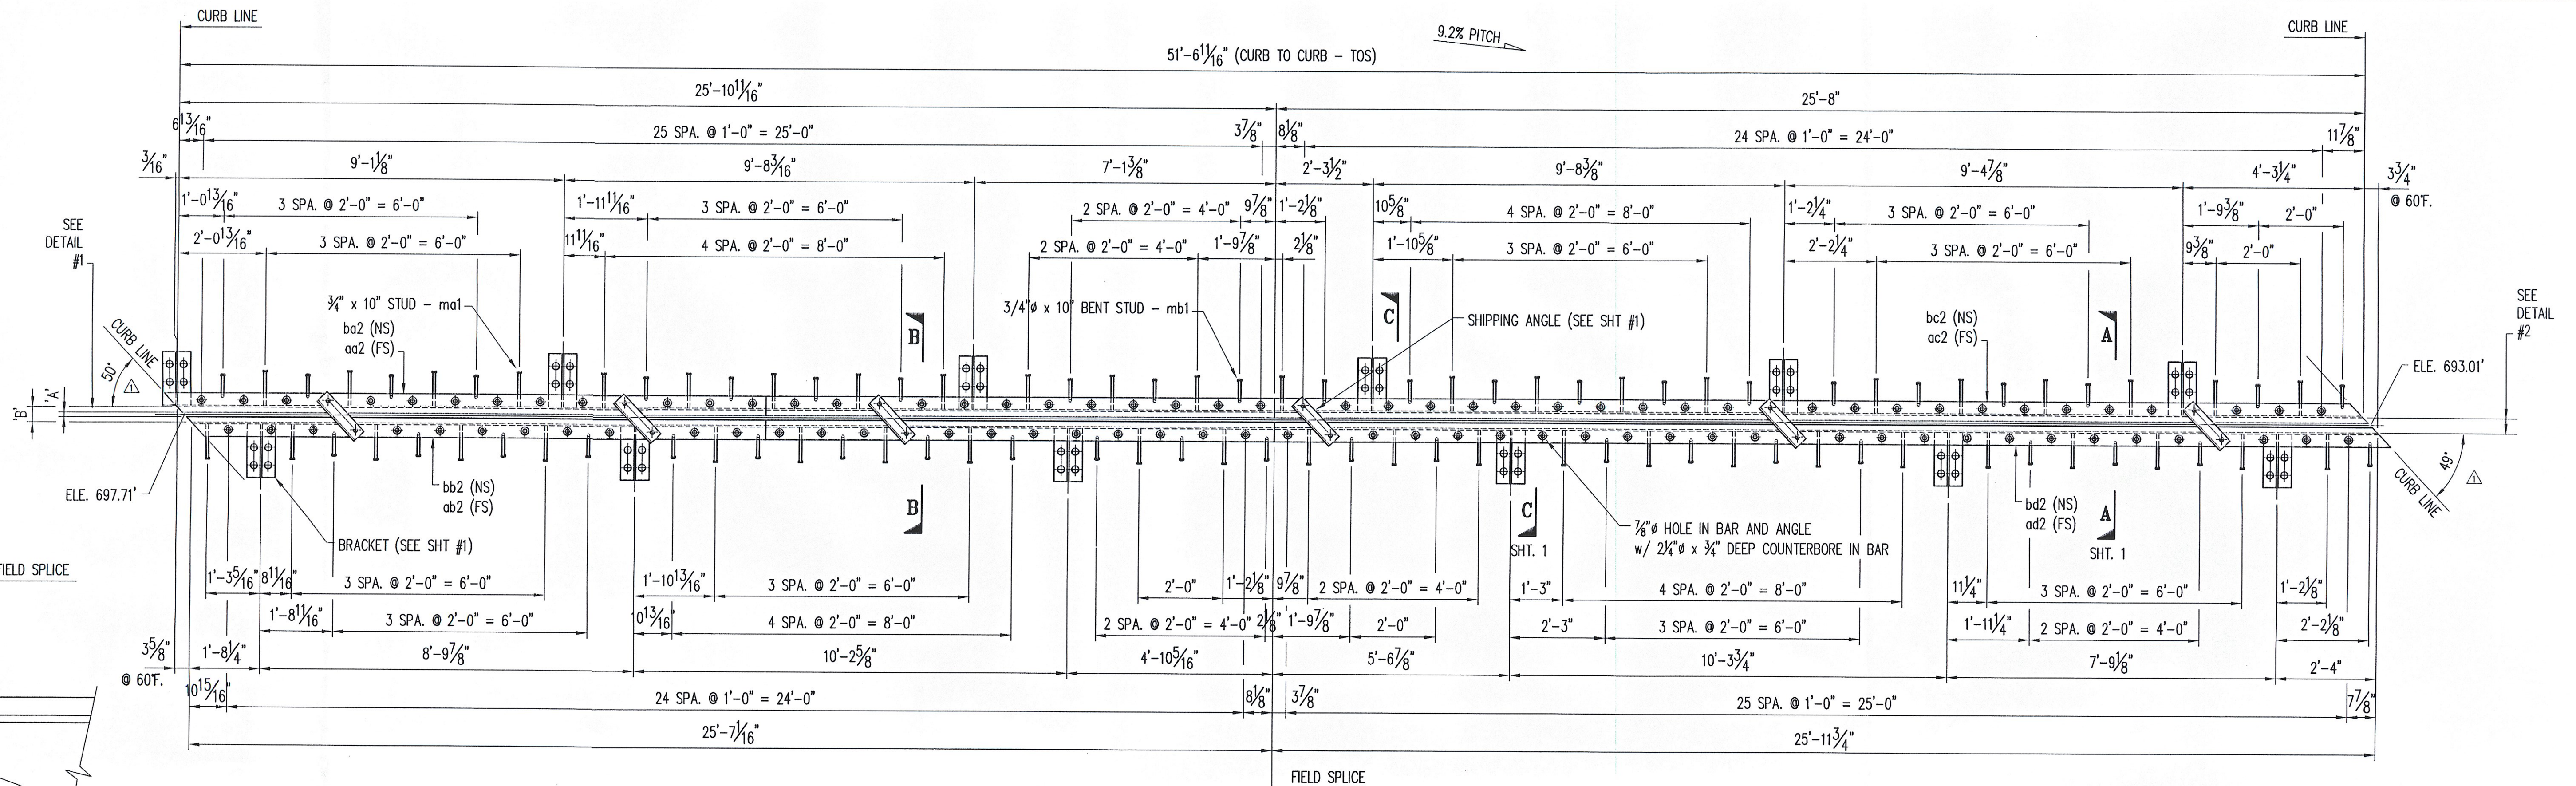

- (2) 7/8" HEX BOLTS - mk2
- (2) 3/8" HEX NUT - mm2
- (2) 3/8" FLAT WASHER - mn2


**BOLTED FIELD SPLICE DETAIL**

#	MARK No.	QTY	DESCRIPTION	MATERIAL	REMARKS
1			ONE - EXPANSION JOINT - 2EJ1		HGD
2	aa1	6	L4 x 4 x 1/2 x 1'-3"	A36	
3					
4	ma1	47	3/4" x 10 CONCRETE HEADED STUD	A108	
5	mb1	45	3/4" x 10 CONCRETE HEADED STUD	A108	BENT
6	mc1	5	1/16" x 1 1/2 (MIN) BUTYL RUBBER TAPE (SOFT ROLL)	AASHTO M-198 #75385A15	
7	md1	102	3/4" x 2 1/4 HEX BOLT	A325	M/G
8	mf1	12	3/4" x 3 3/4 HEX BOLT	A325	M/G
9	mh1	102	3/4" FLAT WASHER	F436	M/G
10	mk1	102	3/4" HEX COUPLER NUT	A563	M/G
11	mm1	48	1" x 18 THREADED ROD	A36	HGD
12	ms1	96	1" HEAVY HEX NUT	A563	HGD
13	pa1	12	PL 1/2 x 6 x 1'-3"	A36	HGD
14	pb1	12	PL 1/2 x 8 x 1'-3"	A36	
15	pd1	96	PL 3/8 x 3 x 3"	A36	HGD
16	aa2	ONE	L8 x 4 x 1/2 x 26'-2 1/16"	A36	
17	ab2	ONE	L8 x 4 x 1/2 x 25'-7 1/16"	A36	
18	ac2	ONE	L8 x 4 x 1/2 x 25'-8"	A36	
19	ad2	ONE	L8 x 4 x 1/2 x 26'-3 1/4"	A36	
20	ba2	ONE	BAR 1 1/4 x 5 1/2 x 26'-2 1/16"	A36	
21	bb2	ONE	BAR 1 1/4 x 5 1/2 x 25'-8 5/16"	A36	
22	bc2	ONE	BAR 1 1/4 x 5 1/2 x 25'-9 5/16"	A36	
23	bd2	ONE	BAR 1 1/4 x 5 1/2 x 26'-3 1/4"	A36	
24	bf2	4	BAR 1/2 x 3 1/2 x 6 1/2"	A36	
25	ma2	ONE	3 PLY FABRIC TROUGH 5/32 x 36 x 51'-11"	PER SPEC	
26	mb2	ONE	3 PLY FABRIC DRIP 5/32 x 1/4 x 7"	PER SPEC	
27	mc2	ONE	1/2" x 1/2" HEX BOLT	A307	M/G
28	md2	ONE	1/2" HEX NUT	A563	M/G
29	mf2	4	1/2" FLAT WASHER	F436	M/G
30	mh2	ONE	ANTI SEIZE GREASE	-	
31	mk2	4	7/8" x 2 HEX BOLT	A325	M/G
32	mm2	4	7/8" HEX NUT	A563	M/G
33	mn2	4	7/8" FLAT WASHER	F436	M/G

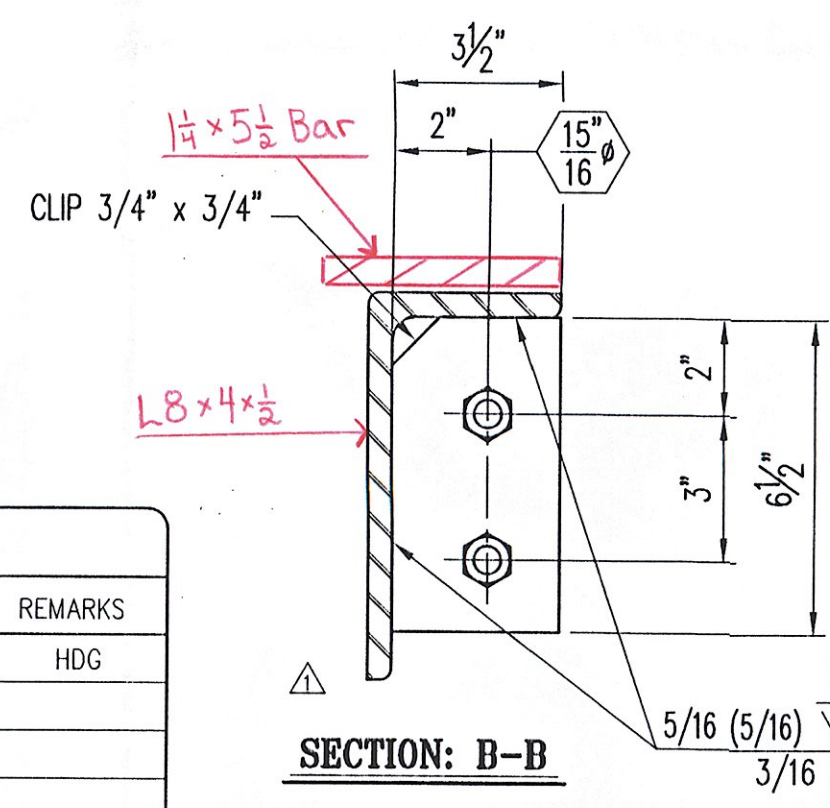


- SHOP NOTES:**
- WORK THIS SHEET ALONG WITH STANDARD SHEET #1.
  - COAT ALL BOLTS AND NUTS WITH NEVER SEIZE GREASE PRIOR TO ASSEMBLY.
  - WRENCH TIGHTEN BOLTS AFTER ASSEMBLY OF THE EXPANSION JOINT.
  - SEAL ALL ACCESSIBLE JOINTS PRIOR TO GALVANIZING.


- CONTRACTOR NOTES:**
- REMOVE SHIPPING ANGLES AND REPLACE WITH 3/4" x 2 1/4" HEX BOLTS. REUSE EXISTING FLAT WASHERS. COAT BOLT TREADS WITH NEVER SEIZE PRIOR TO ASSEMBLY.
  - FILL ALL COUNTERBORED HOLES WITH HOT POURED JOINT SEALER AFTER THE BOLT INSTALLATION. WORK AND MATERIALS ARE TO BE DONE BY OTHERS.

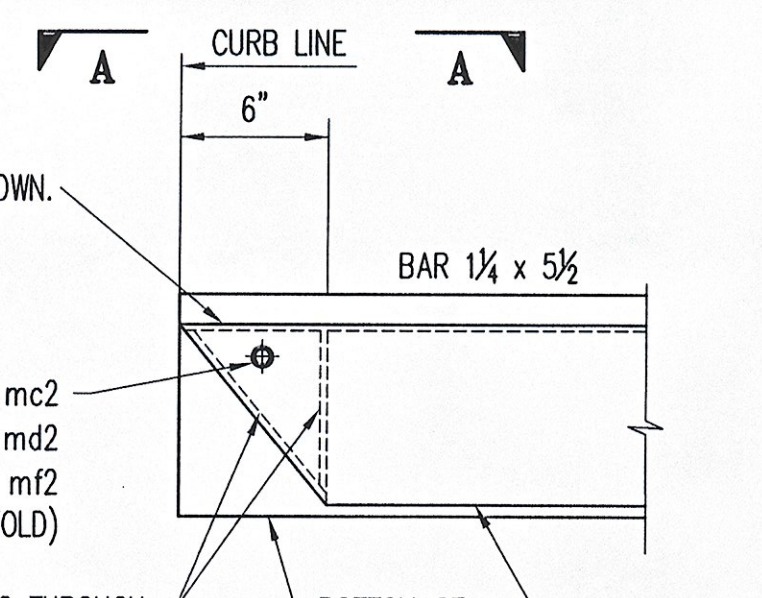


**DETAIL #1 FOLDED THROUGH END DETAILS**

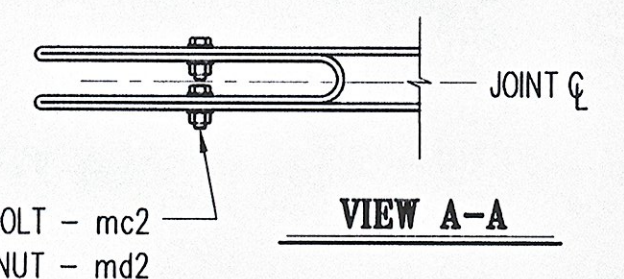


**VIEW A-A**

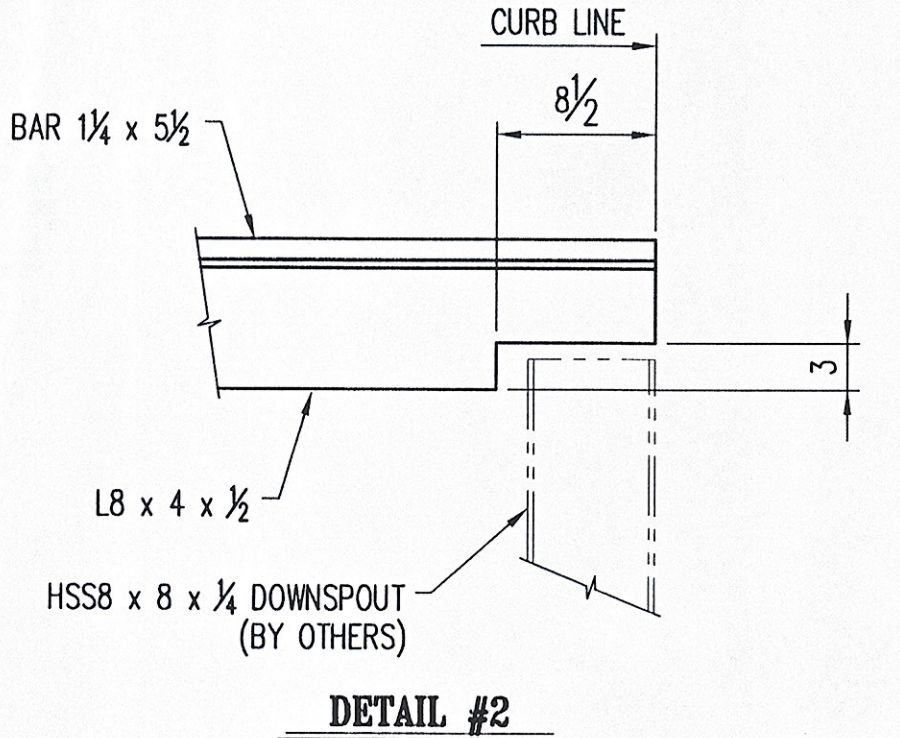

**DETAIL #2**

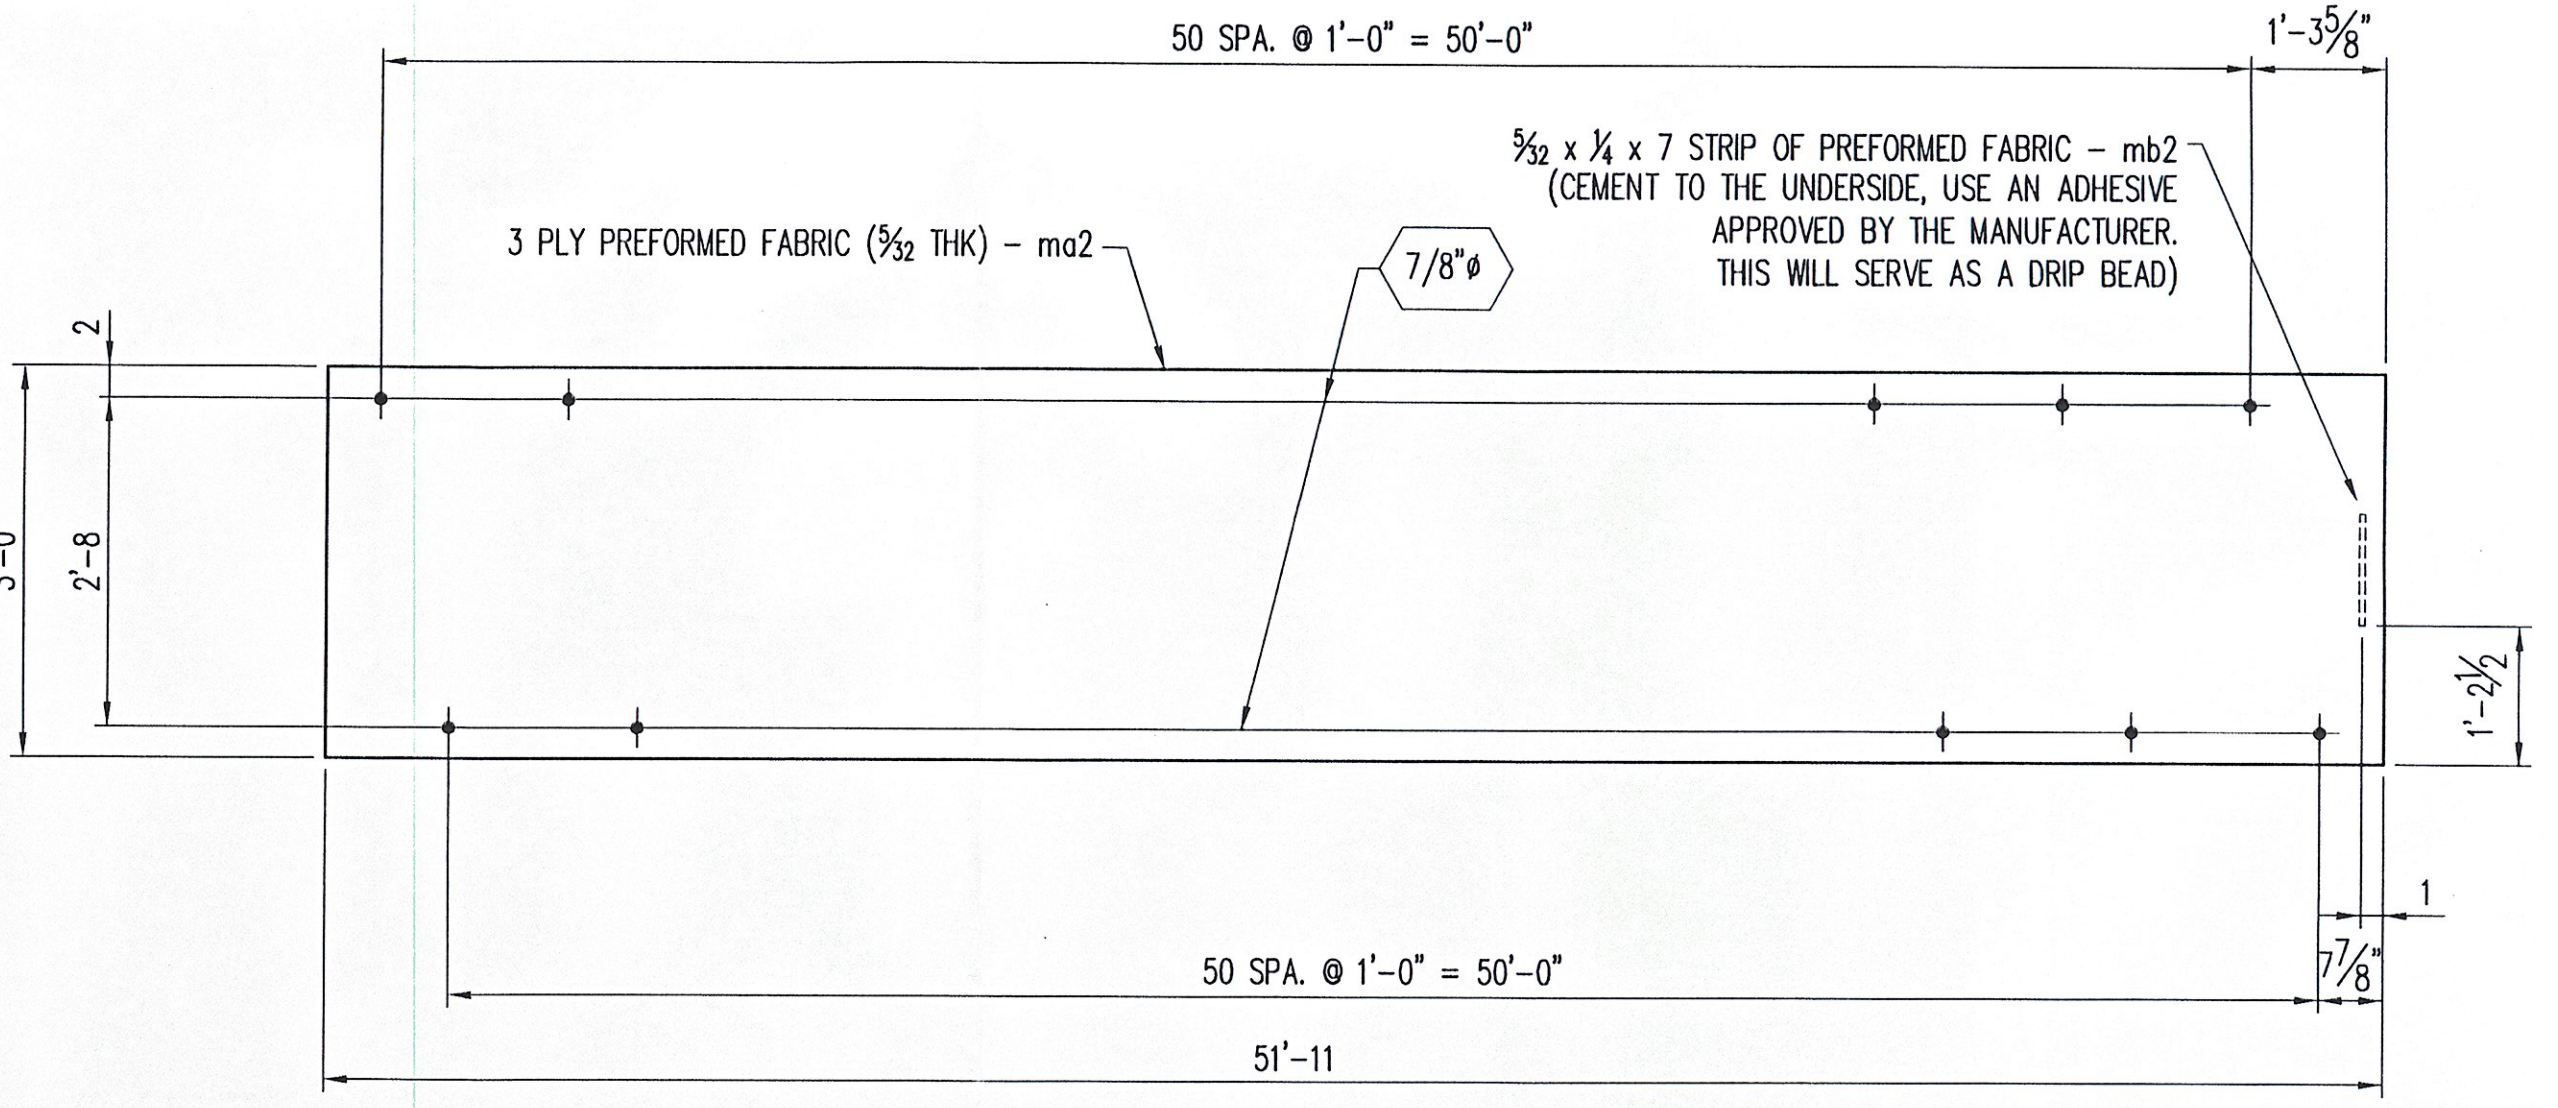

**TROUGH DETAIL**

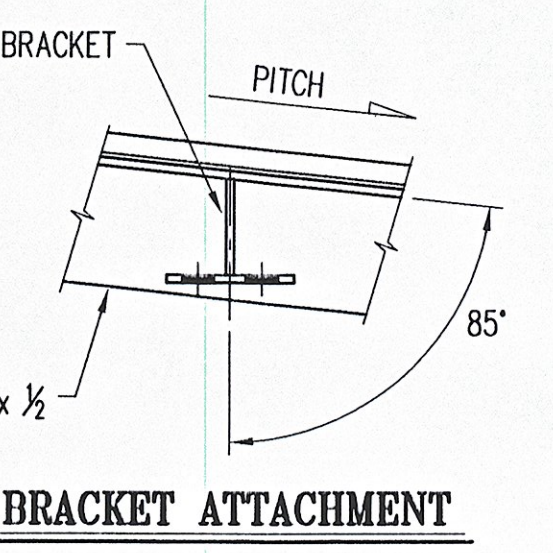

**BRACKET ATTACHMENT**

RECEIVED  
 CK'D BY: JSS OK'D BY: RSY  
 MAY - 7 2008  
 RESUBMIT APPROVED: [Signature]  
 BY: CPW DATE: 5/8/08

**Niagara Bridge and Rail**  
 4817 Henry Avenue, Niagara Falls, N.Y. 14304  
 Phone: (716) 283-4710 Fax: (716) 283-5137



Project Information:  
 STATE: VERMONT  
 COUNTY:  
 CITY / TOWNSHIP: BERLIN  
 LOCATION: I-89 (NB & SB) OVER VT ROUTE 12  
 PROJECT NO.: 1M 089-1 (20)  
 OWNER: VT-AOT  
 CONTRACTOR:

Drawn By: JUB Date: 3/28/08 Checked By: TFW Date: 3/30/08  
 Description: VERMONT - EXPANSION JOINT DETAIL EXPANSION JOINT @ PIER 1  
 Sheet No.: 2 of 5 Scale: NONE  
 Drawing No.: 10064-01 Rev No.: 1


REVISIONS PER APPROVAL DRAWINGS			
No.	Description	Date	By
4/29/08	SB		
REVISIONS			



JOINT OPENING			
TEMP	'A'	'B'	
105° F.	1/2"	3 1/2"	
90° F.	5/8"	3 3/4"	
75° F.	3/4"	3 3/4"	
60° F.	7/8"	3 3/4"	
45° F.	1 1/8"	3 3/4"	
30° F.	1 1/4"	4 1/8"	
15° F.	1 3/8"	4 3/8"	
0° F.	1 1/2"	4 3/8"	

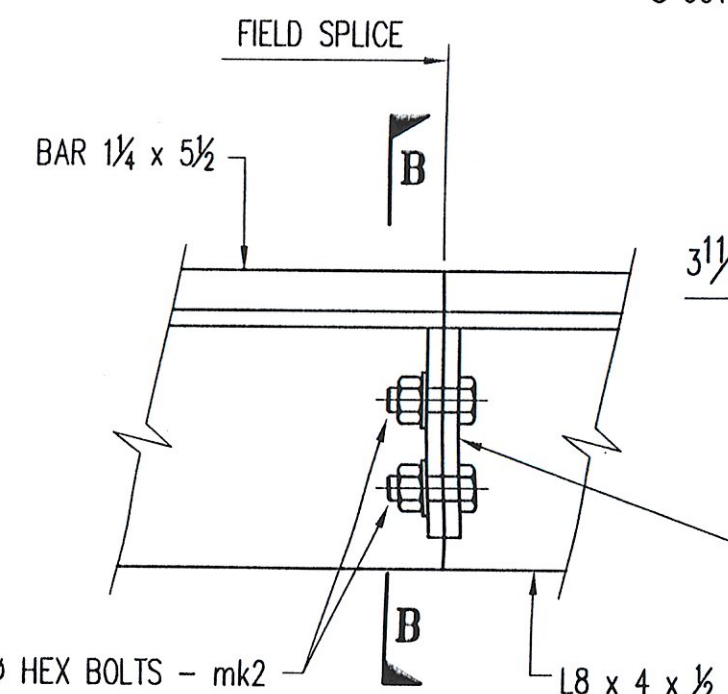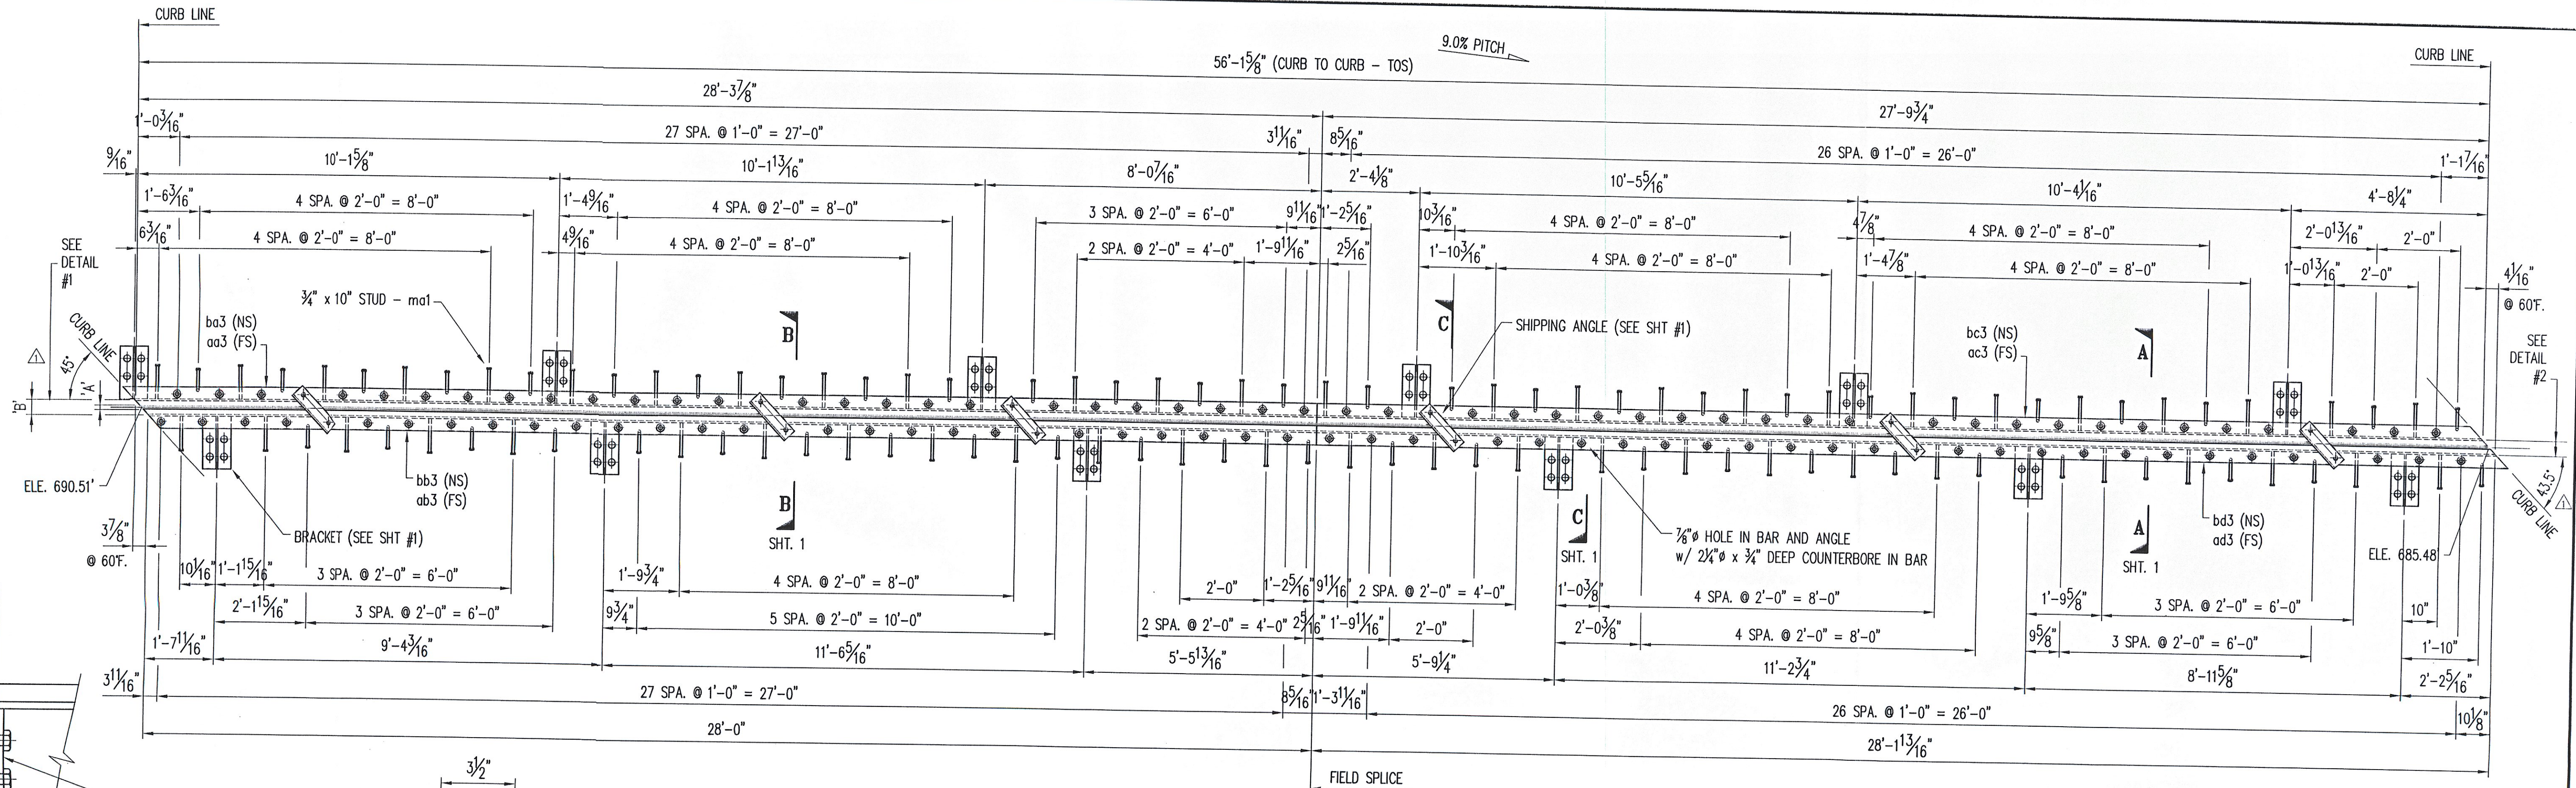

**BOLTED FIELD SPLICE DETAIL**

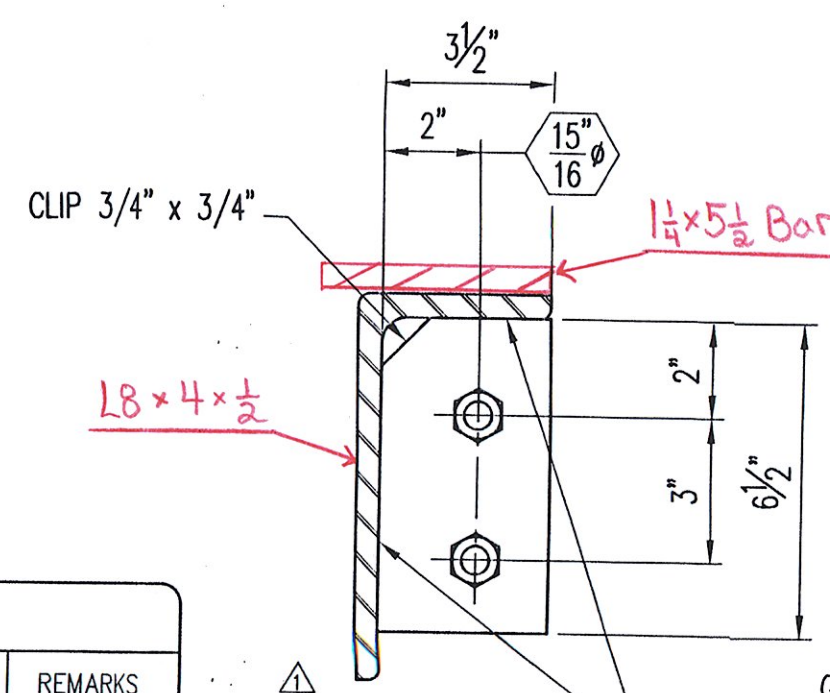

**SECTION: B-B**


**SHOP NOTES:**

1. WORK THIS SHEET ALONG WITH STANDARD SHEET #1.
2. COAT ALL BOLTS AND NUTS WITH NEVER SEIZE GREASE PRIOR TO ASSEMBLY.
3. WRENCH TIGHTEN BOLTS AFTER ASSEMBLY OF THE EXPANSION JOINT.
4. SEAL ALL ACCESSIBLE JOINTS PRIOR TO GALVANIZING.

**CONTRACTOR NOTES:**

1. REMOVE SHIPPING ANGLES AND REPLACE WITH 3/4" x 2 1/4" HEX BOLTS. REUSE EXISTING FLAT WASHERS. COAT BOLT TREADS WITH NEVER SEIZE PRIOR TO ASSEMBLY.
2. FILL ALL COUNTERBORED HOLES WITH HOT POURED JOINT SEALER AFTER THE BOLT INSTALLATION. WORK AND MATERIALS ARE TO BE DONE BY OTHERS.


**ONE - EXPANSION JOINT - 3EJ1 PIER #2**

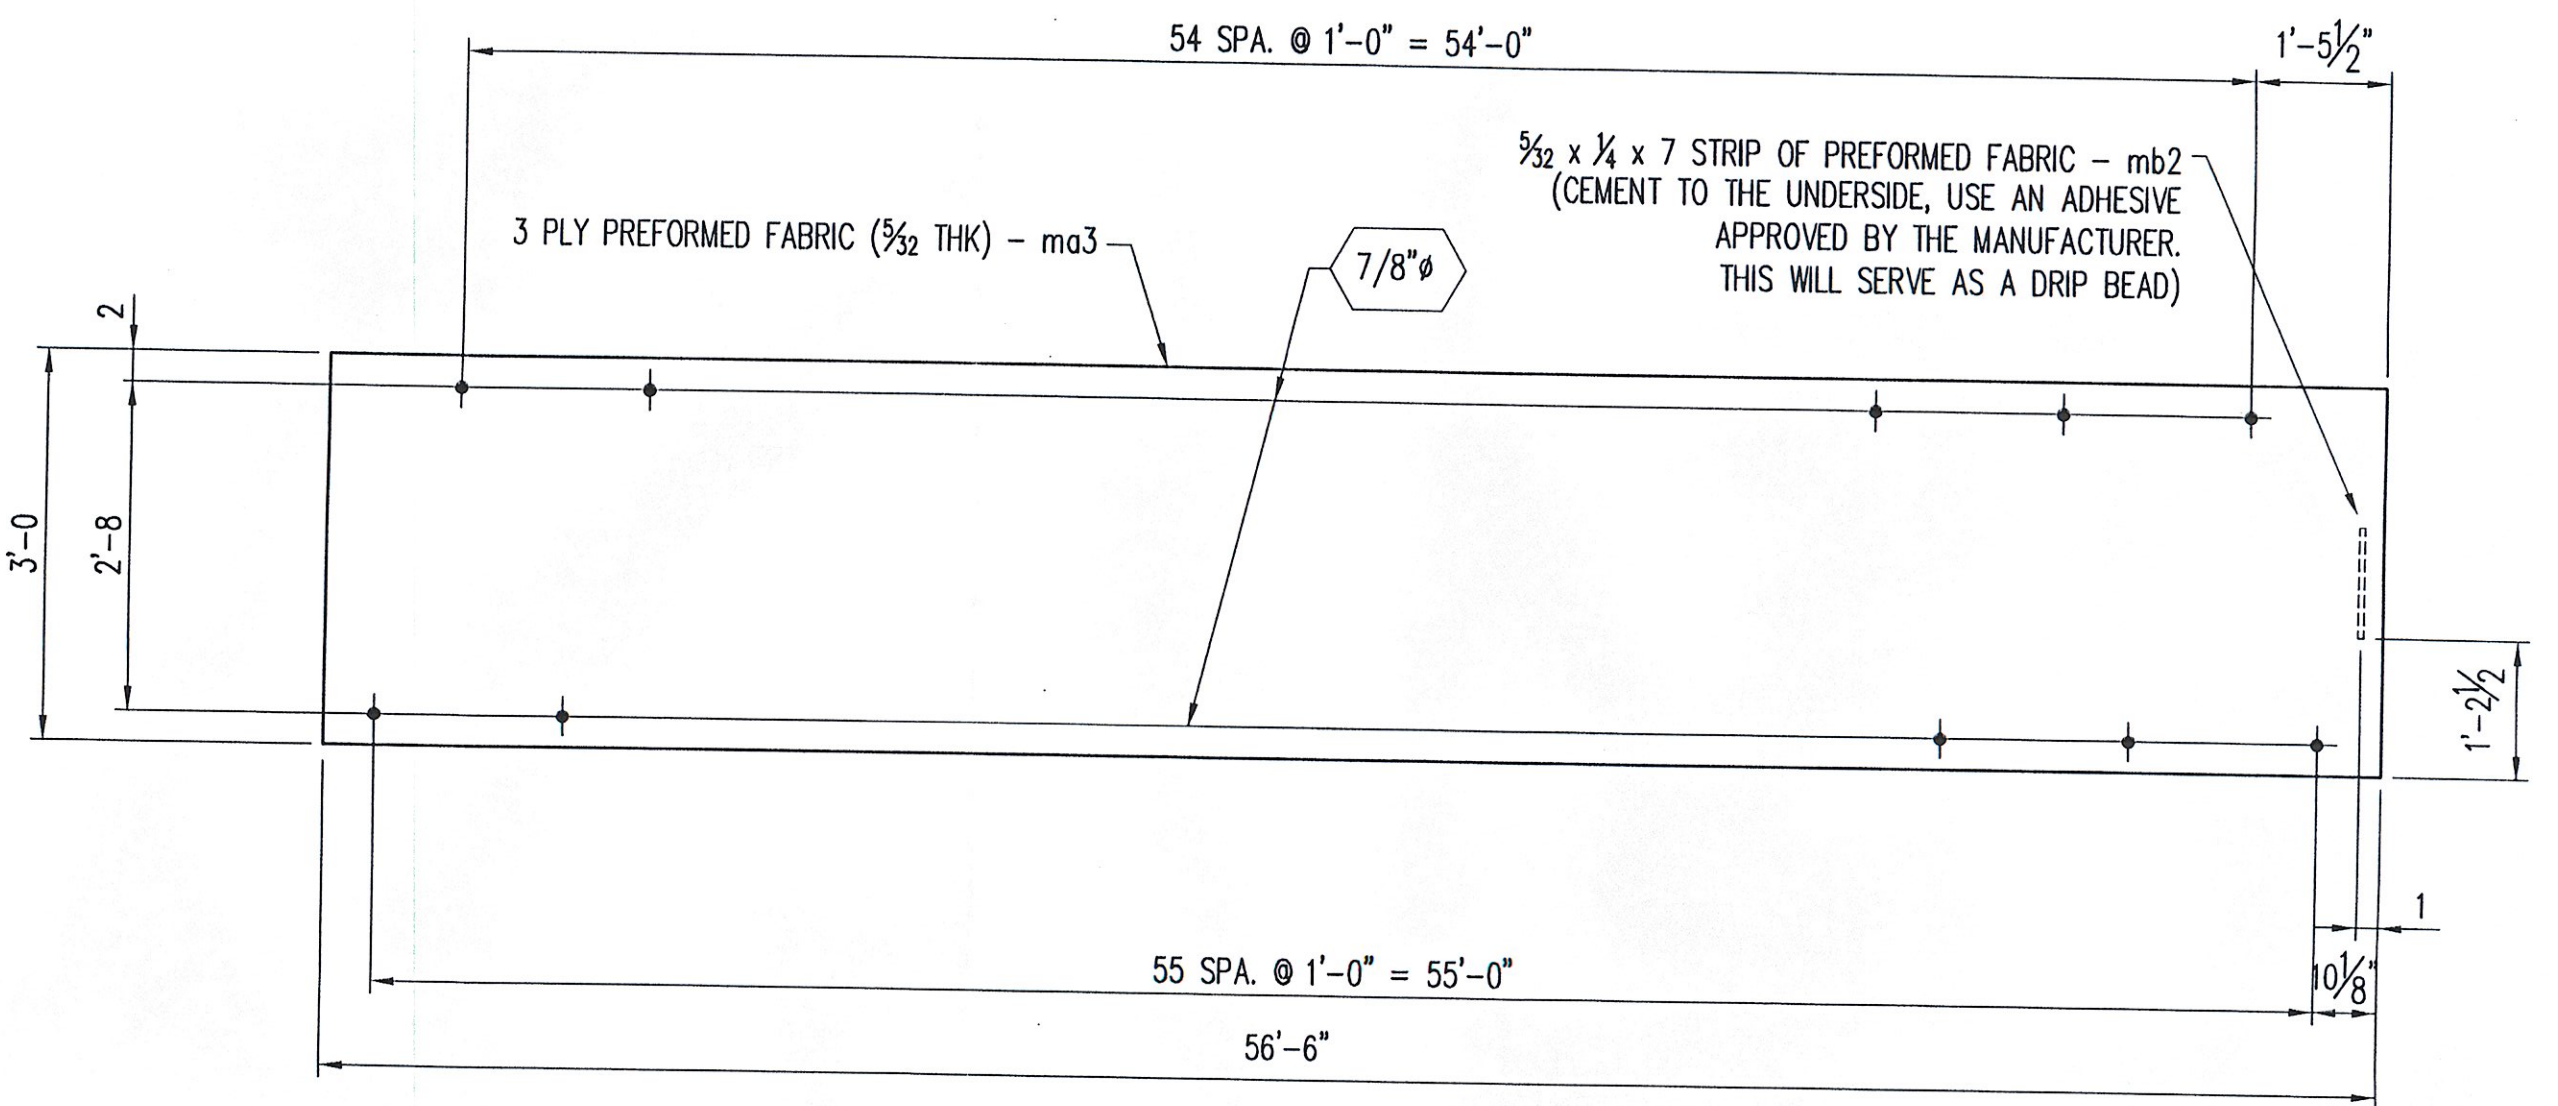


**TROUGH DETAIL**

#	MARK No.	QTY	DESCRIPTION	MATERIAL	REMARKS
1			ONE - EXPANSION JOINT - 3EJ1		HDC
2	aa1	6	L4 x 4 x 1/2 x 1'-3	A36	
3	ma1	52	3/4" x 10 CONCRETE HEADED STUD	A108	
4	mb1	51	3/4" x 10 CONCRETE HEADED STUD	A108	BENT
5	mc1	4	1/16" x 1 1/2 (MIN) BUTYL RUBBER TAPE (SOFT ROLL)	AASHTO M-198	#75385A15
6	md1	111	3/4" x 2 1/4 HEX BOLT	A325	M/G
7	mf1	12	3/4" x 3 3/4 HEX BOLT	A325	M/G
8	mh1	111	3/4" FLAT WASHER	F436	M/G
9	mk1	111	3/4" HEX COUPLER NUT	A563	M/G
10	mm1	48	1" x 7/8 THREADED ROD	A36	HDC
11	ms1	96	1" HEAVY HEX NUT	A563	HDC
12	pa1	12	PL 1/2 x 6 x 1'-3	A36	
13	pb1	12	PL 1/2 x 8 x 1'-3	A36	
14	pd1	96	PL 3/8 x 3 x 3	A36	HDC
15	aa3	ONE	L8 x 4 x 1/2 x 28'-7 7/8	A36	
16	ab3	ONE	L8 x 4 x 1/2 x 28'-0	A36	
17	ac3	ONE	L8 x 4 x 1/2 x 27'-9 3/4	A36	
18	ad3	ONE	L8 x 4 x 1/2 x 28'-6	A36	
19	ba3	ONE	BAR 1 1/4 x 5 1/2 x 28'-7 7/8	A36	
20	bb3	ONE	BAR 1 1/4 x 5 1/2 x 28'-1 1/2	A36	
21	bc3	ONE	BAR 1 1/4 x 5 1/2 x 27'-11 5/16	A36	
22	bd3	ONE	BAR 1 1/4 x 5 1/2 x 28'-6	A36	
23	bf2	4	BAR 1/2 x 3 1/2 x 6 1/2	A36	
24	ma3	ONE	3 PLY FABRIC TROUGH 5/32 x 36 x 56'-6	PER SPEC	
25	mb2	ONE	3 PLY FABRIC DRIP 5/32 x 1/4 x 7	PER SPEC	
26	mc2	ONE	1/2" x 1" HEX BOLT	A307	M/G
27	md2	ONE	1/2" HEX NUT	A563	M/G
28	mf2	ONE	1/2" FLAT WASHER	F436	M/G
29	mh2	ONE	ANTI SEIZE GREASE		
30	mk2	4	7/8" x 2 HEX BOLT	A325	M/G
31	mm2	4	7/8" HEX NUT	A563	M/G
32	mn2	4	7/8" FLAT WASHER	F436	M/G


FOLD THE END OF THE FABRIC TROUGH AS SHOWN. DRILL 7/8" HOLES IN FABRIC TROUGH. USE HARDWARE TO CLOSE OFF THE CHANNEL.

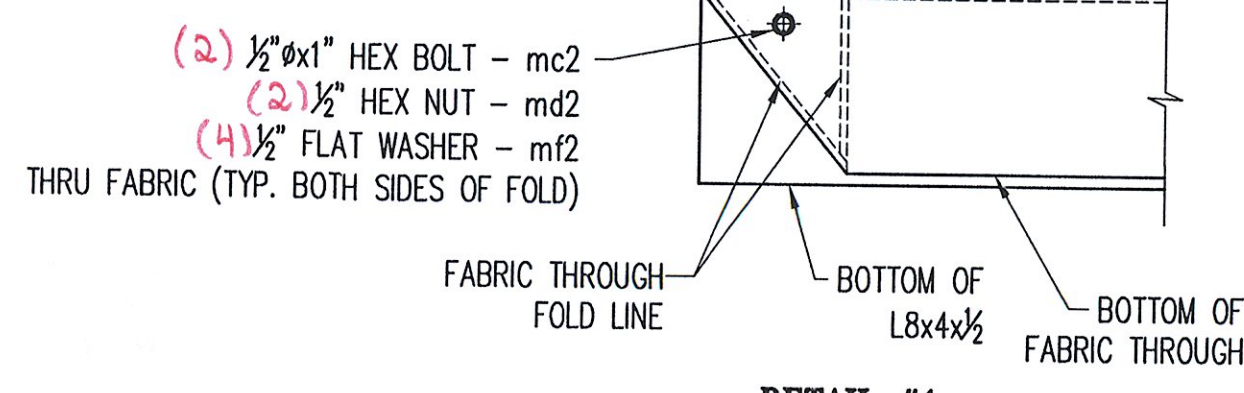


**DETAIL #1 FOLDED THROUGH END DETAILS**

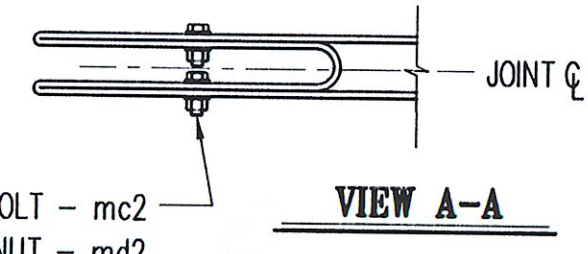

**VIEW A-A**

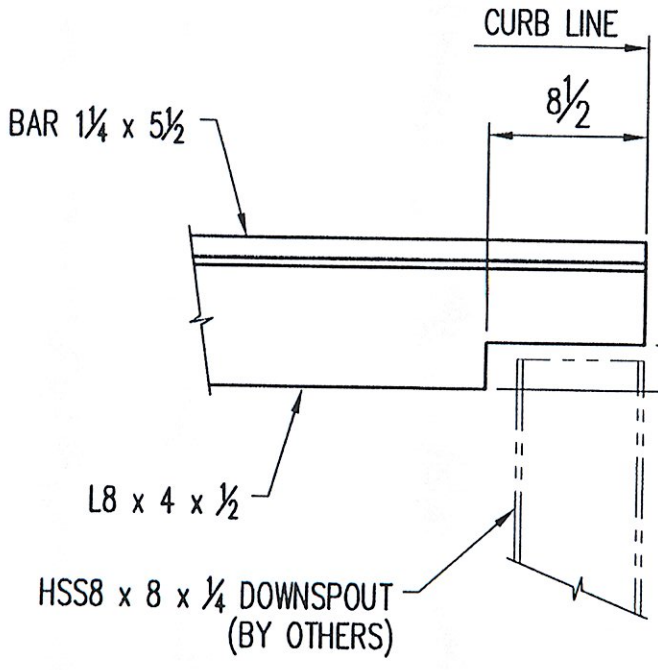

**DETAIL #2**

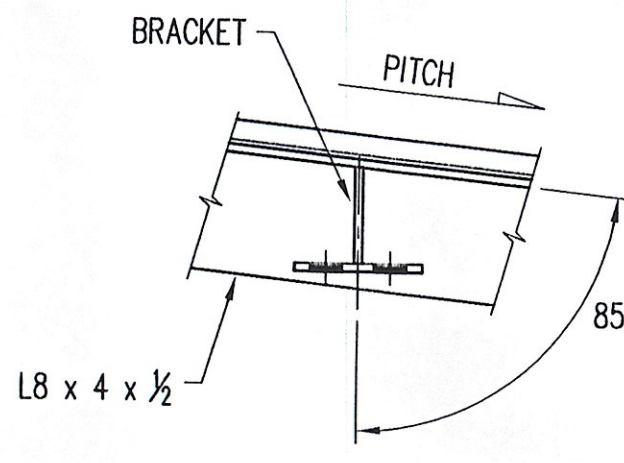

**BRACKET ATTACHMENT**

**Niagara Bridge and Rail**  
4817 Henry Avenue, Niagara Falls, N.Y. 14304  
Phone: (716) 283-4710 Fax: (716) 283-5137

Project Information: VERMONT  
STATE: VERMONT  
COUNTY: BERLIN  
CITY / TOWNSHIP: 1-89 (NB & SB) OVER VT ROUTE 12  
LOCATION: 1M 089-1 (20)  
PROJECT NO.: VT-AOT  
OWNER:  
CONTRACTOR:

Drawn By: JJB Date: 3/28/08 Checked By: TFW Date: 3/30/08  
Description: VERMONT - EXPANSION JOINT DETAIL  
EXPANSION JOINT @ PIER 2  
Sheet No.: 3 of 5 Scale: NONE  
Drawing No.: 10064-01 Rev No.: 1




RECEIVED  
CR'D BY LJS OK'D BY RSY  
MAY - 7 2008  
RESUBMIT APPROVED BY Noted  
BY CPW DATE 5/31/08

No.	Description	Date	By	Approved
	REVISIONS			





JOINT OPENING		
TEMP	'A'	'B'
105° F.	1/2"	3/2"
90° F.	5/8"	3 3/8"
75° F.	3/4"	3 3/4"
60° F.	7/8"	3 7/8"
45° F.	1 1/8"	3 7/8"
30° F.	1 1/4"	4 1/8"
15° F.	1 3/8"	4 1/8"
0° F.	1 3/8"	4 1/8"
-15° F.	1 1/2"	4 1/8"

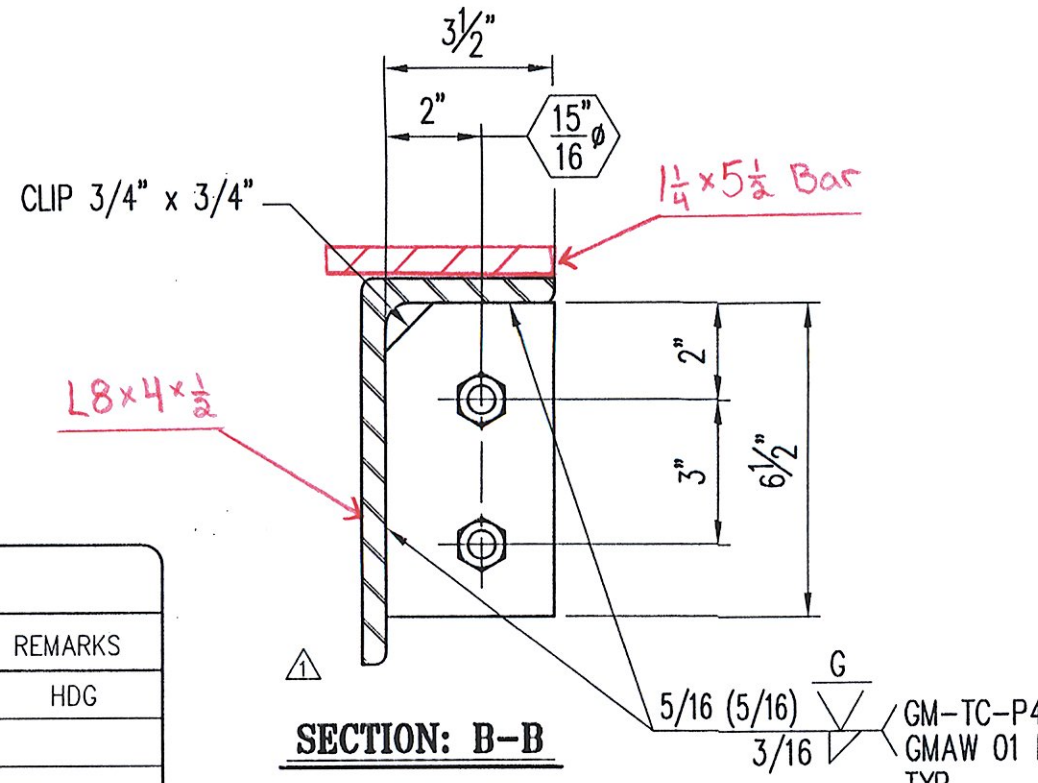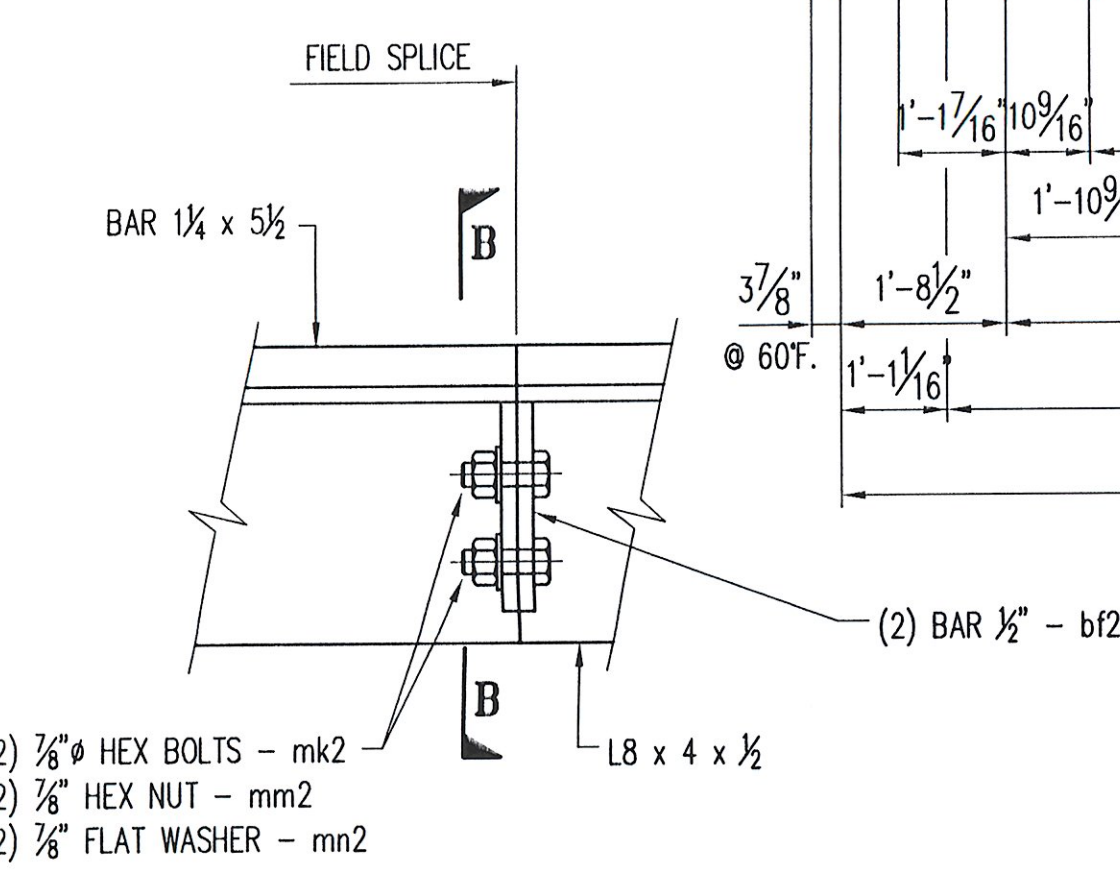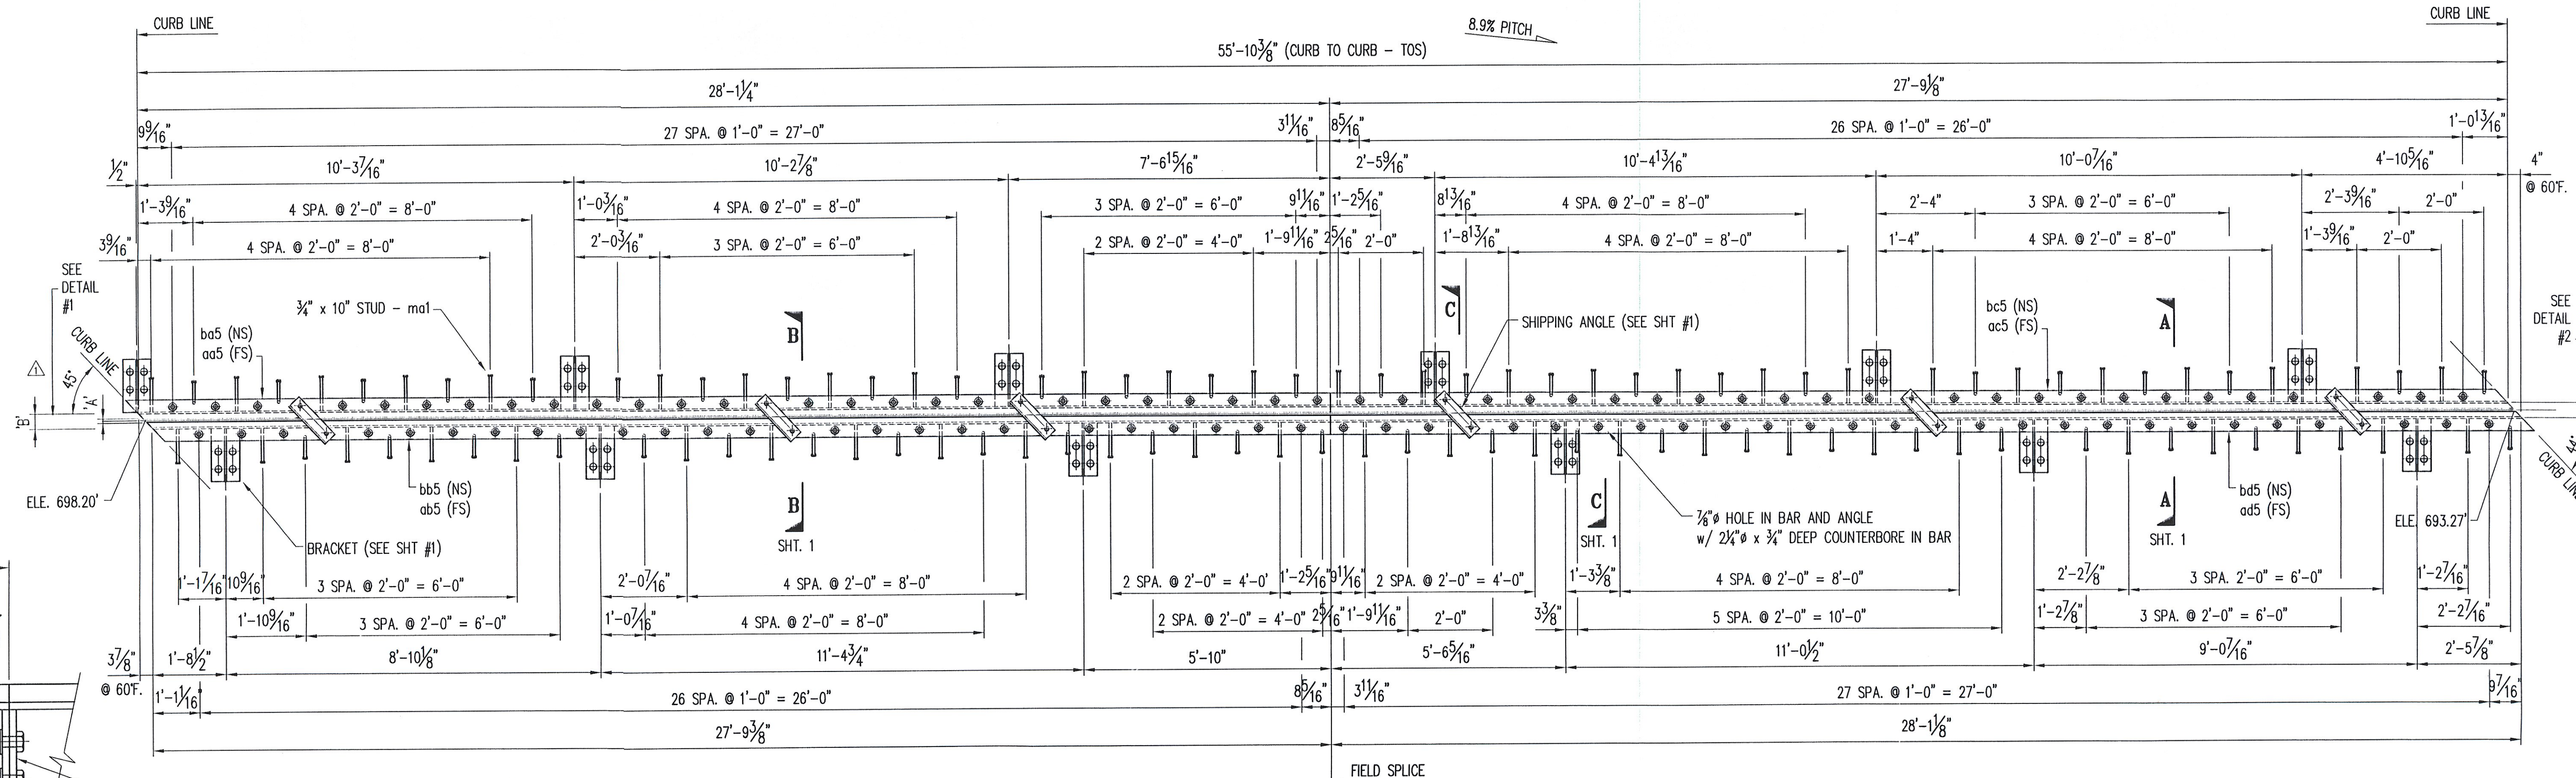

**SHOP NOTES:**





1. WORK THIS SHEET ALONG WITH STANDARD SHEET #1.
2. COAT ALL BOLTS AND NUTS WITH NEVER SEIZE GREASE PRIOR TO ASSEMBLY.
3. WRENCH TIGHTEN BOLTS AFTER ASSEMBLY OF THE EXPANSION JOINT.
4. SEAL ALL ACCESSIBLE JOINTS PRIOR TO GALVANIZING.

**CONTRACTOR NOTES:**

1. REMOVE SHIPPING ANGLES AND REPLACE WITH 3/4" x 2 1/4" HEX BOLTS. REUSE EXISTING FLAT WASHERS. COAT BOLT TREATS WITH NEVER SEIZE PRIOR TO ASSEMBLY.
2. FILL ALL COUNTERBORED HOLES WITH HOT POURED JOINT SEALER AFTER THE BOLT INSTALLATION. WORK AND MATERIALS ARE TO BE DONE BY OTHERS.

BILL OF MATERIALS					
#	MARK No.	QTY	DESCRIPTION	MATERIAL	REMARKS
1			ONE - EXPANSION JOINT - 3EJ1		HDG
2	aa1	6	L4 x 4 x 1/2 x 1'-3"	A36	
3	ma1	49	3/4" x 10 CONCRETE HEADED STUD	A108	
4	mb1	51	3/4" x 10 CONCRETE HEADED STUD	A108	BENT
5	mc1	4	1/16" x 1 1/2 (MIN) BUTYL RUBBER TAPE (50FT ROLL)	AASHTO M-198	#75385A15
6	md1	110	3/4" x 2 1/4 HEX BOLT	A325	M/G
7	mf1	12	3/4" x 3 3/4 HEX BOLT	A325	M/G
8	mh1	110	3/4" FLAT WASHER	F436	M/G
9	mk1	110	3/4" HEX COUPLER NUT	A563	M/G
10	mm1	48	1" x 6 THREADED ROD	A36	HDG
11	ms1	96	1" HEAVY HEX NUT	A563	HDG
12	pa1	12	PL 1/2 x 6 x 1'-3"	A36	
13	pb1	12	PL 1/2 x 8 x 1'-3"	A36	
14	pd1	96	PL 3/8 x 3 x 3"	A36	HDG
15	aa5	ONE	L8 x 4 x 1/2 x 28'-5 1/4"	A36	
16	ab5	ONE	L8 x 4 x 1/2 x 27'-9 3/8"	A36	
17	ac5	ONE	L8 x 4 x 1/2 x 27'-9 1/8"	A36	
18	ad5	ONE	L8 x 4 x 1/2 x 28'-5 1/4"	A36	
19	ba5	ONE	BAR 1 1/4 x 5 1/2 x 28'-5 1/4"	A36	
20	bb5	ONE	BAR 1 1/4 x 5 1/2 x 27'-10 7/8"	A36	
21	bc5	ONE	BAR 1 1/4 x 5 1/2 x 27'-10 11/16"	A36	
22	bd5	ONE	BAR 1 1/4 x 5 1/2 x 28'-5 1/4"	A36	
23	bf2	4	BAR 1/2 x 3 1/2 x 6 1/2"	A36	
24	ma5	ONE	3 PLY FABRIC TROUGH 5/32 x 36 x 56'-3"	PER SPEC	
25	mb2	ONE	3 PLY FABRIC DRIP 5/32 x 1/4 x 7"	PER SPEC	
26	mc2	ONE	1/2" x 1" HEX BOLT	A307	M/G
27	md2	ONE	1/2" HEX NUT	A563	M/G
28	mf2	ONE	1/2" FLAT WASHER	F436	M/G
29	mh2	ONE	ANTI SEIZE GREASE	-	
30	mk2	4	7/8" x 2 HEX BOLT	A325	M/G
31	mm2	4	7/8" HEX NUT	A563	M/G
32	mn2	4	7/8" FLAT WASHER	F436	M/G
33					

FOLD THE END OF THE FABRIC TROUGH AS SHOWN. DRILL 3/8" HOLES IN FABRIC TROUGH. USE HARDWARE TO CLOSE OFF THE CHANNEL.

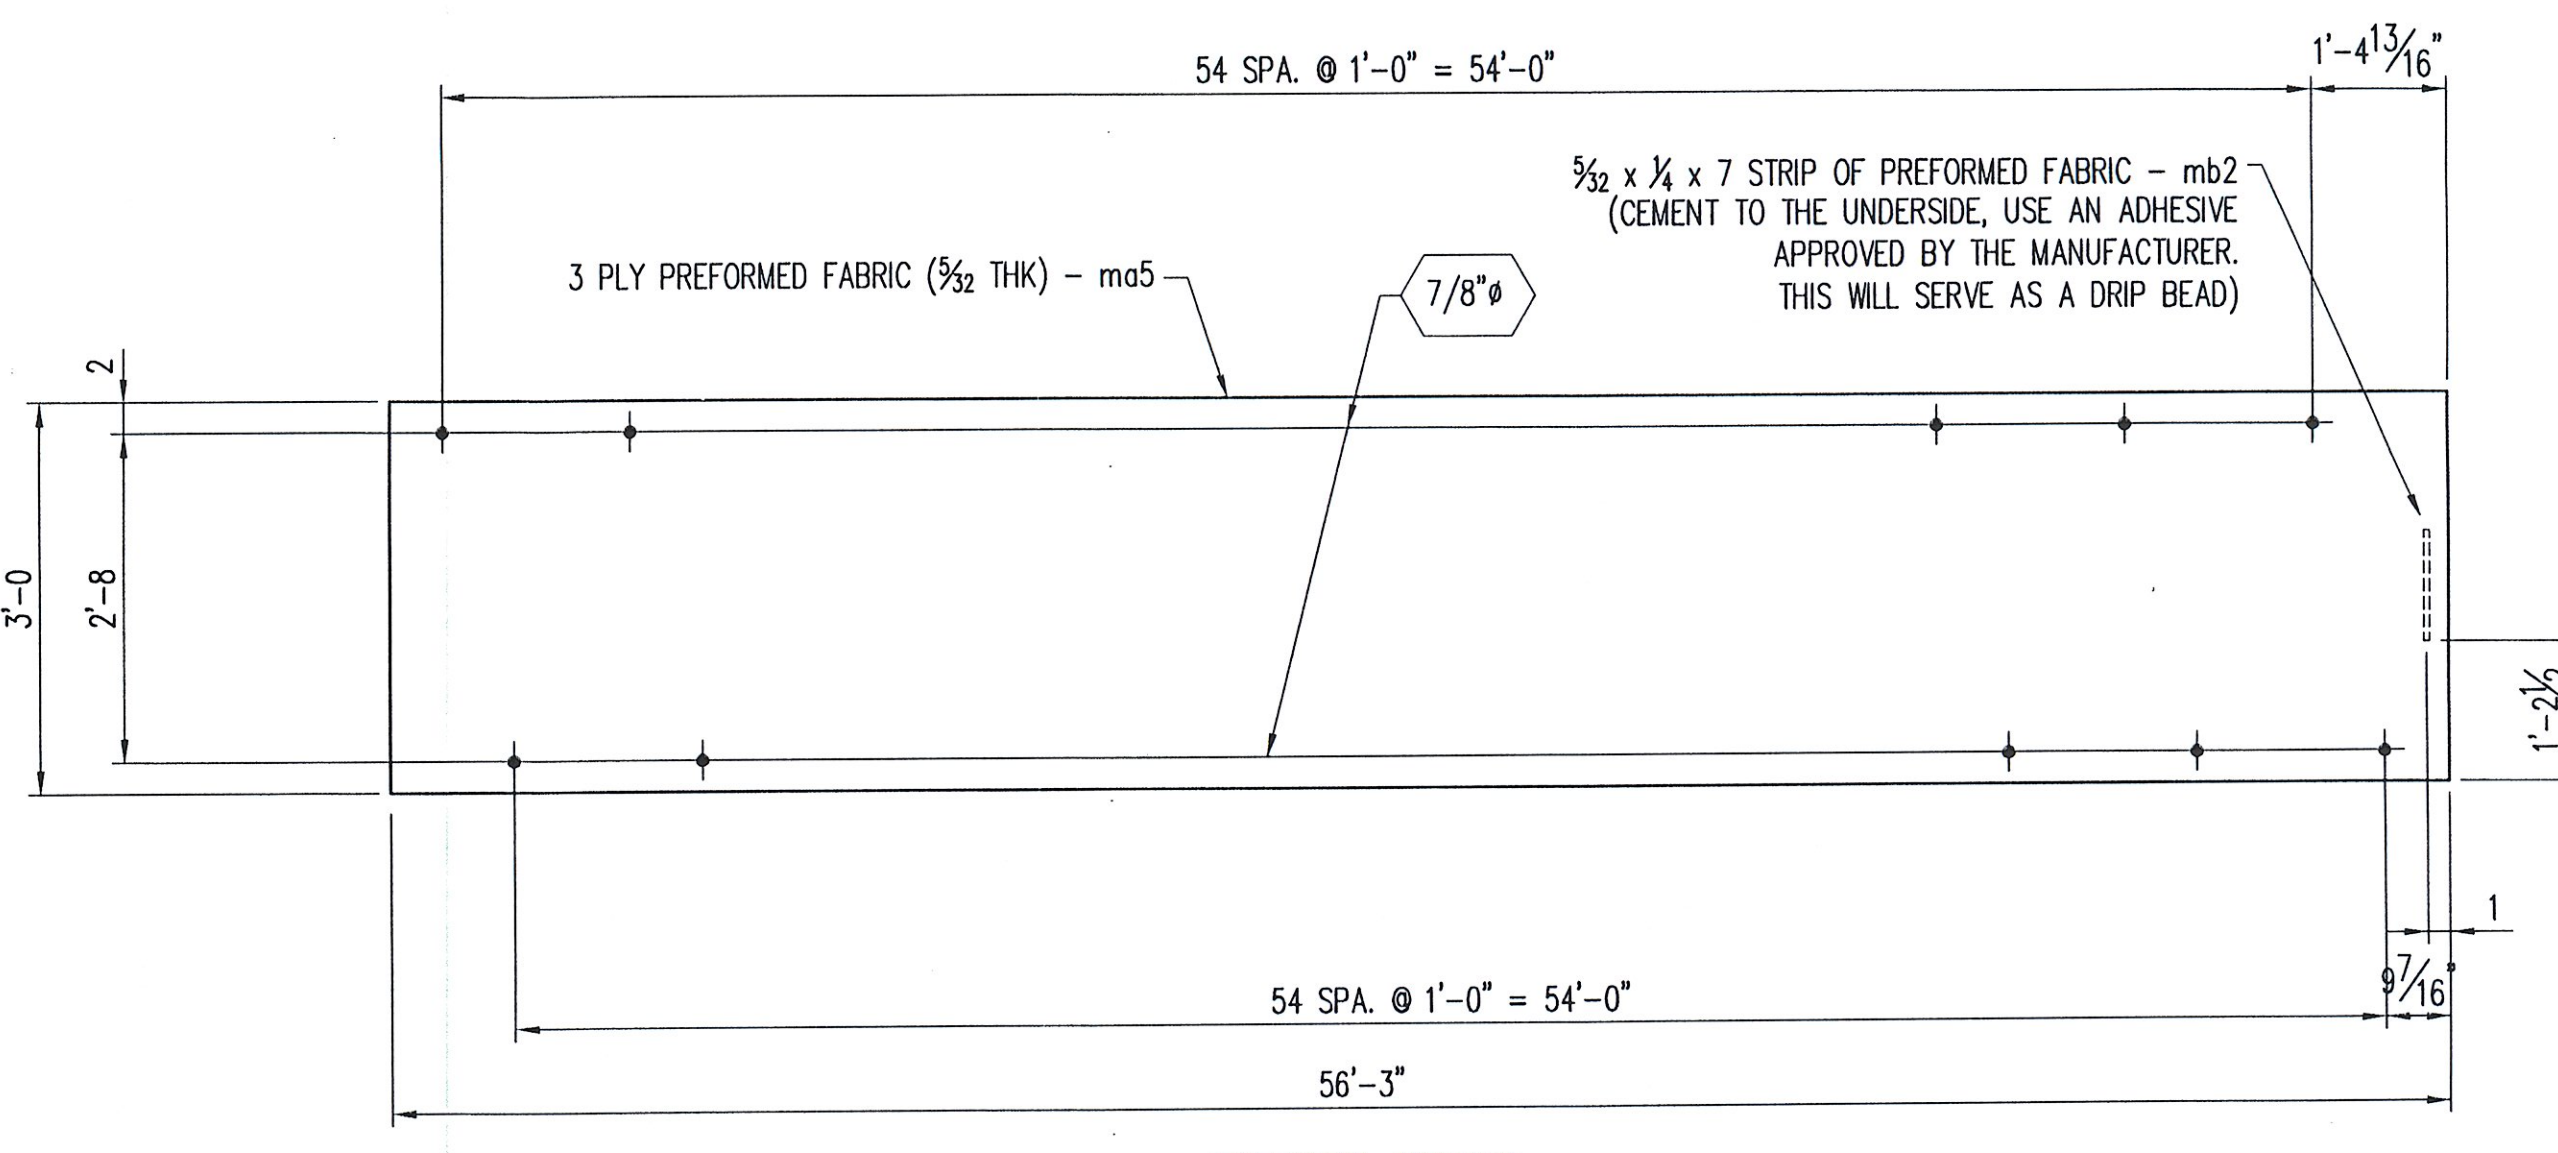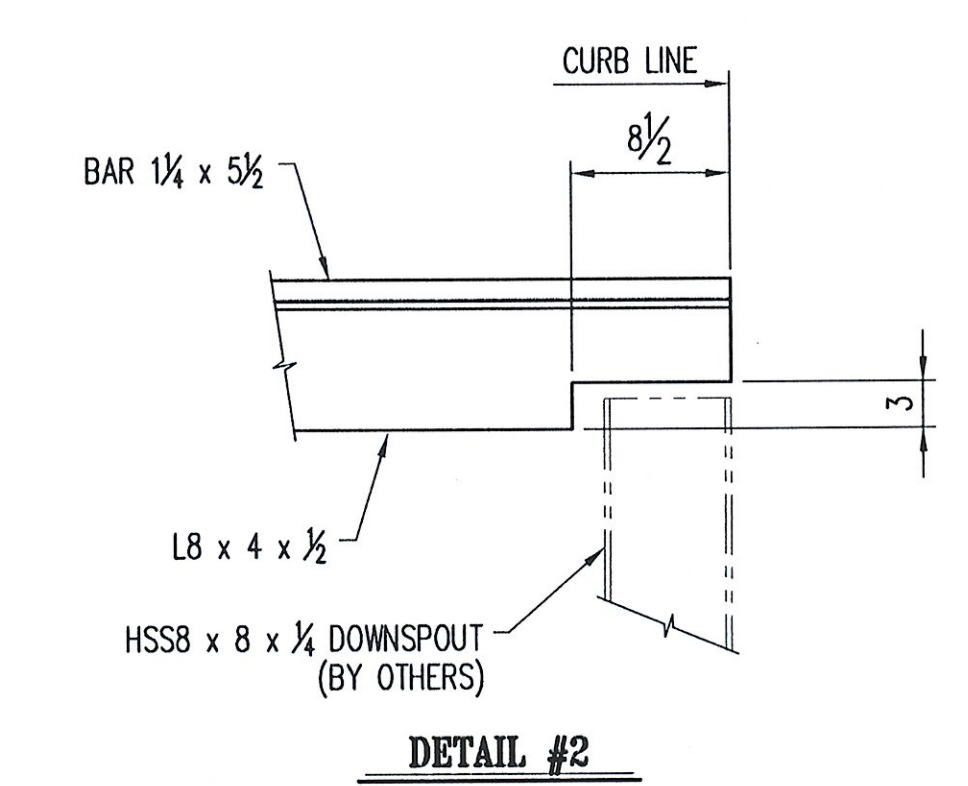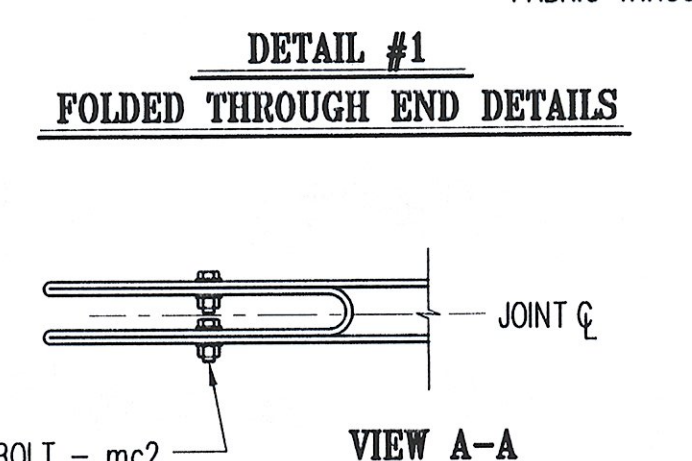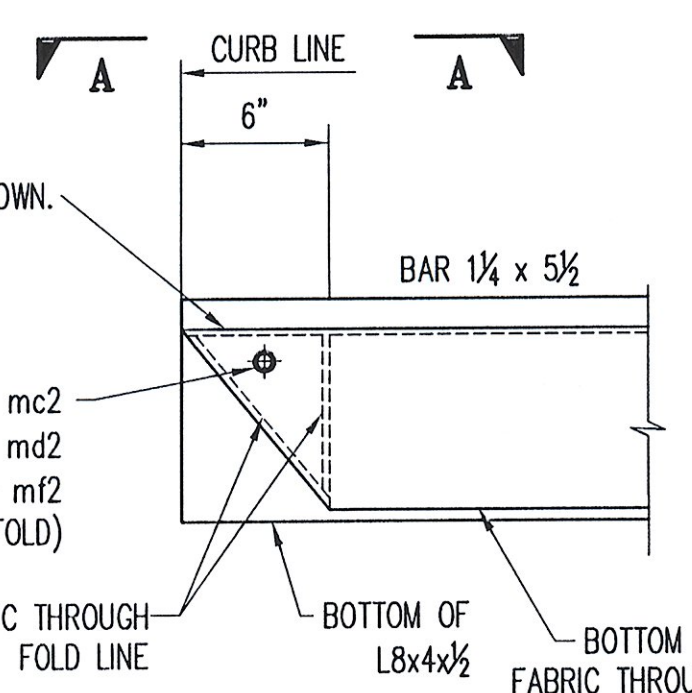

**Niagara Bridge and Rail**  
 4817 Henry Avenue, Niagara Falls, N.Y. 14304  
 Phone: (716) 283-4710 Fax: (716) 283-5137

Project Information:  
 STATE: VERMONT  
 COUNTY: BERLIN  
 CITY / TOWNSHIP: BERLIN  
 LOCATION: I-89 (NB & SB) OVER VT ROUTE 12  
 PROJECT NO.: 1M 089-1 (20)  
 OWNER: VT-AOT  
 CONTRACTOR:

Drawn By: JJB Date: 3/28/08 Checked By: TFW Date: 3/30/08  
 Description: VERMONT - EXPANSION JOINT DETAIL  
 EXPANSION JOINT @ PIER 4  
 Sheet No.: 5 of 5 Scale: NONE  
 Drawing No.: 10064-01 Rev No.: 1

RECEIVED  
 CKD BY: LSS OKD BY: RSY  
 MAY - 7 2008  
 RESUBMIT APPROVED As Noted  
 BY: GPW DATE: 5/8/08

PROJECT NAME \_\_\_\_\_  
 QUALIFIED JOINT WELDING PROCEDURE PROJECT NUMBER \_\_\_\_\_  
 PROCEDURE SPECIFICATION \_\_\_\_\_

Material specification A36/A572-65RR  
 Welding process FCAW  
 Manual or machine SEMI-AUTOMATIC  
 Position of welding FLAT for groove welds Horizontal for fillet welds 1G, 2F  
 Filler metal specification AWS 5.20  
 Filler metal classification ALLOY RODS SHAL SHIELD T1 T1 MILTR (E71T-1)  
 Flux N/A  
 Shielding gas CO<sub>2</sub> Flow rate 25 CFH  
 Single or multiple pass SINGLE AND MULTIPLE  
 Single or multiple arc SINGLE ELECTRICAL STICK-OUT 3/8"-5/8"  
 Welding current DC  
 Polarity REVERSE  
 Welding progression N/A  
 Root treatment NONE  
 Preheat and interpass temperature 50° to 250° F (10° to 150° C) MIN  
 Postheat treatment NONE  
 Supported by PQR 007 and 008

WELDING PROCEDURE \_\_\_\_\_  
 DATE \_\_\_\_\_  
 JWC

Pass no.	Electrode size	Welding current		Travel speed (IPM)	Weld size (in)	RESUBMIT Joint detail BY DATE	APPROVED DATE
		Amperes	Volts				
GROOVE WELDS							
1	.045	220-240	26-28	16-18	3/16"		AUG 19 2008 9/11/08
1	.045	220-240	26-28	10-12	1/4"		
all	.045	220-240	26-28	14-16	5/16"		
FILLET WELDS							
FILLET WELDS SHALL EQUAL 1/4 OF t							
BUT NOT MORE THAN 3/8"							
SEE PROCEDURE DS-16 FOR PARAMETERS OF FILLET WELDS							

This procedure may vary due to fabrication sequence, fit-up, pass size, etc., within the limitation of variables given in Section 5.

Procedure no. DS-13 Contractor Merrimack Sheet Metal, Inc.  
 Revision no. \_\_\_\_\_ Authorized by Scott Blundetto  
 Form E-2 Date 1/26/01

PROJECT NAME \_\_\_\_\_  
 PROJECT NUMBER \_\_\_\_\_  
 PREQUALIFIED JOINT WELDING PROCEDURE PROJECT NUMBER \_\_\_\_\_  
 PROCEDURE SPECIFICATION

Material specification A36-A572-A588  
 Welding process FCM  
 Manual or machine SEMI-AUTOMATIC  
 Position of welding FLAT OR HORIZONTAL  
 Filler metal specification AWS 5.20  
 Filler metal classification ALLOY RODS DUAL SHIELD TT 71 ULTRA (E71T-1)  
 Flux N/A  
 Shielding gas CO<sub>2</sub> Flow rate 35 CFH  
 Single or multiple pass SINGLE AND MULTIPLE  
 Single or multiple arc SINGLE ELECTRICAL STICK-OUT 3/8" - 3/4"  
 Welding current DC  
 Polarity REVERSE  
 Welding progression N/A  
 Root treatment NONE  
 Preheat and interpass temperature 50 TO 275 F (10 TO 213 C)  
 Postheat treatment NONE  
 Supported by WPS\_007\_and\_008

RECEIVED  
 TRANS  
 OK'D BY \_\_\_\_\_ OK'D BY JWC

Pass no.	Electrode size	Welding current		Travel speed (IPM)	Weld size (in)	APPROVED by _____ DATE <u>7/4/08</u>
		Amperes	Volts			
1	.045	220-240	26-28	16-18	3/16"	
1	.045	220-240	26-28	12-13	1/4"	
All	.045	210-230	25-27	9-10	5/16"	
1	.045	220-240	26-28	16-18	3/8" (3 passes)	
2	.045	220-240	26-28	16-18		
3	.045	220-240	26-28	16-18		
1	.045	210-230	25-27	9-11	7/16" (3 passes)	
2	.045	210-230	25-27	9-11		
3	.045	210-230	25-27	9-11		

This procedure may vary due to fabrication sequence, fit-up, pass size, etc., within the limitation of variables given in Section 5.

Procedure no. DS-16 Contractor Merrimack Sheet Metal, Inc.  
 Authorized by [Signature]  
 Revision 1/2/07

PROJECT NAME BELVIN  
 PROJECT NUMBER 11261-102

PREQUALIFIED JOINT WELDING PROCEDURE PROJECT NUMBER 11261-102  
 PROCEDURE SPECIFICATION

Material specification A36, A572, A588 SINGLE PASS ONLY TO A-635 (section)  
 Welding process FCAW  
 Manual or machine SEMI AUTOMATIC  
 Position of welding FLAT OR HORIZONTAL  
 Filler metal specification AWS 5.20  
 Filler metal classification ALLOY RODS DUAL SHIELD TT 71 NITRA (E71T-1)  
 Flux N/A  
 Shielding gas CO2 Flow rate 27-37.5 CFM  
 Single or multiple pass SINGLE  
 Single or multiple arc ELECTRICAL STICK ONT 3/8"-3/4"  
 Welding current DC  
 Polarity REVERSE  
 Welding progression N/A  
 Root treatment NONE  
 Preheat and interpass temperature 255°F CE 65°F 65°C E 75°F 200°F 65°C F  
 Postheat treatment NONE  
 Supported by WPS


WELDING PROCEDURE

Pass no.	Electrode size	Welding current		Travel speed (IPM)	Weld size (IP)	Groove depth	Joint detail
		Amperas	Volts				
1	.045	220-240	26-28	10-12	1/8"	5/16"	

TRANS RECEIVED  
 OK'D BY JUL  
 SEP 04 2008  
 RESUBMIT APPROVED  
 BY JUL DATE 9/4/08

This procedure may vary due to fabrication sequence, fit-up, pass size, etc., within the limitation of variables given in Section 5.


Procedure no. DS-18 Contractor Merrimack Sheet Metal, Inc.  
 Revision no. \_\_\_\_\_ Authorizes by Scott Beal  
 Form 6-2 Date 1126101

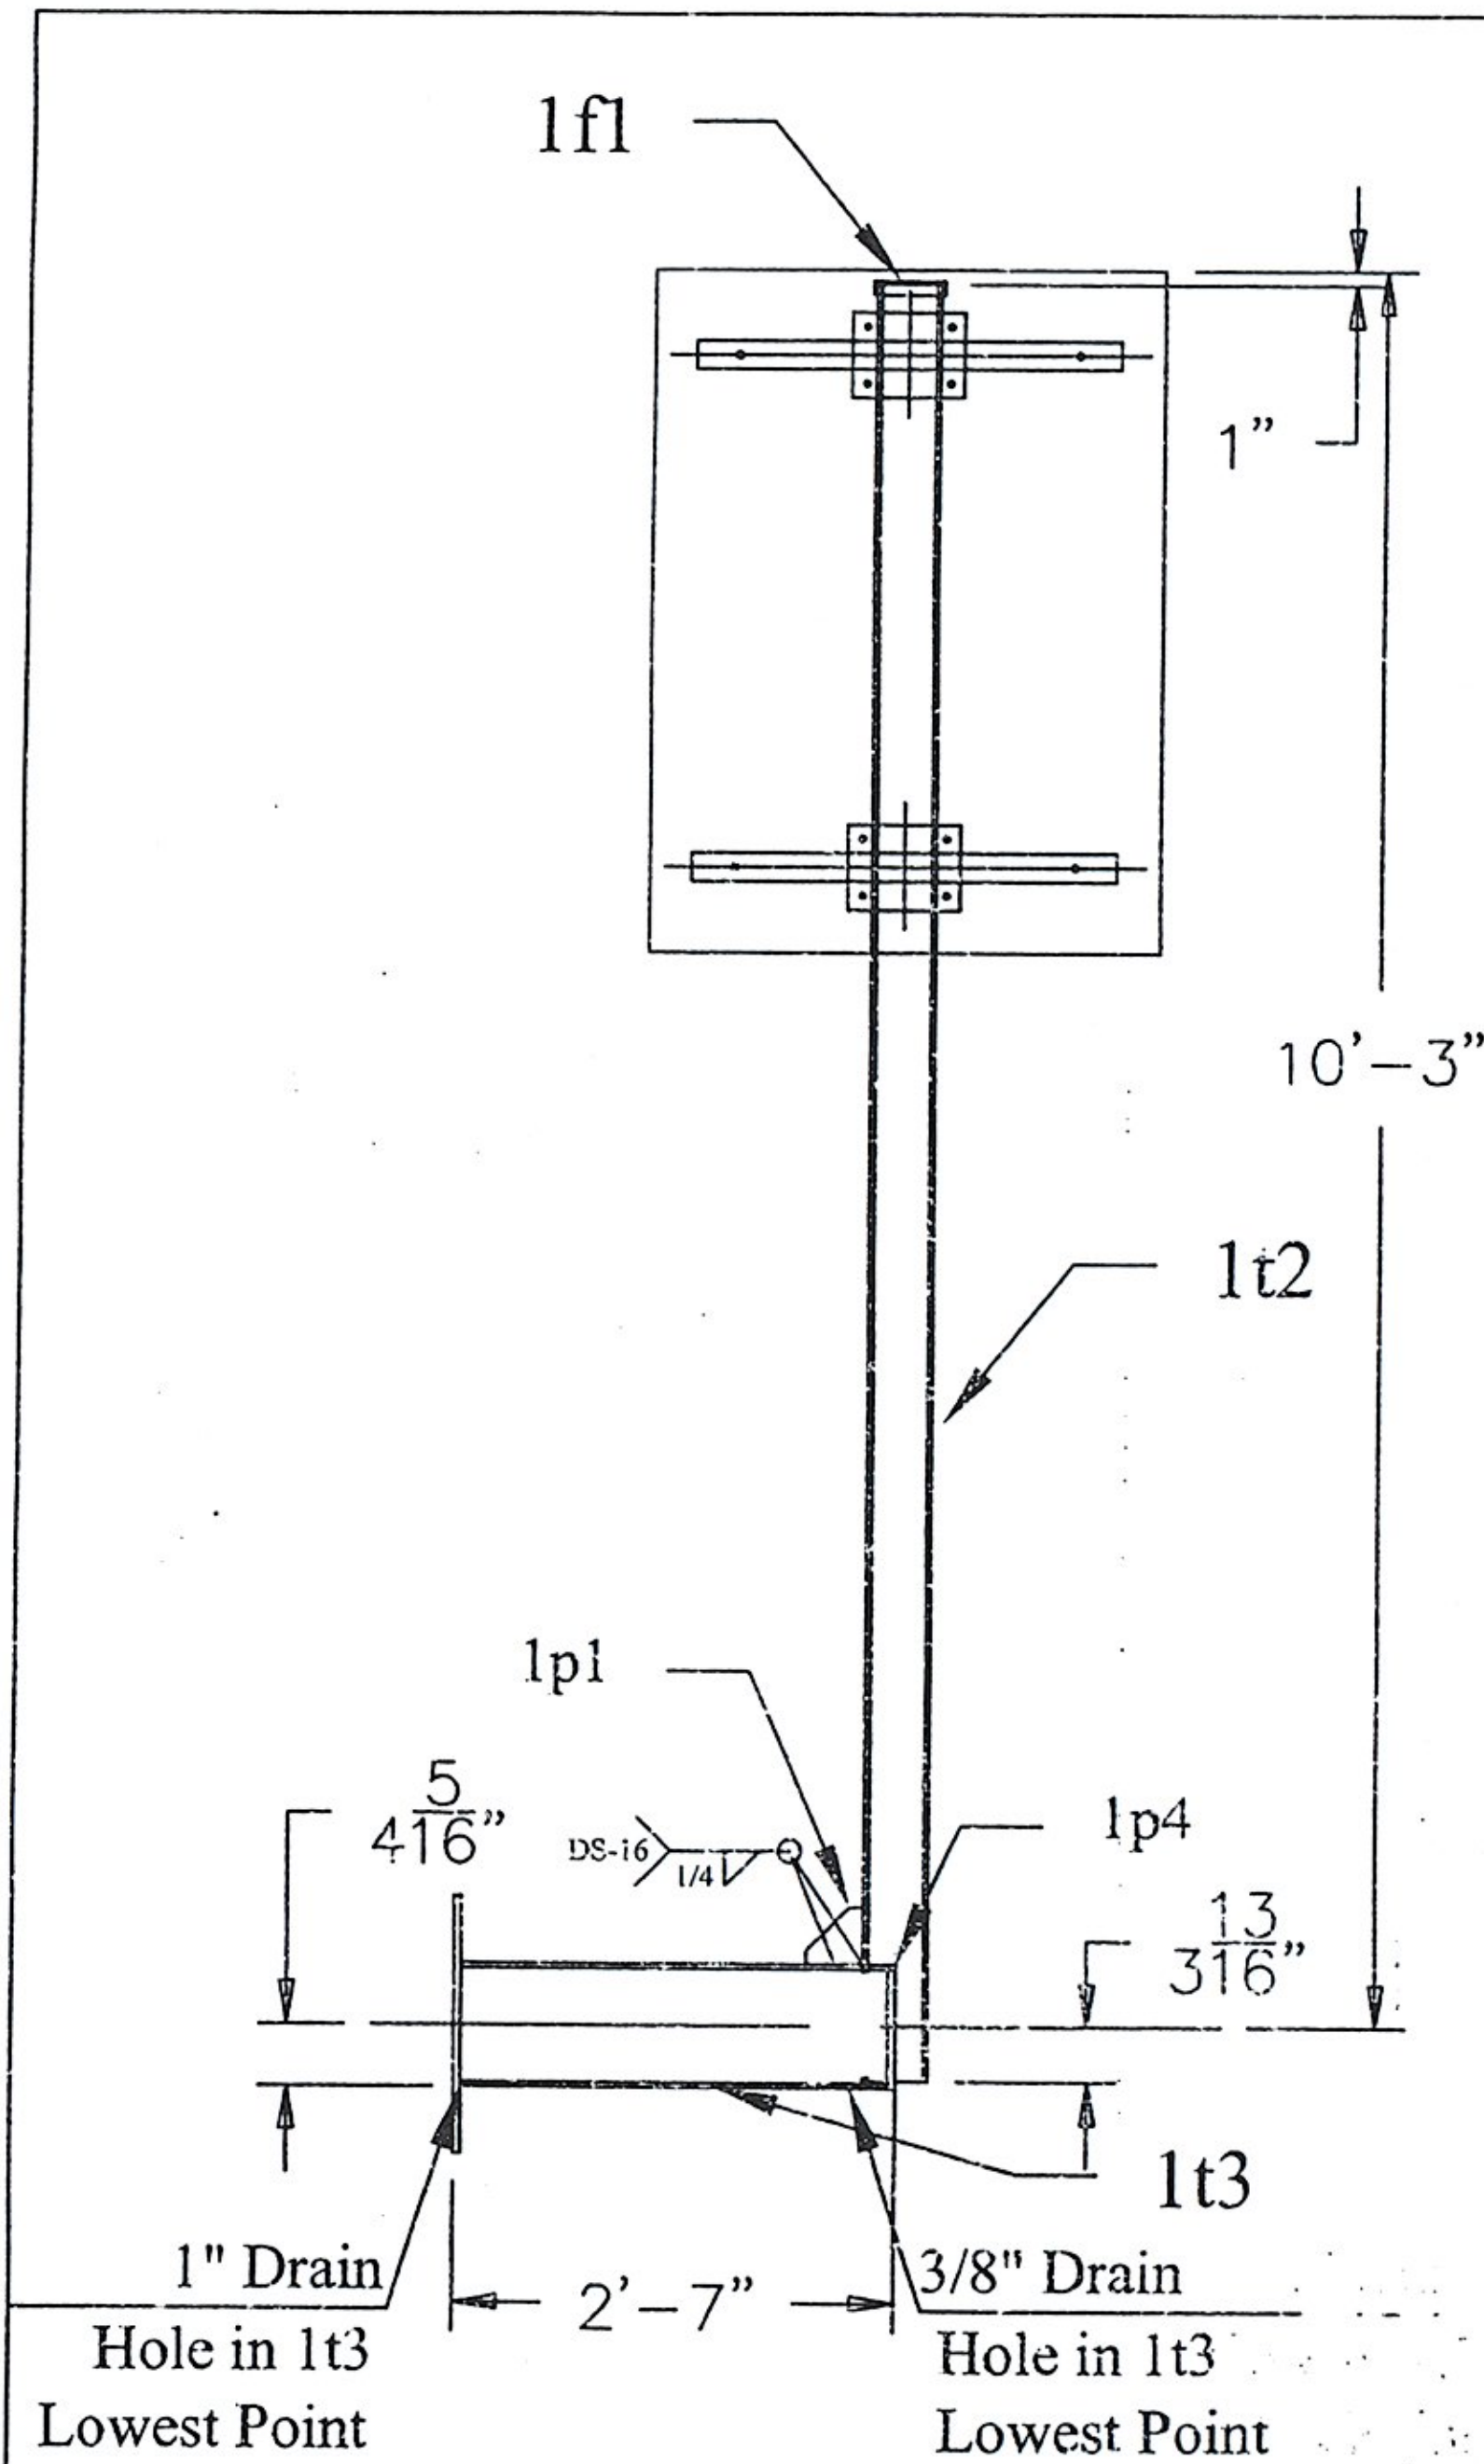


SIDE VIEW

(2) - 1M1 BRIDGE MOUNTED SIGN STRUCTURE


STRUCTURES COPY

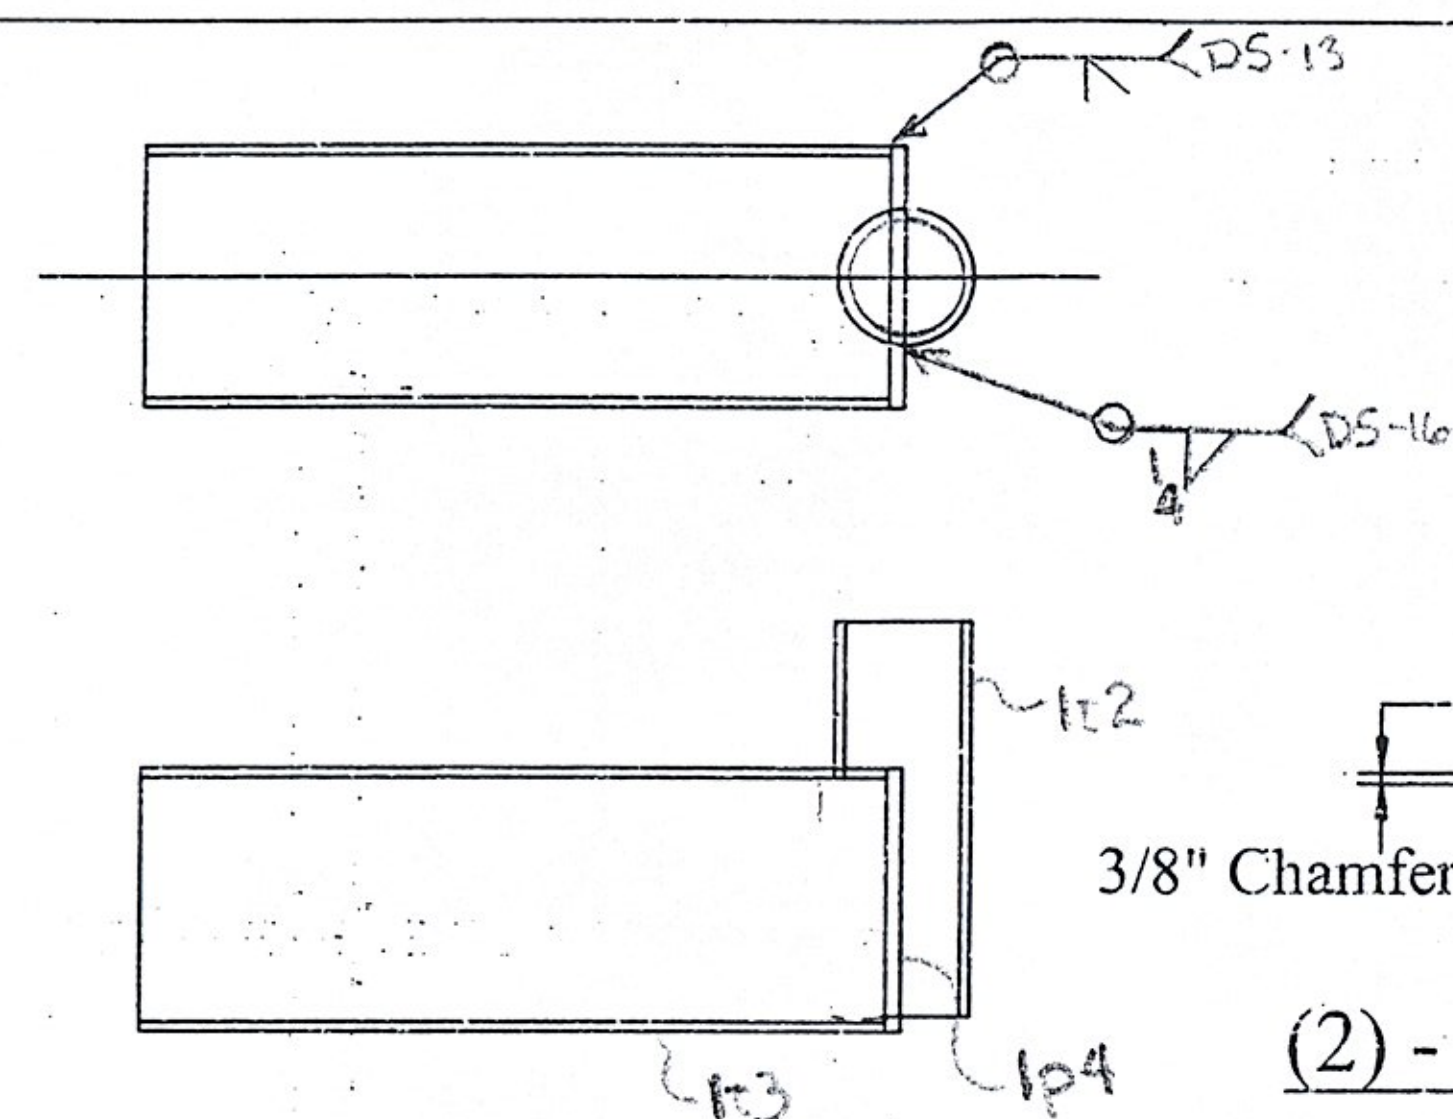



VIEW OF 1t3, 1t2 & 1p4

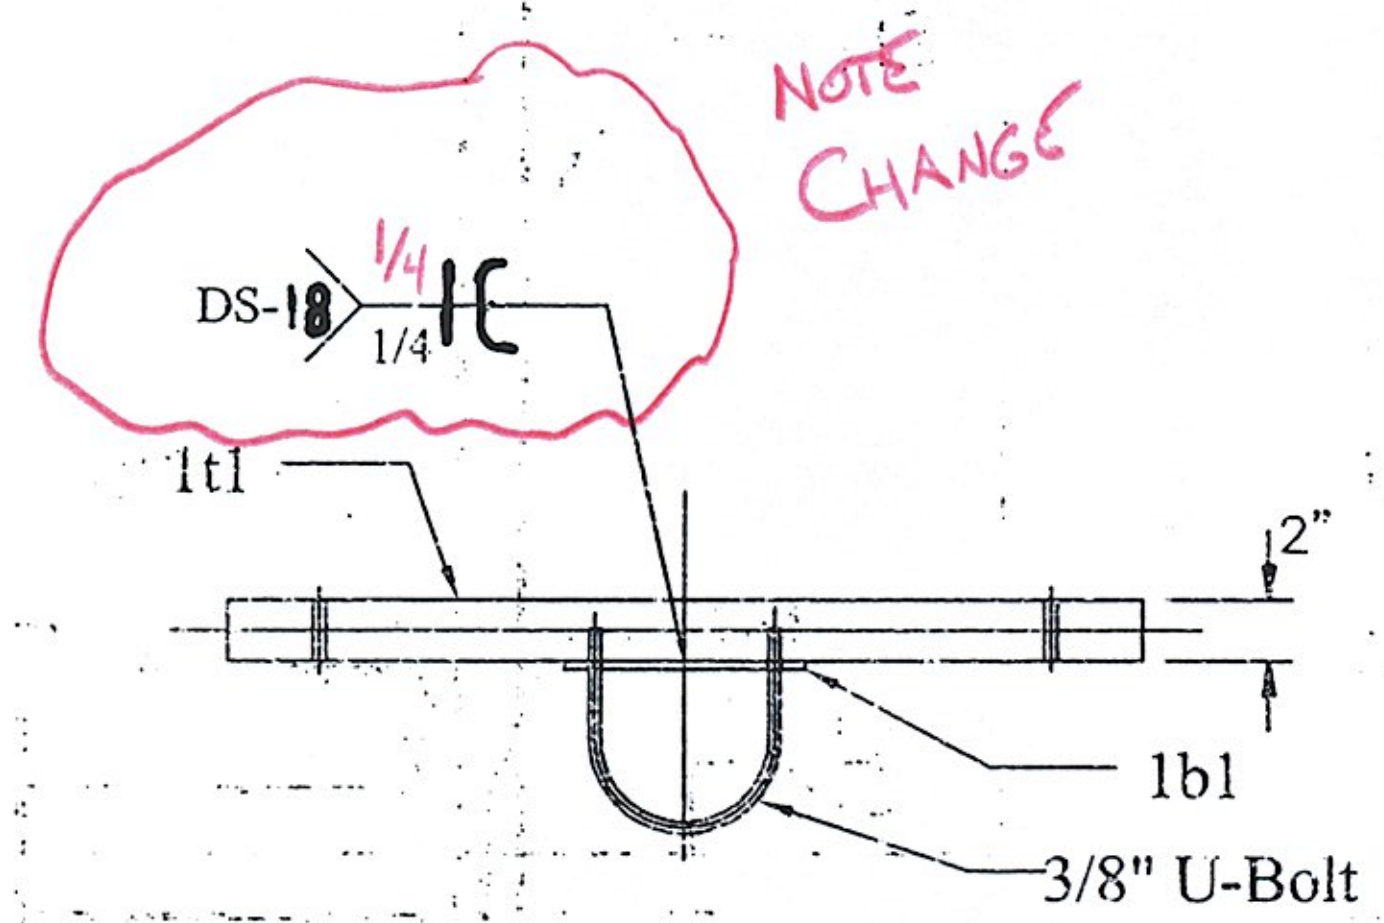


TOP VIEW

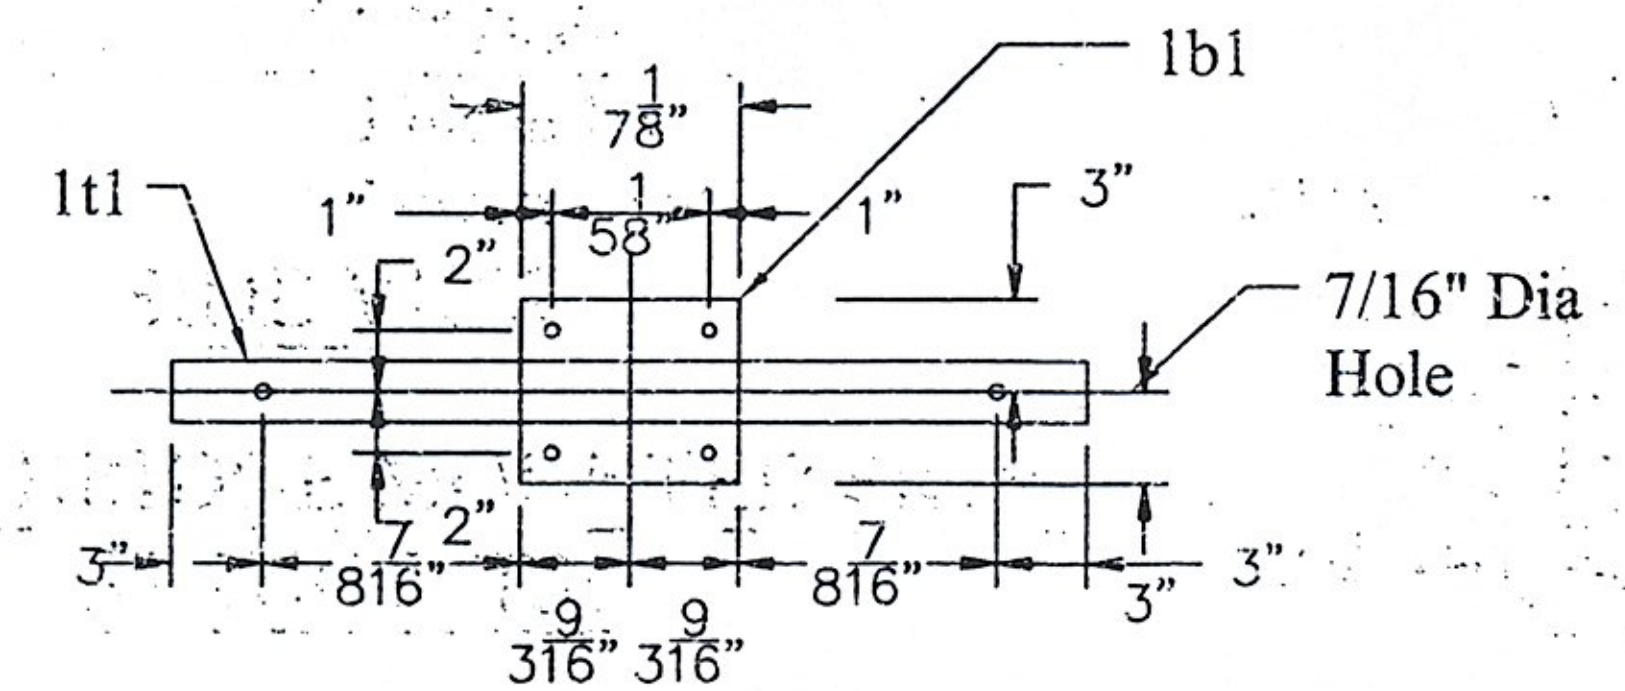

(4) - 1C1 PIPE CLAMP

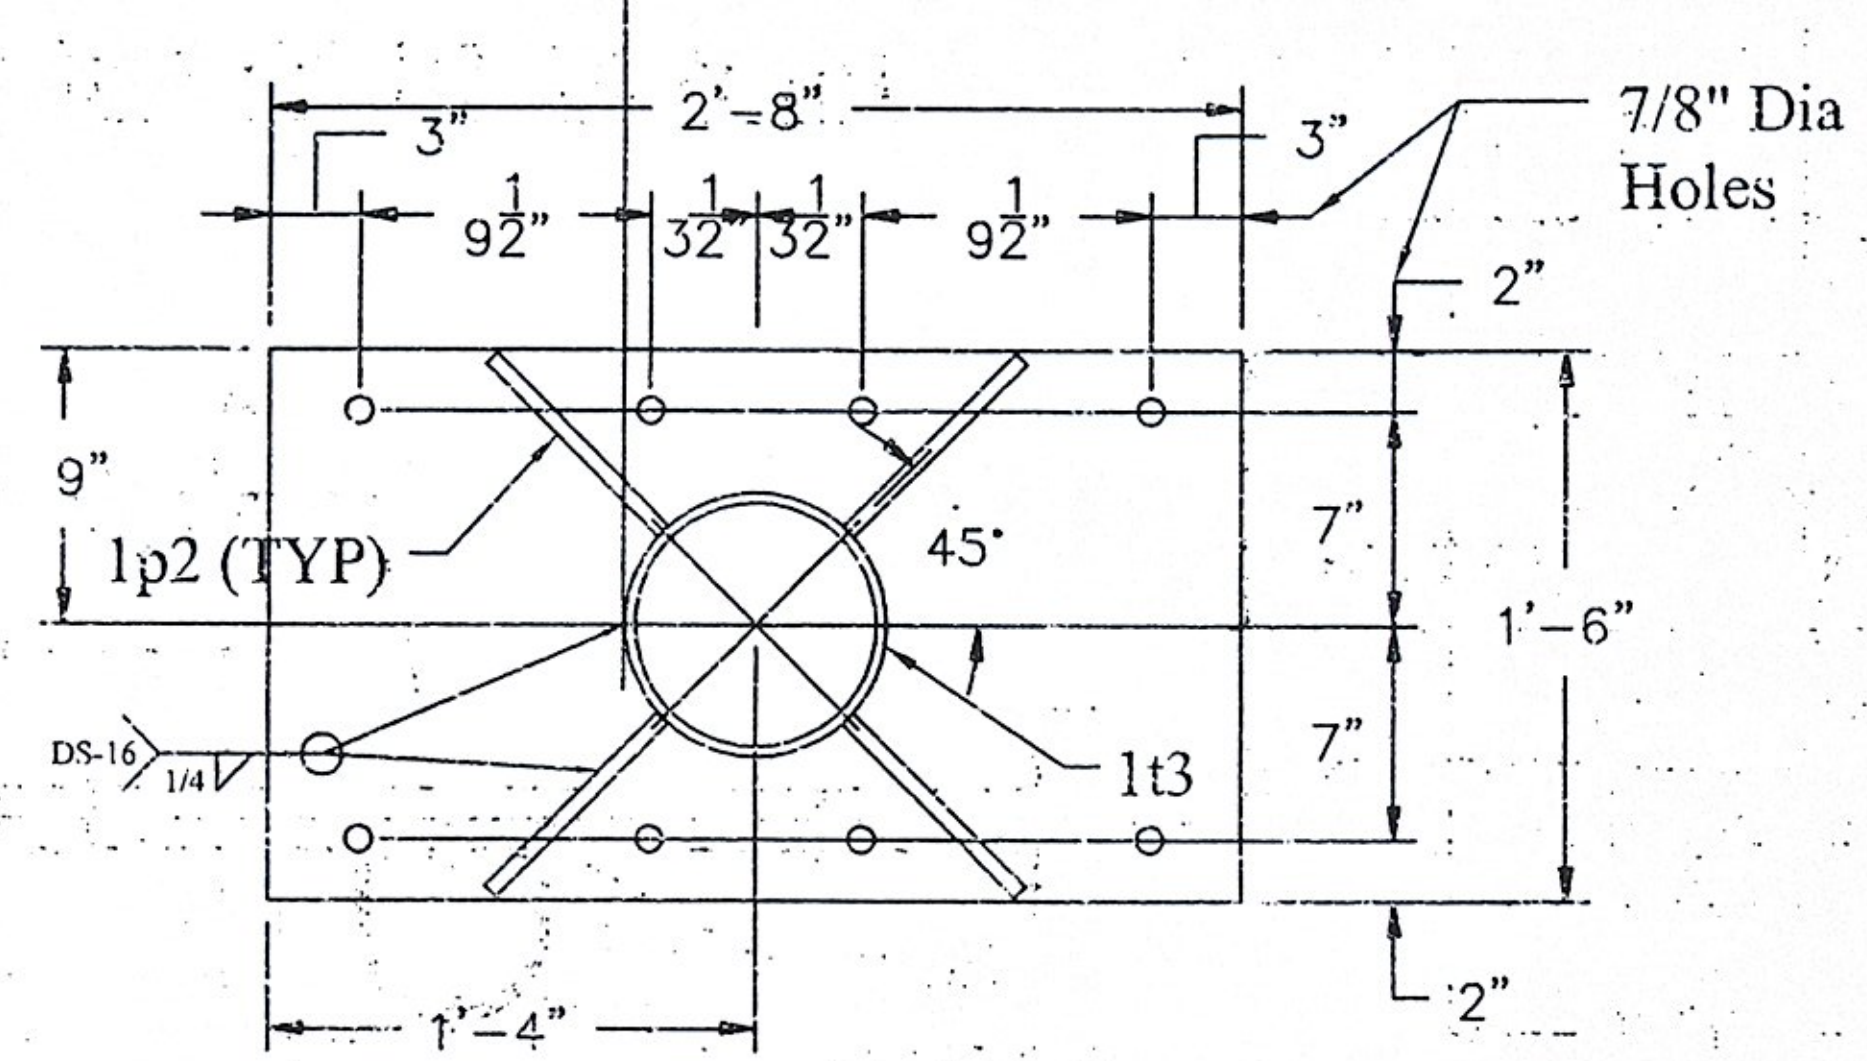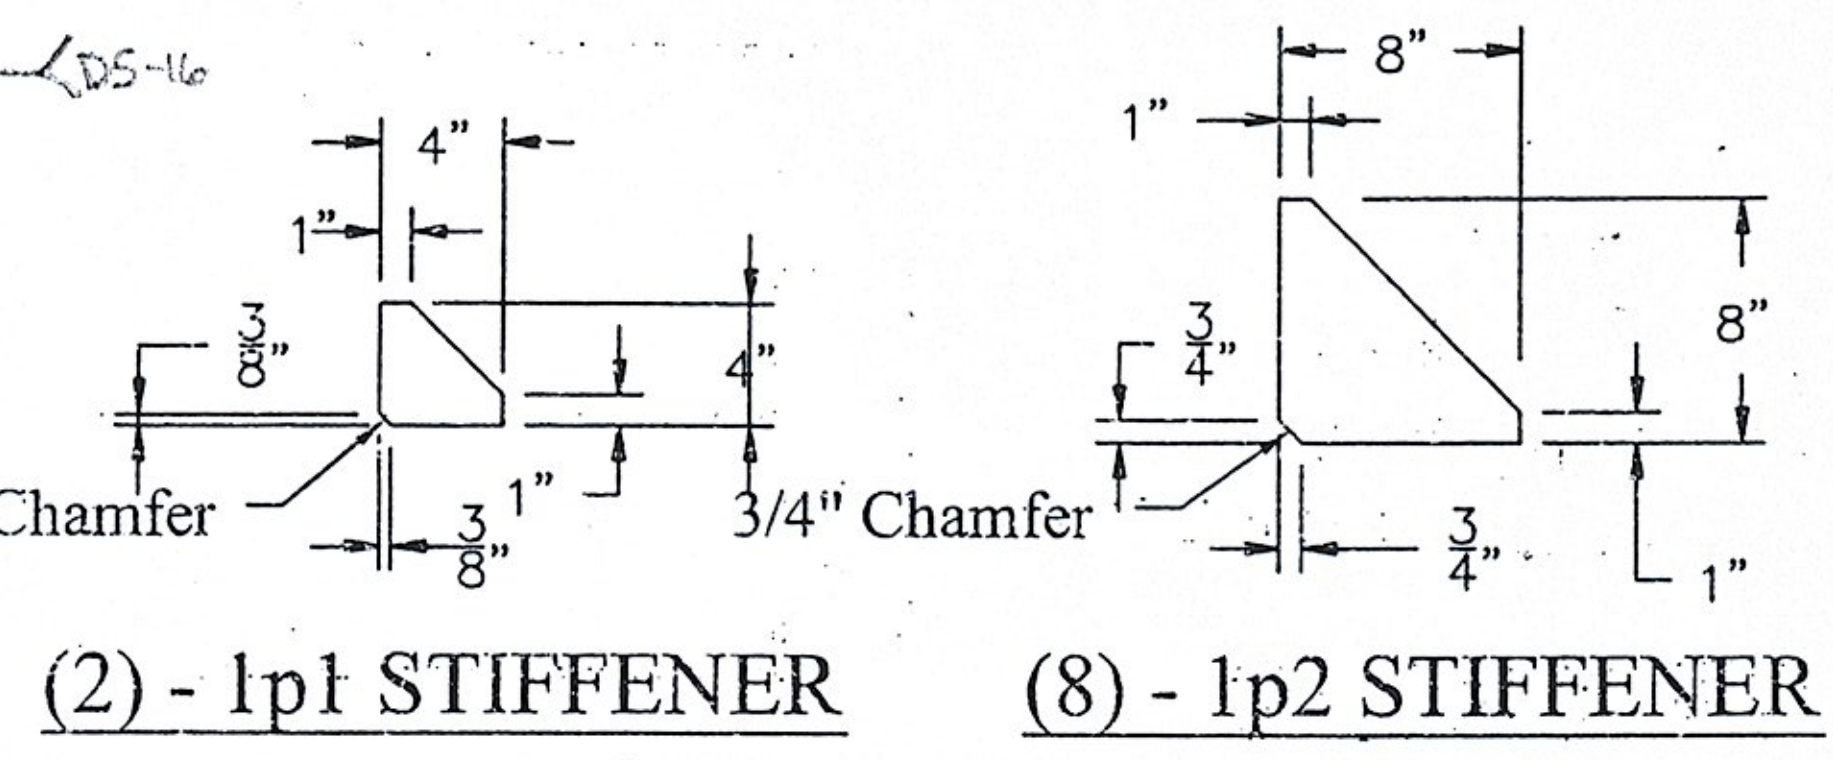

(2) - 1p3 BOLT PLATE

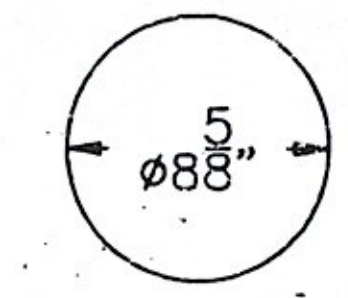

(2) - 1p4 END CAP

BILL OF MATERIALS				
QTY	MARK	SHAPE	LENGTH	REMARKS
4	1C1	PIPE CLAMP ASSEMBLY		
4	1b1	Bar 1/4 x 6	0'-7 1/8"	
4	1t1	Tube 2 x 2 x 3/16	2'-6"	
8		U-Bolt 3/8" x 5 1/8"		
		with 2 Nuts & 2 Washers		
8		3/8" Bolts ButtonHead x 3"		
		with Nut & Washer		
2	1S1	SIGN SUPPORT ASSEMBLY		
2	1f1	Friction Cap 4" Pipe		
2	1p1	Plate 3/8 x 4	0'-4"	
8	1p2	Plate 1/2 x 8	0'-8"	
2	1p3	Plate 1/2 x 1'-6"	2'-8"	
2	1p4	Plate 1/2 x 8 3/8"	0'-8 5/8"	
2	1t2	Pipe 4" x Sched 80	10'-5 7/8"	
2	1t3	Pipe 8" x Sched 40	2'-6"	
8		Bolts 3/4" Squarehead x 9"		
		1 3/4" Flat Washer & Lock Nut		
8		Bolts 3/4" Squarehead x 12" Bent		
		1 3/4" Flat Washer & Lock Nut		

NOTES:  
 1. Fabricate sign mounts so sign support is vertical.  
 2. Boils shall be A307.  
 3. Pipe and structural tubing shall be ASTM A500, Grade B. Plates shall be ASTM A572, Grade 50.  
 4. Sign support shall be galvanized after fabrication.  
 5. 1/4" R CHAMFERED PLATE TO GALV.

RECEIVED  
 DRAWN BY: \_\_\_\_\_ CHECKED BY: RST  
 AUG 19 2008  
 RESUBMITTED BY: \_\_\_\_\_ APPROVED: AS Noted  
 BY: CPW DATE: 9/4/08

REV NO.	DATE	DESCRIPTION
1	8-1-2008	REVISED PER APPROVAL COMMENTS
0	3-14-2008	SUBMITTED FOR APPROVAL


HOLES AS NOTED  
 MATERIAL: ASTM A572, GRADE 50 GALV

DRAWING COVERS	
PROJECT	BERLIN IM 089-1(20)
LOCATION	1-89
ENGINEER	VERMONT AGENCY OF TRANSPORTATION
CUSTOMER	BECK & BELUCI, INC.

MERRIMACK SHEET METAL  
 119 HALL STREET  
 CONCORD NH 03301  
 Tel. 603.224.7766  
 Fax 603.224.7925

DRAWN BY: RL  
 CHECKED BY: JD  
 JOB NO: #2004  
 DWG: F1

RECEIVED  
 OK'D BY JSS OK'D BY N.Y.  
 SEP 16 2008  
 RESUBMIT \_\_\_\_\_ APPROVED   
 BY OPW DATE 9/16/08

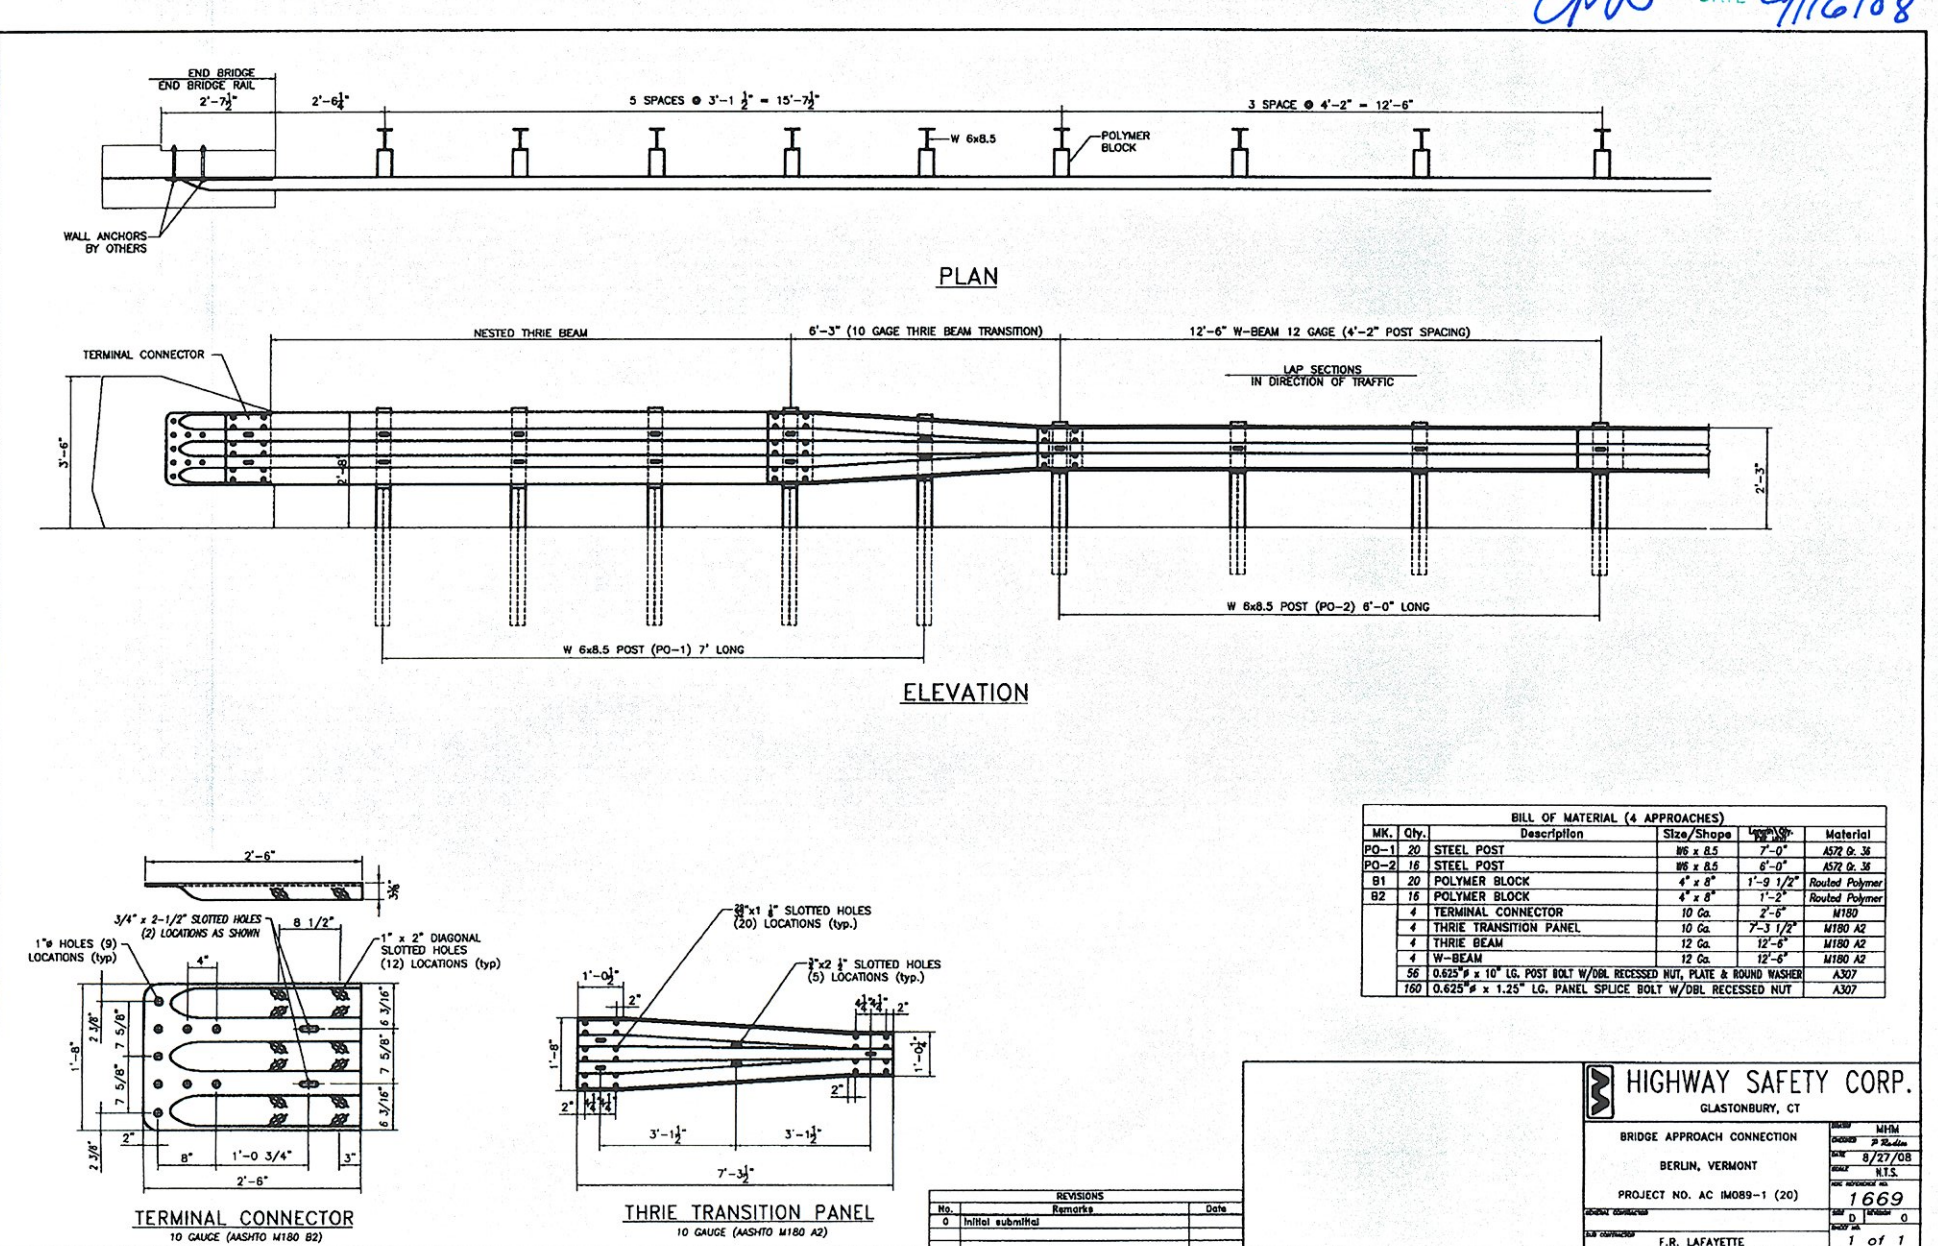

BILL OF MATERIAL (B APPROXIMATE)

NO.	QTY	DESCRIPTION	UNIT	APPROXIMATE QUANTITY	REMARKS
1	1	STEEL POST	EA	1	12" W. BROW IS CASE
2	1	STEEL POST	EA	1	12" W. BROW IS CASE
3	1	POLYMER BLOCK	EA	1	12" W. BROW IS CASE
4	1	TERMINAL CONNECTOR	EA	1	12" W. BROW IS CASE
5	1	THRU TRANSITION PANEL	EA	1	12" W. BROW IS CASE
6	1	W. WALLS	EA	1	12" W. BROW IS CASE
7	1	W. WALLS	EA	1	12" W. BROW IS CASE
8	1	W. WALLS	EA	1	12" W. BROW IS CASE
9	1	W. WALLS	EA	1	12" W. BROW IS CASE
10	1	W. WALLS	EA	1	12" W. BROW IS CASE

HIGHWAY SAFETY CORP.  
 GILBERTOWN, CT  
 PROJECT NO. AC 8088-1 (2)  
 DATE: 9/16/08  
 BY: J.S.S.  
 CHECKED: N.Y.  
 APPROVED: \_\_\_\_\_

Vermont Agency of Transportation  
Materials & Research Laboratory

Page: 4/


Approved products listing

Date printed: 4/16/2008  
Last revision: 4/15/2008


Material Spec. No.: 728.01(d), Guard Rail Posts and Post Accessories - Alternate Blockouts Certification required: None Const. section nos.: 621

Product	Manufacturer	Distributor	Jurisdiction	Comments
Polymer Offset Blocks	Mondo Polymer Tech., Inc. P.O. Box 250, State Rt 7 Reno, OH 45773-0250 Tel: (888) 607-4790 FAX: (740) 376-9960	Mondo Polymer Tech., Inc. P.O. Box 250 Reno, OH 45773 Tel: (888)607-4790 FAX: (740)376-9960	Main: Research & Develop. (802)828-2561 Alt: N/A	Recycled Polyethylene. Acceptable for use on steel post guard rail systems installed on the National Highway System per FHWA letter of 03/27/2002.

RECEIVED  
CK'D BY: JSS CK'D BY: JSS  
SEP 16 2008  
RESUBMIT APPROVED ✓  
BY: CPW DATE: 9/16/08

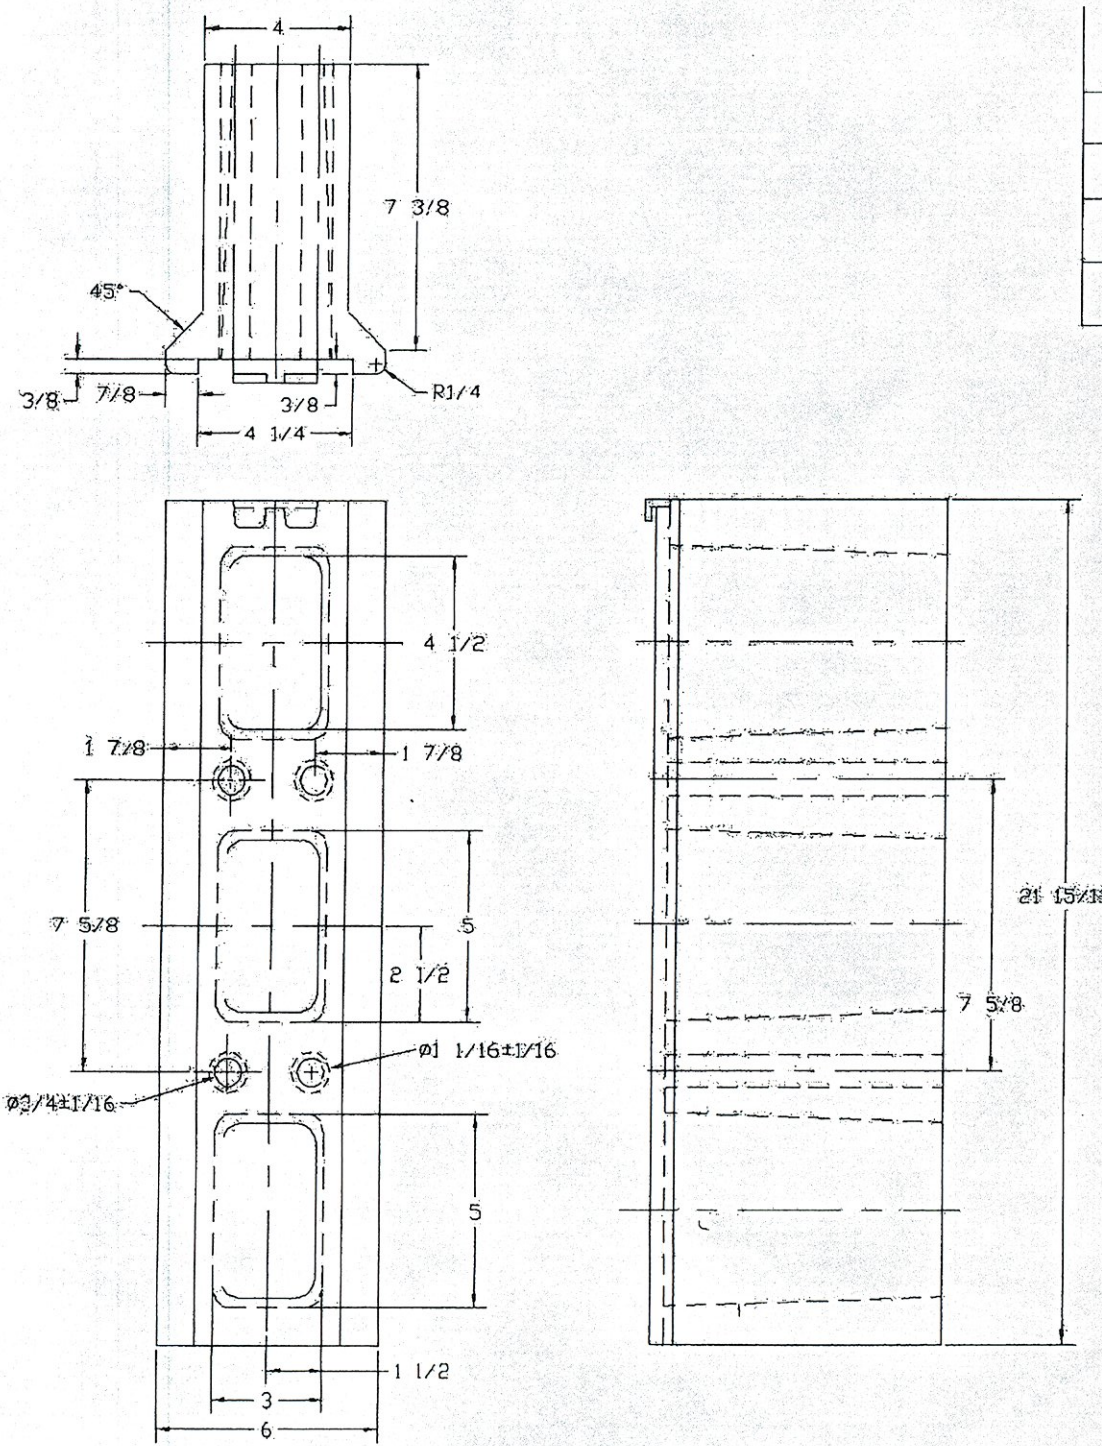

MONDO POLYMER TECHNOLOGIES  
 RECYCLED POLYMER OFFSET BLOCK  
 STEEL POST THRI BEAM MODEL TB21SH  
 P.O. BOX 250 BEND, OH 45773  
 DOCUMENT # 600.008

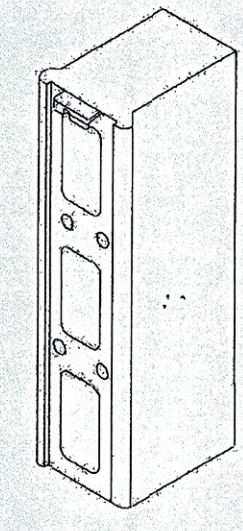

RECEIVED  
 OK'D BY SS OK'D BY R  
 SEP 16 2008  
 RESUBMIT \_\_\_\_\_ APPROVED \_\_\_\_\_  
 BY CPW DATE 9/16/08

All tolerances +/- 1/4" unless otherwise noted