

QUANTITY SHEET



SUMMARY OF ESTIMATED QUANTITIES

ROADWAY	EROSION CONTROL	FULL C.E. ITEMS	QUANTITIES GRAND TOTAL	UNIT	ITEMS	ITEM NUMBER	RND
	150		150	CM	STONE FILL, TYPE I	613.10	EST
400			400	T	BITUMINOUS CONCRETE CURB, TYPE B	616.31	28
2000			2000	M	TREATED TIMBER CURB	616.35	EST
1440			1440	M	REMOVING AND RESETTING CURB	616.40	53
2000			2000	M	REMOVAL OF EXISTING CURB	616.41	EST
545			545	T	BITUMINOUS CONCRETE GUTTERS AND TRAFFIC ISLANDS	616.47	22
440			440	M	CHAIN - LINK FENCE, 1.8 M	620.12	40
144			144	EA	BRACING ASSEMBLY FOR CHAIN - LINK FENCE, 1.8 M	620.21	16
320			320	M	CABLE GUARDRAIL	621.17	22
50900			50900	M	STEEL BEAM GUARDRAIL (GALVANIZED)	621.20	2049
165			165	EA	MANUFACTURED TERMINAL SECTION (FLARED)	621.505	10
4			4	EA	MANUFACTURED TERMINAL SECTION (TANGENT)	621.505	EST
160			160	EA	TRAILING END TERMINAL	621.52	5
2			2	EA	ANCHOR FOR STEEL BEAM RAIL	621.60	EST
7			7	EA	ANCHOR FOR CABLE RAIL	621.65	1
30			30	EA	ANCHOR FOR CABLE RAIL (MOD.)	621.65	EST
190			190	EA	REPLACE GUARDRAIL POST ASSEMBLY	621.76	17
330			330	EA	REPLACE GUARDRAIL BEAM UNIT	621.77	20
370			370	M	ADJUST HEIGHT OF GUARDRAIL	621.79	69
41700			41700	M	REMOVAL AND DISP OF GUARDRAIL	621.80	1647


DETAILED SUMMARY OF QUANTITIES

QUANTITIES	UNIT	ITEMS
		BITUMINOUS CONCRETE CURB, TYPE B
150	T	NORTHBOUND
250	T	SOUTHBOUND
		TREATED TIMBER CURB
1000	M	NORTHBOUND
1000	M	SOUTHBOUND
		REMOVING AND RESETTING CURB
65	M	NORTHBOUND
1375	M	SOUTHBOUND
		REMOVAL OF EXISTING CURB
1000	M	NORTHBOUND
1000	M	SOUTHBOUND
		BITUMINOUS CONCRETE GUTTERS AND TRAFFIC ISLANDS
200	T	NORTHBOUND
345	T	SOUTHBOUND
		CHAIN - LINK FENCE, 1.8 M
220	M	NORTHBOUND
220	M	SOUTHBOUND
		BRACING ASSEMBLY FOR CHAIN - LINK FENCE, 1.8 M
72	EA	NORTHBOUND
72	EA	SOUTHBOUND
		CABLE GUARDRAIL
80	M	NORTHBOUND
240	M	SOUTHBOUND
		STEEL BEAM GUARDRAIL (GALVANIZED)
21400	M	NORTHBOUND
29500	M	SOUTHBOUND

DETAILED SUMMARY OF QUANTITIES

QUANTITIES	UNIT	ITEMS
		MANUFACTURED TERMINAL SECTION (FLARED)
75	EA	NORTHBOUND
90	EA	SOUTHBOUND
		MANUFACTURED TERMINAL SECTION (TANGENT)
2	EA	NORTHBOUND
2	EA	SOUTHBOUND
		TRAILING END TERMINAL
75	EA	NORTHBOUND
85	EA	SOUTHBOUND
		ANCHOR FOR STEEL BEAM RAIL
1	EA	NORTHBOUND
1	EA	SOUTHBOUND
		ANCHOR FOR CABLE RAIL
2	EA	NORTHBOUND
5	EA	SOUTHBOUND
		ANCHOR FOR CABLE RAIL (MOD.)
15	EA	NORTHBOUND
15	EA	SOUTHBOUND
		REPLACE GUARDRAIL POST ASSEMBLY
120	EA	NORTHBOUND
70	EA	SOUTHBOUND
		REPLACE GUARDRAIL BEAM UNIT
190	EA	NORTHBOUND
140	EA	SOUTHBOUND
		ADJUST HEIGHT OF GUARDRAIL
220	M	NORTHBOUND
150	M	SOUTHBOUND
		REMOVAL AND DISP OF GUARDRAIL
17500	M	NORTHBOUND
24200	M	SOUTHBOUND

QUANTITY SHEET
NO. 2

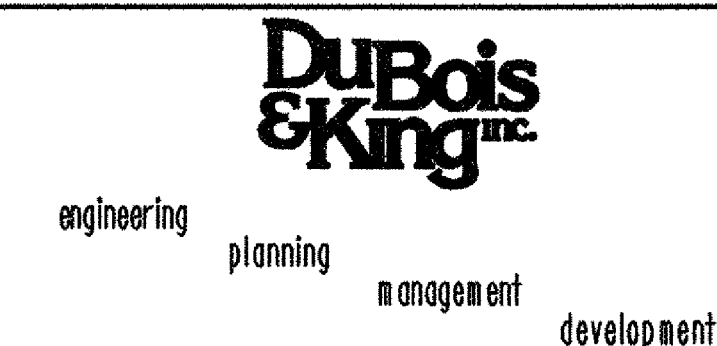

PROJECT NAME: HARTFORD - NEWBURY
PROJECT NUMBER: IM 09I-2(67)

FILE NAME: ... \DGN\ZA042050L.dgn PLOT DATE: 09/25/2006
PROJECT LEADER: C.D. LATHROP DRAWN BY: R.H. BARNES
DESIGNED BY: CHECKED BY: E.P. DETRICK
SHEET 4 OF 32