


# I-91 EXIT #11 HARTFORD (US ROUTE 5) INTERCHANGE

## NORTHBOUND RAMPS

REMOVING AND RESETTING CURB

RAMP "D" 0+021 - 0+120 RT (60M)

**BEGIN PROJECT  
HARTFORD - NEWBURY  
IM 091-2(67)  
MM 69.96**

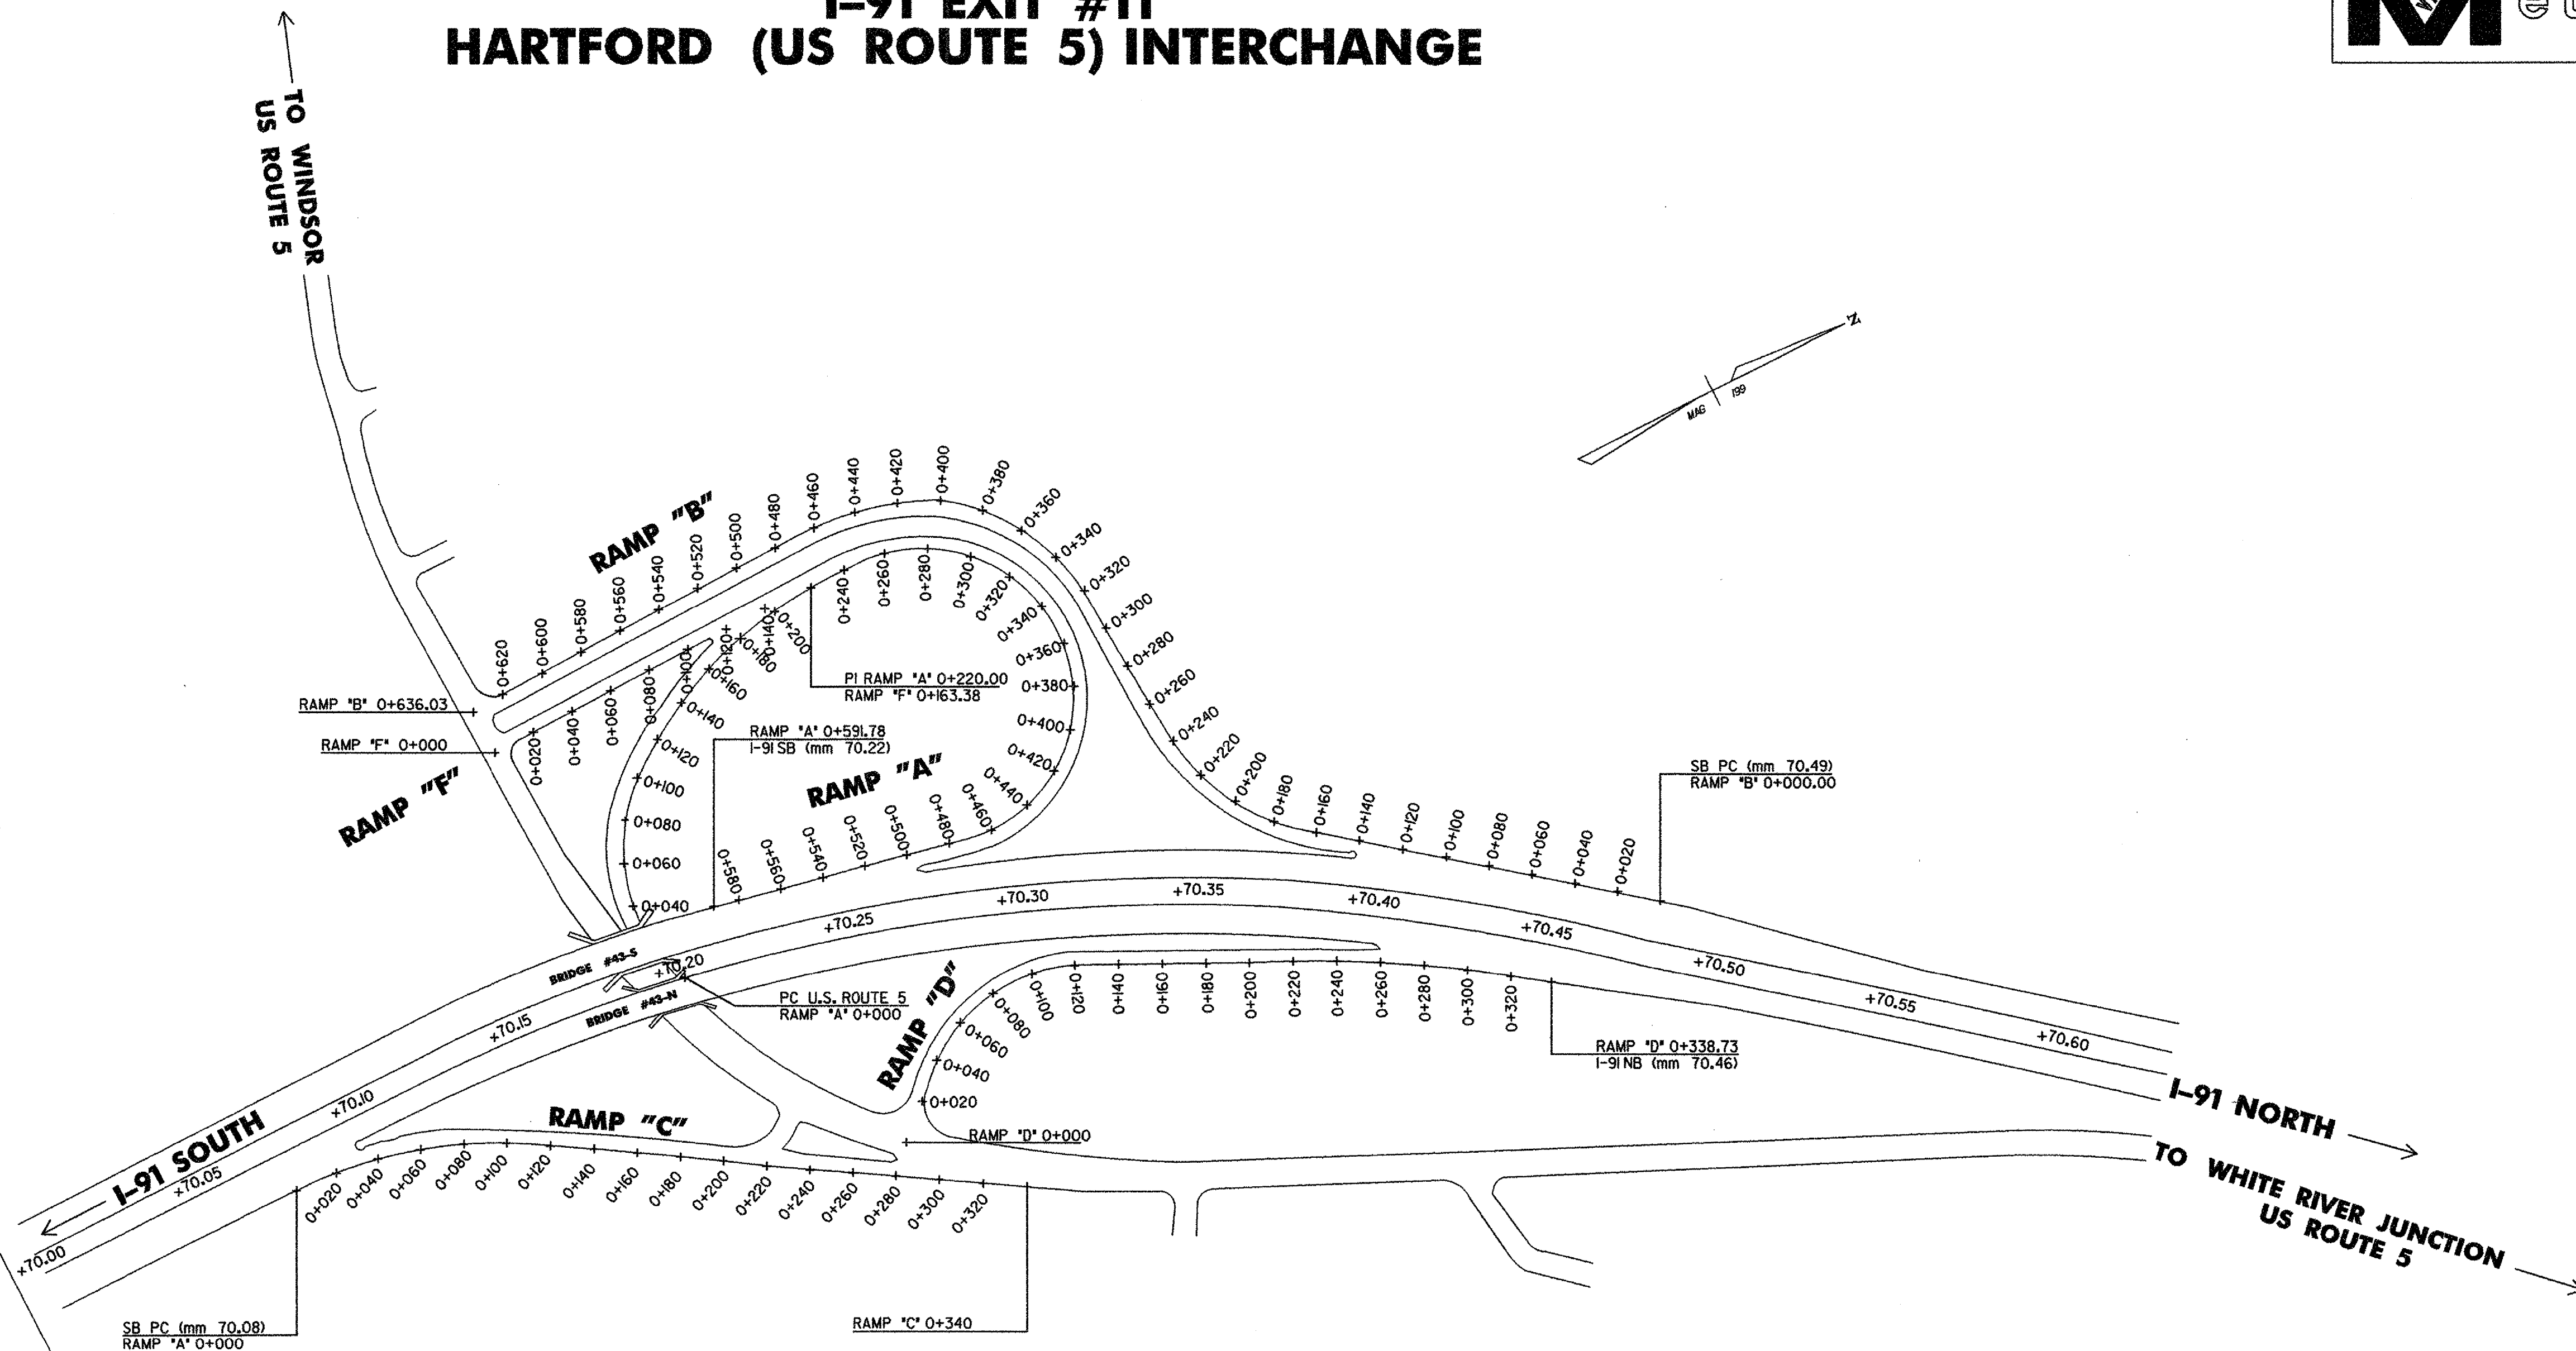

## SOUTHBOUND RAMPS

REMOVAL AND DISPOSAL OF GUARDRAIL

RAMP "B" 0+150 - 0+225 RT (75M)

STEEL BEAM GUARDRAIL (GALVANIZED)

RAMP "B" 0+138 - 0+221 RT (83M)

MANUFACTURED TERMINAL SECTION (FLARED)

RAMP "B" 0+138 RT (1 EA)

TRAILING END TERMINAL

RAMP "B" 0+221 RT (1 EA)

REMOVING AND RESETTING CURB

RAMP "A" 0+240 - 0+500 RT (260M)  
RAMP "A" 0+200 - 0+470 LT (270M)  
RAMP "B" 0+140 - 0+260 RT (120M)  
RAMP "B" 0+140 - 0+160 LT (28M)  
RAMP "B" 0+340 - 0+621 LT (300M)  
RAMP "F" 0+010 - 0+150 LT (140M)

BITUMINOUS CONCRETE GUTTER AND TRAFFIC ISLANDS

RAMP "B" 0+620 LT (1.00T)

AGGREGATE SHOULDERS

RAMP "B" 0+150 - 0+225 RT (11.88 CM)

SUBBASE OF DENSE GRADED CRUSHED STONE

RAMP "B" 0+150 - 0+225 RT (2 CM)  
RAMP "B" 0+620 LT (2 CM)

SEE ITEM DETAIL SUMMARY SHEETS FOR:


621.17 CABLE GUARDRAIL  
621.20 STEEL BEAM GUARDRAIL (GALVANIZED)  
621.205 STEEL BEAM GUARDRAIL, GALVANIZED W/2.4M POSTS  
621.505 MANUFACTURED TERMINAL SECTION (FLARED)  
621.505 MANUFACTURED TERMINAL SECTION (TANGENT)  
621.52 TRAILING END TERMINAL  
621.60 ANCHOR FOR STEEL BEAM GUARDRAIL  
621.65 ANCHOR FOR CABLE RAIL  
621.65 ANCHOR FOR CABLE RAIL (MOD)

## NOTES

- REFER TO GUARDRAIL ITEM DETAIL SHEETS FOR GUARDRAIL ITEMS.
- MILE MARKER INFORMATION ON THIS SHEET IS CONSISTENT WITH VTRANS ROUTE LOGS. FIELD CONDITIONS MAY VARY.

**NOT TO SCALE**

**INTERCHANGE  
NO. 11  
LAYOUT SHEET**

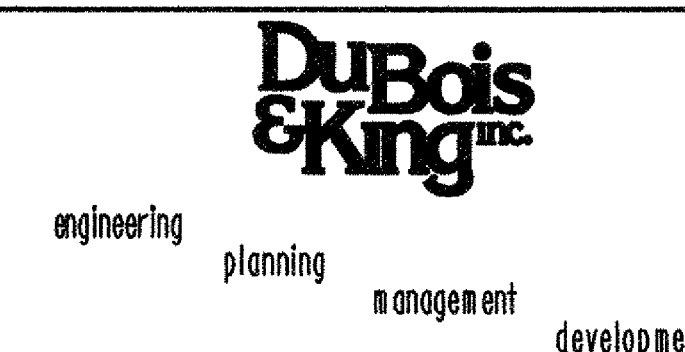

PROJECT NAME: HARTFORD - NEWBURY  
PROJECT NUMBER: IM 091-2(67)

FILE NAME: ... \DGN\z042LA01.dgn  
PROJECT LEADER: C.D. LATHROP  
DESIGNED BY: C.D. LATHROP  
PLOT DATE: 09/25/2006  
DRAWN BY: R. H. BARNES  
CHECKED BY: E.P. DETRICK  
SHEET 24 OF 32