

I-91 EXIT #14 THETFORD (VT ROUTE 113) INTERCHANGE

NORTHBOUND RAMPS

REMOVAL AND DISPOSAL OF GUARDRAIL

RAMP "D" 0+334 - 0+376 RT (42M)

STEEL BEAM GUARDRAIL (GALVANIZED)

RAMP "D" 0+334 - 0+376 RT (27M)

MANUFACTURED TERMINAL SECTION (FLARED)

RAMP "D" 0+334 RT (1 EA)

TRAILING END TERMINAL


RAMP "D" 0+376 RT (1 EA)

AGGREGATE SHOULDERS

RAMP "D" 0+334 - 0+376 RT (10.00 CM)

SEE ITEM DETAIL SUMMARY SHEETS FOR:

- 621.17 CABLE GUARDRAIL
- 621.20 STEEL BEAM GUARDRAIL(GALVANIZED)
- 621.205 STEEL BEAM GUARDRAIL, GALVANIZED W/2.4M POSTS
- 621.505 MANUFACTURED TERMINAL SECTION (FLARED)
- 621.505 MANUFACTURED TERMINAL SECTION (TANGENT)
- 621.52 TRAILING END TERMINAL
- 621.60 ANCHOR FOR STEEL BEAM GUARDRAIL
- 621.65 ANCHOR FOR CABLE RAIL
- 621.65 ANCHOR FOR CABLE RAIL (MOD)

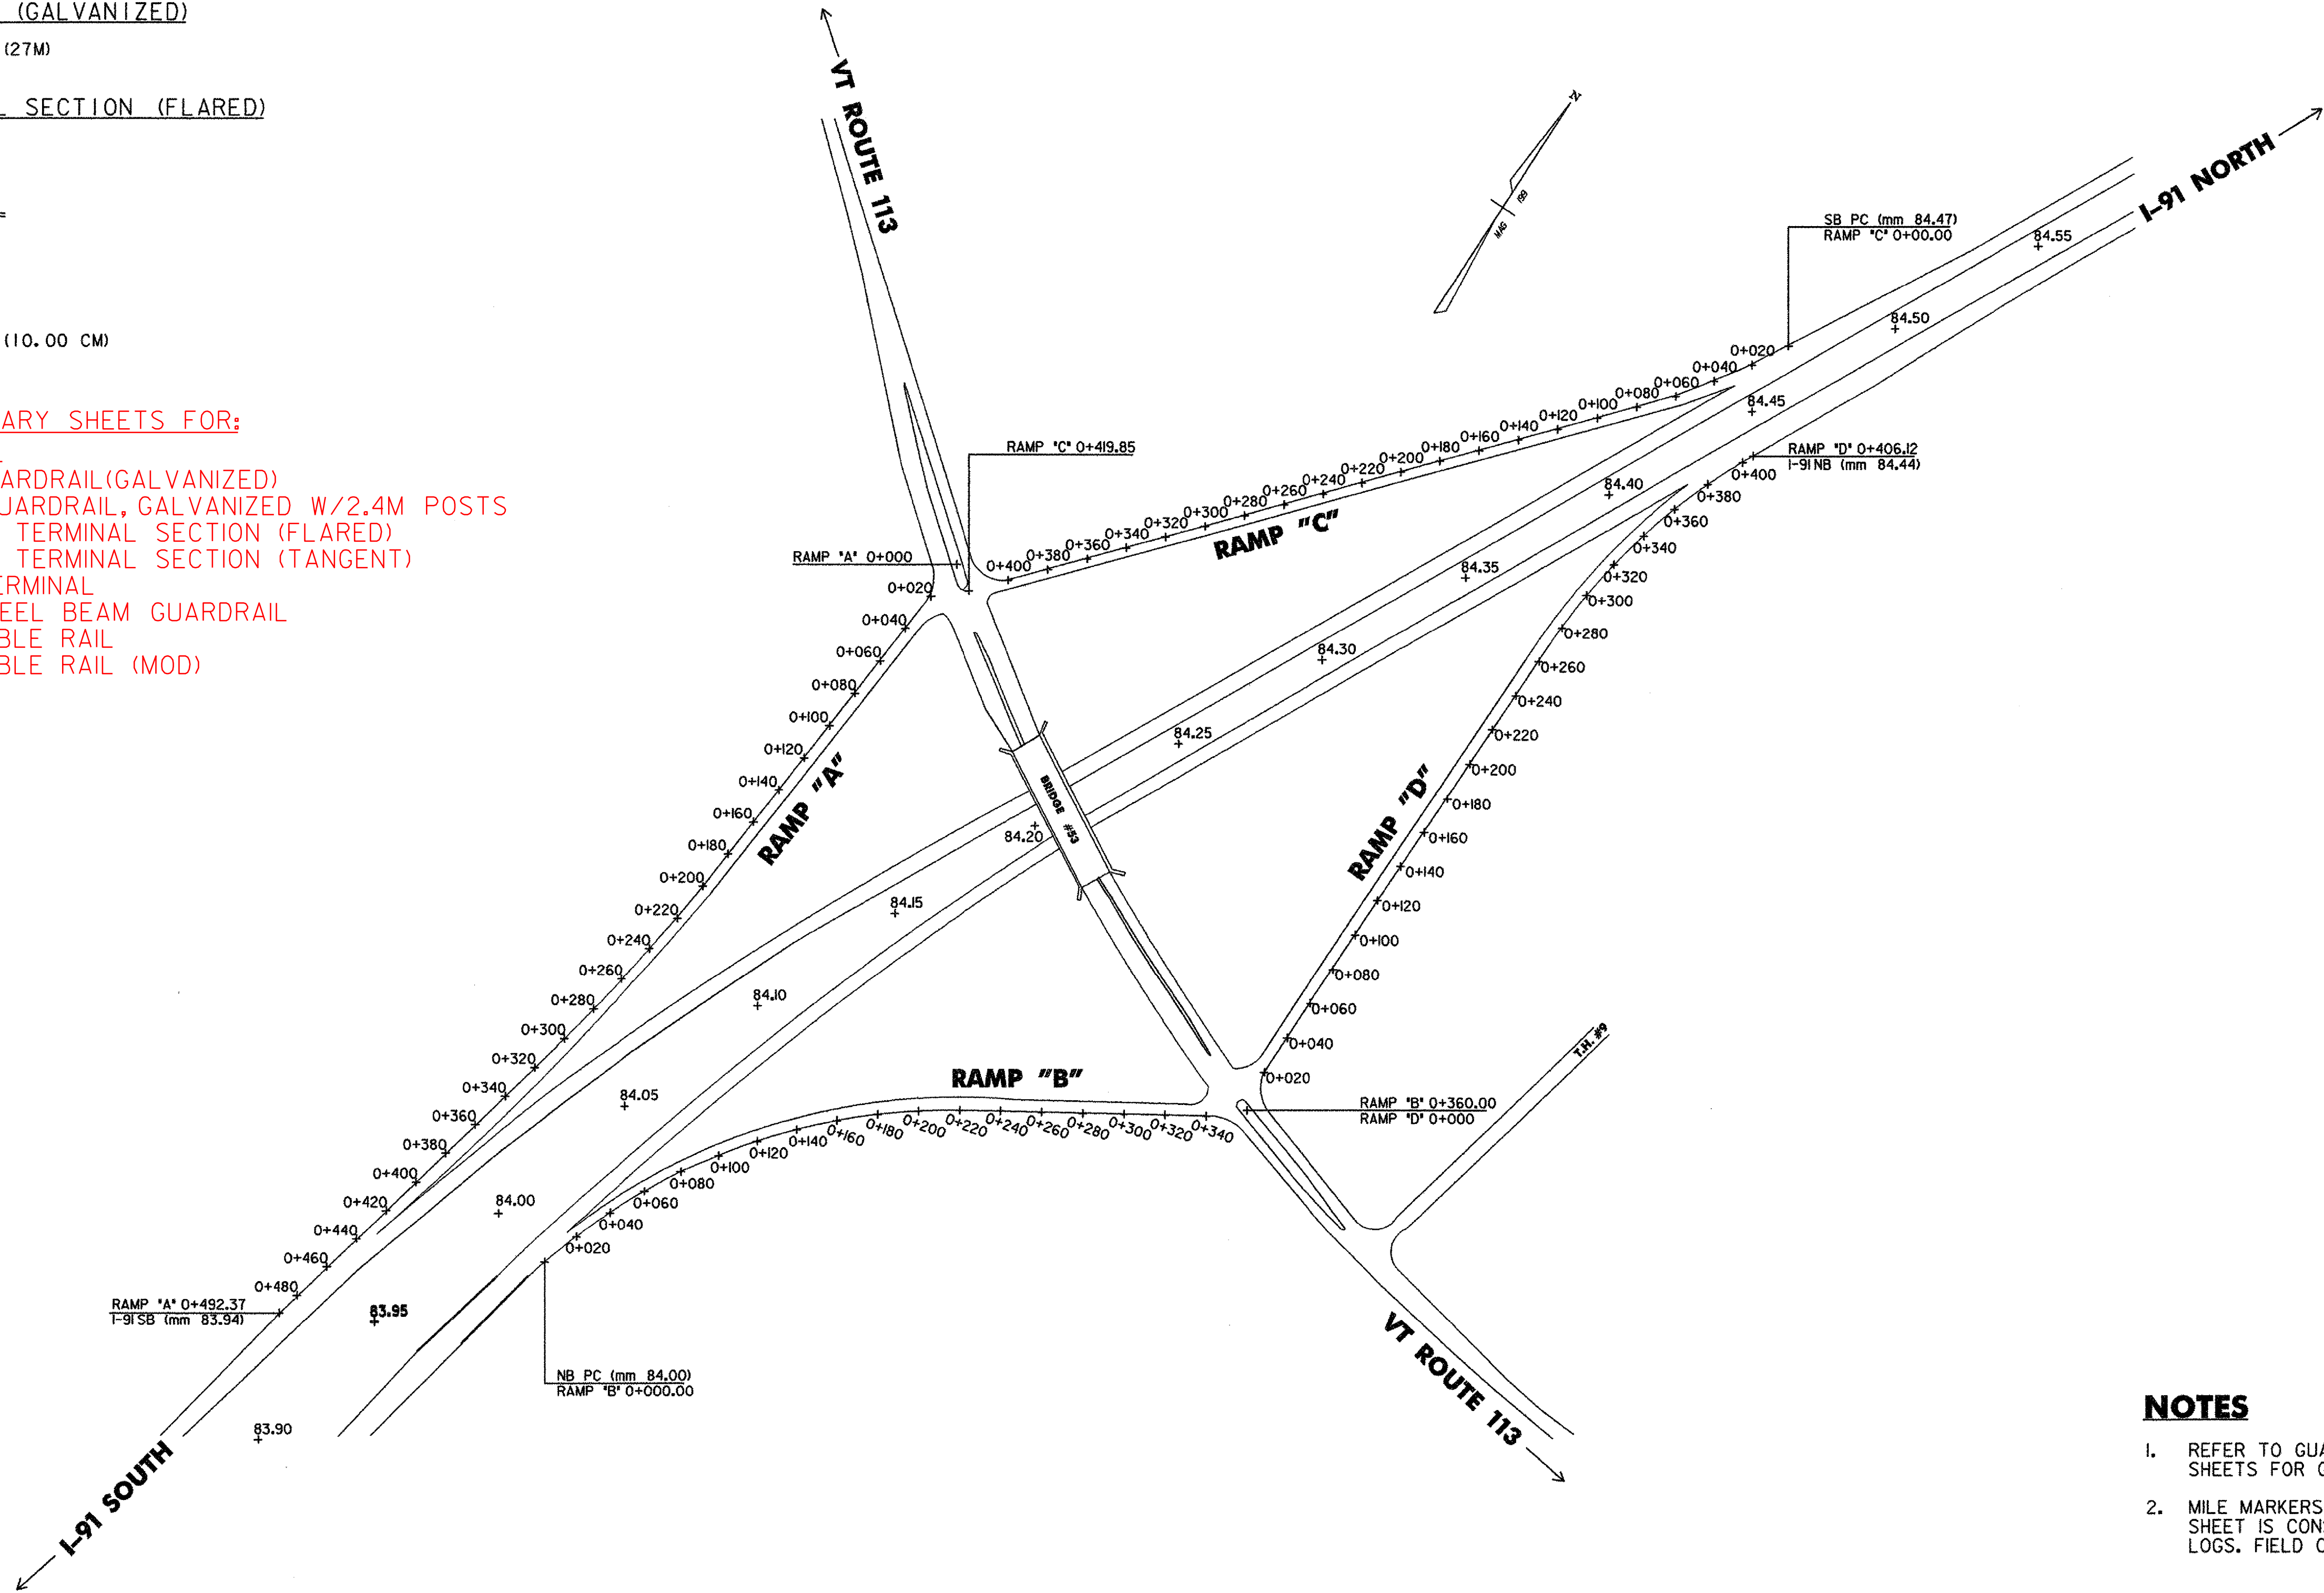

NOTES

1. REFER TO GUARDRAIL ITEM DETAIL SHEETS FOR GUARDRAIL ITEMS.
2. MILE MARKERS INFORMATION ON THIS SHEET IS CONSISTENT WITH VTRANS ROUTE LOGS. FIELD CONDITIONS MAY VARY.

NOT TO SCALE

INTERCHANGE NO. 14 LAYOUT SHEET	 <small>engineering planning management development</small>	PROJECT NAME: HARTFORD - NEWBURY PROJECT NUMBER: IM 091-2(67)
		FILE NAME: ...\\DGN\z\042LA01.dgn PROJECT LEADER: C.D. LATHROP DESIGNED BY: C.D. LATHROP
		PLOT DATE: 09/25/2006 DRAWN BY: R. H. BARNES CHECKED BY: E.P. DETRICK SHEET 27 OF 32