

# I-91 EXIT #15 FAIRLEE INTERCHANGE

## NORTHBOUND RAMP

REPLACE GUARDRAIL POST ASSEMBLY

RAMP "D" 0+027 - 0+295 RT (20 EA)

REMOVAL AND DISPOSAL OF GUARDRAIL

RAMP "B" 0+000 - 0+218 RT (218M)

STEEL BEAM GUARDRAIL (GALVANIZED)

RAMP "B" 0+000 - 0+218 RT (214M)

TRAILING END TERMINAL

RAMP "B" 0+218 RT (1 EA)

BITUMINOUS CONCRETE CURB, TYPE B

RAMP "B" 0+000 - 0+218 RT (4.97T)

BITUMINOUS CONCRETE GUTTER AND TRAFFIC ISLANDS

RAMP "B" 0+000 - 0+218 RT (6.66T)

AGGREGATE SHOULDERS

RAMP "B" 0+000 - 0+218 RT (14.25 CM)

## SOUTHBOUND RAMP

REMOVAL AND DISPOSAL OF GUARDRAIL

RAMP "A" 0+074 - 0+312 RT (237M)

STEEL BEAM GUARDRAIL (GALVANIZED)

RAMP "A" 0+086 - 0+312 RT (226M)

MANUFACTURED TERMINAL SECTION (FLARED)

RAMP "A" 0+086 RT (1 EA)

BITUMINOUS CONCRETE CURB, TYPE B

RAMP "A" 0+074 - 0+312 RT (4.46T)

BITUMINOUS CONCRETE GUTTER AND TRAFFIC ISLANDS

RAMP "A" 0+074 - 0+312 RT (5.98T)

AGGREGATE SHOULDERS

RAMP "A" 0+074 - 0+312 RT (13.30 CM)

RAMP "C" 0+127 - 0+311 RT (1.00 CM)


RAMP "C" 0+131 - 0+312 LT (1.00 CM)

SUBBASE OF DENSE GRADED CRUSHED STONE

RAMP "A" 0+074 - 0+312 RT (3 CM)

SEE ITEM DETAIL SUMMARY SHEETS FOR:

- 621.17 CABLE GUARDRAIL
- 621.20 STEEL BEAM GUARDRAIL(GALVANIZED)
- 621.205 STEEL BEAM GUARDRAIL, GALVANIZED W/2.4M POSTS
- 621.505 MANUFACTURED TERMINAL SECTION (FLARED)
- 621.505 MANUFACTURED TERMINAL SECTION (TANGENT)
- 621.52 TRAILING END TERMINAL
- 621.60 ANCHOR FOR STEEL BEAM GUARDRAIL
- 621.65 ANCHOR FOR CABLE RAIL
- 621.65 ANCHOR FOR CABLE RAIL (MOD)

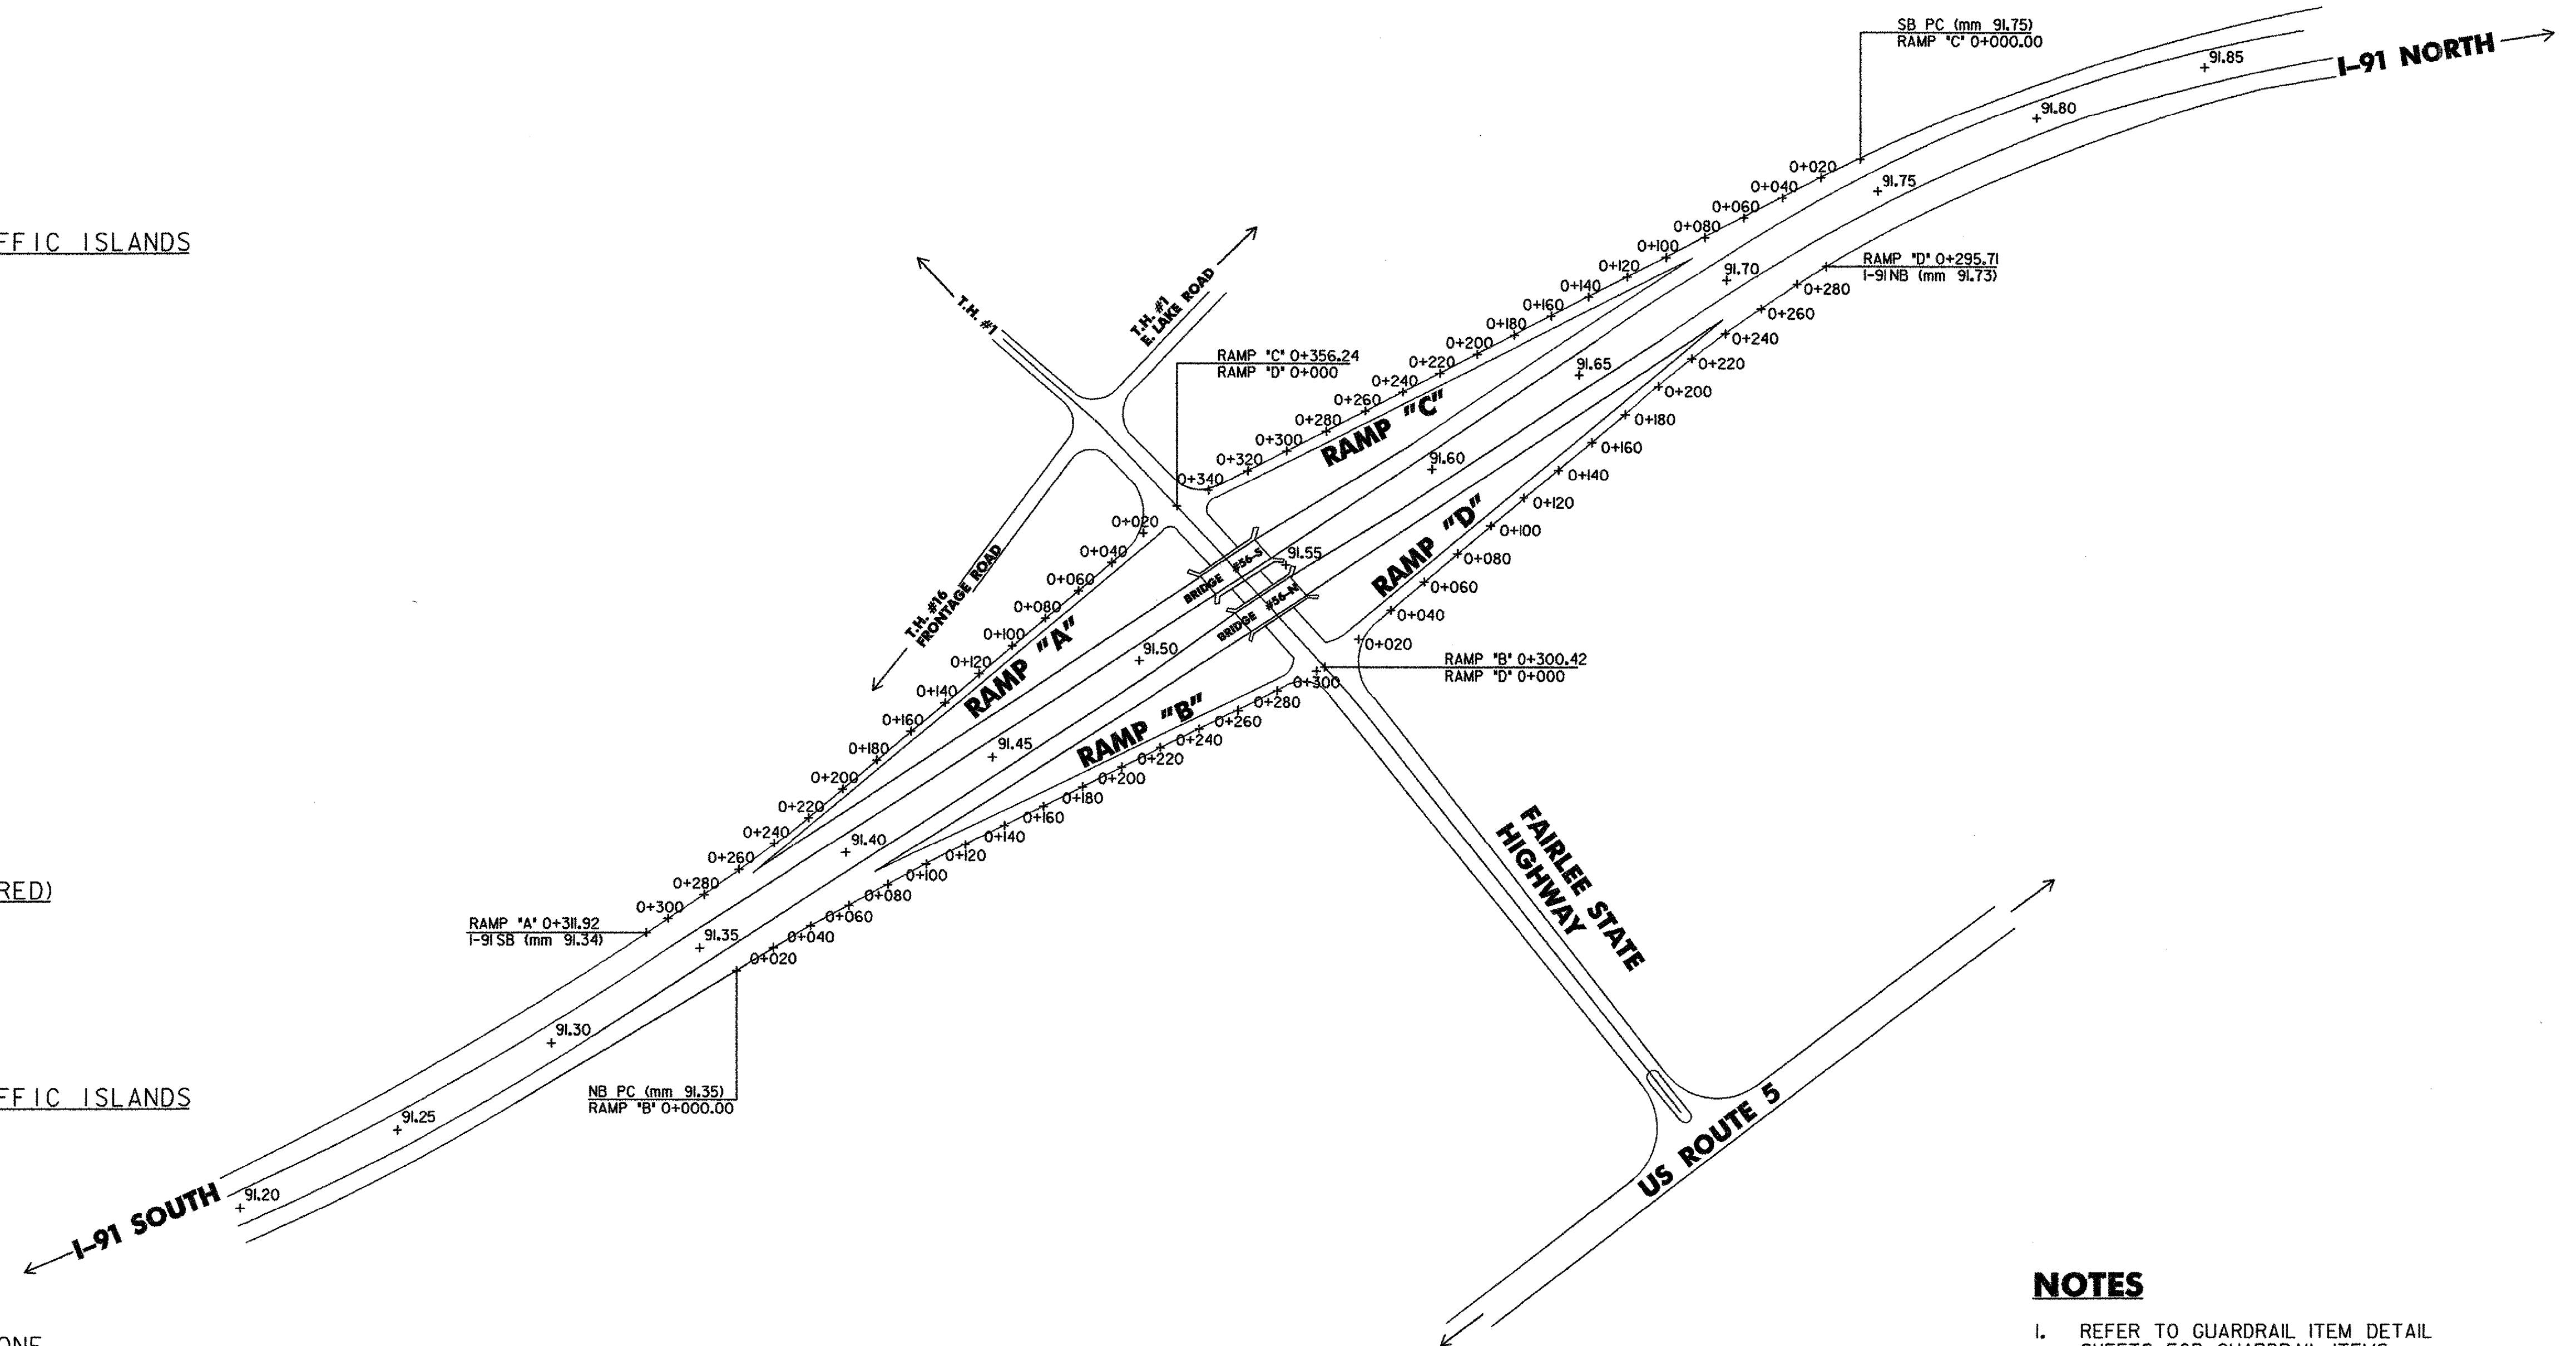

### NOTES

1. REFER TO GUARDRAIL ITEM DETAIL SHEETS FOR GUARDRAIL ITEMS.
2. MILE MARKERS INFORMATION ON THIS SHEET IS CONSISTENT WITH VTRANS ROUTE LOGS. FIELD CONDITIONS MAY VARY.

**NOT TO SCALE**

<b>INTERCHANGE NO. 15 LAYOUT SHEET</b>	 engineering    planning    management    development	PROJECT NAME: HARTFORD - NEWBURY PROJECT NUMBER: IM 091-2(67)
		FILE NAME: ...\\DGN\z\042LA01.dgn PROJECT LEADER: C.D. LATHROP DESIGNED BY: C.D. LATHROP
		PLOT DATE: 09/25/2006 DRAWN BY: R. H. BARNES CHECKED BY: E.P. DETRICK SHEET 28 OF 32