


# STATE OF VERMONT AGENCY OF TRANSPORTATION



## PROPOSED IMPROVEMENT HARTFORD-NEWBURY TOWNS OF HARTFORD, NORWICH, THETFORD, FAIRLEE, BRADFORD & NEWBURY COUNTIES OF WINDSOR & ORANGE INTERSTATE 91 - SIGNS

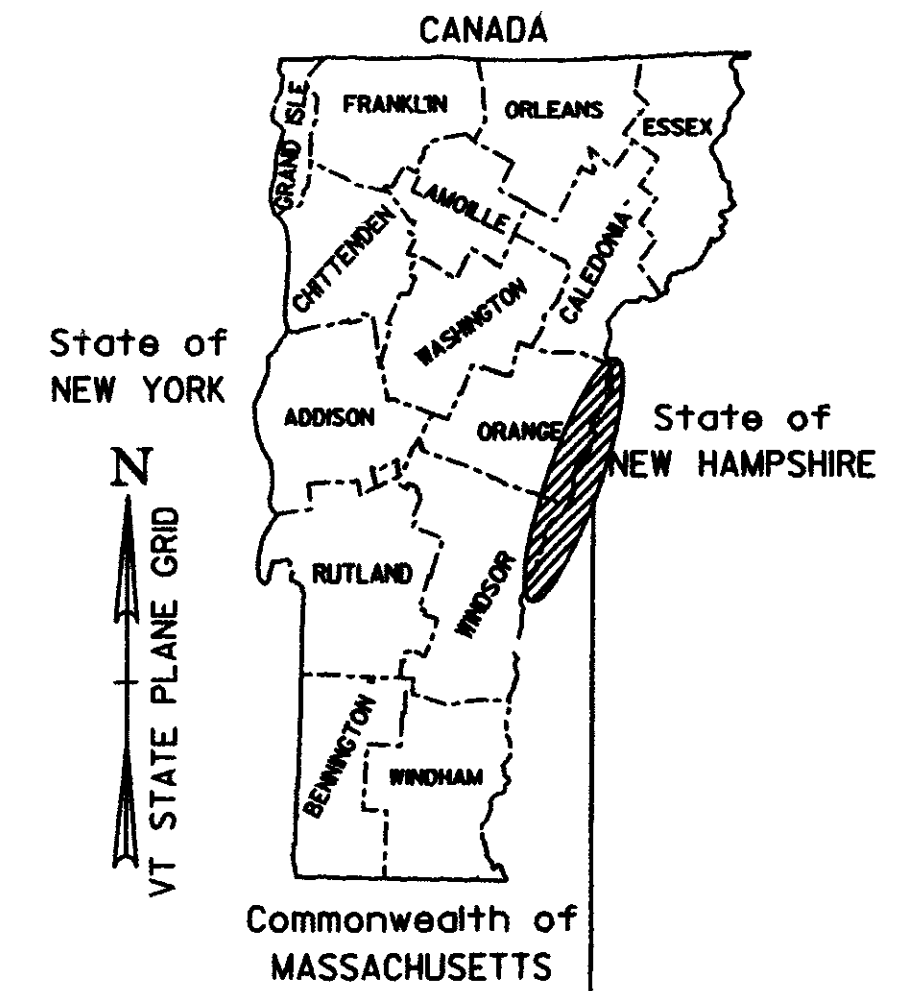


RECORD PLANS	
CONTRACTOR	F. R. LAFAYETTE, INC. - ESSEX JUNCTION, VT.
RESIDENT ENGINEER	JIM FOREST
CONSTRUCTION BEGAN	APRIL 17, 2006
CONSTRUCTION COMPLETE	DECEMBER 19, 2007
RECORD PLANS BY	JIM FOREST & NICK GARBACIK
I HEREBY CERTIFY THAT ALL THE CONSTRUCTION REQUIRED BY THIS SET OF DRAWINGS HAS BEEN ACCOMPLISHED AS INDICATED HEREIN	
BY	<i>James A. Flood</i> RESIDENT ENGINEER
DATE	07-19-10
NOTE: Any further information concerning final quantities, amounts or other details relative to this project may be found at Central Files in the electronic archives	

PROJECT LOCATION: THE NORTHBOUND AND SOUTHBOUND LANES BEGINNING AT THE NORTH END OF BRIDGE 42N (THE JUNCTION OF INTERSTATES 89 & 91) AT-MM 69.96 AND EXTENDING NORTHERLY 65.983 KM TO MM-110.96, THE NEWBURY/RYEGATE TOWN LINE.

PROJECT DESCRIPTION: WORK TO BE PERFORMED UNDER THIS PROJECT INCLUDES REPLACEMENT OF EXISTING MAINLINE AND INTERCHANGE SIGNS, SIGN POSTS, DELINEATORS AND OTHER RELATED ITEMS.


LENGTH OF ROADWAY : 65983 m 65.983 km  
LENGTH OF PROJECT : 65983 m 65.983 km

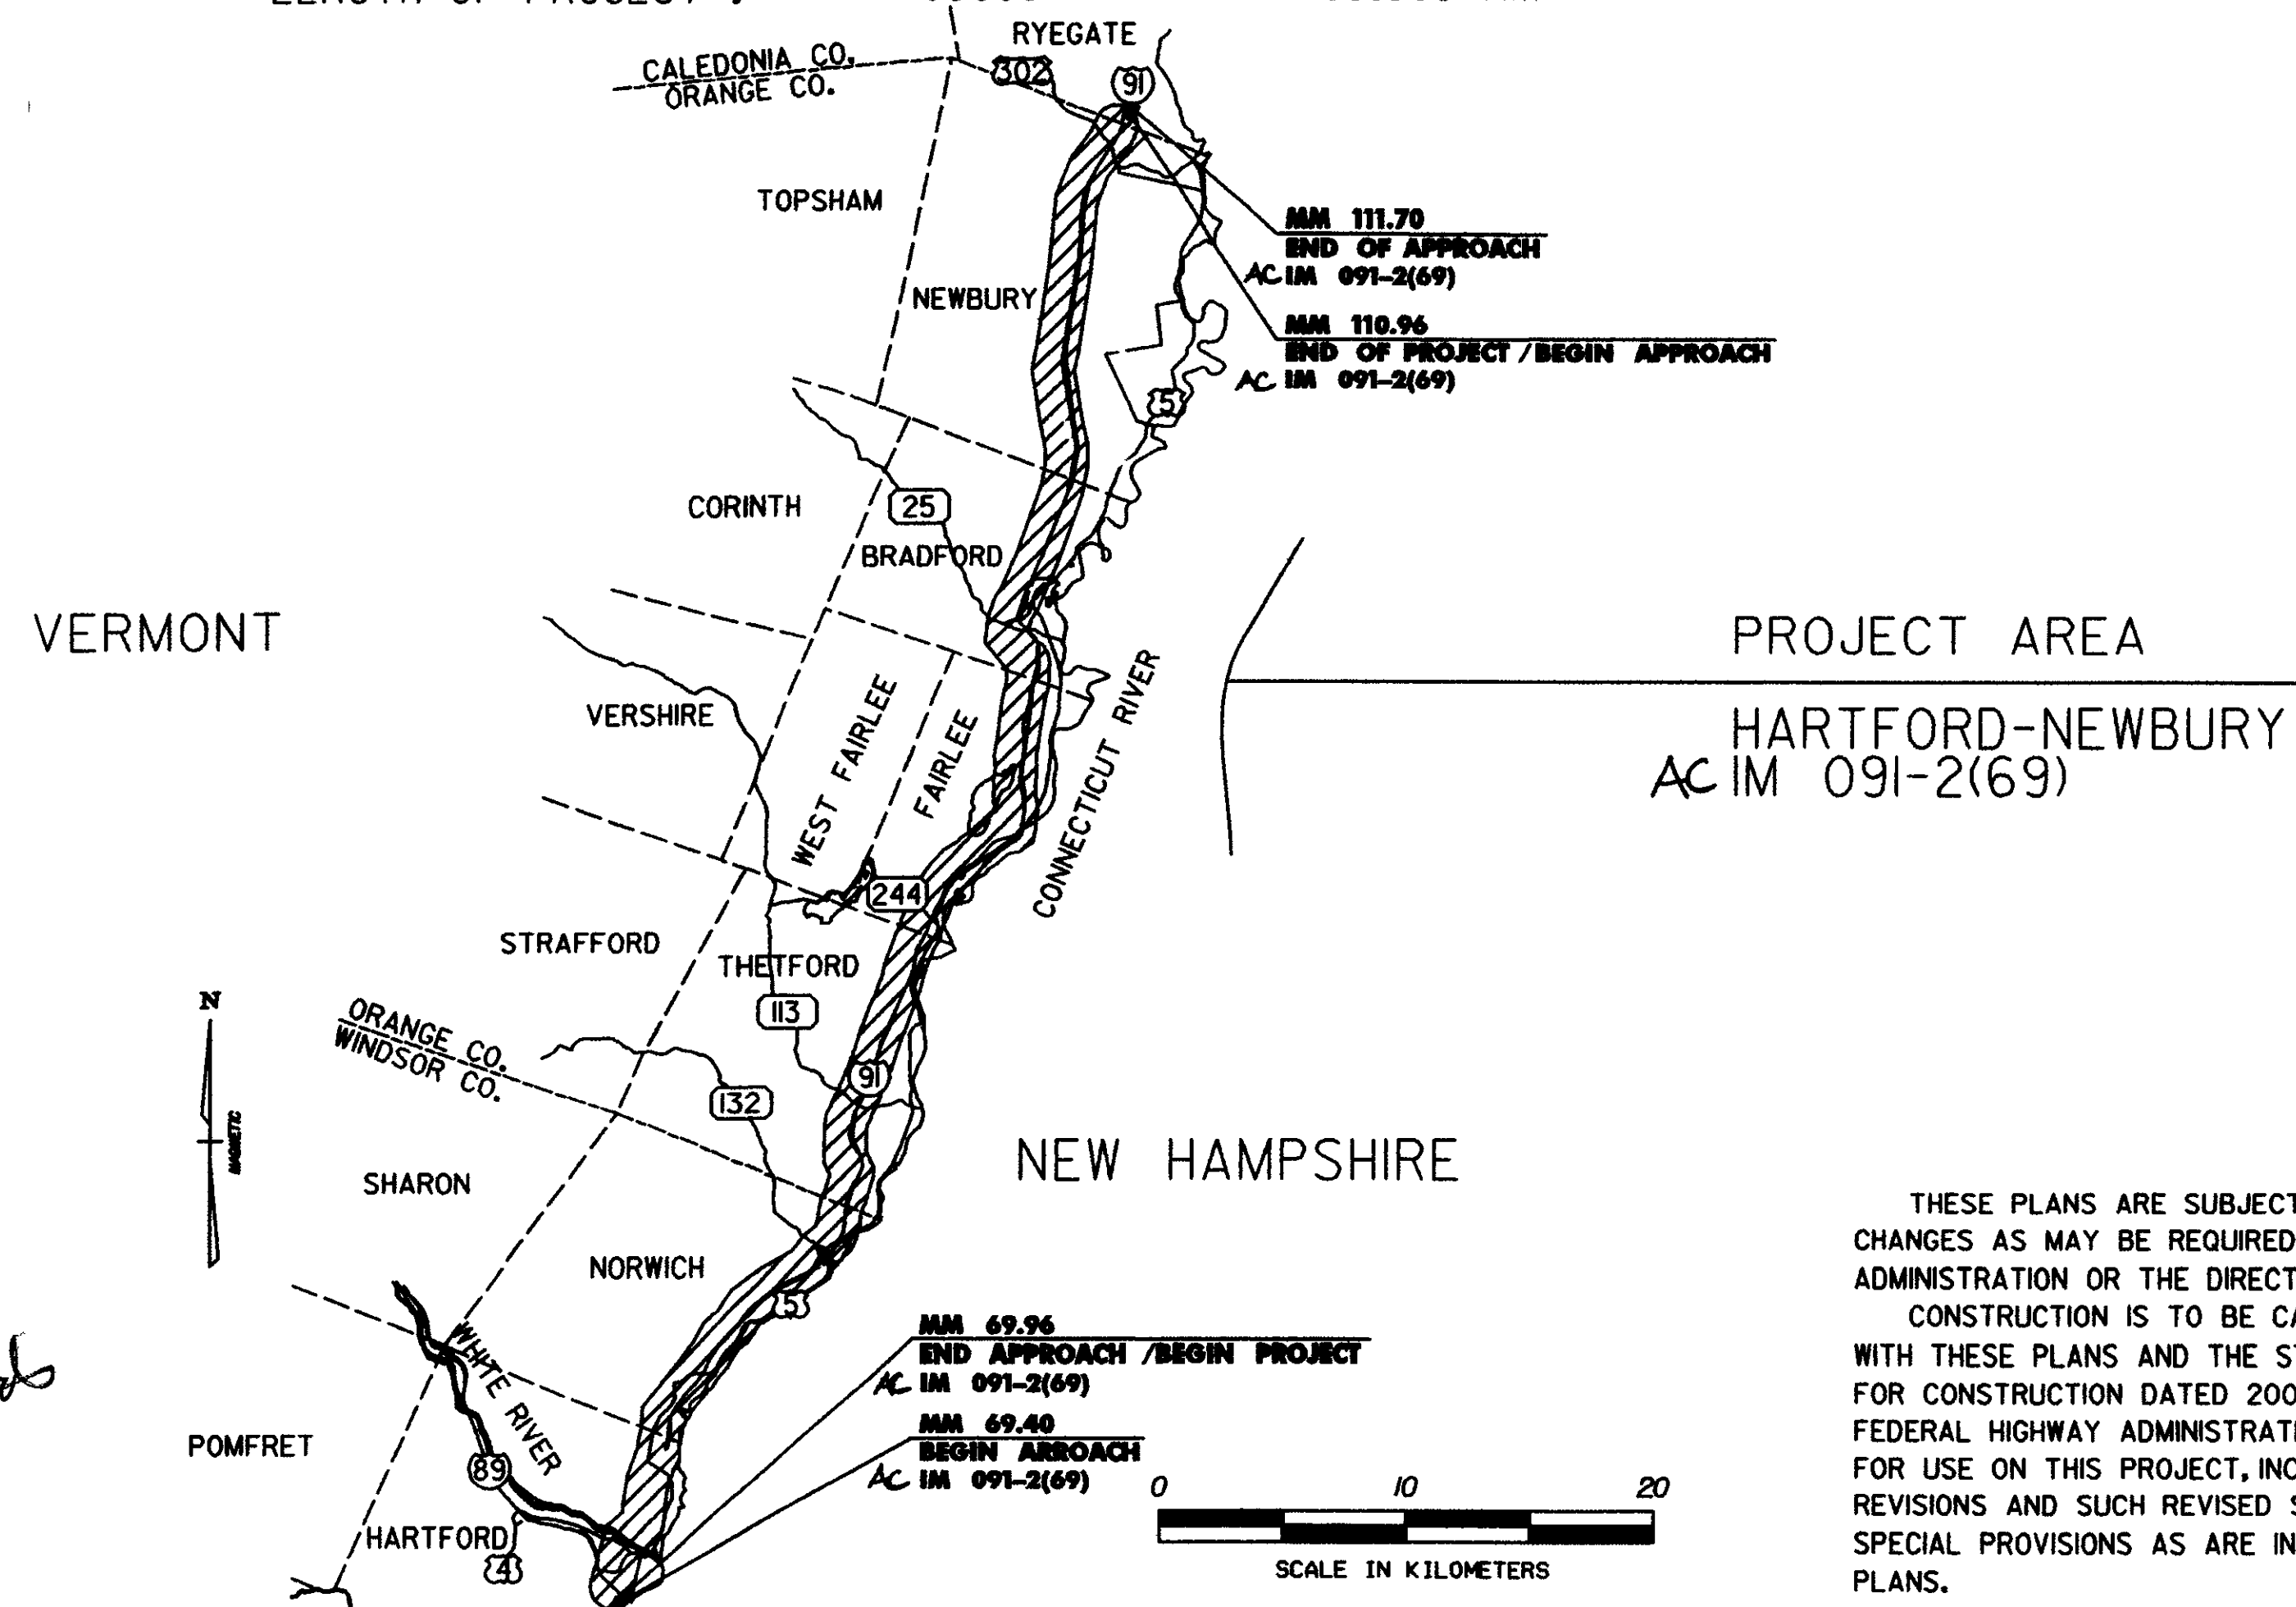

CONVENTIONAL SIGNS	
COUNTY LINE	---
TOWN LINE	- - - - -
LIMITS OF ACCESS	○—○
POINT OF ACCESS	○—X
FENCE LINE	-x-x-
STONE WALL	o-o-o-o-o
TRAVELED WAY	—+—+—+—
GUARD RAIL	—o—o—o—o—
RAILROAD	—+—+—+—+—
SURVEY LINE	—+—+—+—+—
CULVERT	—+—+—+—+—
POWER POLE	□
TELEPHONE POLE	○
TREES	⊗
CONTROL OF ACCESS	///
PROPERTY LINE	—+—+—+—+—
R.O.W. TAKING LINE	—+—+—+—+—
SLOPE RIGHTS	○—SR—△
TOP OF CUT	—△—△—△—
TOE OF SLOPE	—○—○—○—

**DuBois & King**  
engineering planning design development

DATUM  
VERTICAL N/A  
HORIZONTAL N/A

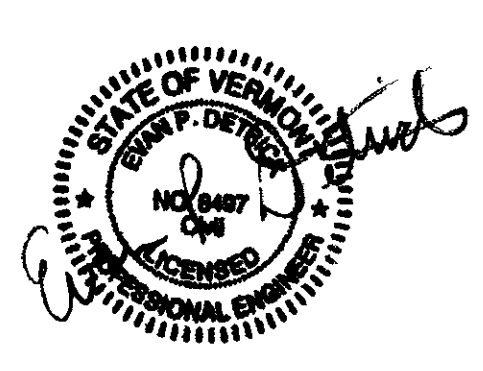

THESE PLANS ARE SUBJECT TO SUCH ENGINEERING CHANGES AS MAY BE REQUIRED BY THE FEDERAL HIGHWAY ADMINISTRATION OR THE DIRECTOR OF PROGRAM DEVELOPMENT. CONSTRUCTION IS TO BE CARRIED ON IN ACCORDANCE WITH THESE PLANS AND THE STANDARD SPECIFICATIONS FOR CONSTRUCTION DATED 2001, AS APPROVED BY THE FEDERAL HIGHWAY ADMINISTRATION ON JANUARY 4, 2001 FOR USE ON THIS PROJECT, INCLUDING ALL SUBSEQUENT REVISIONS AND SUCH REVISED SPECIFICATIONS AND SPECIAL PROVISIONS AS ARE INCORPORATED IN THESE PLANS.

APPROVED *Kevin S. Marsha* DATE 12-15-07  
DIRECTOR OF PROGRAM DEVELOPMENT

DEPARTMENT OF TRANSPORTATION  
FEDERAL HIGHWAY ADMINISTRATION

APPROVED *Mark W. Ricketts* DATE 2-2-08  
DIVISION ADMINISTRATOR

PROJECT MANAGER: KEVIN S. MARSHIA

PROJECT HARTFORD - NEWBURY  
AC IM 091-2(69)

SHEET 1 OF 180 SHEETS

