


NOTE:
ALL SIGNS AND POSTS SHOWN ON THIS SHEET ARE TO BE REMOVED UNLESS OTHERWISE NOTED.

EXISTING SIGNS
INTERCHANGE - 158

WELLS RIVER INTERCHANGE #17

EXISTING SIGNS

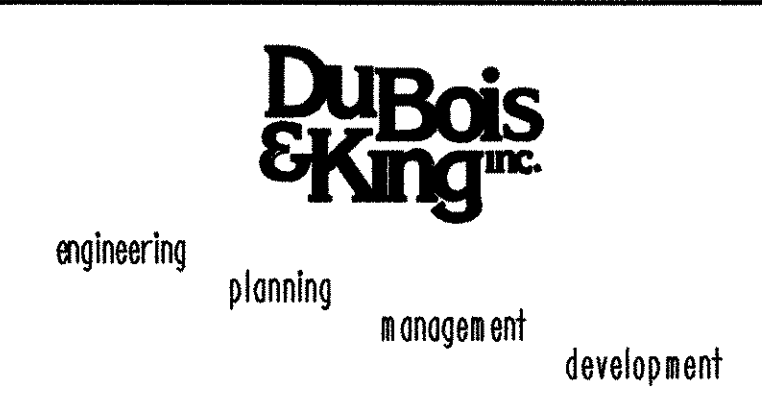

PROJECT NAME : HARTFORD - NEWBURY	PROJECT NO. : IM 091 -2 (69)
DESIGN FILE NAME: ... \ZA046LA08.DGN	PLOT DATE: 12/12/2005
IPARM FILE NAME:	SURVEY DATE: FEB 1998
SURVEYED BY: NAS, RAN	DRAWN BY: S. J. BIJOLLE
SQUAD LEADER: J. W. TUCKER	SHEET: 28 OF 180