


PROPOSED MAINLINE SIGNS

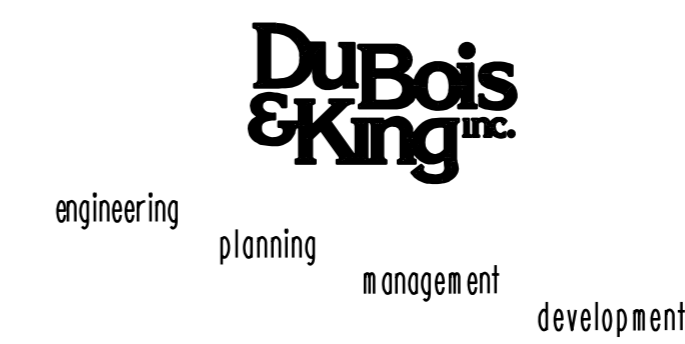

PROJECT NAME :	PROJECT NO. :
HARTFORD - NEWBURY	IM 091 -2 (69)
DESIGN FILE NAME: M:\PROJECTS\99A046\CONSTRUCTION\99A046.DGN	PLOT DATE: JUN-2013 16:
IPARM FILE NAME:	SURVEY DATE: FEB 1998
SURVEYED BY: NAS, RAN	DRAWN BY: S.J. BIJOLLE
SQUAD LEADER: J. W. TUCKER	SHEET: 35 OF 180