


**PROPOSED
MAINLINE
SIGNS**

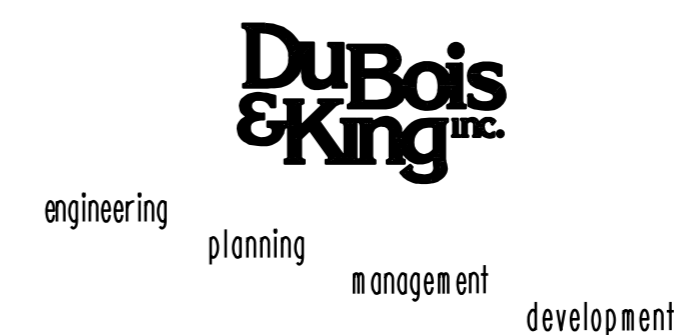

PROJECT NAME : HARTFORD - NEWBURY	PROJECT NO. : IM 091 -2 (69)
DESIGN FILE NAME: M:\PROJECTS\99A046\CONSTRUCTION\99A046.DGN	PLOT DATE: JUN-2013 16:
IPARM FILE NAME:	SURVEY DATE: FEB 1998
SQUAD LEADER: J. W. TUCKER	DRAWN BY: S. J. BIJOLLE
	SHEET: 39 OF 180