


(A) EXIT 11 (2)	(B) MM. 2.807 US 5 MM. 70.11 NB MM. 70.38 SB (3)	(C) WRONG WAY (2)	(D) ONE WAY (2) STA. 0+476 LT RAMP A	(E) (2) STA. 0+460 RT RAMP A
(F) YIELD	(G) PROHIBITED RESTRICTIONS STOPPED FOR VEHICLES BICYCLES FARM MACHINERY SHOW VEHICLES TURN SIGNAL REQUIRED BEFORE CHANGING LANES (2)	(H) STOP DO NOT ENTER B - B END OF RAMP B RT		
(I) B - B (3) MM. 2.891 MM. 3.041 MM. 3.044	(J) ONLY MM. 2.958 LT			
(K) ONLY MM. 2.928 RT	(L) (2) SOUTHBOUND MM. 70.33 NORTHBOUND MM. 70.35	(M) END OF RAMP B LT STOP ONE WAY B - B		
(N) B - B MM. 2.957	(O) B - B (2)			
(P) B - B LEFT LANE MUST TURN LEFT MM. 2.965	(Q) MM. 2.891 RT NORTH NORTH TO 91 5 4 ← ↑ ↑			
(R) MM. 2.884 LT SOUTH SOUTH TO 5 91 89 ↑ ↗ ↗	(S) MM. 3.040 LT HARTLAND 9 WINDSOR 14 BARRE 51 CONCORD N.H. 61 BRATTLEBORO 62			

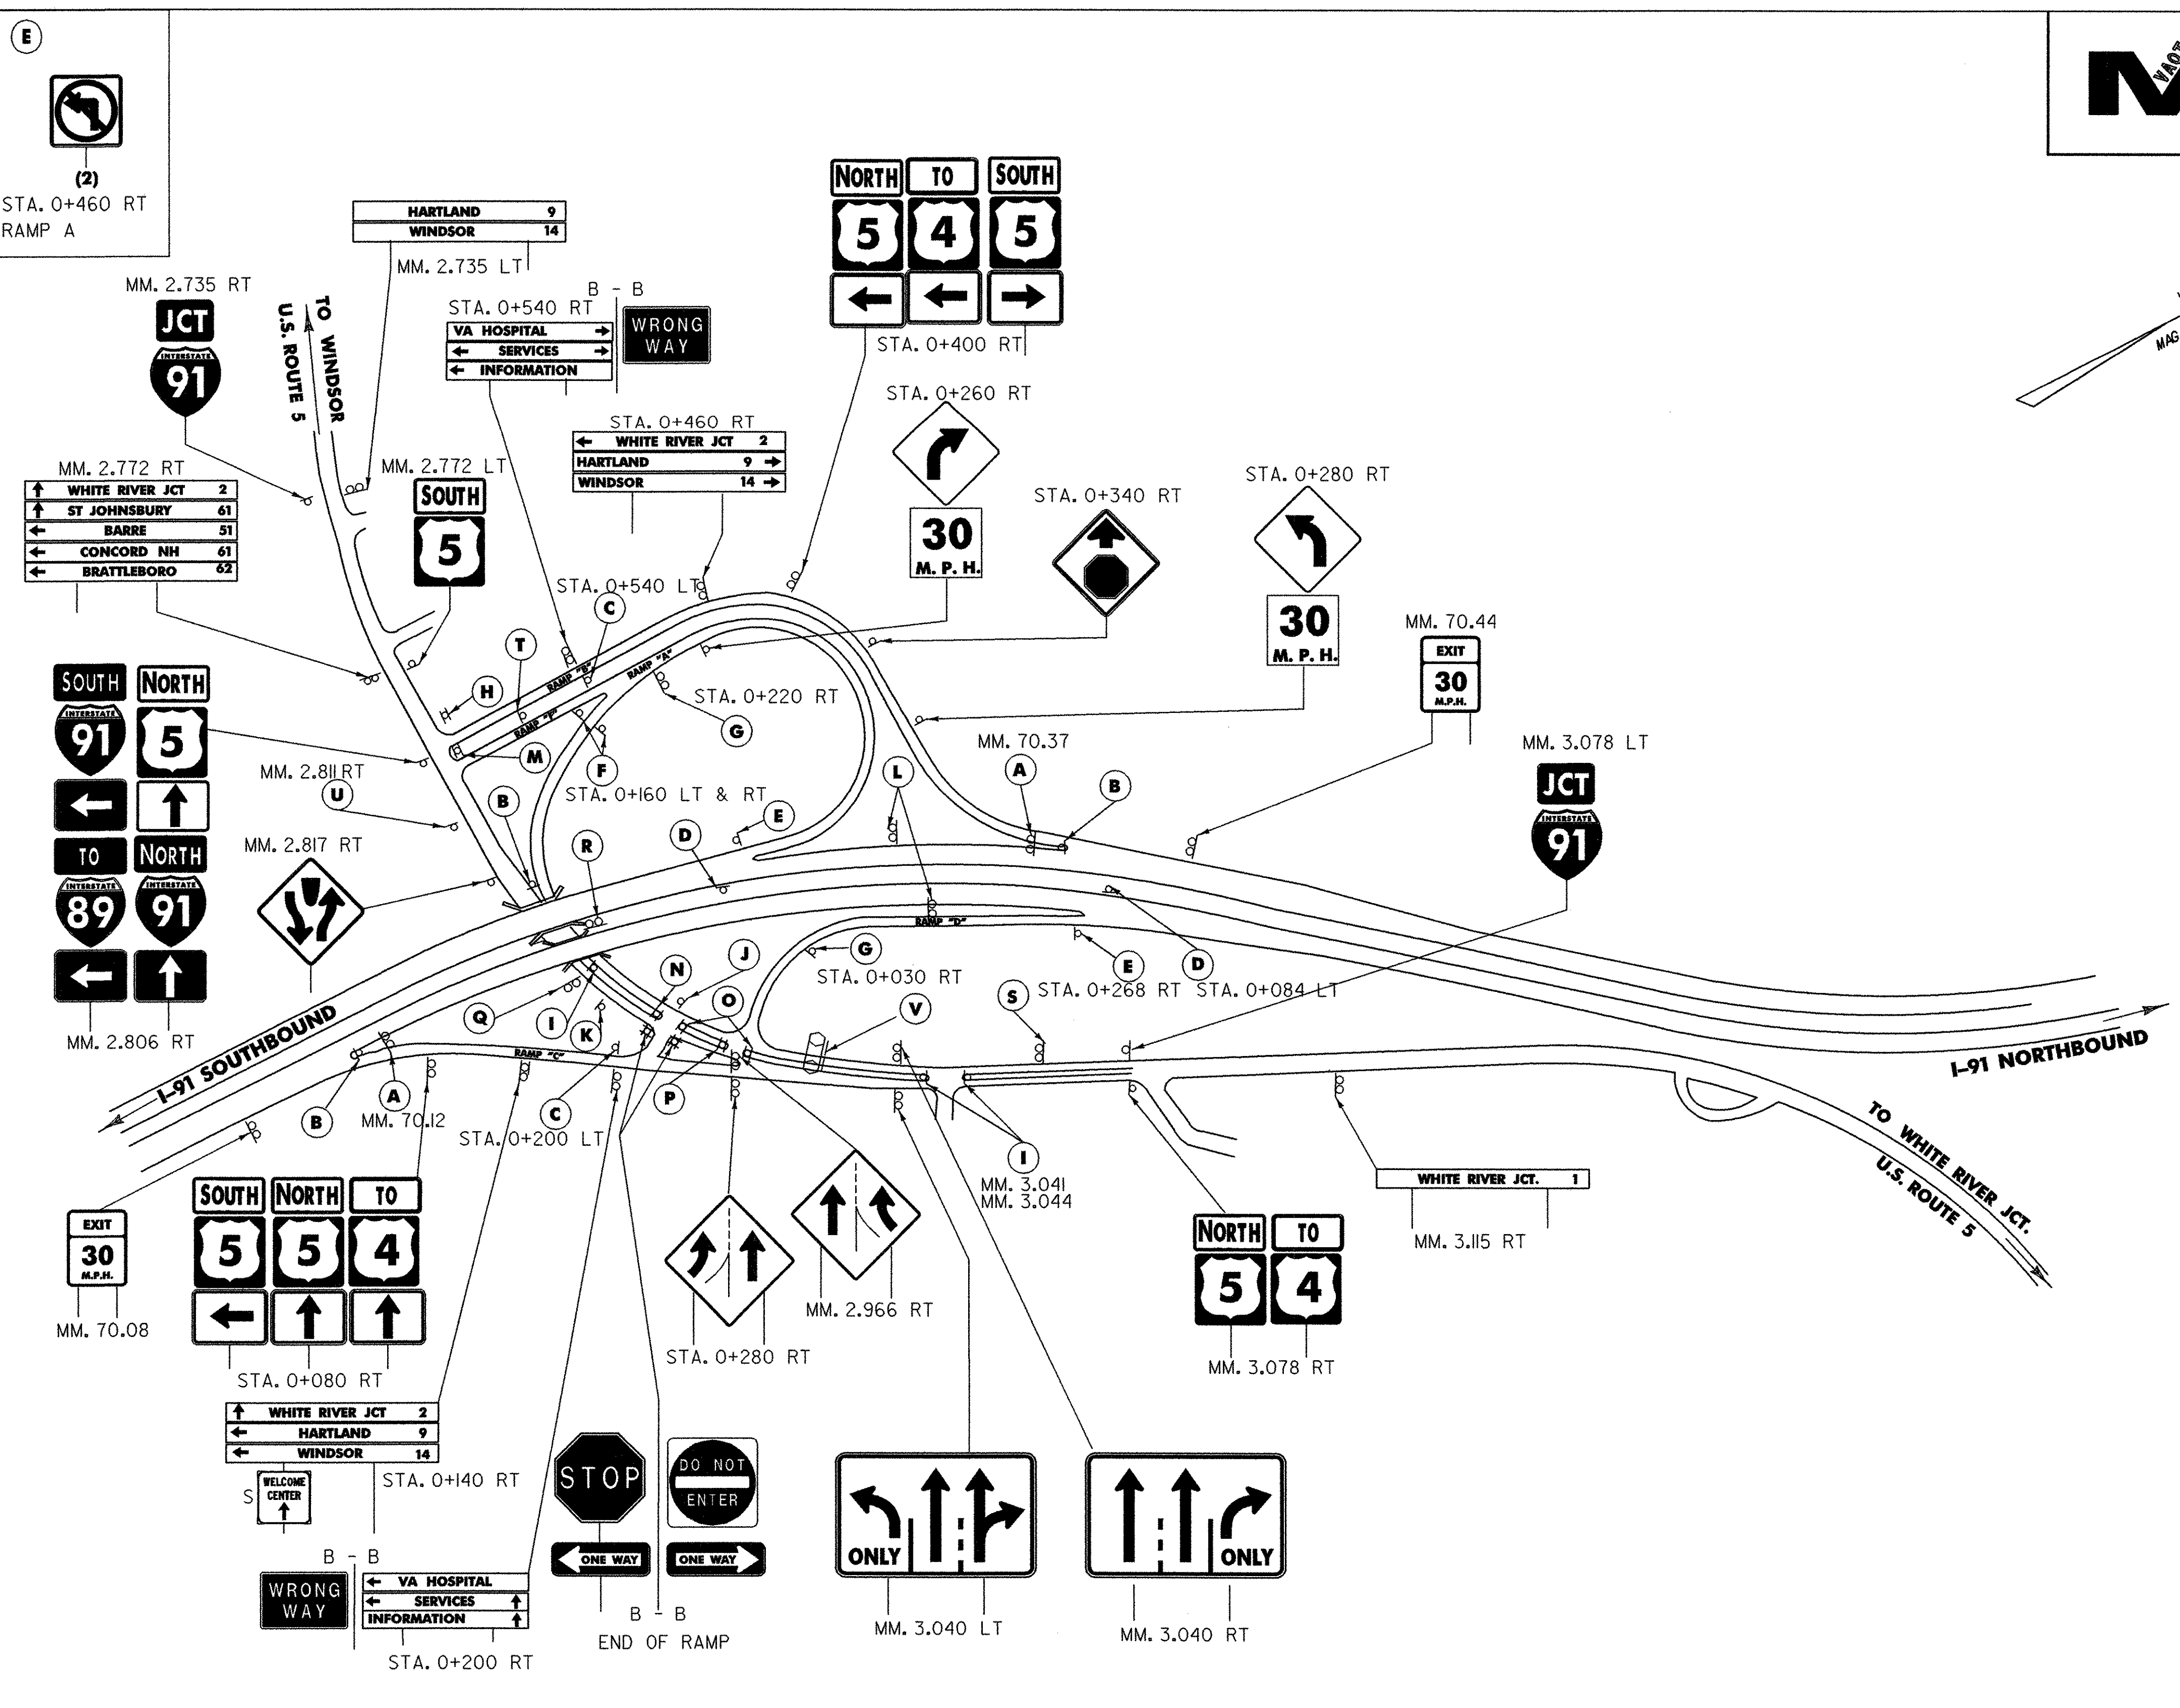

(T) DO NOT ENTER STA 0+550 LT	(U) SPEED LIMIT 40	(V) MOUNTED ON OVERHEAD STRUCTURE SOUTH 5 ↓ SOUTH TO 91 ↓ 89 EXIT 600 FT NORTH 91 ↗ ST JOHNSBURY		
--	------------------------------	---	--	--

NOTES:

- ALL SIGNS AND POSTS SHOWN ON THIS SHEET ARE TO BE NEW UNLESS OTHERWISE NOTED.
- SOME ADJUSTMENT OF EXISTING SIGN LOCATIONS MAY BE REQUIRED.