



* REFER TO SPECIAL PROVISIONS FOR BASIS OF PAYMENT

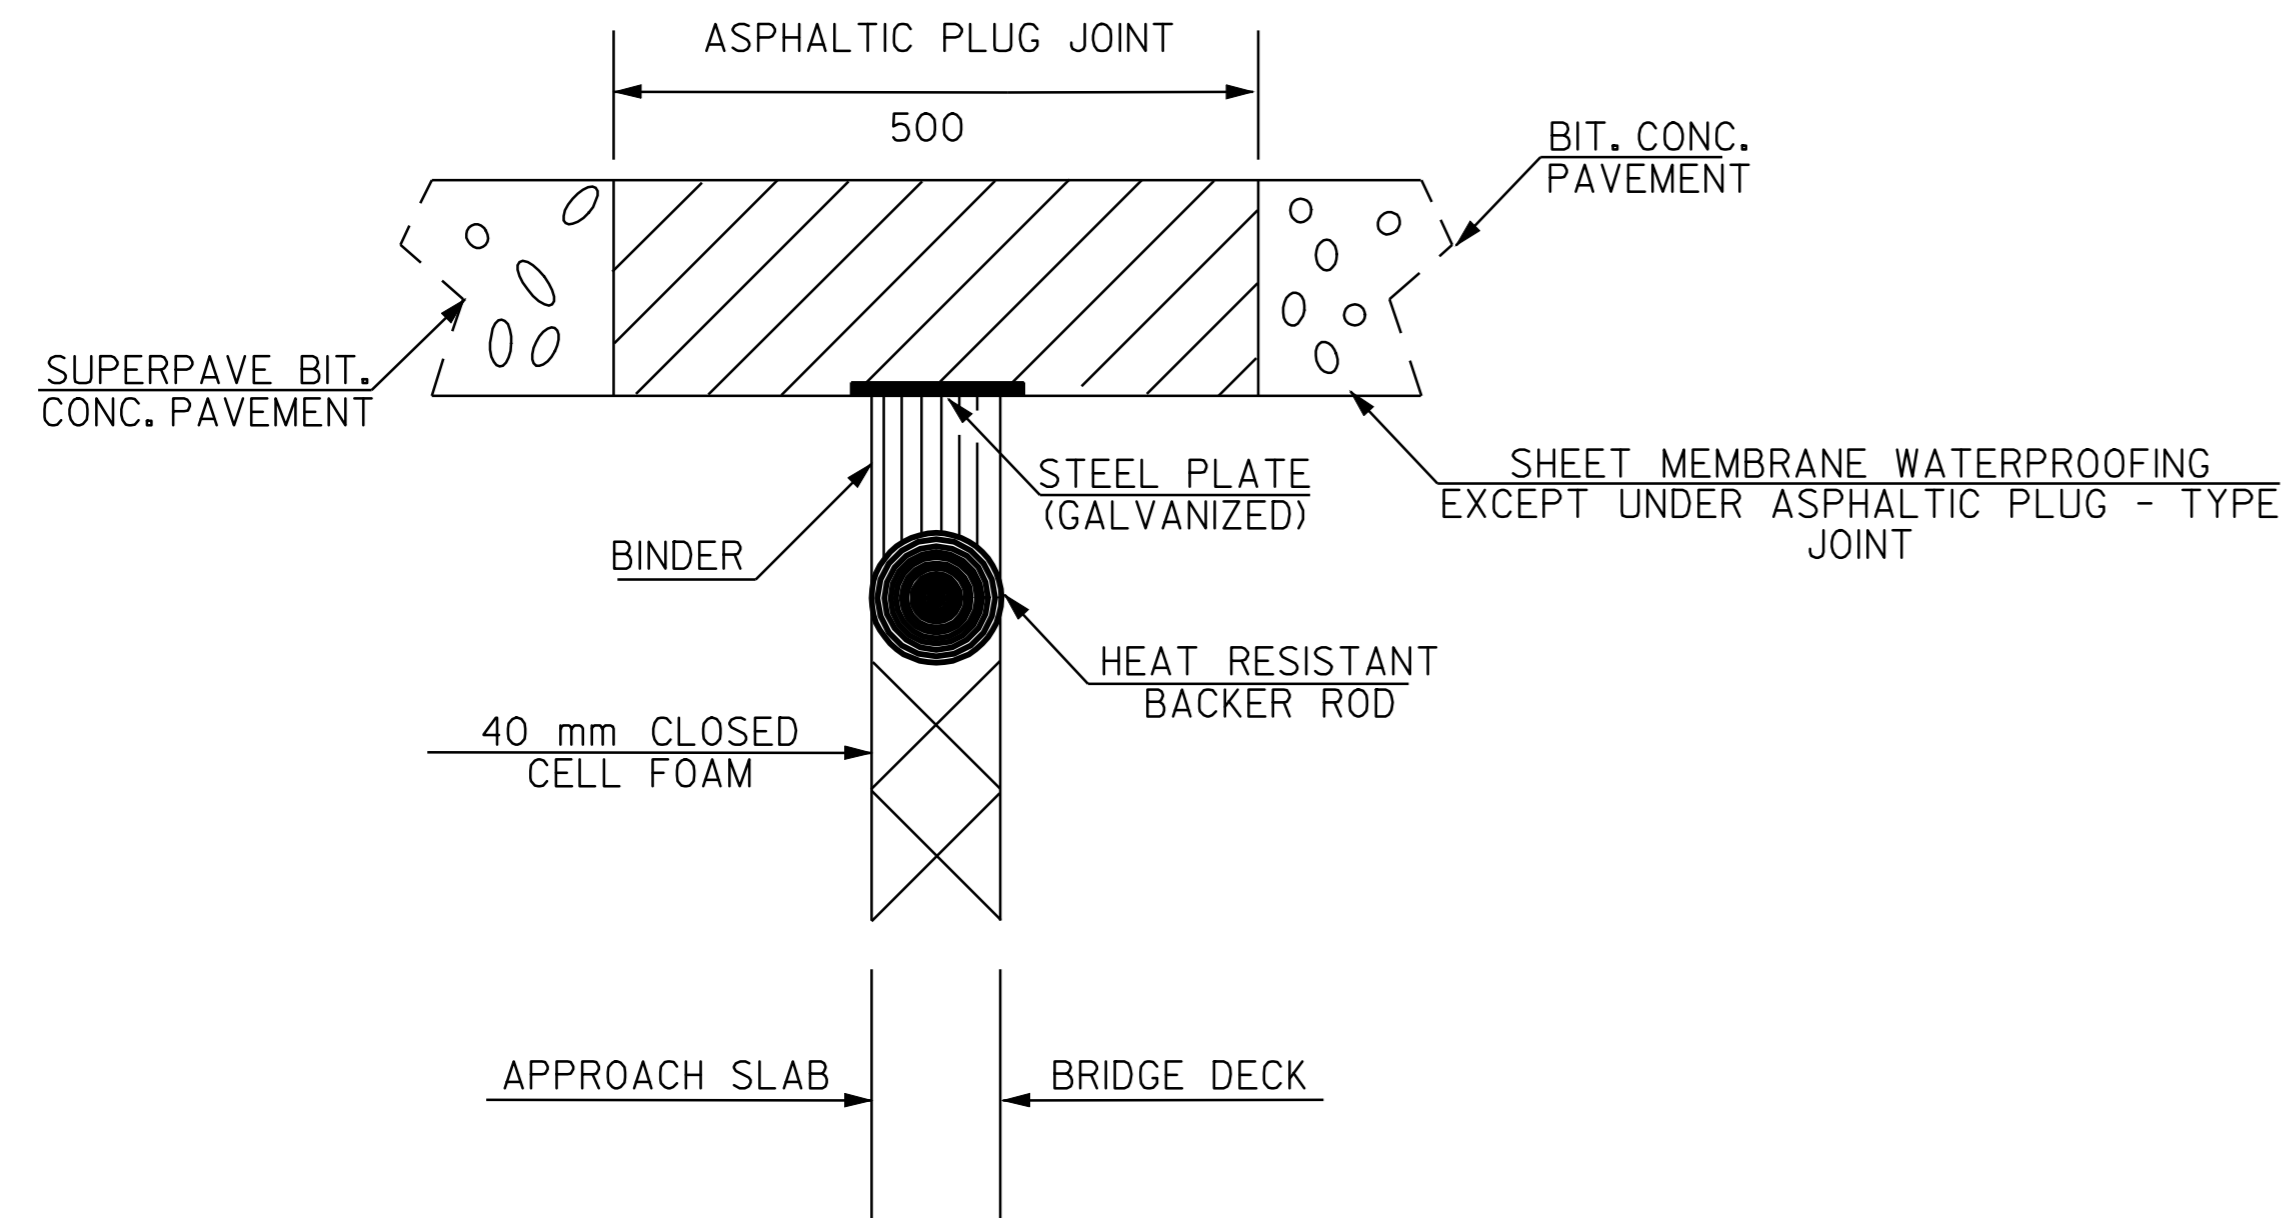

ASPHALTIC PLUG-TYPE JOINT DETAIL

LOCATION

| | | | | | |
|-------------|------|----------|-------|--------------------|--------------------|
| PUTNEY | | | | | |
| BRIDGE # | 14-S | (9.2 M) | @ STA | 29+715 (MM 18.464) | (4 EXP. JOINTS) |
| BRIDGE # | 15-S | (9.2 M) | @ STA | 31+686 (MM 19.689) | 4(-3) EXP. JOINTS) |
| BRIDGE # | 16-S | (9.2 M) | @ STA | 34+279 (MM 21.300) | (-4) EXP. JOINTS) |
| WESTMINSTER | | | | | |
| BRIDGE # | 18-S | (12.8 M) | @ STA | 41+234 (MM 25.621) | 4(-2) EXP. JOINTS) |
| BRIDGE # | 20-S | (9.3 M) | @ STA | 46+041 (MM 28.608) | 4(-2) EXP. JOINTS) |
| BRIDGE # | 21-S | (9.2 M) | @ STA | 49+952 (MM 31.039) | (2 EXP. JOINTS) |
| ROCKINGHAM | | | | | |
| BRIDGE # | 22-S | (11.4 M) | @ STA | 54+171 (MM 33.660) | (2 EXP. JOINTS) |
| BRIDGE # | 23-S | (11.6 M) | @ STA | 56+655 (MM 35.204) | 4(-3) EXP. JOINTS) |
| BRIDGE # | 24-S | (9.2 M) | @ STA | 57+123 (MM 35.495) | (2 EXP. JOINTS) |

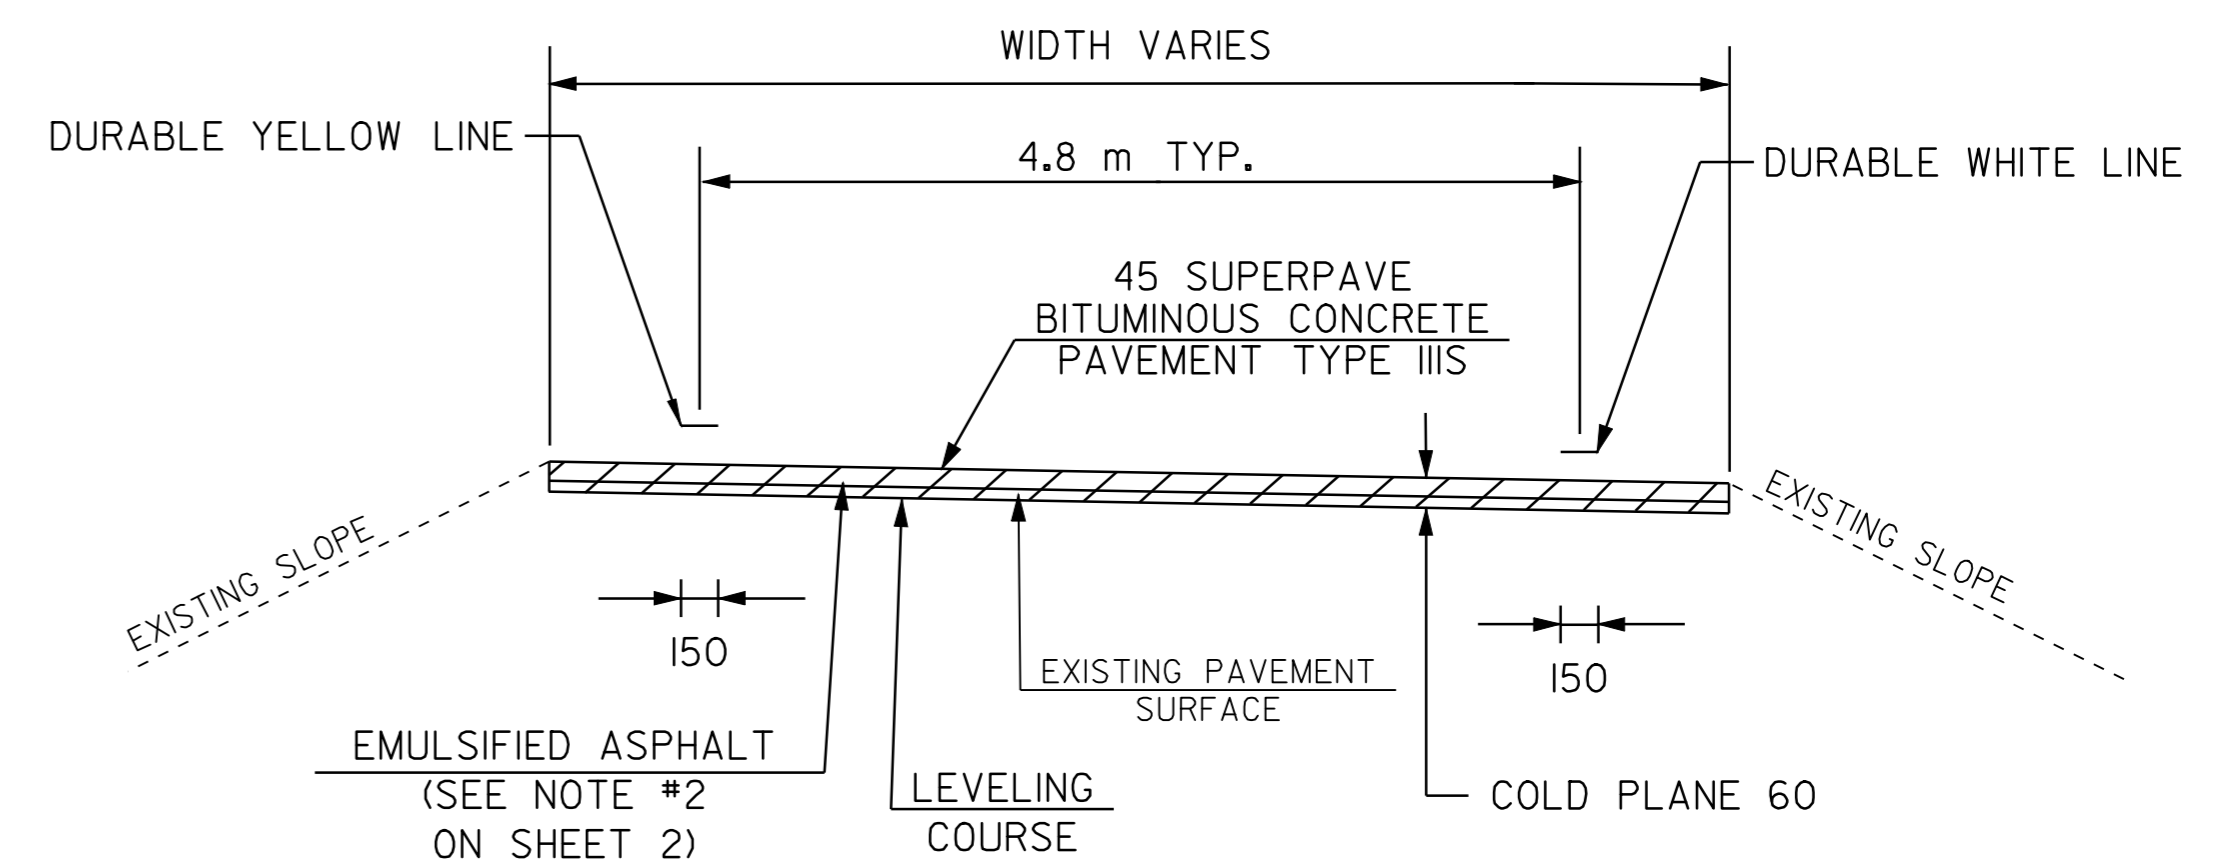

RAMP PAVEMENT TYPICAL

LOCATION

| | |
|--------|---|
| EXIT 4 | OFF & ON RAMPS - SEE SHEETS 13 & 14 FOR DETAILS |
| EXIT 5 | OFF & ON RAMPS - SEE SHEETS 15 & 16 FOR DETAILS |
| EXIT 6 | OFF & ON RAMPS - SEE SHEETS 17 & 18 FOR DETAILS |

NOTE: ALL DIMENSIONS IN MILLIMETERS EXCEPT AS INDICATED

| | |
|------------|-------|
| DATUM | _____ |
| VERTICAL | _____ |
| HORIZONTAL | _____ |

NOT TO SCALE

PROJECT TYPICAL SHEET 2

| | |
|--|-------------------------------|
| PROJECT: BRATTLEBORO - ROCKINGHAM | PROJECT NO.: IM 091-1(39) |
| DESIGN FILE NAME: <u>./pave/99a202/pa202.dgn</u> | PLOT DATE: <u>02-JUN-2005</u> |
| IPARM FILE NAME: <u>pa202ty02.d</u> | SURVEY DATE: <u>10/00</u> |
| SURVEYED BY: <u>CLD ENGINEERS INC</u> | DRAWN BY: <u>MPS</u> |
| SQUAD LEADER: <u>WRH</u> | SHEET: <u>4</u> OF <u>37</u> |