

TEMPORARY AND DURABLE 150 mm YELLOW LINE
 EXIT 4
 SOUTHBOUND OFF RAMP 147 SOLID LT
 POLY UREA - LPM 1200

TEMPORARY AND DURABLE 150 mm WHITE LINE
 EXIT 4
 SOUTHBOUND OFF RAMP 150 SOLID RT
 INTERSTATE 91 ~~62-75~~ DASHED RT
 INTERSTATE 91 ~~137-50~~ DOTTED RT
 POLY UREA - LPM 1200

TEMPORARY AND DURABLE 300 mm WHITE LINE
 EXIT 4
 SOUTHBOUND OFF RAMP 30 SOLID LT
 INTERSTATE 91 45 SOLID RT
 THERMOPLASTIC - DOBCO









TEMPORARY AND DURABLE LETTER OR SYMBOL
 EXIT 4
 SOUTHBOUND OFF RAMP "STOP"
 SOUTHBOUND OFF RAMP "AHEAD"
 SOUTHBOUND OFF RAMP "STOP"

TEMPORARY & DURABLE 600 mm STOP BAR

EXIT 4
 SOUTHBOUND OFF RAMP
 THERMOPLASTIC - DOBCO

REMOVING SIGNS
 AS SHOWN - 10

EXIT 4 - RAMP B SOUTHBOUND OFF RAMP

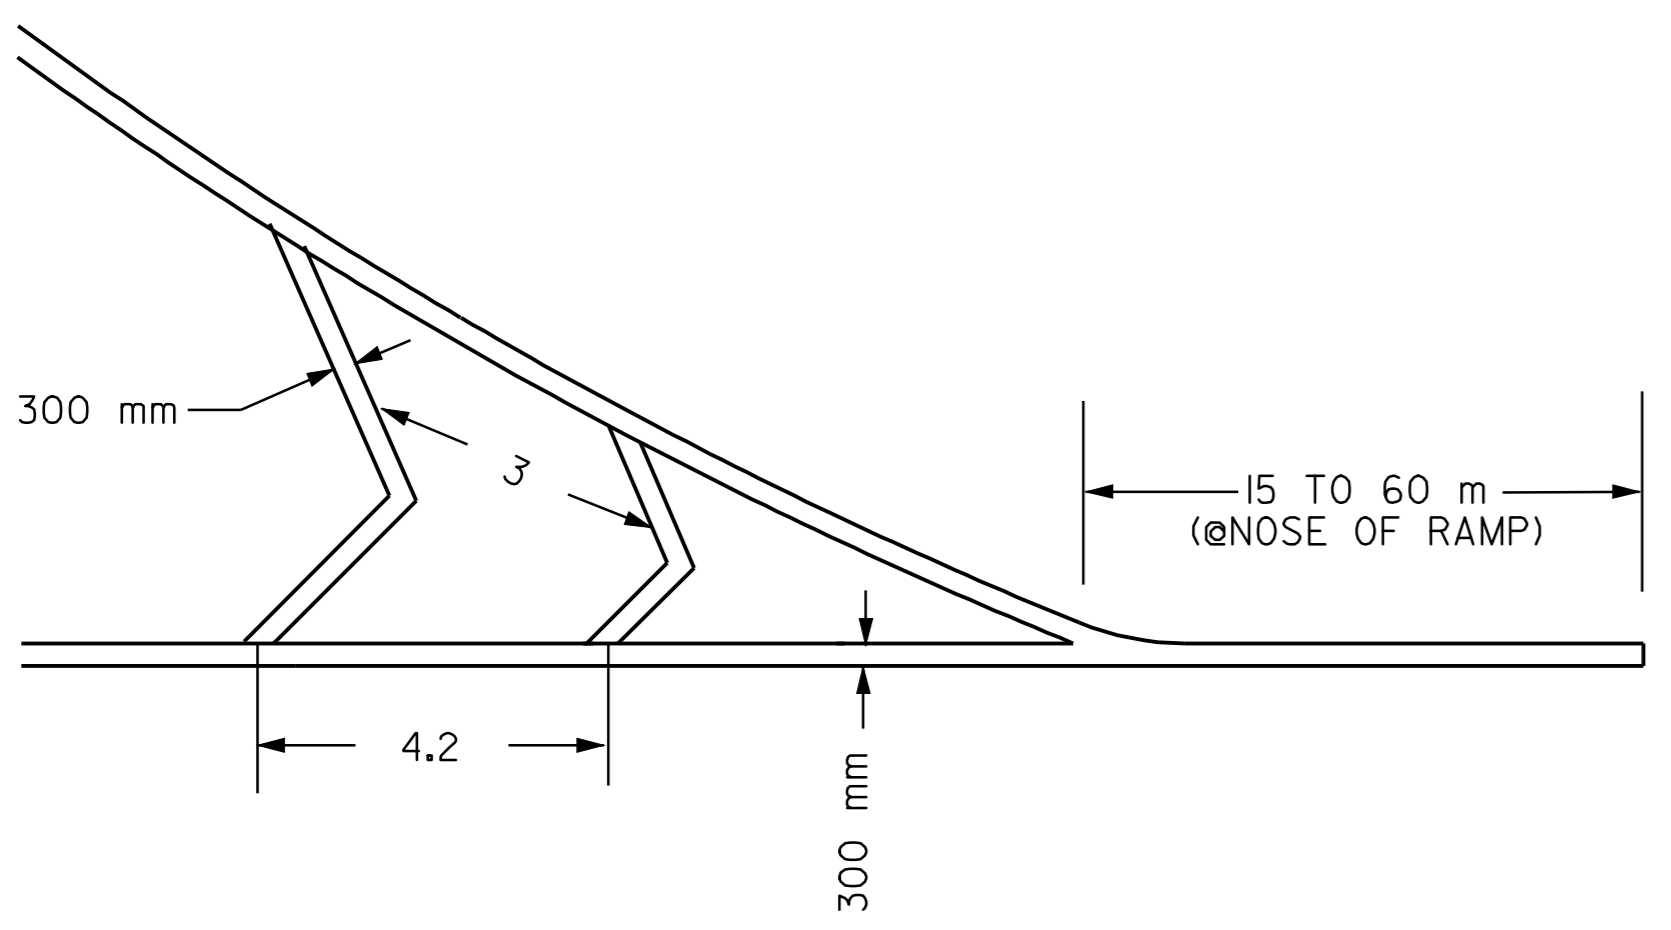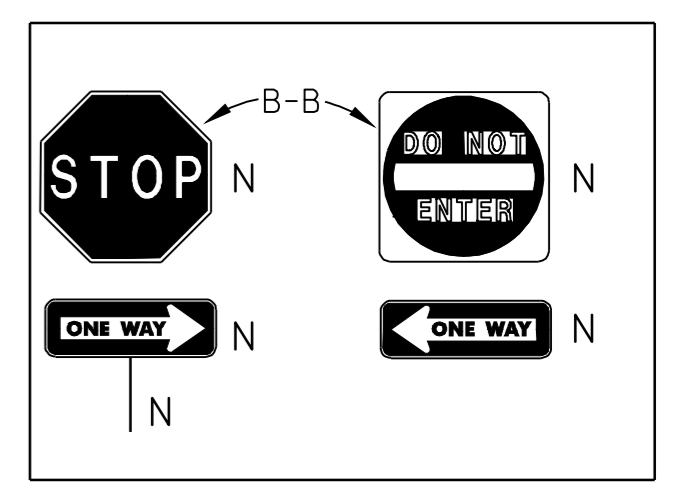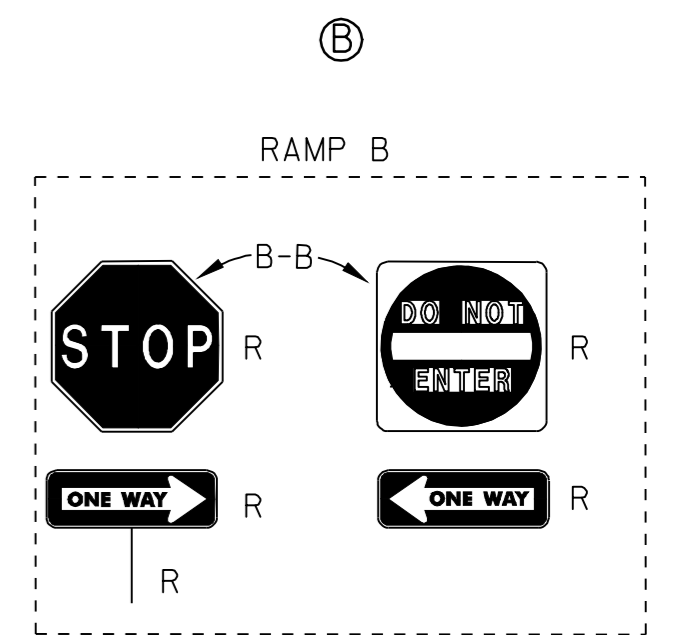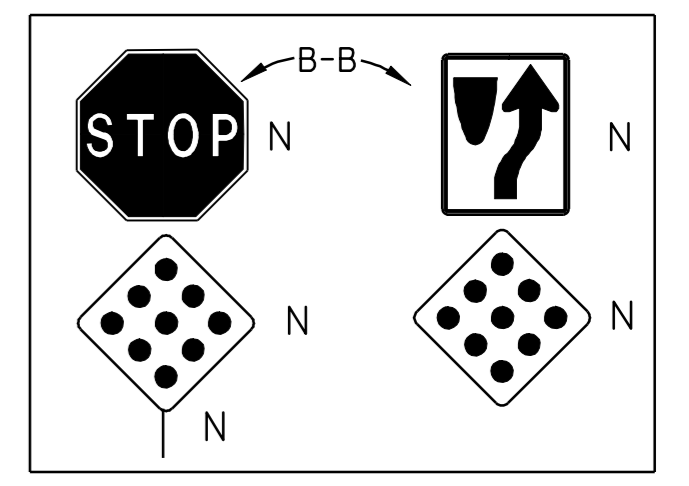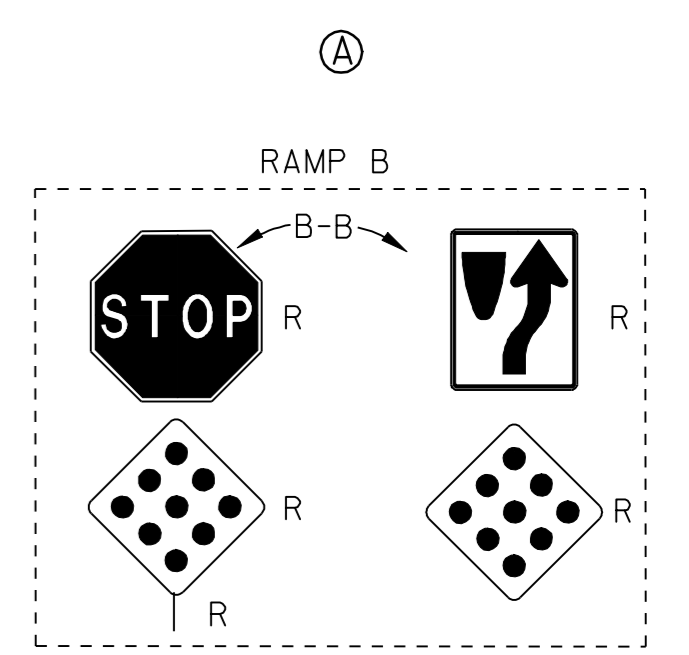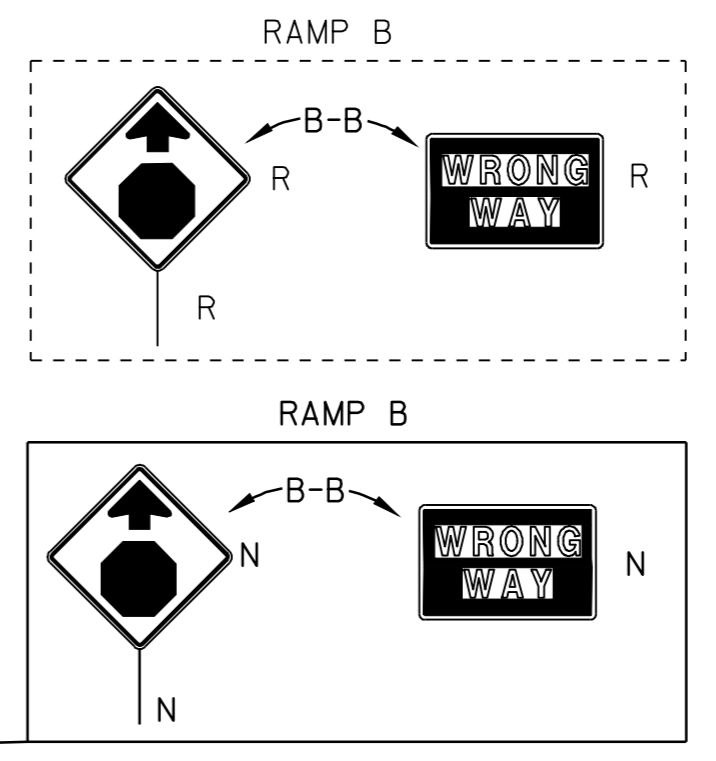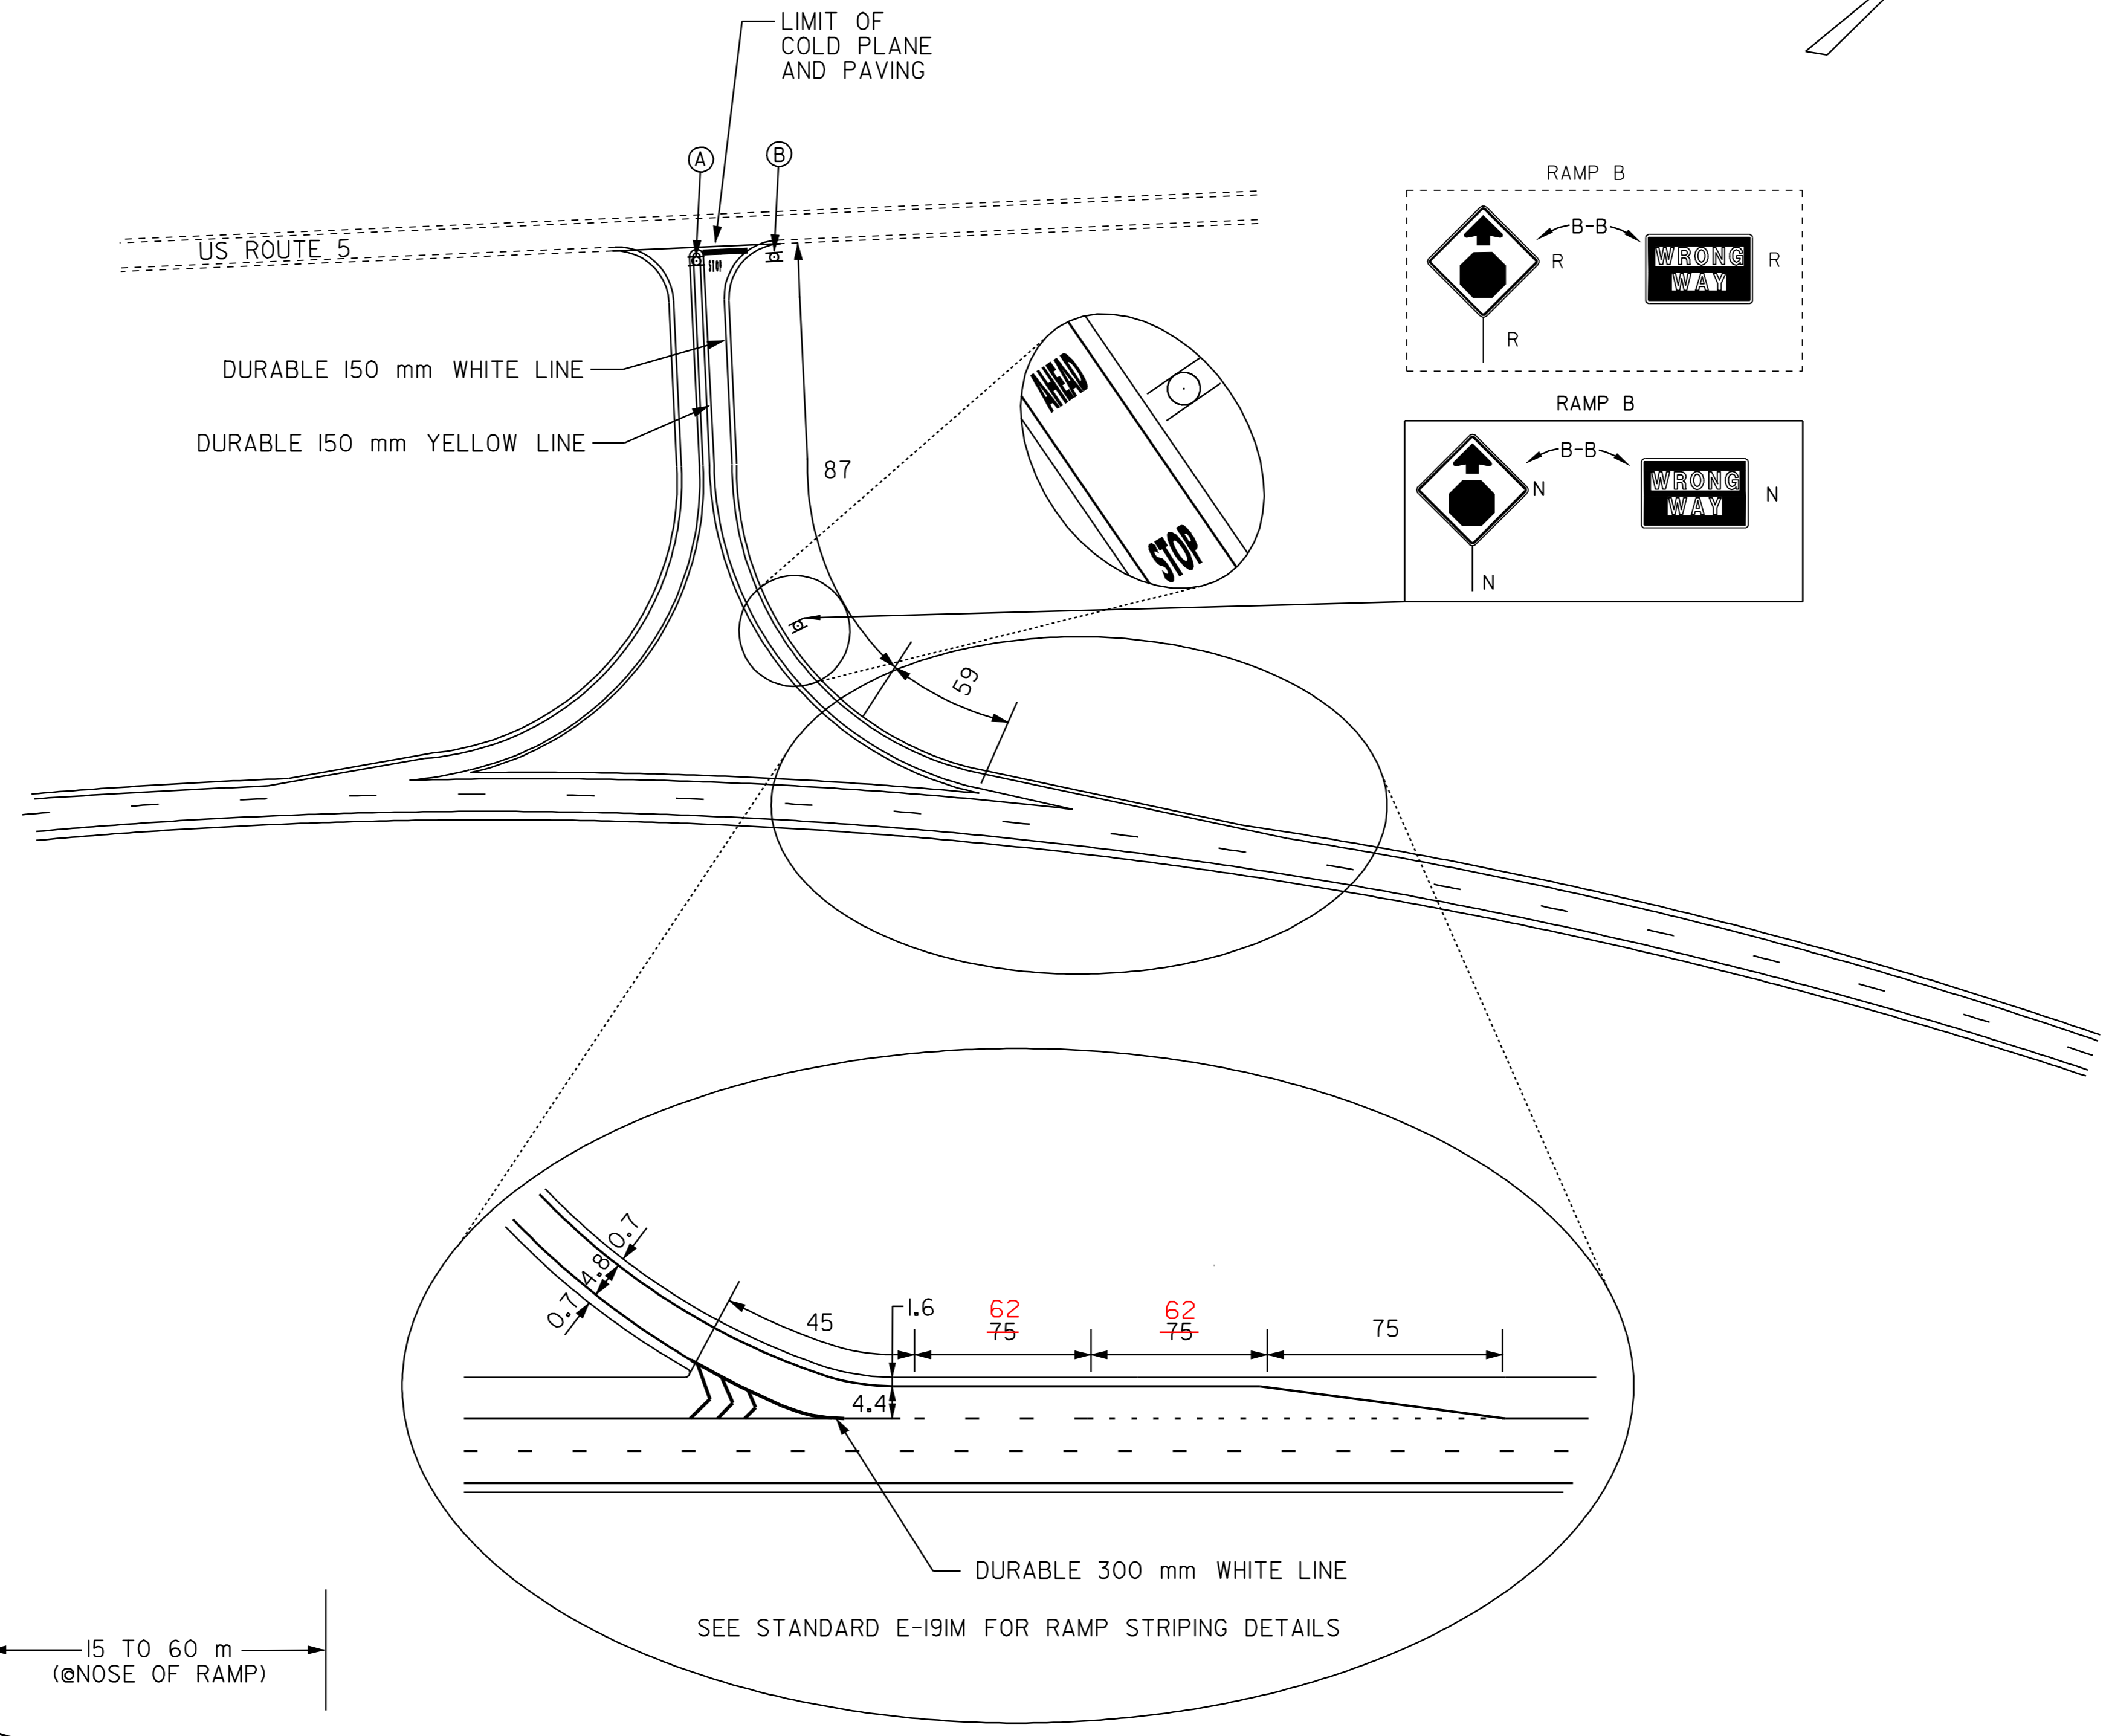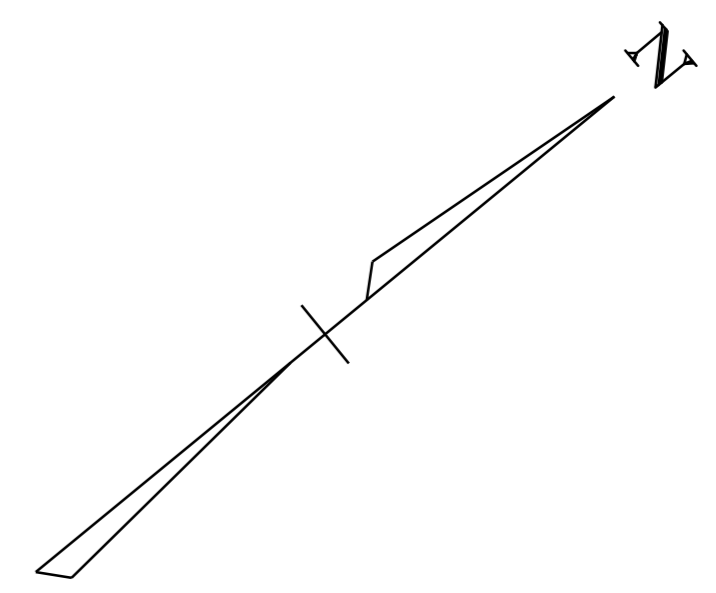

GORE MARKING DETAIL

LEGEND

- R = REMOVE EXISTING
- S = SALVAGE
- R&S = REMOVE AND SALVAGE
- N = NEW
- RET = RETAIN
- B-B = BACK TO BACK
- = NEW RAIL
- = EXISTING RAIL
- ⊗ = BORING LOCATION

NOTE: ALL DIMENSIONS IN METERS EXCEPT AS INDICATED

**RAMP
 DETAIL #1**

PROJECT: BRATTLEBORO-ROCKINGHAM	PROJECT NO.: IM 091-I(39)
DESIGN FILE NAME: /pave/99a202/pa202.dgn	PLOT DATE: 02-JUN-2005
IPARM FILE NAME: pa202d+01.i	SURVEY DATE: 10/00
SURVEYED BY: CLD_ENGINEERS_INC	DRAWN BY: HJC
SQUAD LEADER: WRH	SHEET: 17 OF 37

NOT TO SCALE

DATUM	
VERTICAL	
HORIZONTAL	