

TEMPORARY AND DURABLE 150 mm YELLOW LINE
 EXIT 6
 SOUTHBOUND OFF RAMP 372 SOLID LT
 (POLY UREA) DOBCO

BITUMINOUS CONCRETE GUTTERS AND TRAFFIC ISLANDS
 EXIT 6
 SOUTHBOUND OFF RAMP 2

REMOVING SIGNS
 AS SHOWN - 9

TEMPORARY AND DURABLE 150 mm WHITE LINE
 EXIT 6
 SOUTHBOUND OFF RAMP 376 SOLID RT POLY UREA LPM - 1200
 INTERSTATE 91 30-75 DASHED RT THERMOPLASTIC DOBCO
 INTERSTATE 91 126-150 DOTTED RT THERMOPLASTIC DOBCO

TEMPORARY AND DURABLE LETTER OR SYMBOL
 EXIT 6
 SOUTHBOUND OFF RAMP "STOP"
 SOUTHBOUND OFF RAMP "AHEAD"
 SOUTHBOUND OFF RAMP "STOP"

TEMPORARY AND DURABLE 300 mm WHITE LINE THERMOPLASTIC DOBCO







EXIT 6
 SOUTHBOUND OFF RAMP 17 SOLID LT
 INTERSTATE 91 32 SOLID RT

+ DIAGONALS
 + GORE MARKINGS EXIT 6 OFF RAMP

TEMPORARY AND DURABLE 600 mm STOP BAR

EXIT 6
 SOUTHBOUND OFF RAMP THERMOPLASTIC DOBCO

EXIT 6 - RAMP C & G SOUTHBOUND OFF RAMP

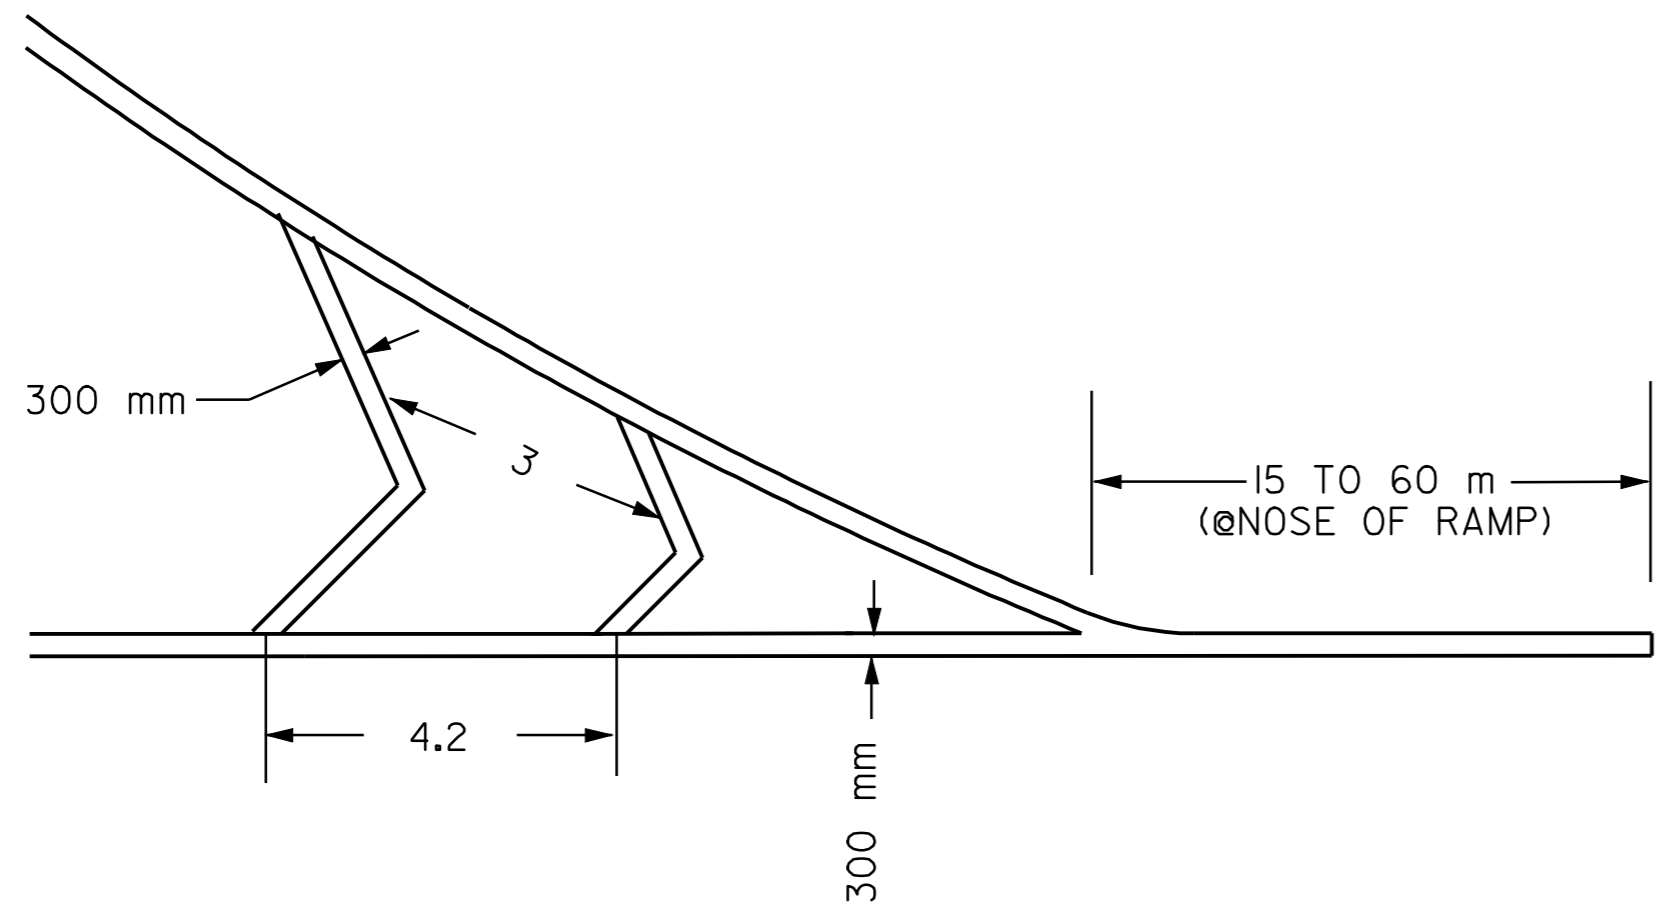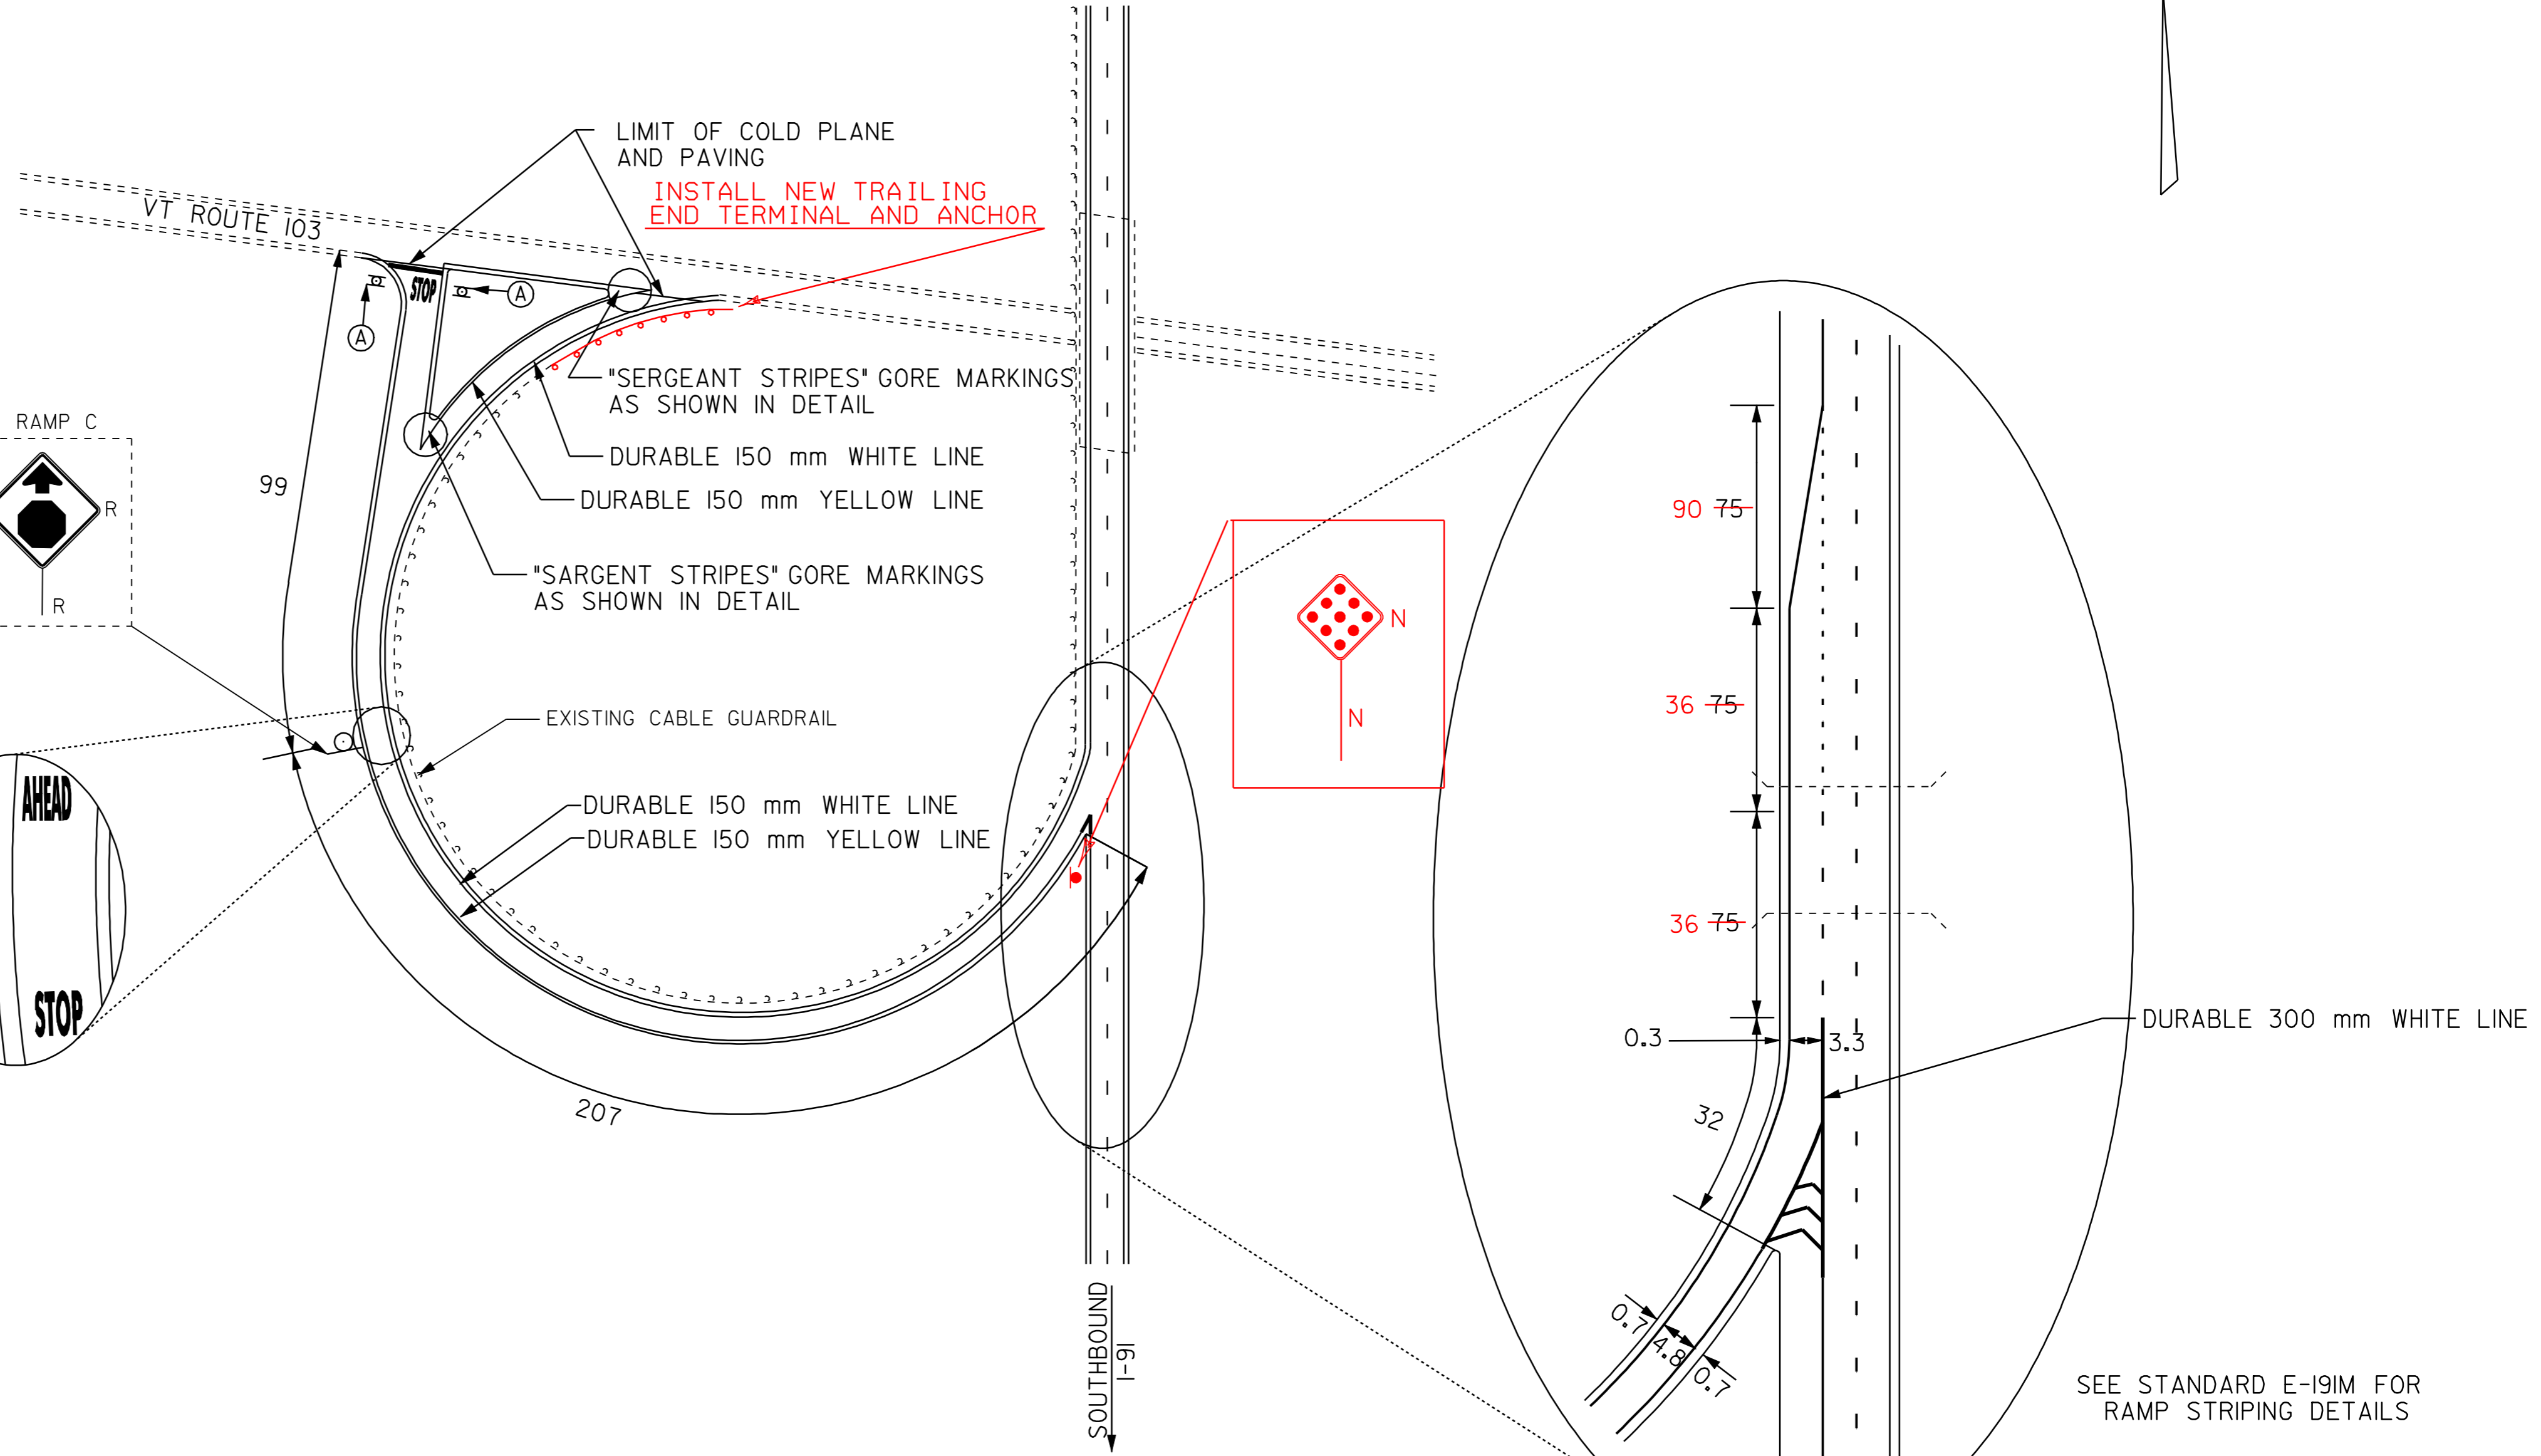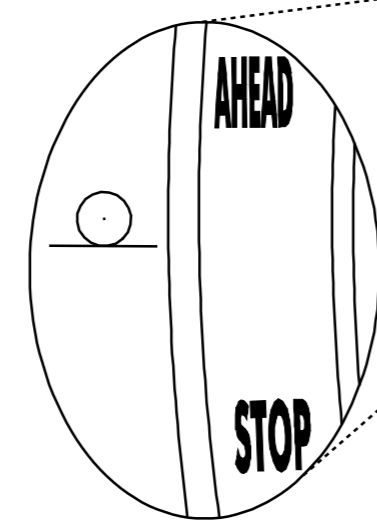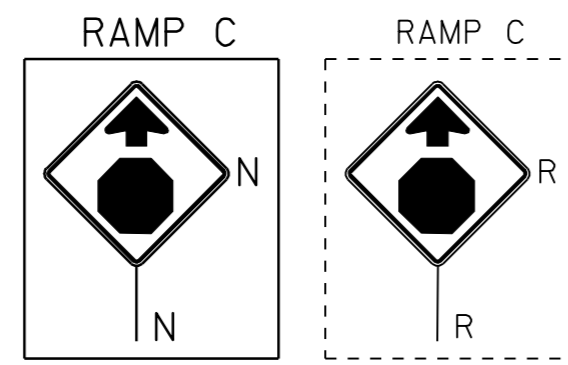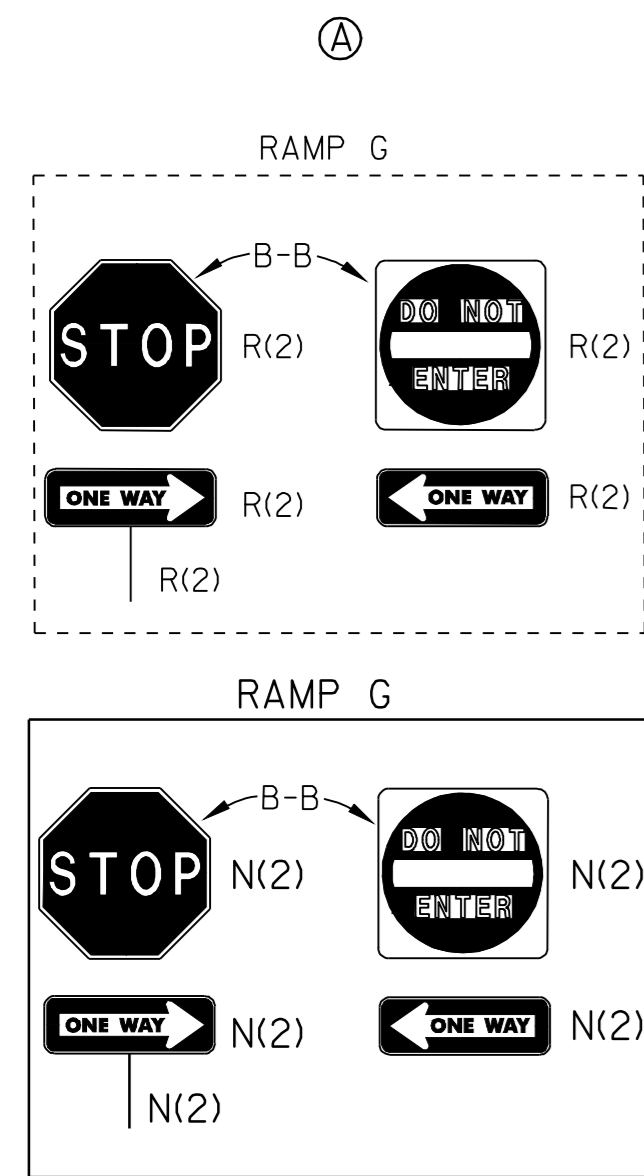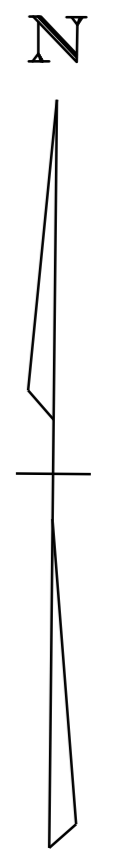

GORE MARKING DETAIL

LEGEND

- R = REMOVE EXISTING
- S = SALVAGE
- R&S = REMOVE AND SALVAGE
- N = NEW
- RET = RETAIN
- B-B = BACK TO BACK
- = NEW RAIL
- = EXISTING RAIL
- ⊗ = BORING LOCATION

NOTE: ALL DIMENSIONS IN METERS EXCEPT AS INDICATED

**RAMP
 DETAIL #5**

PROJECT: BRATTLEBORO-ROCKINGHAM	PROJECT NO.: IM 091-I(39)
DESIGN FILE NAME: /pave/99a202/pa202.dgn	PLOT DATE: 02-JUN-2005
IPARM FILE NAME: pa202d+05.l	SURVEY DATE: 10/00
SURVEYED BY: CLD_ENGINEERS_INC	DRAWN BY: HJC
SQUAD LEADER: WRH	SHEET: 21 OF 37

NOT TO SCALE

DATUM	
VERTICAL	
HORIZONTAL	