


TEMPORARY AND DURABLE 150 mm WHITE LINE  
 WEIGH STATION 171 SOLID RT (LANE LINE)  
 DECELERATION LANE ~~140~~ DOTTED RT ~~143~~  
 DECELERATION LANE ~~56~~ DASHED LINE ~~59~~  
 ACCELERATION LANE ~~85~~ DASHED LINE ~~98~~

~~TEMPORARY AND DURABLE 150 mm YELLOW LINE~~  
 GRASS ISLAND 181 SOLID RT

~~TEMPORARY AND DURABLE 100 mm WHITE LINE~~  
 LANE AND EDGE 342 SOLID RT

~~TEMPORARY AND DURABLE 100 mm YELLOW LINE~~  
 GRASS ISLAND 181 SOLID RT

TEMPORARY AND DURABLE 300 mm WHITE LINE  
 WEIGH STATION  
 INTERSTATE 91 60 SOLID RT  
 OFF RAMP 39 SOLID LT 45  
 ON RAMP 45 SOLID LT  
 INTERSTATE 91 ~~103~~ SOLID RT 105

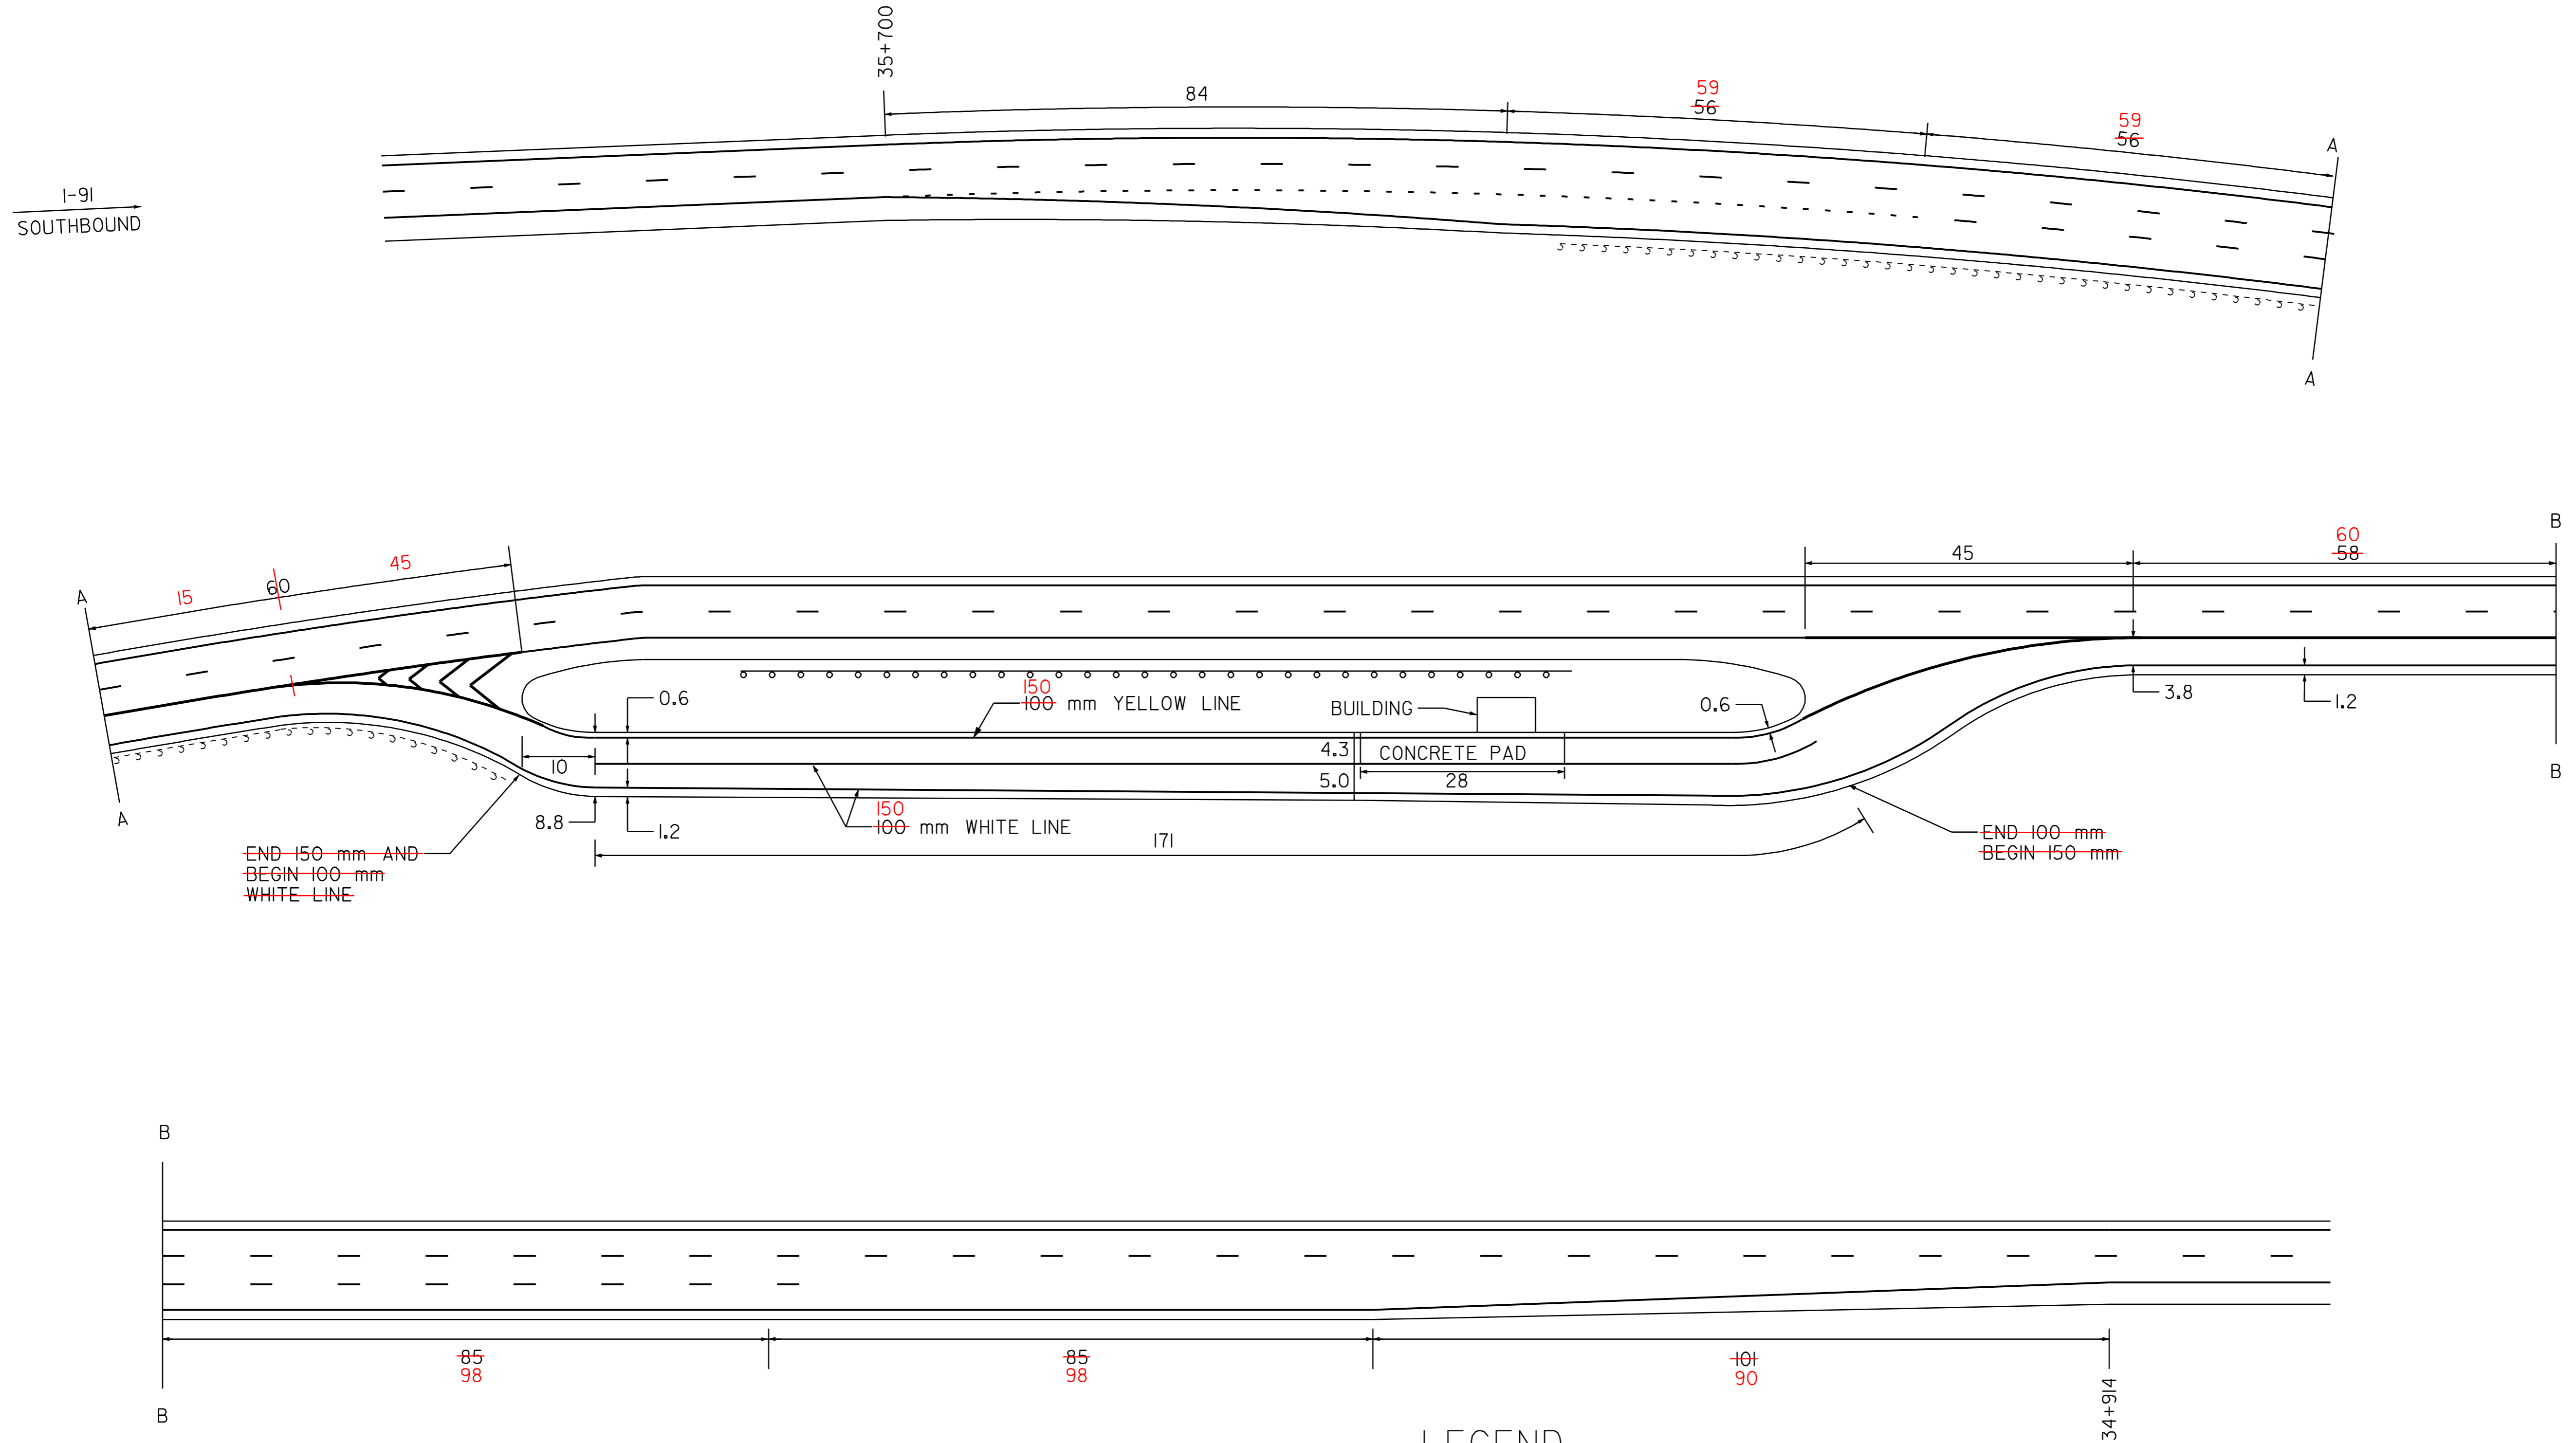

END 150 mm AND  
 BEGIN 100 mm  
 WHITE LINE

END 100 mm  
 BEGIN 150 mm

LEGEND

- R = REMOVE EXISTING
- S = SALVAGE
- R&S = REMOVE AND SALVAGE
- N = NEW
- RET = RETAIN
- B-B = BACK TO BACK
- = NEW RAIL
- - - = EXISTING RAIL
- ⊗ = BORING LOCATION

NOTE: ALL DIMENSIONS IN METERS EXCEPT AS INDICATED

**WEIGH STATION DETAIL**

PROJECT: BRATTLEBORO-ROCKINGHAM	PROJECT NO.: IM 091-I(39)
DESIGN FILE NAME: /pave/99q202/pa202.dgn	PLOT DATE: 02-JUN-2005
IPARM FILE NAME: pa202dt08.i	SURVEY DATE: 6/99
SURVEYED BY: CLD ENGINEERS INC	DRAWN BY: MPS
SQUAD LEADER: WRH	SHEET: 24 OF 37

DATUM  
 VERTICAL \_\_\_\_\_  
 HORIZONTAL \_\_\_\_\_

NOT TO SCALE

I-91  
 SOUTHBOUND