




29+075

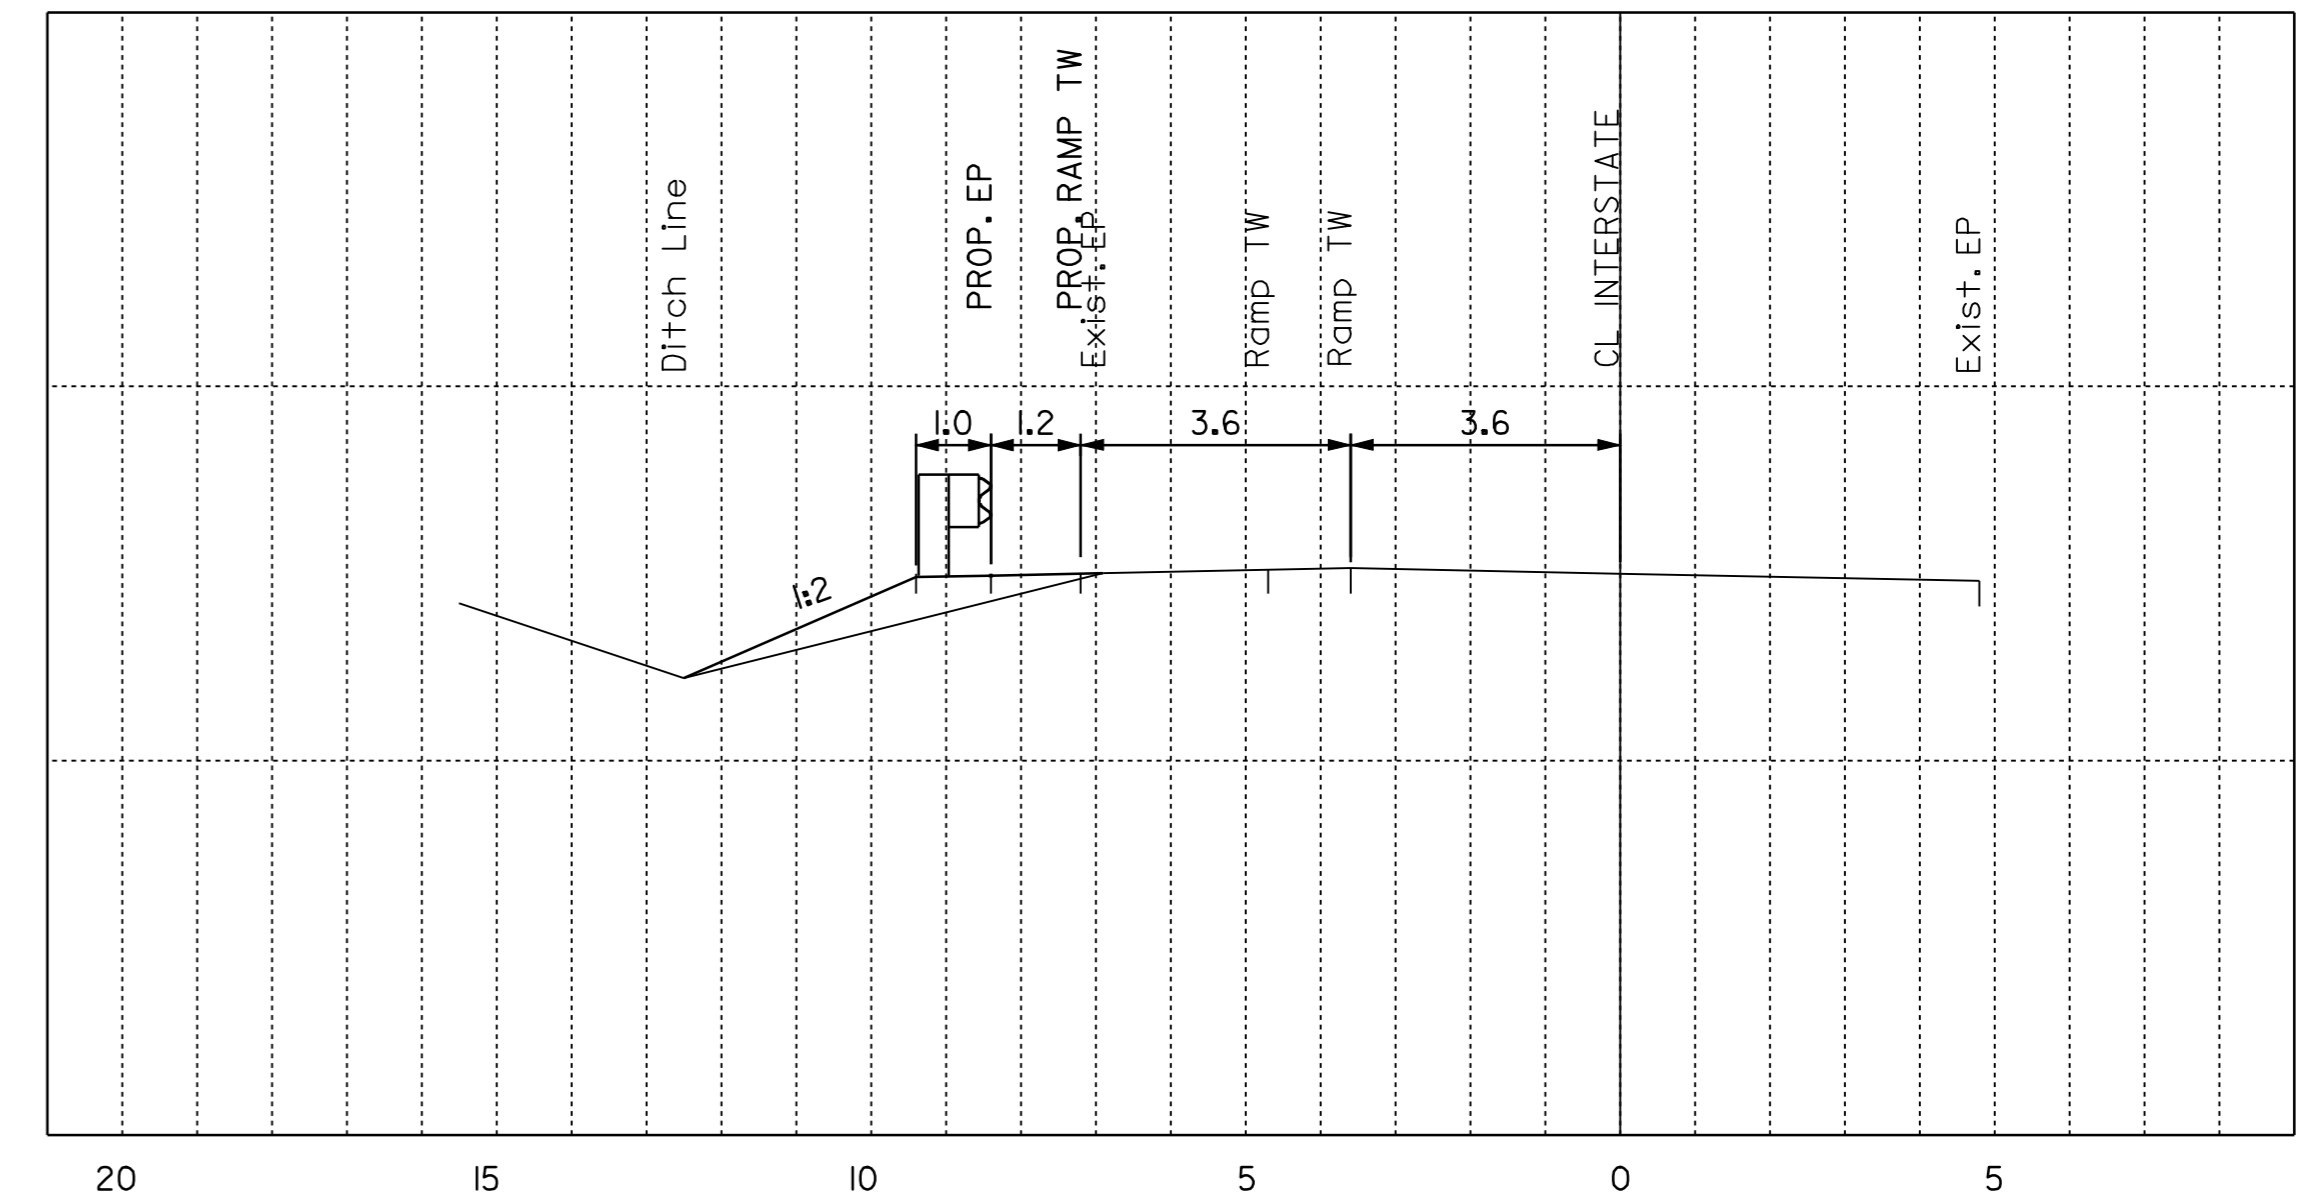

29+115

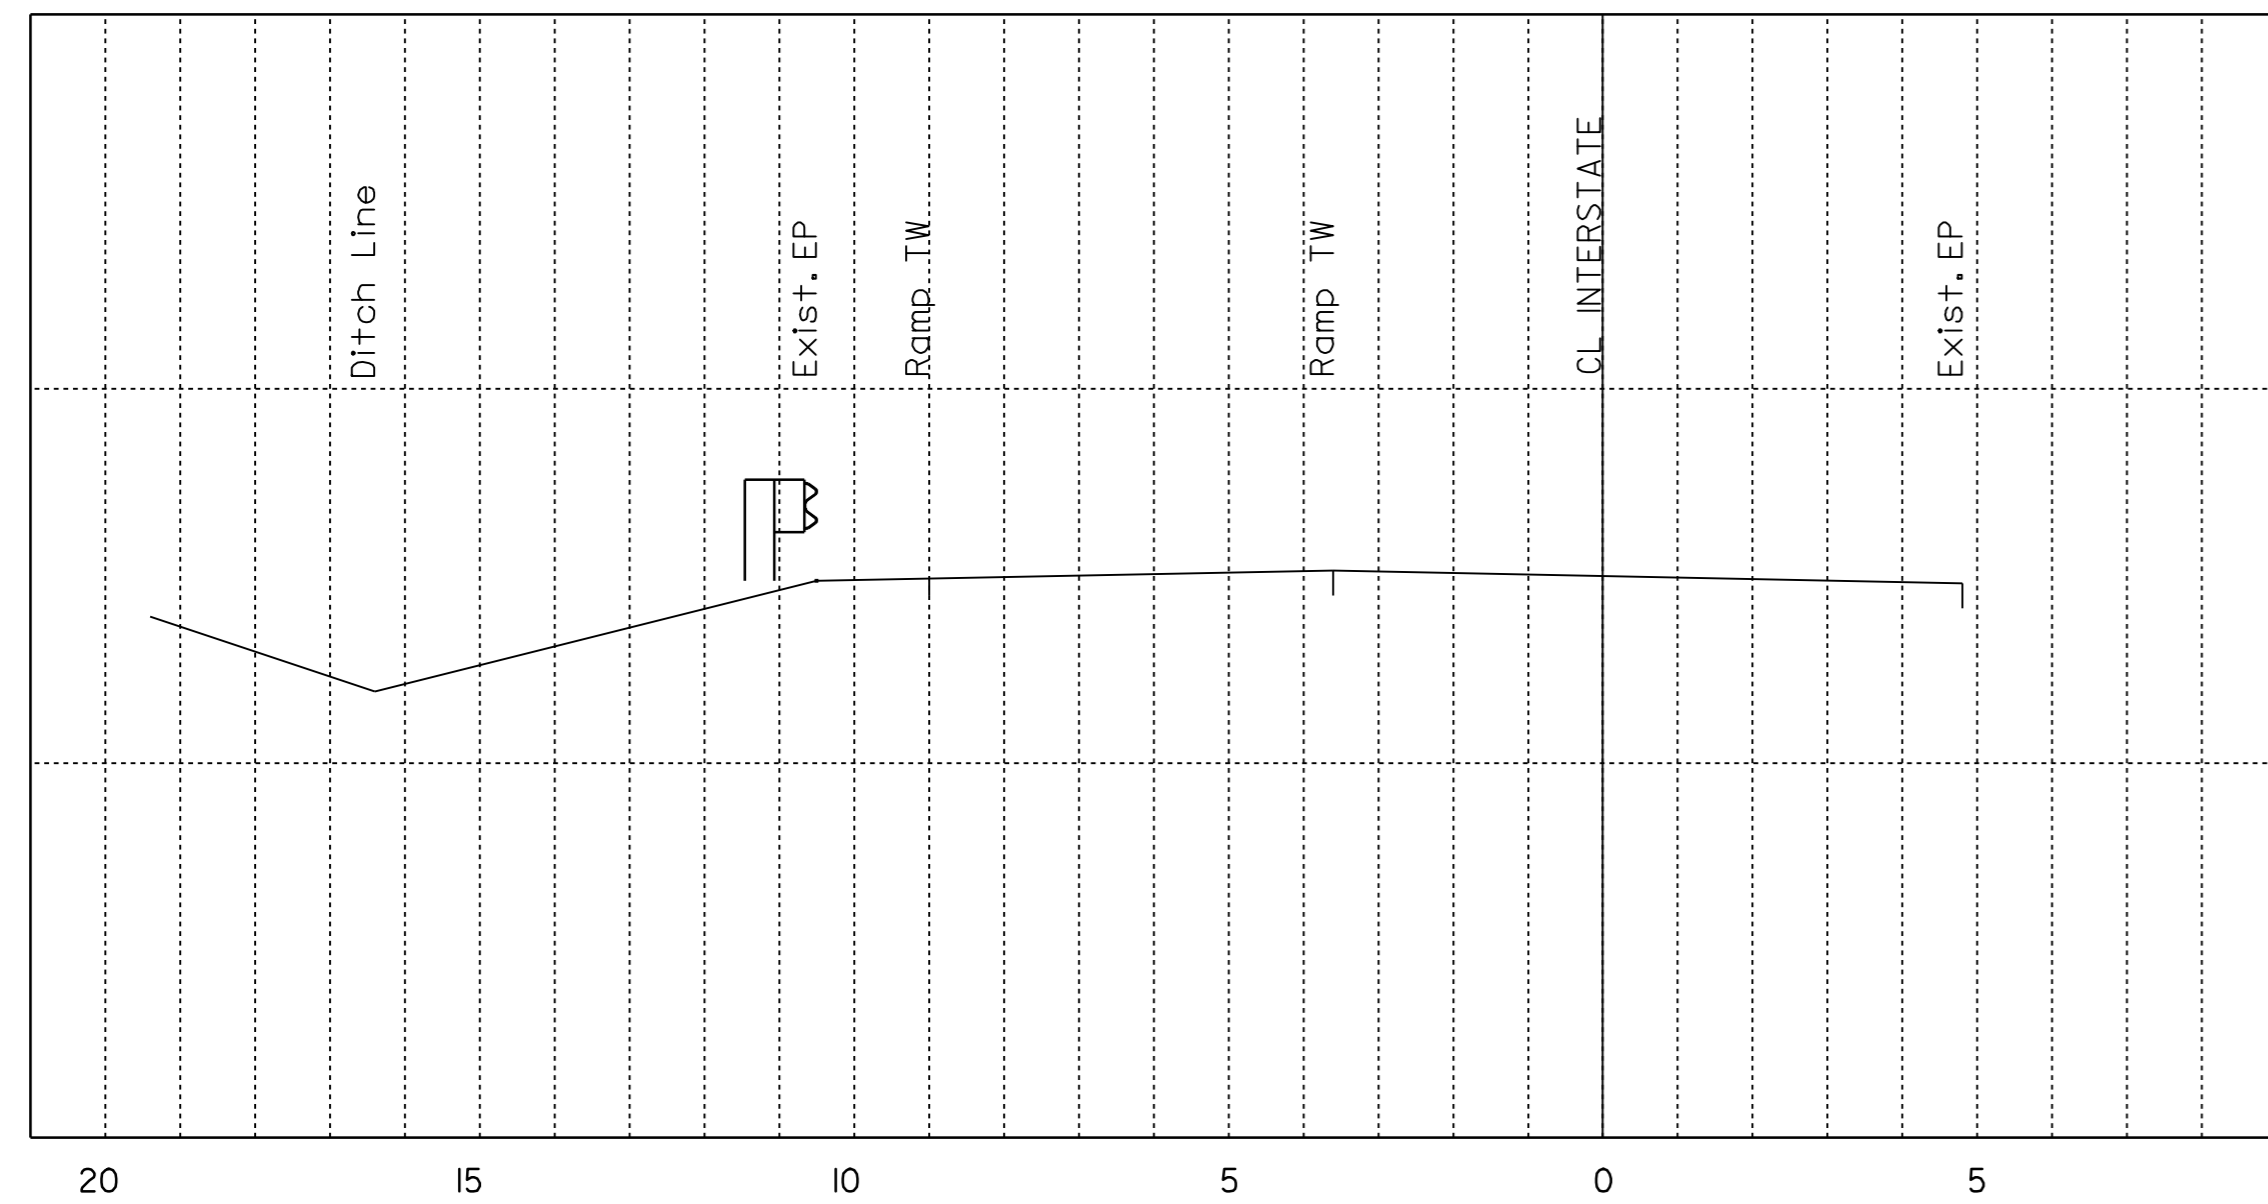

29+055

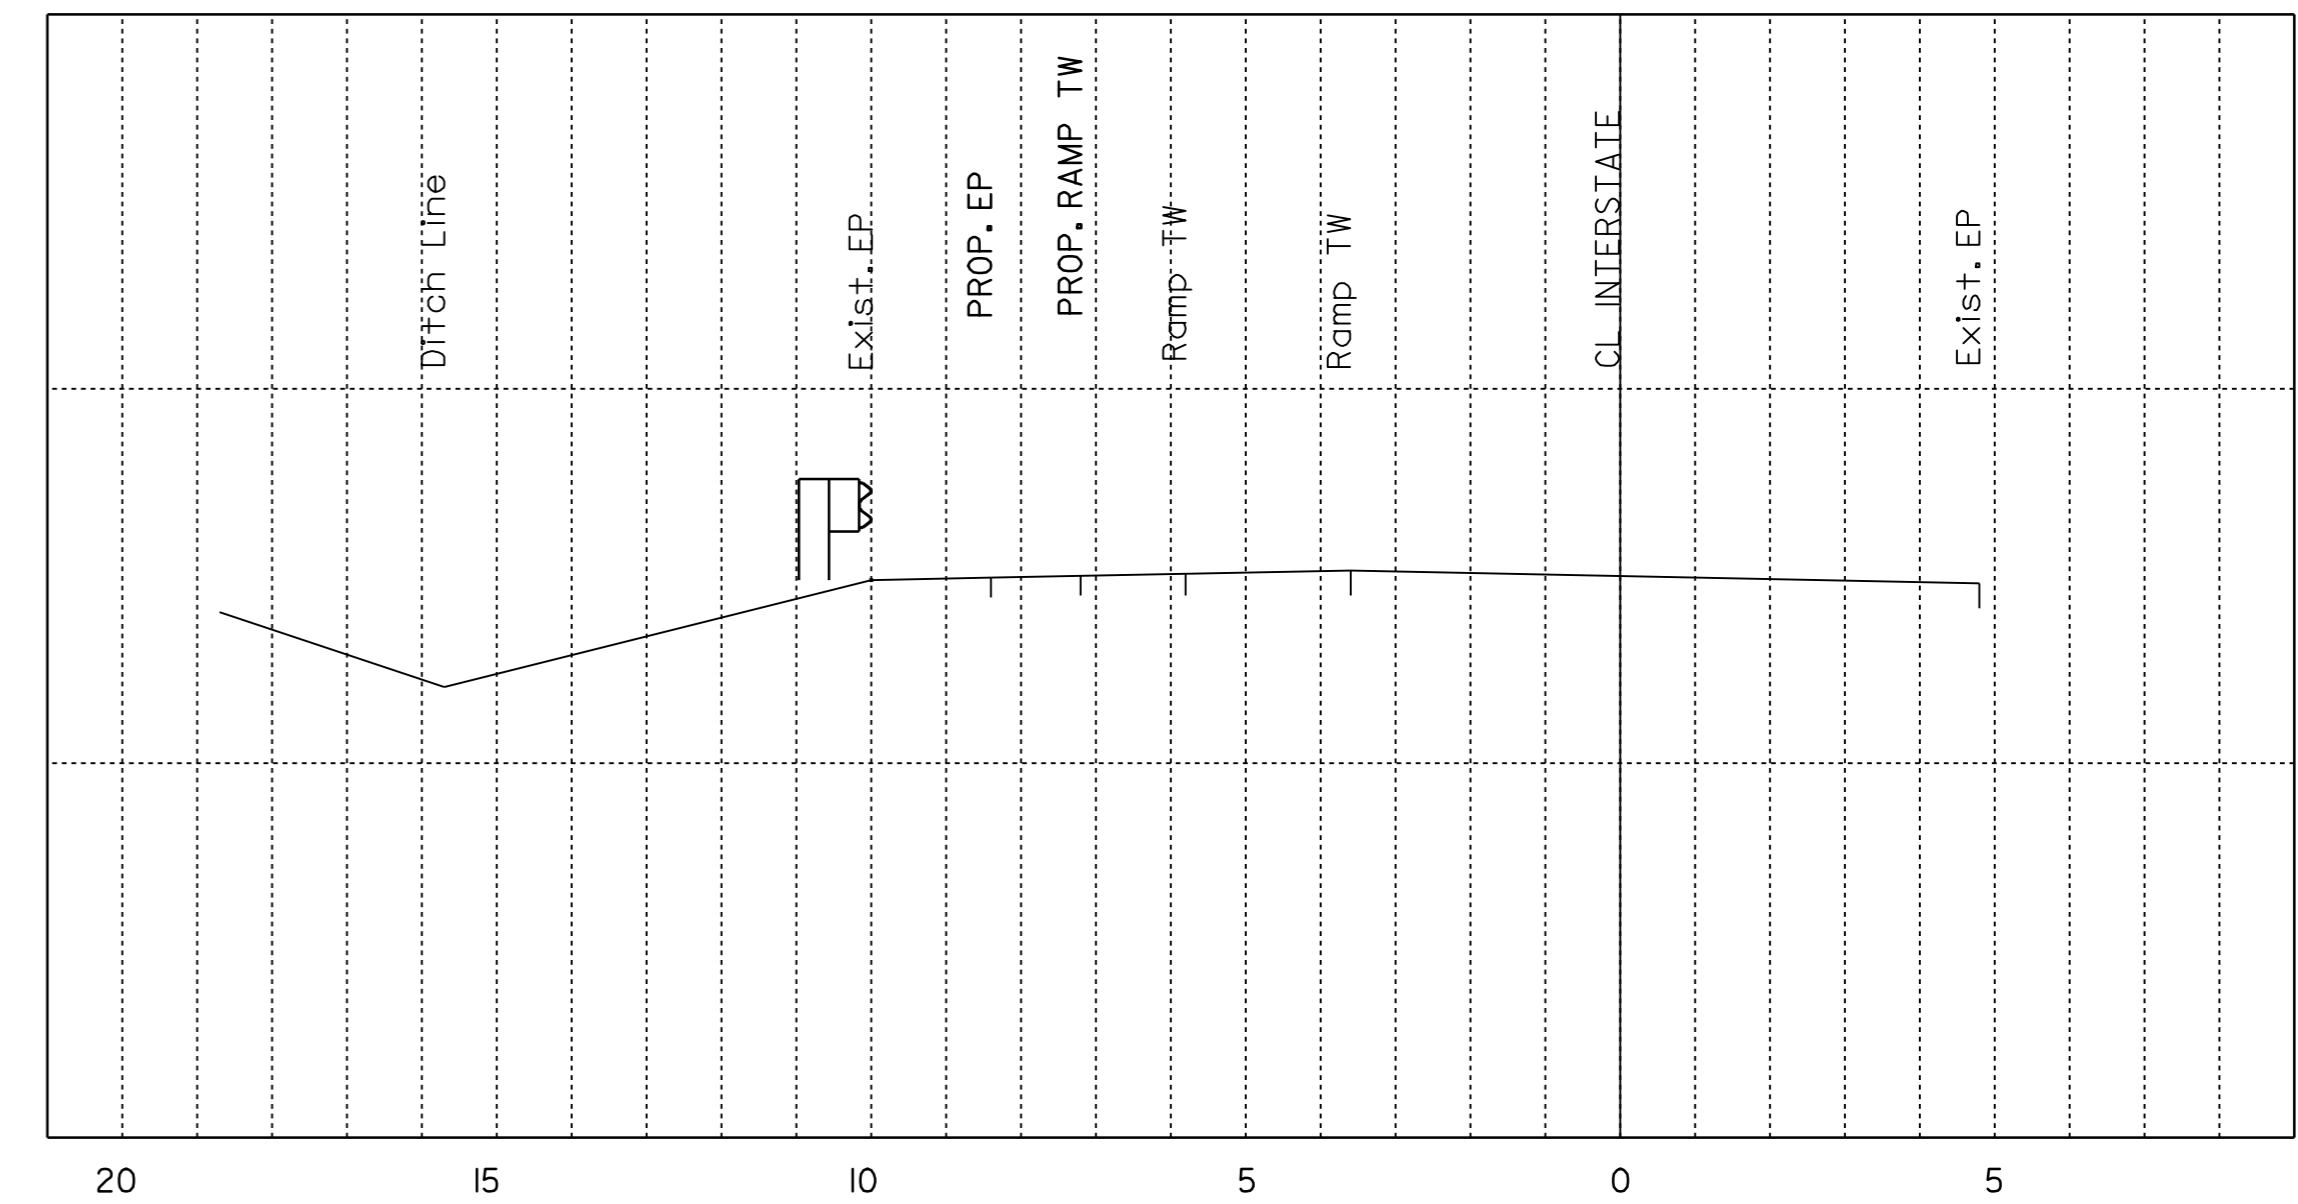

29+095

NOTE: SEE SHEET #24 FOR PAVEMENT WIDENING DETAIL

NOTE: ALL DIMENSIONS IN METERS EXCEPT AS INDICATED

DATUM  
VERTICAL \_\_\_\_\_  
HORIZONTAL \_\_\_\_\_

NOT TO SCALE

<b>EXIT 4 SB OFF CROSS SECTIONS SHEET 1</b>	PROJECT: BRATTLEBORO-ROCKINGHAM	PROJECT NO.: IM 091-I(39)
	DESIGN FILE NAME: /pave/99a202/pa202.dgn	
	IPARM FILE NAME: pa202xs01.l	PLOT DATE: 02-JUN-2005
	SURVEYED BY: CLD_ENGINEERS_INC	SURVEY DATE: 10/00
	SQUAD LEADER: WRH	DRAWN BY: NLL
		SHEET: 26 OF 37