




29+235

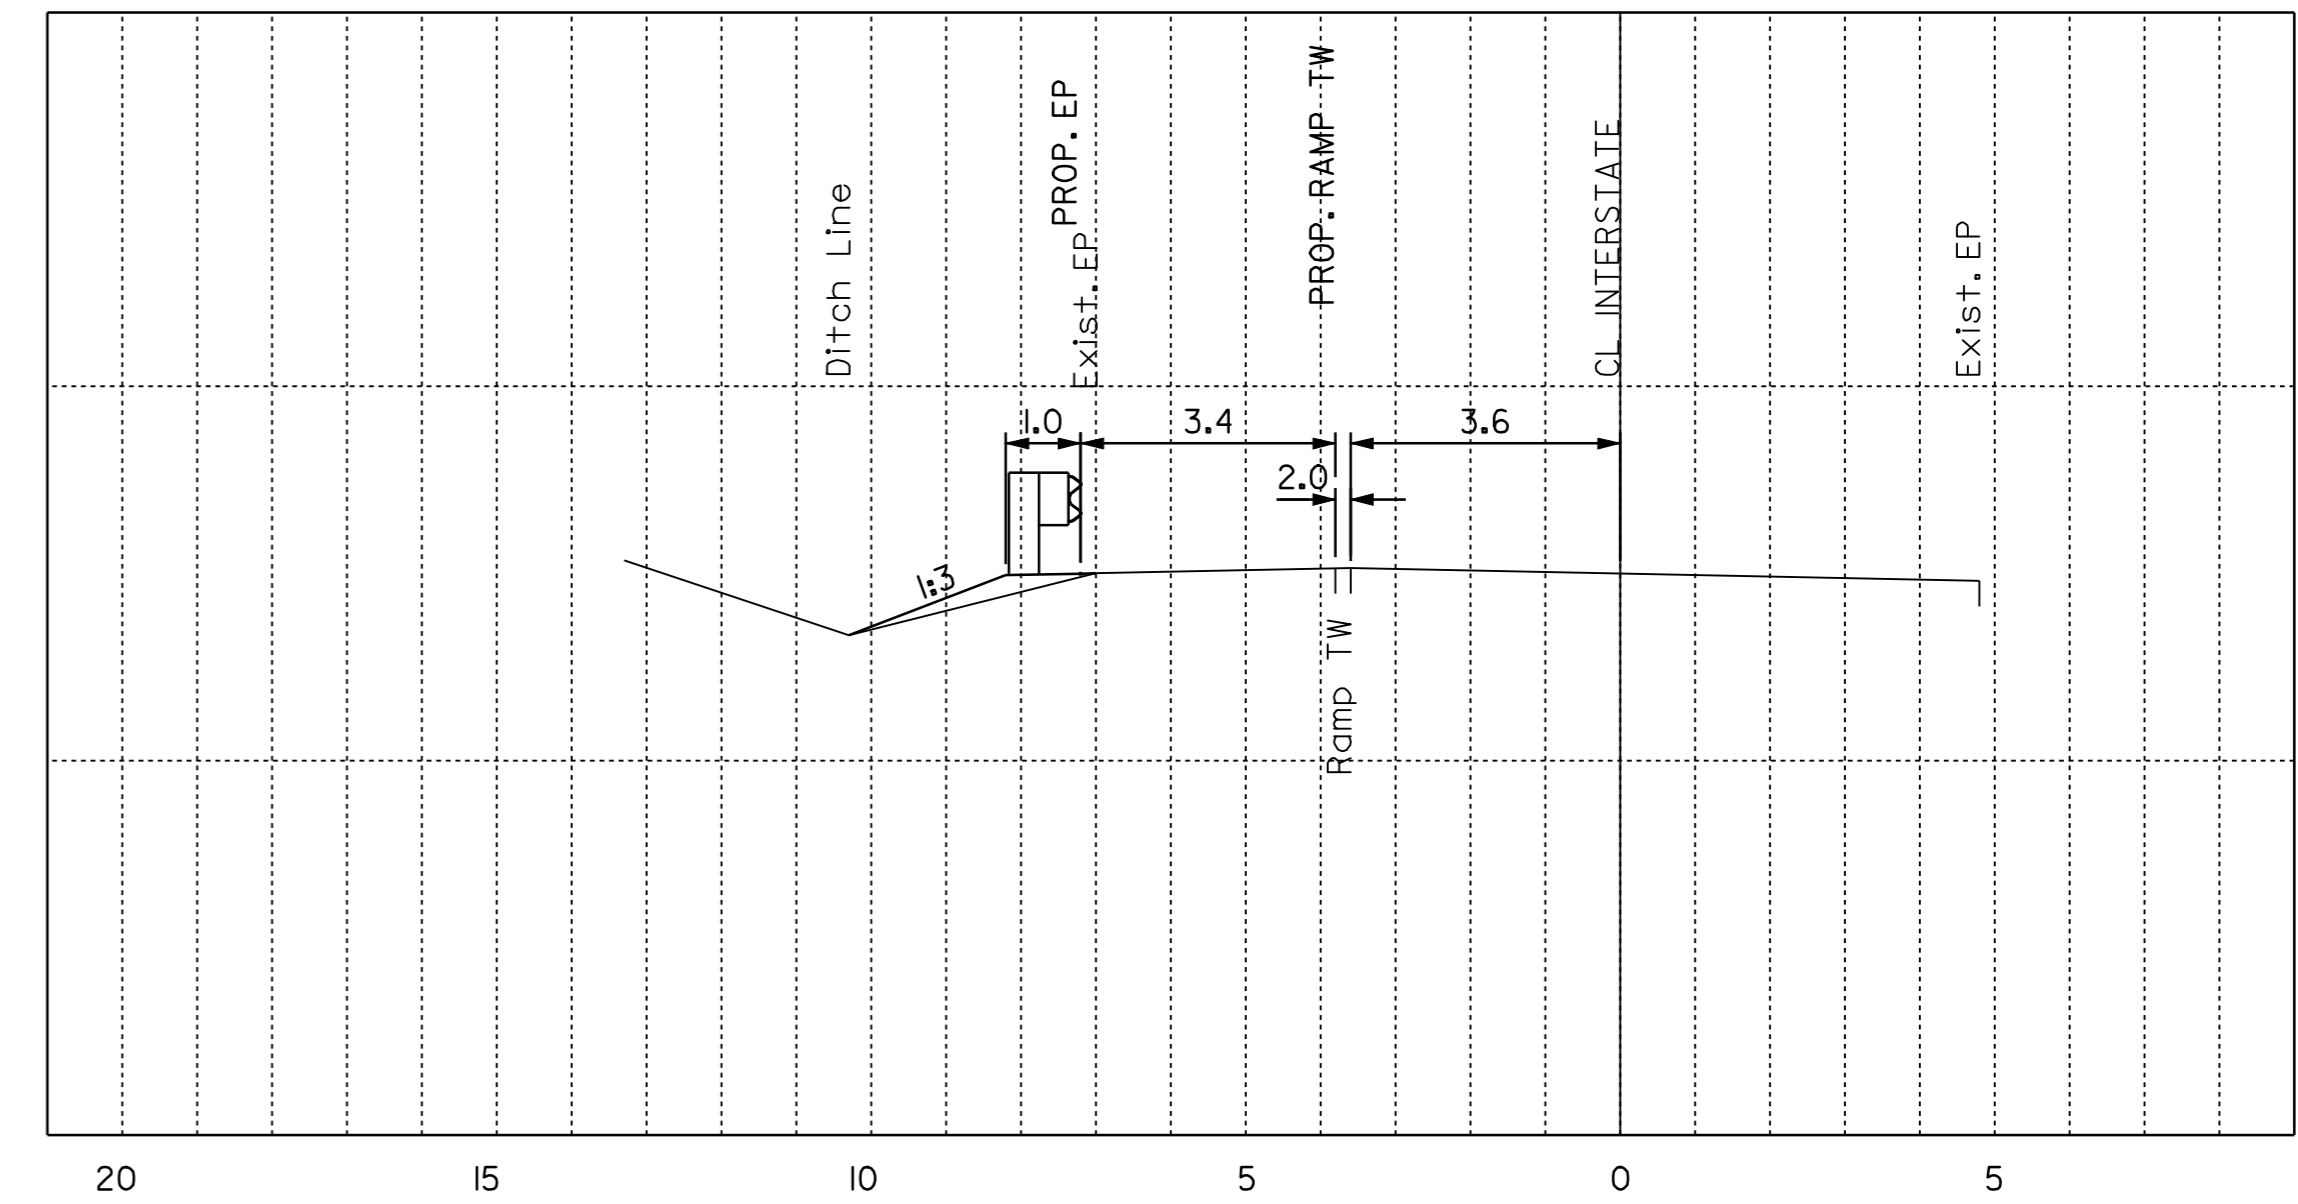

29+275

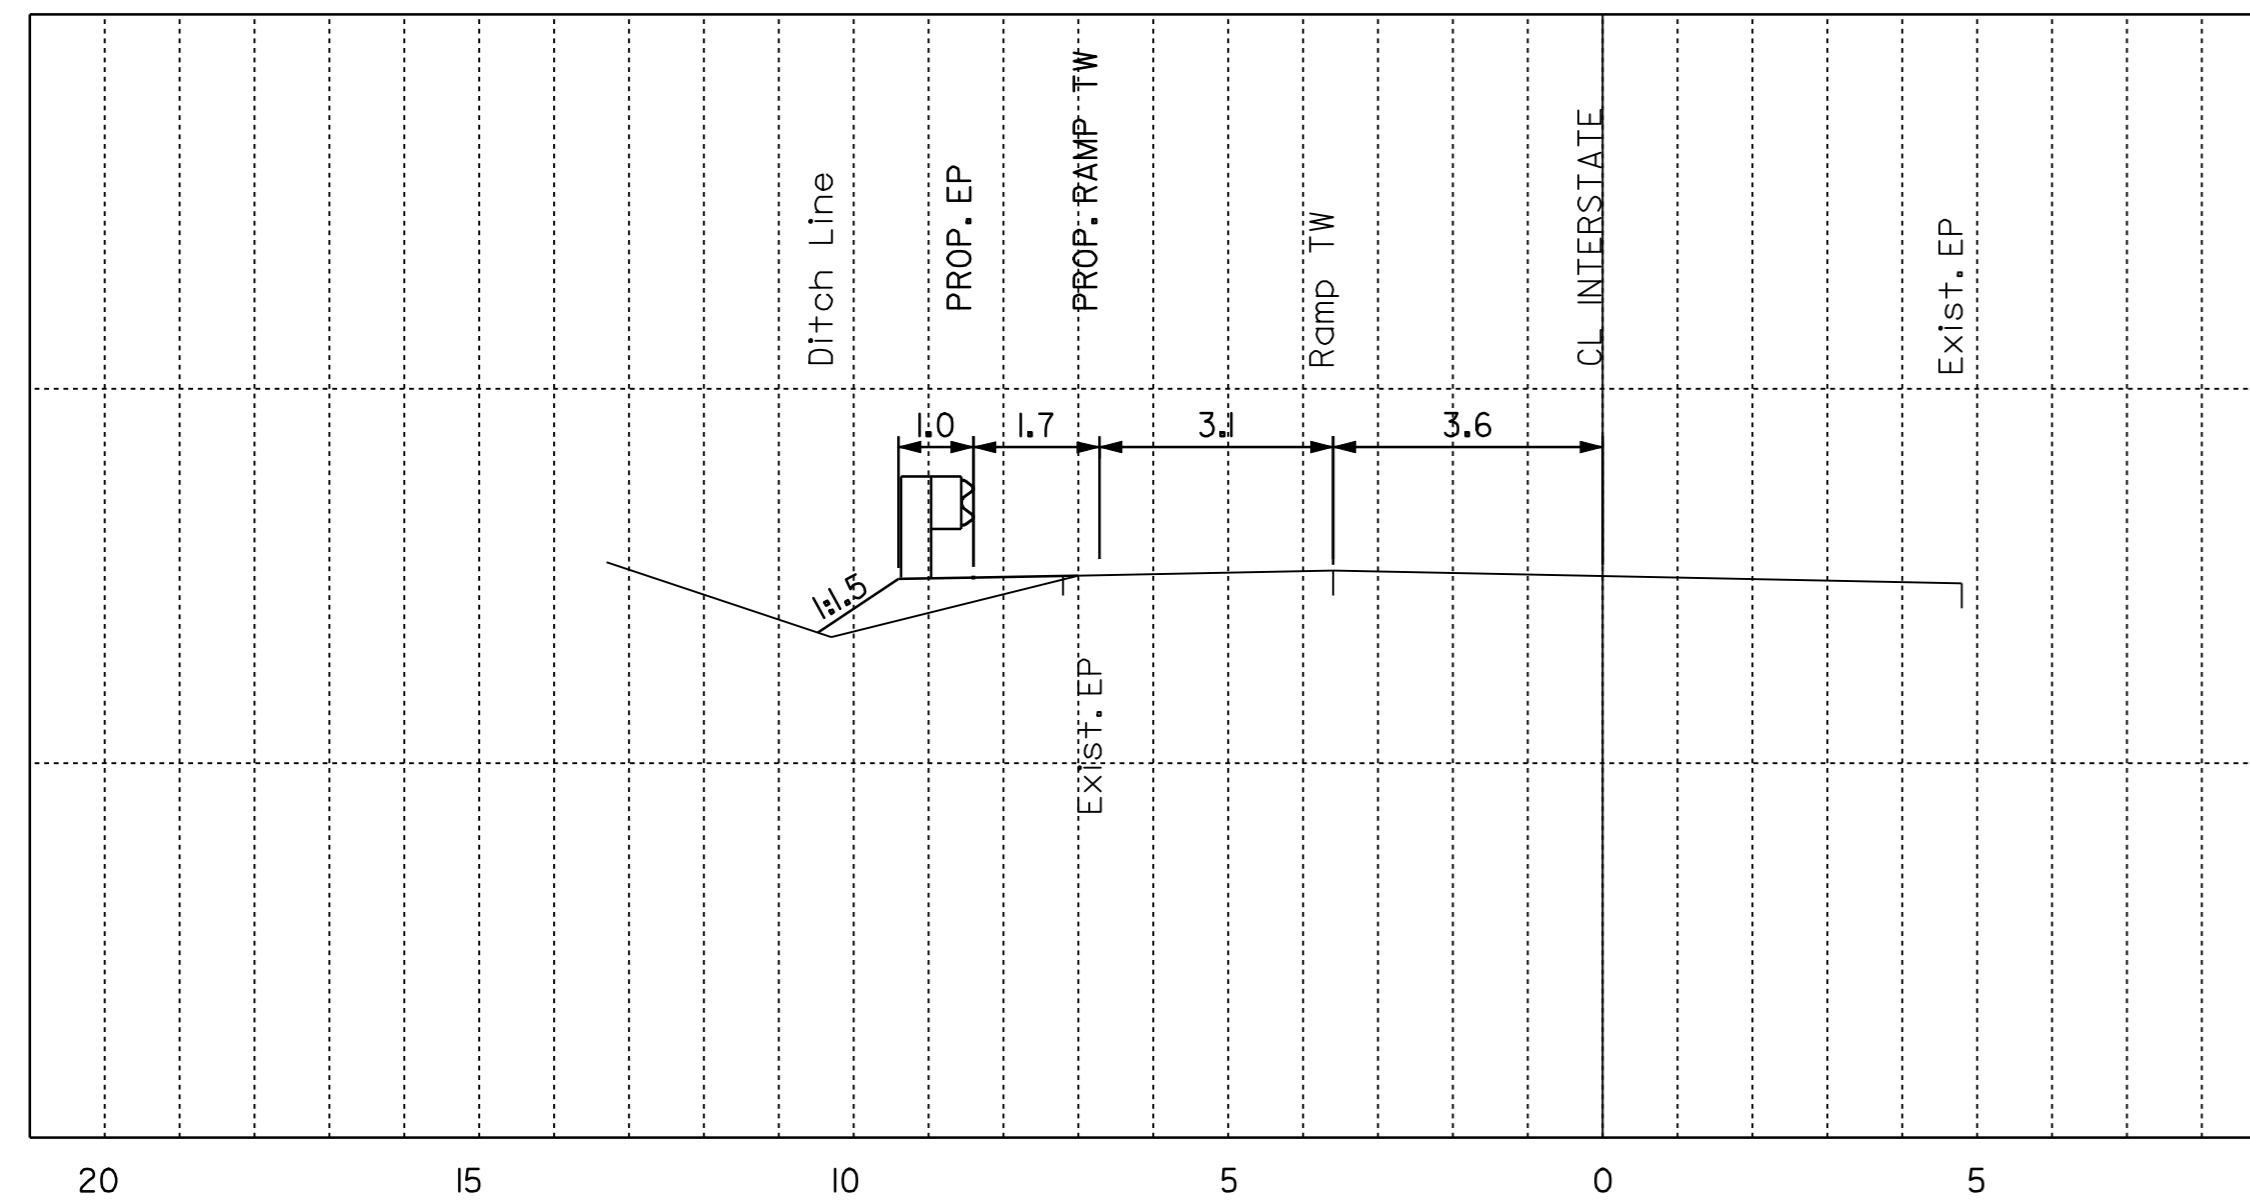

29+215

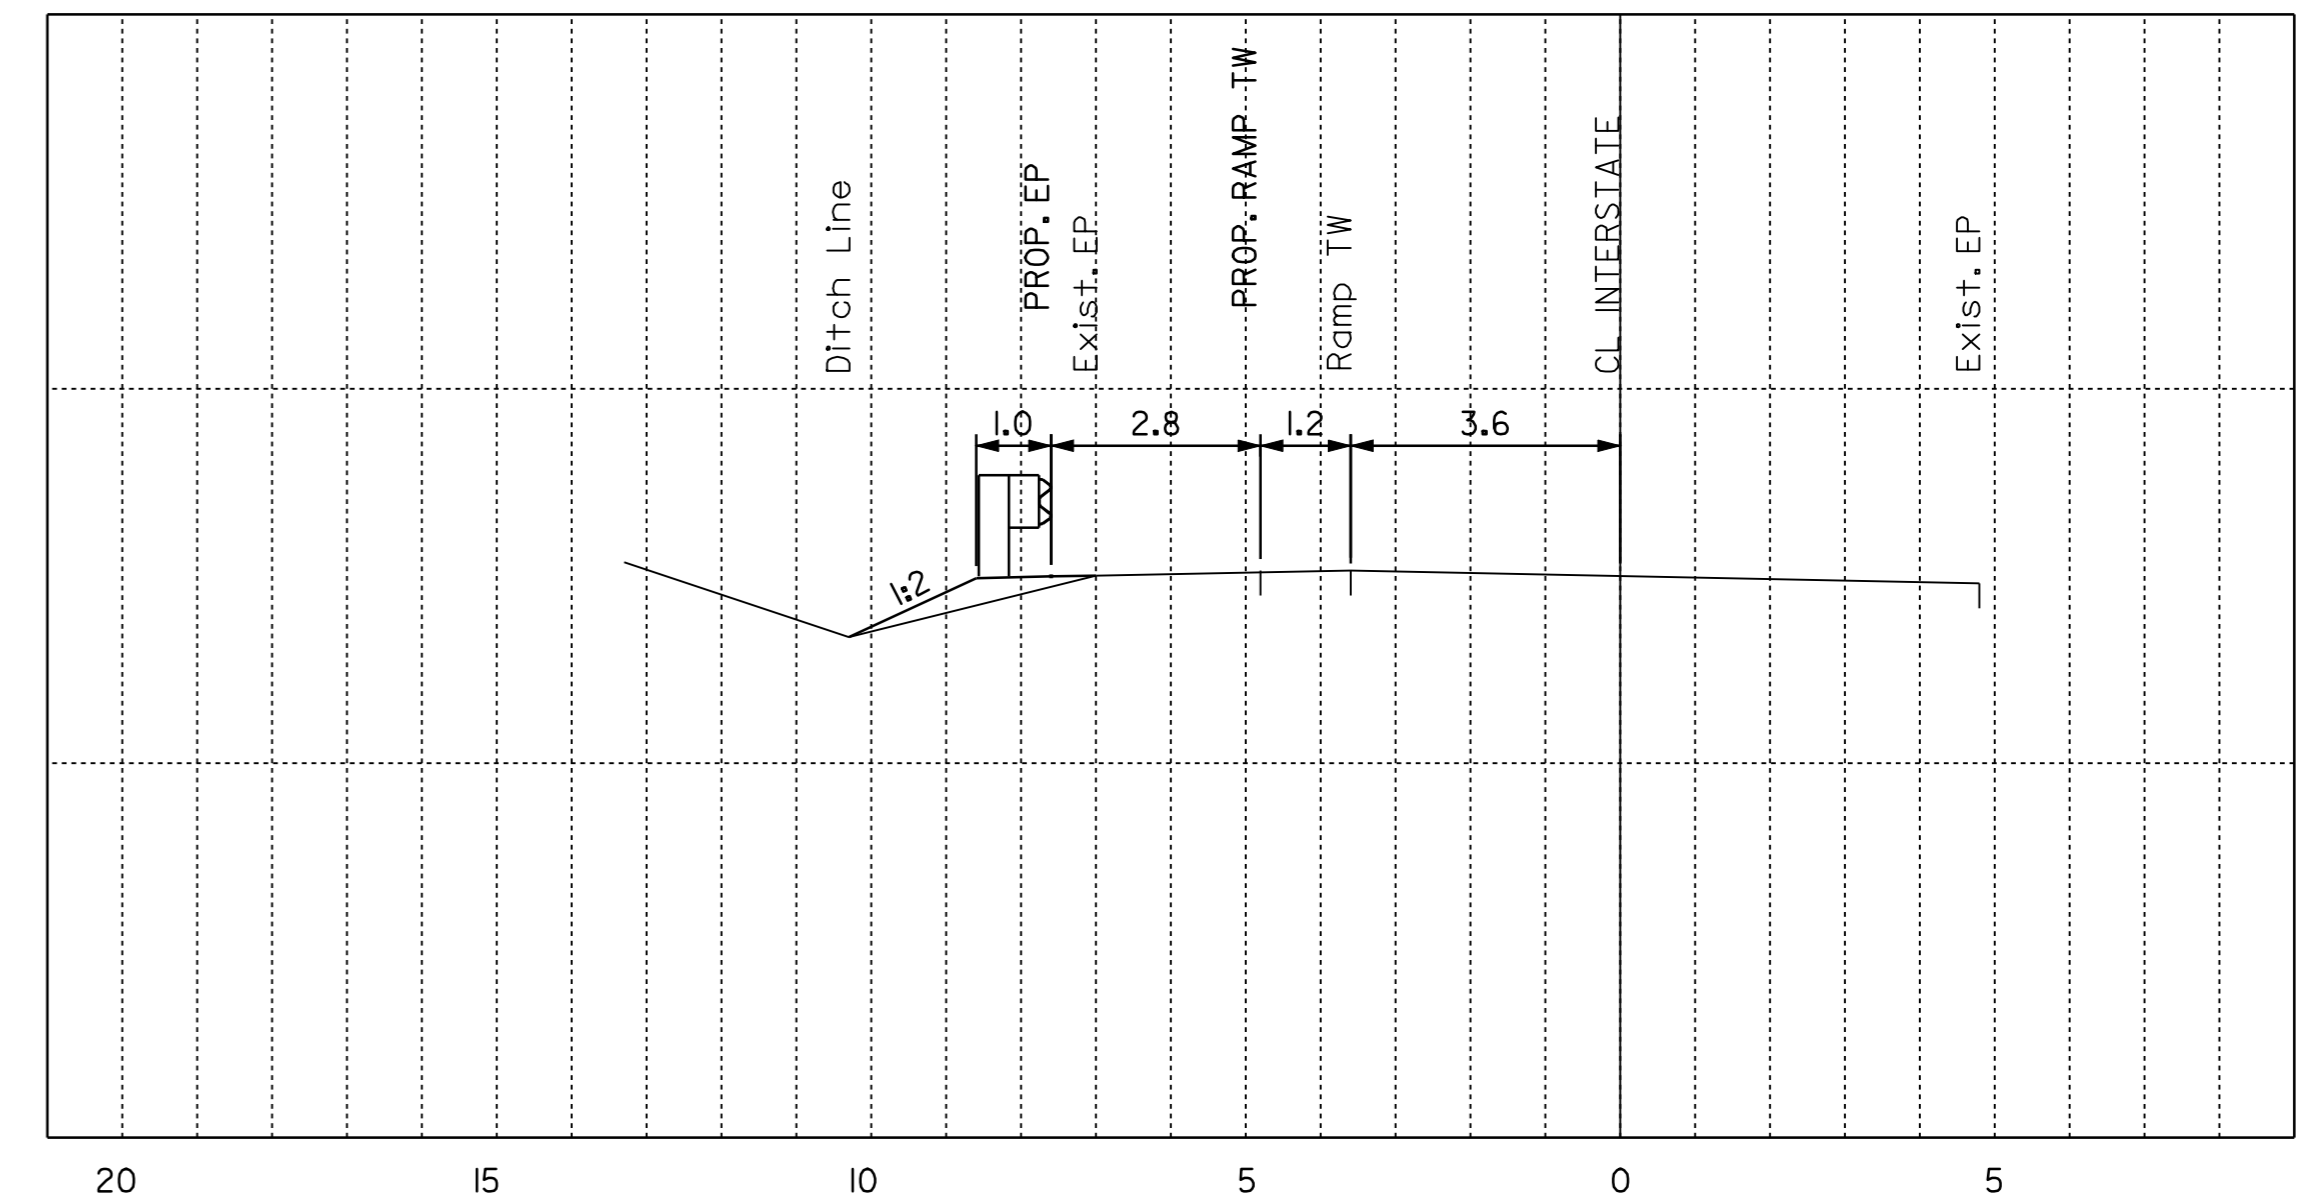

29+255

NOTE: ALL DIMENSIONS IN METERS EXCEPT AS INDICATED

DATUM
 VERTICAL _____
 HORIZONTAL _____

NOT TO SCALE

EXIT 4 SB OFF CROSS SECTIONS SHEET 3	PROJECT: BRATTLEBORO-ROCKINGHAM	PROJECT NO. : IM 091-I(39)
	DESIGN FILE NAME: <u>_/pave/99a202/pa202.dgn</u>	PLOT DATE: <u>02-JUN-2005</u>
	IPARM FILE NAME: <u>_pa202xs03.I</u>	SURVEY DATE: <u>10/00</u>
	SURVEYED BY: <u>CLD_ENGINEERS_INC</u>	DRAWN BY: <u>NLL</u>
SQUAD LEADER: <u>WRH</u>	SHEET: <u>28</u> OF <u>37</u>	