


TYPICAL PHASE I TRAFFIC CONTROL ON EXISTING BRIDGE (SOUTHBOUND)

SCALE: 1/2" = 1'-0"

NOTE:

* TRANSVERSE SECTIONS FOR BR 43, 48, 50 AND 51 ARE SHOWN.
TRANSVERSE SECTION FOR BR 49 IS SIMILAR EXCEPT AS NOTED.

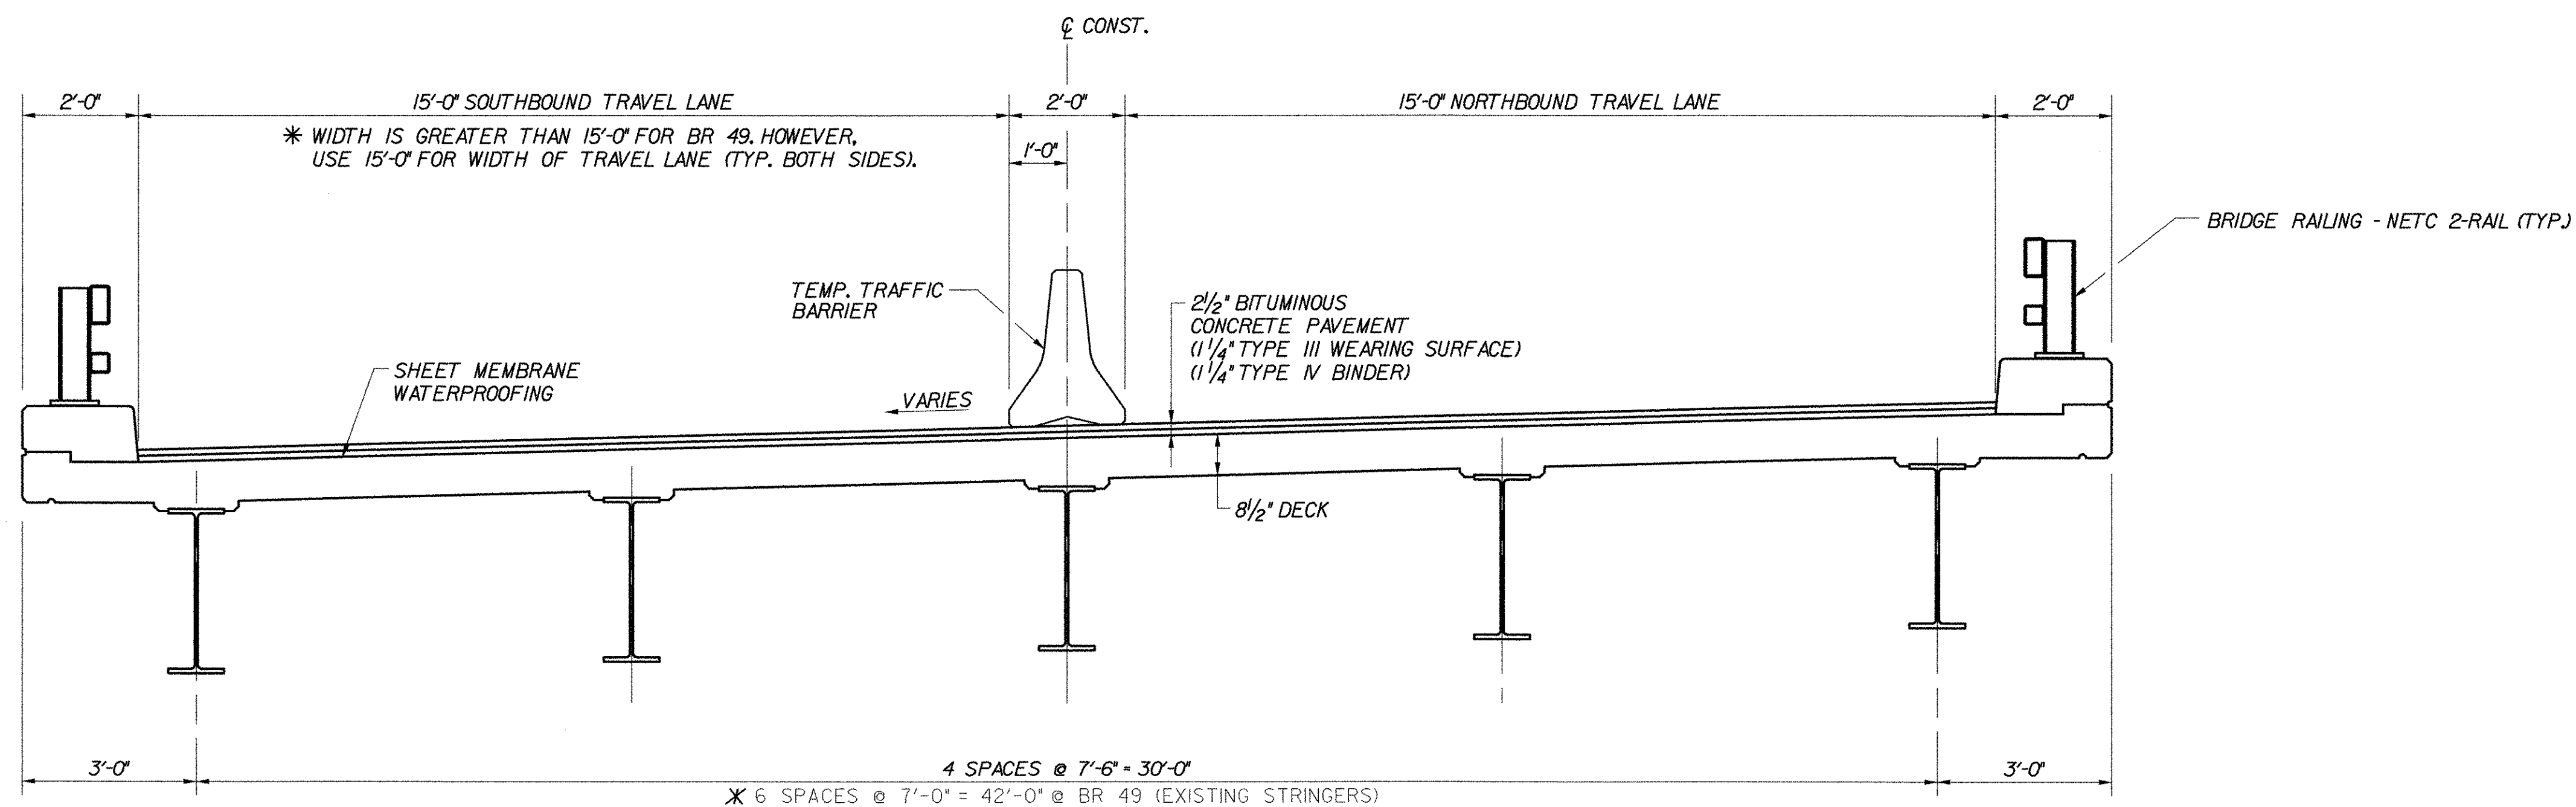

TYPICAL PHASE II TRAFFIC CONTROL ON NEW BRIDGE (NORTHBOUND)

SCALE: 1/2" = 1'-0"

**STATE OF VERMONT
AGENCY OF TRANSPORTATION**

Town Of	BOLTON	Bridge No.	
Highway No.	I-89	Log Sta.	
		Surv. Sta.	

TRANSVERSE SECTIONS

FOR TRAFFIC CONTROL

Designed By	P.W. SZUSTAK	Drawn By	R.A. BOTZENHART
Checked By	J.P. HALSTEAD	Date	10/99
		Bridge Design Supervisor	J.P. HALSTEAD Date 10/99

PROJECT	BOLTON	PROJECT NO.	IM-089-2(29)
---------	--------	-------------	--------------

TVGA CAD Drawing No.	tstraf	Date	10/99
Bridge Sheet No.	C-14	Sheet	14 of 307