



**ABUTMENT 2 PLAN (EXP.)**

SCALE: 1/4"=1'-0"

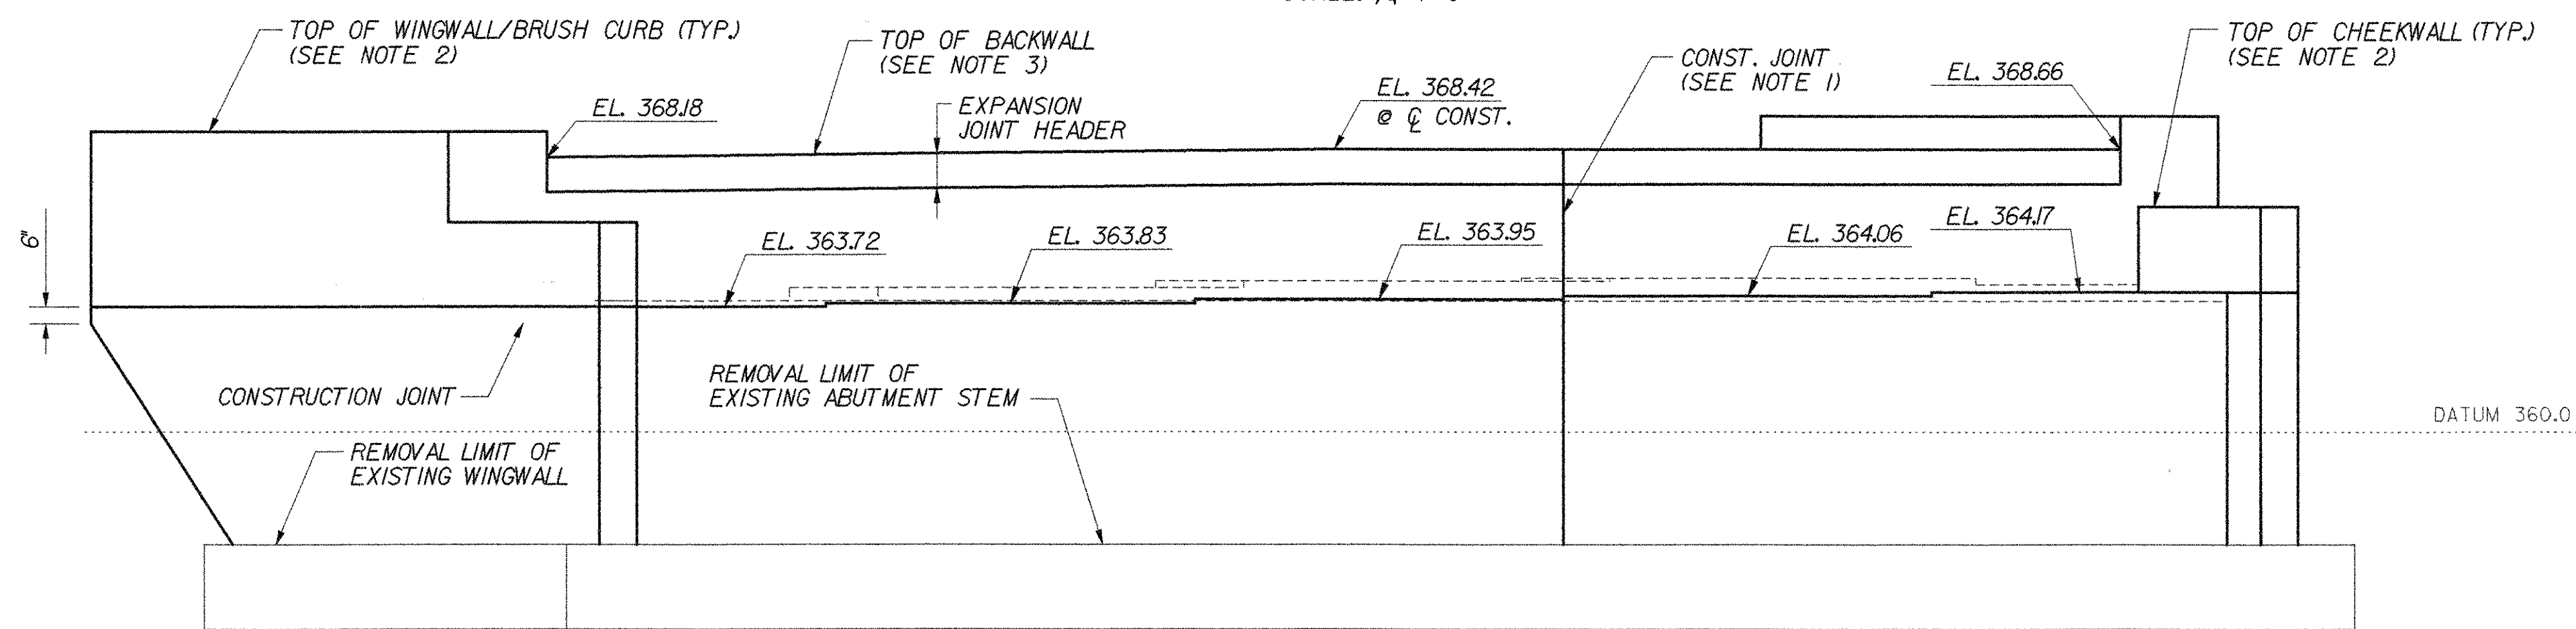

**ABUTMENT 2 ELEVATION**


SCALE: 1/4"=1'-0"

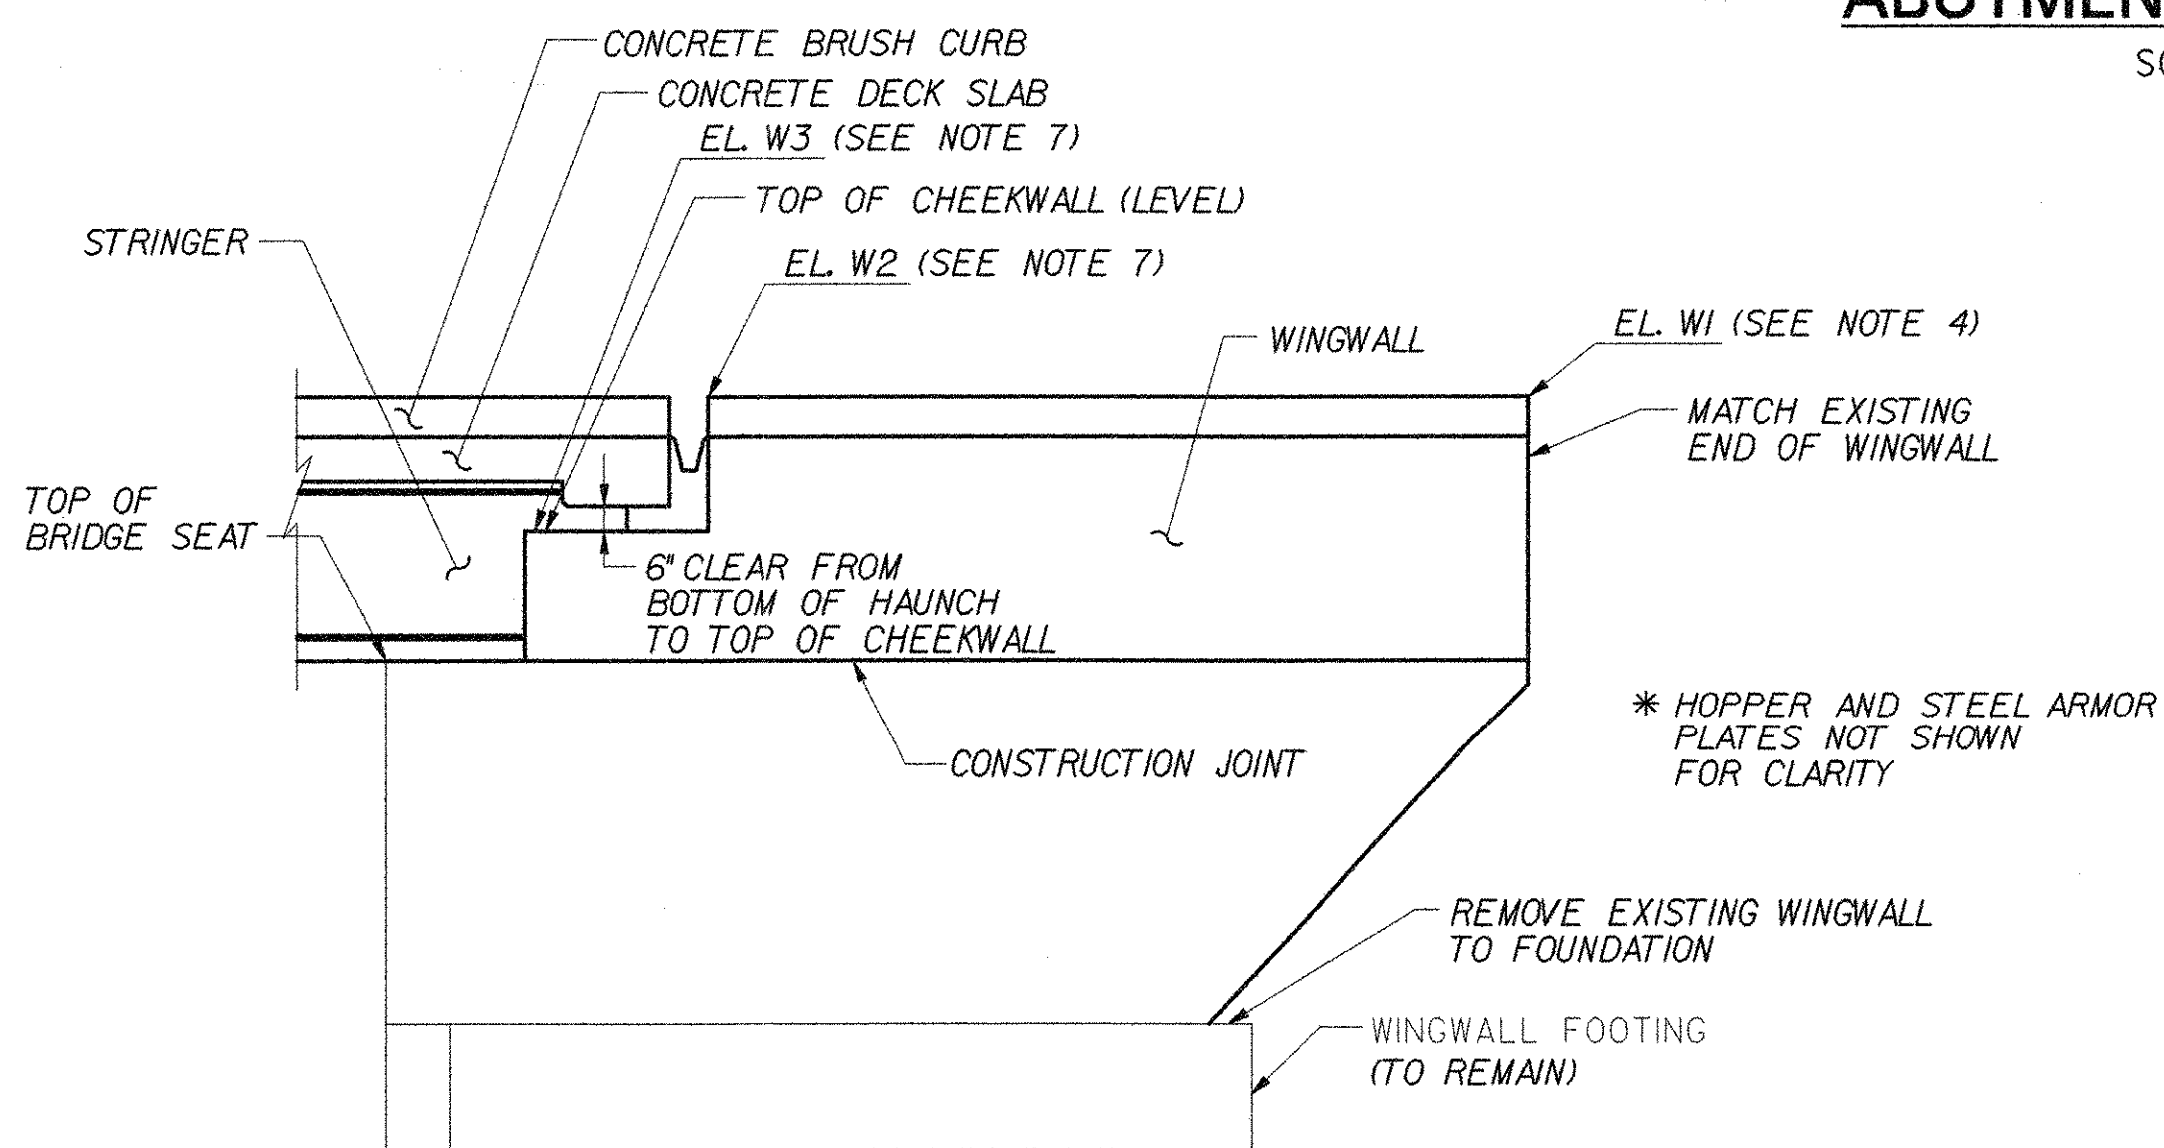

**ELEVATION B-B (EXP. ABUTMENTS)**

(ACUTE CORNER SIMILAR)


SCALE: 1/4"=1'-0"

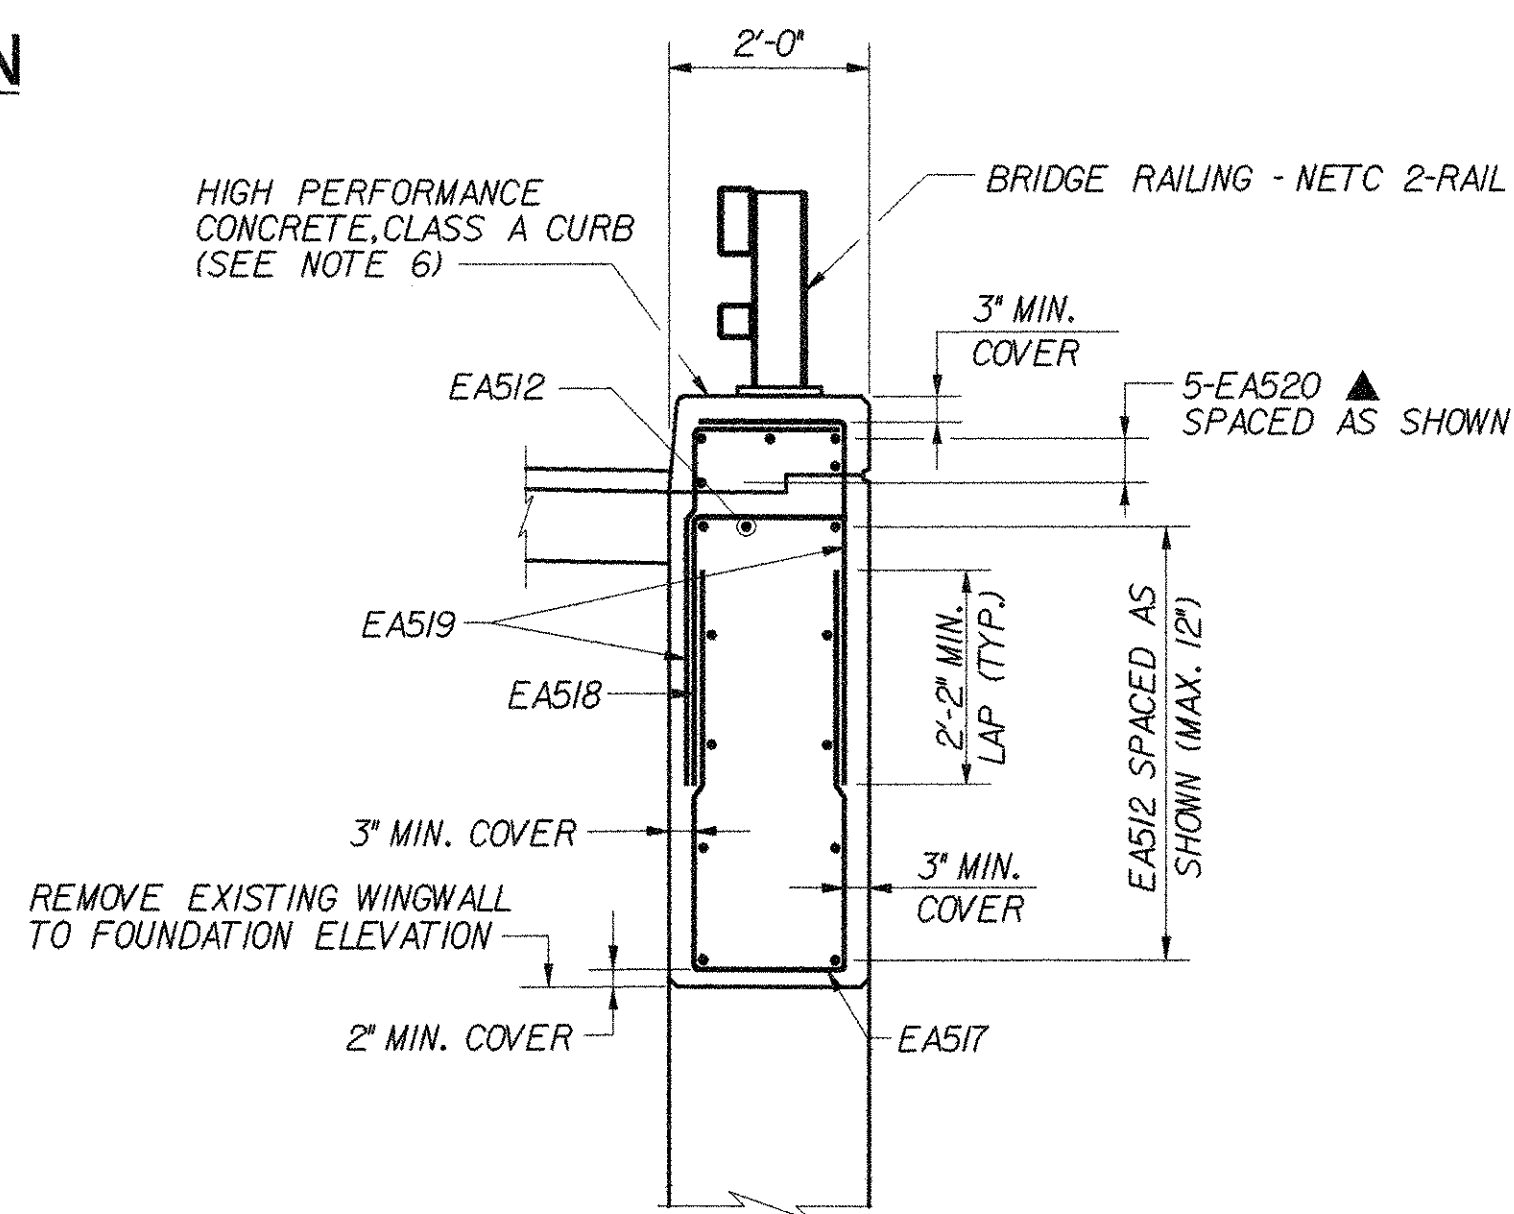

**SECTION C-C**

(ALL WINGWALLS SIMILAR)

SCALE: 1/2"=1'-0"

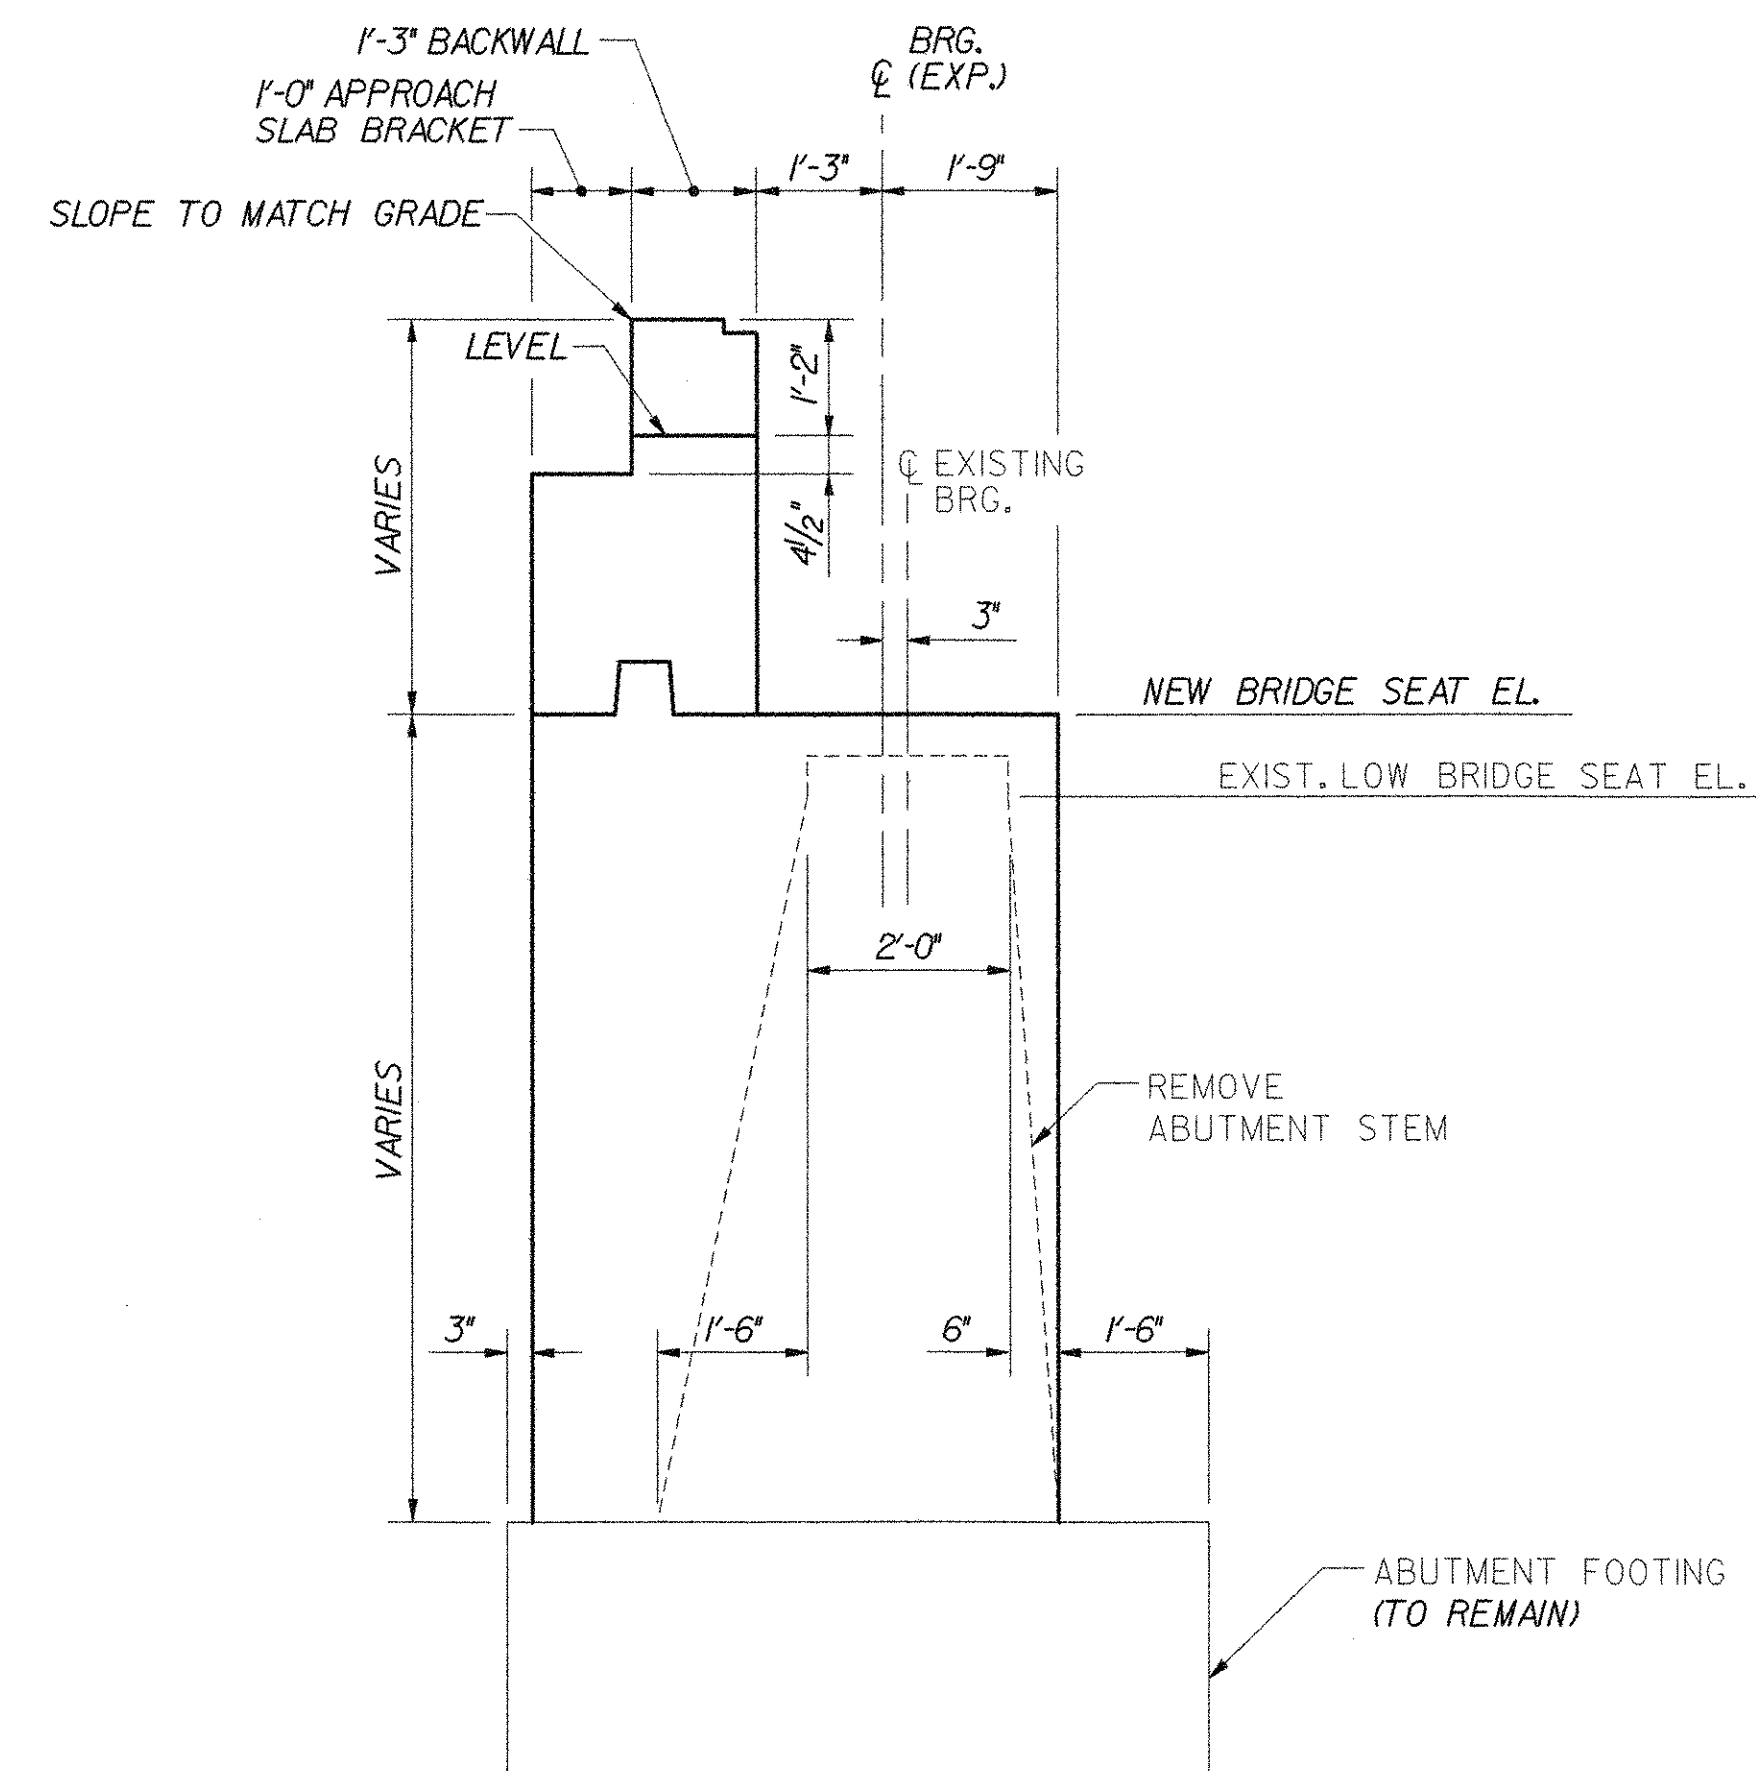

**SECTION A-A**

SCALE: 1/2"=1'-0"

**NOTES:**

1. CONSTRUCTION JOINT LOCATED AT STEP IN BRIDGE SEAT. LOCATION SHALL BE REVISED AS DIRECTED BY THE RESIDENT ENGINEER AS REQUIRED TO MATCH ANY CONSTRUCTION JOINTS IN THE EXISTING ABUTMENT FOOTING.
2. WORKING POINT (W.P.) 1 AND 2 LOCATIONS ARE SHOWN ON ABUTMENT MASONRY PLANS FOR EACH BRIDGE. FROM THE WORKING POINTS, THE CONTRACTOR MAY CONSTRUCT WINGWALLS CONCENTRIC TO THE CENTERLINE OF CONSTRUCTION, OR ON AN APPROXIMATE TANGENT LINE, AS APPROVED BY THE ENGINEER.
3. BACKWALL ELEVATIONS SHOWN AT FRONT FACE OF BACKWALL.
4. FOR ABUTMENT REINFORCEMENT DETAILS, SEE TYPICAL EXPANSION ABUTMENT REINFORCEMENT, BRIDGE SHEET BR51-2IBR.
5. STEPS IN BRIDGE SEATS SHALL BE EQUIDISTANT BETWEEN STRINGERS.
6. FOR DIMENSIONS OF CONCRETE CURB, SEE FASCIA DETAIL ON THE TRANSVERSE SECTION.
7. FOR TABLE OF WINGWALL AND BRUSH CURB ELEVATIONS, SEE TYPICAL WINGWALL DETAILS (2 OF 2), BRIDGE SHEET C-44.

**STATE OF VERMONT  
AGENCY OF TRANSPORTATION**

Town Of	<b>BOLTON</b>	Bridge No.	<b>515</b>
Highway No.	<b>I-89</b>	Log Sta.	
		Surv. Sta.	
<b>I-89 SB OVER U.S. ROUTE 2 AND JOINER BROOK</b>			
<b>ABUTMENT MASONRY (515)</b>			
Designed By	J.T. DEPLANCHE	Drawn By	D.S. URBINO
Checked By	Date	Bridge Design Supervisor	
	B.J. CARLSON	12/05	K.M. WOJTKOWSKI Date 12/05
PROJECT	BOLTON		PROJECT NO. IM-089-2(29)
TVGA ENGINEERING, SURVEYING, P.C.		TVGA CAD Drawing No.	5labmas Date 11/2005
Bridge Sheet No.		<b>BR51-21AR</b>	Sheet 119A of 307