



**TYPICAL RADIAL PIER CAP PLAN**  
SCALE: 3/8"=1'-0"

BRIDGE	PIER	CL BRG.	SIDE	PIER SEAT ELEVATIONS					BOTTOM OF PIER
				S1	S2	S3	S4	S5	C1
51N	1	3+68.56	SPAN 1	360.63	360.79	360.95	361.11	361.28	356.32
		3+60.56	SPAN 2	360.24	360.39	360.55	360.71	360.87	
51S	1	3+68.68	SPAN 1	360.38	360.53	360.69	360.85	361.01	356.46
		3+60.68	SPAN 2	359.99	360.15	360.30	360.46	360.62	
	2	4+48.57	-	361.12	361.28	361.44	361.59	361.75	357.87

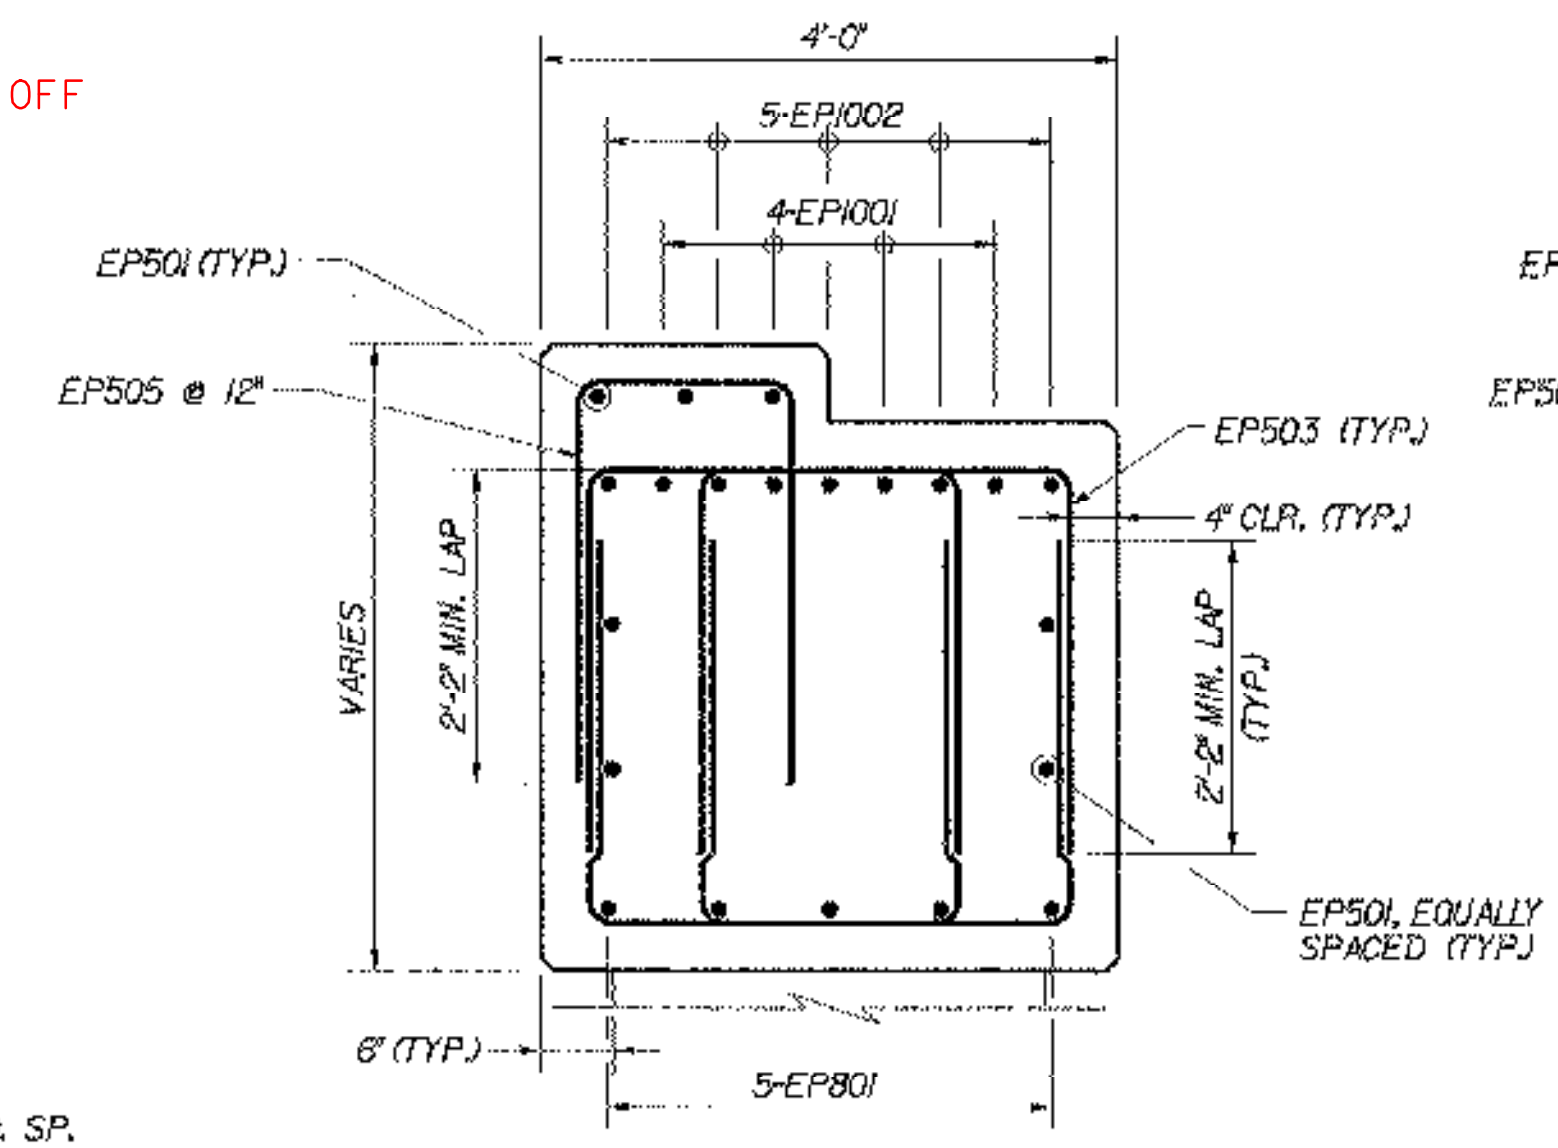


**SECTION A-A**  
SCALE: 3/4"=1'-0"

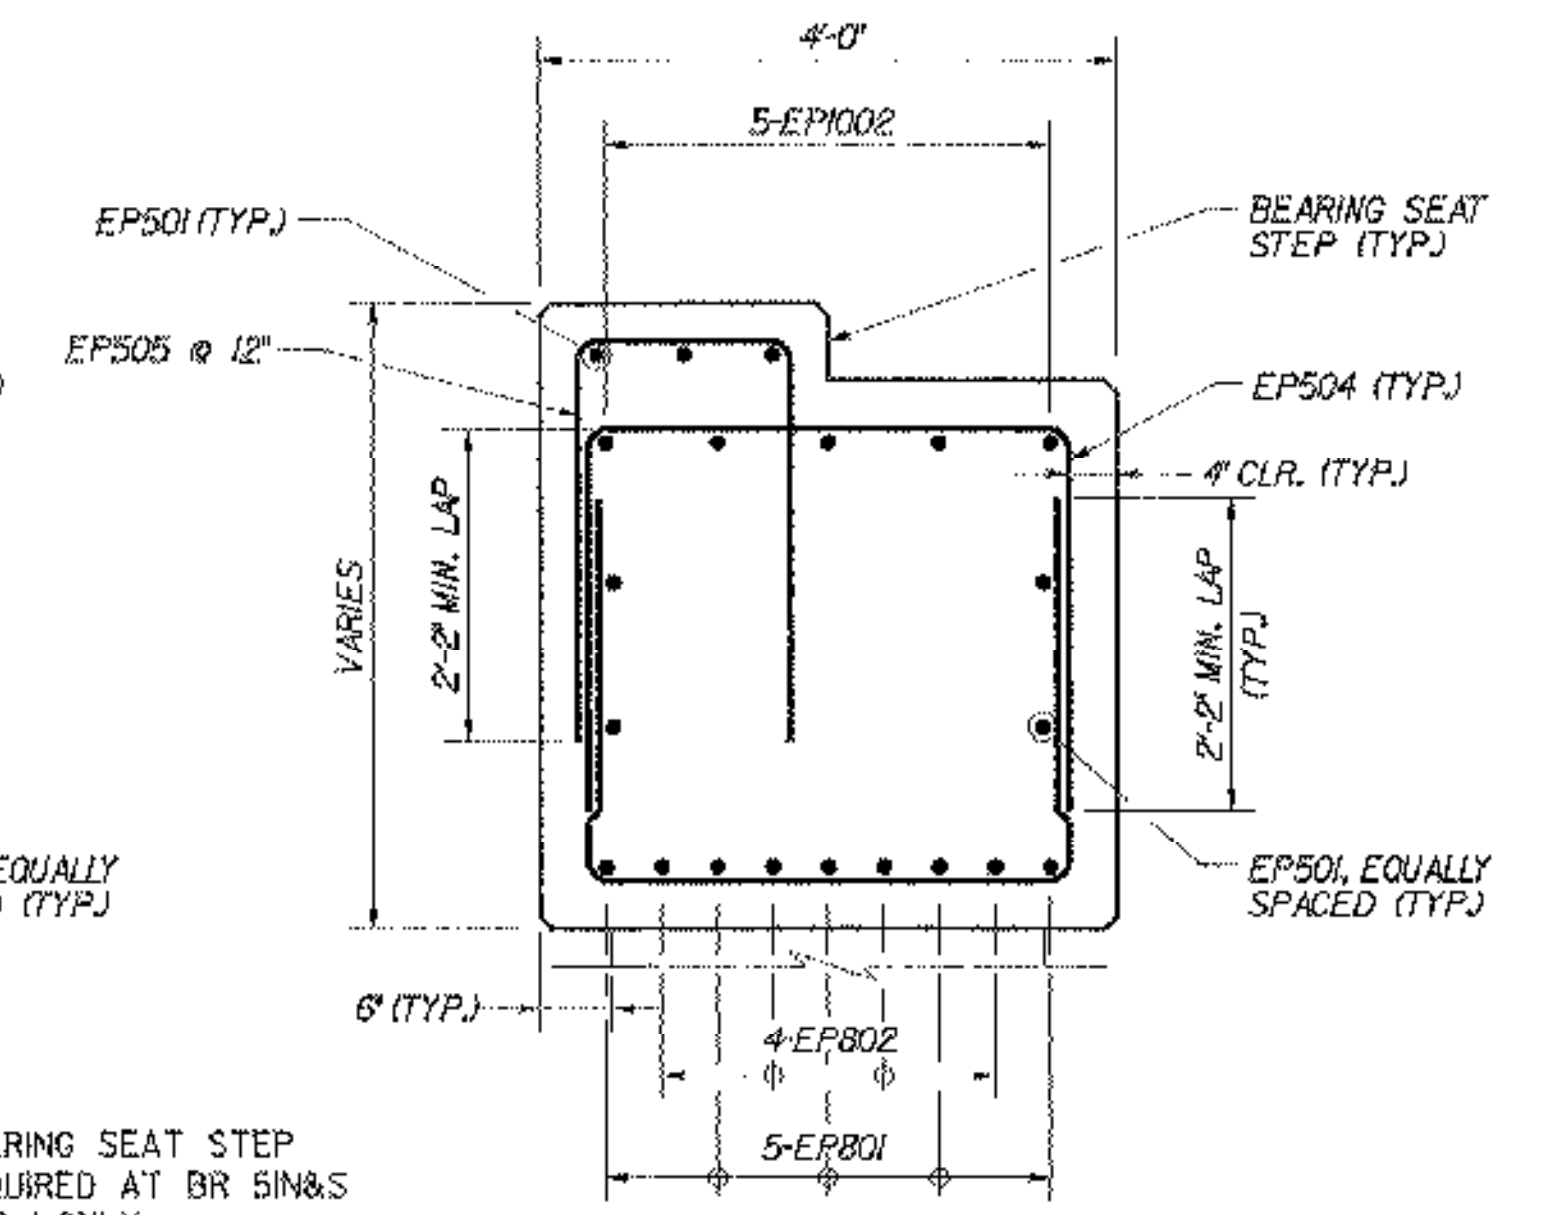

**SECTION B-B**  
SCALE: 3/4"=1'-0"

NOTE: BEARING SEAT STEP REQUIRED AT BR SIN&S PIER 1 ONLY.

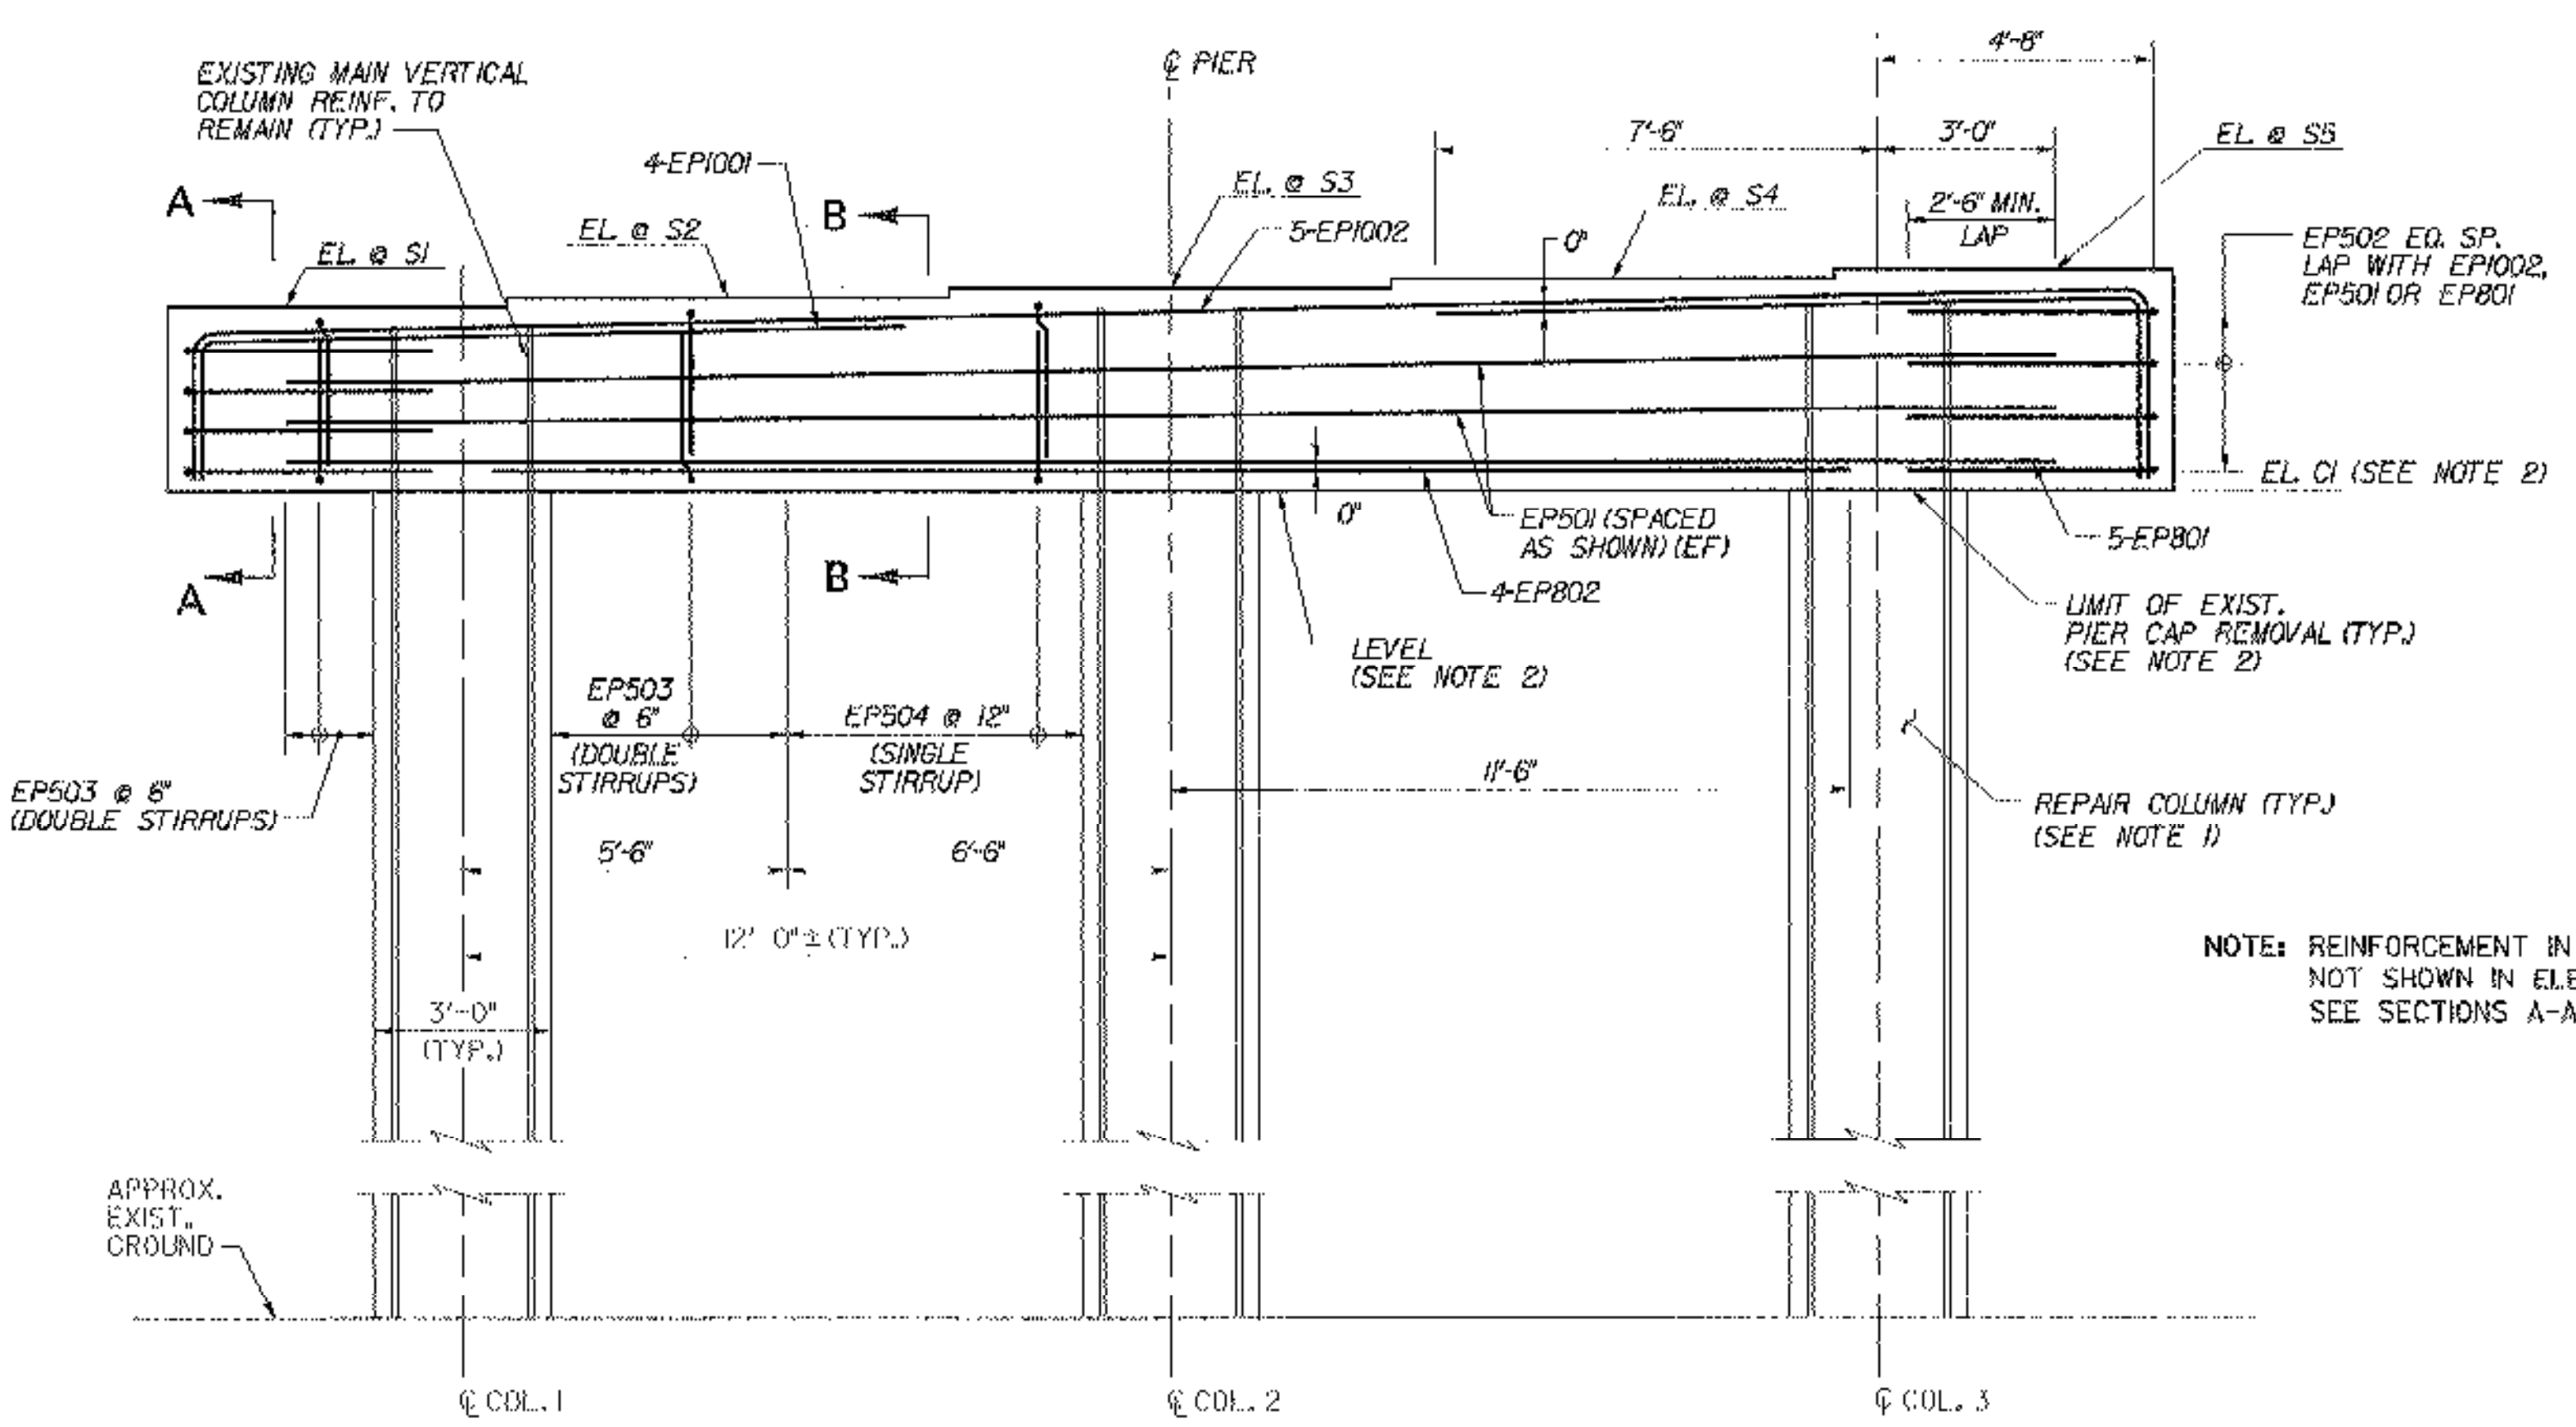

**TYPICAL RADIAL PIER ELEVATION**  
SCALE: 3/8"=1'-0"

NOTE: REINFORCEMENT IN BEARING SEAT STEP NOT SHOWN IN ELEVATION FOR CLARITY. SEE SECTIONS A-A AND B-B FOR DETAILS.

**NOTES:**

- REPAIR EXISTING SPALLED AND DELAMINATED AREAS AND APPLY FIBER-REINFORCED POLYMER WRAP, IN ACCORDANCE WITH THE DETAILS SHOWN ON SUBSTRUCTURE REPAIR DETAILS AND NOTES, BRIDGE SHEET C-45. FOR APPROXIMATE CONDITION OF EXISTING PIERS, SEE EXISTING SUBSTRUCTURE CONDITION, BRIDGE SHEETS SC-17 THROUGH SC-23.
- BOTTOM OF PIER CAP ELEVATIONS SHOWN ARE APPROXIMATE, BASED ON MATCHING THE EXISTING TOP OF COLUMN ELEVATIONS. HOWEVER, SOME MINOR REMOVAL OF EXISTING COLUMN CONCRETE MAY BE REQUIRED TO ACHIEVE LEVEL PIER CAP. LIMIT OF REMOVAL TO BE SAWCUT AS ORDERED BY THE ENGINEER. COSTS TO BE INCIDENTAL TO ITEM S29.20, "PARTIAL REMOVAL OF STRUCTURE (AT SIXX)".

**KEY**

- NF NEAR FACE
- FF FAR FACE
- EF EACH FACE
- ▲ REINFORCEMENT TO BE CUT TO FIT IN THE FIELD

**STATE OF VERMONT  
AGENCY OF TRANSPORTATION**

Town Of	BOLTON	Bridge No.	51N&S
Highway No.	I-89	Log Sta.	
		Surv. Sta.	
I-89 OVER U.S. ROUTE 2 AND JOINER BROOK			
<b>PIER CAP MASONRY AND REINF. (RADIAL)</b>			
Designed By	P.W. SZUSTAK	Drawn By	R.A. BOTZENHART
Checked By	J.P. HALSTEAD	Date	10/99
		Bridge Design Supervisor	J.P. HALSTEAD
PROJECT	BOLTON	PROJECT NO.	IM-089-2(29)
		Date	10/99
TVGA CAD Drawing No.	Sipmas	Bridge Sheet No.	BR51-22
		Sheet	120 of 307