



ELEVATION
SCALE: 1/4"=1'-0"

CAST-IN-PLACE CONCRETE PILING, ITEM 505.25 (TYP.)
EXISTING 10 BP 42 STEEL H-PILE (TYP.)

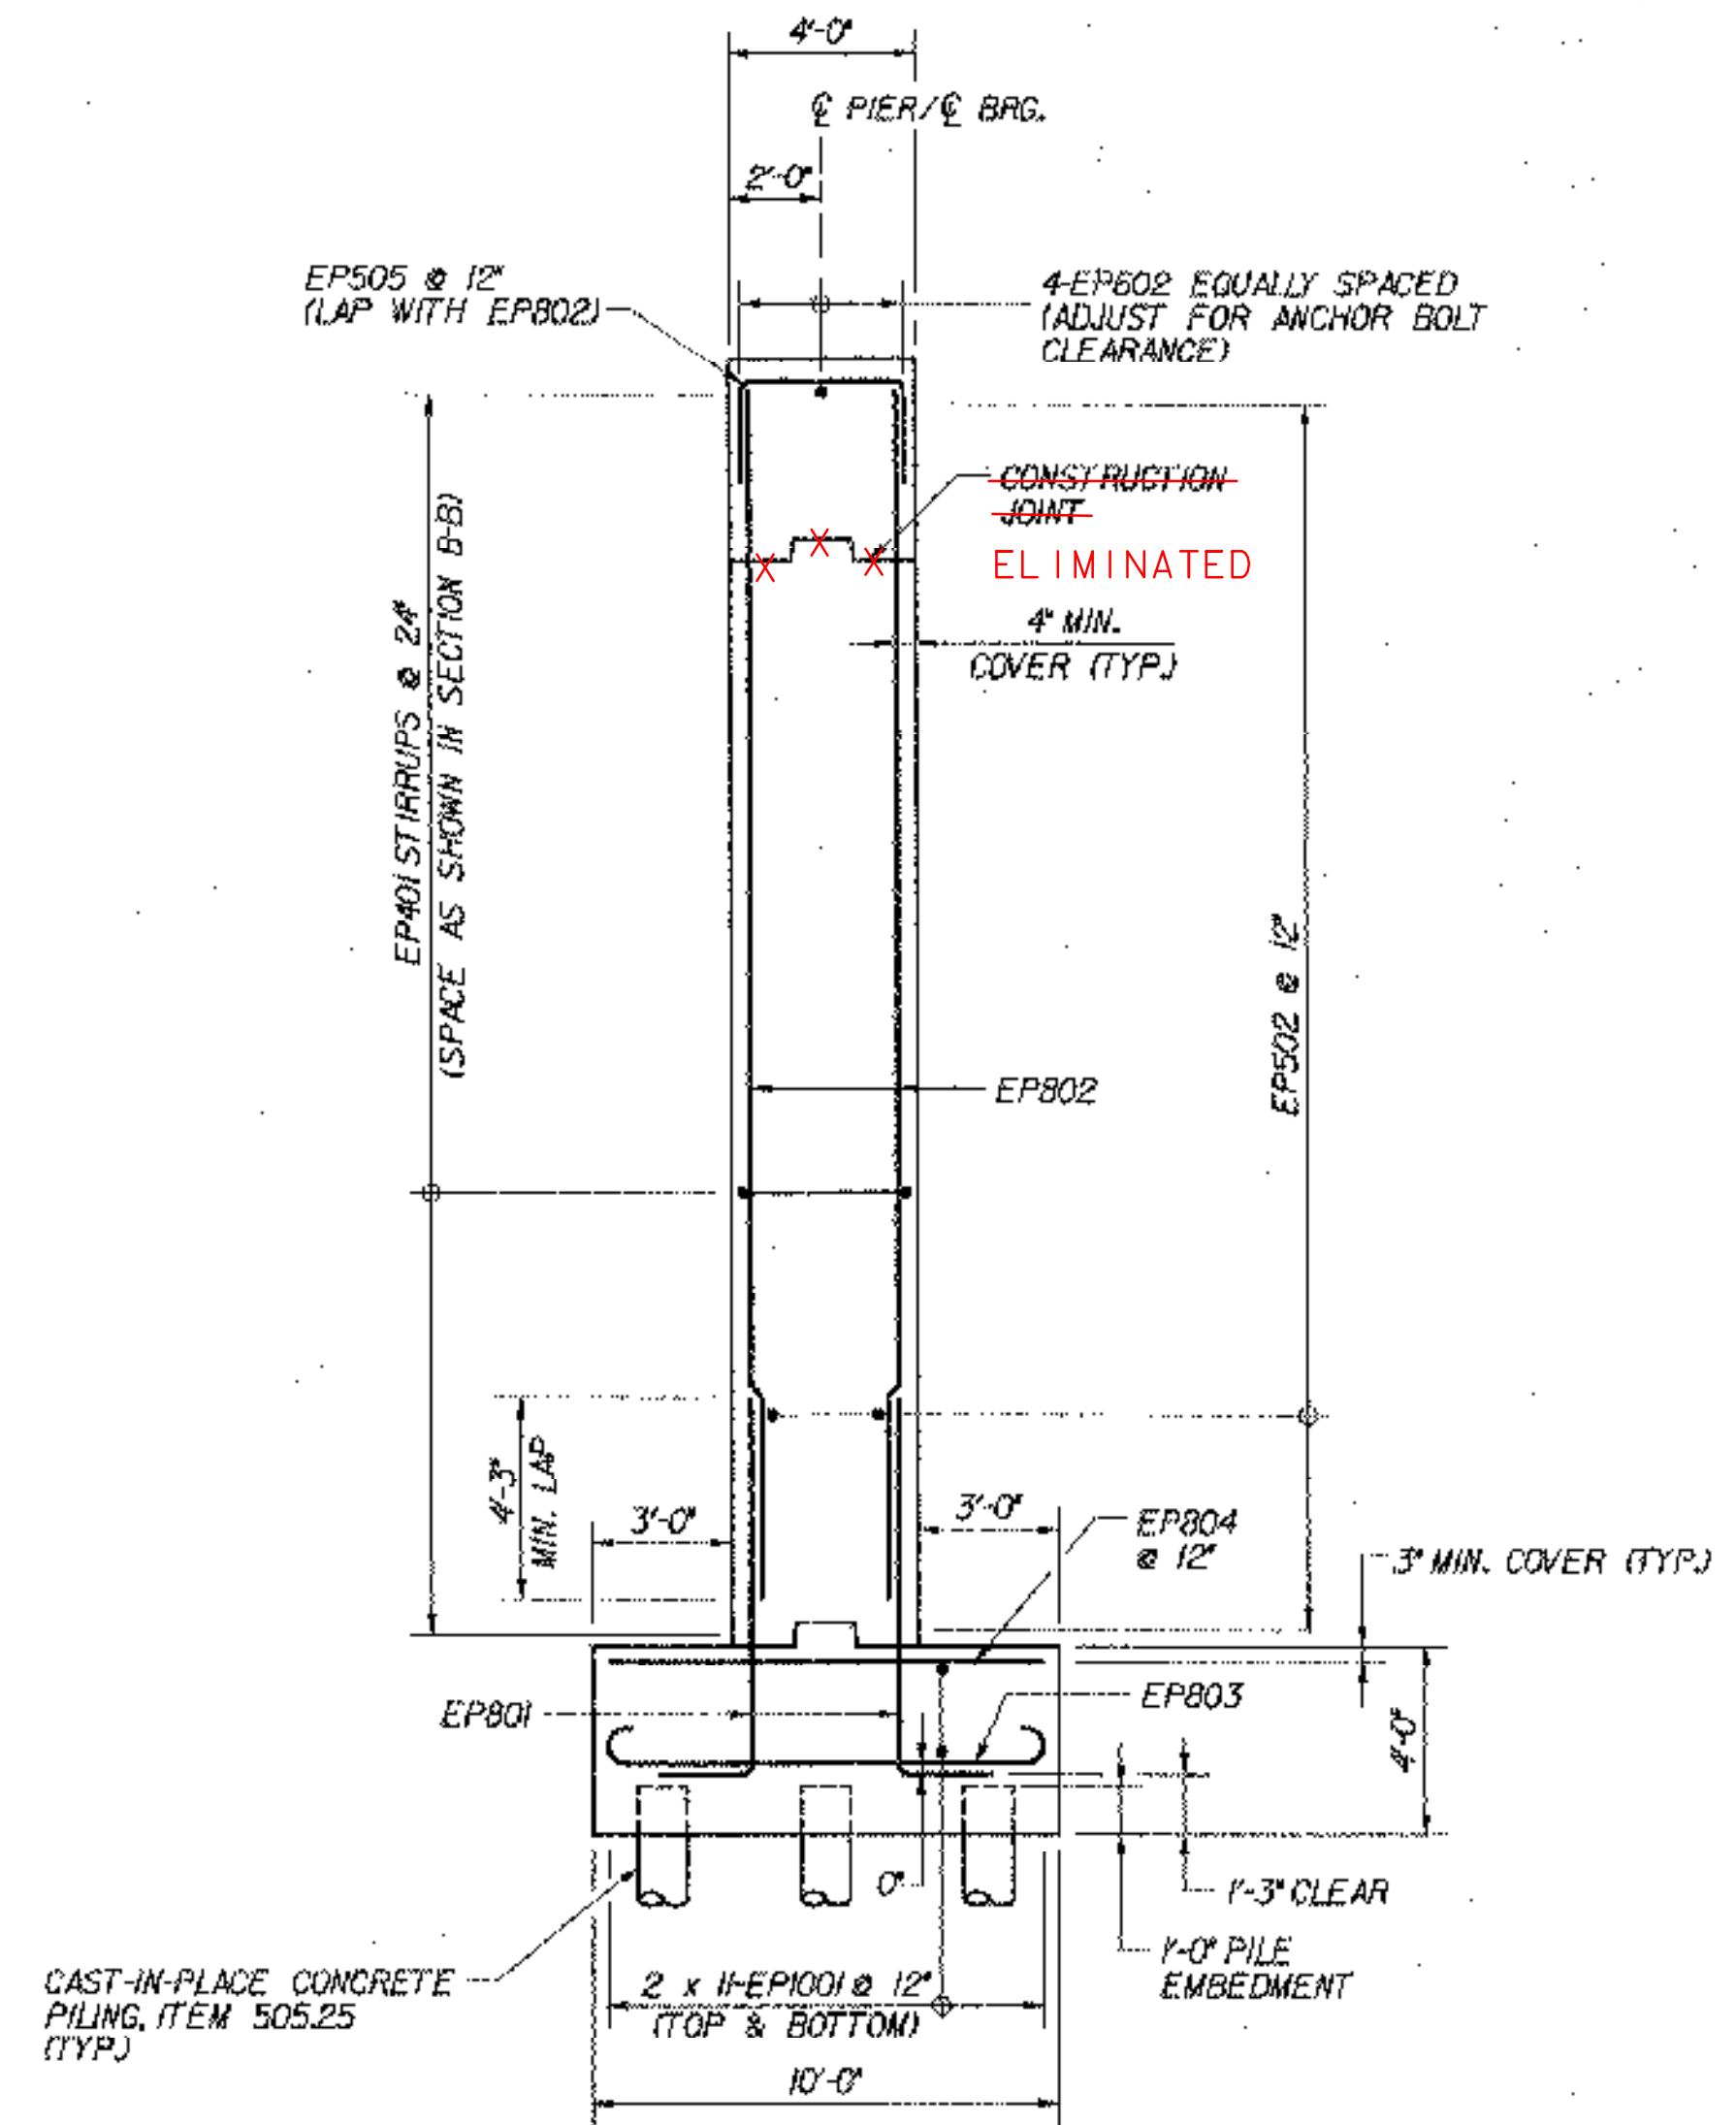

SECTION A-A
SCALE: 1/4"=1'-0"

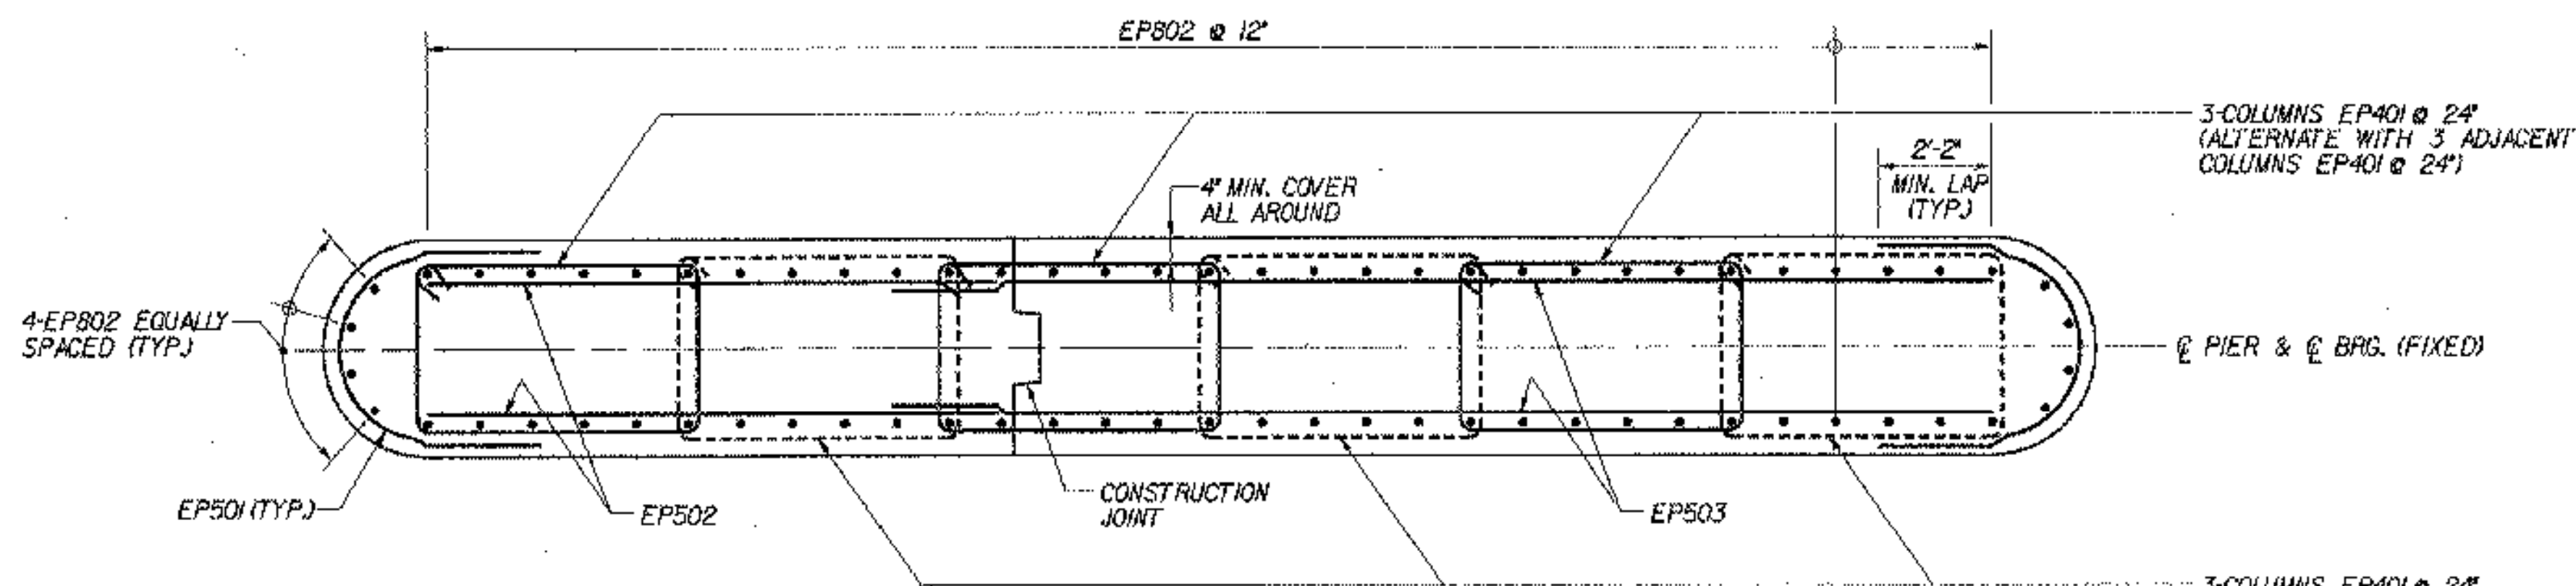

SECTION B-B
SCALE: 3/8"=1'-0"

KEY

- NF NEAR FACE
- FF FAR FACE
- EF EACH FACE
- ▲ REINFORCEMENT TO BE CUT TO FIT IN THE FIELD

**STATE OF VERMONT
AGENCY OF TRANSPORTATION**

Town Of	BOLTON	Bridge No.	515
Highway No.	I-89	Log. Sta.	
		Surv. Sta.	
I-89 OVER US ROUTE 2 AND JOINER BROOK			
PIER NO. 3 REINFORCEMENT (515)			
Designed By	M.J. MOZER	Drawn By	R.A. BOTZENHART
Checked By	Date	Bridge Design Supervisor	Date
P.W. SZUSTAK	10/99	J.P. HALSTEAD	Date 10/99
PROJECT	BOLTON	PROJECT NO.	IM-089-2(29)
TVGA CAD Drawing No.	515p3rel	Date	10/99
Bridge Sheet No.	BR51-27	Sheet	125 of 307