


| | | | |
|---------------|-------------|-----------------|------------|
| HIGHWAY NO. | I 89 | NAME OF HIGHWAY | Interstate |
| STRUCTURE NO. | 20 | COUNTY | CHITTENDEN |
| PROJECT NO. | I-89-2(7) | TOWN | Bolton |
| LOCATION | Sta 1148+50 | | |

| EXISTING STRUCTURE | |
|---|------------------------------|
| 1. RATED LOADING OF EXISTING STRUCTURE | None |
| 2. TYPE OF EXISTING STRUCTURE | None |
| 3. UNDERCLEARANCE ELEVATION OF EXISTING STRUCTURE | None |
| 4. WHAT DISPOSITION SHOULD BE MADE OF EXISTING STRUCTURE | COST OF REMOVAL None |
| 5. SHOULD EXISTING STRUCTURE BE USED TO MAINTAIN TRAFFIC DURING CONSTRUCTION OF NEW STRUCTURE | No |
| 6. SHOULD NEW TEMPORARY STRUCTURE BE BUILT | |
| 7. ORDINARY HIGH WATER SURFACE ELEV. AT EXISTING STRUCTURE | WATERWAY TO ORDINARY H.W. |
| 8. EXTREME HIGH WATER AT EXISTING STRUCTURE | |
| 9. SPAN OF EXISTING BRIDGE UPSTREAM | 35' WATERWAY TO EXTREME H.W. |
| 10. SPAN OF EXISTING BRIDGE DOWNSTREAM | 35' WATERWAY TO EXTREME H.W. |
| 11. TYPE OF FOUNDATION UNDER EXISTING ABUTMENTS | |
| 12. DOES ALL WATER AT FLOOD ELEVATION PASS THROUGH EXISTING STRUCTURE | |
| 13. IF NOT AT WHAT ELEVATION IS RELIEF AFFORDED | |
| 14. ADDITIONAL WATERWAY AREA PROVIDED | |



| NEW STRUCTURE | |
|---|---|
| 1. RECOMMENDED TYPE OF STRUCTURE | 5 and 6 Span Composite Steel Stringer Bridge |
| 2. RECOMMENDED CLEAR SPAN OR SPANS | Left Lane 37'-87"-85.5' 66'-51" Right Lane 37'-87"-97'-96-51" |
| MEASURED PARALLEL TO NEW HIGHWAY | |
| 3. ARE THERE OBJECTIONS TO A PIER IN THE STREAM ANSWER YES OR NO | YES |
| 4. ORDINARY HIGH WATER ELEVATION AT NEW STRUCTURE | 336.0 Profile 1927 Flood from |
| 5. EXTREME HIGH WATER ELEVATION AT NEW STRUCTURE | 342.0 SOURCE OF INFORMATION U.S. Corps of Engineers |
| 6. IS ALL WATER INTENDED TO PASS THROUGH NEW STRUCTURE | Yes |
| 7. DOES STREAM REACH ITS MAXIMUM HIGH WATER ELEVATION RAPIDLY | Yes IS ORDINARY RISE RAPID |
| 8. LOW WATER ELEVATION AT NEW STRUCTURE | 333.5 |
| 9. DRAINAGE AREA IN ACRES ABOVE STRUCTURE | 6100 CHARACTER OF TERRAIN Mountainous |
| 10. IS STREAM EVER DRY | No |
| 11. VELOCITY OF STREAM AT HIGH WATER STAGE | 13 Ft. Per Second ESTIMATED DISCHARGE 1900 C.F.S |
| 12. AREA FULL OPENING | AREA BELOW ORDINARY H.W. 88 S.F. |
| 13. CHARACTER OF SCOUR | DRIFT ICE |
| 14. ESTIMATED DRAINAGE AREA ABOVE NATURAL OR ARTIFICIAL STORAGE | None |
| 15. VERTICAL CLEARANCE ABOVE FLOOD ELEVATION | |
| 16. ARE SIDEWALKS REQUIRED, IF SO ON WHAT SIDE | NO BOTH SIDES |
| 17. RECOMMENDED TYPE OF PAVEMENT | 2" Bituminous Concrete Pavement |
| 18. TRAFFIC TO BE MAINTAINED UNDER ITEM NO. | NONE ONE OR TWO WAYS PROBABLE COST |
| 19. PROBABLE COST OF CLEARING AND GRUBBING STREAM CHANNEL AT STRUCTURE SITE | |
| 20. SHOULD PROVISIONS BE MADE FOR PUBLIC UTILITIES | |
| 21. ESTIMATED ALLOWABLE LOAD ON FOUNDATIONS | SHOULD PILES BE USED YES EST. LGTH. |

| FOUNDATION INFORMATION | |
|--|--|
| OBTAINED FOR DESIGN PURPOSES ONLY, THE STATE ASSUMES NO RESPONSIBILITY WHATSOEVER FOR THE SUFFICIENCY OR ACCURACY OF THE INFORMATION SHOWN. BOULDERS MAY BE ENCOUNTERED AT ANY PIER OR ABUTMENT LOCATION. FOR BORING LOGS, SEE SHEETS 68 & 69 OF 137 | |

| GENERAL NOTES | |
|---|---|
| DESIGN SPECIFICATIONS: AASHTO 1957 Edition, and as modified by Vermont Dept. of Highways. | SUPERSTRUCTURES: Separate Structure for Each Lane 30' Roadway, 1'-6" Safety Walks, as per SCB-30-56 6 Spans (Simple) Left Lane, 5 Spans (Simple) Right Lane, rolled beam, composite design, as per SB-30-56 Aluminum bridge railing, or galvanized bridge railing, and granite bridge curb as per SB-56-57 (1 & 2). |
| LIVE LOAD H20-S16-44 and Military Loading | Bearing and diaphragm connections as per SB-20-56 Approach Slabs as per SB-AS-45 Skew 57 SB-AS-Square 57 |
| DESIGN STRESSES: Structural steel fs = 18,000 psi Reinforcing steel fs = 20,000 psi Concrete fc = 1,200 psi f'c = 3,000 psi. | SUBSTRUCTURE Open piers, round columns spaced 12'-0" o.c. ± continuous footing. Stub abutments. |
| CLEARANCES: Horizontal: as shown on drawings. Vertical: 14'-3" Clear-U.S. Route 2 (Relocated) | FOUNDATION: Stub Abutments, Steel Piles, 35 Ton Design Load. Piers, A, B, C, D, Untreated Timber Piles 20 Ton Capacity. Piers, E, F, G, H & J, Steel Piles 35 Ton Design Load. |

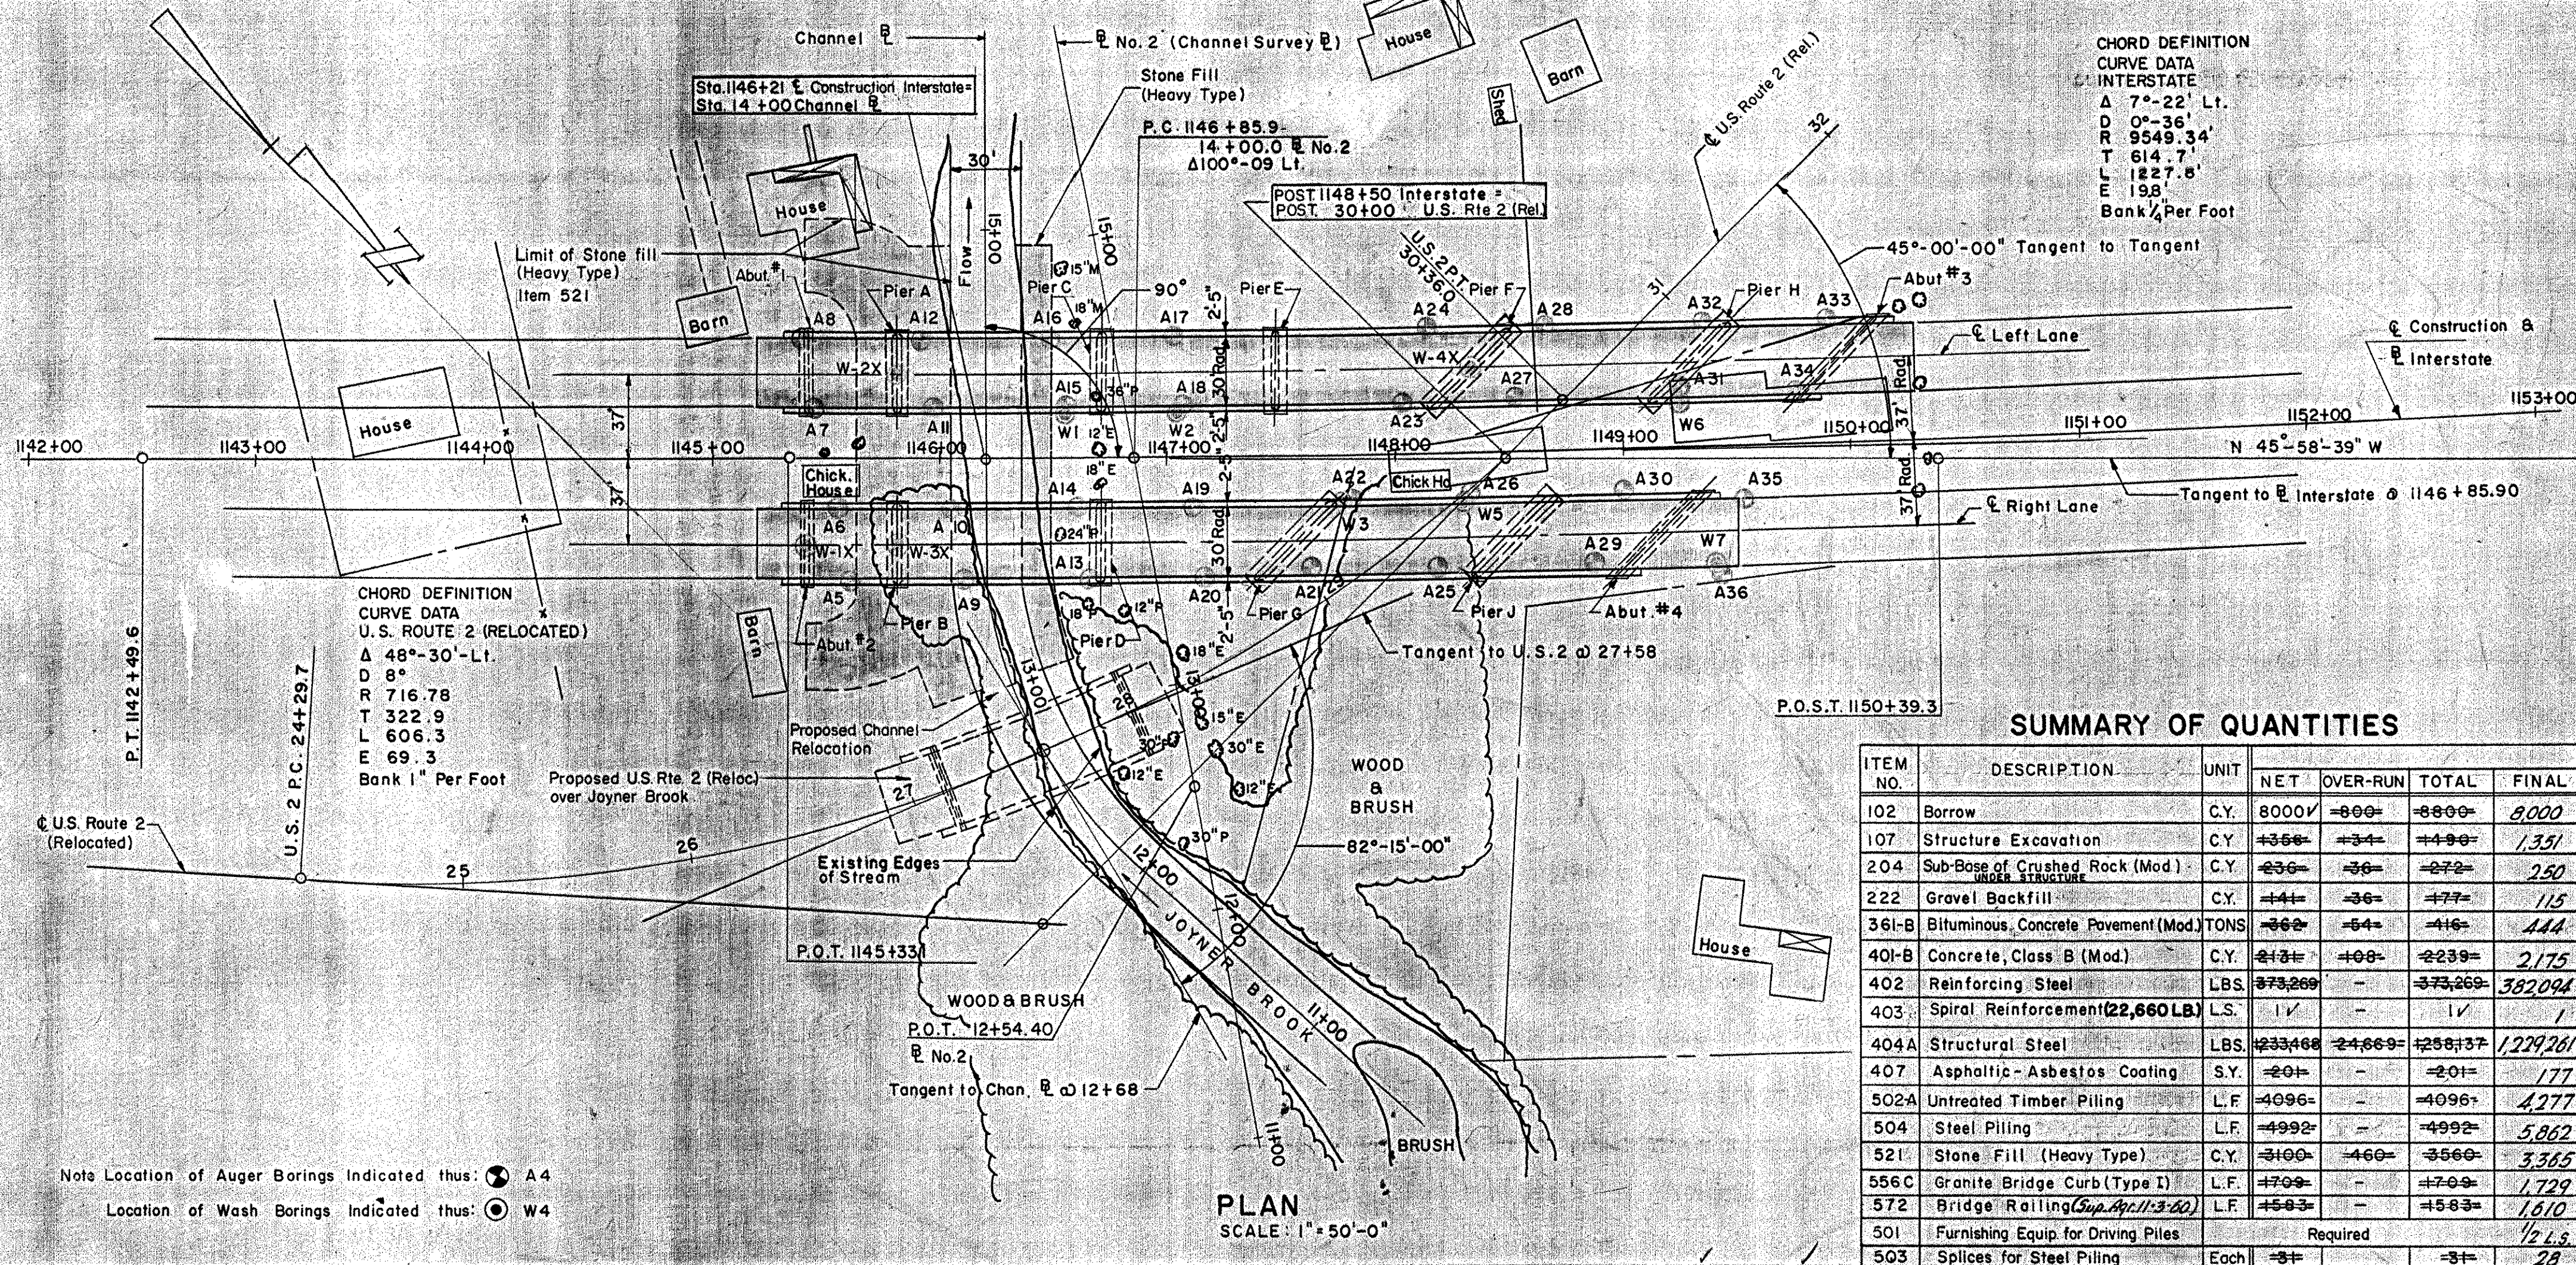

| SUMMARY OF QUANTITIES | | | | | | |
|-----------------------|---|----------|---------|----------|---------|-----------|
| ITEM NO. | DESCRIPTION | UNIT | NET | OVER-RUN | TOTAL | FINAL |
| 102 | Borrow | C.Y. | 8000V | +800 | +8800 | 8,000 |
| 107 | Structure Excavation | C.Y. | +366 | -34 | +332 | 1,351 |
| 204 | Sub-Base of Crushed Rock (Mod.) | C.Y. | +66 | -6 | +60 | 150 |
| 222 | Gravel Backfill | C.Y. | +44 | -36 | +8 | 115 |
| 361-B | Bituminous Concrete Pavement (Mod.) | TONS | +66 | -64 | +2 | 444 |
| 401-B | Concrete, Class B (Mod.) | C.Y. | +13 | +98 | +111 | 2,175 |
| 402 | Reinforcing Steel | LBS. | +73,269 | - | +73,269 | 382,094 |
| 403 | Spiral Reinforcement (22,660 LB.) | L.S. | 1V | - | 1V | 1 |
| 404A | Structural Steel | LBS. | +33,468 | +2,669 | +36,137 | 1,229,261 |
| 407 | Asphaltic-Asbestos Coating | S.Y. | +20 | - | +20 | 177 |
| 502A | Untreated Timber Piling | L.F. | +4996 | - | +4996 | 4,277 |
| 504 | Steel Piling | L.F. | +4992 | - | +4992 | 5,862 |
| 521 | Stone Fill (Heavy Type) | C.Y. | +100 | +46 | +146 | 3,365 |
| 556C | Granite Bridge Curb (Type I) | L.F. | +709 | - | +709 | 1,729 |
| 572 | Bridge Railing (Sup. Apr. 11-3-60) | L.F. | +583 | - | +583 | 1,610 |
| 501 | Furnishing Equip. for Driving Piles | Required | | | | 12 L.S. |
| 503 | Splices for Steel Piling | Each | +3 | - | +3 | 28 |
| 319 | For Emulsion for Bridge Floors (Sup. Apr. 6-7-61) | | | | | 660 gal. |
| 372 | Joint Sealer: Hot Poured Elastic Type (Sup. Apr. 6-22-61) | | | | | 474 L.S. |
| 106-A | Channel Excav. of Earth | C.V. | 0 | 0 | 0 | 1,790 |

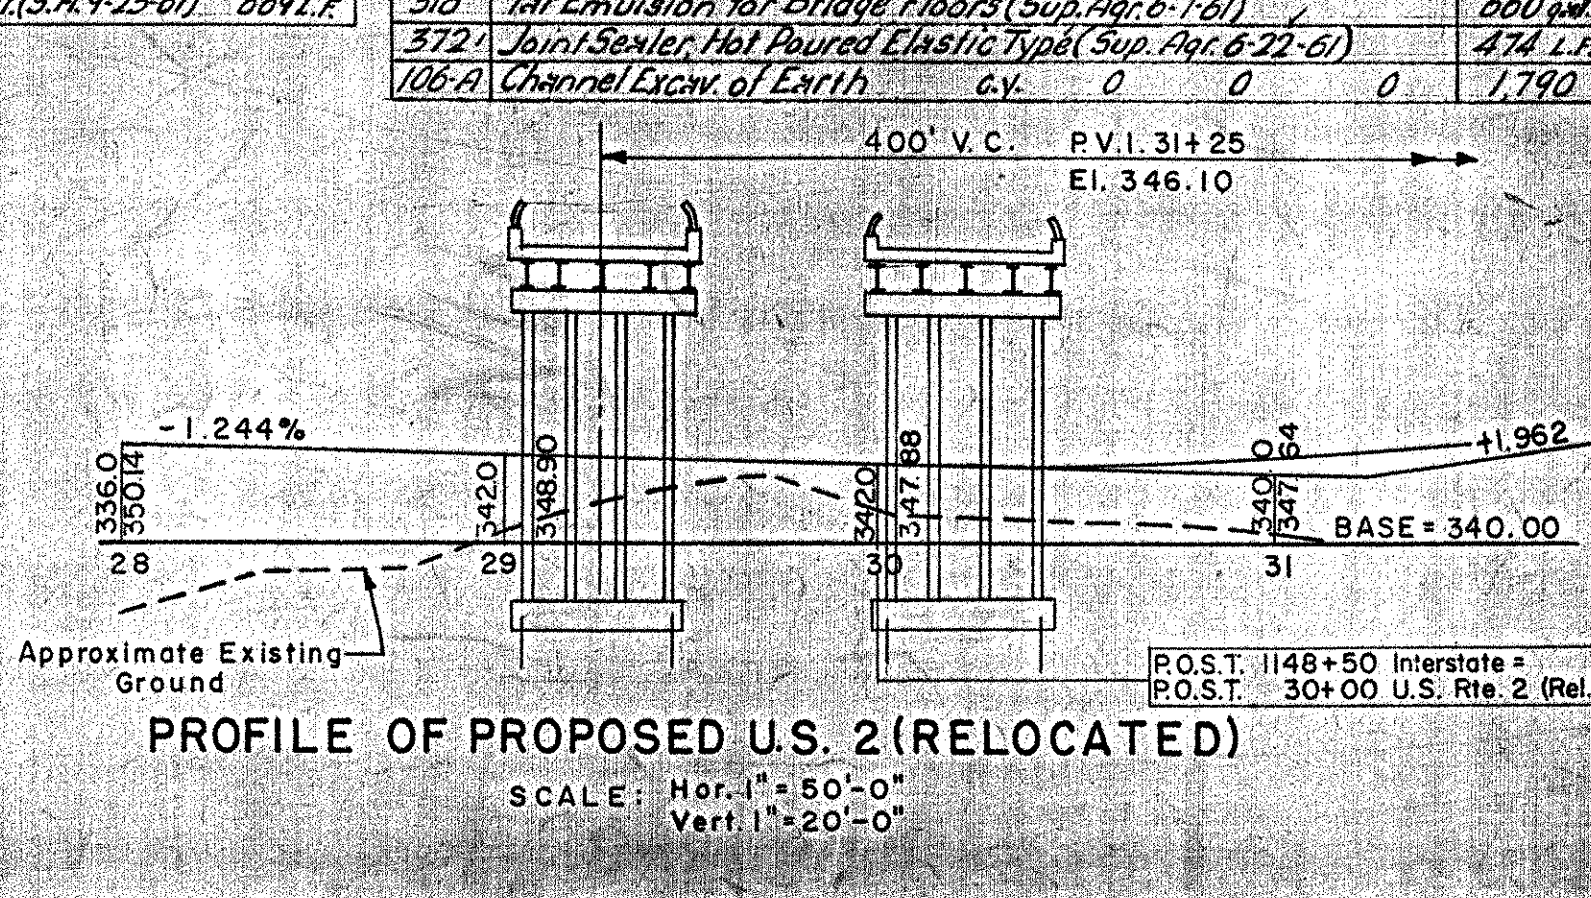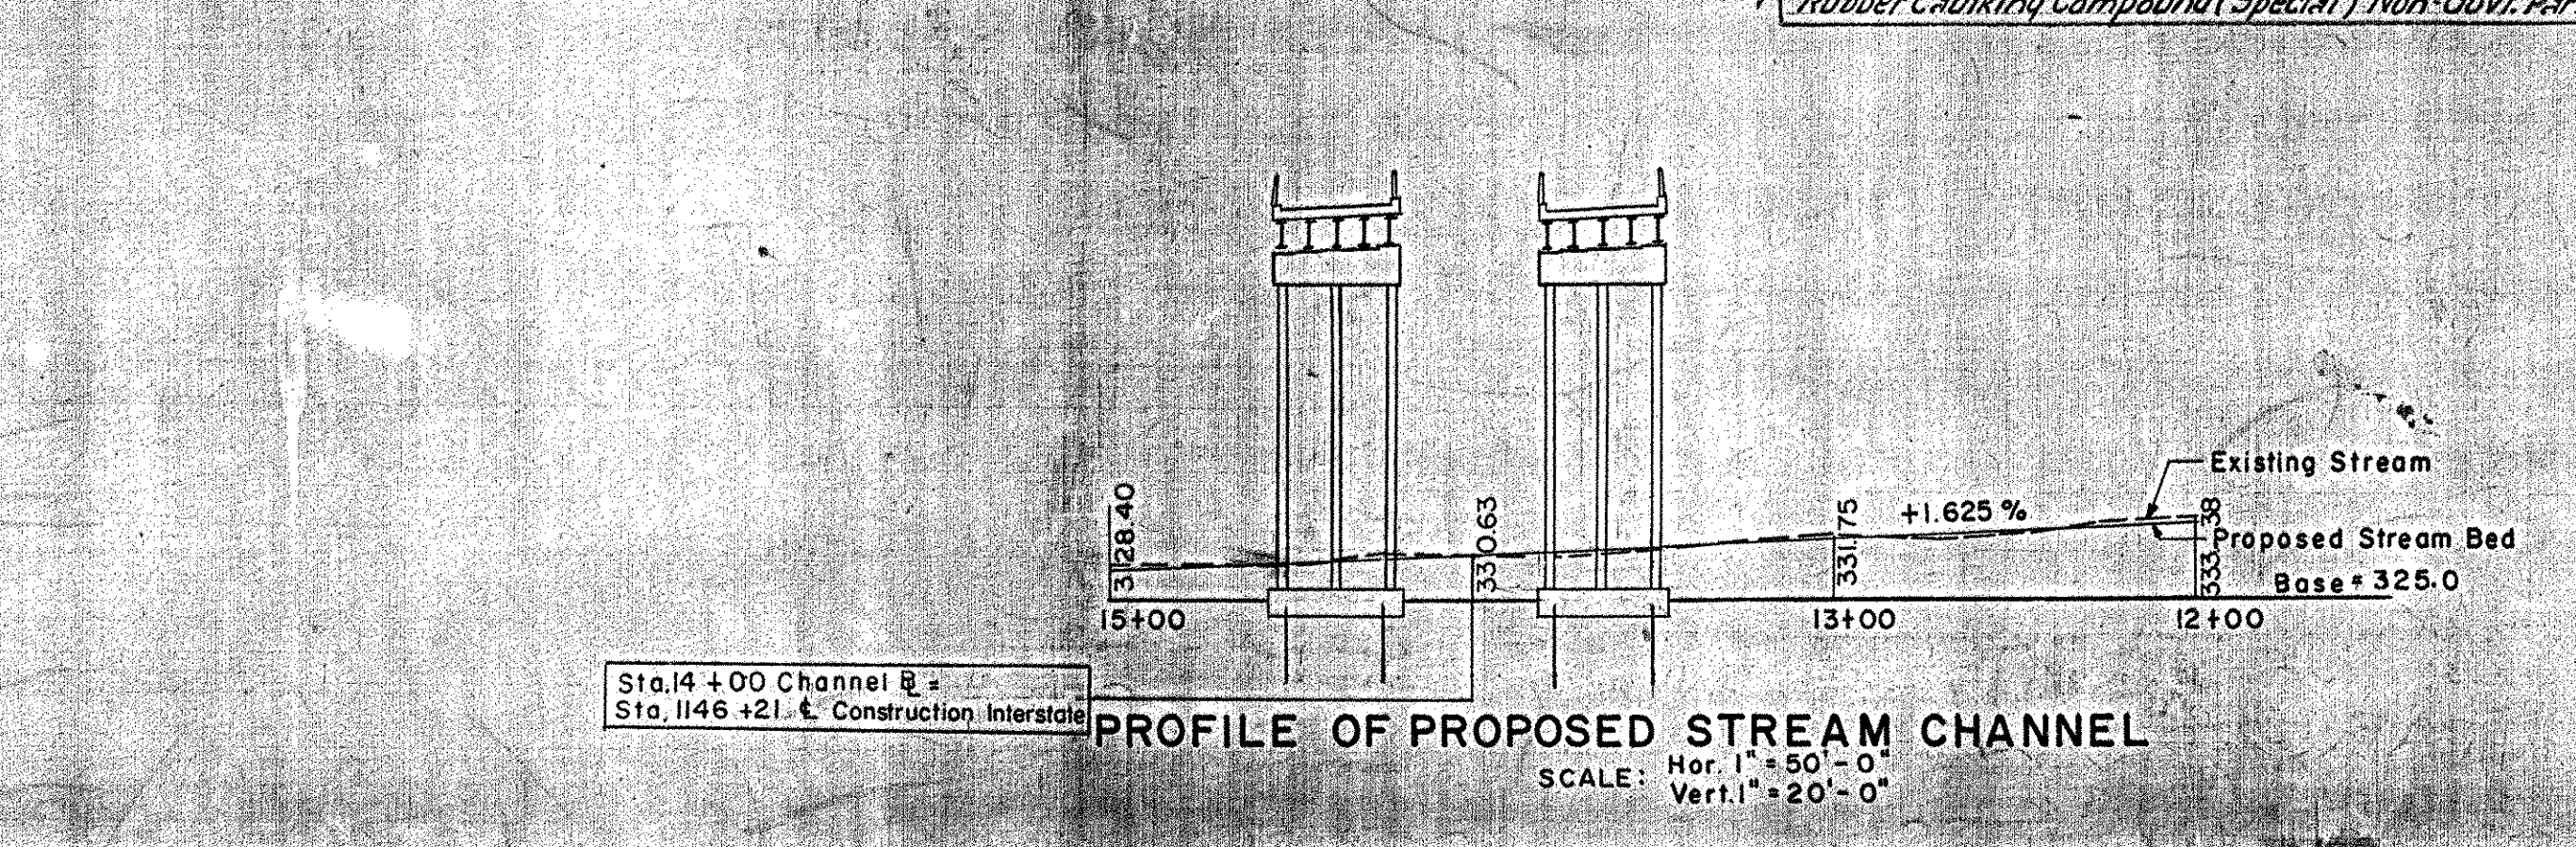

| LIST OF SHEETS | |
|----------------|----------------------------|
| SHEET NO. | DESCRIPTION |
| 68 | GENERAL PLAN |
| 69 | BORING LOGS |
| 70 | BORING LOGS |
| 71 | PLAN AND ELEVATION |
| 72 | PLAN AND ELEVATION |
| 73 | ABUTMENTS #1 AND #2 |
| 74 | ABUTMENT #3 |
| 75 | ABUTMENT #4 |
| 76 | APPROACH SLABS |
| 77 | PIERS A, B, C, D AND E |
| 78 | PIERS F, G, H AND J |
| 79 | STRUCTURAL STEEL PLAN |
| 80 | STRUCTURAL STEEL PLAN |
| 81 | STRUCTURAL DETAILS |
| 82 | REINFORCING SCHEDULE |
| 83 | REINFORCING SCHEDULE |
| 84 | REINFORCING SCHEDULE |
| 85 | HIGHWAYS PLAN AND PROFILES |
| 16-1 | SB-30-56 (1 & 2) |
| 50-5 | SB-56-57 (1 & 2) |
| 54-5 | SB-20-56 |
| 59 | SB-22-56 |
| 56 | SB-AS-Square-57 |
| 58 | SB-AS-45° Skew-57 |

CONTRACT NO. 3

GENERAL PLAN

STATE OF VERMONT
DEPARTMENT OF HIGHWAYS

INTERSTATE PROJECT in the towns of
WATERBURY - BOLTON

INTERSTATE OVER
STA. 1148+50

U.S. ROUTE 2 (REL.) OVER
STA. 30+00

APPROVED BY: *Wm. A. Henderson* DATE: 12-16-58

THE CLARKSON ENGINEERING CO., INC.
CONSULTING ENGINEERS
BOSTON MASSACHUSETTS

DRAWN BY: *R.J.F.* CHECKED BY: *W.H.M.* SCALE: AS NOTED
DATE: 7-7-58

PROJECT NO. I-89-2(7) SHEET 260 OF 307