



MARK	QTY	DESCRIPTION	FT	IN	16ths	FAB MARK	MILL MARK	WEIGHT
BP1	10	PREFORMED PAD 1/8"x 10 1/2"	-	26	0	-	-	53
BP2	5	PREFORMED PAD 1/8"x 15"	-	27	8	-	-	13
BP3	5	PREFORMED PAD 1/8"x 14"	-	29	8	-	-	13


TOTAL GROSS WT = 79

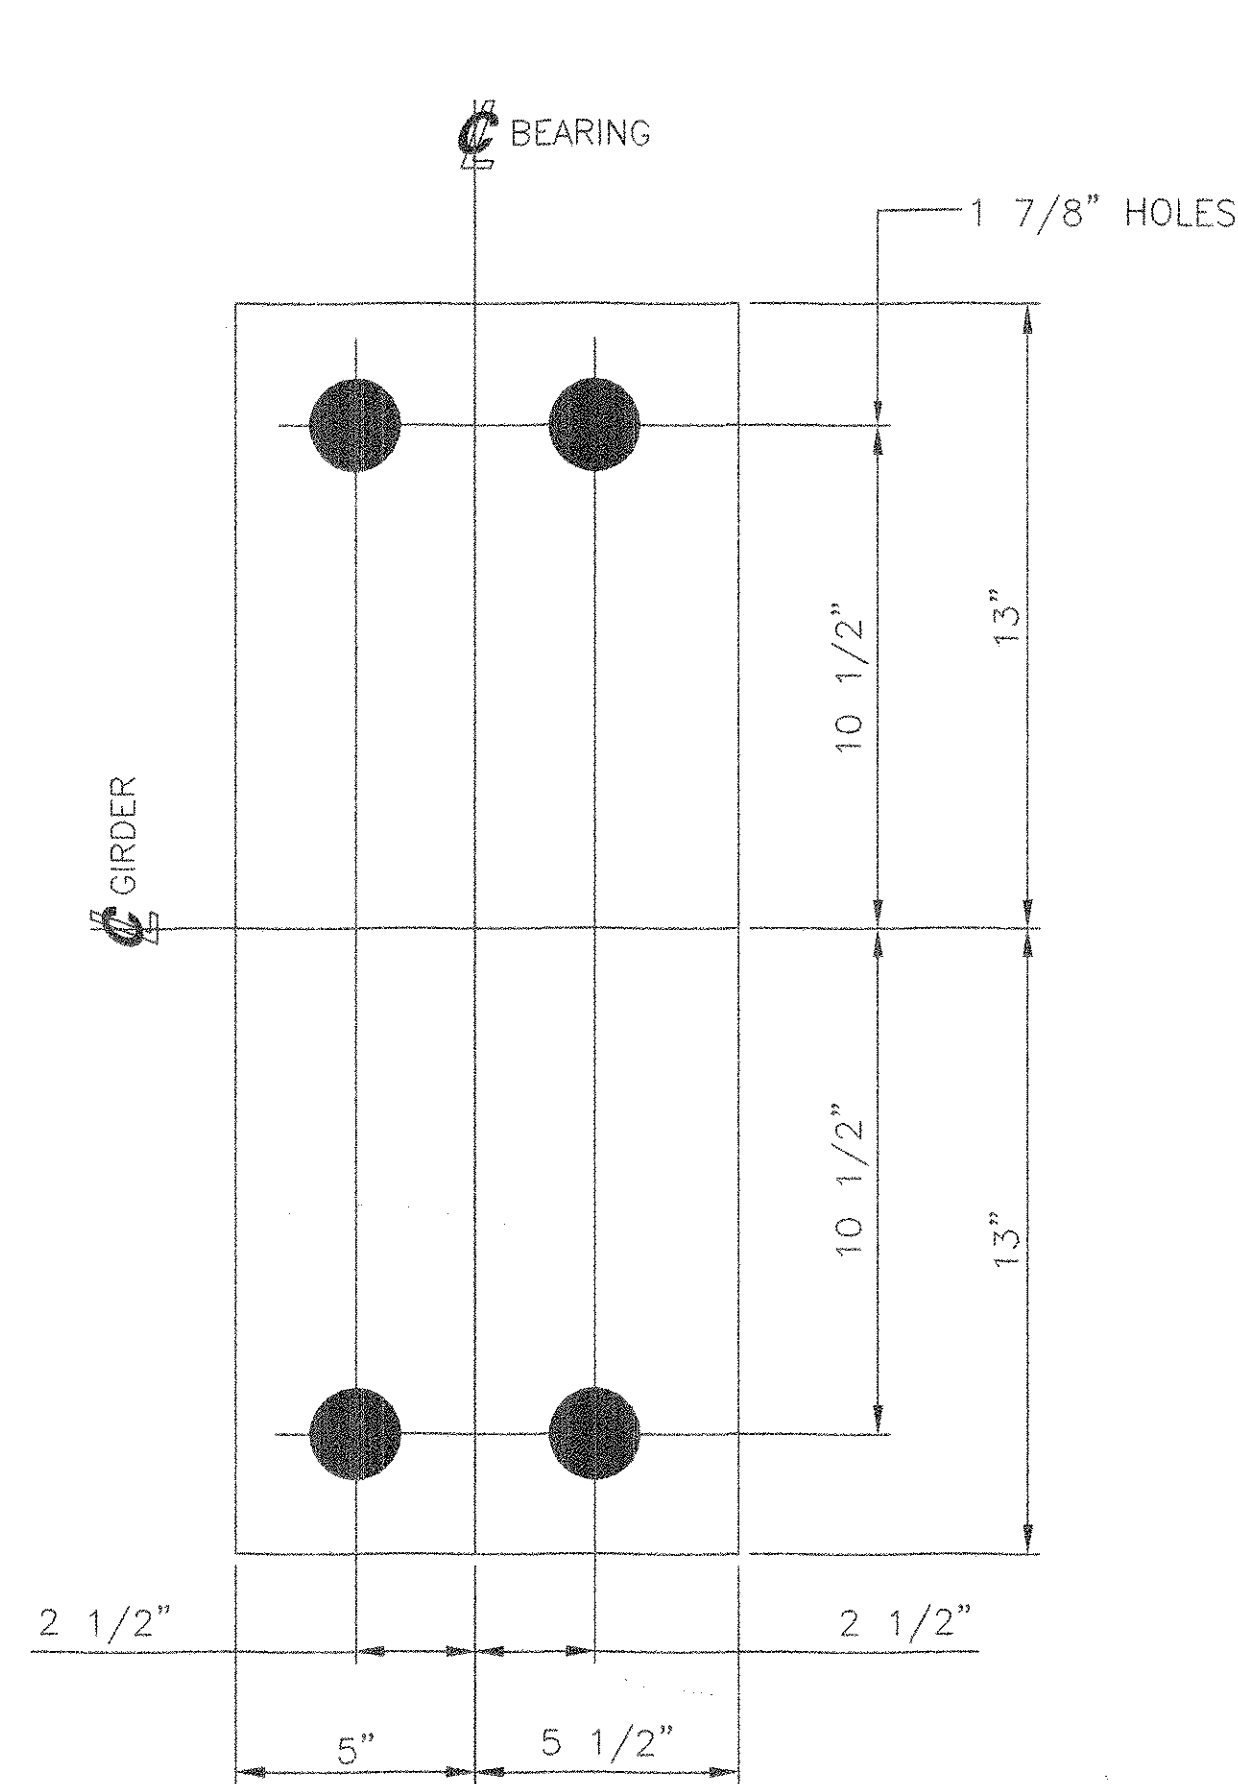

10 PREFORMED BEARING PADS, BP1
 1/8" x 10 1/2" x 26"
 MATERIAL SHALL BE IN ACCORDANCE WITH
 AASHTO 18.4.9.1, DIV. 2
 LOCATE AT
 BRIDGE NO. 51N, ABUT. 1
 BRIDGE NO. 51S, ABUT. 1

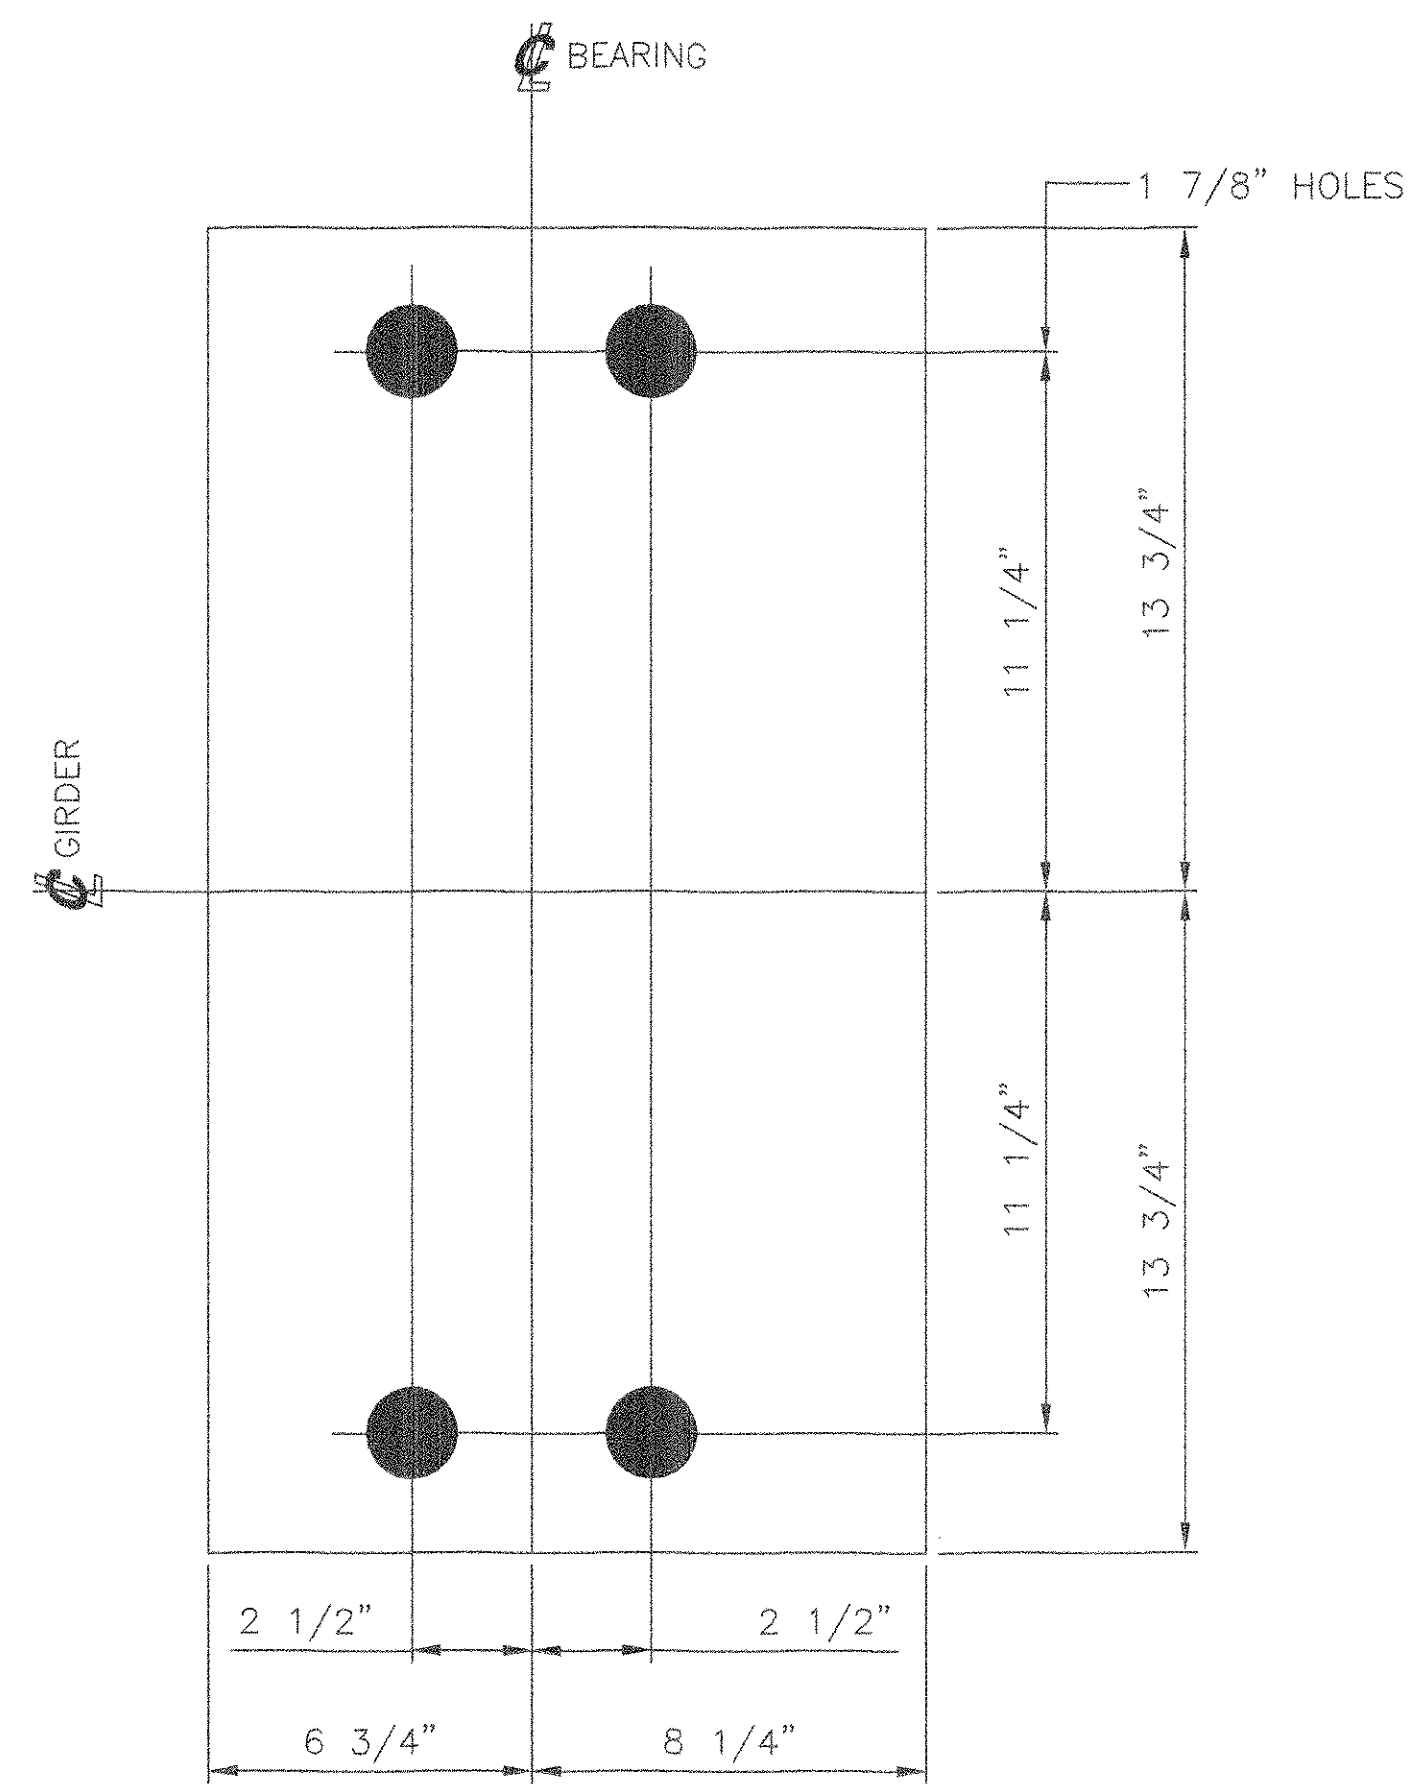

5 PREFORMED BEARING PAD, BP2
 1/8" x 15" x 27 1/2"
 MATERIAL SHALL BE IN ACCORDANCE WITH
 AASHTO 18.4.9.1, DIV. 2
 LOCATE AT
 BRIDGE NO. 51N, PIER 2

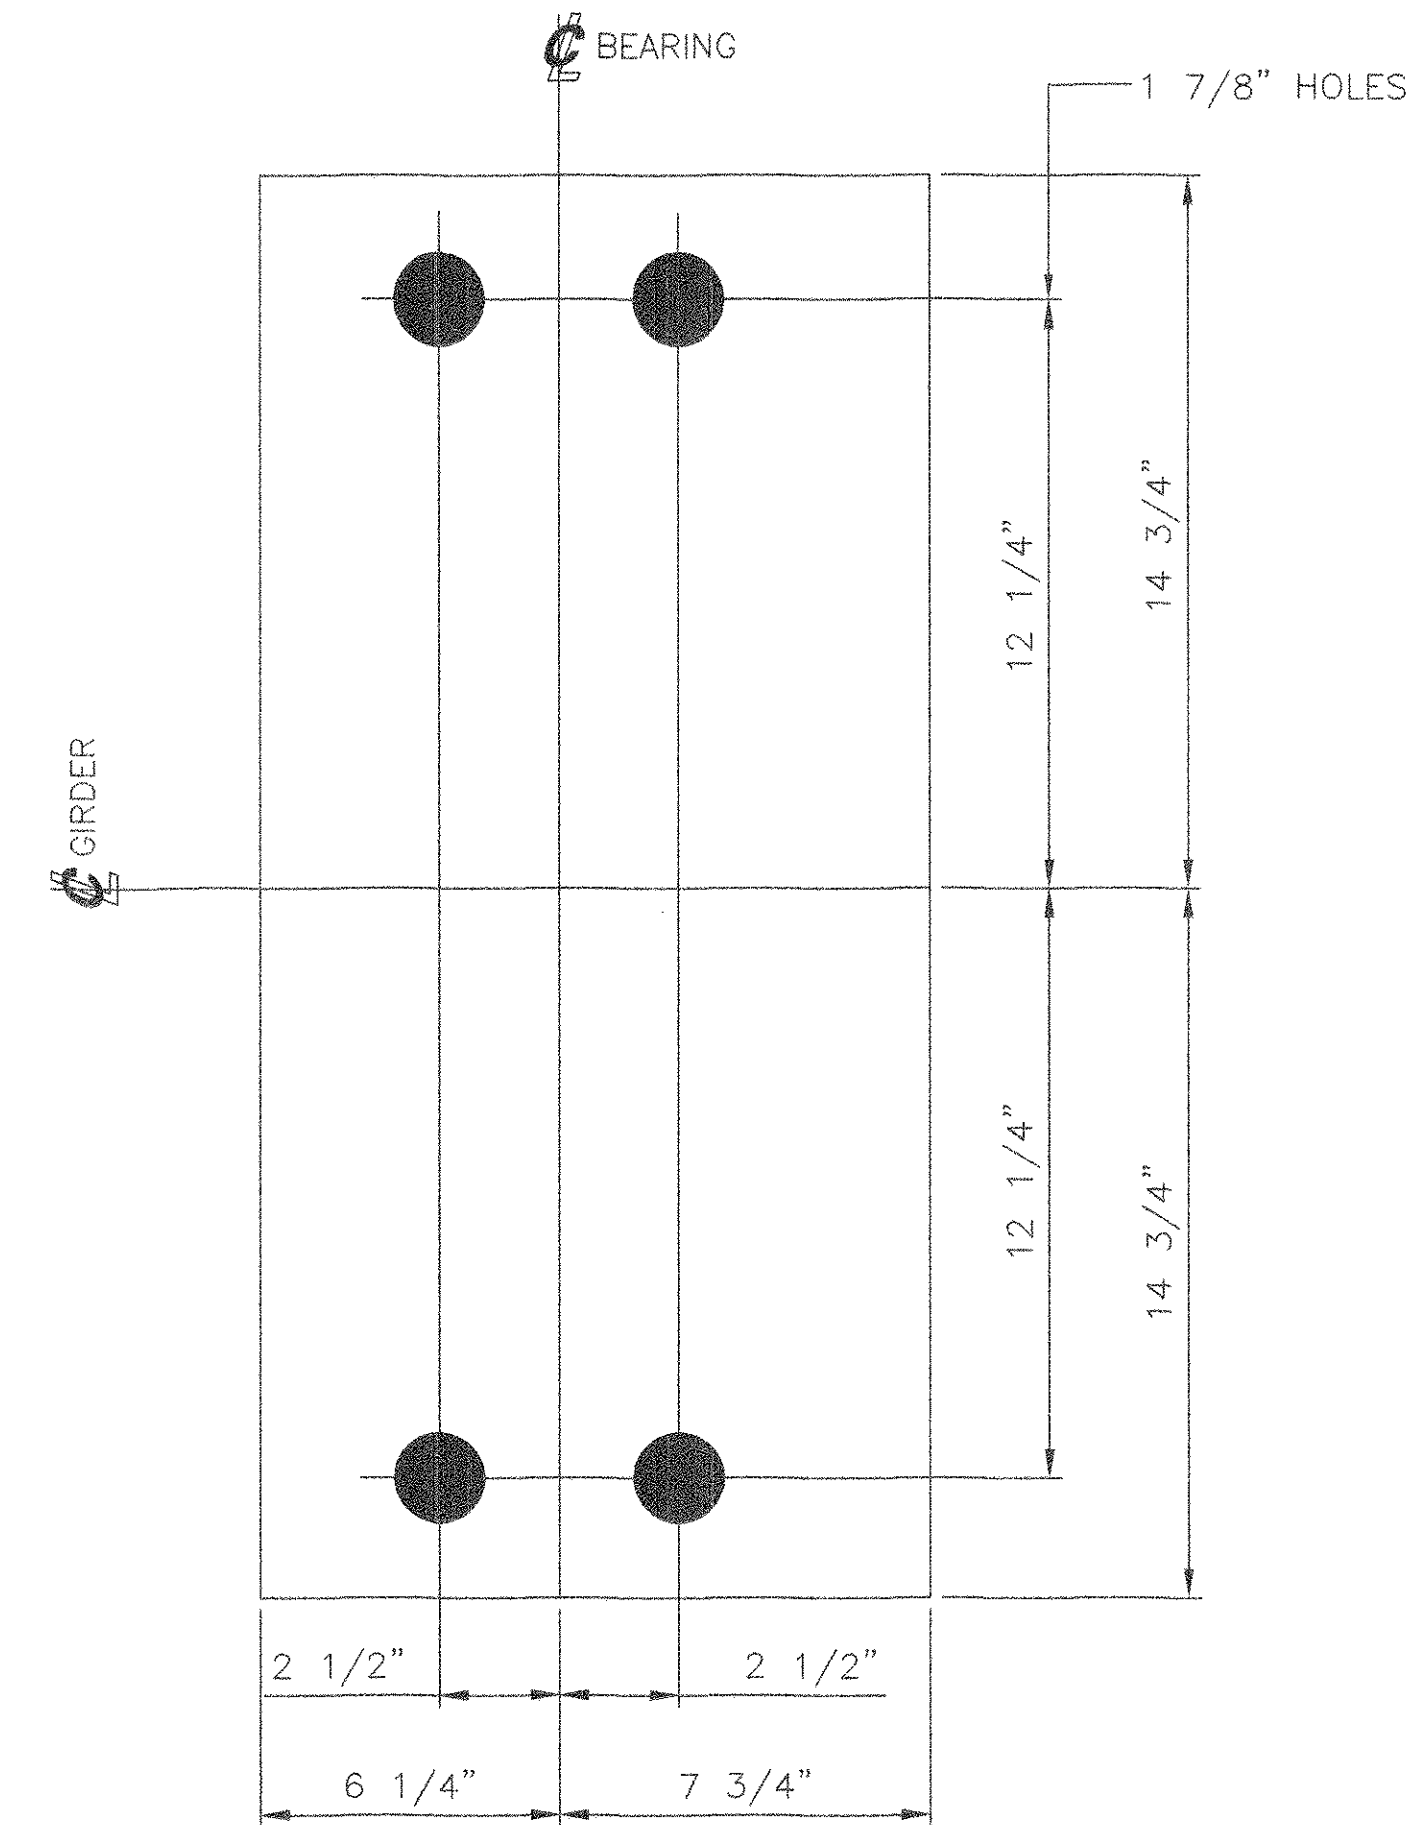

5 PREFORMED BEARING PAD, BP3
 1/8" x 14" x 29 1/2"
 MATERIAL SHALL BE IN ACCORDANCE WITH
 AASHTO 18.4.9.1, DIV. 2
 LOCATE AT
 BRIDGE NO. 51S, PIER 3

TVGA CONSULTANTS

NO EXCEPTIONS TAKEN REJECTED
 FURNISH AS CORRECTED
 REVISE AND RESUBMIT
 ENGINEER HAS REVIEWED SHOP DRAWINGS AND SAMPLES AND
 OTHER DATA WHICH CONTRACTOR IS REQUIRED TO SUBMIT ONLY FOR
 CONFIRMATION WITH THE INFORMATION GIVEN IN THE CONTRACT
 DOCUMENTS AND COMPATIBILITY WITH THE DESIGN CONCEPT OF THE
 COMPLETED PROJECT AS A FUNCTIONING WHOLE AS INDICATED IN THE
 CONTRACT DOCUMENTS. SUCH REVIEWS DO NOT EXTEND TO MEANS,
 METHODS, TECHNIQUES, SEQUENCES OR PROCEDURES OF
 CONSTRUCTION OR TO SAFETY PRECAUTIONS AND PROGRAMS INCIDENT
 THEREOF. CONTRACTOR IS RESPONSIBLE FOR DIMENSIONS TO BE
 CONFIRMED AND CORRELATED AT THE JOB SITE, FOR INFORMATION THAT
 PERTAINS SOLELY TO THE FABRICATION PROCESSES OR TO TECHNIQUES
 OF CONSTRUCTION, AND FOR COORDINATION OF THE WORK OF ALL TRADES.

BY: *[Signature]*
 DATE: 02/05

SEE SHEET AS1 FOR ASSEMBLY NOTES.
 SEE SHEET 1 FOR SHOP NOTES.

STATE OF VERMONT
 AGENCY OF TRANSPORTATION
 TOWN OF BOLTON
 PROJECT NO.: IM-089-2 (29)
 BRIDGE NO.'S 51N AND 51S
 ON INTERSTATE 89

COSMEC, INC. 70 SOUTH STREET
 WALPOLE, MA. 02081

SCALE: 1/4"=1" DRAWN BY: JEP CHECKED BY: PJM
 SHT 11 OF 12 DATE: 01/05 DATE: 02/05

COSMEC BEARING bb325

REV.	BY	DATE	CK'D BY	DATE	S.O. NUMBER	DRAWING NUMBER	REV.
-	-	-	-	-	60233	4370	0

CUSTOMER: WINTERSET