

INDEX OF SHEETS

1. TITLE SHEET
2. PRELIMINARY INFORMATION SHEET
3. ROADWAY TYPICAL SECTION
- 4-4A-4B. QUANTITIES SHEET
5. TIE SHEET
6. LAYOUT SHEET
7. US 5 PROFILE SHEET
8. TEMP. DETOUR-BRIDGE AND ROADWAY TYPICALS
9. TEMP. DETOUR-PLAN-SHEET 1 OF 2
10. TEMP. DETOUR-PLAN-SHEET 2 OF 2
11. TEMP. DETOUR PROFILE - SHEET 1 OF 2
- 11A. TEMP. DETOUR PROFILE - SHEET 2 OF 2
- 11B. TEMP. BRIDGE FRAMING PLAN - SHEET 1 OF 2
- 11C. TEMP. BRIDGE FRAMING PLAN - SHEET 2 OF 2
12. GENERAL PLAN & ELEVATION
13. SEDIMENT AND EROSION CONTROL PLAN
14. GENERAL NOTES AND CONSTRUCTION SCOPE
- 15-17. DECK REINFORCEMENT AND DETAILS
- 18-18A. BRIDGE END & MISCELLANEOUS DETAILS
19. BRIDGE FRAMING PLAN
- 20-21. BEARING LAYOUT & DETAILS
22. SHEAR STUD CONNECTION & LAYOUT
- 23-26. EXPANSION JOINT AT PIER 1 AND 4
27. APPROACH SLAB DETAILS
28. SUBSTRUCTURE REPAIR NOTES AND DETAILS
29. ABUTMENT 1 REPAIR AREAS
30. ABUTMENT 2 REPAIR AREAS
31. ABUTMENT MODIFICATIONS
32. PIER NO.1 REPAIR AREAS
33. PIER NO.2 REPAIR AREAS
34. PIER NO.3 REPAIR AREAS
35. PIER NO.4 REPAIR AREAS
36. PIER REPAIR
37. DETAIL BR1-BRIDGE RAILING-NETC 2 RAIL
38. DETAIL BR2-BRIDGE RAILING-NETC 2 RAIL-THRIE BEAM APPROACH RAIL
- 38A. DETAIL BR3-BRIDGE RAILING-NETC 2 RAIL-THRIE BEAM APPROACH RAIL
- 38B. DETAIL BR4-SNOW FENCE FOR BRIDGE RAILING-NETC 2 RAIL
39. CURB & CONSTRUCTION JOINT DETAILS
40. REINFORCING STEEL SCHEDULE
41. NOT USED
- 42-44. US 5 CROSS SECTIONS
- 44A-44G. TEMPORARY DETOUR CROSS-SECTIONS
- 45-63. OLD BRIDGE REFERENCE SHEETS
- 64-65. OLD FILL-IN DESIGN STANDARDS
- 66-72. OLD ROADWAY REFERENCE SHEETS
- 73-81. NOT USED
- 82-85. OLD DESIGN STANDARDS

STATE OF VERMONT AGENCY OF TRANSPORTATION



PROPOSED IMPROVEMENT BRIDGE PROJECT

TOWN OF HARTLAND
COUNTY OF WINDSOR
ROUTE No. : I-91 BRIDGE No. : 38


PROJECT LOCATION: US 5 MM 3.75 OVER I-91MM 63.4, (BRIDGE 62 ON US 5)

PROJECT DESCRIPTION: INSTALL TWO-WAY TEMPORARY BRIDGE, REMOVE AND REPLACE DECK ON EXISTING STEEL, REMOVE TEMPORARY BRIDGE AND PAINT EXISTING STEEL

LENGTH OF STRUCTURE: 374.64 FEET


LENGTH OF ROADWAY: 200 FEET

LENGTH OF PROJECT: 574.64 FEET

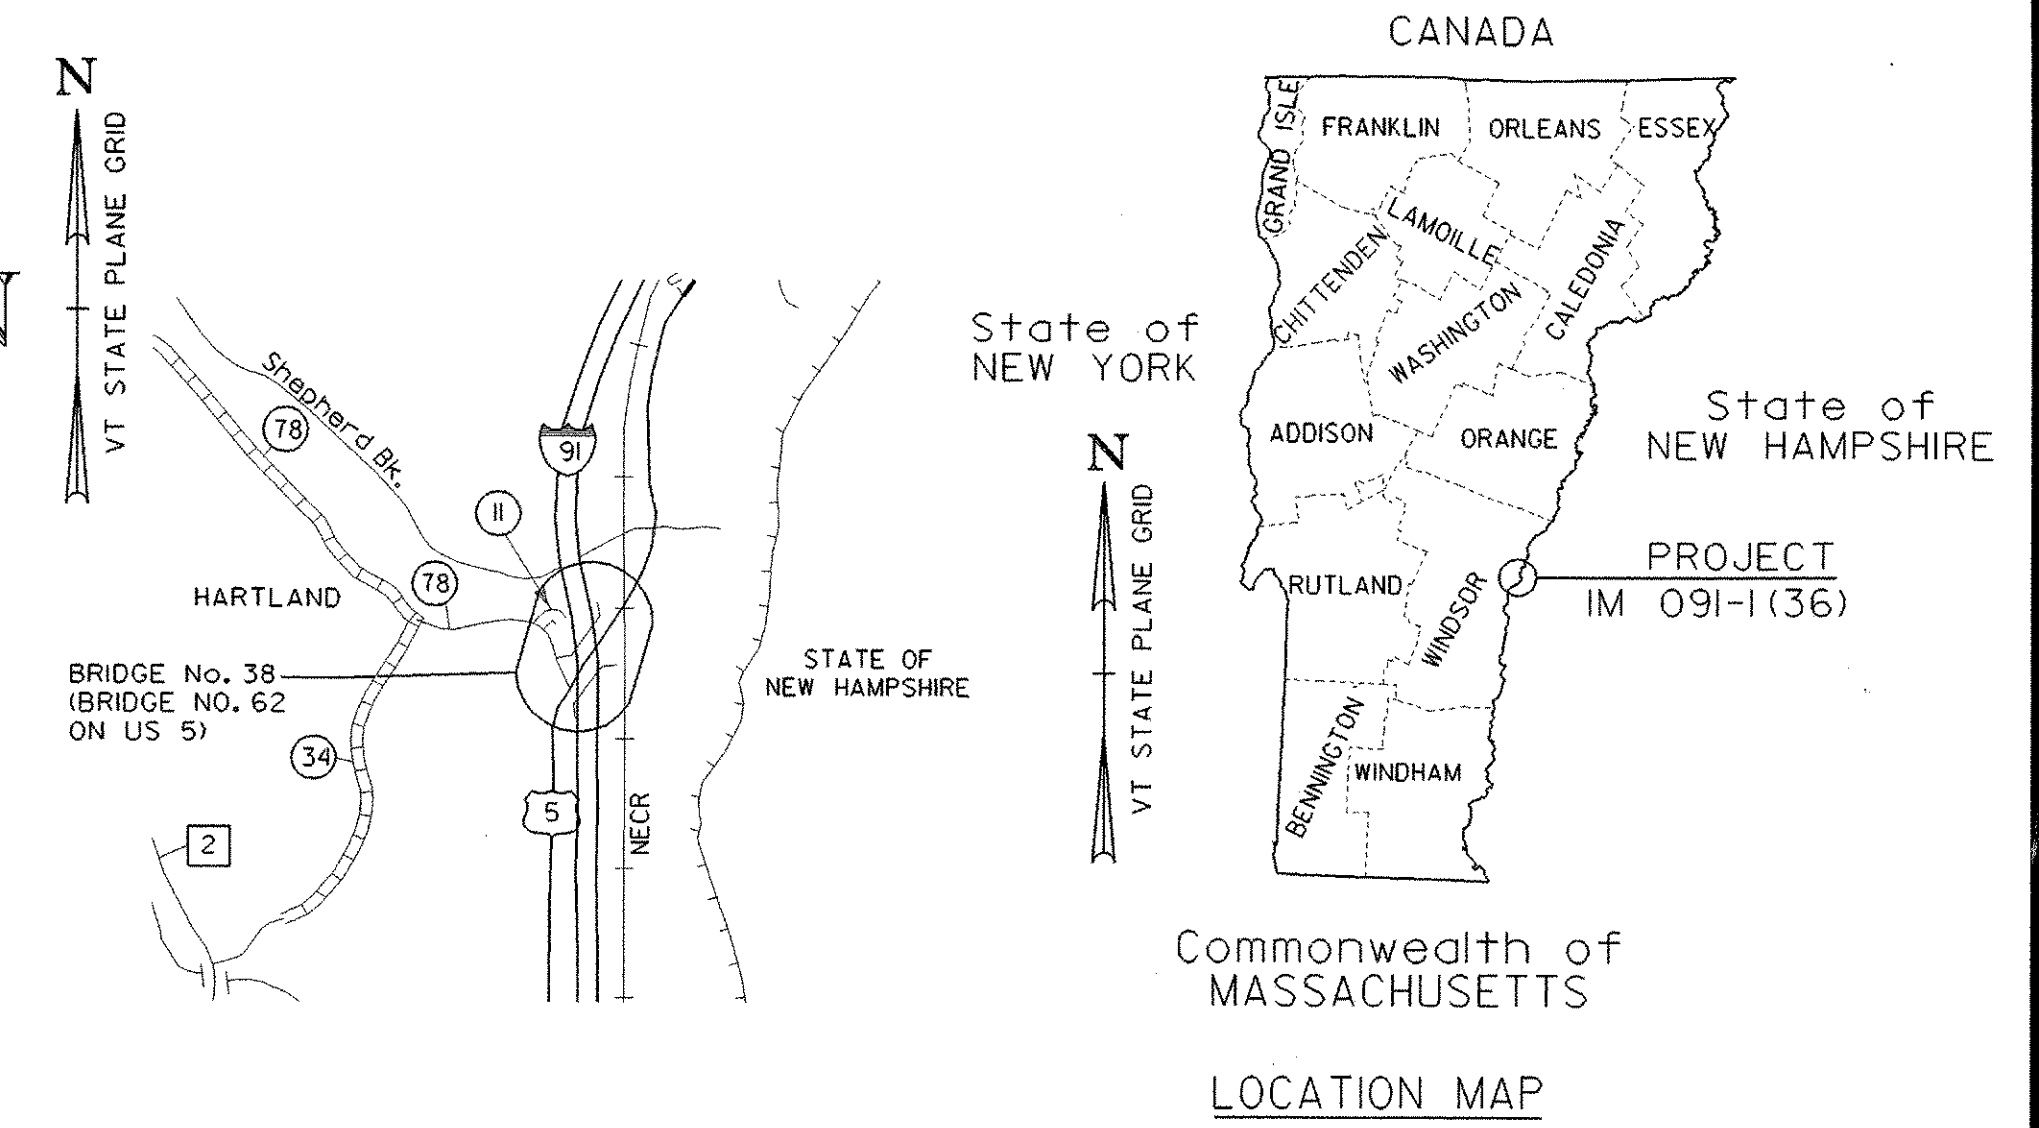

RECORD PLANS	
CONTRACTOR:	FW WHITCOMB CONST. CORP.
RESIDENT ENGINEER:	JACK COUTURE
CONSTRUCTION BEGAN:	MAY 5, 2003
CONSTRUCTION COMPLETE:	SEPTEMBER 27, 2004
RECORD PLANS BY:	K. NORTH, N. GARBACIK
I HEREBY CERTIFY THAT ALL THE CONSTRUCTION REQUIRED BY THIS SET OF DRAWINGS HAS BEEN ACCOMPLISHED AS INDICATED HEREIN.	
BY:	<i>Jack Couture</i> RESIDENT ENGINEER
DATE:	6-15-05
NOTE: Any further information concerning final quantities, amounts or other details relative to this project may be found at Central Files in the electronic archives.	

LIST OF STANDARDS	
E-100	01-06-97
E-101	03-10-97
E-102	08-08-95
E-103	09-23-98
E-106	08-08-95
E-140	08-30-96
E-152	08-08-95
E-171A	08-09-95
E-171B	08-09-95
E-172	08-09-95
E-173	08-09-95
E-175	11-17-93
E-193	08-18-95
F-1	06-01-94
G-1	01-03-00
G-1D	01-03-00
G-18	06-01-94
T-1	06-01-94
T-2	06-01-94
SB-R6-82 01/06/95	

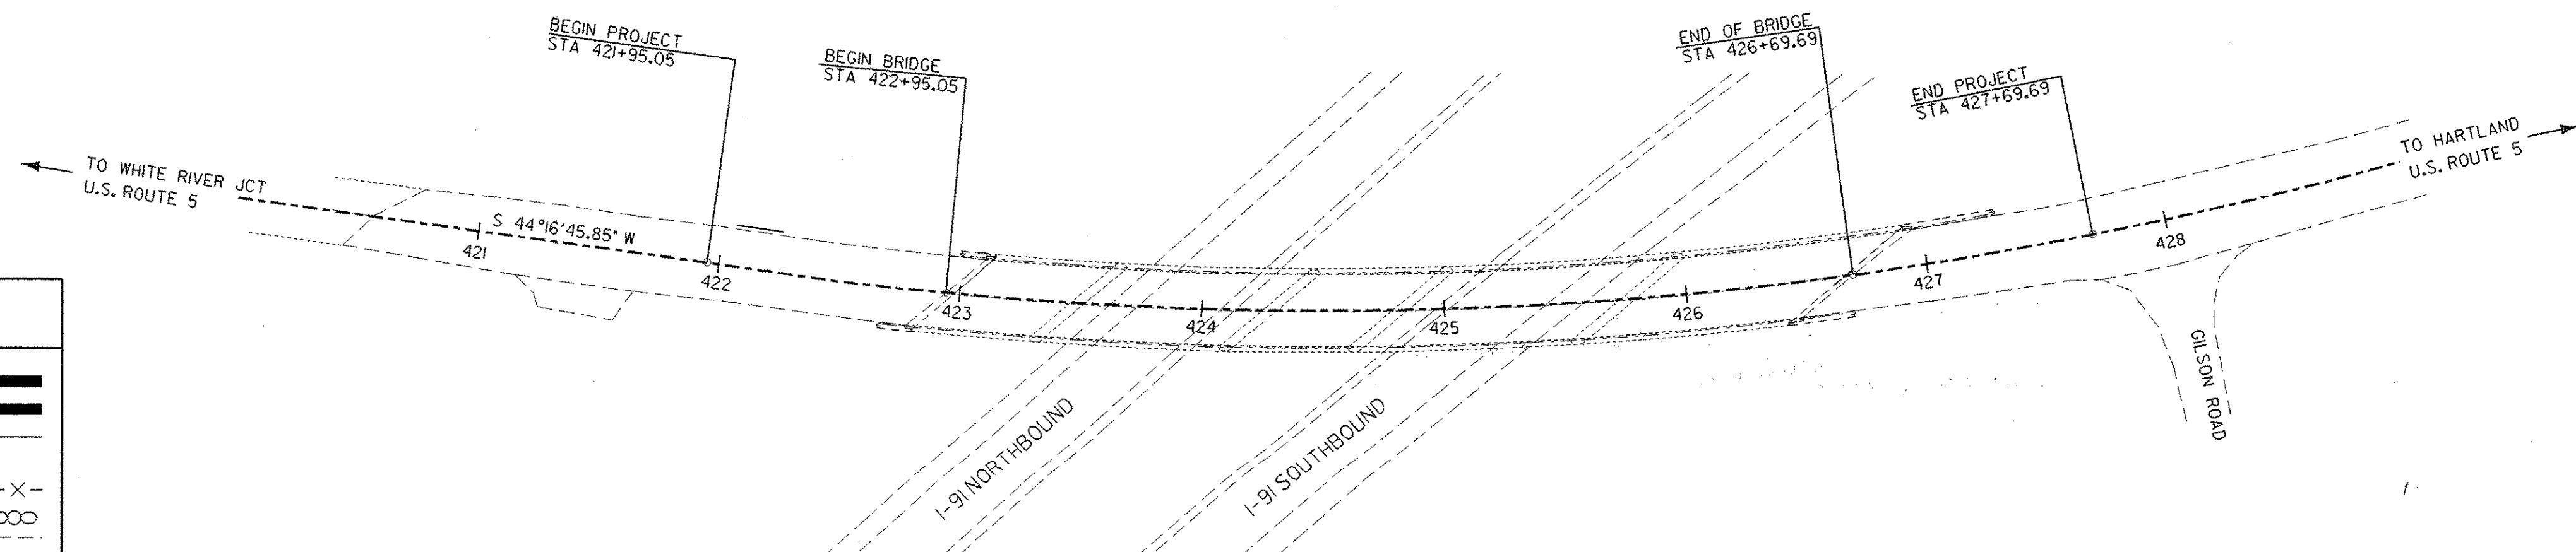

CONVENTIONAL SYMBOLS	
COUNTY LINE	
TOWN LINE	
LIMITS OF ACCESS	
POINT OF ACCESS	
FENCE LINE	
STONE WALL	
TRAVELED WAY	
GUARD RAIL	
RAILROAD	
SURVEY LINE	
CULVERT	
POWER POLE	
TELEPHONE POLE	
TREES	
CONTROL OF ACCESS	
PROPERTY LINE	
R.O.W. TAKING LINE	
SLOPE RIGHTS	
TOP OF CUT	
TOE OF SLOPE	

DATUM	
VERTICAL	NAVD 88
HORIZONTAL	NAD-83(96)

THESE PLANS ARE SUBJECT TO SUCH ENGINEERING CHANGES AS MAY BE REQUIRED BY THE FEDERAL HIGHWAY ADMINISTRATION OR THE DIRECTOR OF PROJECT DEVELOPMENT. CONSTRUCTION IS TO BE CARRIED ON IN ACCORDANCE WITH THESE PLANS AND THE STANDARD SPECIFICATIONS FOR CONSTRUCTION DATED 2001, AS APPROVED BY THE FEDERAL HIGHWAY ADMINISTRATION ON JANUARY 4, 2001 FOR USE ON THIS PROJECT, INCLUDING ALL SUBSEQUENT REVISIONS AND SUCH REVISED SPECIFICATIONS AND SPECIAL PROVISIONS AS ARE INCORPORATED IN THESE PLANS.

DEPARTMENT OF TRANSPORTATION FEDERAL HIGHWAY ADMINISTRATOR	
APPROVED <i>Micha</i>	DATE 2/24/05
DIRECTOR OF PROJECT DEVELOPMENT	
APPROVED <i>Doug Smith</i>	DATE 12/23/02
PROJECT MANAGER : SHERWARD FARNSWORTH	
PROJECT NAME : HARTLAND	
PROJECT NUMBER : ACIM 091-1(36)	
SHEET 1 OF 85 SHEETS	

STONE & WEBSTER, INC.

20-DEC-2002

v:\Struc\working\va2721t.dgn