


CURVE DATA	
$\Delta$	= 24°00'00" LEFT
R	= 1637.0223'
T	= 347.9598'
L	= 685.7143'
E	= 36.572'
BANK	= 0.057

**NOTES:**

1. COLD PLANE BIT. PAVEMENT AND PLACE BIT. CONCRETE SURFACE COURSE.
2. PLACE BIT. CONCRETE SURFACE AND BIT. CONCRETE BASE COURSE OVER EXISTING BIT. CONCRETE.
3. PLACE BIT. CONCRETE SURFACE AND BIT. CONCRETE BASE COURSE OVER NEW CONCRETE APPROACH SLAB. SEE SHEET 27.
4. NOT USED.
5. FILL SLOPES ARE 1-2 (VERT-HORZ)
6. DURABLE 4" DOUBLE YELLOW LINE IS COINCIDENT WITH CONSTRUCTION BASELINE.

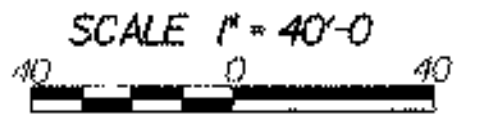

ITEM 210.40  
COLD PLAINING-BIT. PAVEMENT  
STA 421+95 TO 422+20  
STA 426+95 TO 427+69

ITEM 621.80  
REMOVAL AND DISPOSAL OF GUARD RAIL  
421+95.18 LT TO 422+99 LT  
427+30 LT TO 427+69 LT 428+53  
421+95.80 RT TO 422+67 RT  
426+67 RT TO 427+69 RT  
426+54 TH 8 COMPLETE REMOVAL

ITEM 646.40  
DURABLE 4" WHITE LINE  
STA 421+00 LT TO 429+00 LT  
STA 421+00 RT TO 429+00 RT

ITEM 646.41  
DURABLE 4" YELLOW LINE  
STA 421+00 TO 429+00

ITEM 203.28  
EXCAVATION OF SURFACES AND PAVEMENTS  
STA 422+20 TO 422+70

ITEM 621.21  
HEAVY DUTY STEEL BEAM GUARD RAIL (WITH STEEL POSTS)  
STA 421+95 LT TO 422+69 LT  
STA 427+61.60 LT TO 427+69.85 LT  
STA 422+30.14 RT TO 422+38.39 RT  
STA 426+98 RT TO 427+69 RT  
422+45 TO 422+70

ITEM 651.15, 651.18, 651.20, 651.25, 651.35  
SEED, FERTILIZER, HAY MULCH LIME STONE AND TOP SOIL (6")  
STA 421+95 TO 423+80  
STA 426+45 TO 427+69

ITEM 616.28 616.21 VERTICLE GRANITE CURB  
CAST-IN-PLACE CEMENT CONCRETE CURB, TYPE-B  
STA 422+59 LT TO 422+99 LT  
STA 427+31 LT TO 427+71 LT  
STA 422+27 RT TO 422+67 RT  
STA 426+68 RT TO 427+08 RT

ITEM 621.505  
MANUFACTURED TERMINAL SECTION  
STA 421+80.75 RT TO 422+30.15 RT  
STA 426+97 RT TO 427+47 RT

ITEM 621.72  
GUARDRAIL APPROACH SECTION, NETC2 RAIL (MOD)  
STA 422+69 LT TO 422+99 LT  
STA 427+31 LT TO 427+61 LT  
STA 422+38 RT TO 422+67 RT  
STA 426+68 RT TO 426+98 RT

ITEM 646.85  
REMOVAL OF EXISTING PAVEMENT MARKINGS  
STA 425+09 TO 426+69  
STA 421+85 TO 422+95

ITEM 675.50  
REMOVING SIGNS  
SIGN OM-3, QTY=4

ITEM 675.30  
FLANGED CHANNEL SIGN POST  
SIGN POST FOR OM-3,  
QTY = 4 @ 25 LBS EA = 100 LBS

ITEM 675.60  
ERECTING SALVAGED SIGNS  
SIGN OM-3, QTY=4

DATUM  
VERTICAL NAVD 88  
HORIZONTAL NAD-83(96)

STONE & WEBSTER, INC.

<b>STATE OF VERMONT</b>	
<b>AGENCY OF TRANSPORTATION</b>	
Town of HARTLAND	Bridge No. 38
Highway No. 1-91	Log Sta.
	Surv. Sta.
LAYOUT SHEET	
Designed By J. BARRACK	Drawn By N. HERRERA
Checked By J. BARRACK	Date DEC. 2000
	Bridge Design Supervisor E. JOHNSTON Date FEB. 2001
PROJECT HARTLAND	PROJECT NO. IM 091-1(36)
Drawing Name za272lay.dgn	Bridge Sheet No.
	Sheet 6 of 85

64-FEB-2000  
\\ncivil\working\za272lay.dgn