



\*\*\*NOTE: REFER TO FRAMING PLANS FOR ALL OTHER CENTERLINE OF BEARING LOCATIONS FOR MEDIAN SPAN 3 AND APPROACH SPANS

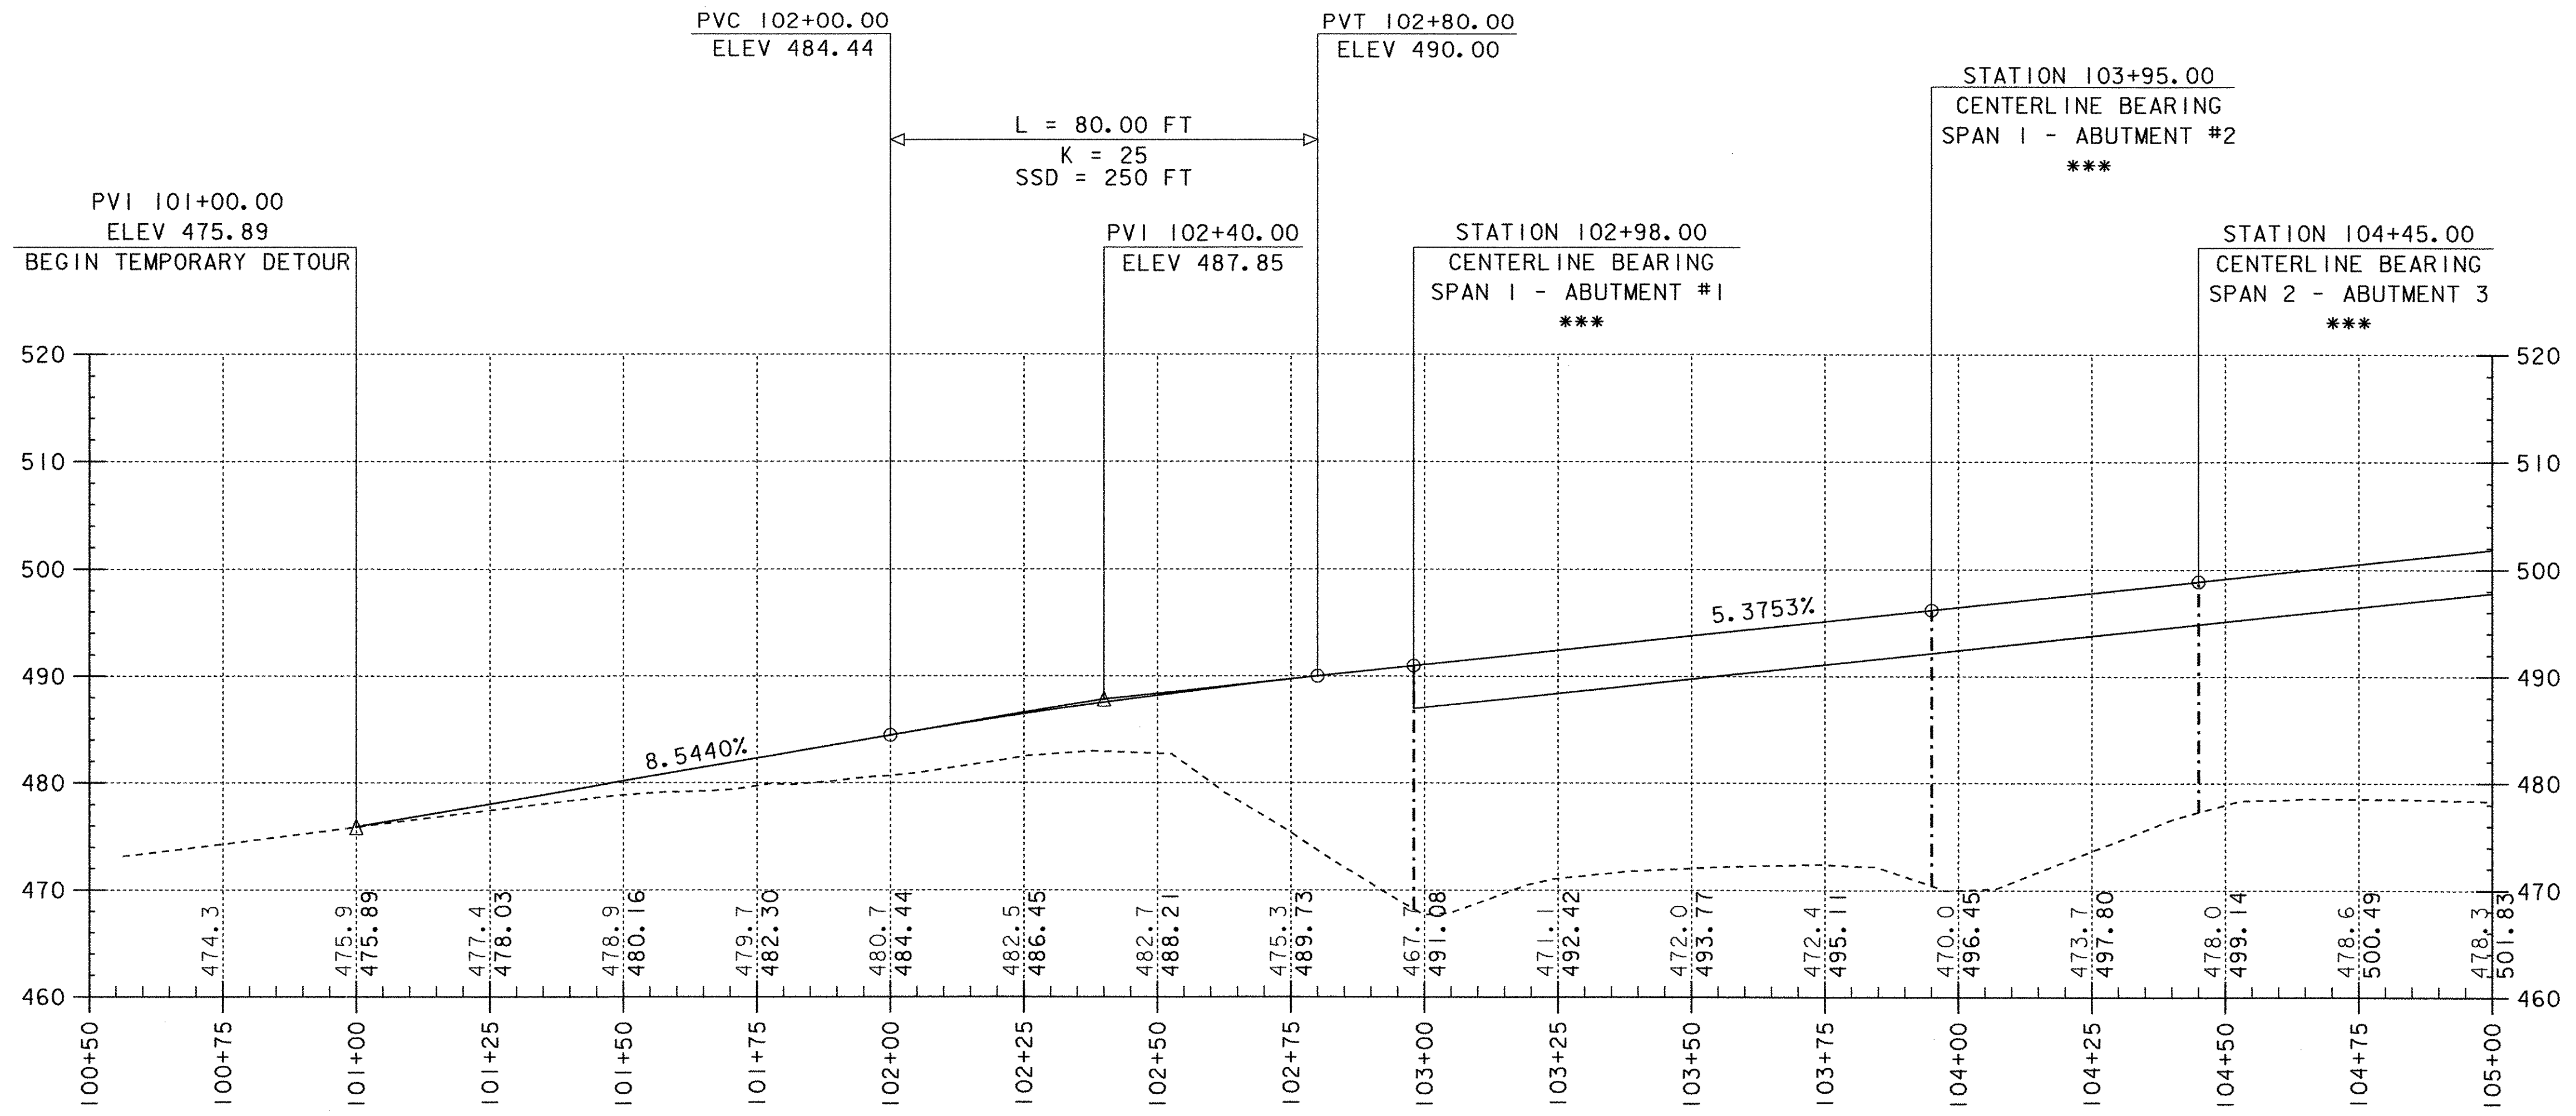

TEMPORARY DETOUR PROFILE

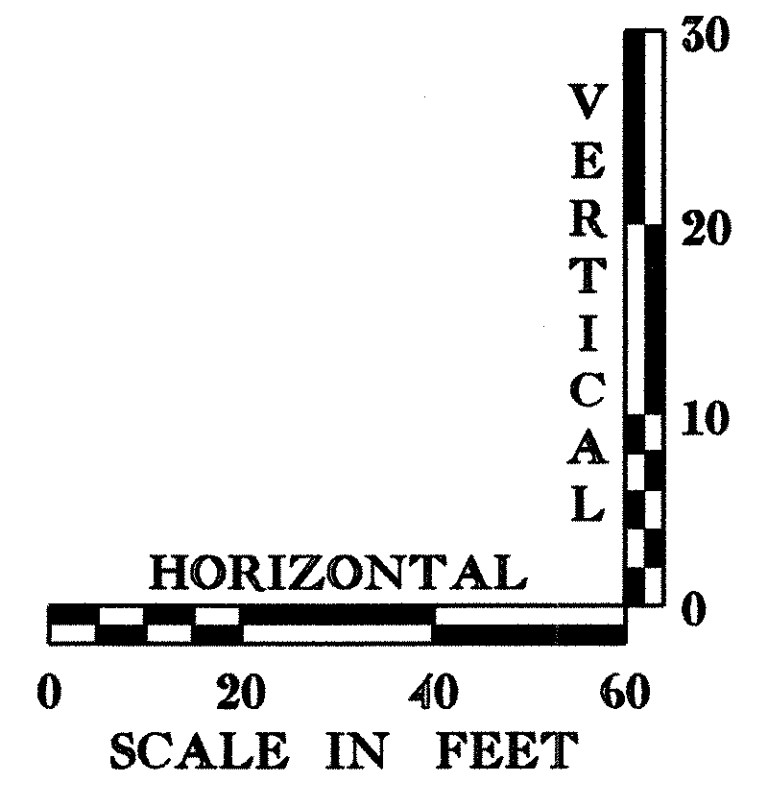

**TEMP. DETOUR PROFILE - SHEET 1 OF 2**

THE GRADES SHOWN TO THE NEAREST TENTH ARE THE OLD GROUND ALONG THE CENTERLINE. THE GRADES SHOWN TO THE NEAREST HUNDREDTH ARE THE PROPOSED FINISHED GRADE ALONG THE CENTERLINE.

PROJECT NAME:	HARTLAND	PLOT DATE:	26-FEB-2003
PROJECT NUMBER:	IM 091-(136)	DRAWN BY:	K. UPMAL
FILE NAME:	str7/99q272/sq272xs.dgn	CHECKED BY:	
PROJECT LEADER:	S. FARNSWORTH	SHEET II	OF 85
DESIGNED BY:	K. UPMAL		