
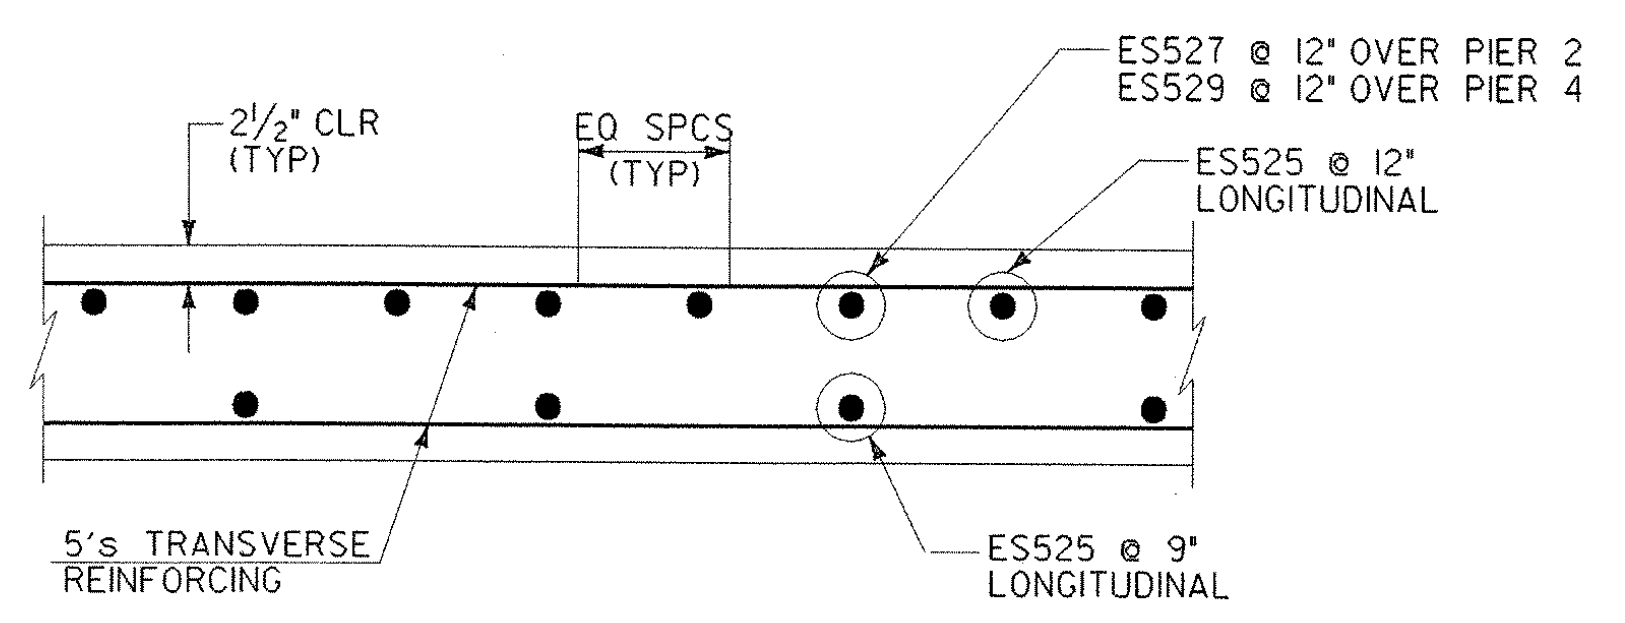
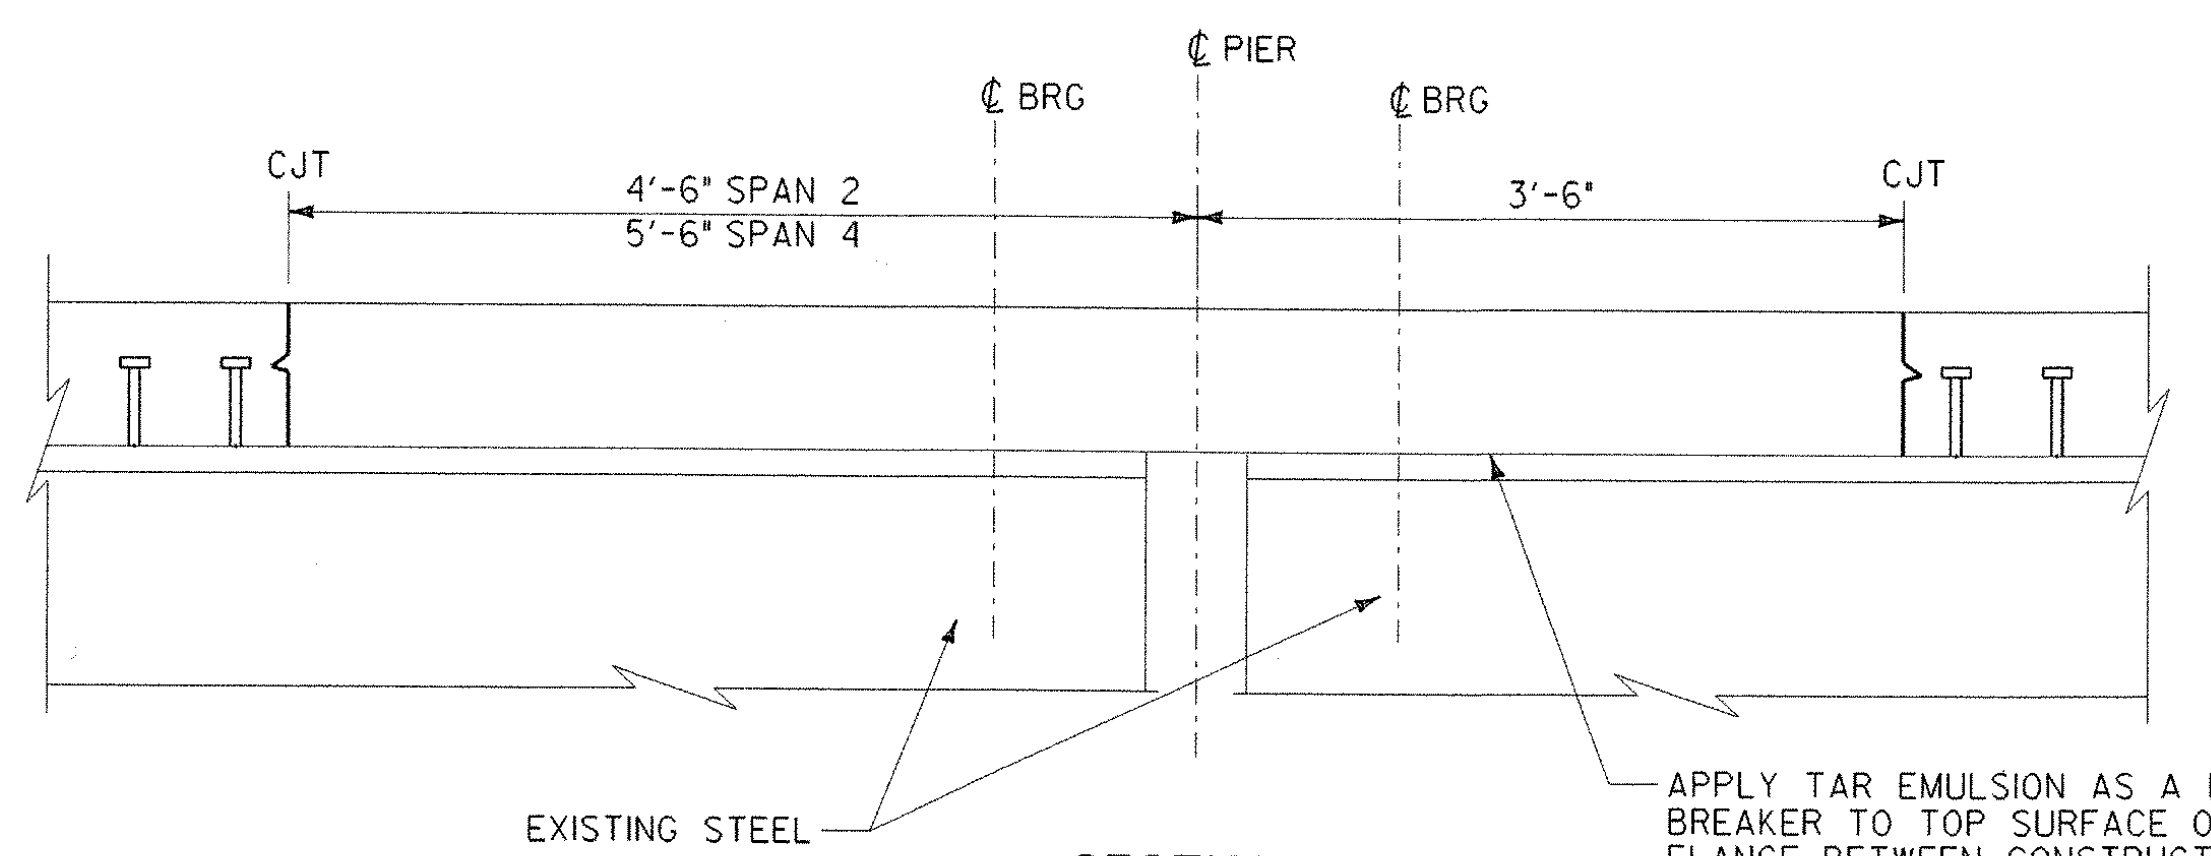
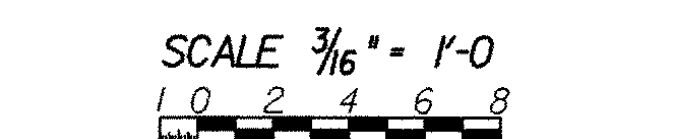
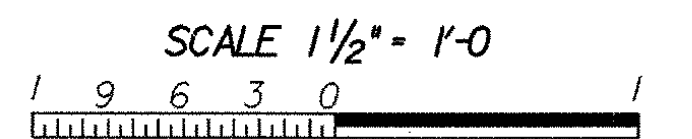


**REINFORCEMENT PLAN**

SCALE: 3/16" = 1'-0"

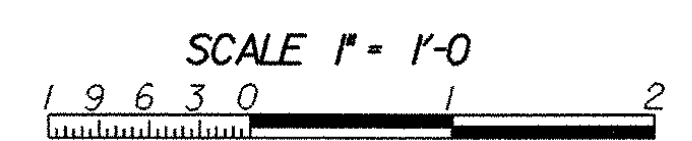

**STATE OF VERMONT  
AGENCY OF TRANSPORTATION**

Town Of HARTLAND	Bridge No. 38
Highway No. 1-91	Log Sta.
DECK REINFORCEMENT & DETAILS	
SHEET 2 OF 3	
Designed By S. YONGHO	Drawn By N. HERRERA
Checked By E. JOHNSTON	Date DEC 2000
Bridge Design Supervisor E. JOHNSTON Date FEB. 2001	
PROJECT HARTLAND	PROJECT NO. IM 091-1(36)
Drawing Name za272dr2.dgn	
Bridge Sheet No.	Sheet 16 of 85

STONE & WEBSTER, INC.

04-FEB-2003

v:\Struc\working\za272dr2.dgn