


426+70

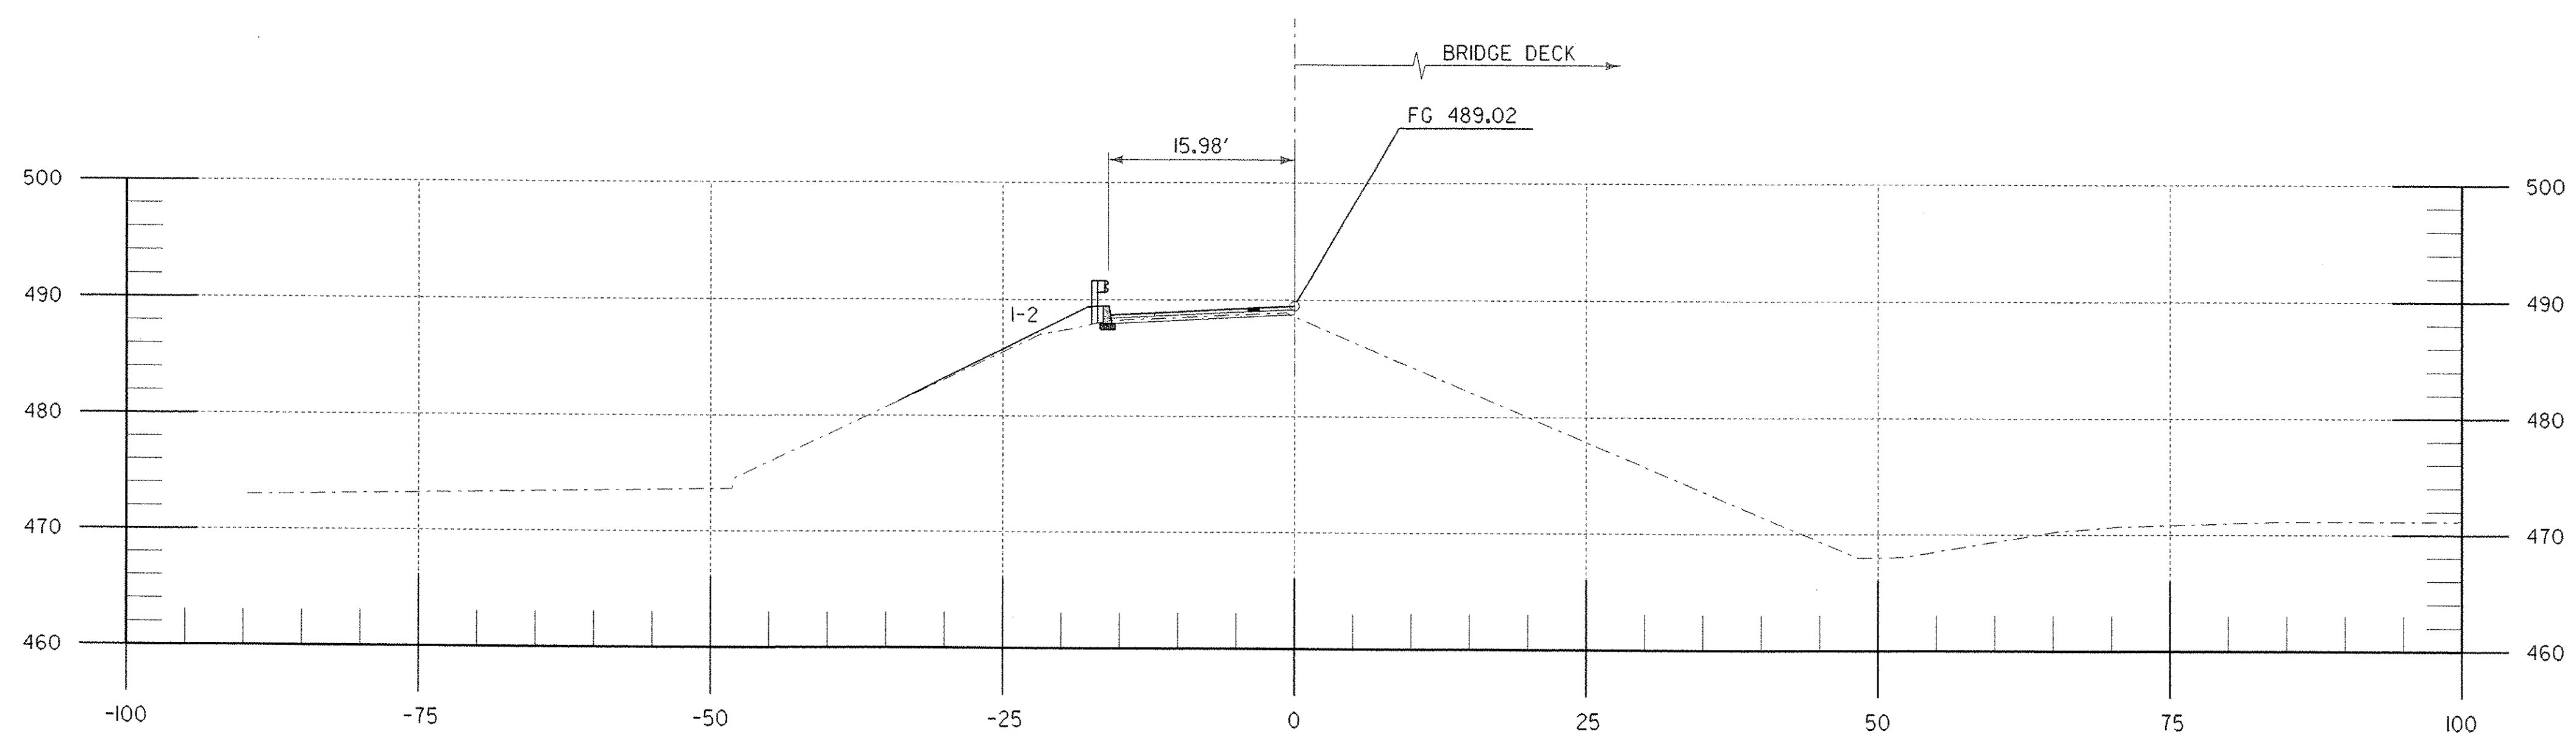

422+95

SCALE 1" = 10'-0"

**STATE OF VERMONT  
AGENCY OF TRANSPORTATION**

Town Of HARTLAND	Bridge No. 38
Highway No. 1-91	Log Sta.
Surv. Sta.	
US 5 CROSS SECTIONS	
STA 422+95 TO 426+70	
Designed By J. BARRACK	Drawn By N. HERRERA
Checked By J. BARRACK	Date DEC 2000
Bridge Design Supervisor E. JOHNSTON	Date FEB. 2001
PROJECT HARTLAND	PROJECT NO. IM 091-1(36)
Drawing Name za272xs2.dgn	
Bridge Sheet No.	Sheet 43 of 85

STONE & WEBSTER, INC.

10-DEC-2002

v:\civil\working\za272xs2.dgn