




103+95.00
 CENTERLINE BEARING - SPAN 1 - ABUTMENT #2
 ASKEW 40°-00'-00''

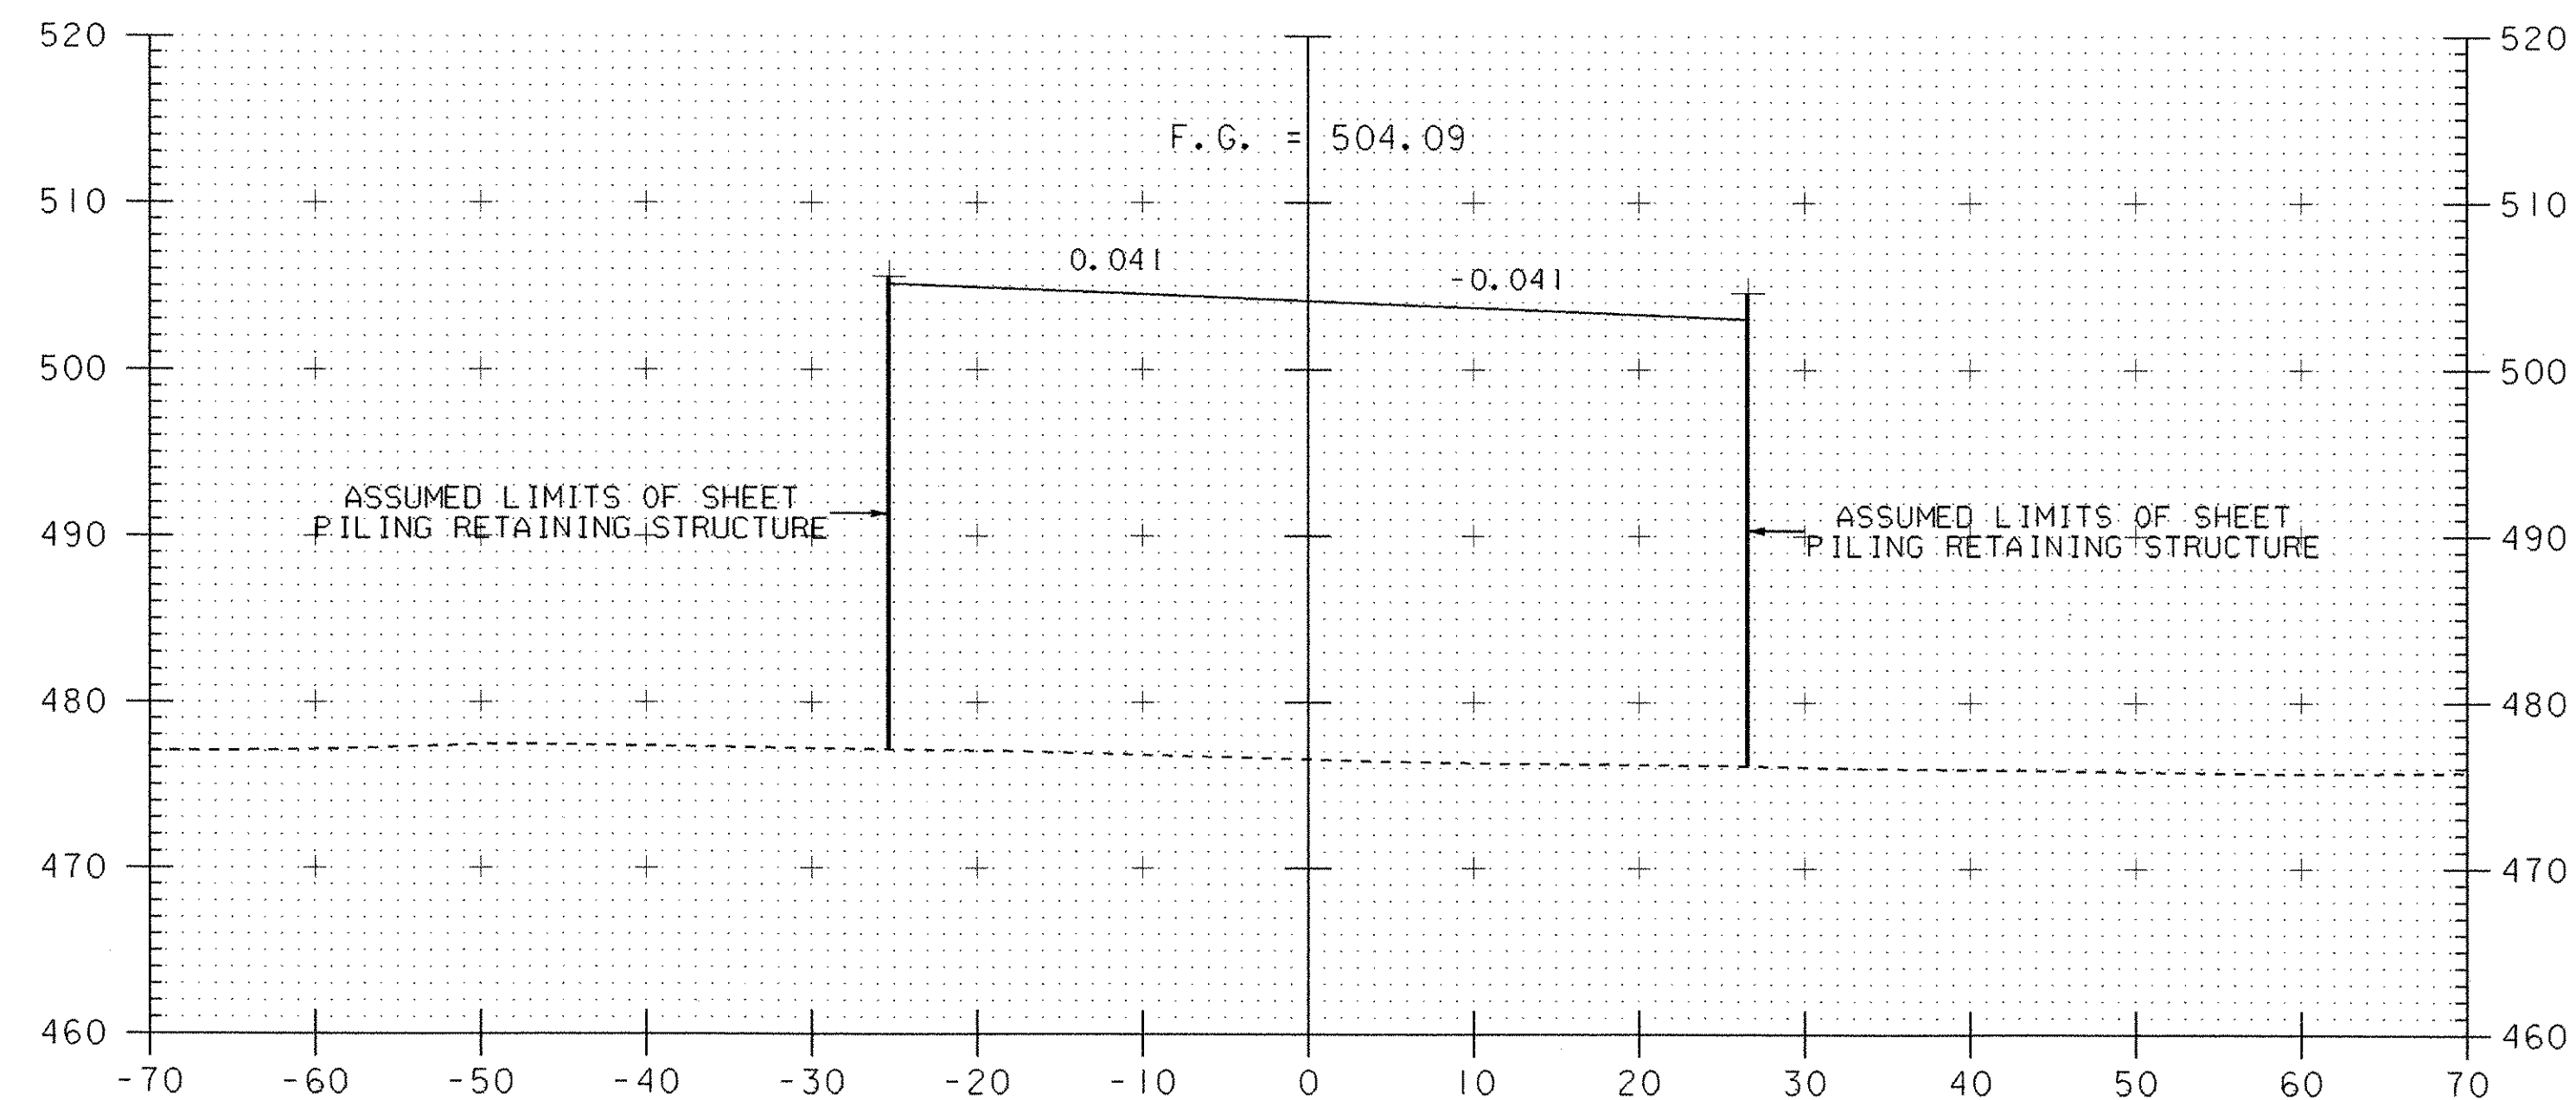

105+42.00
 CENTERLINE BEARING - SPAN 2 - ABUTMENT #4
 ASKEW 40°-00'-00''

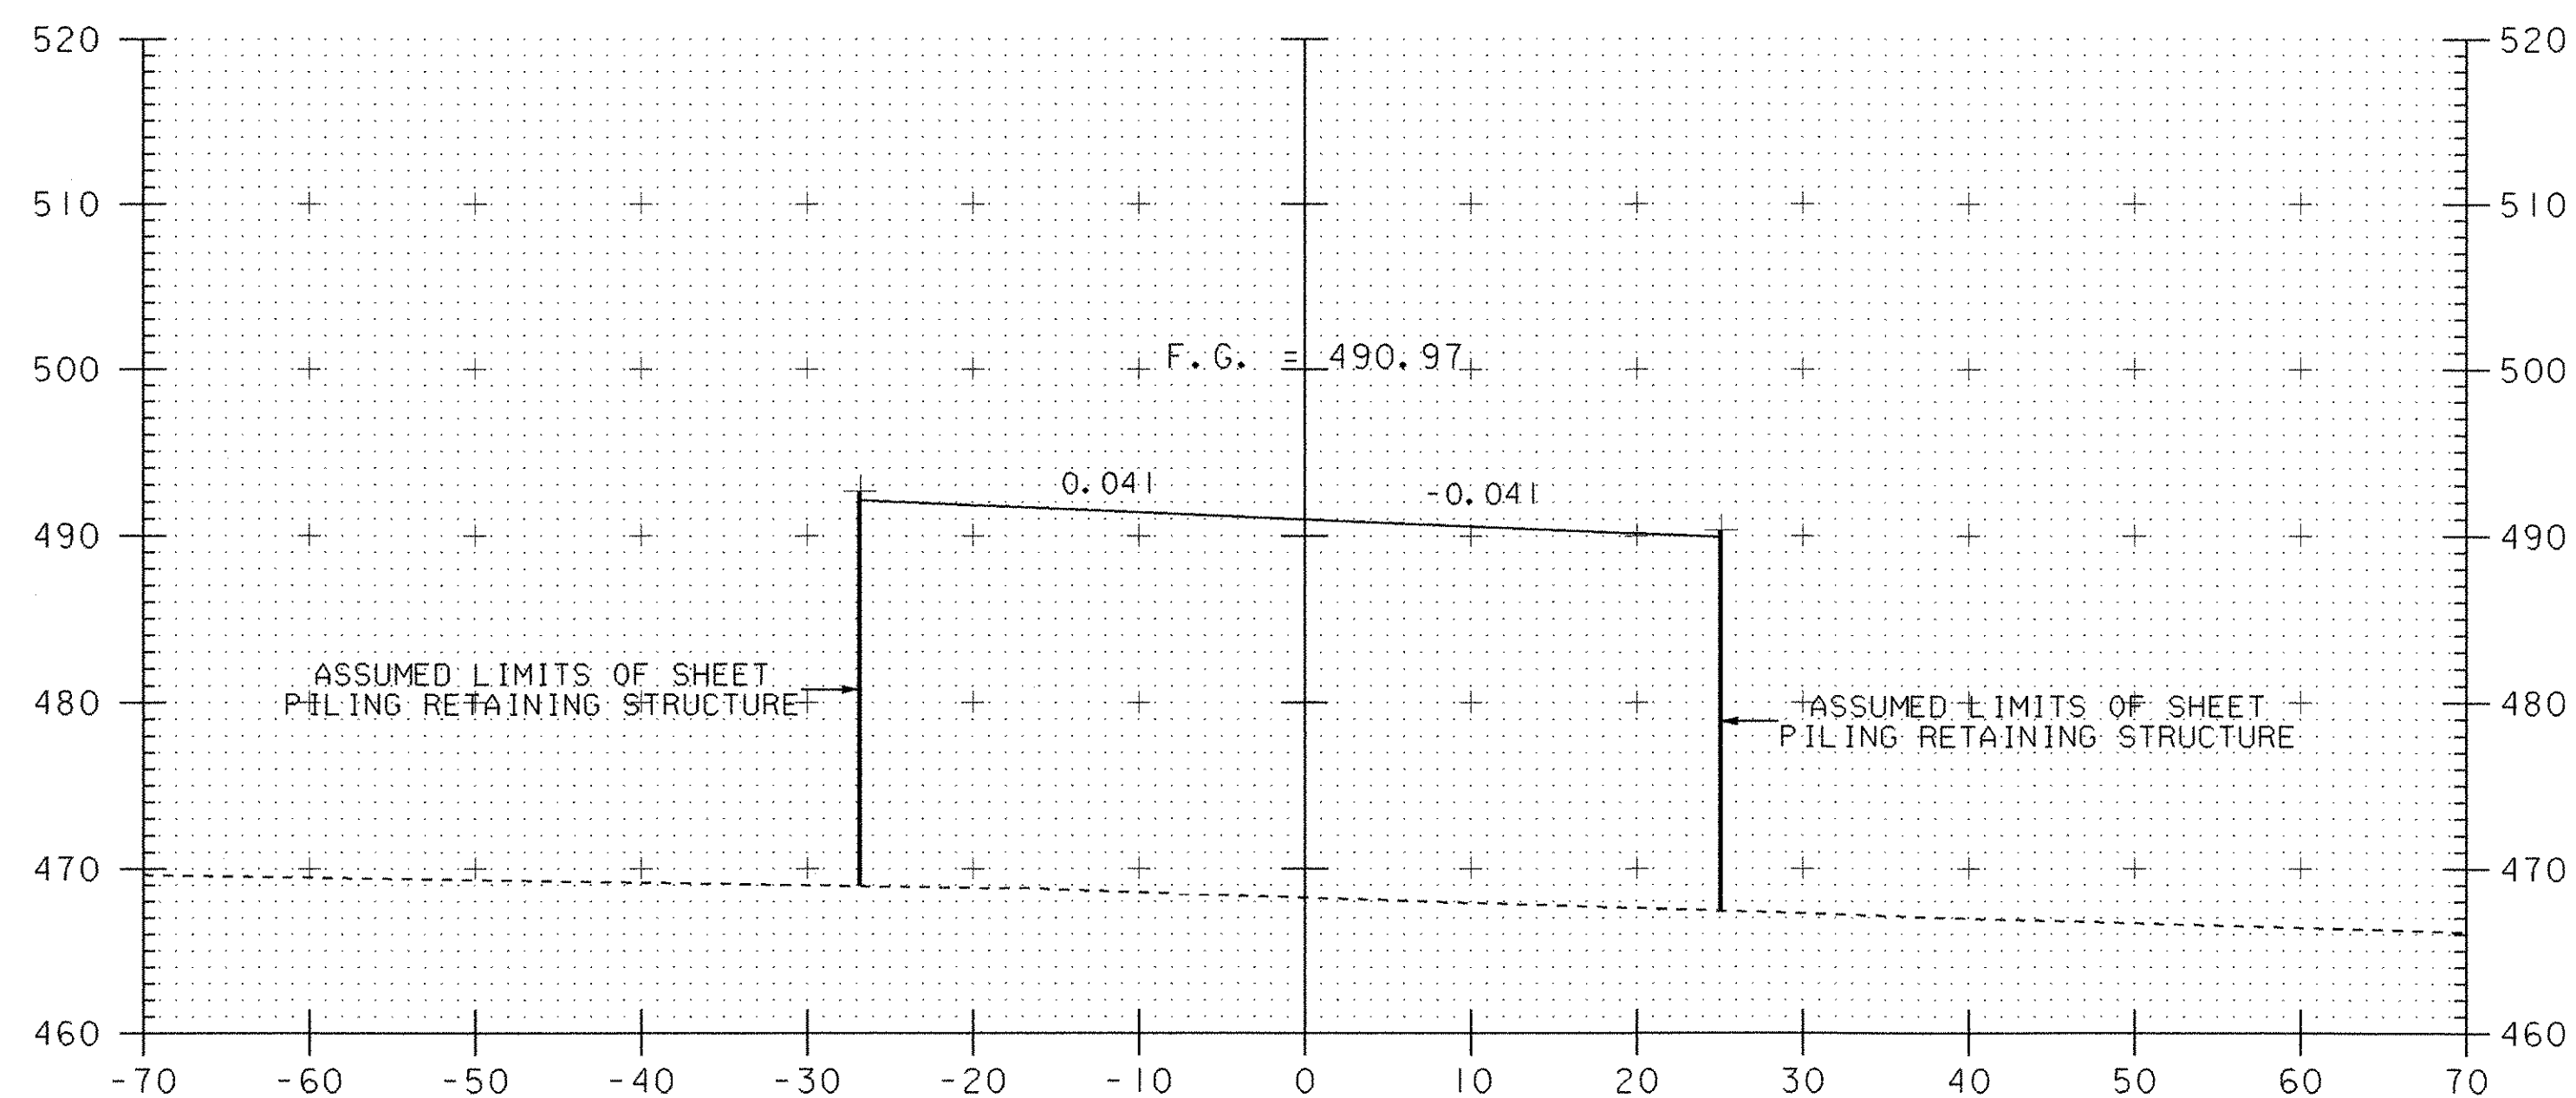

102+98.00
 CENTERLINE BEARING - SPAN 1 - ABUTMENT #1
 ASKEW 40°-00'-00''
 STA 103+14 LT - BEGIN W.W. 2

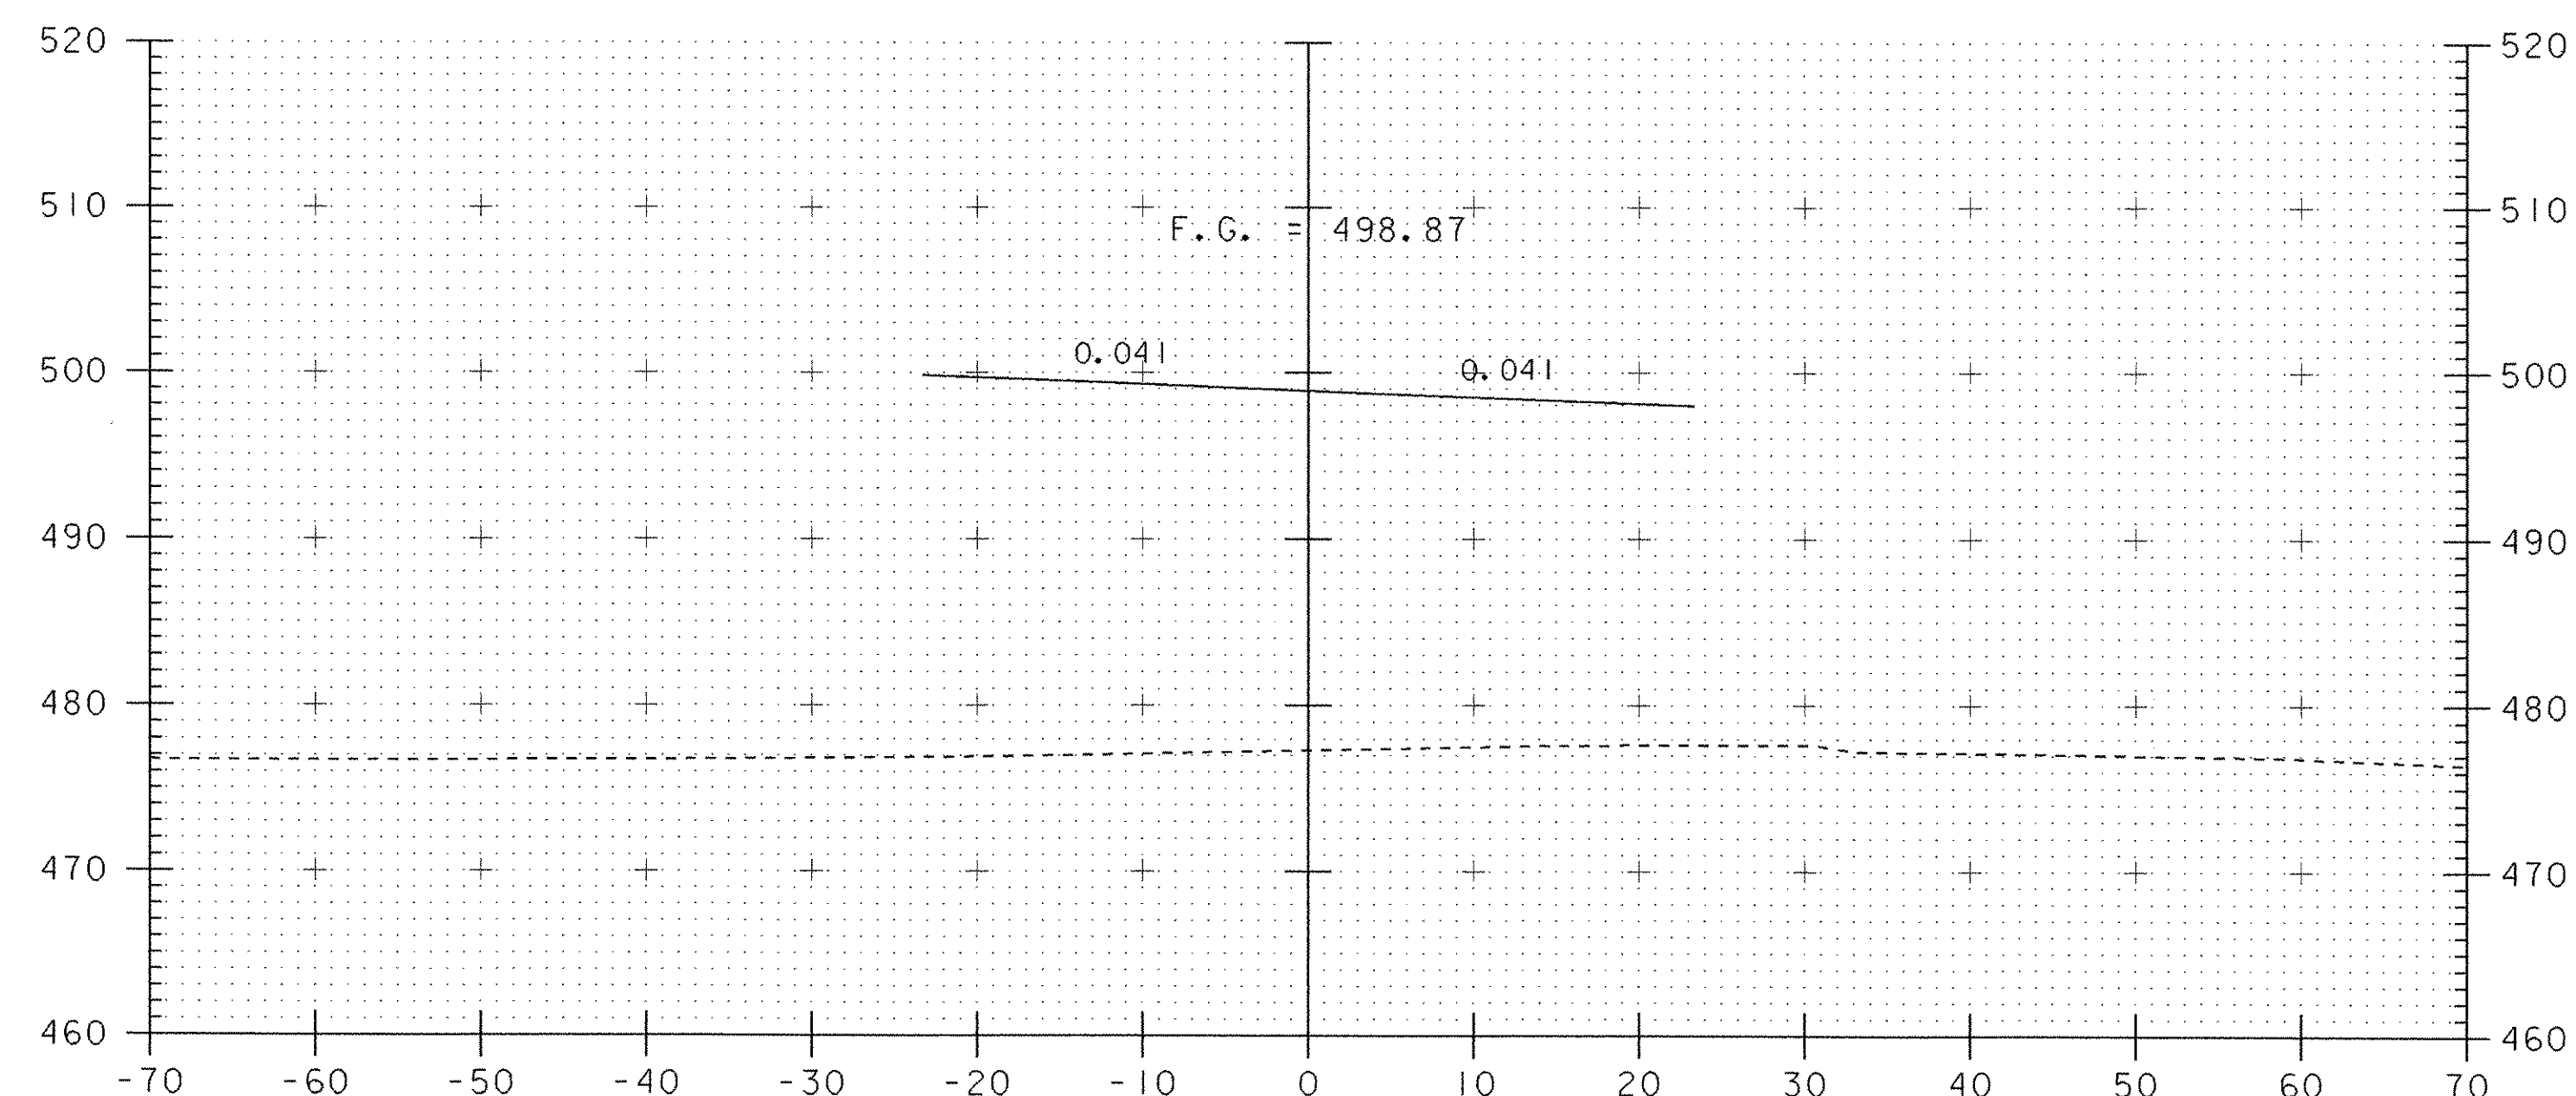

104+45.00
 CENTERLINE BEARING - SPAN 2 - ABUTMENT #3
 ASKEW 40°-00'-00''

**TEMPORARY DETOUR CROSS SECTIONS
 STATION 102+98 TO 105+42**

PROJECT NAME:	HARTLAND	PLOT DATE:	24-DEC-2002
PROJECT NUMBER:	IM 091-(36)	DRAWN BY:	K. UPMAL
FILE NAME:	str7/99a272/sa272xs.dgn	DESIGNED BY:	FOWLER / UPMAL
PROJECT LEADER:	S. FARNSWORTH	CHECKED BY:	
sa272x3.j		SHEET	44C OF 85

