




106+75
STA 106+75 LT - END W.W. 4

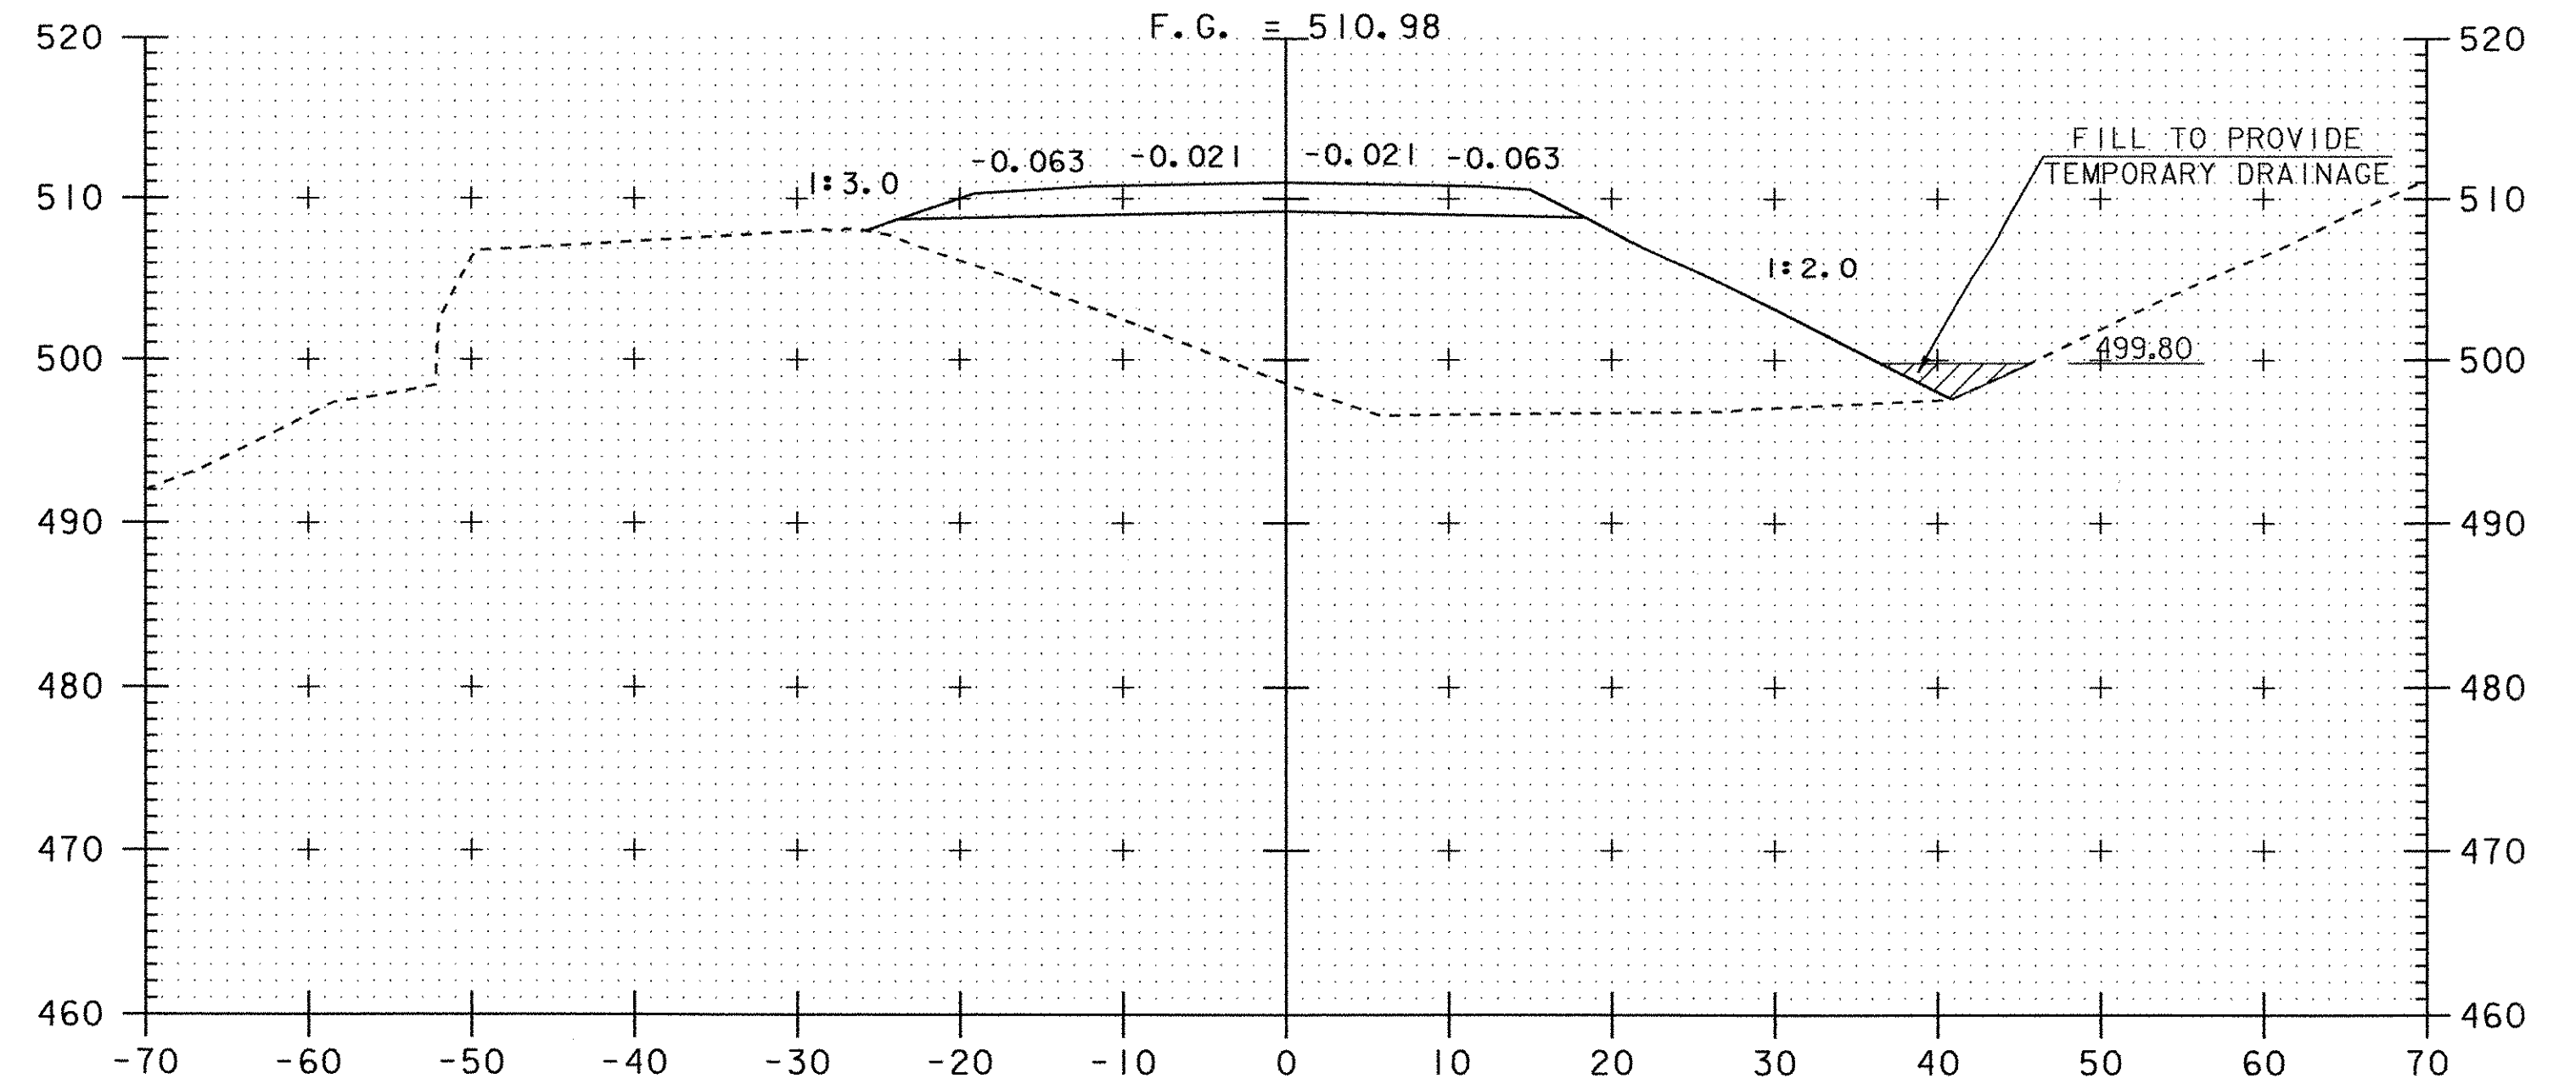

107+25

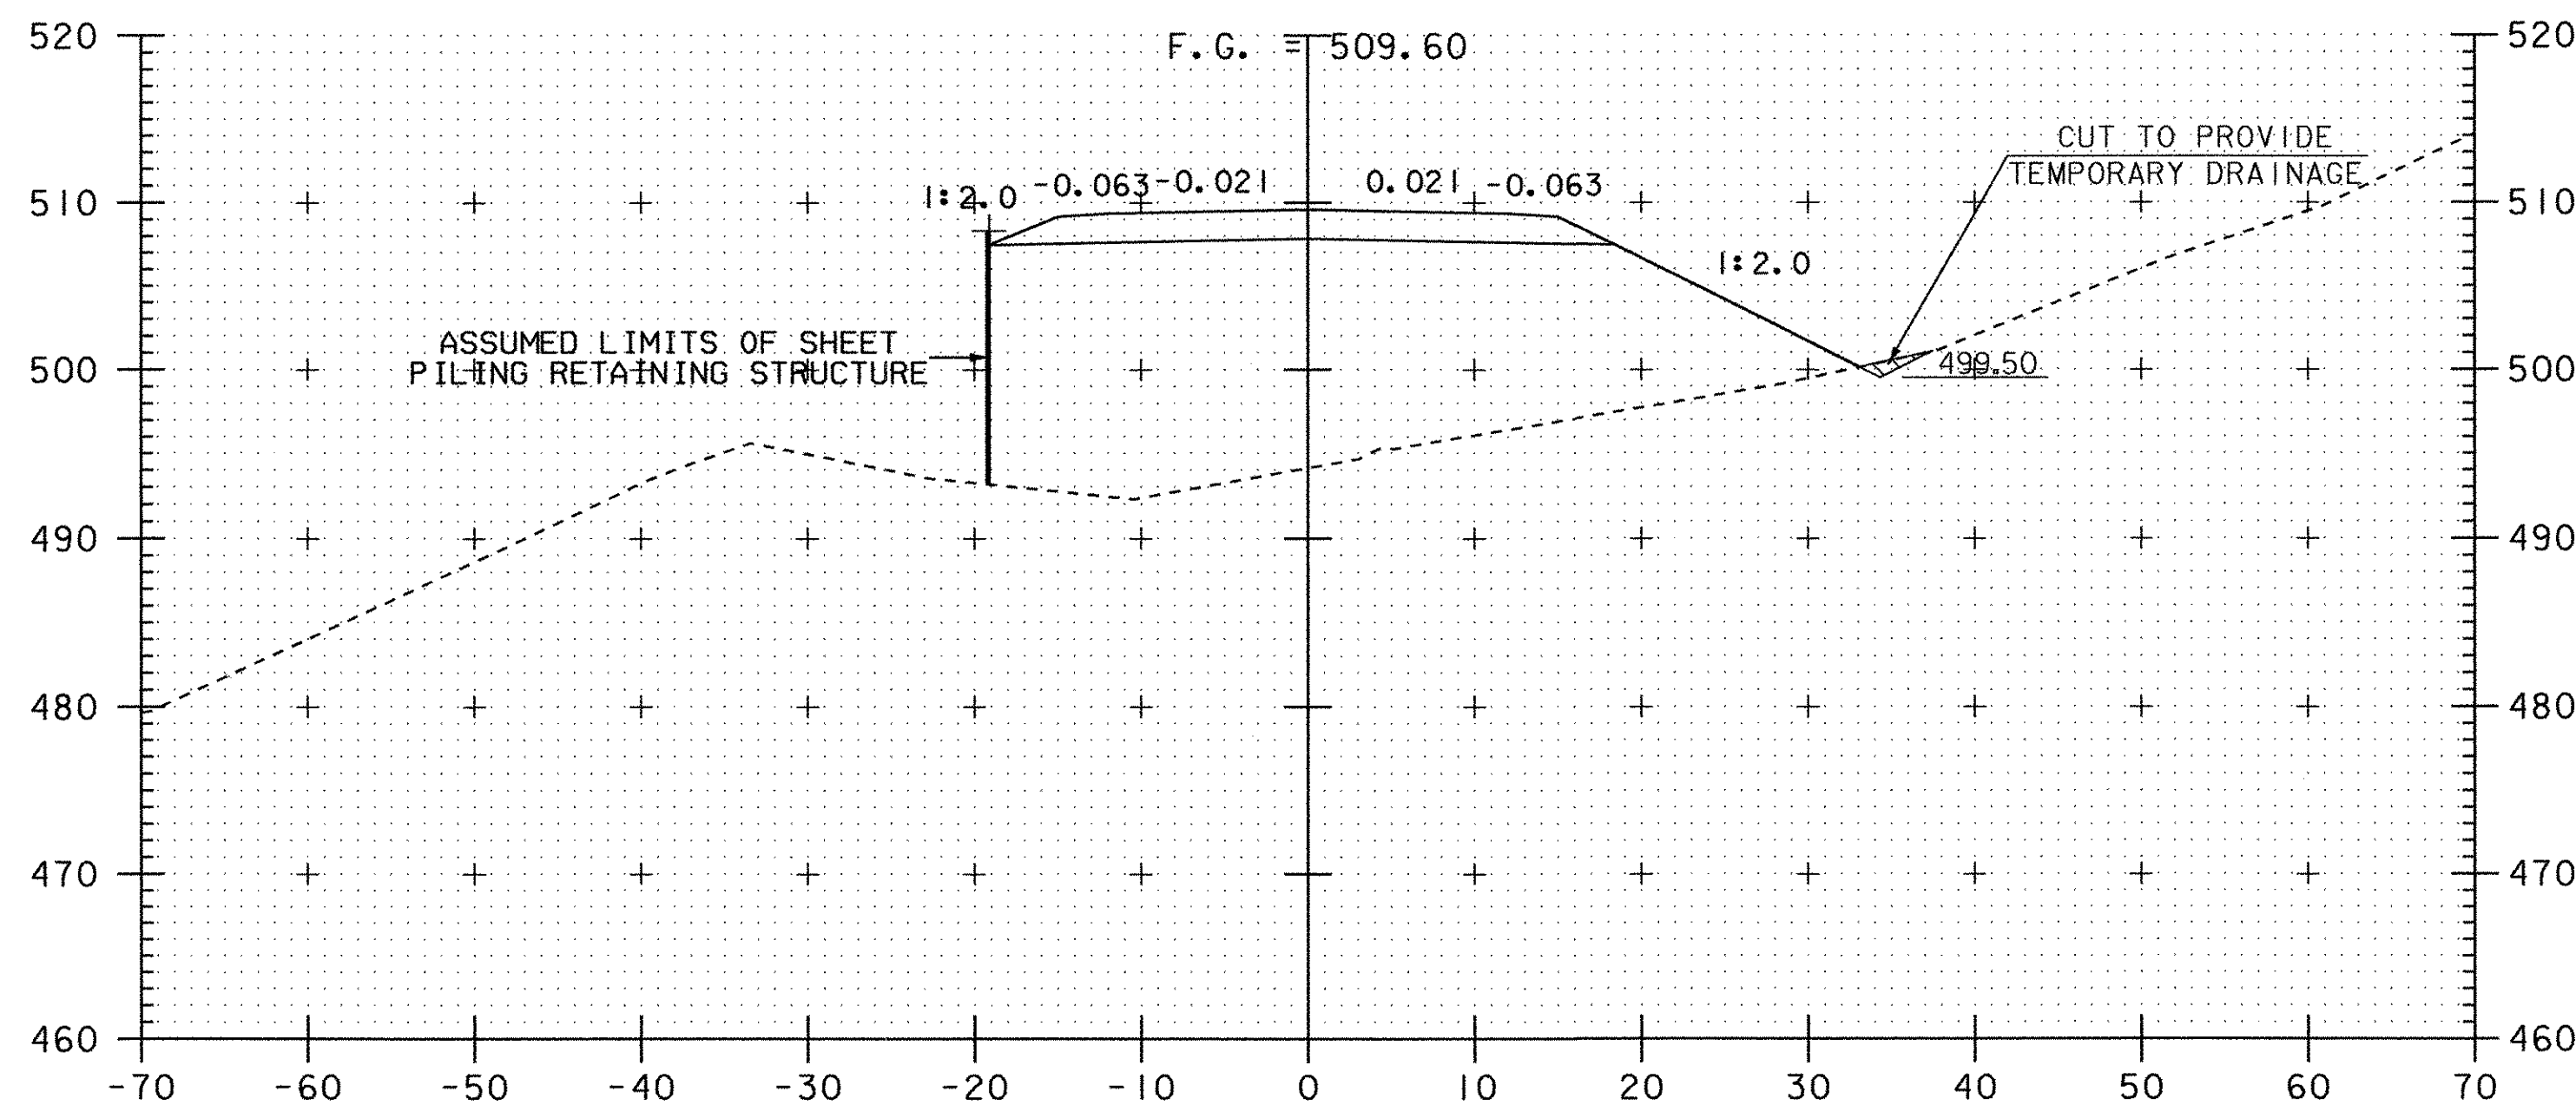

106+50

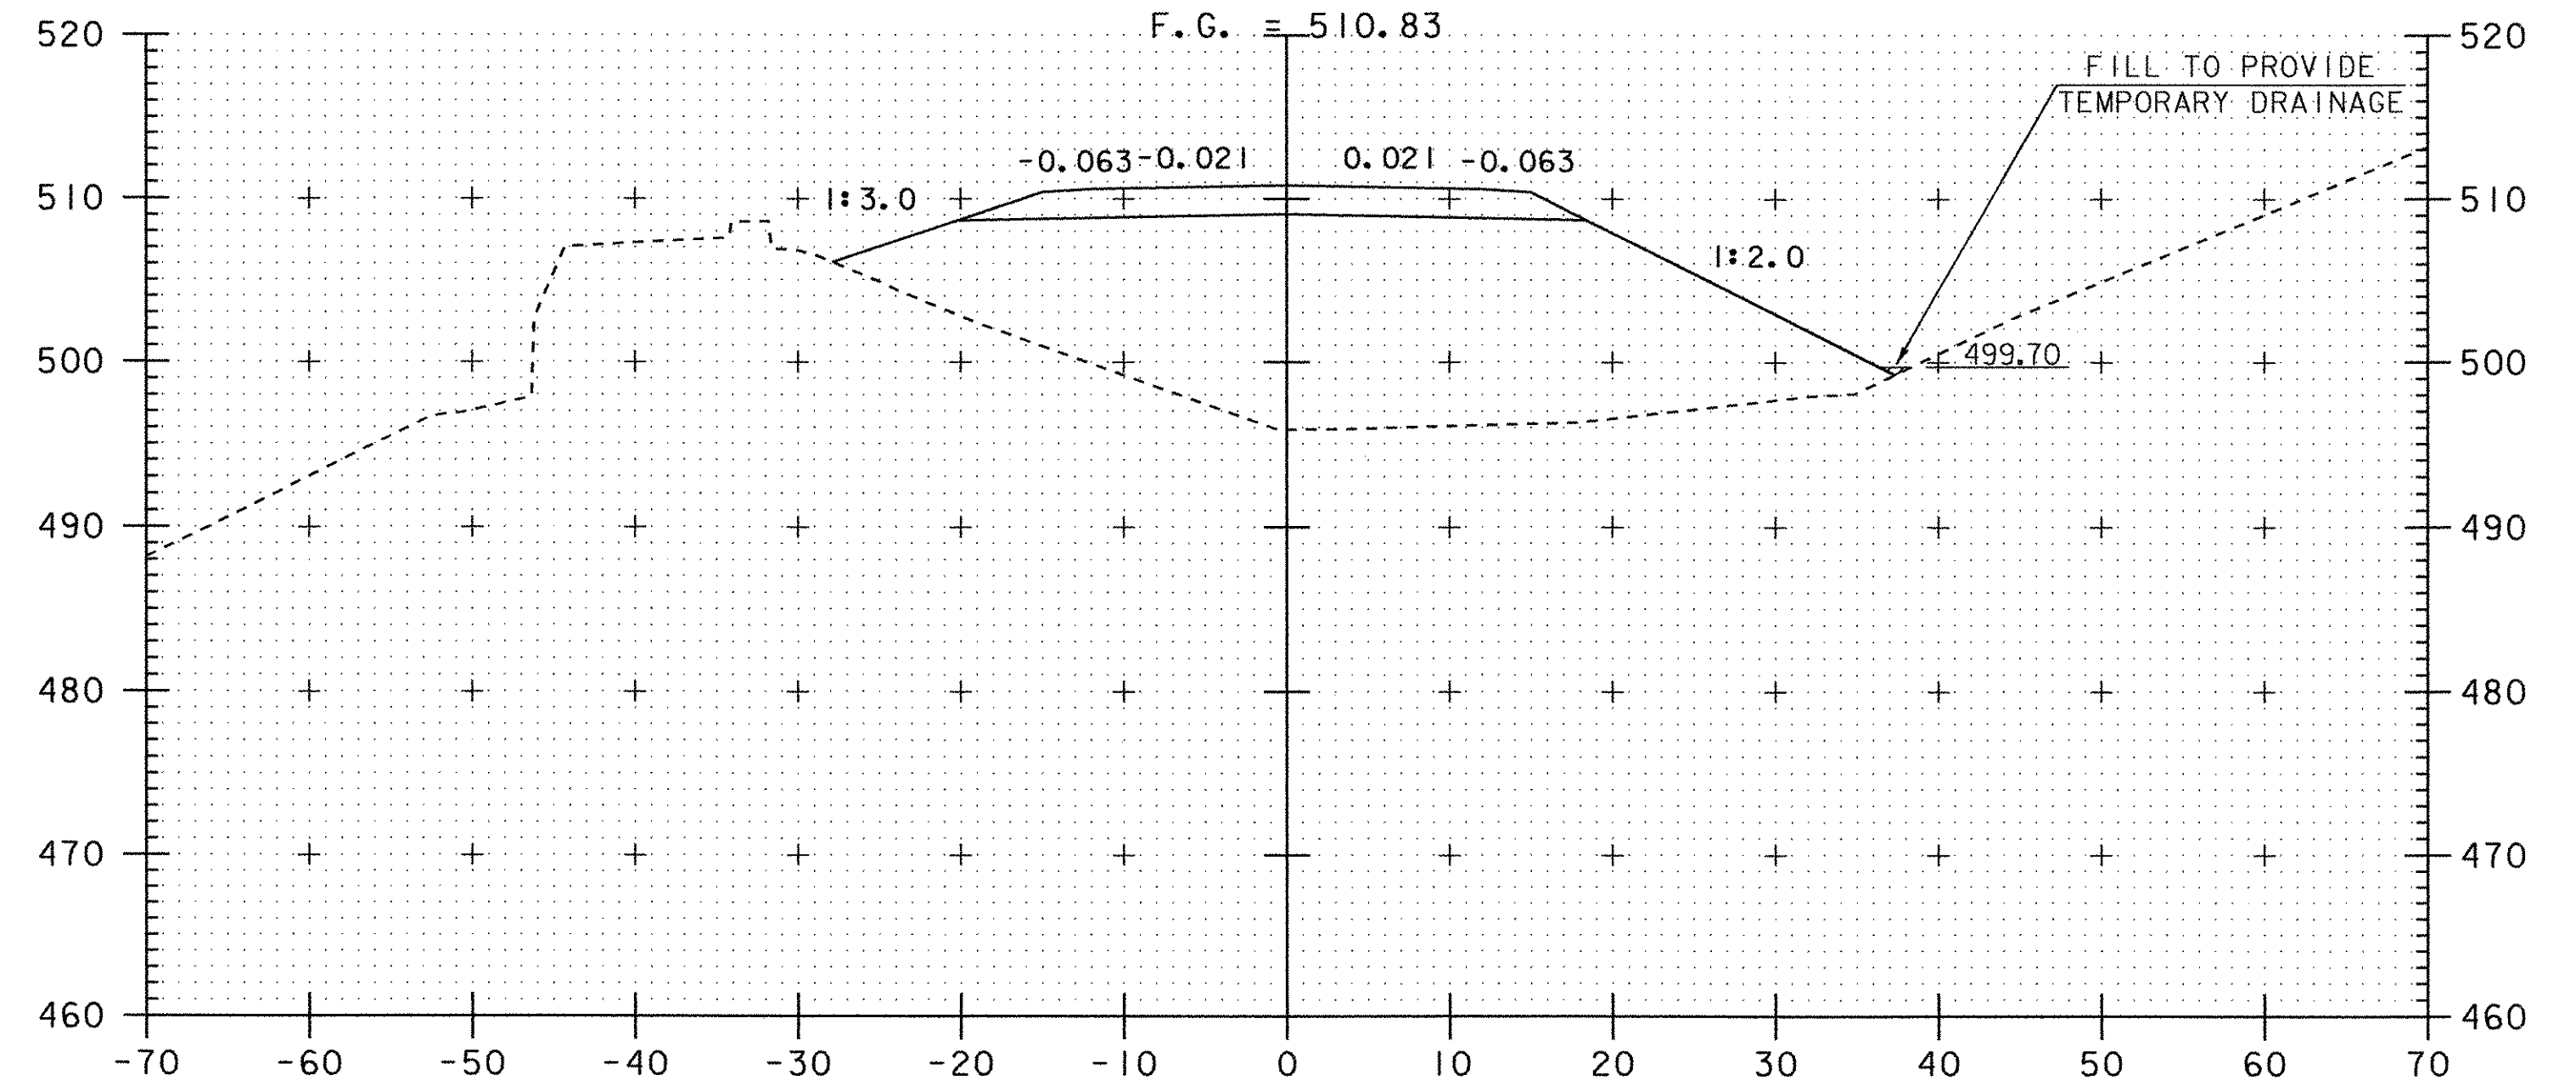

107+00

**TEMPORARY DETOUR CROSS SECTIONS
STATION 106+50 TO 107+25**

PROJECT NAME:	HARTLAND	PLOT DATE:	03-FEB-2003
PROJECT NUMBER:	IM 091-1(36)	DRAWN BY:	K. UPMAL
FILE NAME:	str7/99a272/sa272xs.dgn	DESIGNED BY:	FOWLER / UPMAL
PROJECT LEADER:	S. FARNSWORTH	CHECKED BY:	
DESIGNED BY:	FOWLER / UPMAL	SHEET	44E OF 85
sa272xs.J			

