

Bituminous Concrete Curb
S.B. 3372+80 - 3375+50 Lt.

SUB-BASE of SAND, ITEM 202

3367+00 - 3372+50 SB
3368+00 - 3373+00 NB

* STEEL GUIDE POSTS, ITEM 548-B
3361+00 - 3383+00 SB Lt.

* STAGE TWO CONSTRUCTION

* STANDARD STEEL BEAM GUARD
RAIL w/ STEEL POSTS, ITEM 547-A

3367+00 - 3367+780 SB Lt. 545-A
3368+26 - 3368+93 NB Lt.
3367+45 - 3368+1765 SB Lt.
3367+00 - 3369+29 NB Lt.

* THREE CABLE GUARD RAIL
w/ STEEL POSTS, ITEM 543-542

3372+00 - 3377+42 NB Lt.
3379+50 - 3380+94 NB Lt.
3368+20 - 3368+00 NB Lt.
3372+50 - 3375+80 SB Lt.
3374+22 - 3377+42 N.B. Lt.
3380+53 - 3383+00 N.B. Lt.
3381+85 - 3383+00 S.B. Lt.

DEMOLITION & REMOVAL of BUILDING
ITEM 506

3370+85 - 3372+50 Lt - Rt SB (7 buildings) Sold
3370+25 & NB
3371+00 & NB Sold
3371+50 Rt NB Sold

* TREATED TIMBER CURB, ITEM 558
3372+50 - 3375+50 SB Lt.

STONE FILL for SLOPE PROTECTION
ITEM 522-512

3368+00 NB Lt.
3374+00 - 3376+200 NB Lt.
3381+82 SB Lt. - 3382+00 NB Lt.
3382+00 NB Lt. - 3383+50 NB Lt.
3374+00 - 3375+60 SB Lt.
3380+10 - 3382+00 NB Lt.



JUTE MATTING, ITEM 623
3375+60 - 3376+65 SB Lt.

Bituminous Concrete Surface for Batters
Item 554
3367+75 SB Rt.
3370+75 - 3371+00 Med.
3374+00 - 3374+50 Med.

THIS SHEET FOR REFERENCE ONLY
HARTLAND IM 091-1(36)
I-91 BRIDGE 38

SHEET 68 OF 85

PLAN CHECKED BY: [Signature]
DESIGNED BY: [Signature]
DATE: [Date]

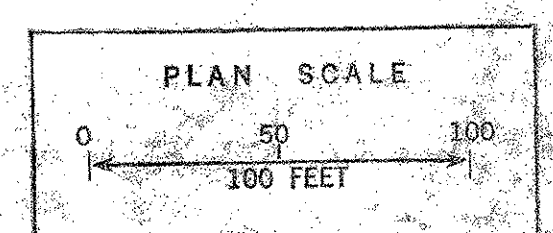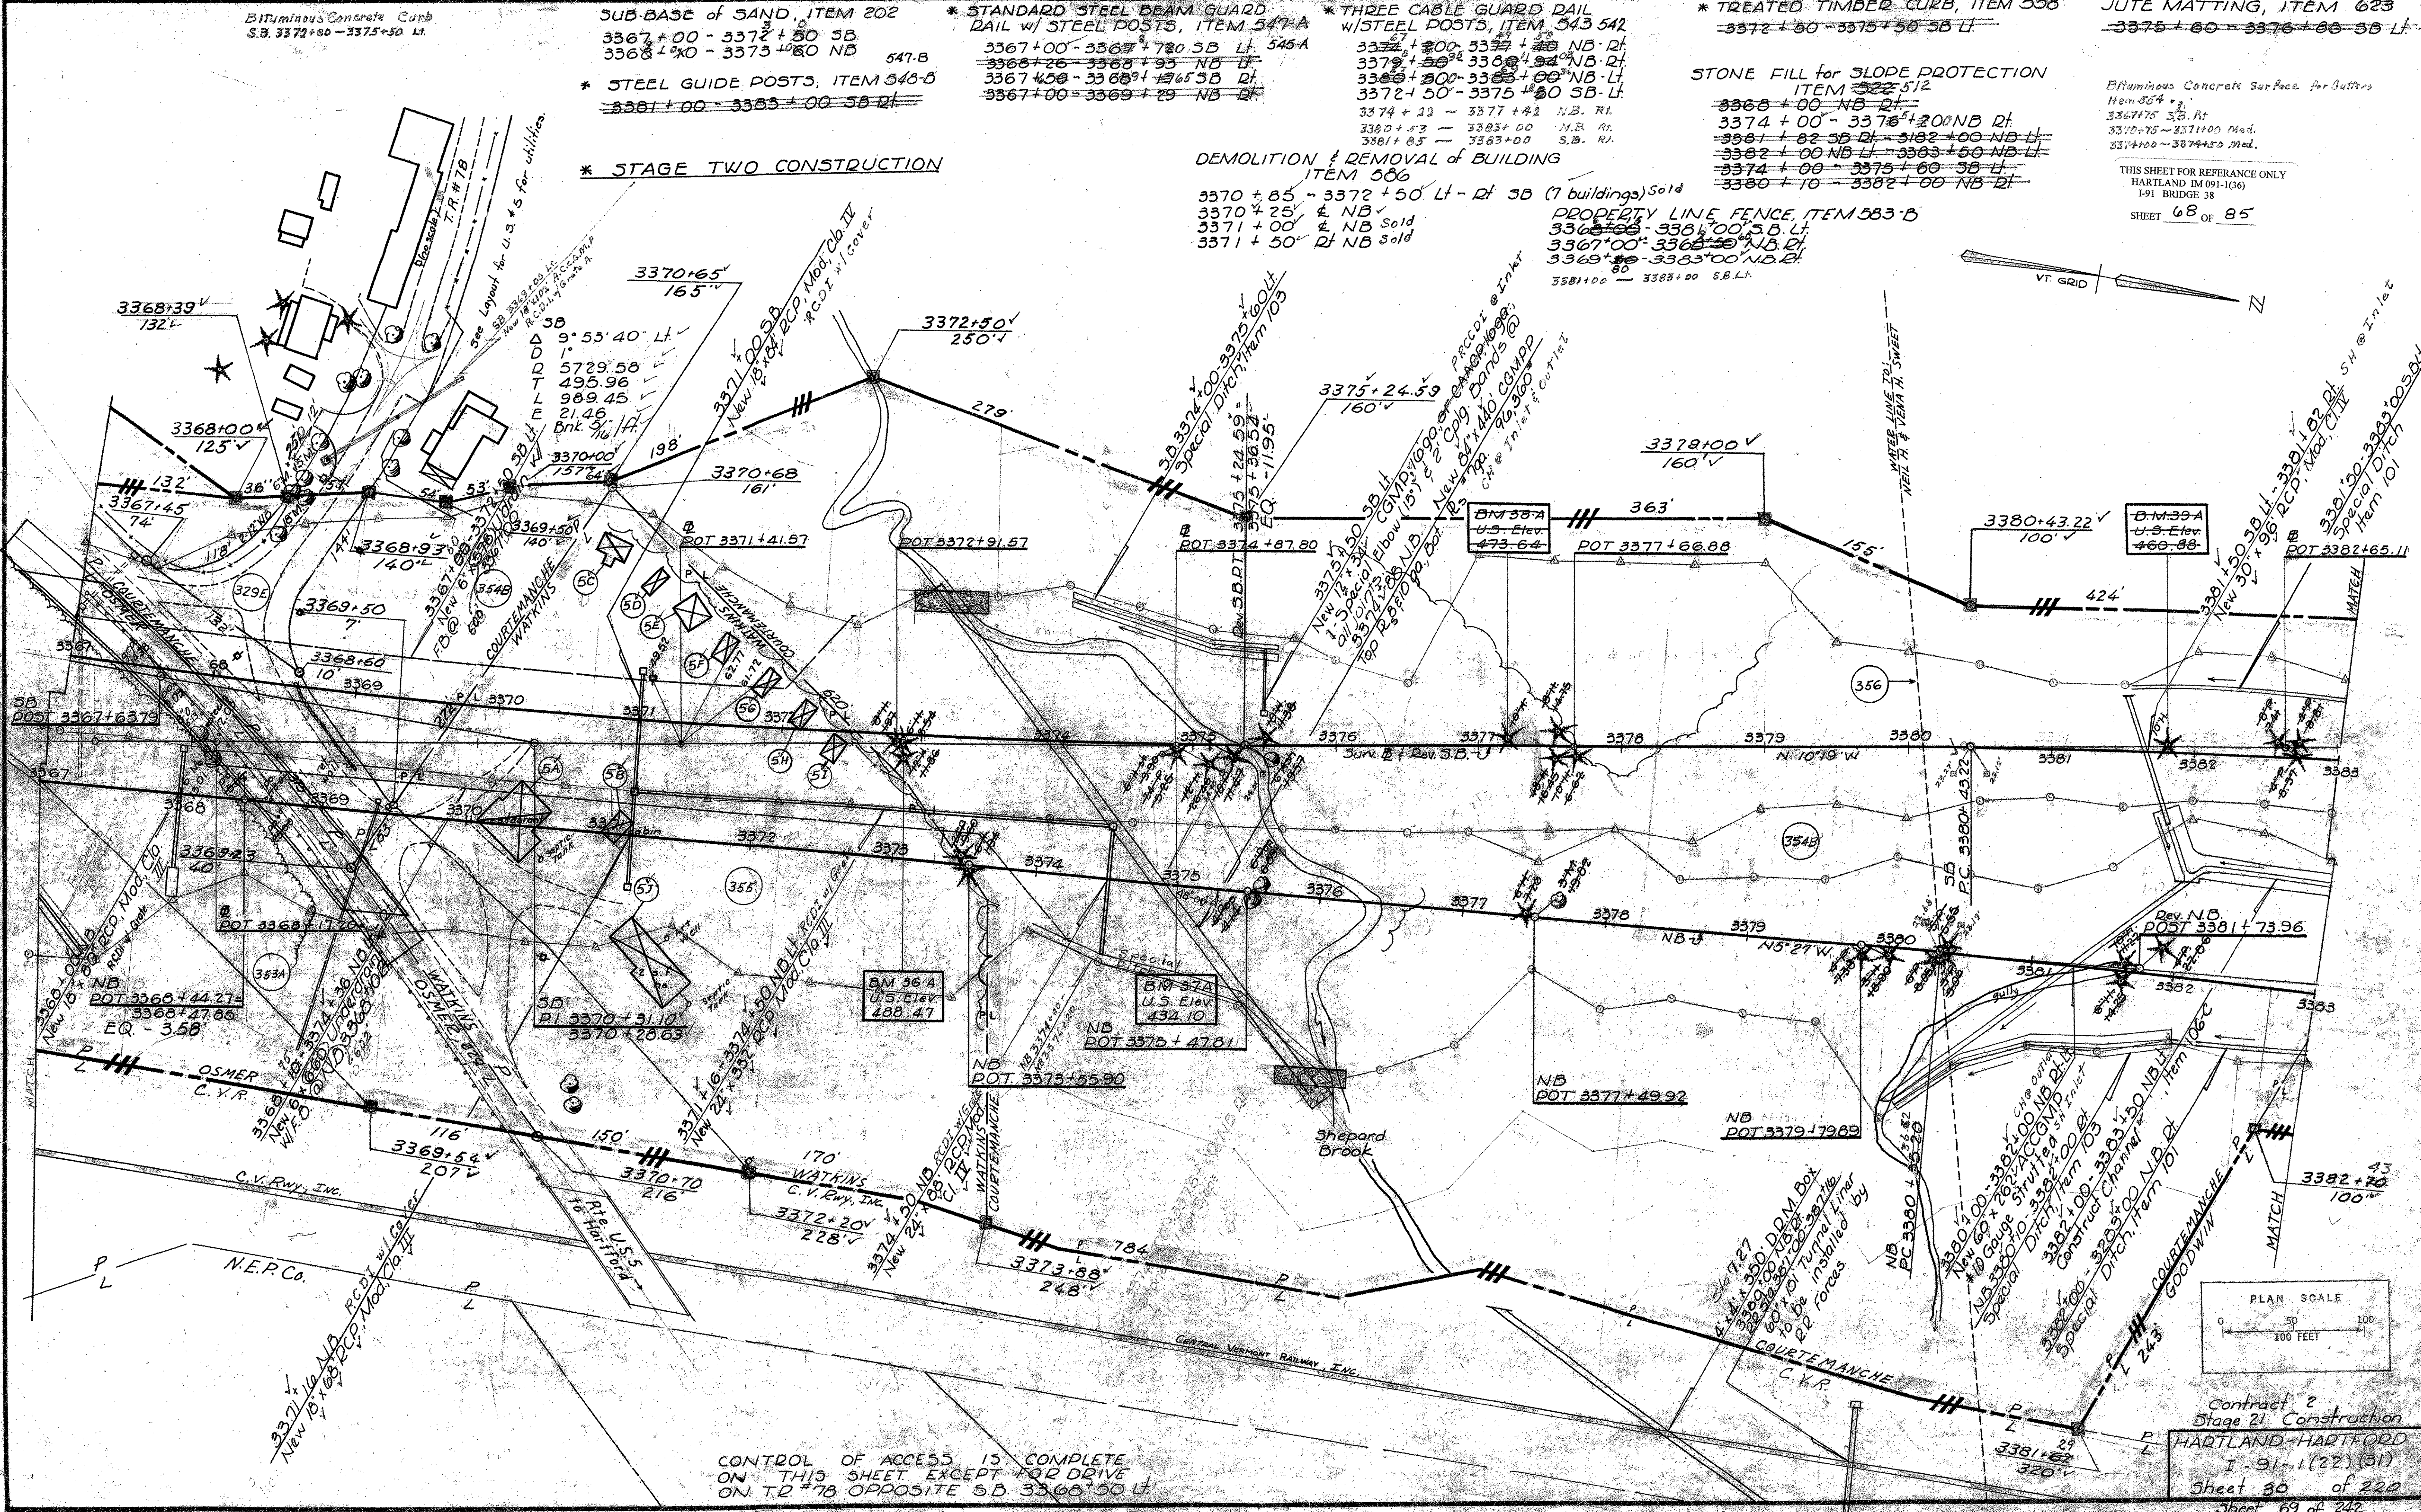

CONTROL OF ACCESS IS COMPLETE
ON THIS SHEET EXCEPT FOR DRIVE
ON T.R. 78 OPPOSITE S.B. 3368+50 Lt.

Contract 2
Stage 21 Construction
HARTLAND-HARTFORD
I-91-1(22)(31)
Sheet 68 of 220
Sheet 69 of 242