



PLAN
 SURVEYED BY
 PLOTTED BY
 NOTE BOOK NO.
 DATE

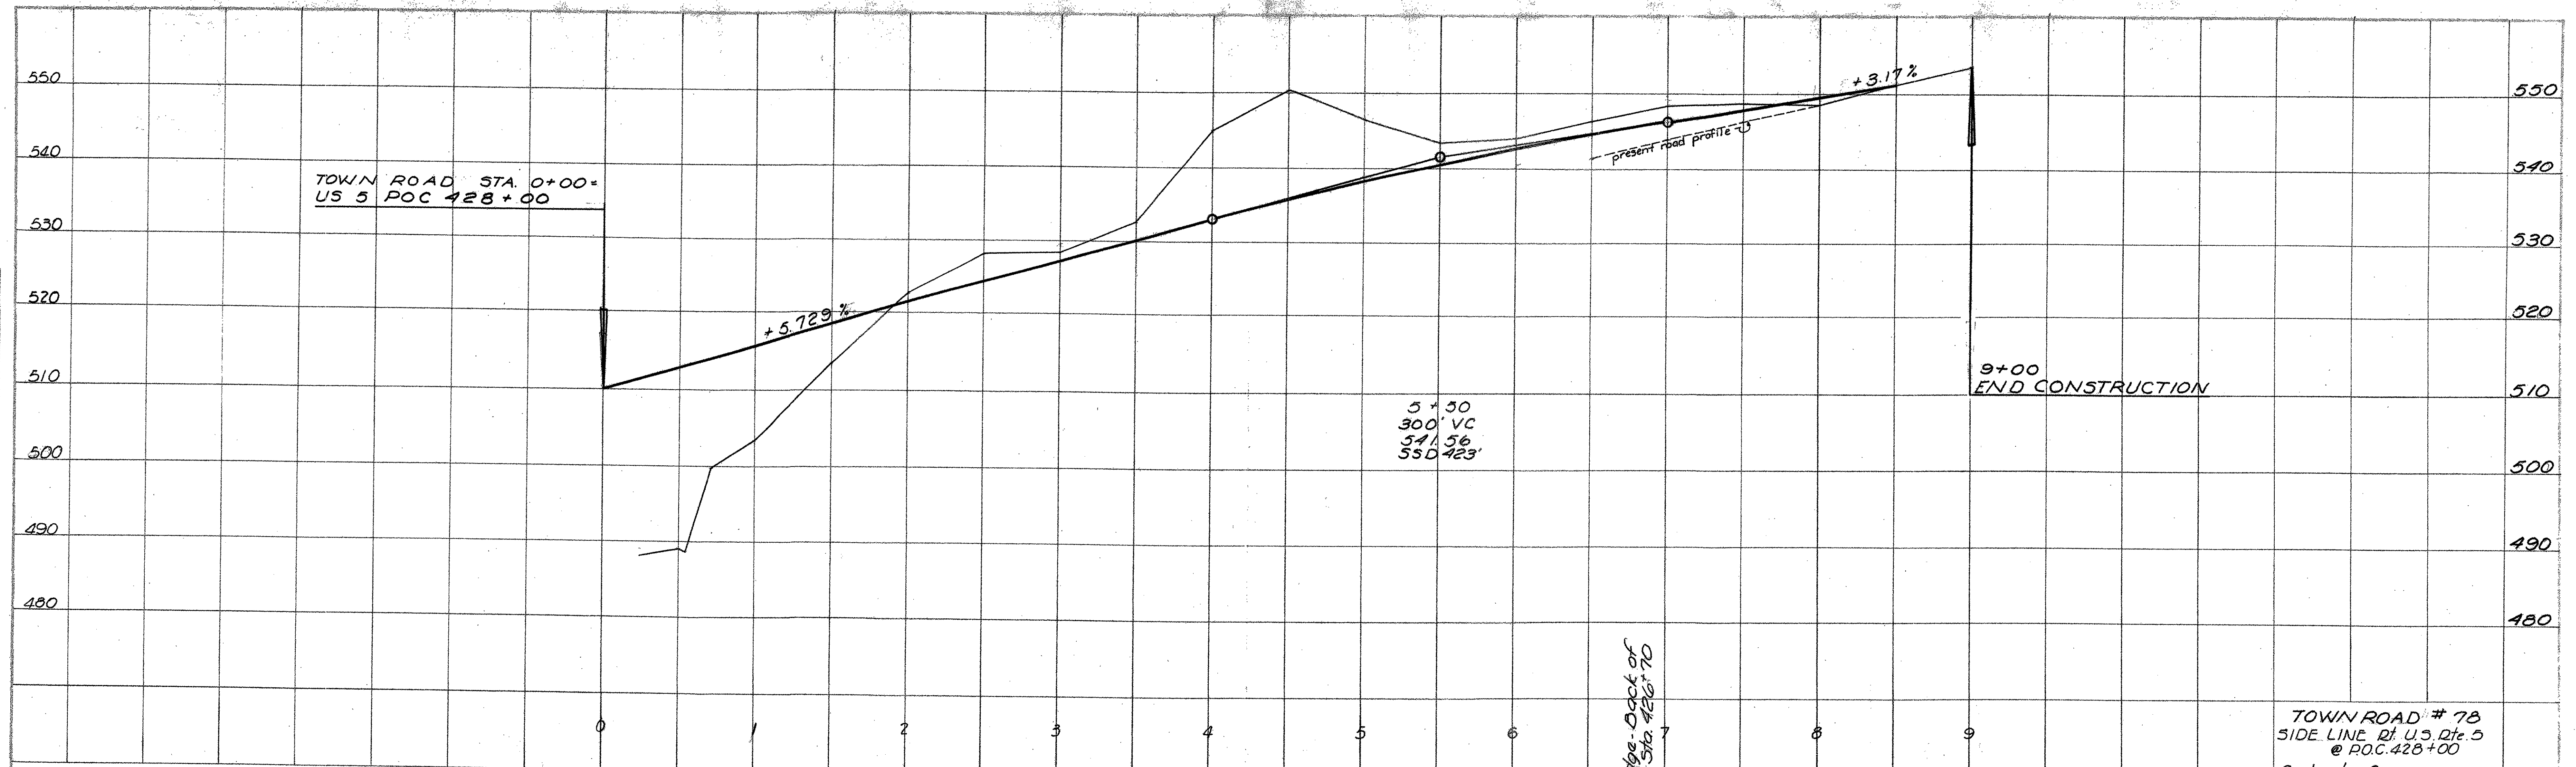

PROFILE
 SURVEYED BY
 PLOTTED BY
 NOTE BOOK NO.
 DATE

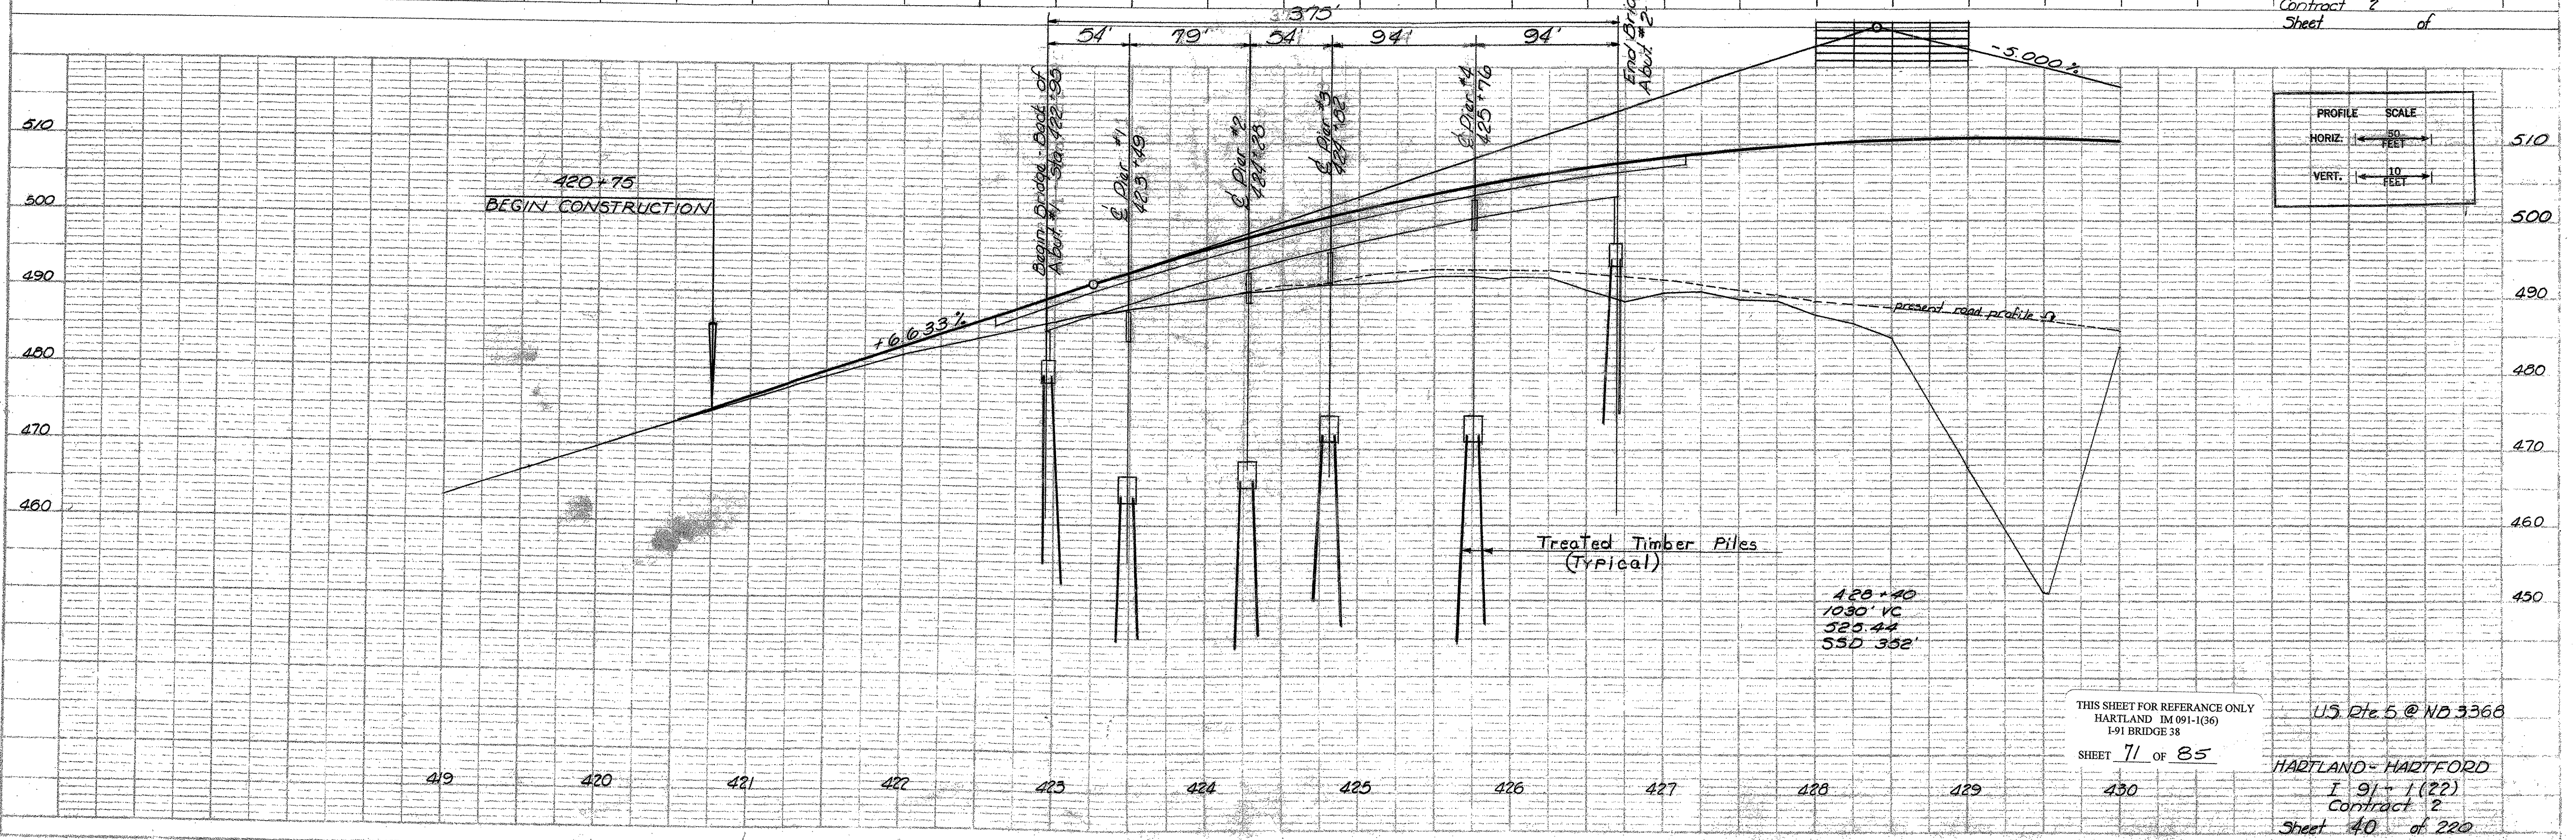

TOWN ROAD # 78
 SIDE LINE Rt. U.S. Dte. 5
 @ P.O.C. 428+00
 Contract 2
 Sheet of

PROFILE SCALE
 HORIZ. 50 FEET
 VERT. 10 FEET

THIS SHEET FOR REFERENCE ONLY
 HARTLAND IM 091-1(36)
 I-91 BRIDGE 38
 SHEET 71 OF 85

US Dte. 5 @ NO. 3366
 HARTLAND - HARTFORD
 I 91 - 1(22)
 Contract 2
 Sheet 40 of 220