
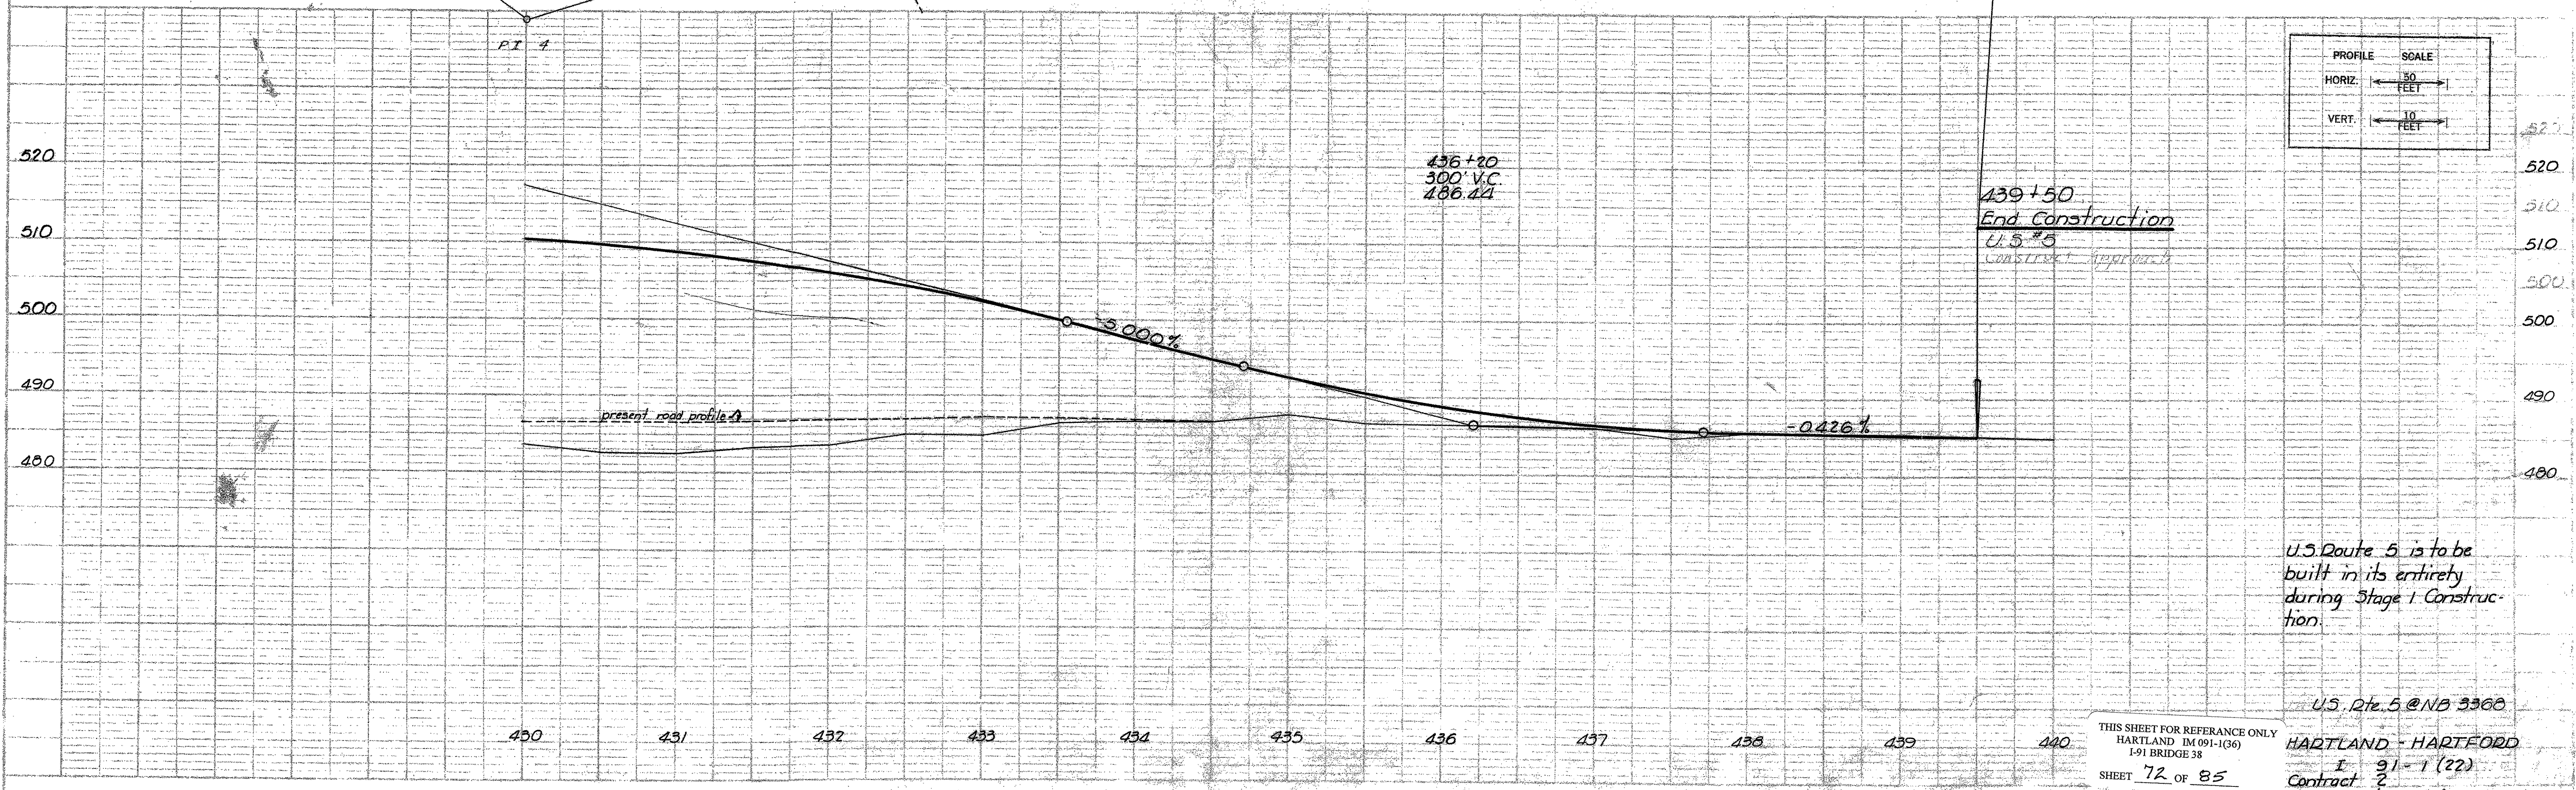


PLAN
 DATE
 NO. OF SHEETS
 NO. OF SHEETS CHECKED
 NO. OF SHEETS NOT CHECKED

PROFILE
 DATE
 NO. OF SHEETS
 NO. OF SHEETS CHECKED
 NO. OF SHEETS NOT CHECKED

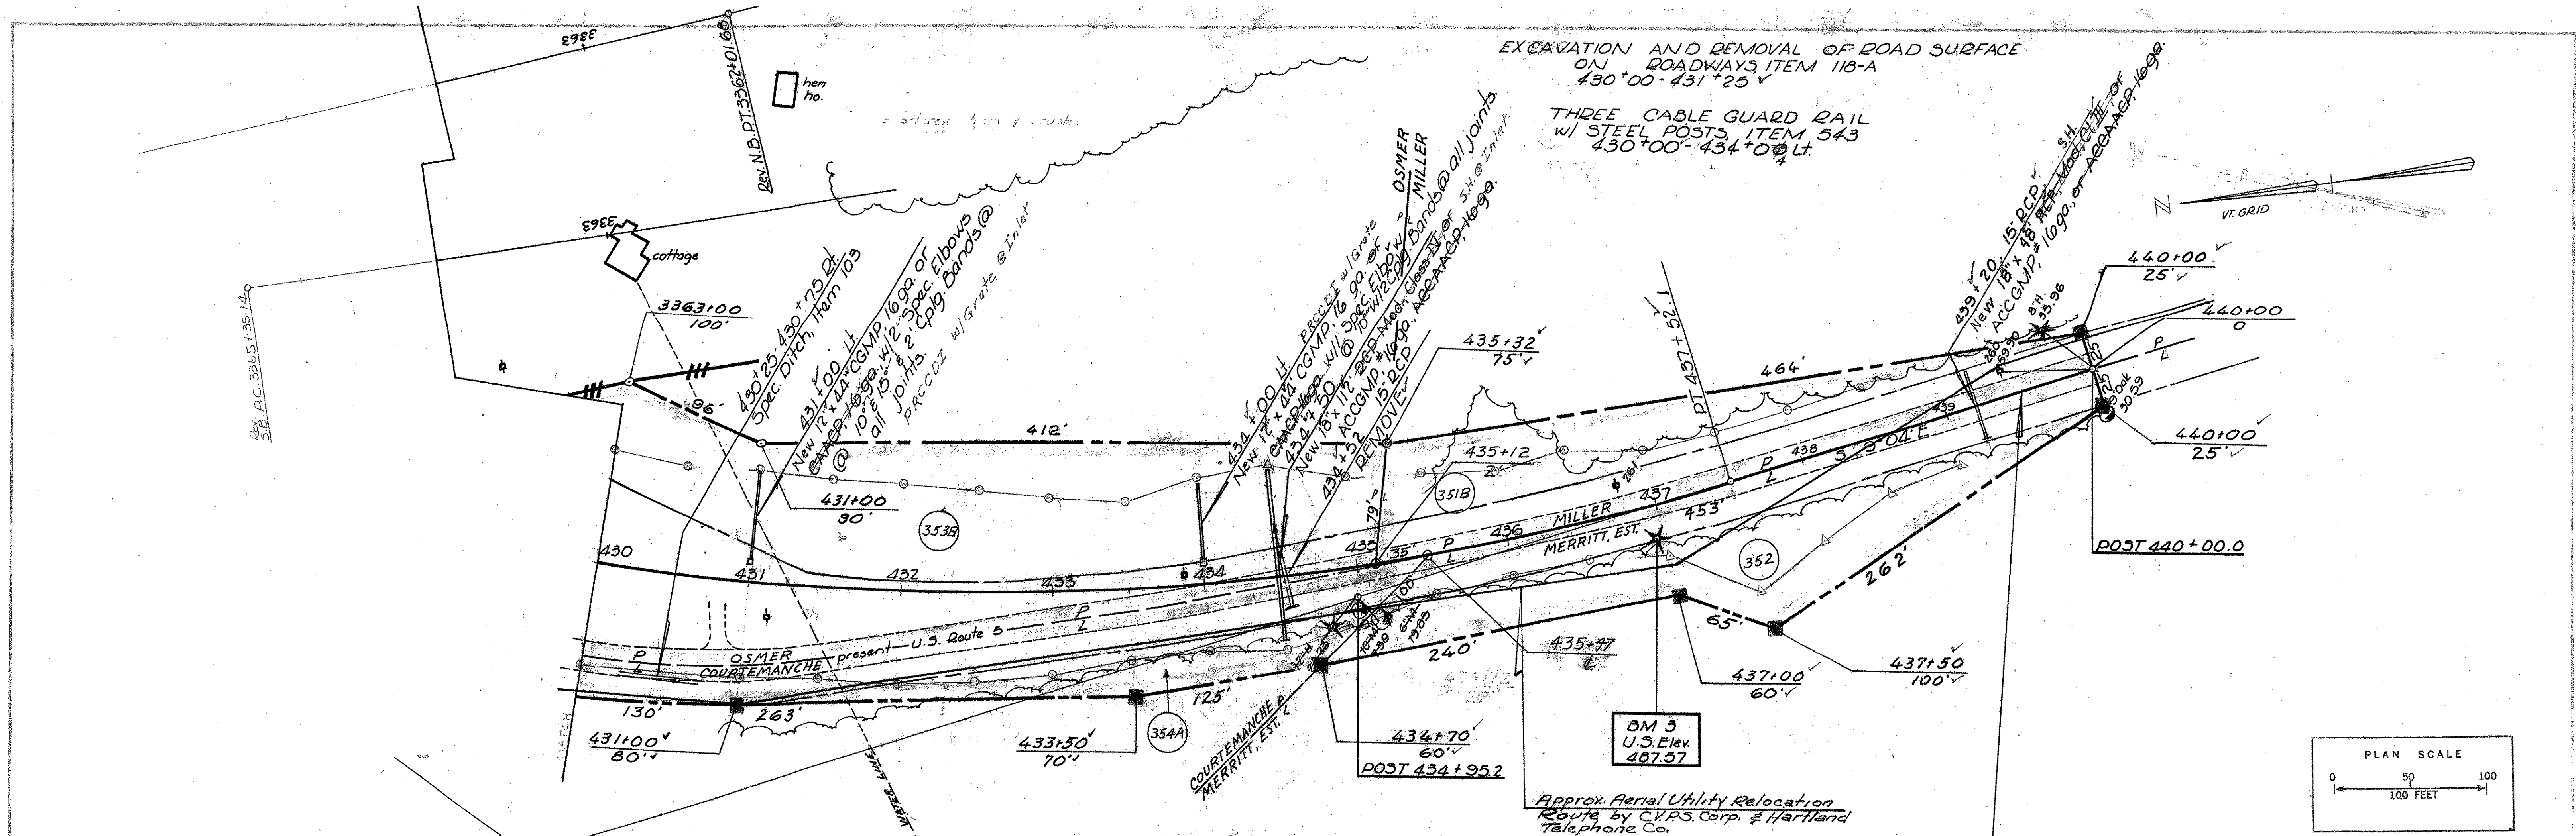

U.S. Route 5 is to be built in its entirety during Stage 1 Construction.

U.S. Rte. 5 @ NB 3360
 THIS SHEET FOR REFERENCE ONLY
 HARTLAND IM 091-1(36)
 191 BRIDGE 38
 SHEET 72 OF 85
 HARTLAND - HARTFORD
 I 91-1 (22)
 Contract 2
 Sheet 41 of 220