


ABM INFO		SHOP BILL		JOB NO.	DRG. NO.				
PAGE	LINE	NO.	DESCRIPTION	FT	IN	ASSEM. MARK	SHIPPING MARK	REMARKS	WEIGHT
			$R4 \times 10^3$	2	0 $\frac{3}{8}$			PB1	
			DO	2	3 $\frac{1}{2}$			PB2	BEND
			DO	2	3 $\frac{1}{2}$			PB3	
			$R4 \times 10$	2	3 $\frac{1}{2}$			PB4	
			DO	2	3 $\frac{1}{2}$			PB5	
			$R4 \times 11^3$	2	4 $\frac{1}{2}$			PB46	
			$R4 \times 10$	2	4 $\frac{1}{2}$			PB47	
			$R4 \times 10^3$	2	4 $\frac{1}{2}$			PB48	
			$R4 \times 9^3$	2	4 $\frac{1}{2}$			PB49	BEND
			$R4 \times 10^3$	1	10 $\frac{3}{8}$			PB50	

Bearing height at centerline of bearing is 3.16" for B1-B5 and 2.66" for B46-B50. Verify with Contractor (J. Hollar of F. Whitcomb) that shim plates are not being used. Update heights accordingly.

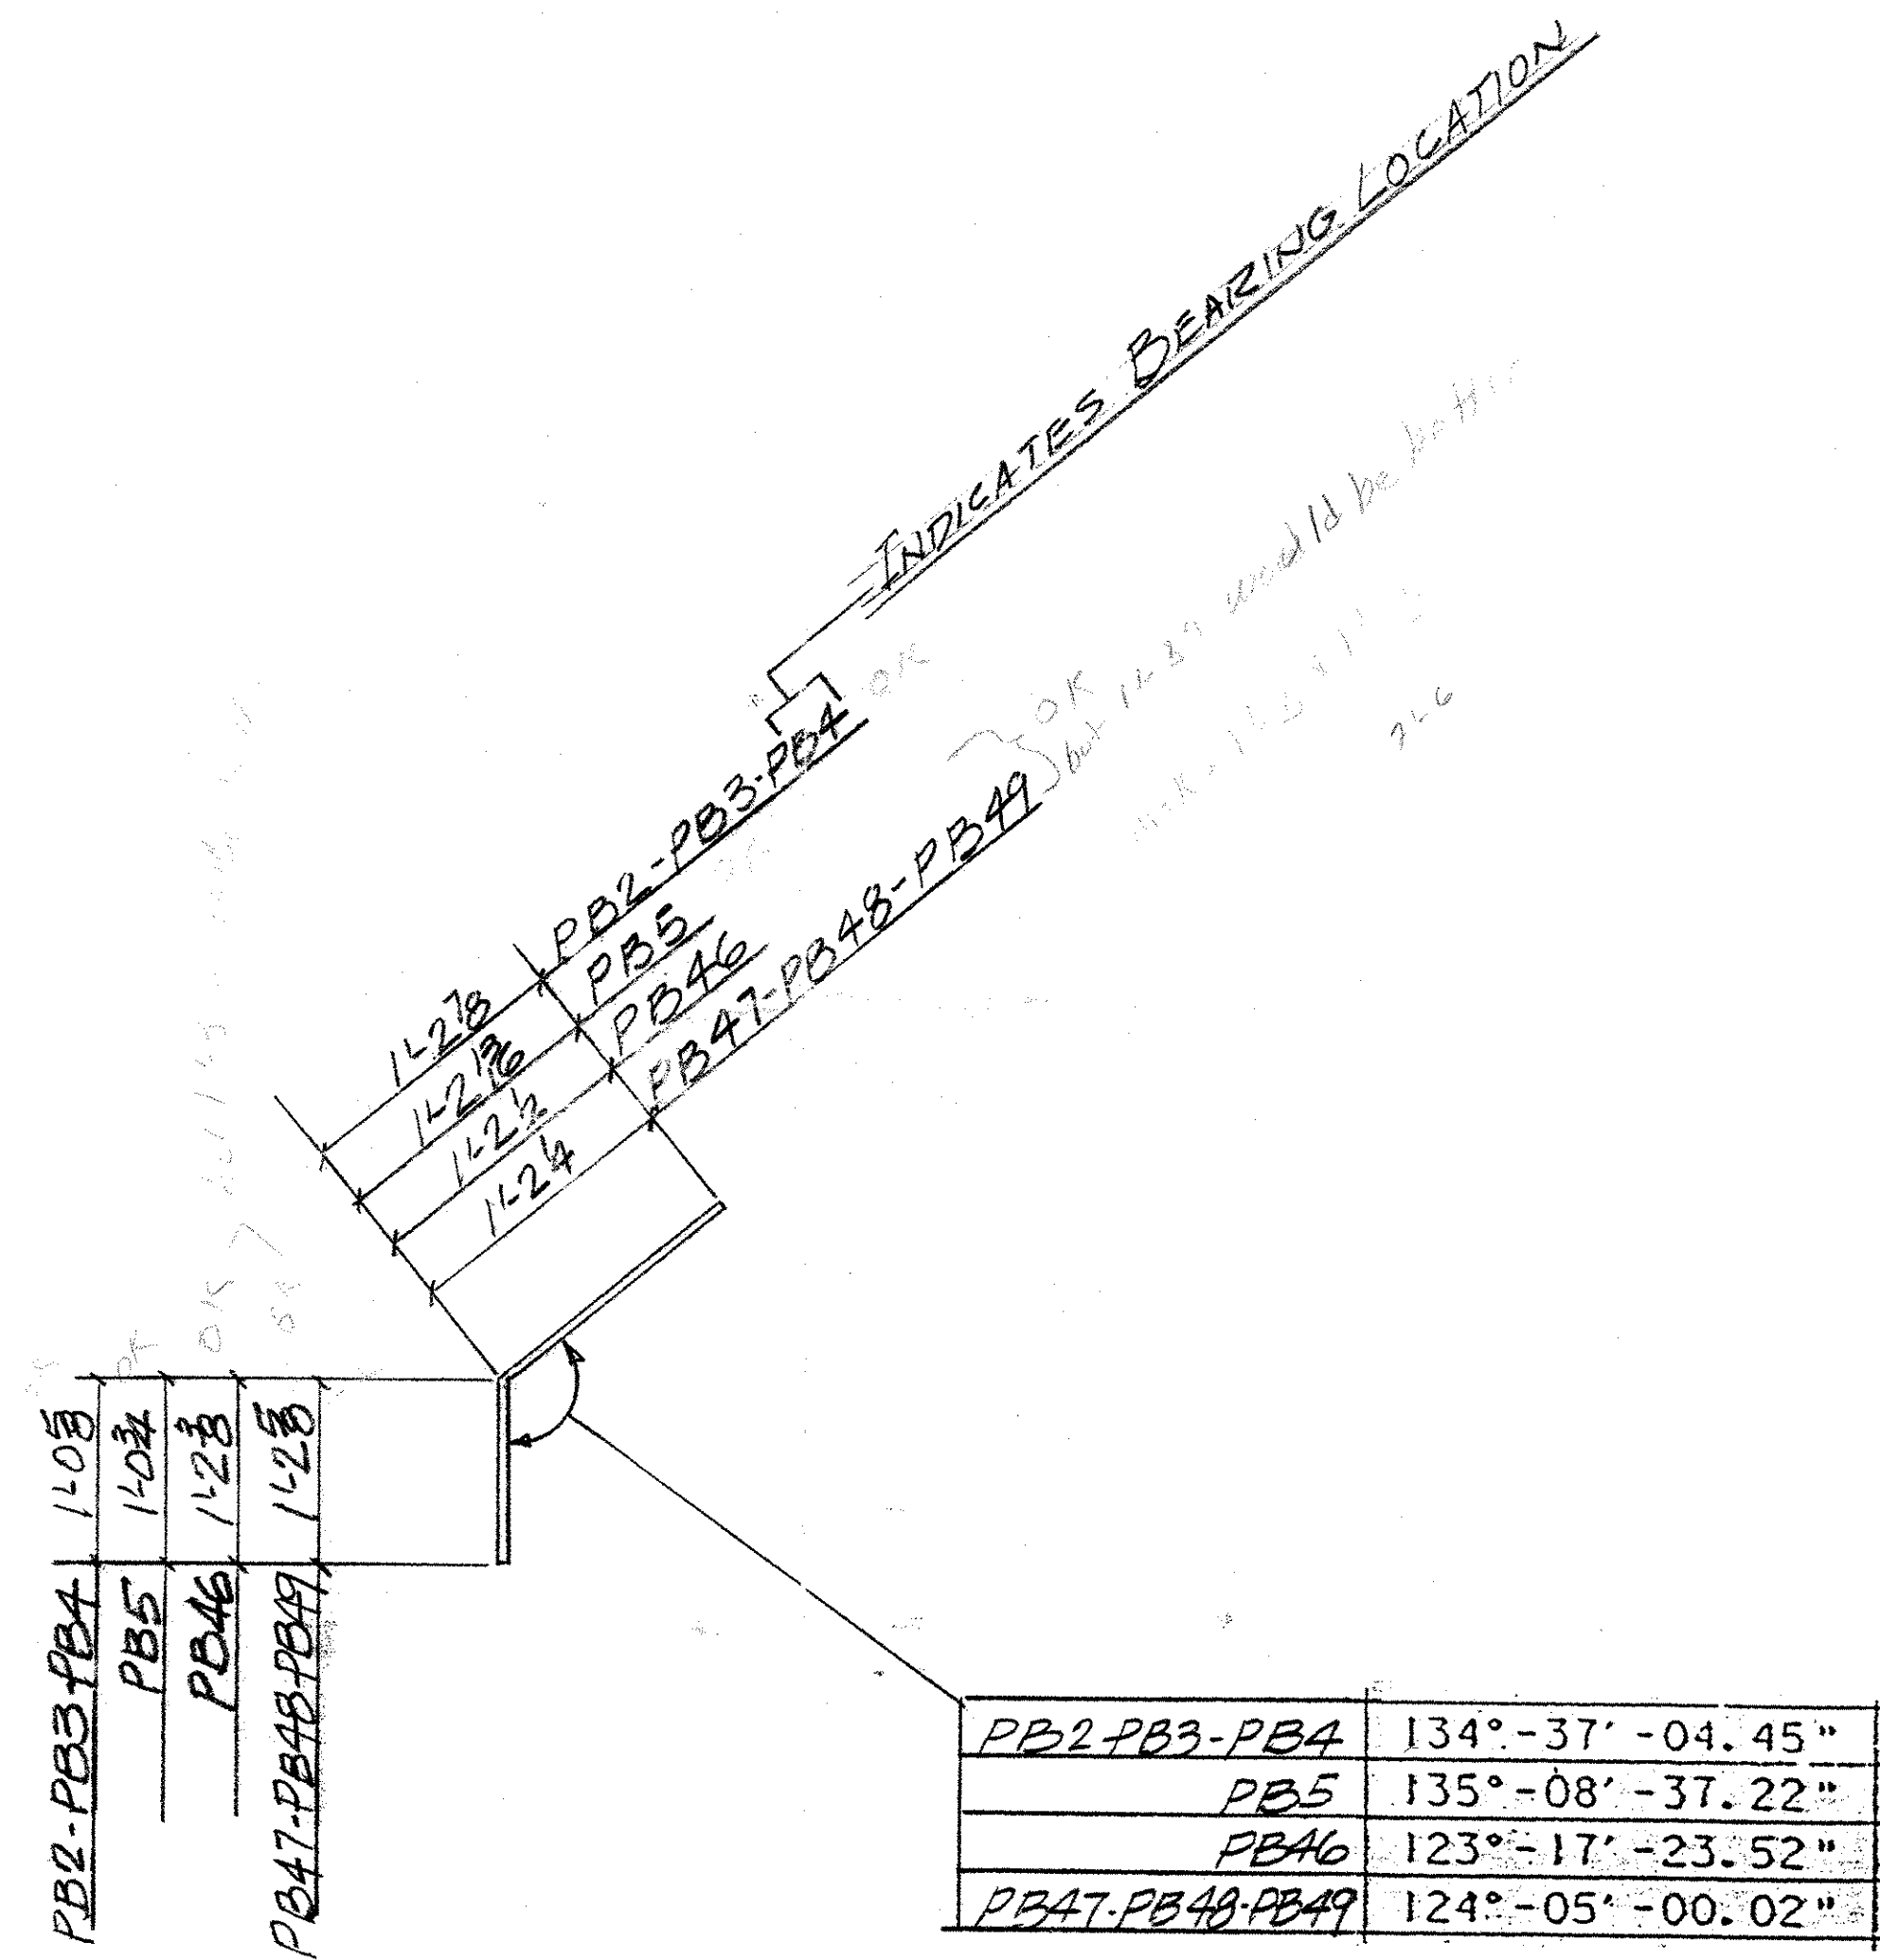

REVIEW STATUS		CONTRACTOR ACTION	
APPROVED	<input type="checkbox"/>	NONE	<input type="checkbox"/>
APPROVED AS REVISED	<input type="checkbox"/>	CONFIRM	<input type="checkbox"/>
REJECTED	<input checked="" type="checkbox"/>	RESUBMIT	<input checked="" type="checkbox"/>

REVIEW IS FOR GENERAL CONFORMANCE WITH THE DESIGN CONCEPT AND CONTRACT DOCUMENTS. MARKINGS OF CONFORMANCE SHALL NOT BE CONSTRUED AS RELIEVING THE CONTRACTOR FROM COMPLIANCE WITH THE PROJECT PLANS AND SPECIFICATIONS FOR DIMENSIONS. THEREFORE, THE CONTRACTOR REMAINS RESPONSIBLE FOR DETAILS AND QUANTITIES AND DIMENSIONS, FOR SELECTING FABRICATION PROCESSES FOR TECHNOLOGY, MATERIALS AND FOR ESTABLISHING WORKING & SHOP DRAWINGS.

BY Martha J. Lus DATE 7/15/03

PB1	$R4 \times 10^3 \times 2^0 \frac{3}{8}$
PB50	$R4 \times 9^3 \times 1^0 \frac{3}{8}$

Absolutely
VERIFY

OUT FOR APPROVAL	10-24-03
OUT FOR APPROVAL	
ISSUED TO SHOP	
FIELD & OFFICE	

REV.	REMARKS	DATE	DWN	CHK	APP	Q.A.	NO.	DIA.	LGT	TYPE	WASHER
	PROJECT NO. IM-091-1 (36)										
	STATE BRIDGE NO. 38										
	MATERIAL: <u>A1370</u>										
	<u>A1370</u> ELECTRODES: —										
	HOLES: —										
	SHOP BOLTS: —										
	SURFACE PREP. & PAINT:										
	<u>GALV. AFTER FAB (ASTM-A123)</u>										

DESCRIPTION: BEAM END RS. ABUTS. 1&2	DRAWN BY	DATE
JOB:	JPF	6-03
<u>US ROUTE 5</u>	CHKD BY	
<u>OVER I-91</u>	EJ	
<u>HARTLAND, VT.</u>	APPROV BY	
	Q.A.	

CUSTOMER: F.W. WHITCOMB	JOB NO.	DRG. NO.
CASCO BAY STEEL STRUCTURES, INC.	198	M2
75 SPRING HILL ROAD SACO, MAINE 04072	097	REV. Δ
PHONE (207) 282-7360 FAX. (207) 282-1179		