





# Bus Loop

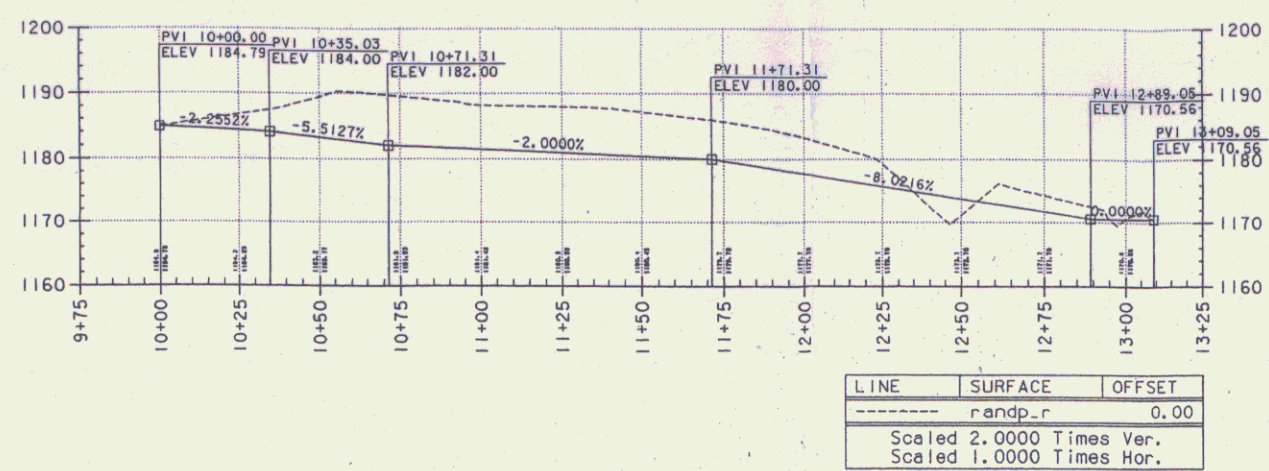

# Access Road

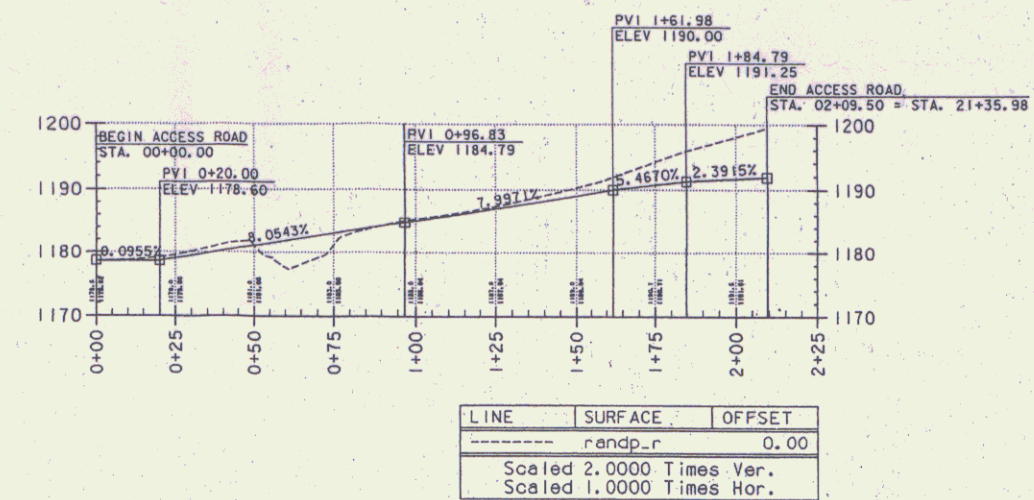

# Parking Lot

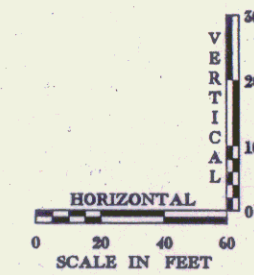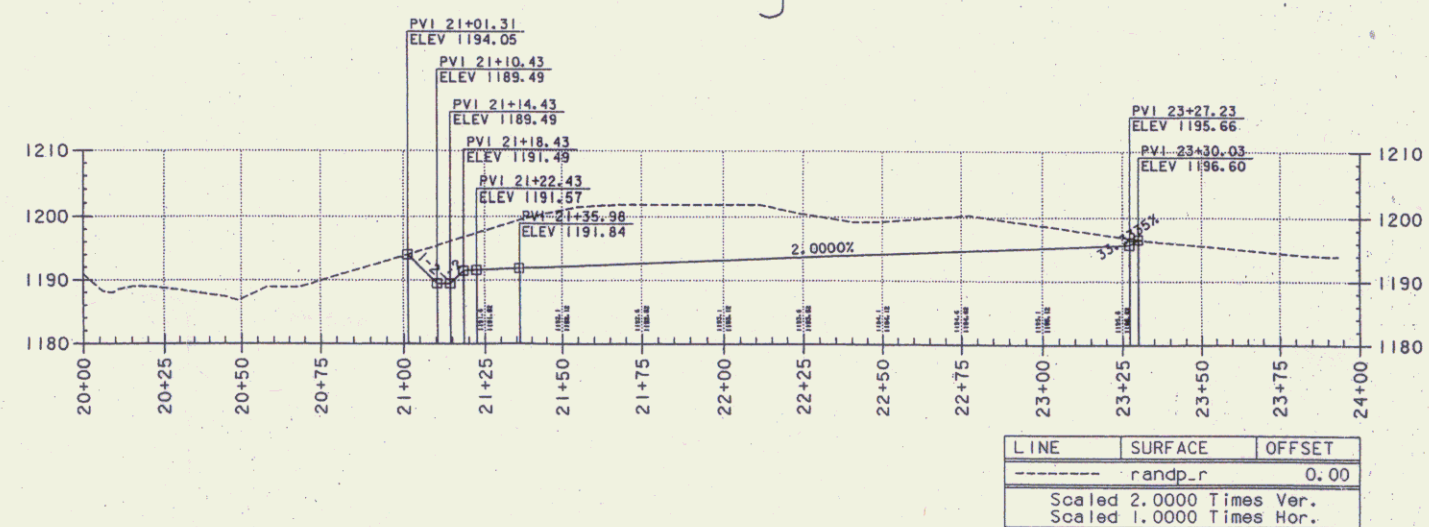

	PROJECT NAME: RANDOLPH CMG PARK(2)IS	PLOT DATE: 04
	PROJECT NUMBER: 6380012.15	DRAWN BY: GG
	FILE NAME: ...04 PROFILES.p+f	CHECKED BY: CS
	PROJECT LEADER: WLD	SHEET 4 0
	DESIGNED BY: CSP/GGG	PROFILES