


RIGHT-OF-WAY DIVISION  
TOWN FILE  
PERPETUAL  
Town of VT 12  
(To Be Returned To R.O.W. Division)

A 4.30 Lt  
D 1.15"  
T 180.1  
L 360.0  
E 9.5  
Do not bank

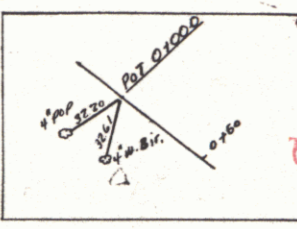

(To Be Returned To R.O.W. Division)  
Town of VT 12  
PERPETUAL  
RIGHT-OF-WAY DIVISION

Parcel	Instr	Date	Grantor	Grantee	Recorded	Book	Page	Date	Remarks
#1	W.D.O.E.		Lyman L & Grace L Wilson	St. of Vt.	Berlin	1	144	5-15-54	Misc. Records
#2	W.D.O.E.		Eva DeLory	St. of Vt.	Berlin	1	142	5-15-54	Misc. Records
#3	W.D.O.E.		Guy & Harriet Folsom	St. of Vt.	Berlin	1	139	5-15-54	Misc. Records

Print 002004

Project No. **BERLIN - ROUTE 12**  
**APPLICATION 162-25.6/52**

PART - B

SHEET 1

PLAN  
DATE  
BY  
CHECKED  
DATE  
BY  
NOTE BOOK  
DATE  
BY  
DATE  
BY

PLAN  
DATE  
BY  
CHECKED  
DATE  
BY  
NOTE BOOK  
DATE  
BY  
DATE  
BY