


PLAN	DATE	BY
NOTED		
NOTE BOOK		
QUANTITY CHECKED		
NO. OF WIRE CHECKED		

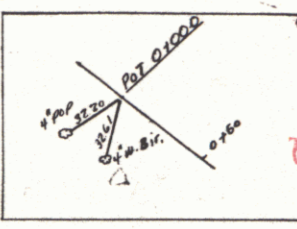

PERPETUAL
TOWN FILE
RIGHT-OF-WAY DIVISION
(To Be Returned To R.O.W. Division)

Parcel	Instr.	Date	Grantor	Grantee	Recorded	Book	Page	Date	Remarks
#1	W.D.O.E.		Lyman L. & Grace L. Wilson	St. of Vt.	Berlin	1	144	5-15-54	Misc. Records
#2	W.D.O.E.		Eva DeLory	St. of Vt.	Berlin	1	142	5-15-54	Misc. Records
#3	W.D.O.E.		Guy & Harriet Folsom	St. of Vt.	Berlin	1	139	5-15-54	Misc. Records

PLAN	DATE	BY
NOTED		
NOTE BOOK		
QUANTITY CHECKED		
NO. OF WIRE CHECKED		

Print 002004

Project No. **BERLIN - ROUTE 12**
APPLICATION 162-25.6/52
PART - B

SHEET 1