
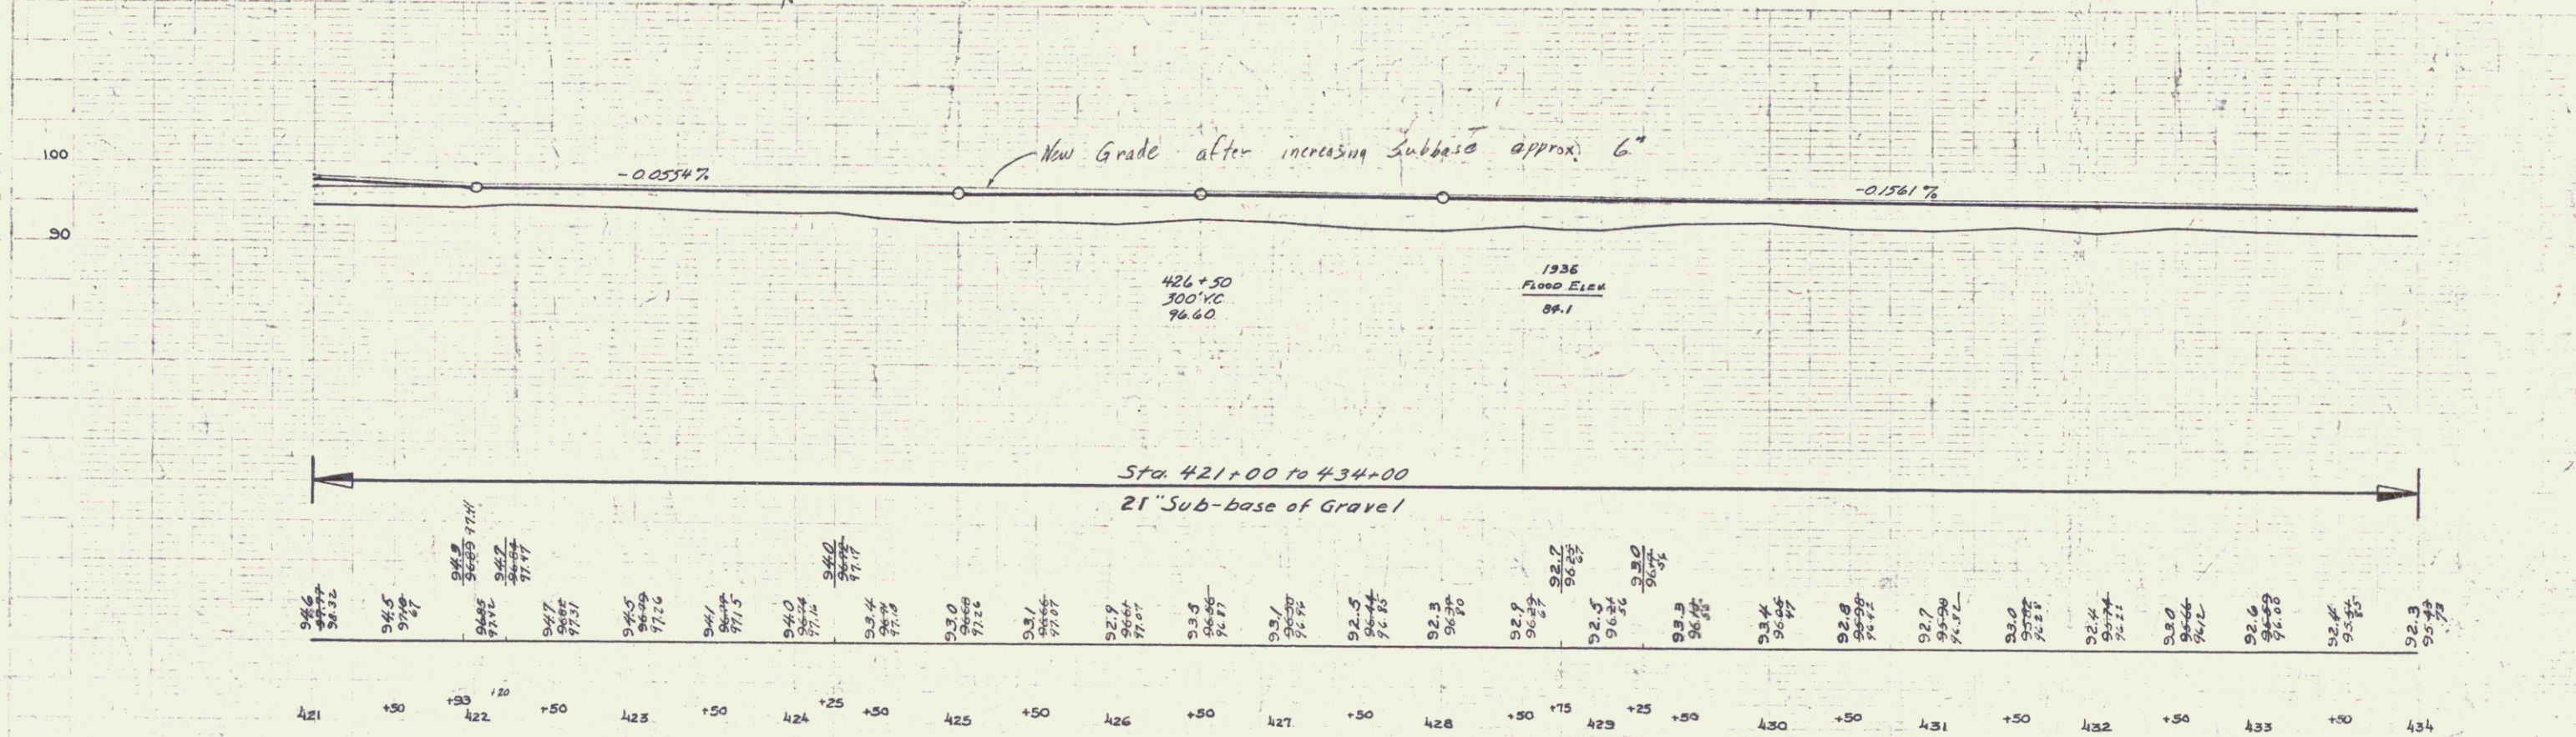


PARCEL	INSTRUMENT	DATE	GRANTOR	GRANTEE	RECORDED	REMARKS
A B C	N.D.	6-9-37	MARTIN L. VYMAN	STATE	29 351-12	6-20-37
A'	N.D.	5-25-37	FRANCIS W. KETCHUM	"	29 351-10	6-20-37

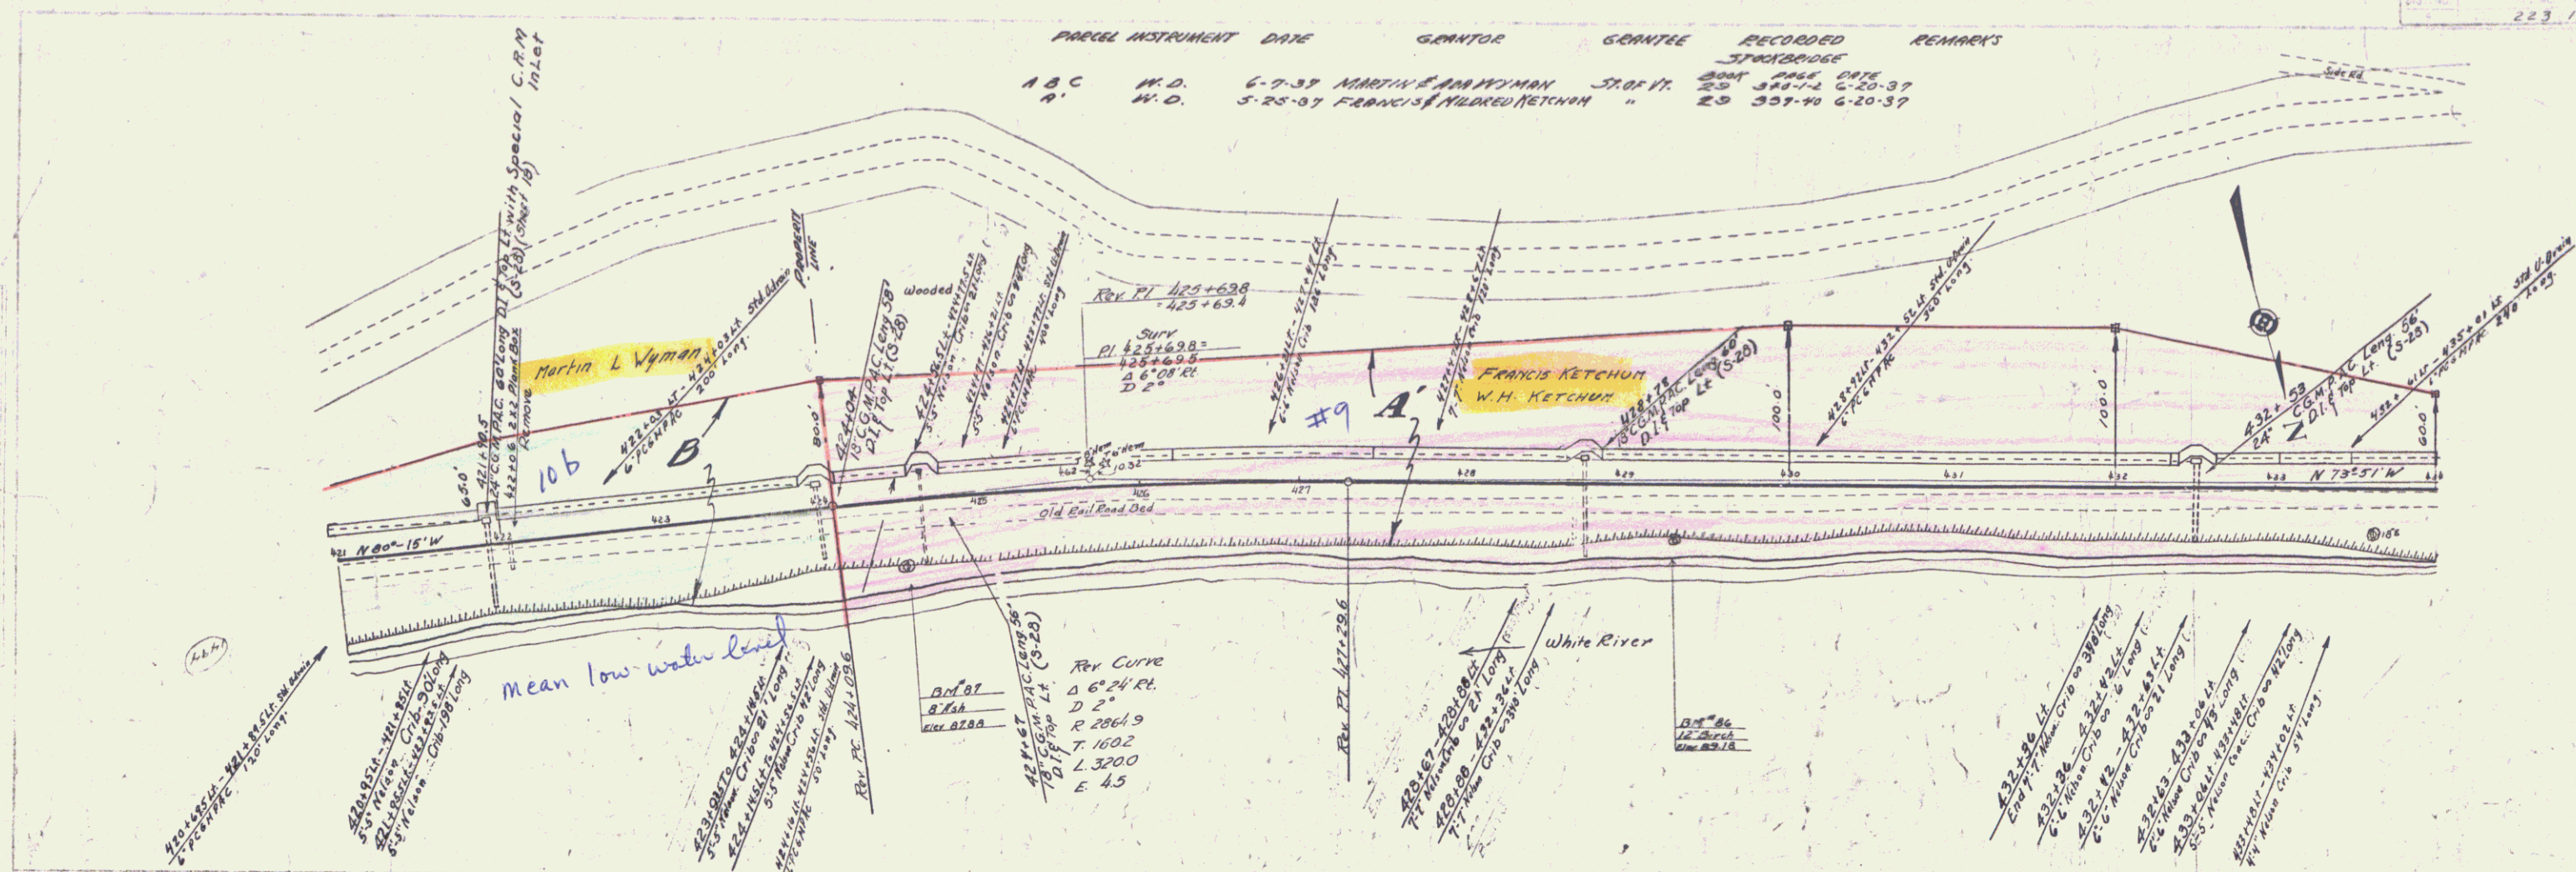

BM 631A in 8' Ash 39' W 510 424+50 Elev 87.88
 BM 632A in 12' Birch 35' W 550 429+30 Elev 89.18