


PARCEL	INSTRUMENT	DATE	GRANTOR	GRANTEE	RECORDED	REMARKS
ABC	N.D.	6-7-37	MARTIN L. WYMAN	57.07 AC	29 370.12	6-20-37
A'	N.D.	5-25-37	FRANCIS W. MILDRED TOWN	"	29 357.74	6-20-37

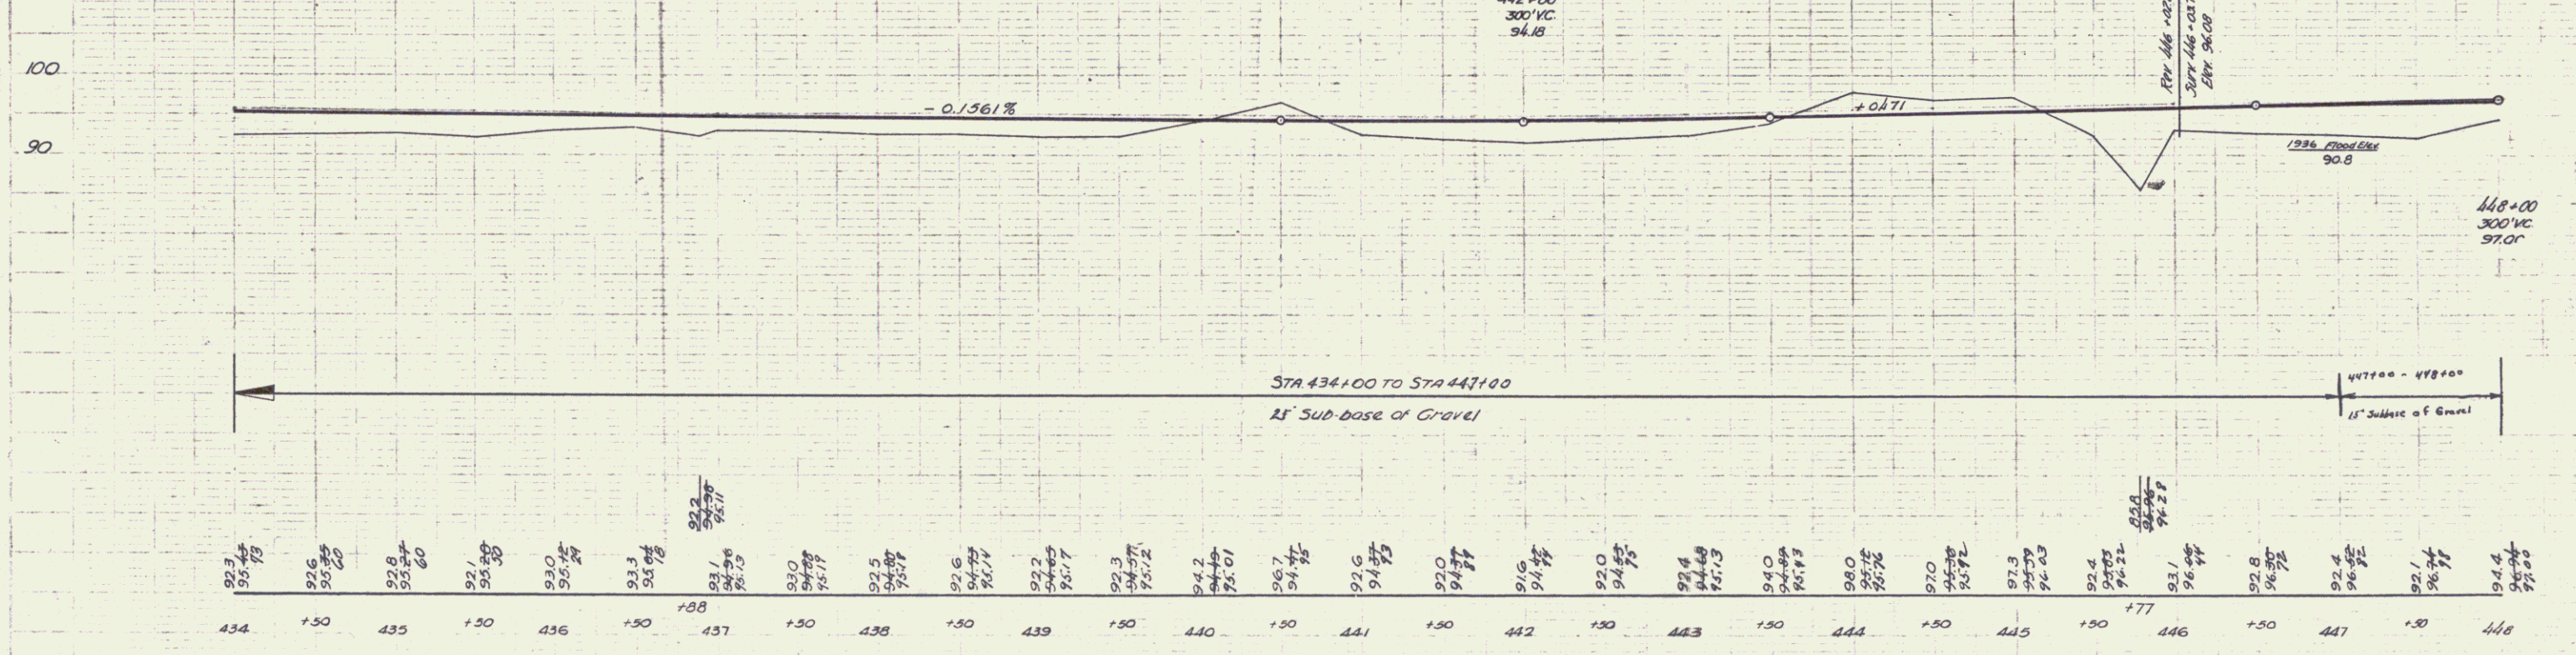

BM 85 - spike in 18" Yellow Birch. 40 ft right Sta 436 + 13. Elevation: 87.13.
 BM 8A - spot on 5 ft. boulder, one foot left Sta 447 + 13. Elevation: 97.25.