


| PARCEL | KIND OF INSTRUMENT | DATE OF INSTRUMENT | GRANTOR | GRANTEE | RECORDED STOCKBRIDGE BOOK PAGE DATE | REMARKS |
|--------|--------------------|--------------------|----------------|---------|-------------------------------------|---------|
| A | Q.C.D. | 12-23-36 | LAWRENCE MILLS | STOFFY | 29 319-20 12-23-36 | |

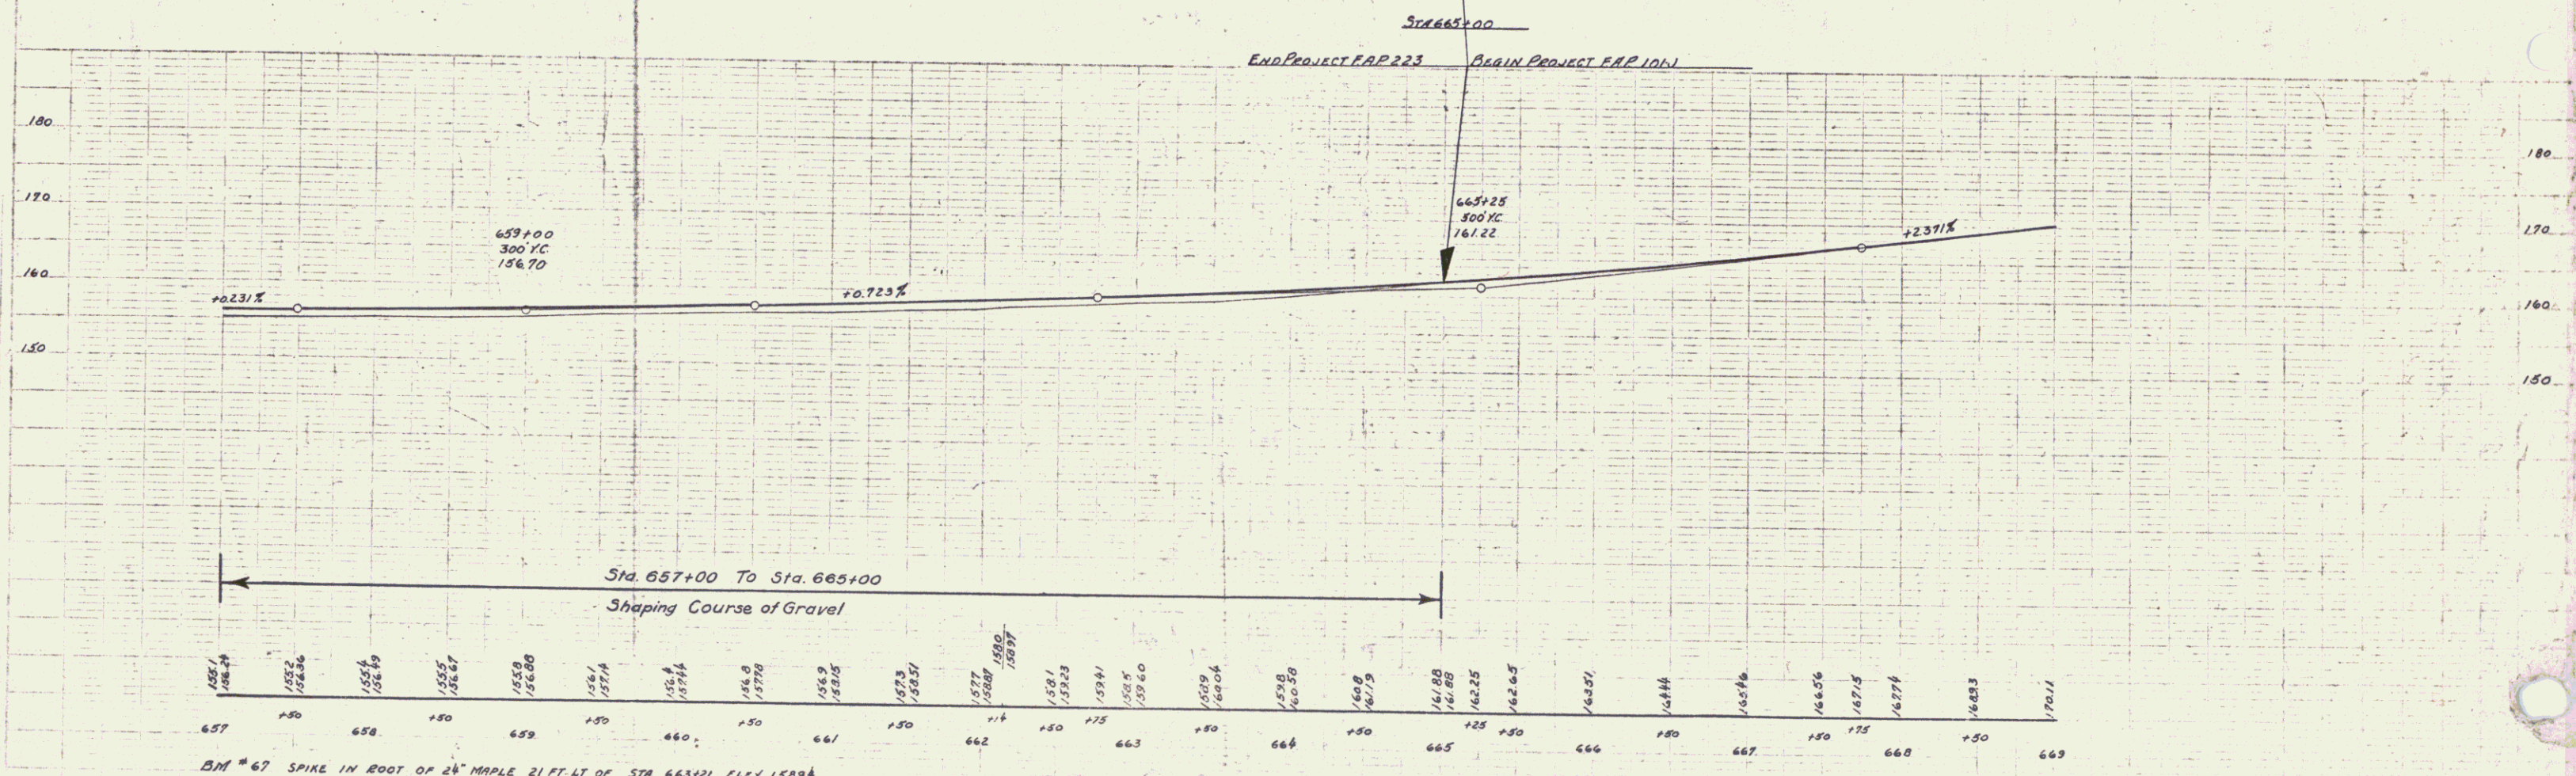

BM # 67 SPIKE IN ROOT OF 24" MAPLE 21 FT. LT. OF STA 663+21 ELEV 1589.4