
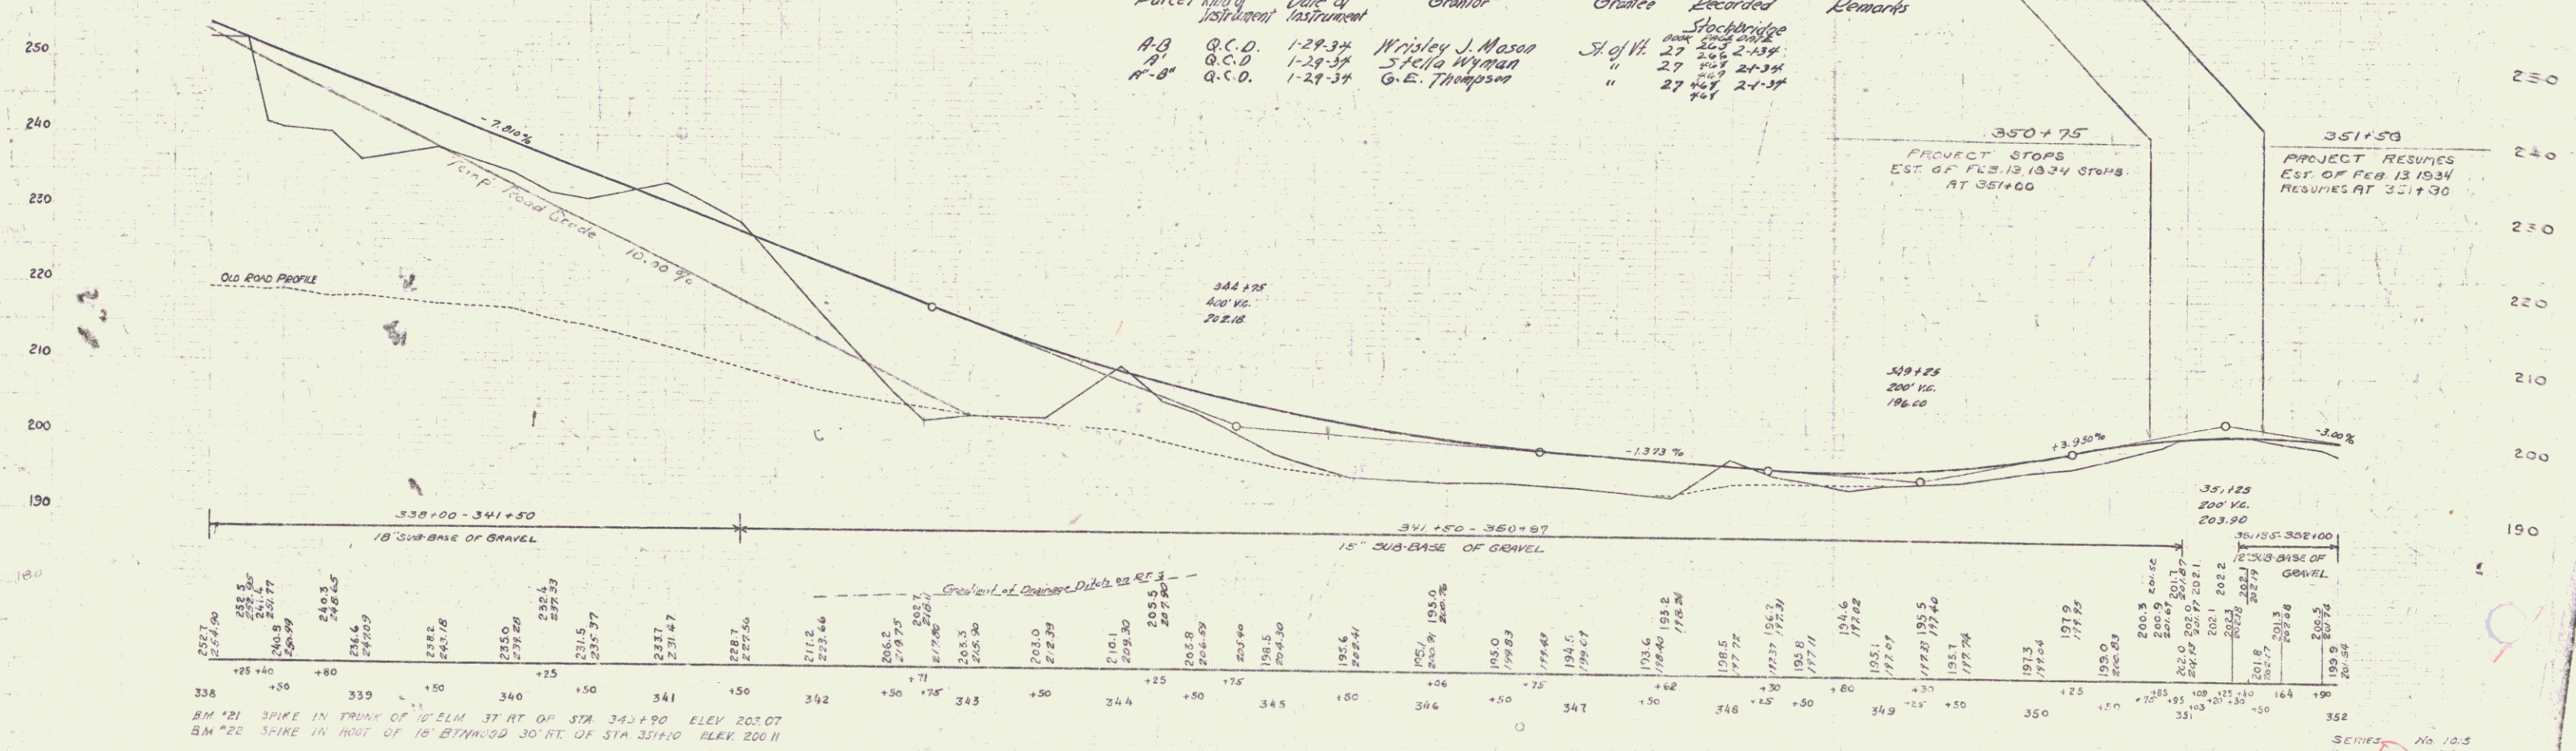


343+75-345+75 LT. GRAVELLED CEMENT GUTTER 56 C.Y.
 343+75-345+75 LT. CEMENT RUBBLE MANSARDY 22.2 C.Y.
 338+25-339+75 RT. DEY " " 102 C.Y.

1015 1934

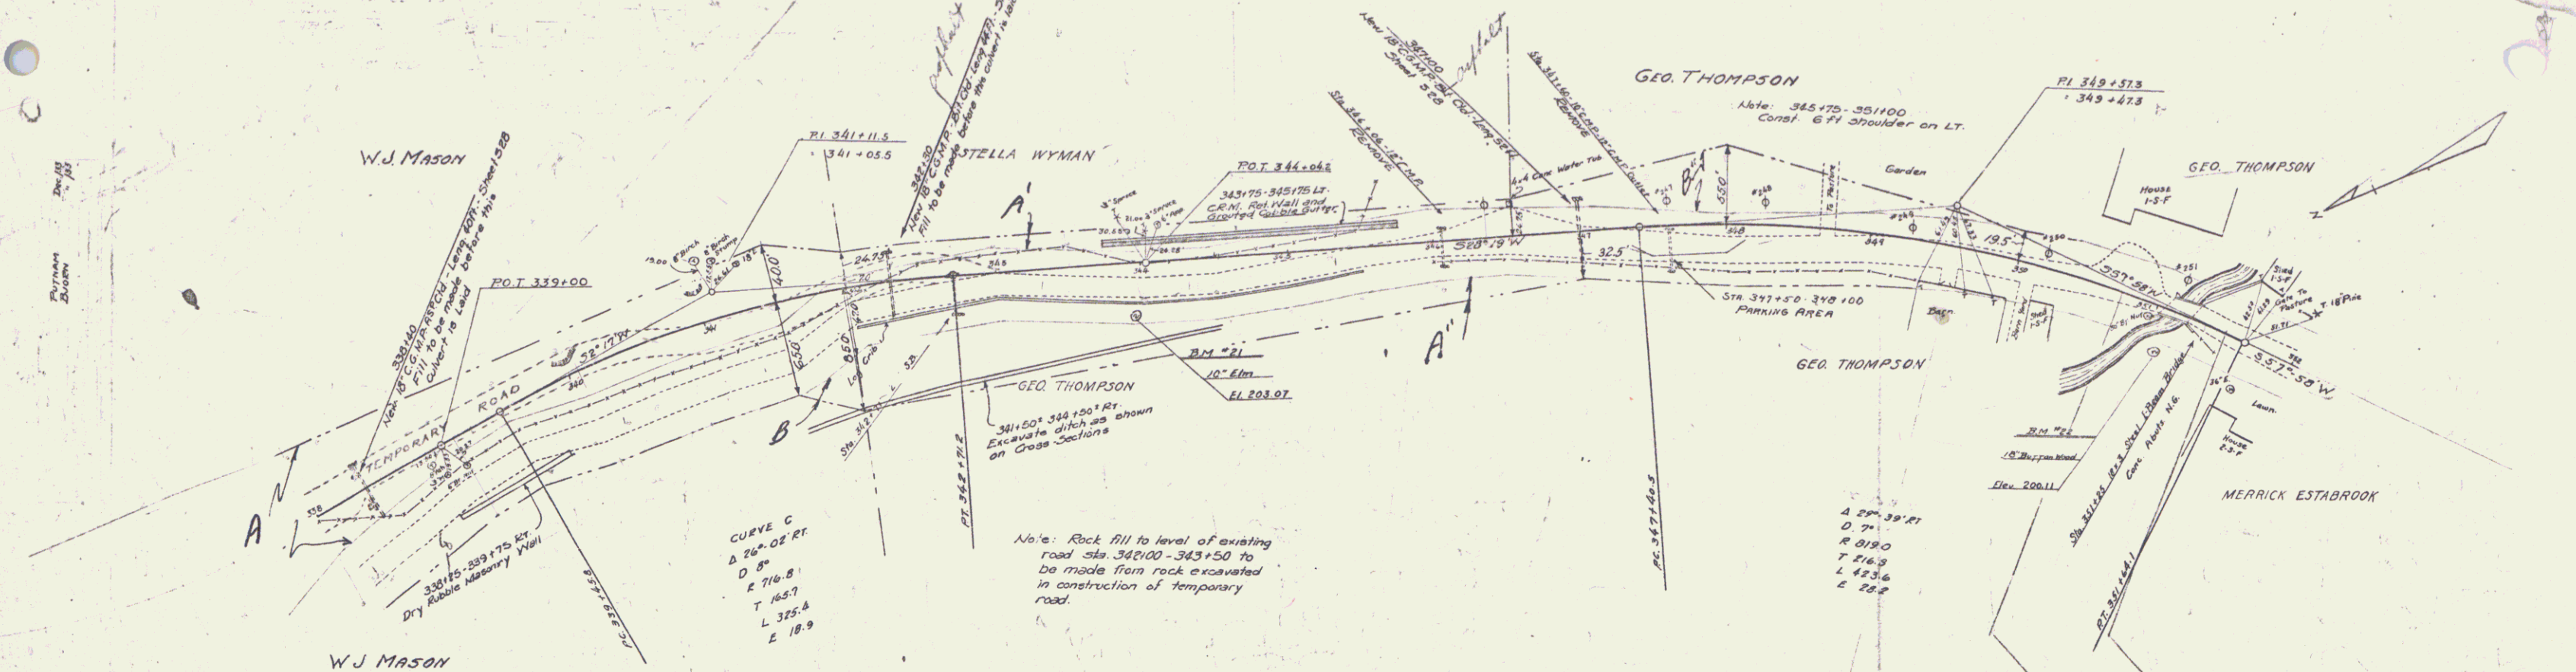

Parcel	Kind of Instrument	Date of Instrument	Grantor	Grantee	Recorded	Remarks
A-B	Q.C.D.	1-29-34	Wesley J. Mason	St of W.	27	263 2-134
A-C	Q.C.D.	1-29-34	Stella Wyman	"	27	263 2-134
A-D	Q.C.D.	1-29-34	G.E. Thompson	"	27	263 2-134

BM #21 SPIKE IN TRUNK OF 10' ELM 37 FT. OF STA 343+90 ELEV 202.07
 BM #22 SPIKE IN ROOT OF 18' BIRCHWOOD 30 FT. OF STA 351+00 ELEV 200.11

SERIES No 1015
 SHEET 3 OF 78

2